



VARIANCE APPLICATION SUMMARY



File Number	V-25-8
Property Address	3590 CLOTTS RD GAHANNA, OH 43230
Parcel ID	025-003899
Zoning District	R-1 - Large Lot Residential
Project/Business Name	Morris Residence
Applicant	Matt Toddy matt@elevationstudio.us 330-697-8525
Description of Variance Request	Requesting a variance from the R-1 side yard setback requirement of 15' to match the existing structure side yard setback of 11'-2".

Requested Variances

Code Section	Code Title
Ch 1103.07(e)	Large Lot Residential



AUTHORIZATION CONSENT FORM

If you are filling out more than one application for the same project & address, you may submit a copy of this form with each additional application.

As the owner or acting agent for the subject property, I have reviewed the application and hereby authorize the listed applicant to make decisions that may affect my property as it pertains to this application.

A handwritten signature in black ink, appearing to be "AM", written over a horizontal line.

(property owner/acting agent signature)

Amanda Morris

(printed name)

03/25/25

(date)

A handwritten signature in black ink, appearing to be "AM", written over a horizontal line.

(applicant signature)

Amanda Morris

(printed name)

03/25/25

(date)

elevate your mission



March 25, 2025

Elevation Studio
933 Taurus Ave.
Columbus, Ohio 43230

Reference: 3590 Clotts Road – Variance Application

To Whom It May Concern,

Please see following adjacent parcels to the subject property:

- Dressing, Tanya
518 Clotts Rd
Columbus, OH 43230
- Assured Holdings, LCC
PO Box 9788
Columbus, OH 43209
- Mathews, Anna
509 Theori Ave
Gahanna, OH 43230
- Kanaan, Alison
503 Theori Ave
Gahanna, OH 43230

Sincerely,

Matt Toddy, AIA

matt@elevationstudio.us



March 25, 2025

Elevation Studio
933 Taurus Ave.
Columbus, Ohio 43230

Reference: 3590 Clotts Road – Variance Application


To Whom It May Concern,

1. What are the special circumstances or conditions necessitating the variance?
 - **The proposed addition aligns with the existing structure, which sits approximately 11'-2" away from the side (south) property line. This is less than the new side-yard setback requirement for R-1 adopted in 2024 of 15'.**
2. How is the variance necessary for preservation and enjoyment of property rights?
 - **The proposed addition must align with the existing structure to avoid existing utility lines in the rear yard to the north of the proposed addition.**
3. How will the variance not adversely affect the health or safety of the surrounding area?
 - **The existing structure is non-conforming (as are most in the neighborhood) since the new code went into effect. The proposed variance would allow for a continuation of the existing character and is not detrimental to the health or safety of the neighborhood.**

Sincerely,


Matt Toddy, AIA

matt@elevationstudio.us

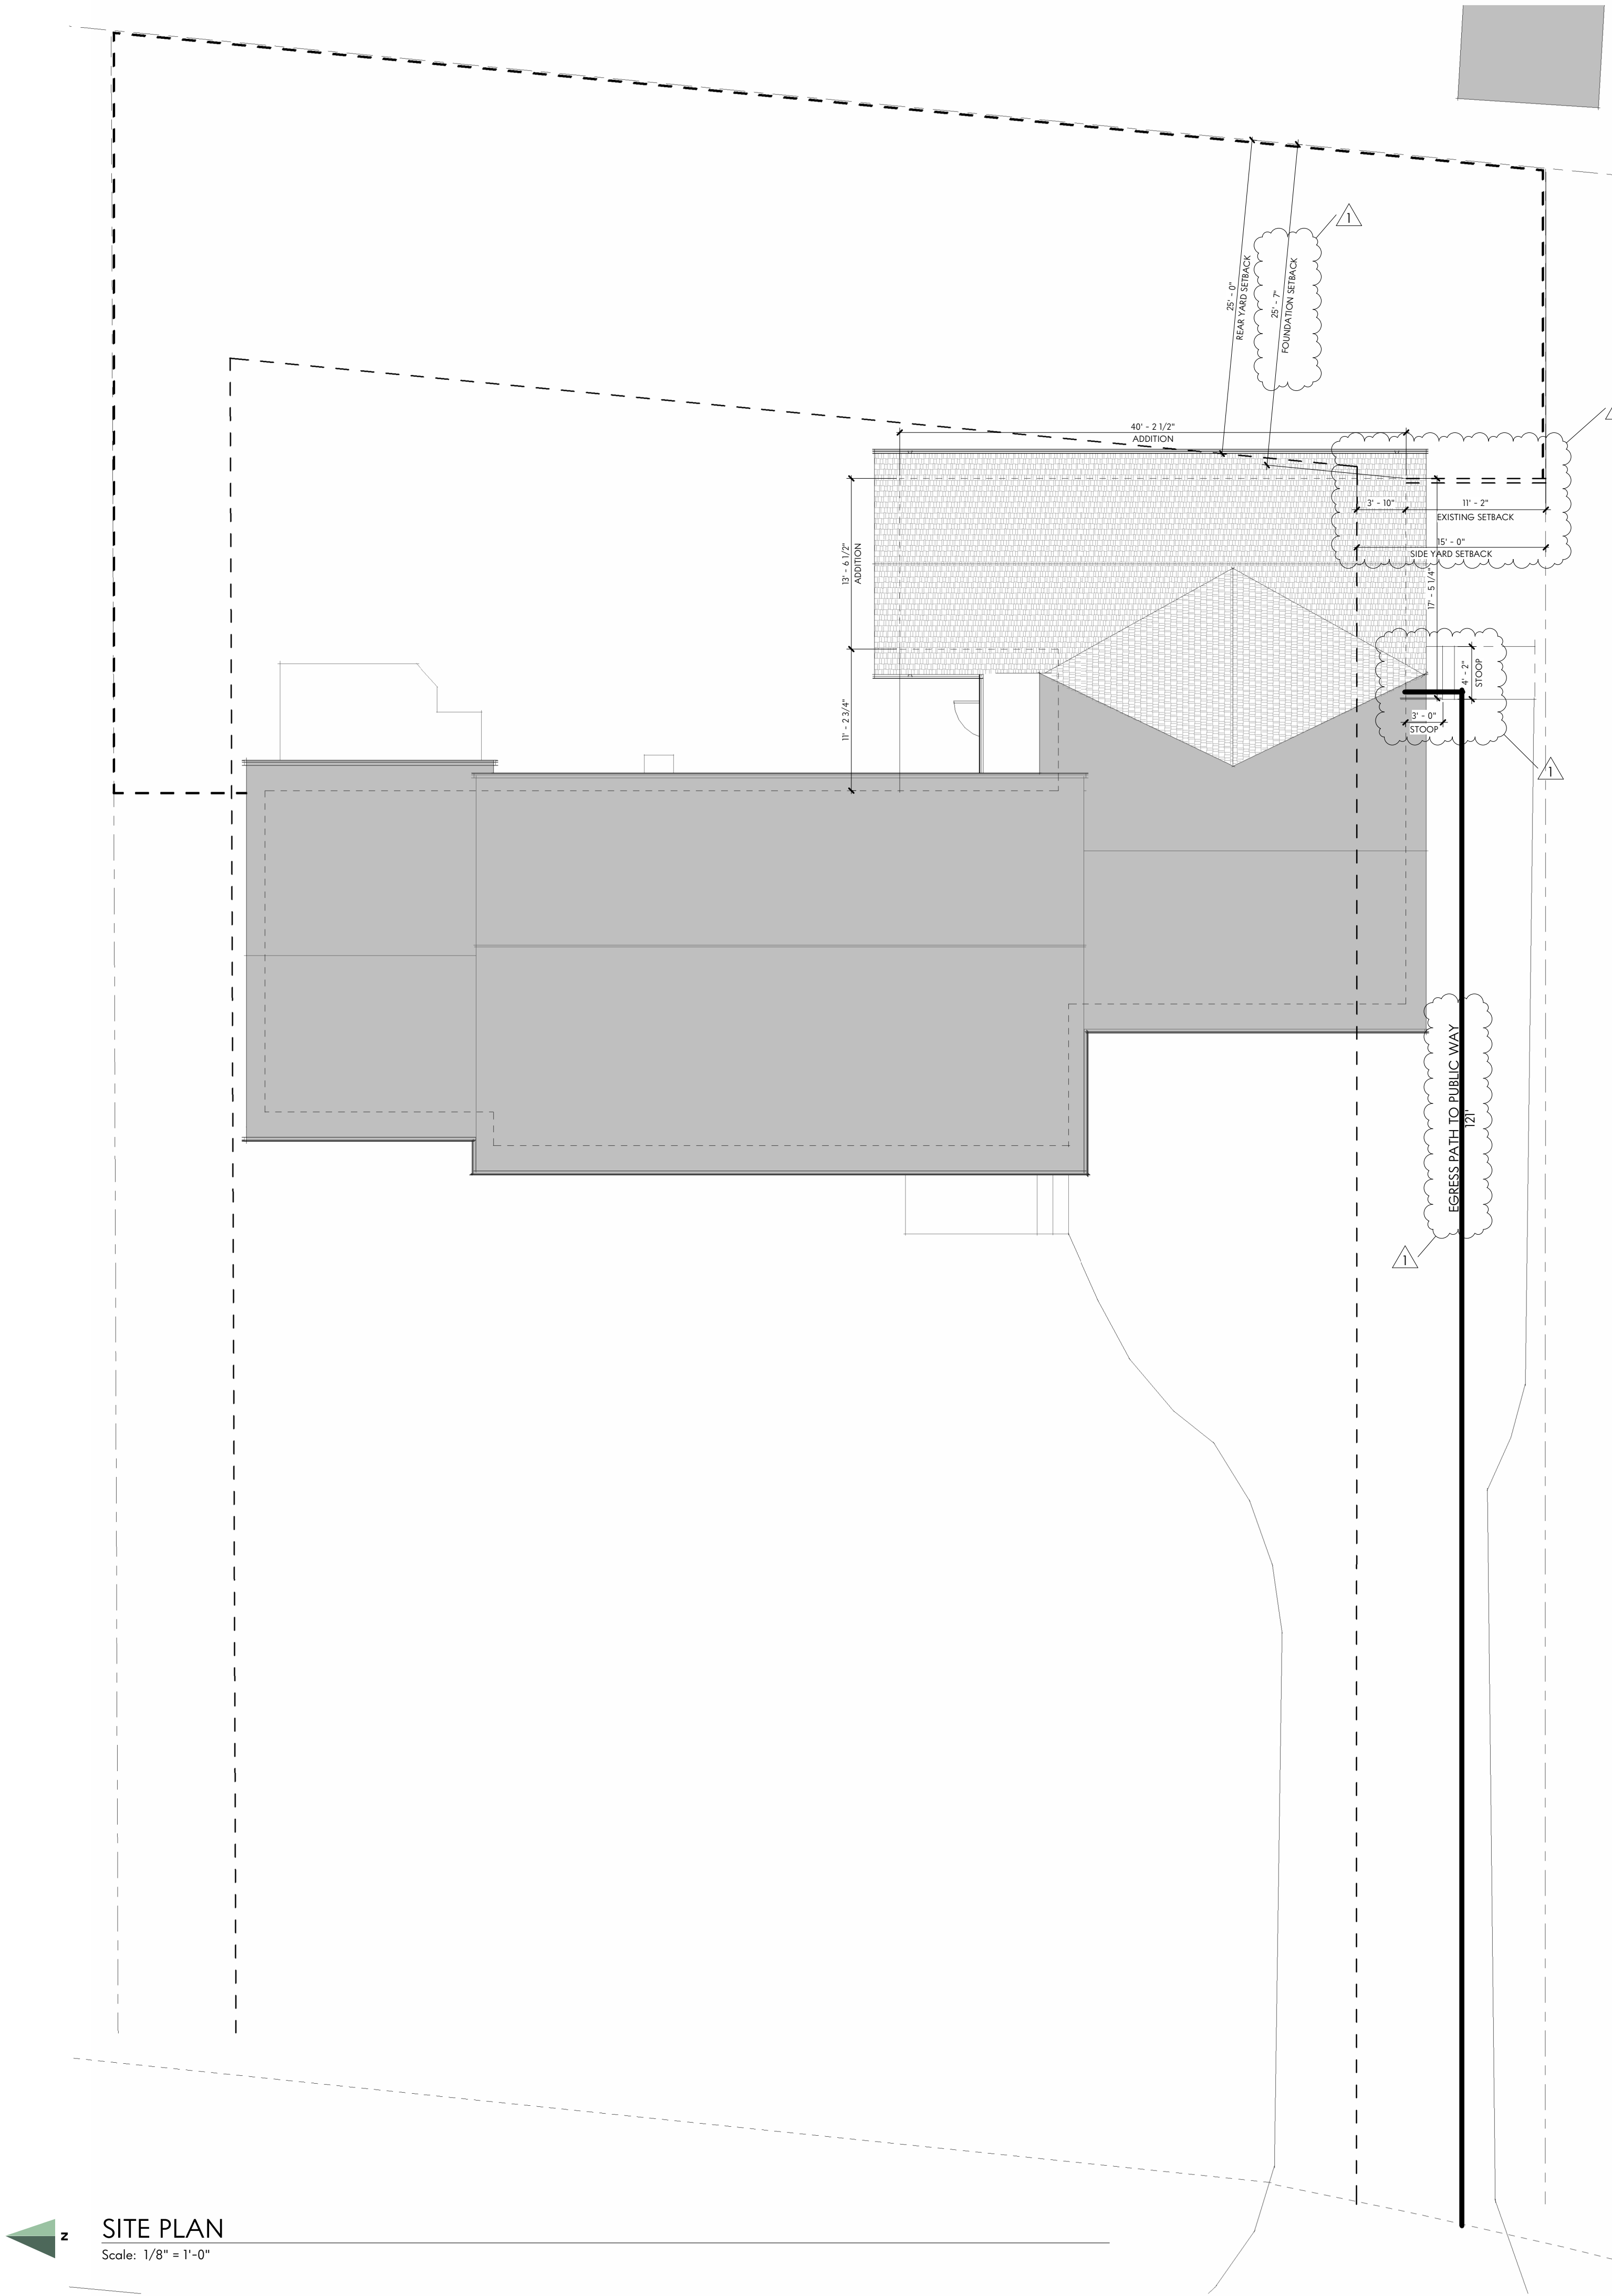

GENERAL NOTES - SITE PLAN

- A. DO NOT SCALE DRAWINGS. IF DIMENSIONS ARE IN QUESTION, THE CONTRACTOR SHALL BE RESPONSIBLE FOR SEEKING CLARIFICATION FROM ARCHITECT PRIOR TO CONSTRUCTION.
- B. ALL DIMENSIONS ARE FROM FINISHED SURFACE TO FINISHED SURFACE, UNLESS NOTED OTHERWISE.
- C. ARCHITECTURAL SITE PLAN IS PROVIDED TO SHOW THE RELATIONSHIP OF THE ARCHITECTURAL ELEMENTS AND TO PROVIDE PLAN AND DETAIL KEY REFERENCE ONLY.

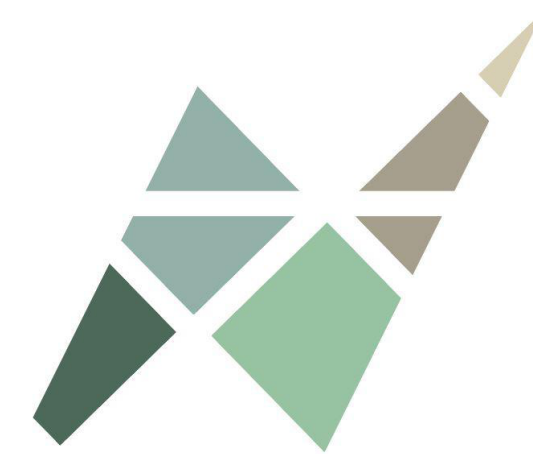

PROJECT STATUS

ZONING VARIANCE

CURRENT ISSUE DATE

3.25.2025

PROJECT NO.

24038

REVISIONS

#	DESCRIPTION	DATE
1	Revision 1	3.11.2025
2	Revision 2	3.25.2025

PROJECT INFORMATION

Morris Residence

Jim & Amanda Morris

3590 Clotts Rd.
Gahanna, OH 43230



MATTHEW TODDY, LICENSE #1616697
EXPIRATION DATE: DECEMBER 31, 2025



SHEET NAME

ARCHITECTURAL
SITE PLAN

SHEET NUMBER

A100

Morris Residence

PROJECT SHEET INDEX

SHEET #	SHEET NAME	REVISION #	REVISION DATE
GENERAL			
G001	TITLE SHEET		
G002	GENERAL NOTES /CODE INFO.		
G003	RESCHECK REPORT		
ARCHITECTURAL			
A100	ARCHITECTURAL SITE PLAN	2	3.25.2025
A101	DEMOLITION & FOUNDATION PLANS	1	3.11.2025
A102	ARCHITECTURAL & ROOF PLANS	2	3.25.2025
A103	FRAMING PLANS	1	3.11.2025
A104	ELECTRICAL & CEILING PLANS	1	3.11.2025
A200	ELEVATIONS	1	3.11.2025
A300	SECTIONS - BUILDING	1	3.11.2025
A301	SECTIONS - WALL	1	3.11.2025

PROJECT SCOPE


THE PROJECT SCOPE IS TO CONSTRUCT A NEW 651SF ADDITION TO AN EXISTING RESIDENCE IN GAHANNA, OHIO. THE WORK INCLUDES A NEW KITCHEN, LIVING ROOM, BATHROOM, AND BEDROOM WITH NEW PLUMBING FIXTURES AND LIGHT FIXTURES.

- MEP SCOPE**
- MECHANICAL:** A NEW RESIDENTIAL SPLIT-TYPE SYSTEM WILL BE INSTALLED.
- ELECTRICAL:** NEW LIGHT FIXTURES AND OUTLETS WILL BE PROVIDED THROUGHOUT THE ADDITION AND THE RENOVATION PER THE OWNER'S SELECTION. ELECTRICAL WILL BE FED FROM NEW SUBPANEL LOCATED IN THE HALLWAY.
- PLUMBING:** THE KITCHEN WILL INCLUDE A NEW SINK. THE BATHROOM WILL INCLUDE A SHOWER, TOILET, AND SINK. PLUMBING WILL TIE INTO EXISTING SANITARY STACK IN BASEMENT.

CODE DESIGN DATA

- BUILDING:** SINGLE FAMILY RESIDENCE
- CONSTRUCTION:** 5-B
- CODE:** 2019 RESIDENTIAL CODE OF OHIO + IECC 2009
- GROUND SNOW LOAD:** 20 PSF
- WIND SPEED:** 90 MPH
- WEATHERING:** SEVERE
- FROST LINE DEPTH:** 36 INCHES
- TERMITE:** MODERATE/HEAVY
- WINTER DESIGN:** 8° F
- MEAN ANNUAL TEMP:** 50° F

SITE MAP

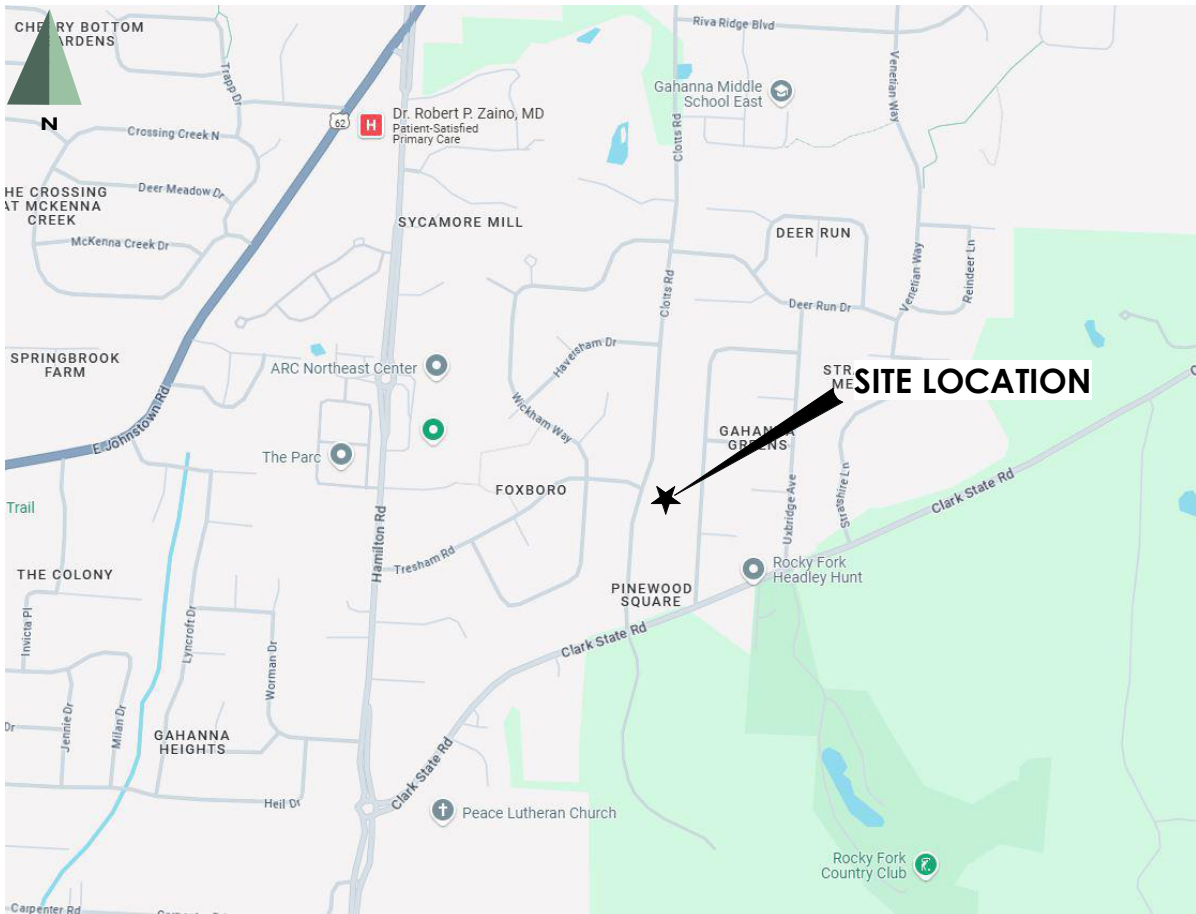

OWNER

JIM & AMANDA MORRIS
3590 CLOTT'S RD.
GAHANNA, OH 43230

ARCHITECT

ELEVATION STUDIO
933 TAURUS AVENUE
GAHANNA, OH 43230

GENERAL CONTRACTOR

KIRK DESIGN & CONSTRUCTION
PO BOX 30180
COLUMBUS, OH 43230



PROJECT STATUS

ZONING VARIANCE

CURRENT ISSUE DATE

3.25.2025

PROJECT NO.

24038

REVISIONS

#	DESCRIPTION	DATE

PROJECT INFORMATION

Morris Residence
Jim & Amanda Morris
3590 Clotts Rd.
Gahanna, OH 43230



MATTHEW TODDY, LICENSE #1616697
EXPIRATION DATE: DECEMBER 31, 2025



SHEET NAME

TITLE SHEET

SHEET NUMBER

G001



ZONING VARIANCE


3.25.2025

24038

#	DESCRIPTION	DATE
---	-------------	------

PROJECT INFORMATION

Jim & Amanda Morris

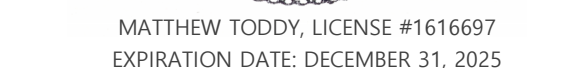

SHEET NUMBER

cccc

F. ROOF TRUSSES SHALL BE FASTENED TO THE SUPPORT WALLS WITH SIMPSON "H2.5A" TIES OR EQUAL U.N.O. AND SHALL BE NAILED PER MANUFACTURER'S RECOMMENDATIONS. TIES TO BE VERIFIED AFTER TRUSS DESIGN.



Project Morris Residence

Energy Code: 2018 IECC
Location: Columbus, Ohio
Construction Type: Single-family
Project SubType: None
Climate Zone: 5 (5708 HDD)
Permit Number:
All Electric: false
Is Renewable: false
Has Charger: false
Has Battery: false
Has Heat Pump: false

Construction Site:
3590 Clotts Rd.
Columbus, Ohio 43230

Owner/Agent:

Designer/Contractor:
Matt Toddy
Elevation Studio
933 Taurus Ave.
Columbus, Ohio 43230

Compliance: Passes using UA trade-off

Compliance: 0.0% Better Than Code Maximum UA: 108 Your UA: 108
The % Better or Worse Than Code value reflects the ability to compliance for heat is based on code trade-off rules.
It DOES NOT provide an estimate of energy use or cost relative to a minimum code home.

Slab-on-grade tradeoffs are no longer considered in the UA or performance compliance path in REScheck. Each slab-on-grade assembly in the specified climate zone must meet the minimum energy code insulation R-value and depth requirements.

Envelope Assemblies

Assembly	Gross Area or Perimeter	Cavity R-Value	Cont. R-Value	Prop. U-Factor	Req. U-Factor	Prop. UA	Req. UA
Ceiling: Flat Ceiling or Scissor Truss	651	38.0	0.0	0.038	0.026	20	17
Wall: Wood Frame, 16" o.c.	696	21.0	0.0	0.057	0.060	31	32
Door: Glass Door (over 50% glazing)	42			0.300	0.300	13	13
Window: Vinyl Frame	114			0.300	0.300	34	34
Crawl Wall: Masonry Block w/ Empty Cells							
Wall height: 2.2'							
Depth below grade: 2.8'							
Insulation depth: 3.2'	283	0.0	19.0	0.045	0.055	10	12

Project Title: Morris Residence

Data filename:

Report date: 03/11/25

Page 1 of 10

Compliance Statement: The proposed building design described here is consistent with the building plans, specifications, and other calculations submitted with the permit application. The proposed building has been designed to meet the 2018 IECC requirements in REScheck Version - REScheck-Web and to comply with the mandatory requirements listed in the REScheck Inspection Checklist.

Name: _____ Title: _____ Signature: _____ Date: _____

Project Title: Morris Residence

Data filename:

Report date: 03/11/25

Page 2 of 10



Energy Code: 2018 IECC

Requirements: 0.0% were addressed directly in the REScheck software

Text in the 'Comments/Assumptions' column is provided by the user in the REScheck Requirements screen. For each requirement, the user certifies that a code requirement will be met and how that is documented, or that an exception is being claimed. Where compliance is itemized in a separate table, a reference to that table is provided.

Section # & Req.ID	Pre-Inspection/Plan Review	Plans Verified Value	Field Verified Value	Complies?	Comments/Assumptions
103.1.103.2 (PR1) Ⓜ	Construction drawings and documentation demonstrate energy code compliance for the building envelope. Thermal envelope represented on construction documents.			<input type="checkbox"/> Complies <input type="checkbox"/> Does Not <input type="checkbox"/> Not Observable <input type="checkbox"/> Not Applicable	
103.1.403.7 (PR2) Ⓜ	Construction drawings and documentation demonstrate energy code compliance for lighting and mechanical systems. Systems serving multiple dwelling units must demonstrate compliance with the IECC Commercial Provisions.			<input type="checkbox"/> Complies <input type="checkbox"/> Does Not <input type="checkbox"/> Not Observable <input type="checkbox"/> Not Applicable	
302.1.403.7 (PR2) Ⓜ	Heating and cooling equipment is sized per ACCA Manual 5 based on loads calculated per ACCA Manual 1 or other methods approved by the code official.	Heating: Btu/hy____ Cooling: Btu/hy____	Heating: Btu/hy____ Cooling: Btu/hy____	<input type="checkbox"/> Complies <input type="checkbox"/> Does Not <input type="checkbox"/> Not Observable <input type="checkbox"/> Not Applicable	

Additional Comments/Assumptions:

1 High Impact (Tier 1)

2 Medium Impact (Tier 2)

3 Low Impact (Tier 3)

Project Title: Morris Residence

Data filename:

Report date: 03/11/25

Page 3 of 10

Section # & Req.ID	Foundation Inspection	Plans Verified Value	Field Verified Value	Complies?	Comments/Assumptions
402.2.11 (FO1) Ⓜ	Unvented crawl space wall insulation R-value.	R:____ R:____	R:____ R:____	<input type="checkbox"/> Complies <input type="checkbox"/> Does Not <input type="checkbox"/> Not Observable <input type="checkbox"/> Not Applicable	See the Envelope Assemblies table for values.
303.2 (FO8) Ⓜ	Unvented crawl space wall insulation installed per manufacturer's instructions.			<input type="checkbox"/> Complies <input type="checkbox"/> Does Not <input type="checkbox"/> Not Observable <input type="checkbox"/> Not Applicable	
402.2.11 (FO2) Ⓜ	Unvented crawl space continuous vapor retarder installed over exposed earth, joints overlapped by 6 in. and sealed, extending at least 6 in. up and attached to the wall.			<input type="checkbox"/> Complies <input type="checkbox"/> Does Not <input type="checkbox"/> Not Observable <input type="checkbox"/> Not Applicable	
402.2.11 (FO10) Ⓜ	Unvented crawl space wall insulation depth of burial or distance from top of wall.	____ in. ____ in.	____ in. ____ in.	<input type="checkbox"/> Complies <input type="checkbox"/> Does Not <input type="checkbox"/> Not Observable <input type="checkbox"/> Not Applicable	See the Envelope Assemblies table for values.
303.2.1 (FO11) Ⓜ	A protective covering is installed to protect exposed exterior insulation and extends a minimum of 6 in. below grade.			<input type="checkbox"/> Complies <input type="checkbox"/> Does Not <input type="checkbox"/> Not Observable <input type="checkbox"/> Not Applicable	
403.9 (FO12) Ⓜ	Snow- and ice-melting system controls installed.			<input type="checkbox"/> Complies <input type="checkbox"/> Does Not <input type="checkbox"/> Not Observable <input type="checkbox"/> Not Applicable	

Additional Comments/Assumptions:

1 High Impact (Tier 1)

2 Medium Impact (Tier 2)

3 Low Impact (Tier 3)

Project Title: Morris Residence

Data filename:

Report date: 03/11/25

Page 4 of 10

Section # & Req.ID	Framing / Rough-In Inspection	Plans Verified Value	Field Verified Value	Complies?	Comments/Assumptions
402.1.1.402.2.1.402.3.1.402.3.2 (FR2) Ⓜ	Glazing U-factor (area-weighted average).	U:____	U:____	<input type="checkbox"/> Complies <input type="checkbox"/> Does Not <input type="checkbox"/> Not Observable <input type="checkbox"/> Not Applicable	See the Envelope Assemblies table for values.
303.1.1.1 (FR4) Ⓜ	U-factors of fenestration products are determined in accordance with the NFRC test procedure or taken from the default table.			<input type="checkbox"/> Complies <input type="checkbox"/> Does Not <input type="checkbox"/> Not Observable <input type="checkbox"/> Not Applicable	
402.4.1.1 (FR23) Ⓜ	Air barrier and thermal barrier installed per manufacturer's instructions.			<input type="checkbox"/> Complies <input type="checkbox"/> Does Not <input type="checkbox"/> Not Observable <input type="checkbox"/> Not Applicable	
402.4.3 (FR20) Ⓜ	Fenestration that is not site built is listed and labeled as meeting AAMA W08MCA 1015.5 2A440 or has infiltration rates per NFRC 400 that do not exceed code limits.			<input type="checkbox"/> Complies <input type="checkbox"/> Does Not <input type="checkbox"/> Not Observable <input type="checkbox"/> Not Applicable	
402.4.5 (FR16) Ⓜ	C-rated recessed lighting fixtures sealed at housing/interior finish and labeled to indicate <2.0 cm leakage at 75 Pa.			<input type="checkbox"/> Complies <input type="checkbox"/> Does Not <input type="checkbox"/> Not Observable <input type="checkbox"/> Not Applicable	
403.3.1 (PR12) Ⓜ	Supply and return ducts in attics installed >= R-8 where duct is >= 3 inches in diameter and >= R-6 where < 3 inches. Supply and return ducts in other portions of the building installed >= R-6 for diameter >= 3 inches and R-4.2 for < 3 inches in diameter.			<input type="checkbox"/> Complies <input type="checkbox"/> Does Not <input type="checkbox"/> Not Observable <input type="checkbox"/> Not Applicable	
403.3.2 (PR13) Ⓜ	Ducts, air handlers and filter boxes are sealed with gaskets/seals compliant with International Mechanical Code or International Residential Code, as applicable.			<input type="checkbox"/> Complies <input type="checkbox"/> Does Not <input type="checkbox"/> Not Observable <input type="checkbox"/> Not Applicable	
403.3.5 (PR15) Ⓜ	Building cavities are not used as ducts or plenums.			<input type="checkbox"/> Complies <input type="checkbox"/> Does Not <input type="checkbox"/> Not Observable <input type="checkbox"/> Not Applicable	
403.4 (FR17) Ⓜ	HVAC piping conveying fluids above 105 °F or chilled fluids below 55 °F are insulated to >R-3.	R:____	R:____	<input type="checkbox"/> Complies <input type="checkbox"/> Does Not <input type="checkbox"/> Not Observable <input type="checkbox"/> Not Applicable	
403.4.1 (FR24) Ⓜ	Protection of insulation on HVAC piping.			<input type="checkbox"/> Complies <input type="checkbox"/> Does Not <input type="checkbox"/> Not Observable <input type="checkbox"/> Not Applicable	
403.5.3 (FR18) Ⓜ	Hot water pipes are insulated to >R-3.	R:____	R:____	<input type="checkbox"/> Complies <input type="checkbox"/> Does Not <input type="checkbox"/> Not Observable <input type="checkbox"/> Not Applicable	
403.6 (FR19) Ⓜ	Automatic or gravity dampers are installed on all outdoor air intakes and exhausts.			<input type="checkbox"/> Complies <input type="checkbox"/> Does Not <input type="checkbox"/> Not Observable <input type="checkbox"/> Not Applicable	

1 High Impact (Tier 1)

2 Medium Impact (Tier 2)

3 Low Impact (Tier 3)

Project Title: Morris Residence

Data filename:

Report date: 03/11/25

Page 5 of 10

Additional Comments/Assumptions:

1 High Impact (Tier 1)

2 Medium Impact (Tier 2)

3 Low Impact (Tier 3)

Project Title: Morris Residence

Data filename:

Report date: 03/11/25

Page 6 of 10

Section # & Req.ID	Insulation Inspection	Plans Verified Value	Field Verified Value	Complies?	Comments/Assumptions
303.1 (IR13) Ⓜ	All installed insulation is labeled or the installed R-values provided.			<input type="checkbox"/> Complies <input type="checkbox"/> Does Not <input type="checkbox"/> Not Observable <input type="checkbox"/> Not Applicable	
402.1.1.402.2.5.402.2.6 (IR3) Ⓜ	Wall insulation R-value. If this is a mass wall with at least 1/2 of the wall insulation on the wall exterior, the exterior insulation requirement applies (R12).	R:____ <input type="checkbox"/> Wood <input type="checkbox"/> Mass <input type="checkbox"/> Steel	R:____ <input type="checkbox"/> Wood <input type="checkbox"/> Mass <input type="checkbox"/> Steel	<input type="checkbox"/> Complies <input type="checkbox"/> Does Not <input type="checkbox"/> Not Observable <input type="checkbox"/> Not Applicable	See the Envelope Assemblies table for values.
303.2 (IR4) Ⓜ	Wall insulation is installed per manufacturer's instructions.			<input type="checkbox"/> Complies <input type="checkbox"/> Does Not <input type="checkbox"/> Not Observable <input type="checkbox"/> Not Applicable	

Additional Comments/Assumptions:

1 High Impact (Tier 1)

2 Medium Impact (Tier 2)

3 Low Impact (Tier 3)

Project Title: Morris Residence

Data filename:

Report date: 03/11/25

Page 7 of 10

Section # & Req.ID	Final Inspection Provisions	Plans Verified Value	Field Verified Value	Complies?	Comments/Assumptions
402.1.1.402.2.1.402.2.2.402.2.6 (IR1) Ⓜ	Ceiling insulation R-value.	R:____ <input type="checkbox"/> Wood <input type="checkbox"/> Steel	R:____ <input type="checkbox"/> Wood <input type="checkbox"/> Steel	<input type="checkbox"/> Complies <input type="checkbox"/> Does Not <input type="checkbox"/> Not Observable <input type="checkbox"/> Not Applicable	See the Envelope Assemblies table for values.
303.1.1.303.2 (IR2) Ⓜ	Ceiling insulation installed per manufacturer's instructions. Blown insulation marked every 300 Rv.			<input type="checkbox"/> Complies <input type="checkbox"/> Does Not <input type="checkbox"/> Not Observable <input type="checkbox"/> Not Applicable	
402.2.3 (IR23) Ⓜ	Vented attics with air permeable insulation include baffle adjacent to soffit and eave vents that extends over insulation.			<input type="checkbox"/> Complies <input type="checkbox"/> Does Not <input type="checkbox"/> Not Observable <input type="checkbox"/> Not Applicable	
402.4.3 (FR20) Ⓜ	Attic access hatch and door insulation >R-value of the adjacent assembly.	R:____	R:____	<input type="checkbox"/> Complies <input type="checkbox"/> Does Not <input type="checkbox"/> Not Observable <input type="checkbox"/> Not Applicable	
402.4.1.2 (IR17) Ⓜ	Blower door test @ 50 Pa. <=5 aach in Climate Zones 2,3, and <=3 aach in Climate Zones 3,8.	ACH 50 =____	ACH 50 =____	<input type="checkbox"/> Complies <input type="checkbox"/> Does Not <input type="checkbox"/> Not Observable <input type="checkbox"/> Not Applicable	
403.3.3 (FR27) Ⓜ	Ducts are pressure tested to determine air leakage with either: Rough-in test: Total leakage measured with a pressure differential of 0.1 inch w.g. across the system including the manufacturer's air handler enclosure if installed at time of test. Postconstruction test: Total leakage measured with a pressure differential of 0.1 inch w.g. across the entire system including the manufacturer's air handler enclosure.	R:____	R:____	<input type="checkbox"/> Complies <input type="checkbox"/> Does Not <input type="checkbox"/> Not Observable <input type="checkbox"/> Not Applicable	
403.3.4 (FR4) Ⓜ	Duct tightness test result of <=4 cfm/100 ft2 across the system or <=3 cfm/100 ft2 without air handler @ 25 Pa. For rough-in tests, verification may need to occur during Framing Inspection.	R:____	R:____	<input type="checkbox"/> Complies <input type="checkbox"/> Does Not <input type="checkbox"/> Not Observable <input type="checkbox"/> Not Applicable	
403.3.2.1 (FR24) Ⓜ	Air handler leakage designated by manufacturer at <=2% of design air flow.			<input type="checkbox"/> Complies <input type="checkbox"/> Does Not <input type="checkbox"/> Not Observable <input type="checkbox"/> Not Applicable	
403.1.1 (FR9) Ⓜ	Programmable thermostats installed for control of primary heating and cooling systems and initially set by manufacturer to code specifications.			<input type="checkbox"/> Complies <input type="checkbox"/> Does Not <input type="checkbox"/> Not Observable <input type="checkbox"/> Not Applicable	
403.1.2 (FR10) Ⓜ	Heat pump thermostat installed on heat pumps.			<input type="checkbox"/> Complies <input type="checkbox"/> Does Not <input type="checkbox"/> Not Observable <input type="checkbox"/> Not Applicable	
403.5.1 (FR11) Ⓜ	Circulating service hot water systems have automatic or accessible manual controls.			<input type="checkbox"/> Complies <input type="checkbox"/> Does Not <input type="checkbox"/> Not Observable <input type="checkbox"/> Not Applicable	

1 High Impact (Tier 1)

2 Medium Impact (Tier 2)

3 Low Impact (Tier 3)

Project Title: Morris Residence

Data filename:

Report date: 03/11/25

Page 8 of 10

Section # & Req.ID	Final Inspection Provisions	Plans Verified Value	Field Verified Value	Complies?	Comments/Assumptions
402.6.1 (FR25) Ⓜ	All mechanical ventilation system fans not part of tested and listed HVAC equipment meet efficacy and air flow limits per Table H403.6.1.			<input type="checkbox"/> Complies <input type="checkbox"/> Does Not <input type="checkbox"/> Not Observable <input type="checkbox"/> Not Applicable	
403.2 (FR26) Ⓜ	Hot water boilers supplying heat through one or two pipe heating systems have outdoor setback controls to lower boiler water temperature based on outdoor temperature.			<input type="checkbox"/> Complies <input type="checkbox"/> Does Not <input type="checkbox"/> Not Observable <input type="checkbox"/> Not Applicable	
403.5.1.1 (FR28) Ⓜ	Heated water circulation systems have a circulation pump. The system return pipe is a dedicated return pipe or a cold water supply pipe. Gravity and thermosiphon circulation systems are not present. Controls for circulating hot water systems start the pump with signal for hot water demand within the occupancy. Controls automatically turn off the pump when water is in circulation loop is at set-point temperature and no demand for hot water exists.			<input type="checkbox"/> Complies <input type="checkbox"/> Does Not <input type="checkbox"/> Not Observable <input type="checkbox"/> Not Applicable	
403.5.1.2 (FR29) Ⓜ	Electric heat trace systems comply with IEEE 515.1 in UL 515. Controls automatically adjust the energy input to the heat tracing to maintain the desired water temperature in the piping.			<input type="checkbox"/> Complies <input type="checkbox"/> Does Not <input type="checkbox"/> Not Observable <input type="checkbox"/> Not Applicable	
403.5.2 (FR30) Ⓜ	Demand recirculation water systems have controls that manage operation of the pump and limit the temperature of the water entering the cold water piping to <= 104°F.			<input type="checkbox"/> Complies <input type="checkbox"/> Does Not <input type="checkbox"/> Not Observable <input type="checkbox"/> Not Applicable	
403.5.4 (FR31) Ⓜ	Drain water heat recovery units tested in accordance with CSA B55.1, Potable water side pressure loss of drain water heat recovery units < 3 psi for individual units connected to one or two showers. Potable water side pressure loss of drain water heat recovery units < 2 psi for individual units connected to three or more showers.			<input type="checkbox"/> Complies <input type="checkbox"/> Does Not <input type="checkbox"/> Not Observable <input type="checkbox"/> Not Applicable	
404.1 (FR6) Ⓜ	90% or more of permanent fixtures have high efficacy lamps.			<input type="checkbox"/> Complies <input type="checkbox"/> Does Not <input type="checkbox"/> Not Observable <input type="checkbox"/> Not Applicable	
404.1.1 (FR31) Ⓜ	Fuel gas lighting systems have no continuous pilot light.			<input type="checkbox"/> Complies <input type="checkbox"/> Does Not <input type="checkbox"/> Not Observable <input type="checkbox"/> Not Applicable	
403.3 (FR7) Ⓜ	Compliance certificate posted.			<input type="checkbox"/> Complies <input type="checkbox"/> Does Not <input type="checkbox"/> Not Observable <input type="checkbox"/> Not Applicable	

1 High Impact (Tier 1)

2 Medium Impact (Tier 2)

3 Low Impact (Tier 3)

Project Title: Morris Residence

Data filename:

Report date: 03/11/25

Page 9 of 10



PROJECT STATUS

ZONING VARIANCE

CURRENT ISSUE DATE

3.25.2025

PROJECT NO.

24038

REVISIONS

#	DESCRIPTION	DATE

PROJECT INFORMATION

Morris Residence

Jim & Amanda Morris

3590 Clotts Rd.
Gahanna, OH 43230



MATTHEW TODDY, LICENSE #1616697

EXPIRATION DATE: DECEMBER 31, 2025


ELEVATIONSTUDIO

SHEET NAME


RESCHECK REPORT

SHEET NUMBER

G003

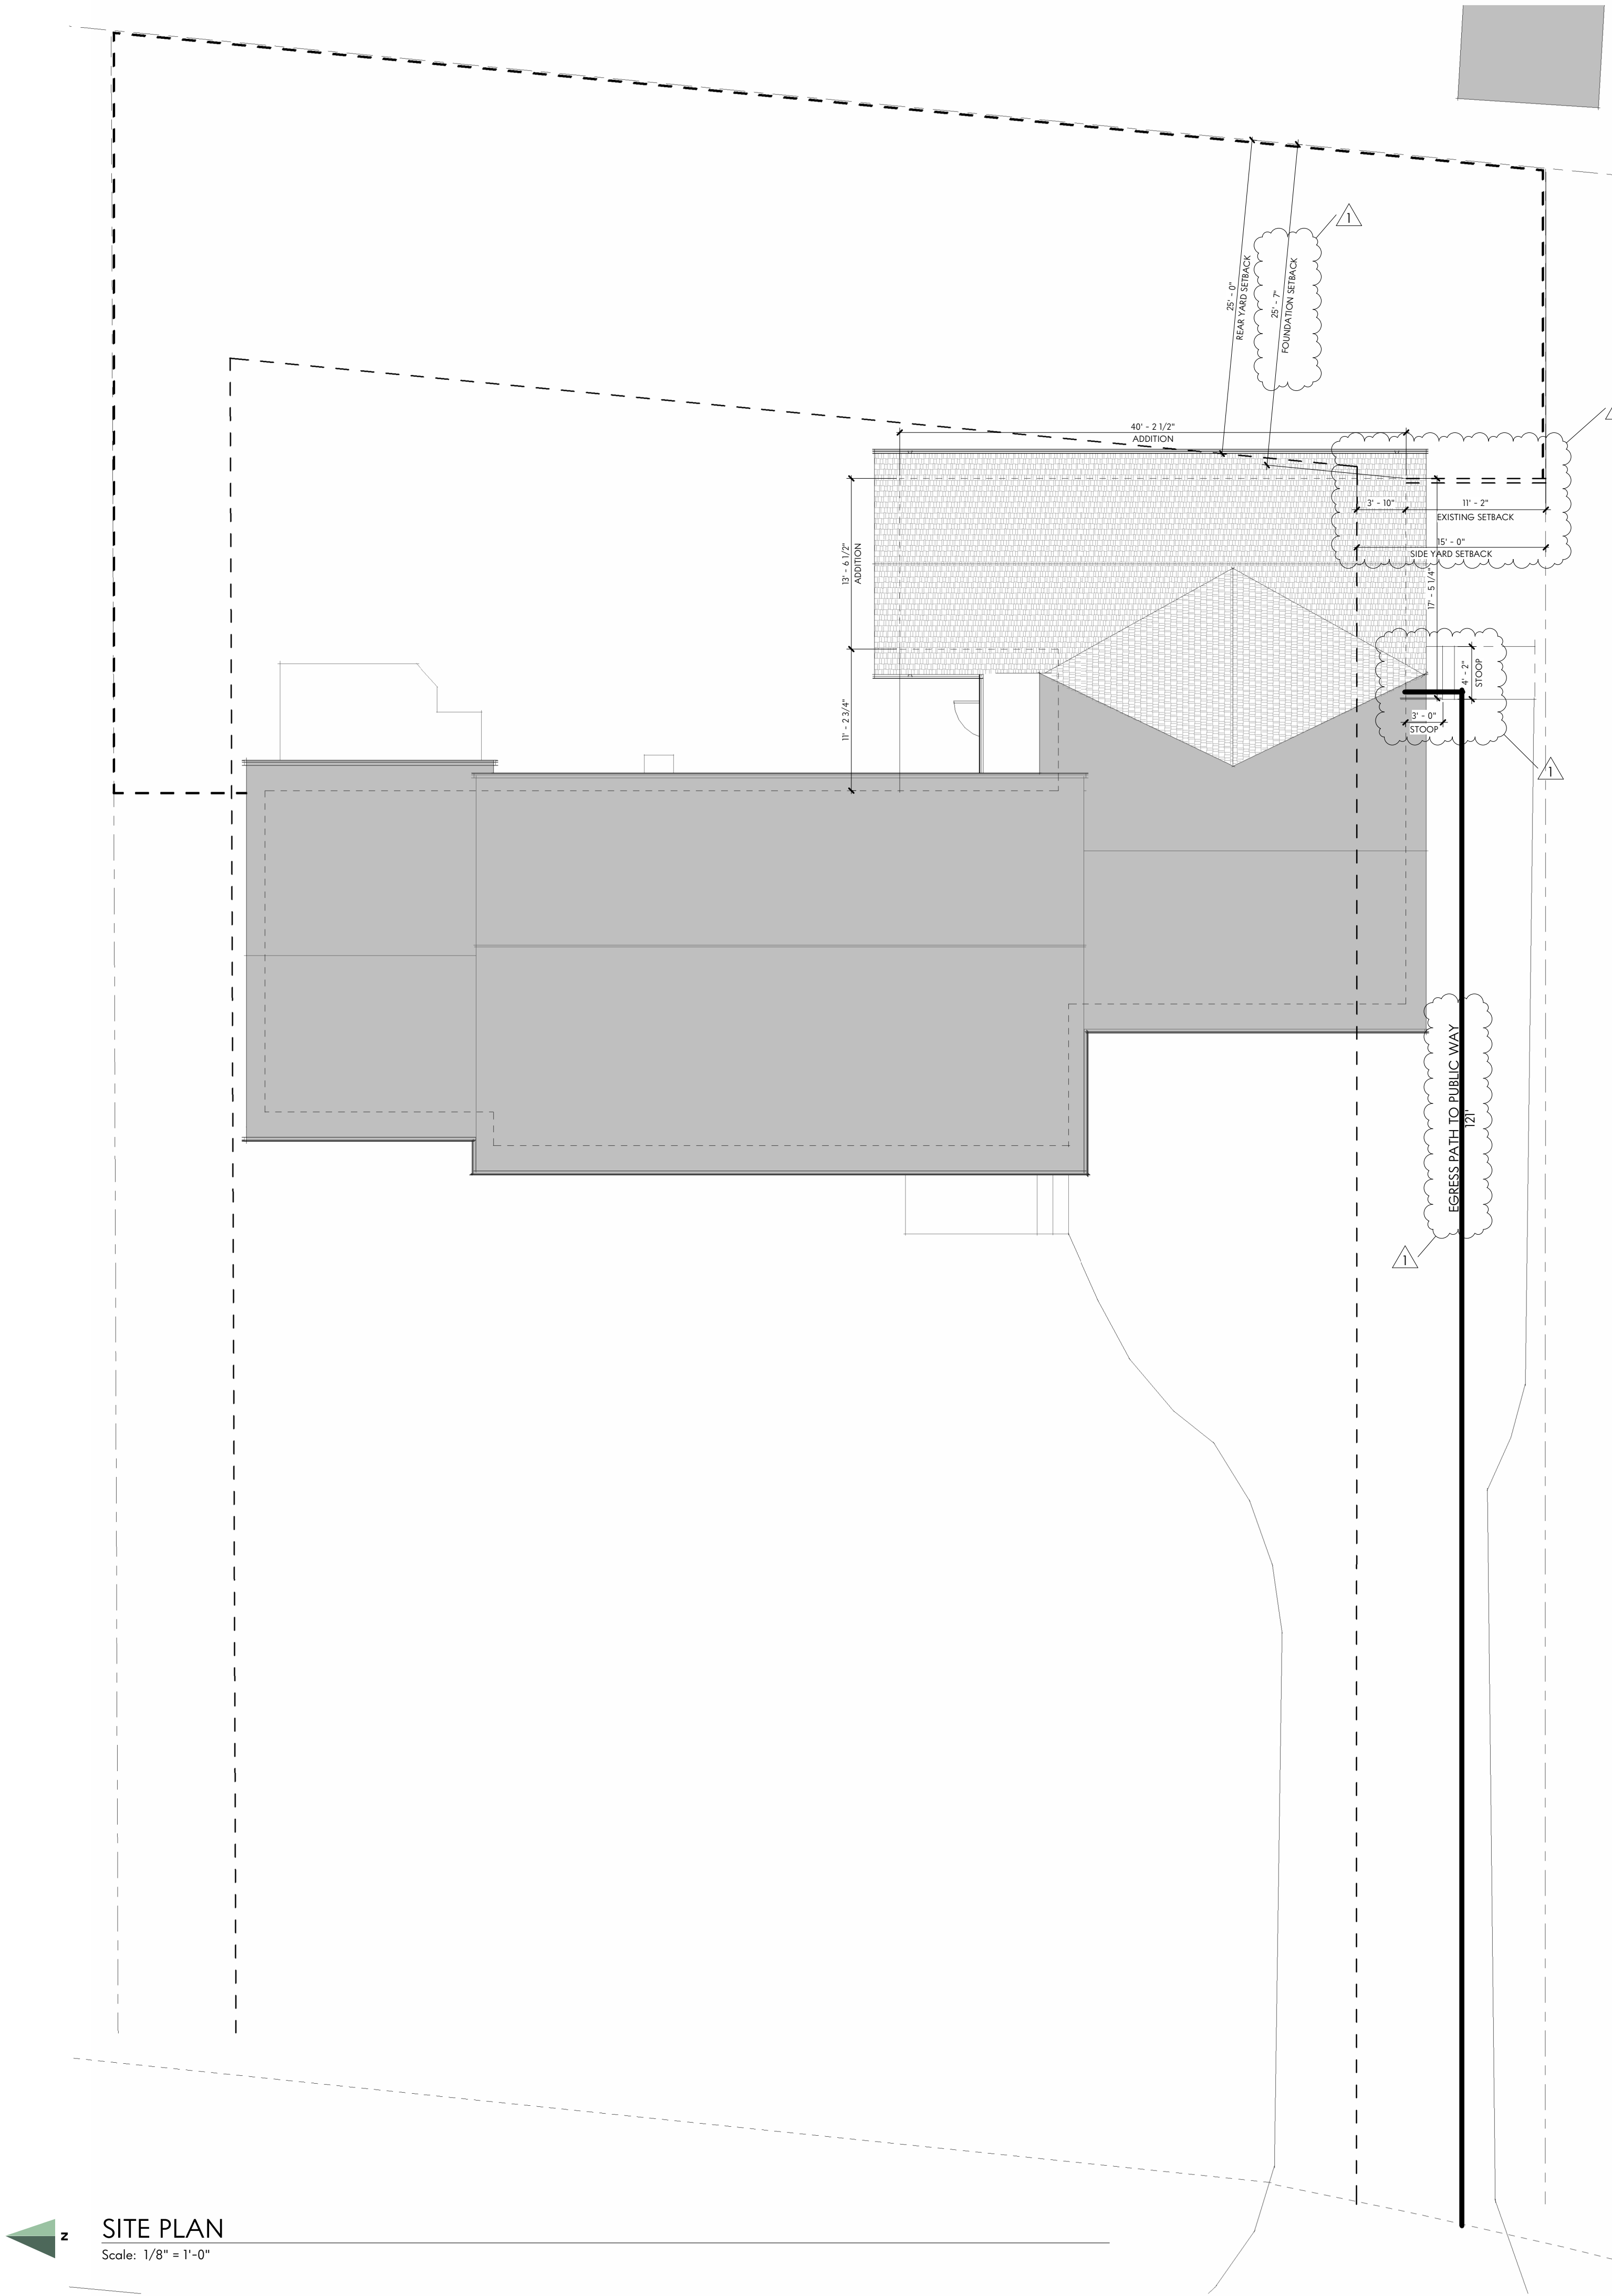

SITE PLAN
Scale: 1/8" = 1'-0"

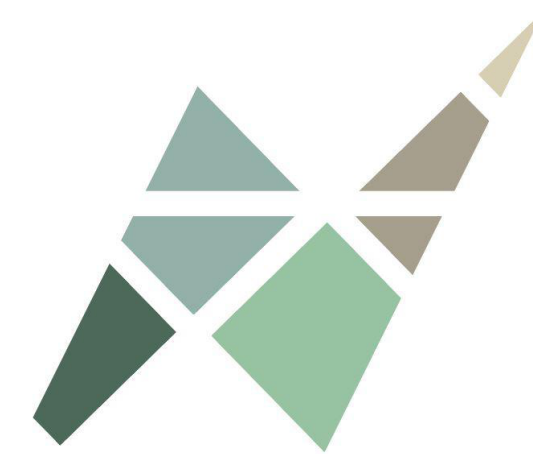

PROJECT STATUS

ZONING VARIANCE

CURRENT ISSUE DATE

3.25.2025

PROJECT NO.

24038

REVISIONS

#	DESCRIPTION	DATE
1	Revision 1	3.11.2025
2	Revision 2	3.25.2025

PROJECT INFORMATION

Morris Residence
Jim & Amanda Morris
3590 Clotts Rd.
Gahanna, OH 43230



MATTHEW TODDY, LICENSE #1616697
EXPIRATION DATE: DECEMBER 31, 2025



SHEET NAME



**ARCHITECTURAL
SITE PLAN**

SHEET NUMBER

A100

GENERAL NOTES - SITE PLAN

- A. DO NOT SCALE DRAWINGS. IF DIMENSIONS ARE IN QUESTION, THE CONTRACTOR SHALL BE RESPONSIBLE FOR SEEKING CLARIFICATION FROM ARCHITECT PRIOR TO CONSTRUCTION.
- B. ALL DIMENSIONS ARE FROM FINISHED SURFACE TO FINISHED SURFACE, UNLESS NOTED OTHERWISE.
- C. ARCHITECTURAL SITE PLAN IS PROVIDED TO SHOW THE RELATIONSHIP OF THE ARCHITECTURAL ELEMENTS AND TO PROVIDE PLAN AND DETAIL KEY REFERENCE ONLY.

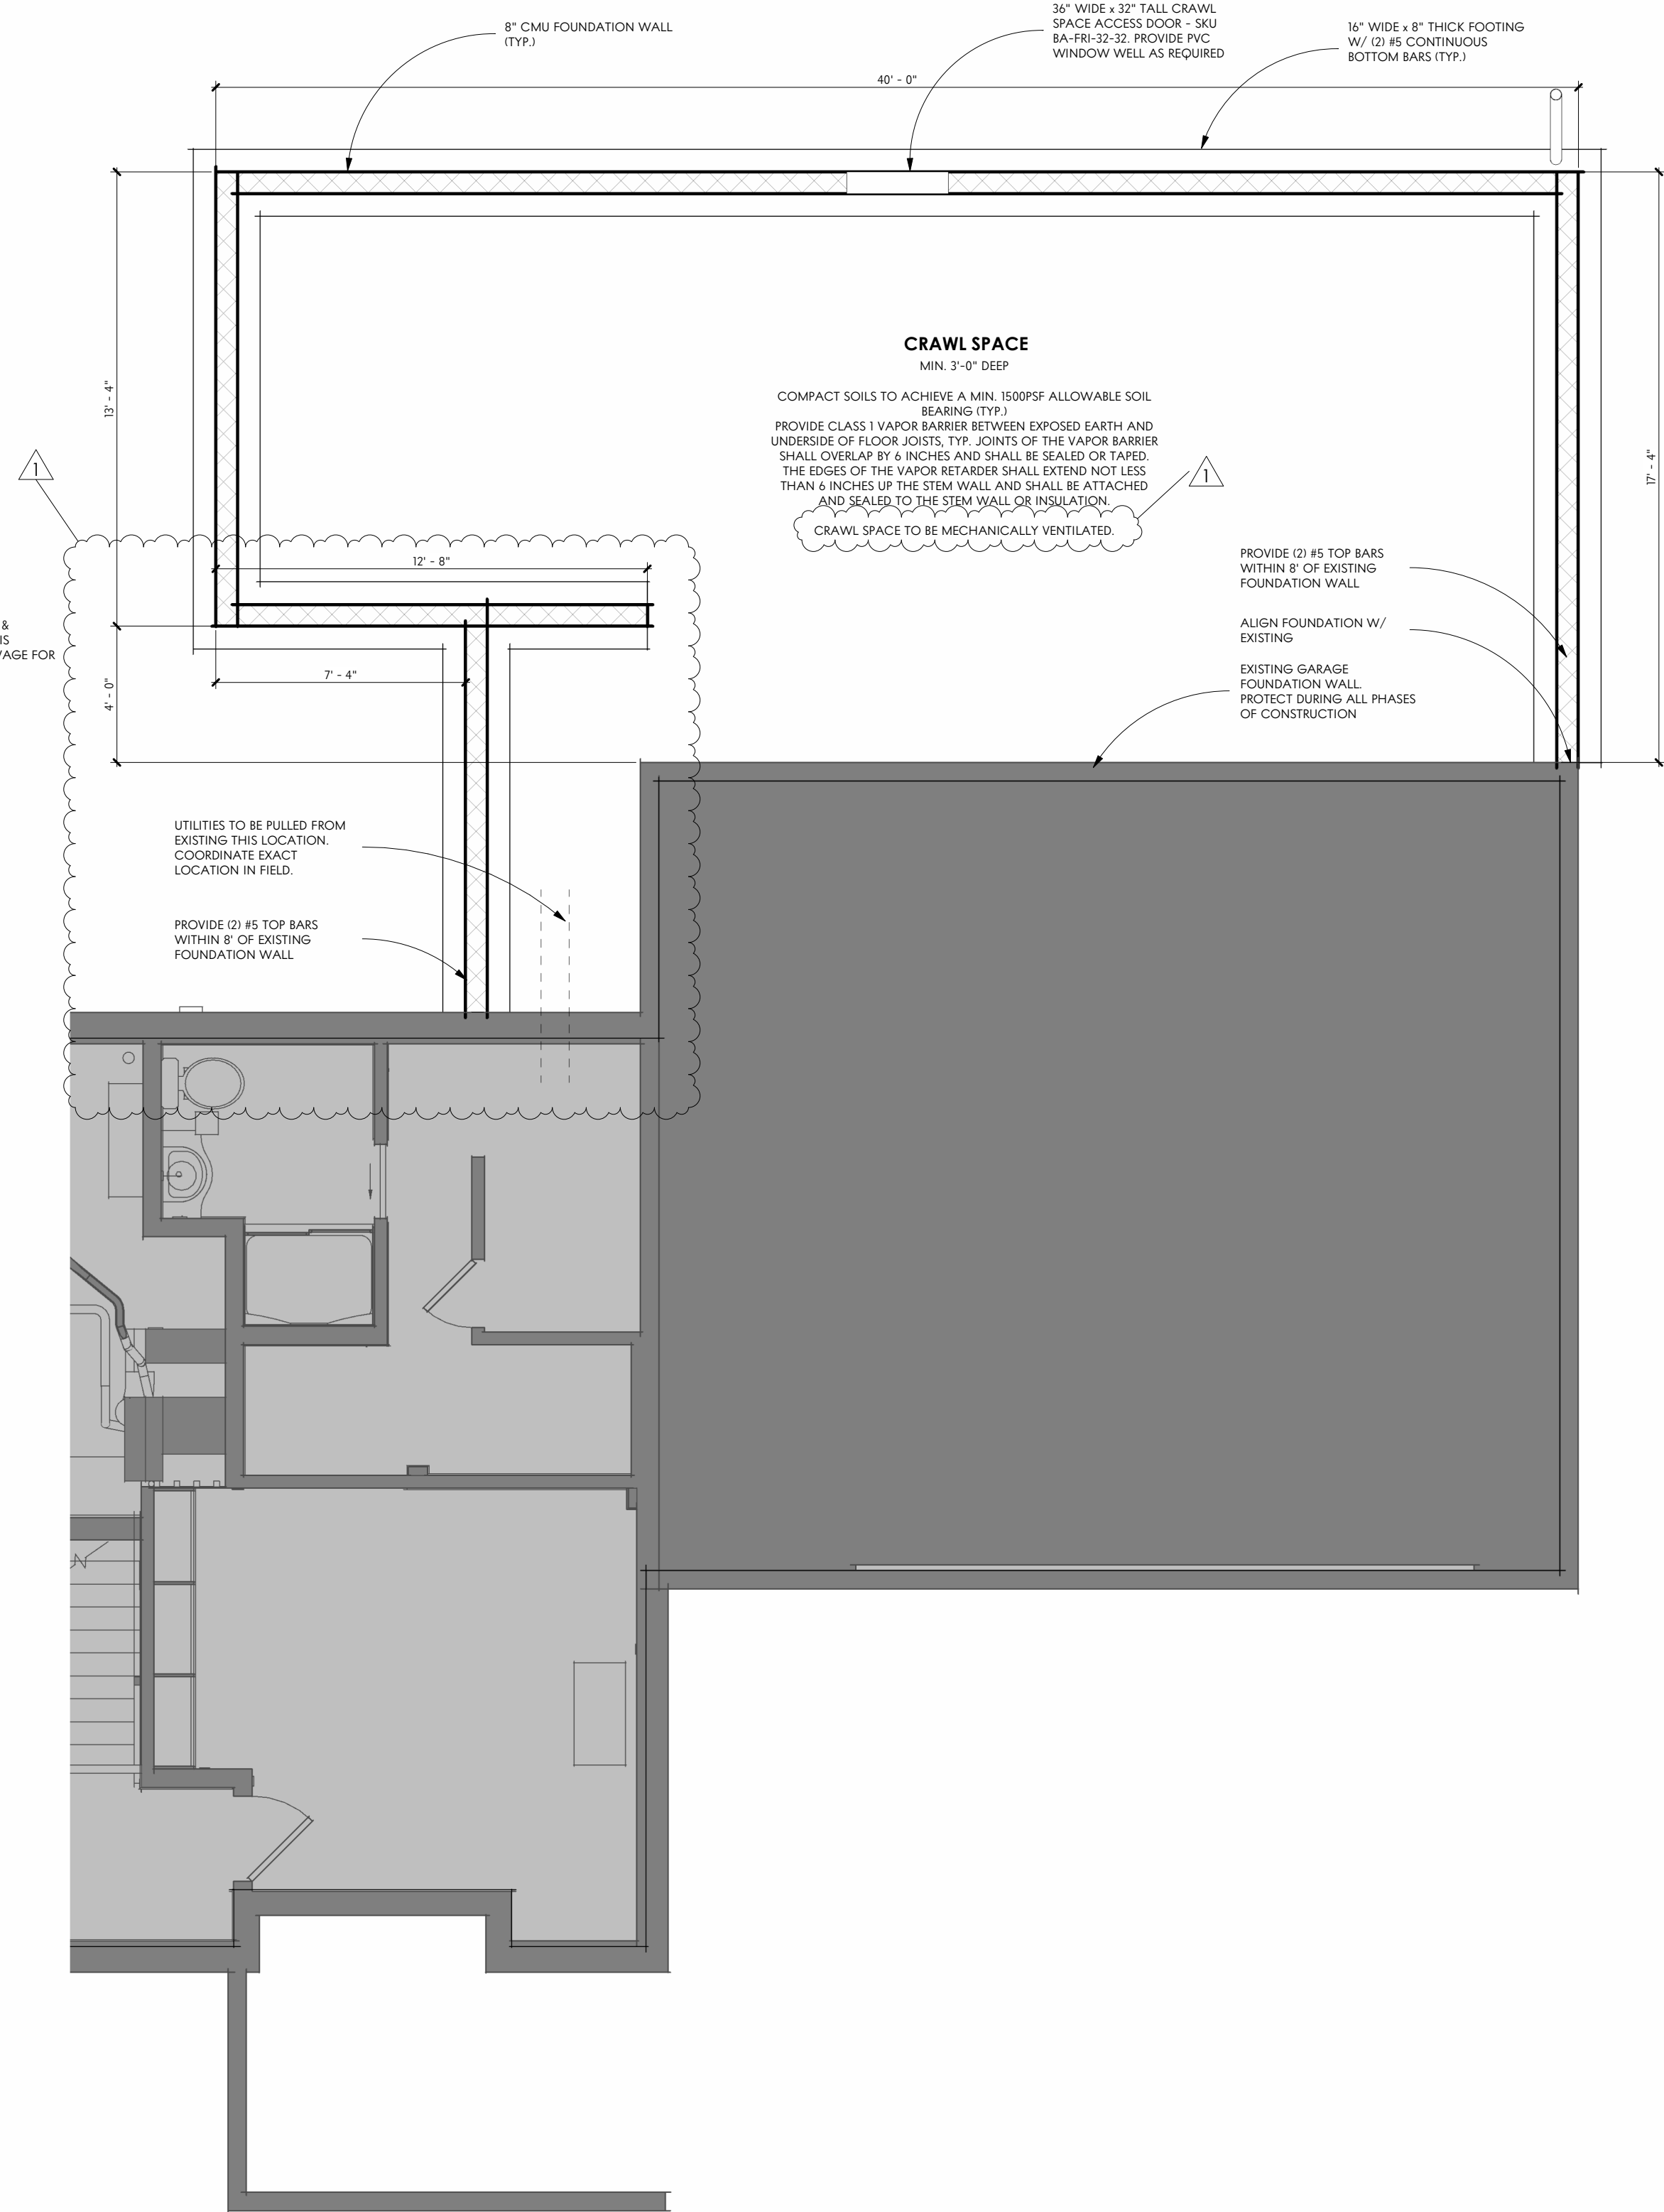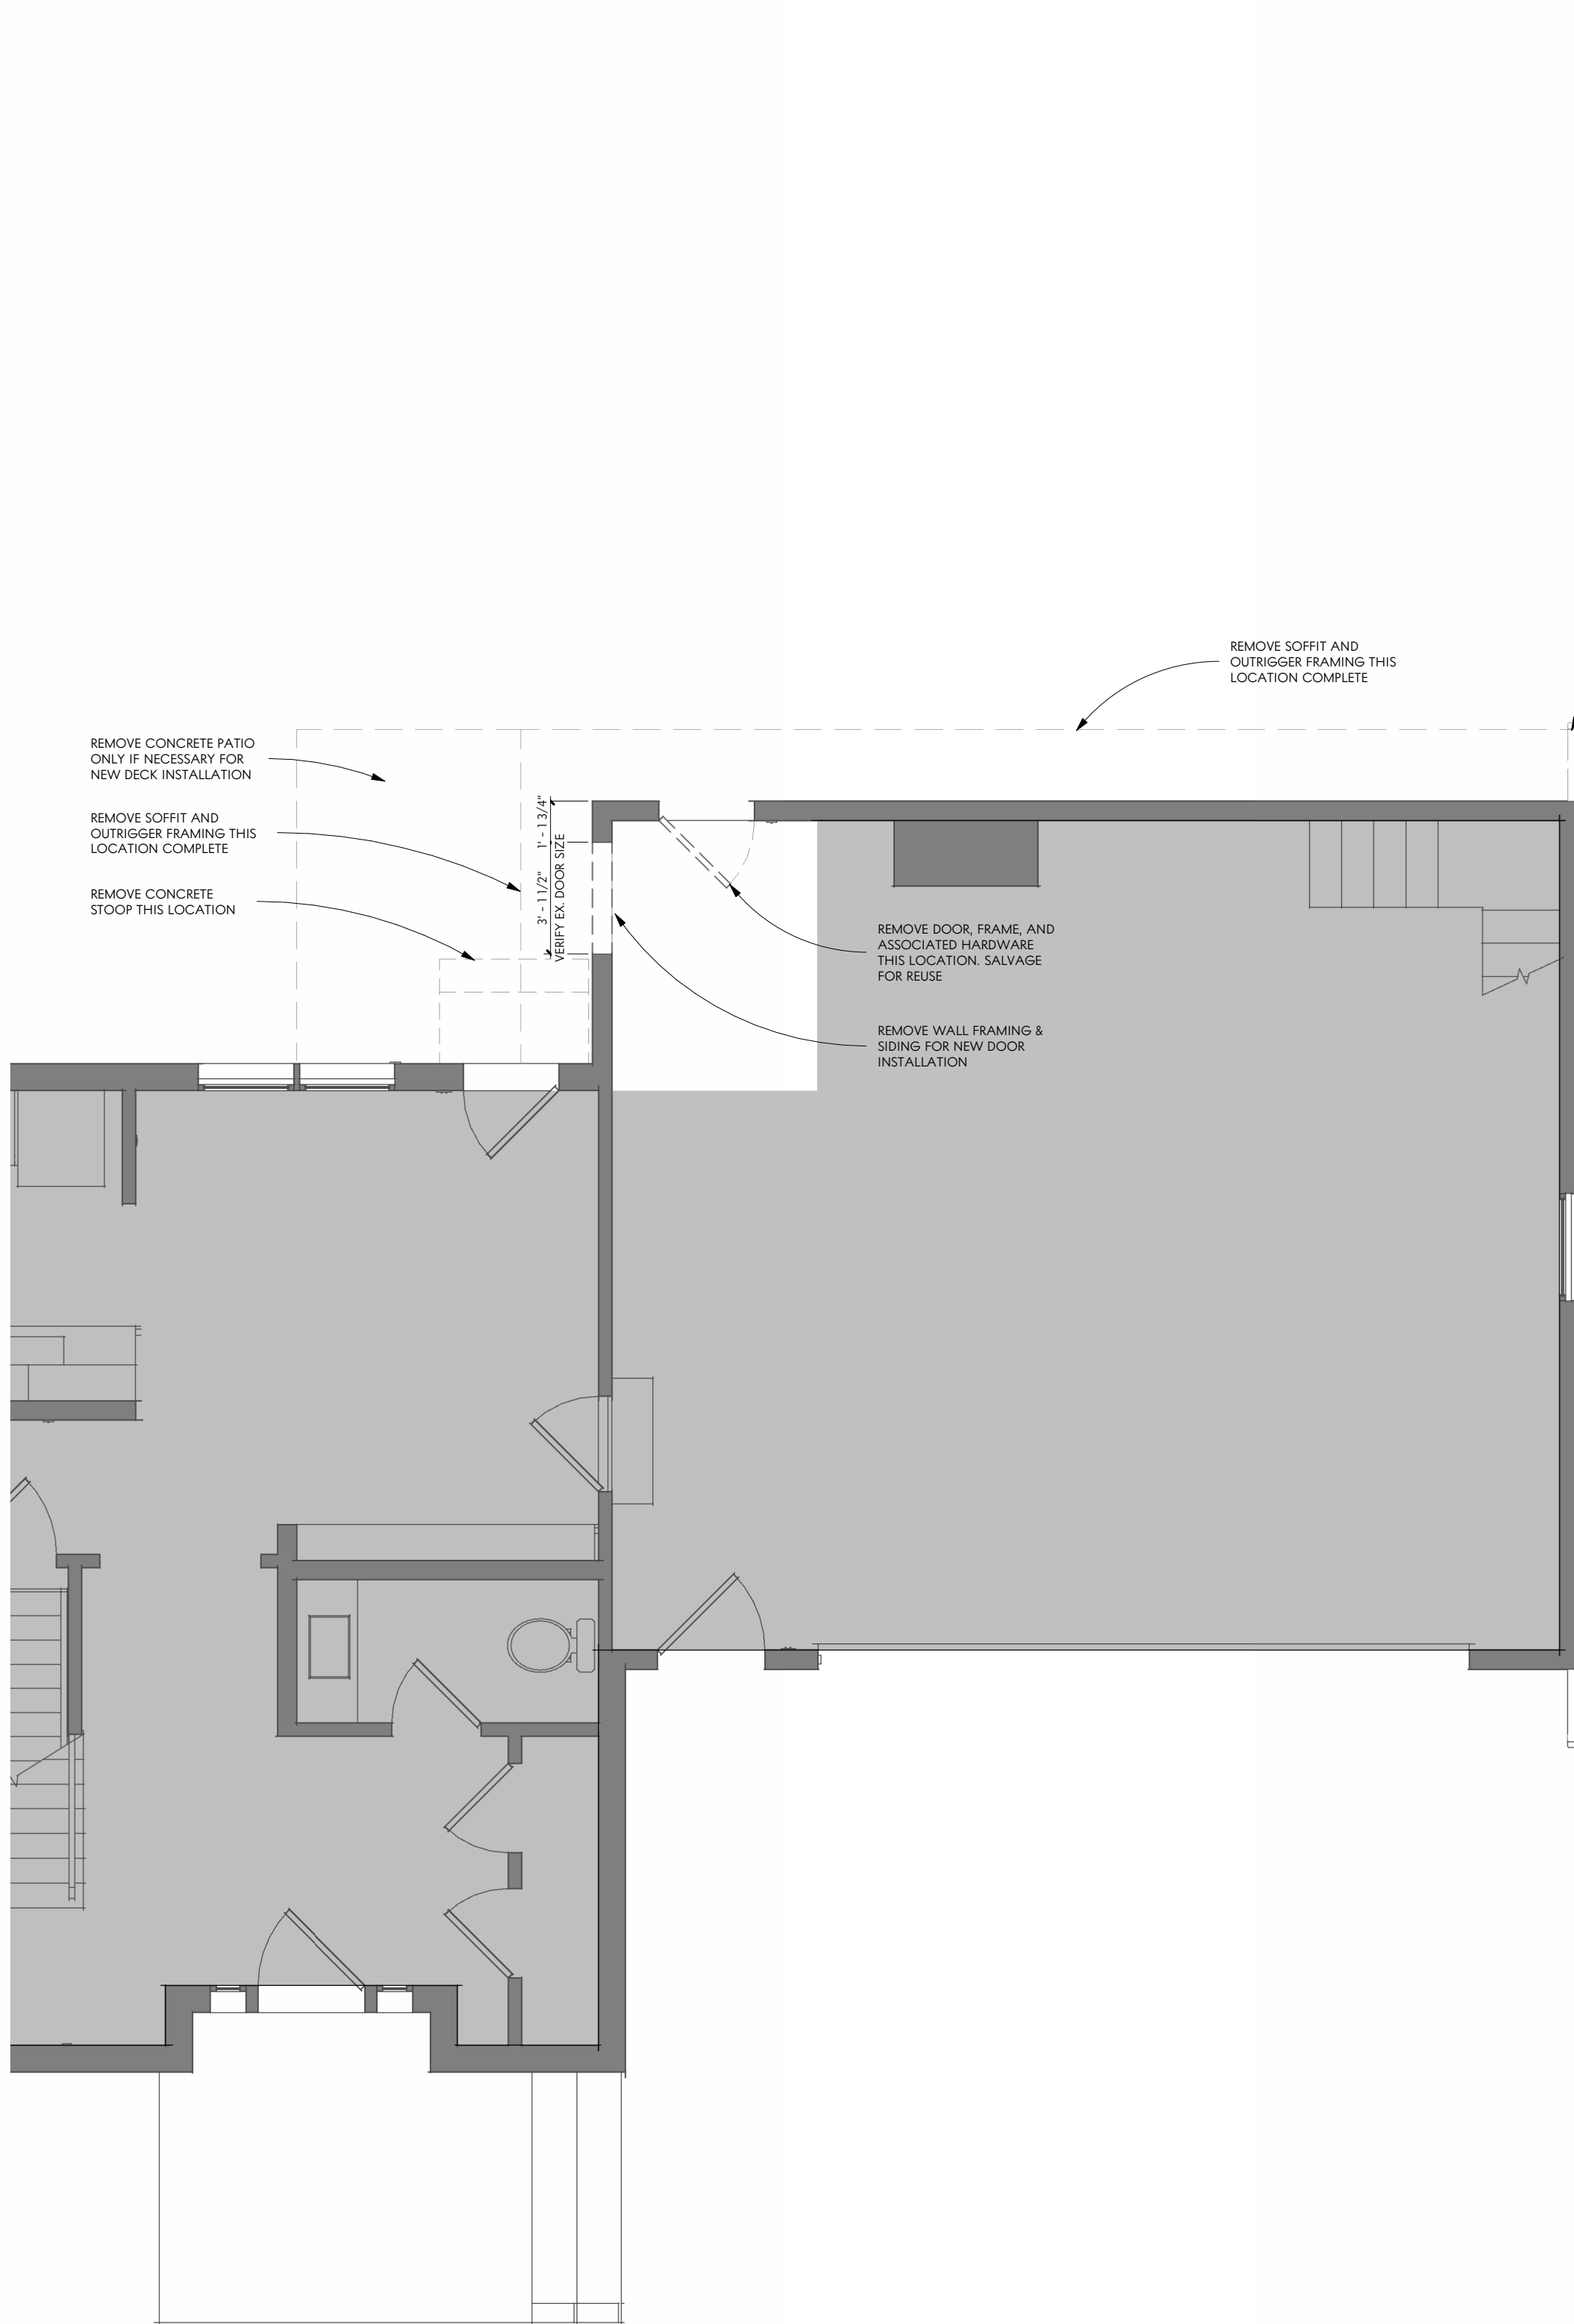

LEGEND - DEMOLITION PLAN

- INDICATES EXISTING WALL OR ELEMENT TO REMAIN.
- INDICATES EXISTING WALL OR ELEMENT TO BE REMOVED.

GENERAL NOTES - DEMOLITION PLAN

- ALL ITEMS NOTED AS REMOVED OR DEMOLISHED BECOME THE PROPERTY OF THE CONTRACTOR, AND ARE TO BE DISPOSED OF IN A MANNER COMPLYING WITH ALL LOCAL, STATE, AND FEDERAL REGULATIONS.
- NOTIFY ARCHITECT OF ALL EXISTING CONSTRUCTION NOT SPECIFICALLY NOTED ON THE DRAWINGS AND REMOVE OR RETAIN THOSE ITEMS ONLY AS DIRECTED BY THE ARCHITECT.
- CONTRACTOR IS SOLELY RESPONSIBLE FOR ALL TEMPORARY BRACING AND SHORING OF EXISTING STRUCTURE AND ALL CONSTRUCTION DURING DEMOLITION AND NEW CONSTRUCTION.
- REMOVE DAMAGED CORNER BEADS AND ANY BEADS AT EXISTING CORNERS WHERE NEW WALLS ALIGN WITH EXISTING TRIM.
- REMOVE PROMPTLY FROM THE PREMISES ALL PRODUCTS OF DEMOLITION NOT DESIGNATED FOR REUSE. NO DEBRIS SHALL BE ALLOWED TO ACCUMULATE. TAKE APPROPRIATE MEASURES TO CONTROL DUST.
- PIPES, CONDUIT AND DUCTWORK ENCOUNTERED IN DEMOLISHED PARTITIONS AND CEILINGS WHICH ARE TO REMAIN WILL BE RE-ROUTED AND CONCEALED. THOSE WHICH ARE TO BE ABANDONED SHALL BE CAPPED AND COMPLETELY CONCEALED IN THE FLOOR, WALL, OR CEILING.
- GENERAL CONTRACTOR IS TO INSTALL FLOOR-TO-CEILING 6MIL POLYETHYLENE BARRIER BETWEEN OCCUPIED AREAS AND RENOVATED AREAS. MAINTAIN EXISTING WALLS AS TEMPORARY PROTECTIVE BARRIERS UNTIL PHASING REQUIRES DEMOLITION OF EXISTING PARTITIONS. PROTECT DOORS, MOLDINGS, AND WALLS WITH NON-STAINING PAPER.
- THE CONTRACTOR IS TO PROMPTLY REPAIR ALL DAMAGE CAUSED TO ADJACENT AREAS BY DEMOLITION AT NO ADDITIONAL EXPENSE TO THE TENANT/ OWNER WITH MATCHING MATERIAL, FINISH, AND COLOR.
- THE CONTRACTOR IS RESPONSIBLE FOR MOVING ANY FURNITURE WHICH MAY BE NECESSARY FOR DEMOLITION OR NEW CONSTRUCTION.
- ALL WORK CAUSING EXCESSIVE NOISE OR REQUIRING SHUTDOWN OF ANY SERVICES, UTILITIES, OR RISERS SERVING OCCUPIED AREAS OF THE BUILDING SHALL BE CARRIED OUT ONLY BY ARRANGEMENT WITH THE TENANT/ OWNER/ BUILDING MANAGEMENT.
- ALL AREAS WHERE DEMOLITION CAUSES UNEVENNESS OR VOIDS IN THE FLOOR ARE TO BE PATCHED TO LEVEL WITH R-DEX OR EQUAL MATERIAL.
- REMOVE ALL RESIDUAL CARPET, PADDING, TACK STRIPS, OR ADHESIVE FROM THE AREAS DESIGNATED.
- REMOVE EXISTING CEILING TILE AS INDICATED ON REFLECTIVE CEILING PLANS. EXISTING BLACK IRON MAY BE REUSED AT CONTRACTOR'S OPTION AND ARCHITECT'S APPROVAL.



PROJECT STATUS

ZONING VARIANCE

CURRENT ISSUE DATE

3.25.2025

PROJECT NO.

24038

REVISIONS

#	DESCRIPTION	DATE
1	Revision 1	3.11.2025

PROJECT INFORMATION

Morris Residence

Jim & Amanda Morris

3590 Clotts Rd.
Gahanna, OH 43230



MATTHEW TODDY, LICENSE #1616697
EXPIRATION DATE: DECEMBER 31, 2025


ELEVATION
STUDIO

SHEET NAME


DEMOLITION &
FOUNDATION
PLANS

A101

A102

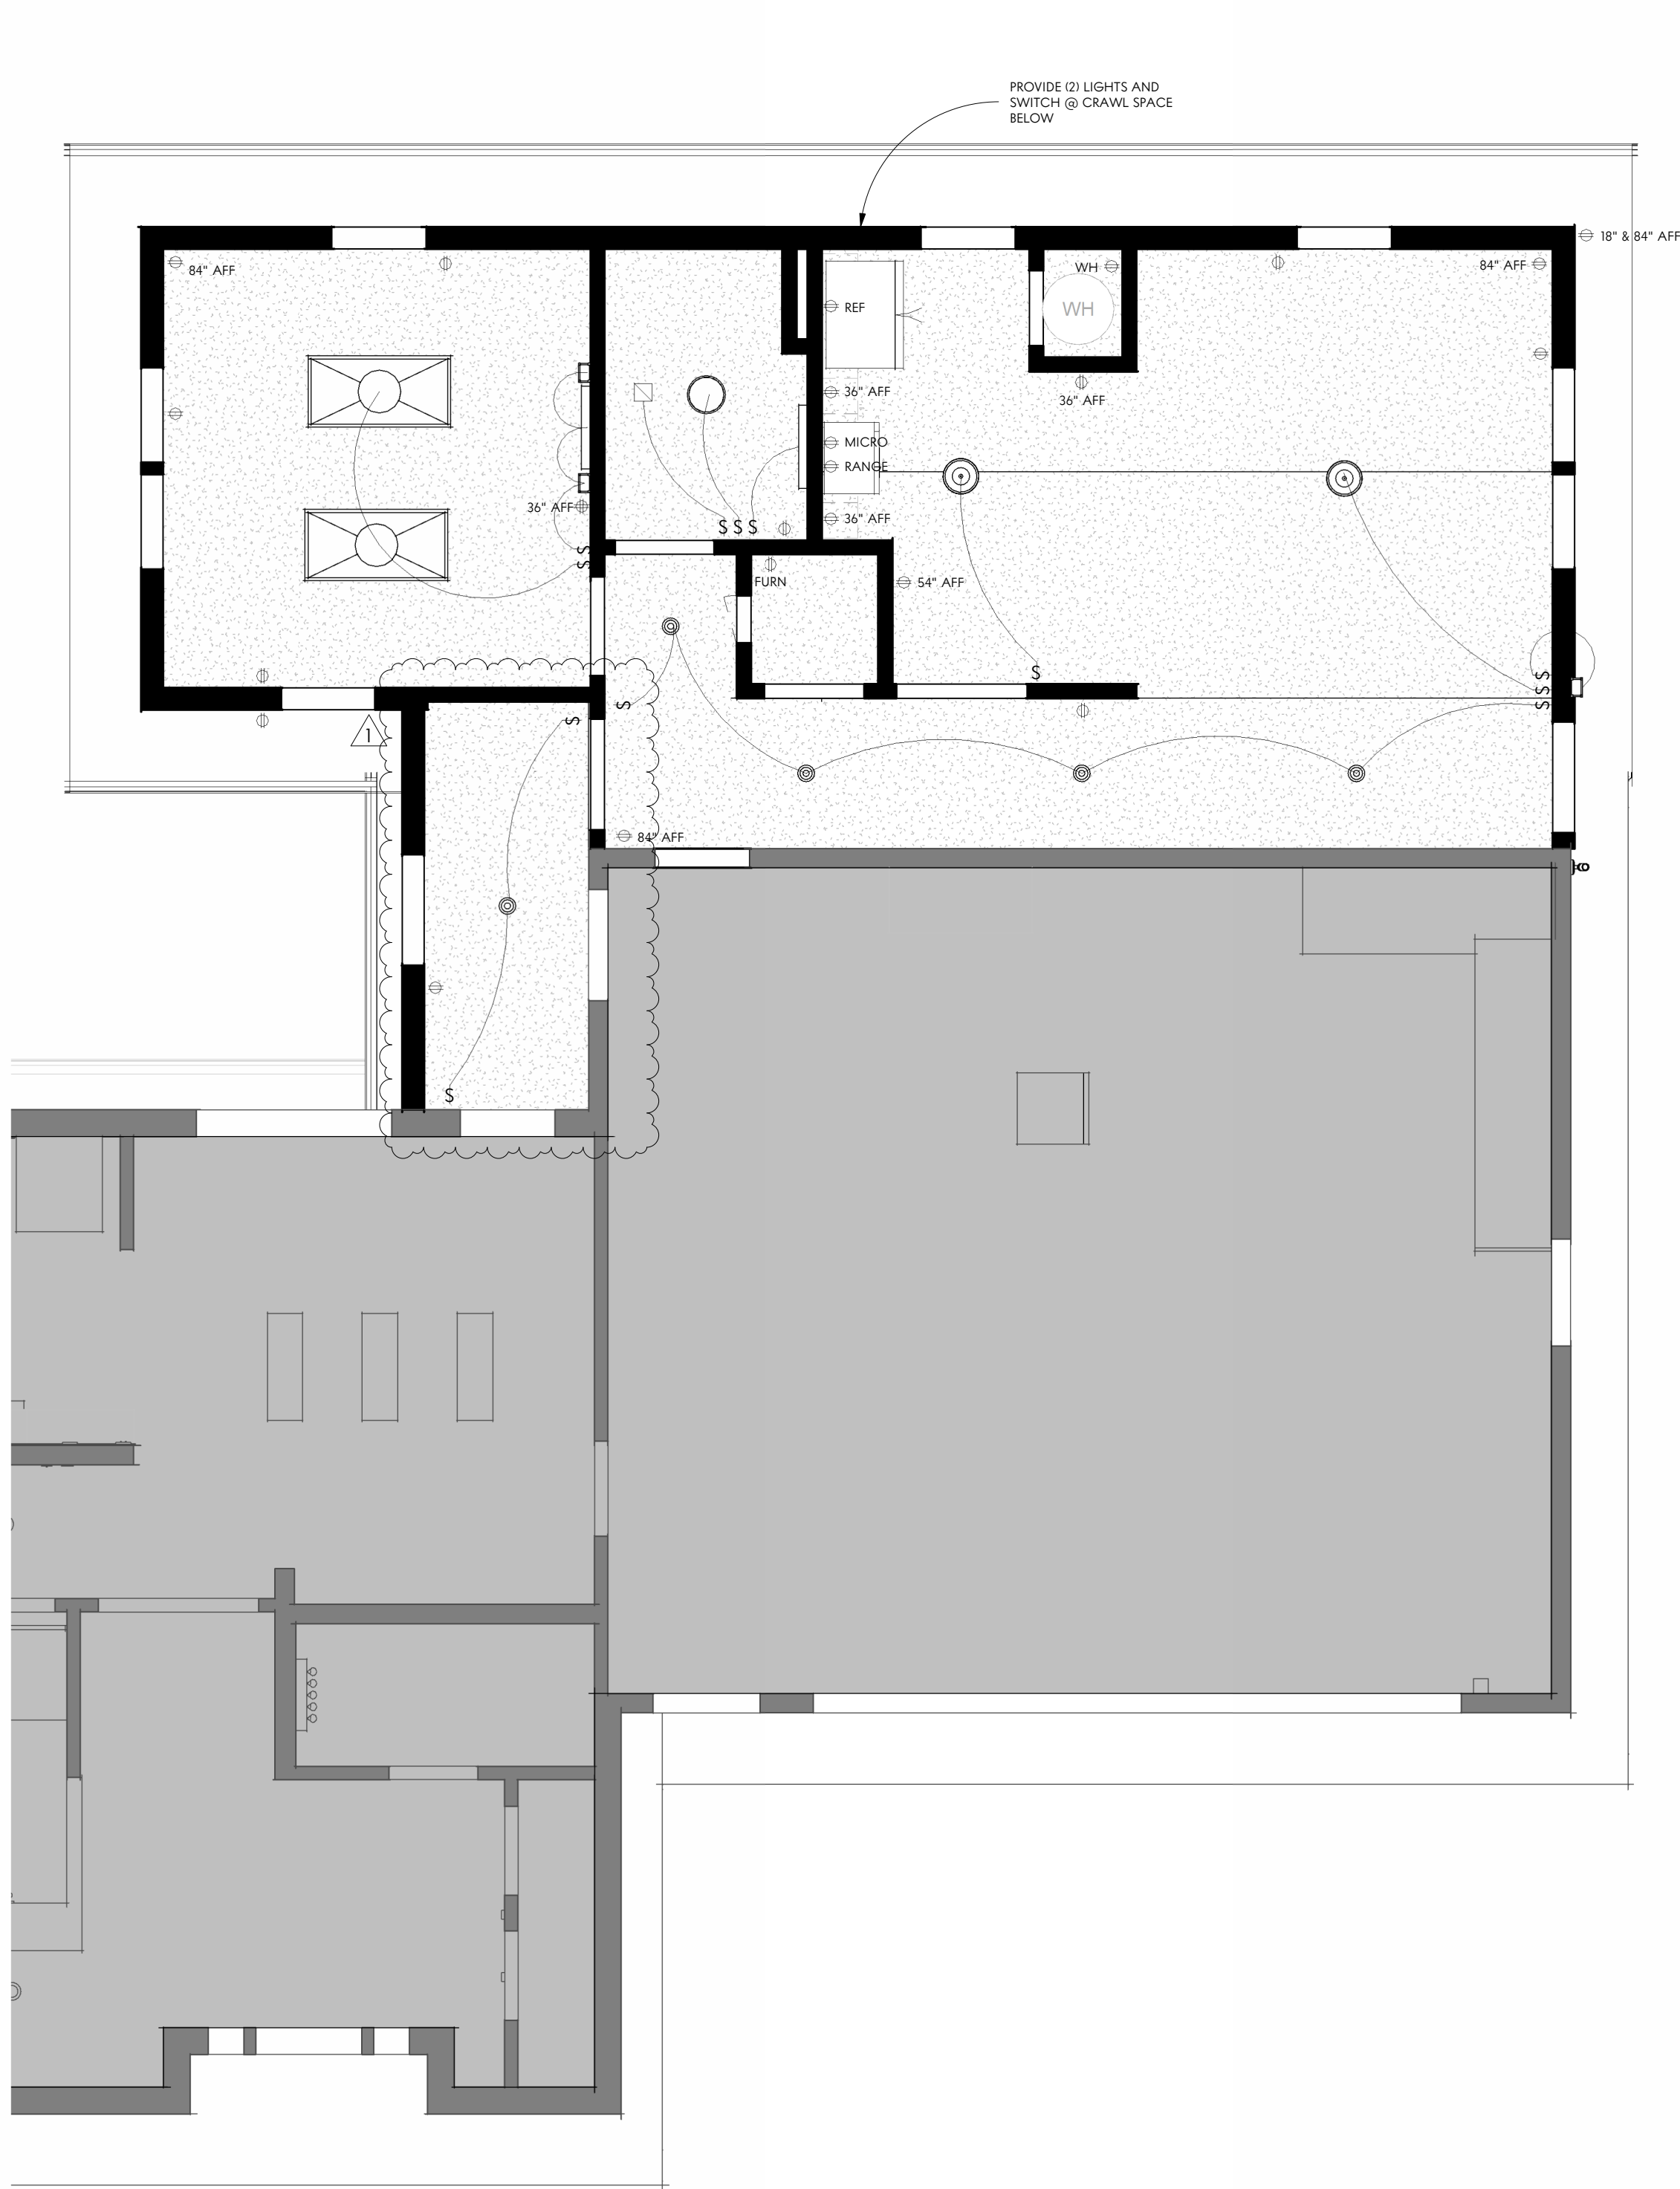

ELECTRICAL PLAN
Scale: 1/4" = 1'-0"

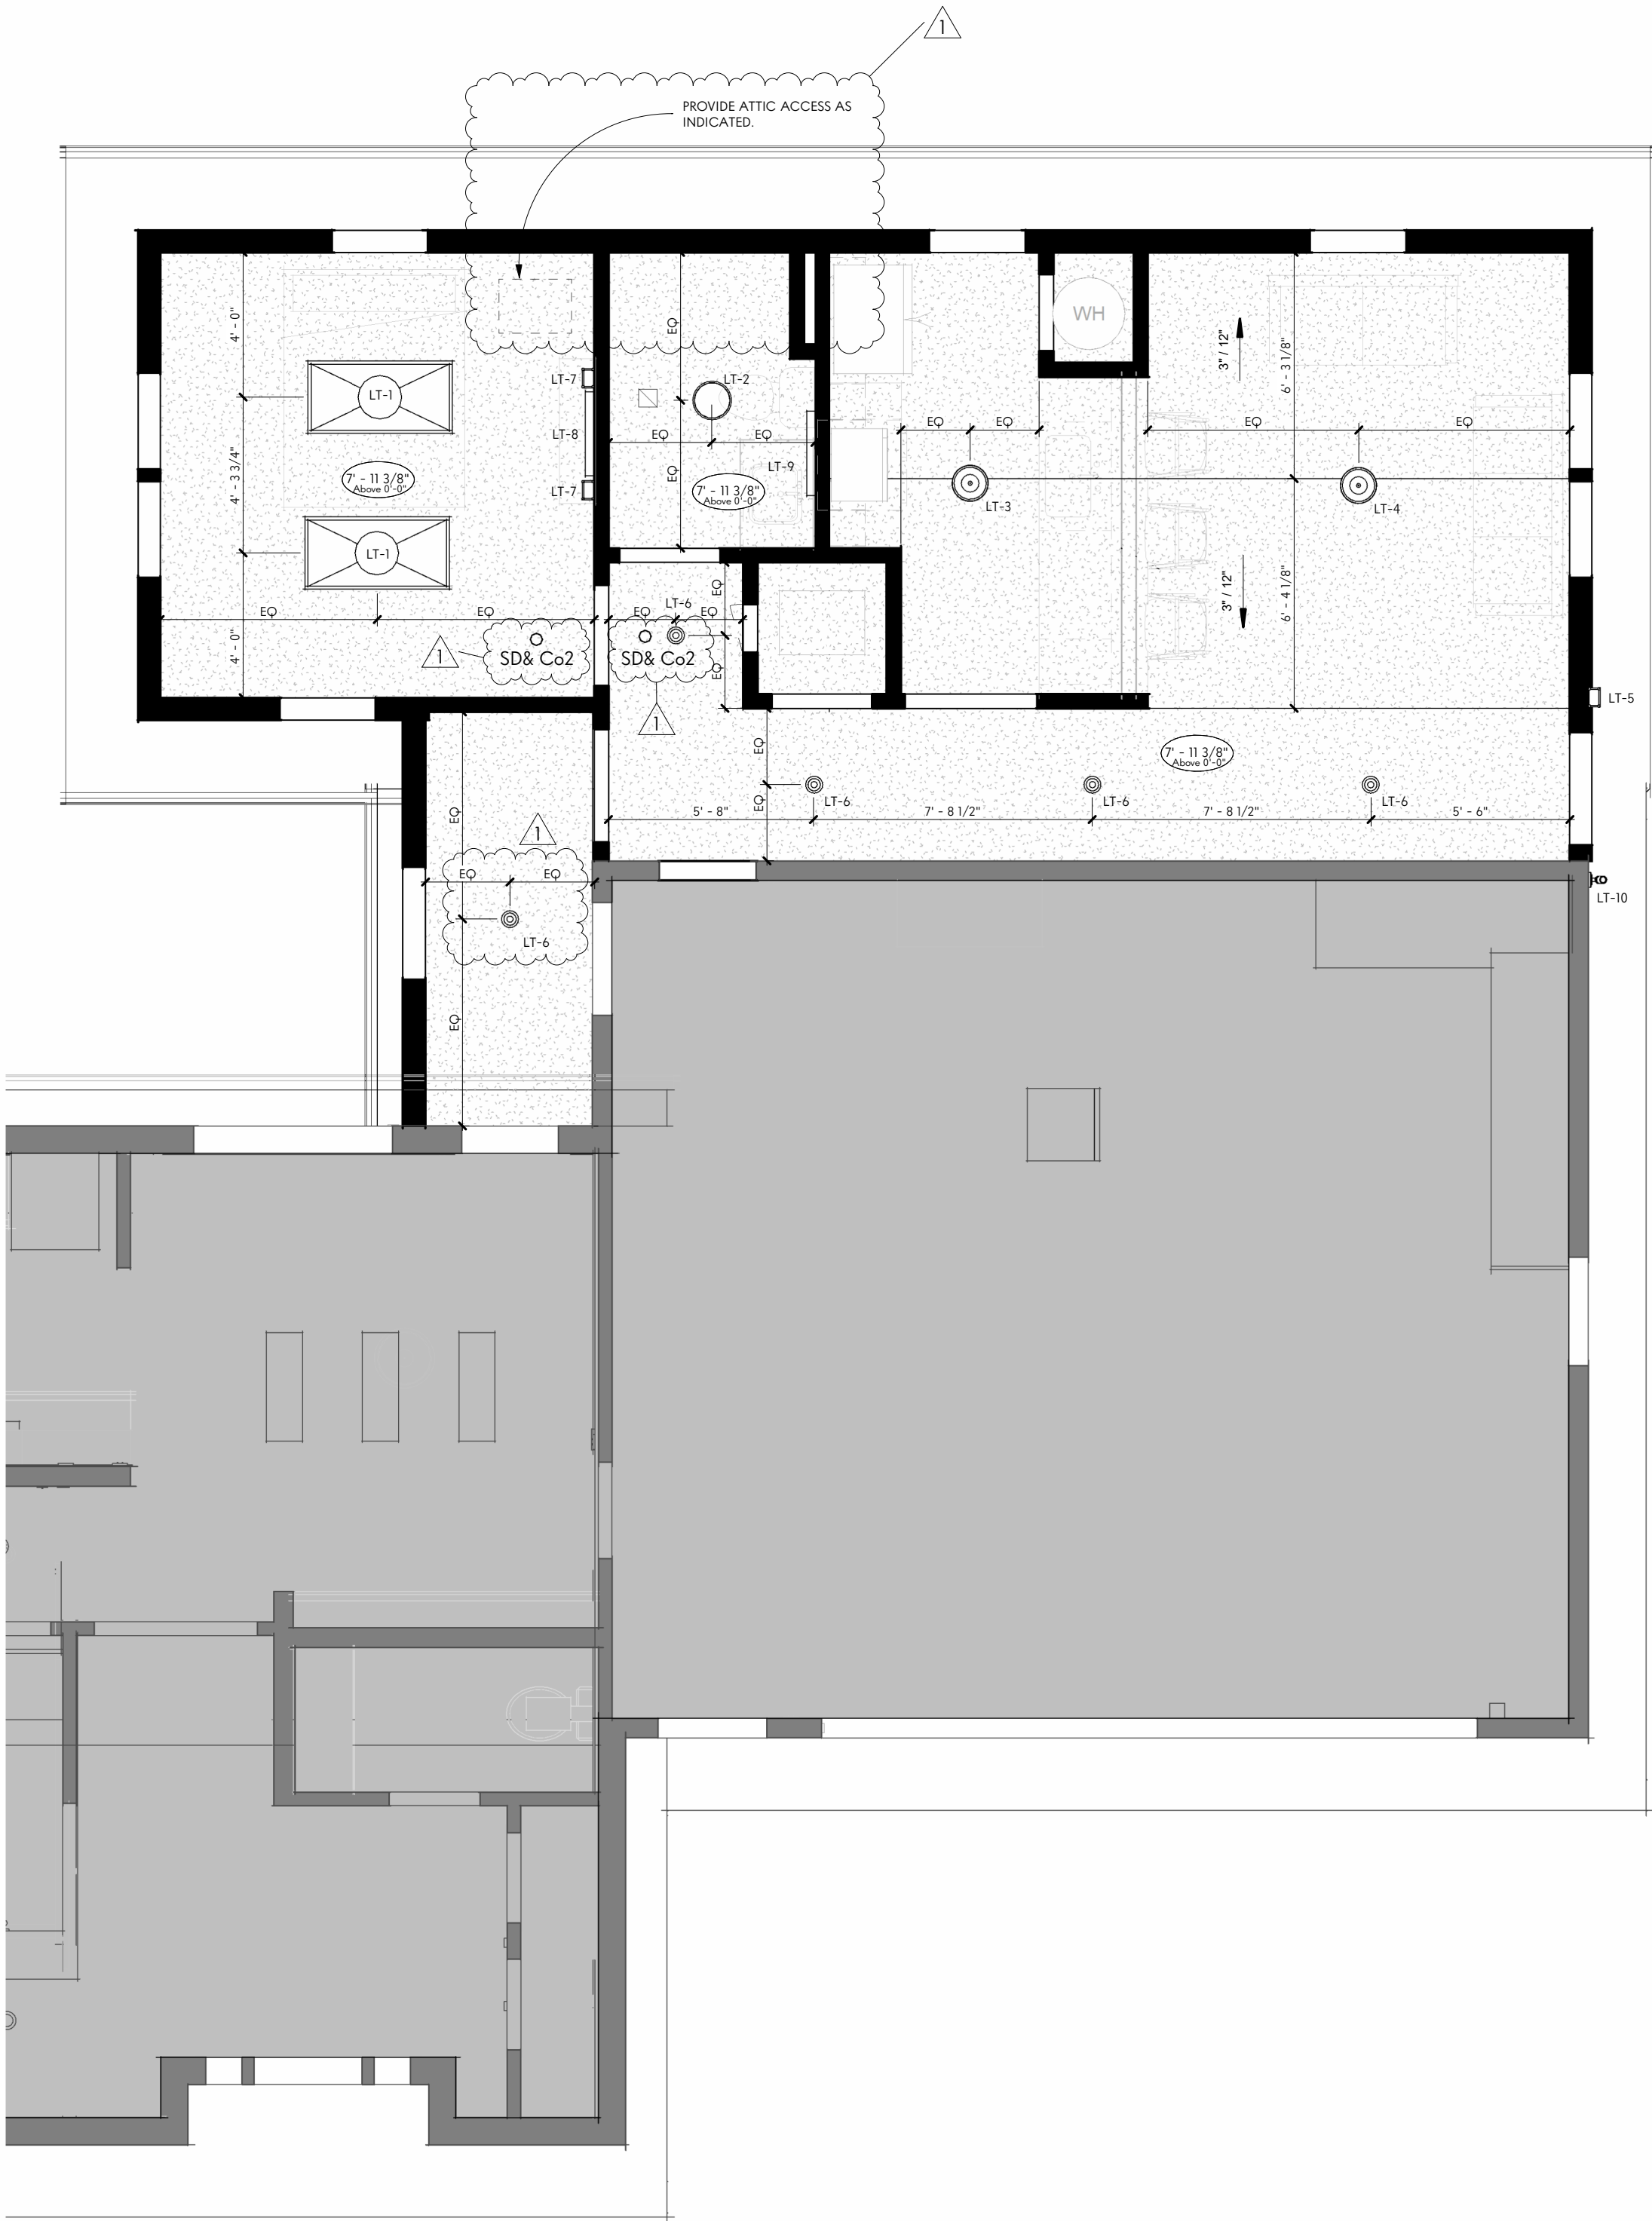

REFLECTED CEILING PLAN
Scale: 1/4" = 1'-0"

CEILING LEGEND

PAINTED 5/8" GYPSUM BOARD CEILING

LIGHT FIXTURE SCHEDULE

TYPE	DESCRIPTION	MANUFACTURE R	MODEL	TYPE	MOUNTING HEIGHT
LT-1	2x4 LED FLAT PANEL	BY GC	BY GC	LED	
LT-2	CEILING LIGHT	BY GC	BY GC	LED	
LT-3	PENDANT	BY OWNER	BY OWNER	LED	R.O. FIXTURE 7'-6" AFF
LT-4	PENDANT	BY OWNER	BY OWNER	LED	R.O. FIXTURE 7'-6" AFF
LT-5	EXTERIOR SCENCE	BY OWNER	BY OWNER	LED	REFER TO ELEVATIONS
LT-6	RECESSED CAN	BY GC	BY GC	LED	
LT-7	WALL SCENCE	BY OWNER	BY OWNER	LED	COORDINATE WITH OWNER IN FIELD
LT-8	WALL SCENCE	BY OWNER	BY OWNER	LED	COORDINATE WITH OWNER IN FIELD
LT-9	WALL SCENCE	BY OWNER	BY OWNER	LED	COORDINATE WITH OWNER IN FIELD
LT-10	FLOOD LIGHT	BY OWNER	BY OWNER	LED	

GENERAL NOTES - REFLECTED CEILING PLAN

- A. DO NOT SCALE DRAWINGS. IF DIMENSIONS ARE IN QUESTION, THE CONTRACTOR IS RESPONSIBLE FOR SEEKING CLARIFICATION FROM ARCHITECT PRIOR TO CONSTRUCTION.
- B. ALL DIMENSIONS ARE FROM FINISHED SURFACE TO FINISHED SURFACE, UNLESS NOTED OTHERWISE.
- C. ARCHITECTURAL REFLECTED CEILING PLANS ARE FOR THE PURPOSE OF INDICATING THE DESIGN INTENT ONLY. INDICATED LOCATION OF HVAC DIFFUSERS, RETURN AIR GRILLES, LIGHT FIXTURES, ETC., ARE SHOWN ONLY FOR COORDINATION OF THESE ITEMS WITH THE ARCHITECTURAL DESIGN ELEMENTS. REFER TO ENGINEER'S DRAWINGS FOR SPECIFICATIONS AND EXACT LOCATIONS OF THESE ITEMS. IF DISCREPANCIES BETWEEN THE ENGINEERING DRAWINGS AND ARCHITECTURAL DRAWINGS ARE DISCOVERED, CONTRACTOR SHALL NOTIFY ARCHITECT FOR CLARIFICATION PRIOR TO INSTALLING WORK IN QUESTION.
- D. CEILING GRID LAYOUT IS TO BE CENTERED BOTH WAYS IN ROOMS OR SPACES UNLESS NOTED OTHERWISE.
- E. HVAC DIFFUSERS AND RETURN AIR GRILLES ARE TO BE CENTERED BETWEEN LIGHT FIXTURES UNLESS NOTED OTHERWISE.
- F. THE CONTRACTOR SHALL PROVIDE ACCESS PANELS, WHERE EQUIPMENT REQUIRING ACCESS IS LOCATED ABOVE FINISHED, NON-ACCESSIBLE CEILINGS. MATCH ACCESS PANEL TO ADJACENT FINISH. COORDINATE SPECIFIC ACCESS PANEL DETAILS WITH ARCHITECT.
- G. DO NOT INSTALL LIGHT FIXTURES LENSES OR REMOVE PROTECTIVE PLASTIC FILM UNTIL CARPET HAS BEEN INSTALLED AND VACUUMED.
- H. INSTALL ACOUSTICAL CEILING PANELS WITH GRAIN/TEXTURE RUNNING IN THE SAME DIRECTION UNLESS INDICATED OTHERWISE.
- I. IF ACOUSTICAL CEILING PANELS HAVE BEEN SPECIFIED, CONTRACTOR SHALL INCLUDE AN ALLOWANCE TO PROVIDE OWNER WITH A FIVE PERCENT ATTIC STOCK OF EACH PANEL TYPE USED ON THE PROJECT, IN UNOPENED CARTONS FOR MAINTENANCE AND REPLACEMENT USE. VERIFY ACTUAL QUANTITY WITH OWNER PRIOR TO ORDER.
- J. GYPSUM BOARD CEILINGS AND SOFFITS AS INDICATED ON THESE DRAWINGS ARE TO BE ATTACHED OR SUSPENDED ACCORDING TO CONSTRUCTION PROCEDURES DESCRIBED IN LATEST EDITION OF *THE GYPSUM CONSTRUCTION HANDBOOK* BY USG, PUBLISHED BY WILEY.
- K. ALL CEILING MOUNTED ITEMS SHALL BE INSTALLED PER MANUFACTURES INSTRUCTIONS. CONTRACTOR SHALL IDENTIFY AND PROVIDE ALL REQUIRED BLOCKING FOR THEIR PROPER ATTACHMENT.



PROJECT STATUS

ZONING VARIANCE

CURRENT ISSUE DATE

3.25.2025

PROJECT NO.

24038

REVISIONS

#	DESCRIPTION	DATE
1	Revision 1	3.11.2025

PROJECT INFORMATION

Morris Residence

Jim & Amanda Morris

3590 Clotts Rd.
Gahanna, OH 43230



MATTHEW TODDY, LICENSE #1616697
EXPIRATION DATE: DECEMBER 31, 2025


ELEVATION STUDIO

SHEET NAME


ELECTRICAL & CEILING PLANS

SHEET NUMBER


A104

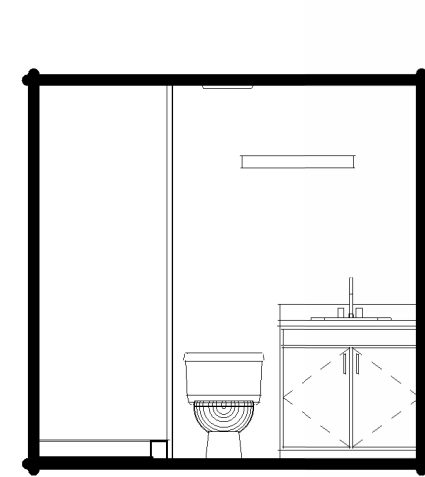


4 INTERIOR ELEVATION
Scale: 1/4" = 1'-0"

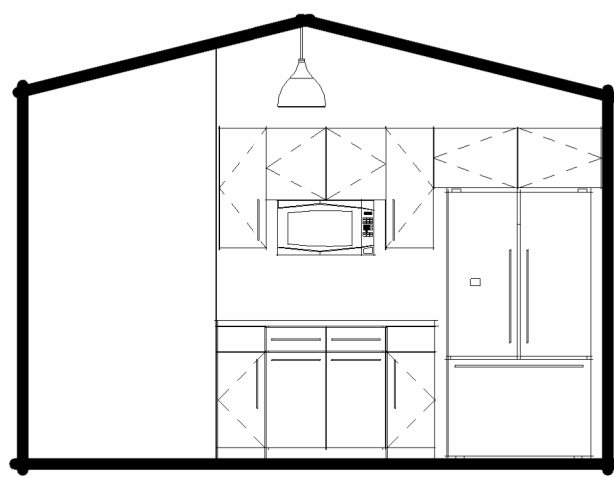


5 INTERIOR ELEVATION
Scale: 1/4" = 1'-0"

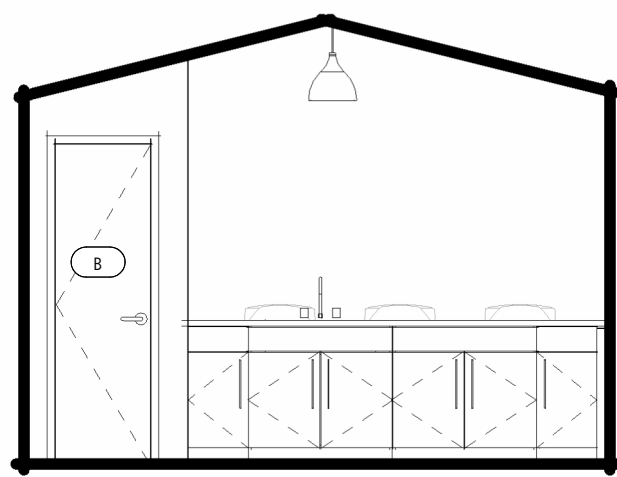


6 INTERIOR ELEVATION
Scale: 1/4" = 1'-0"

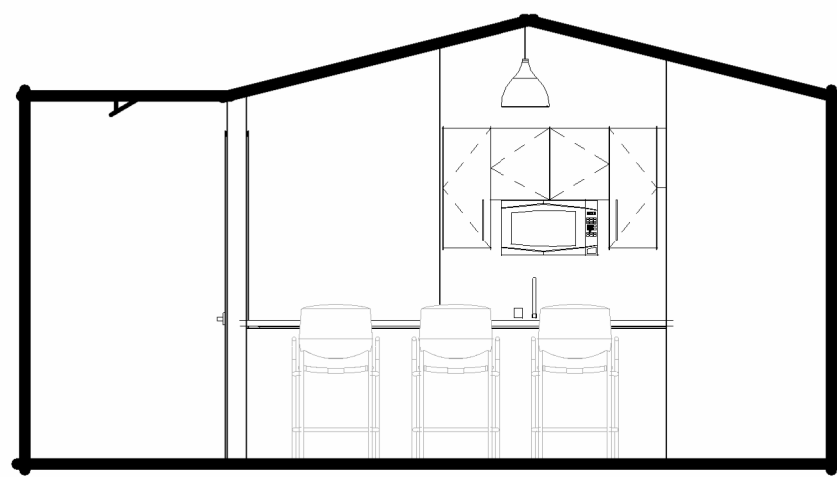


7 INTERIOR ELEVATION
Scale: 1/4" = 1'-0"

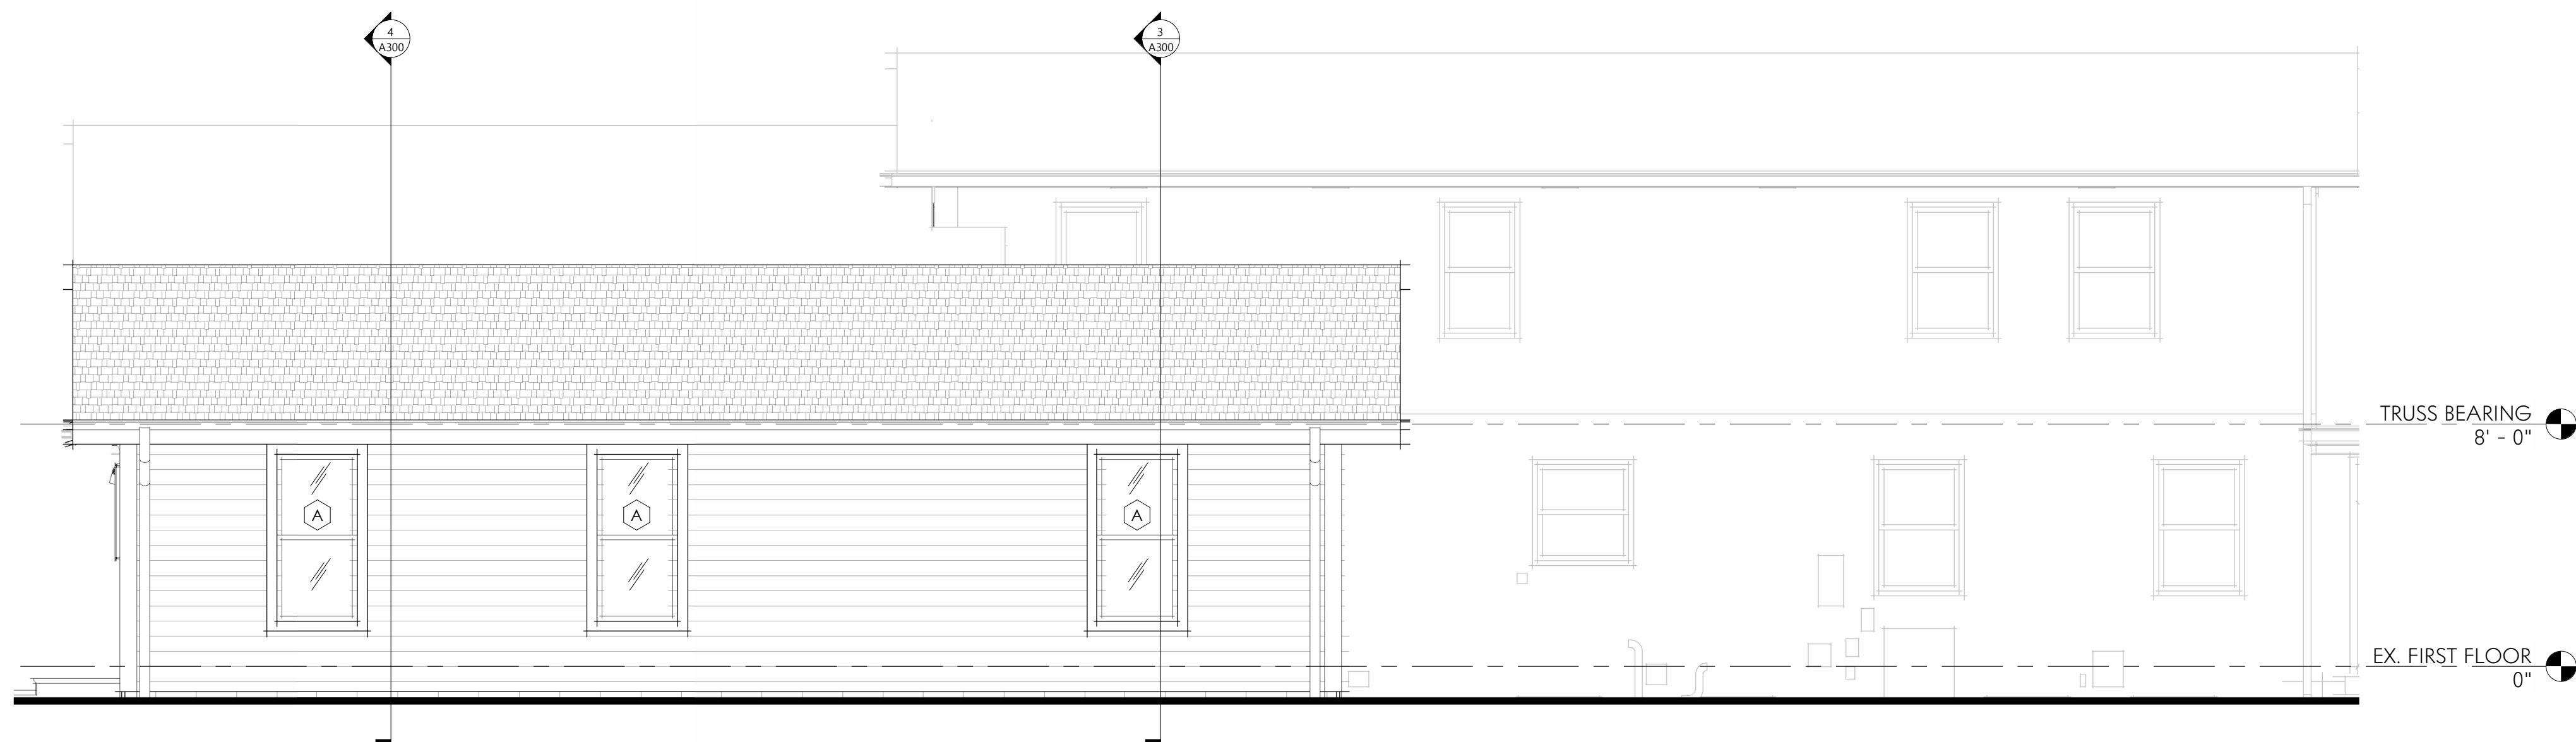

3 EAST ELEVATION
Scale: 1/4" = 1'-0"

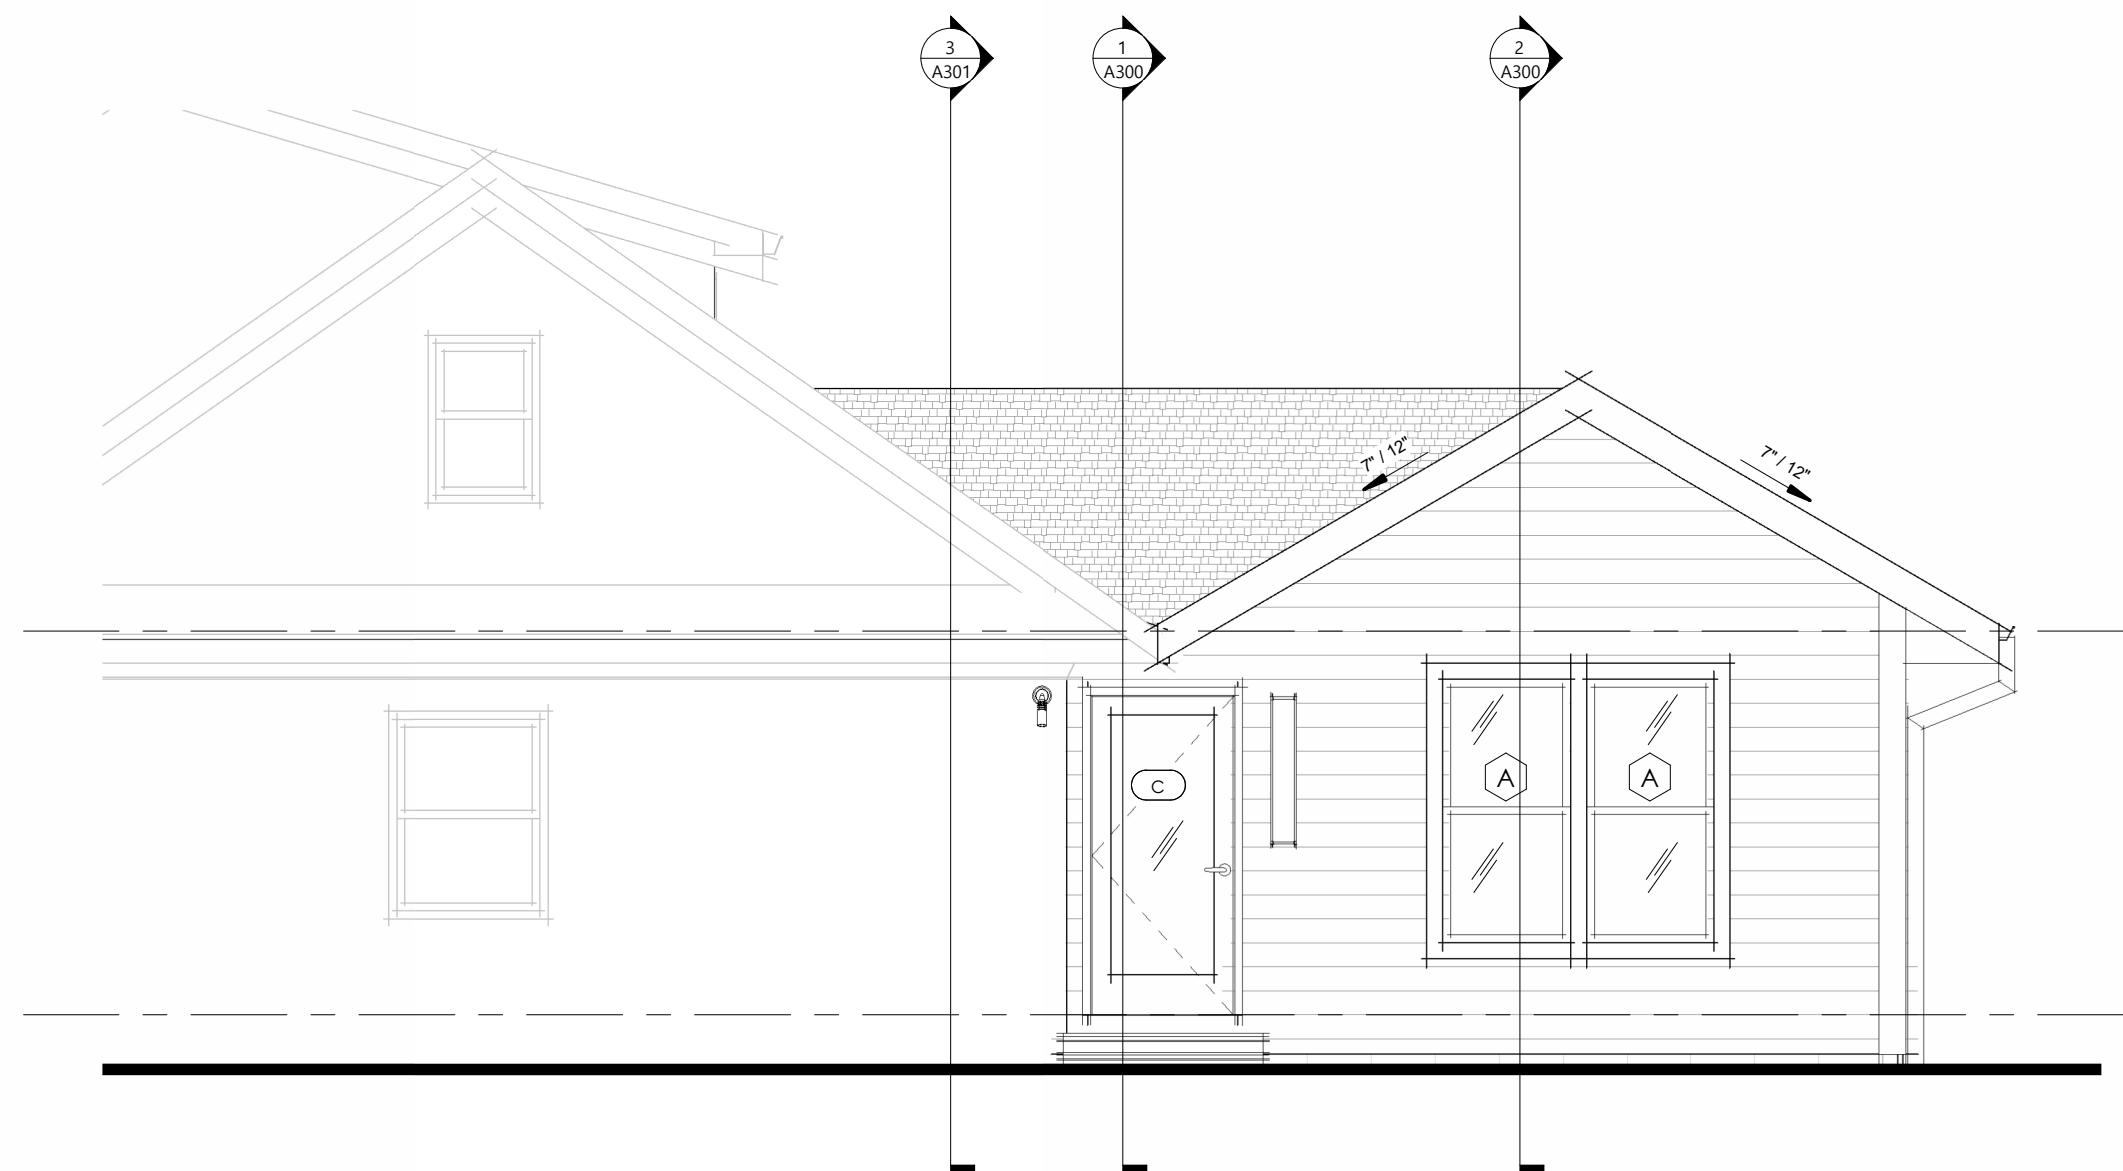

1 SOUTH ELEVATION
Scale: 1/4" = 1'-0"

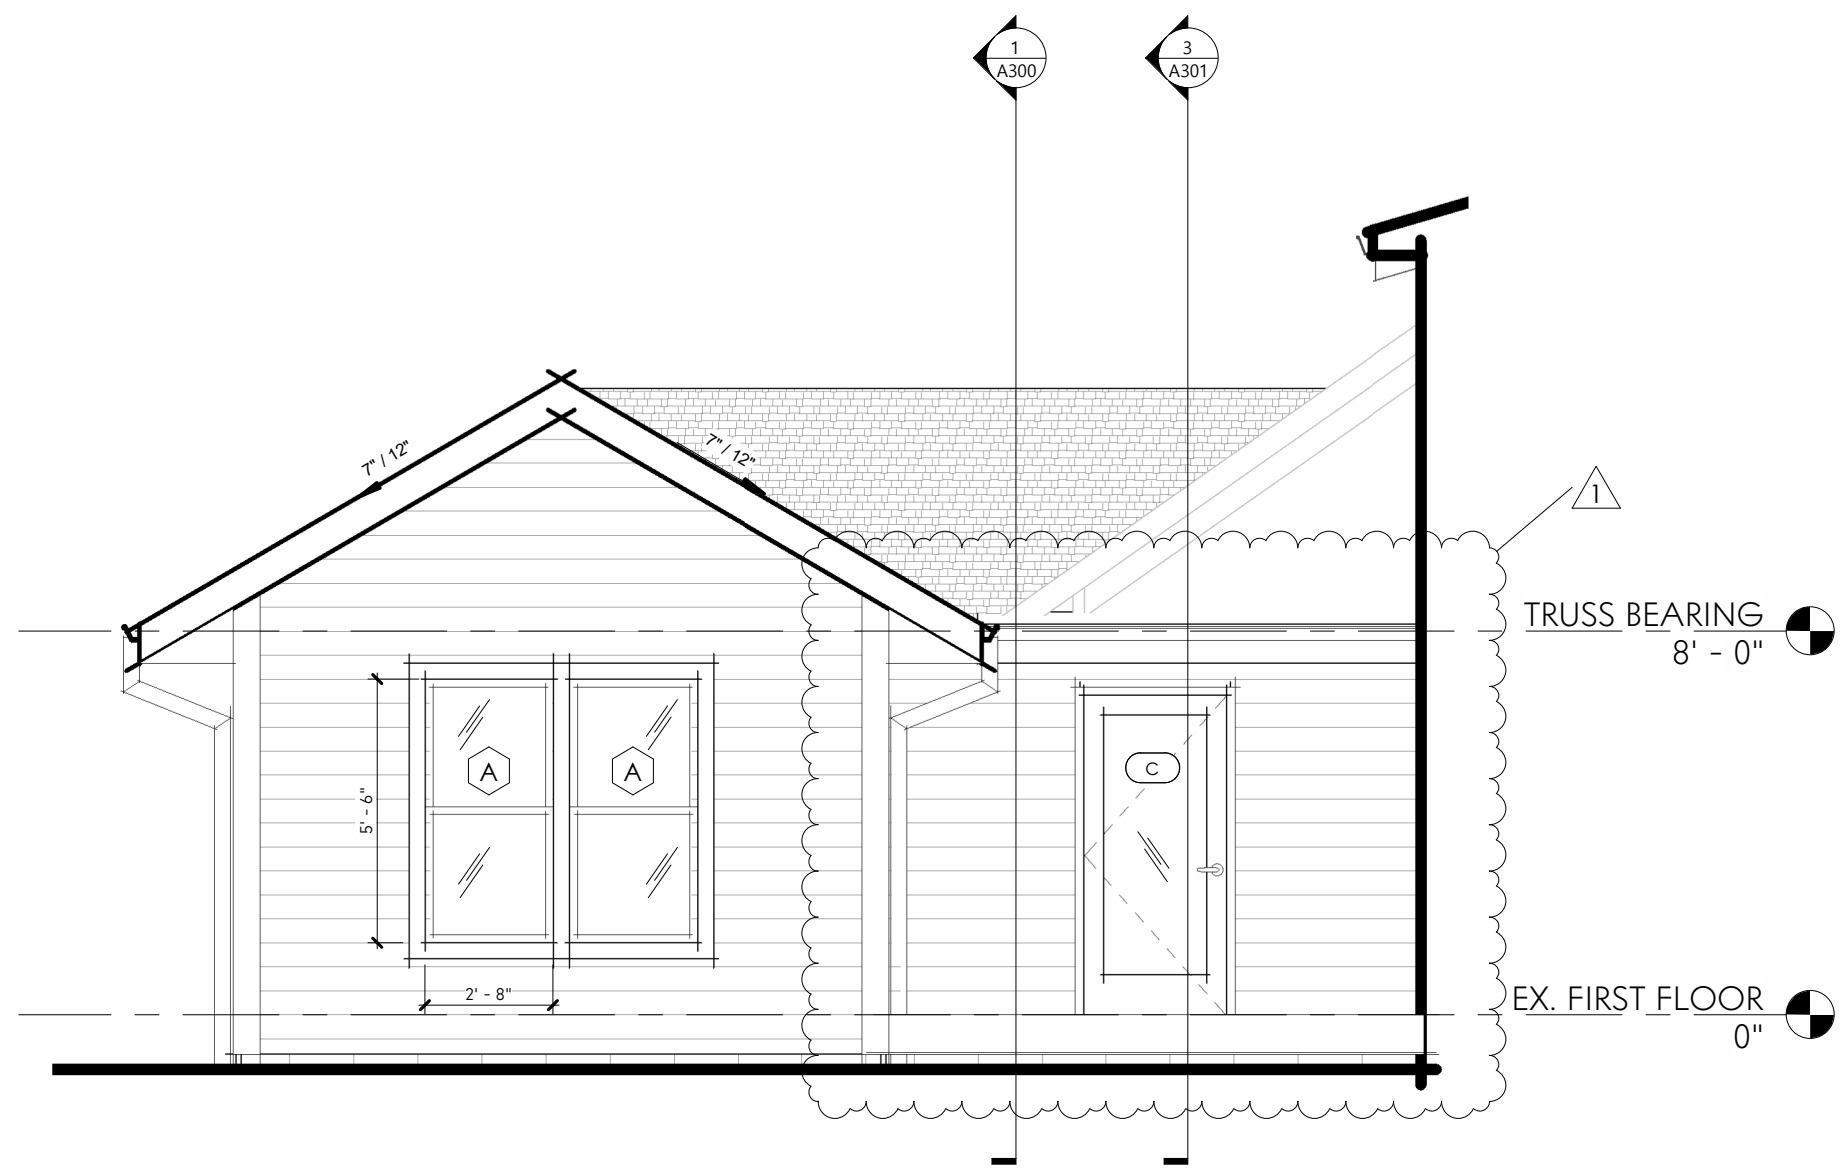


2 NORTH ELEVATION
Scale: 1/4" = 1'-0"

MATERIAL NOTES

- MATCH EXISTING VINYL SIDING AND TRIM PROFILES
- MATCH EXISTING SOFFIT AND FASICA TRIM PROFILES

KEY PLAN - EXTERIOR ELEVATIONS

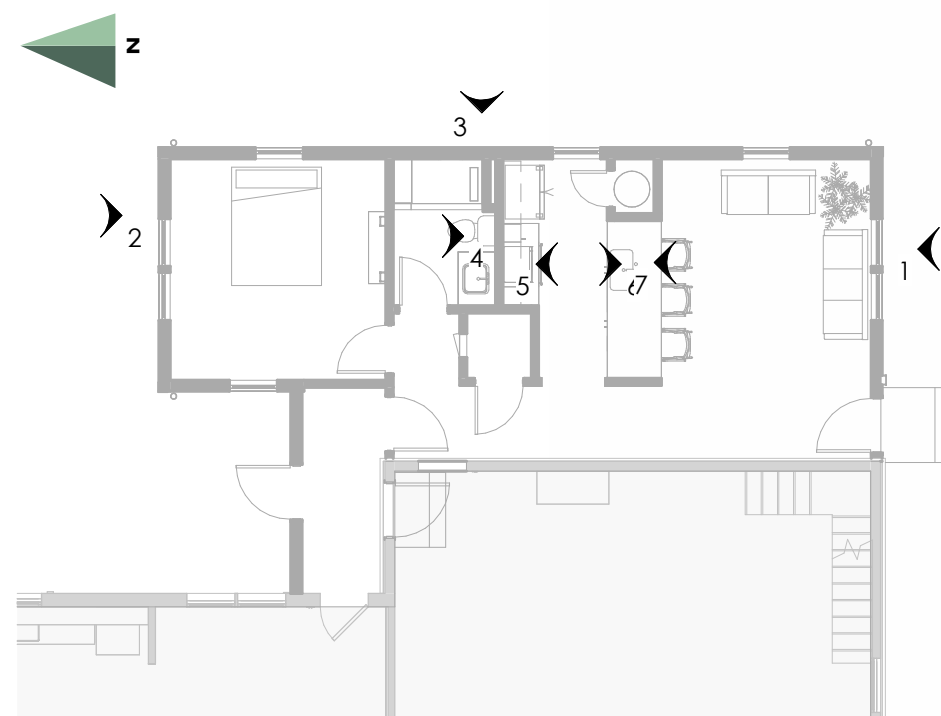

GENERAL NOTES - EXTERIOR ELEVATIONS

- A. DO NOT SCALE DRAWINGS. IF DIMENSIONS ARE IN QUESTION, THE CONTRACTOR SHALL BE RESPONSIBLE FOR SEEKING CLARIFICATION FROM ARCHITECT PRIOR TO CONSTRUCTION.
- B. ALL DIMENSIONS ARE FROM FINISHED SURFACE TO FINISHED SURFACE, UNLESS NOTED OTHERWISE.



PROJECT STATUS

ZONING VARIANCE

CURRENT ISSUE DATE

3.25.2025

PROJECT NO.

24038

REVISIONS

#	DESCRIPTION	DATE
1	Revision 1	3.11.2025

PROJECT INFORMATION

Morris Residence

Jim & Amanda Morris

3590 Clotts Rd.
Gahanna, OH 43230



MATTHEW TODDY, LICENSE #1616697
EXPIRATION DATE: DECEMBER 31, 2025


ELEVATIONSTUDIO

SHEET NAME

ELEVATIONS

SHEET NUMBER

A200

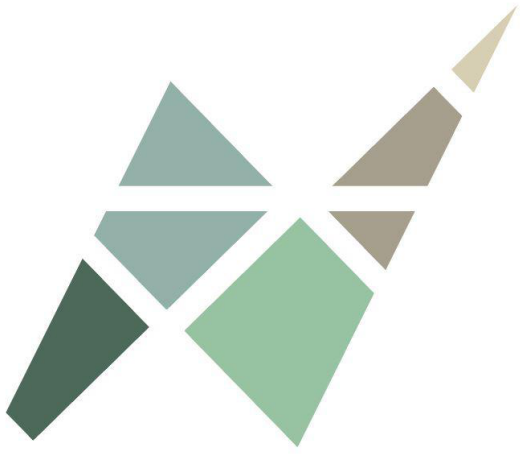

PROJECT STATUS

ZONING VARIANCE

CURRENT ISSUE DATE

3.25.2025

PROJECT NO.

24038

REVISIONS

#	DESCRIPTION	DATE
1	Revision 1	3.11.2025

PROJECT INFORMATION

Morris Residence

Jim & Amanda Morris

3590 Clotts Rd.
Gahanna, OH 43230



MATTHEW TODDY, LICENSE #1616697
EXPIRATION DATE: DECEMBER 31, 2025


ELEVATION
STUDIO

SHEET NAME


SECTIONS -
BUILDING

SHEET NUMBER


A300

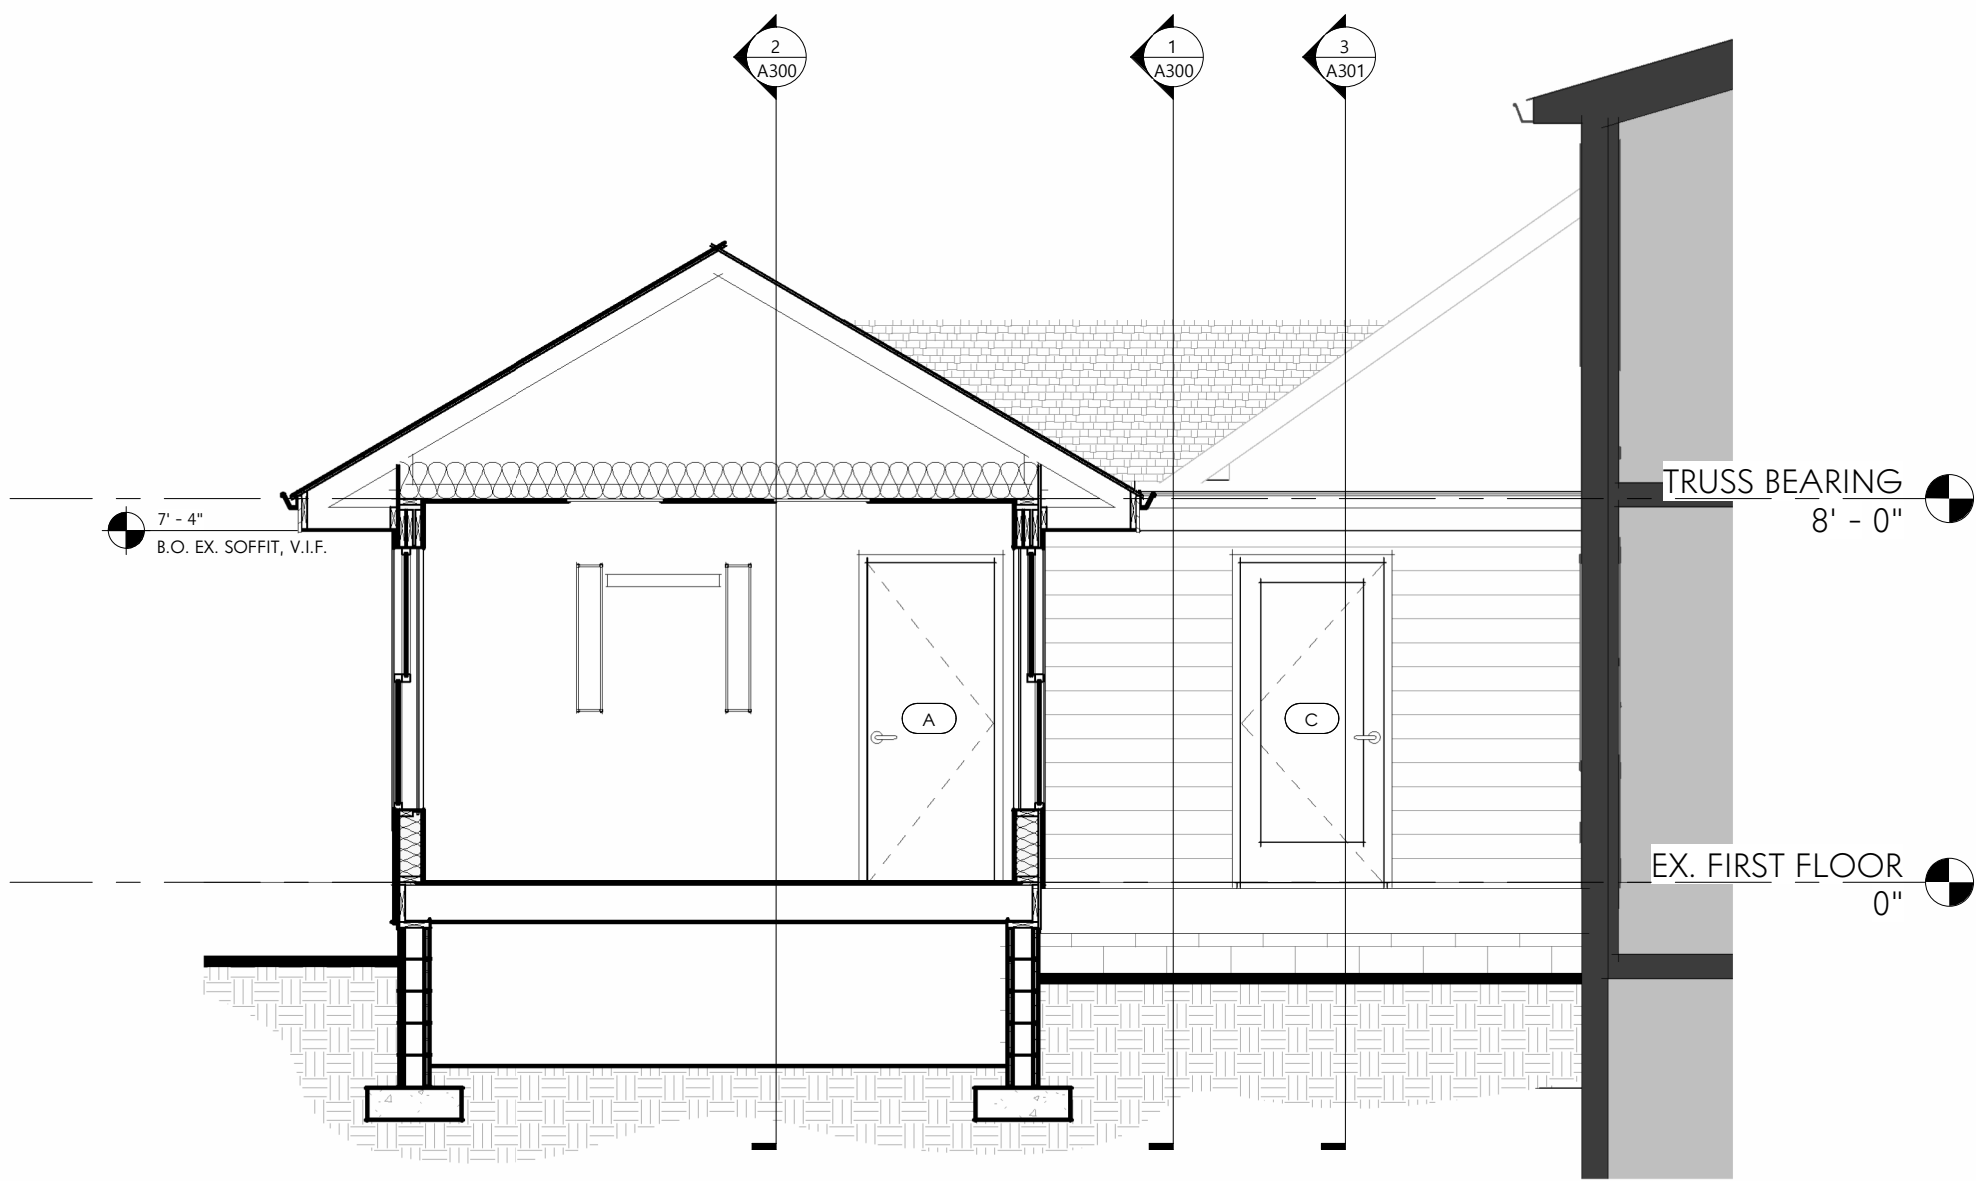


3 BUILDING SECTION D
Scale: 1/4" = 1'-0"

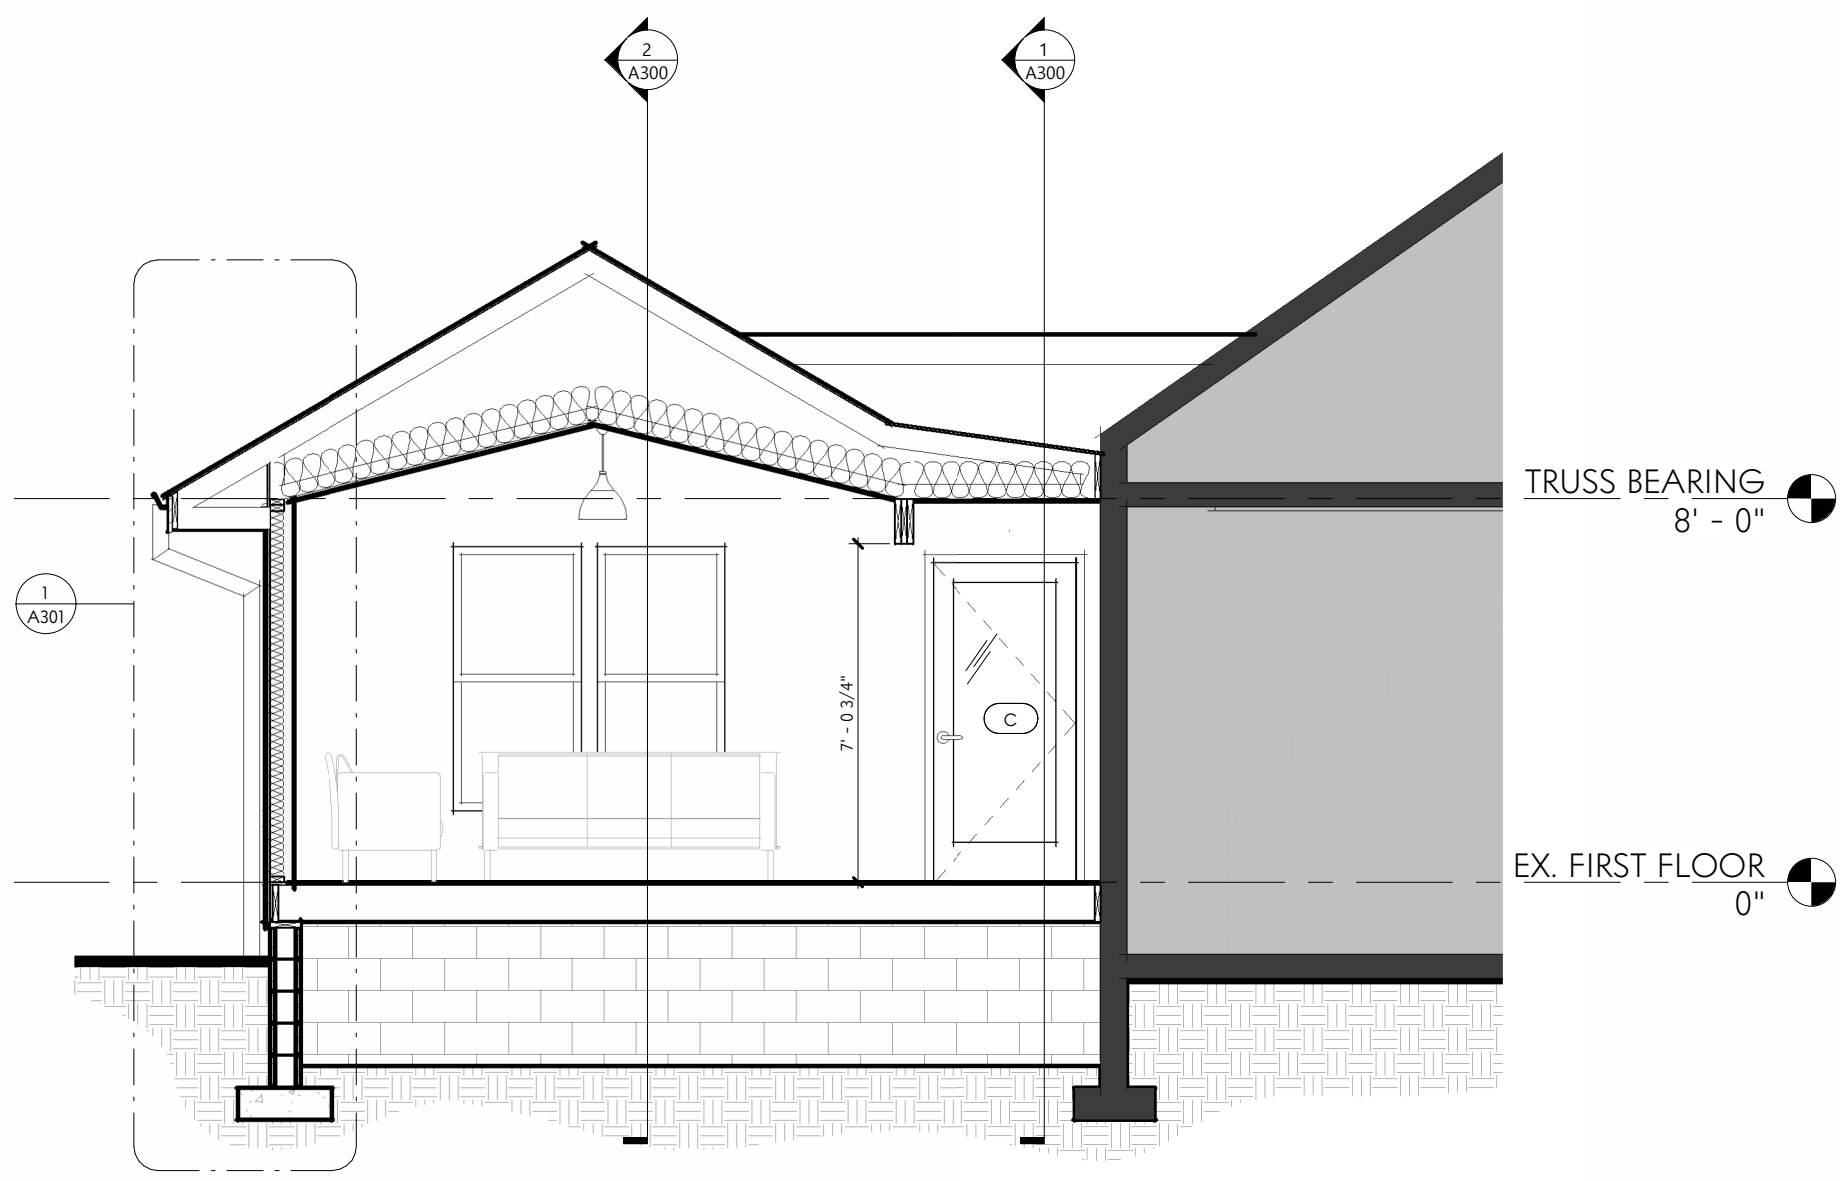


4 BUILDING SECTION C
Scale: 1/4" = 1'-0"

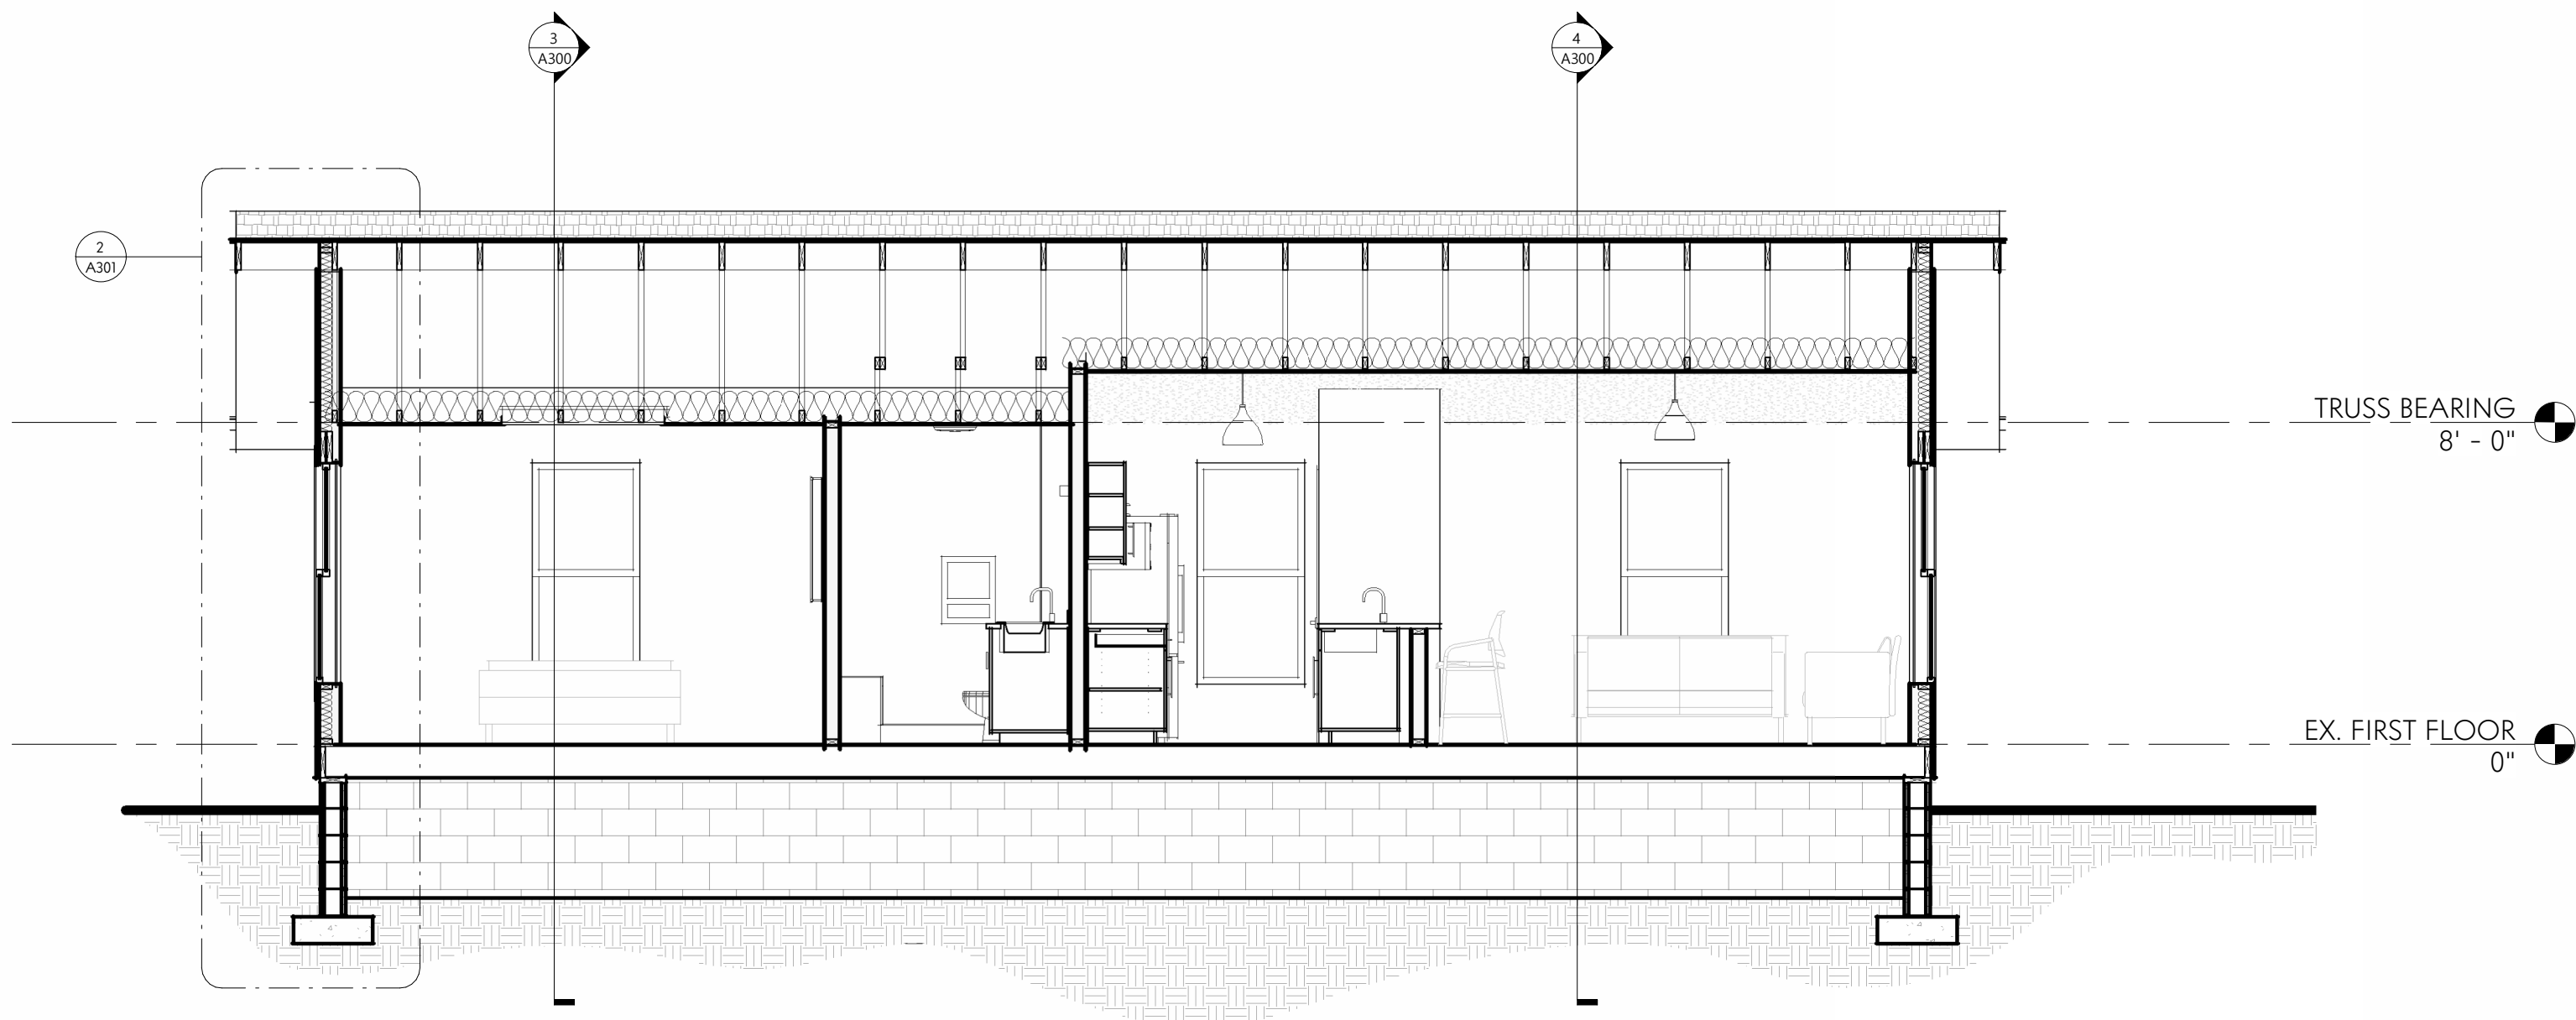


2 BUILDING SECTION B
Scale: 1/4" = 1'-0"

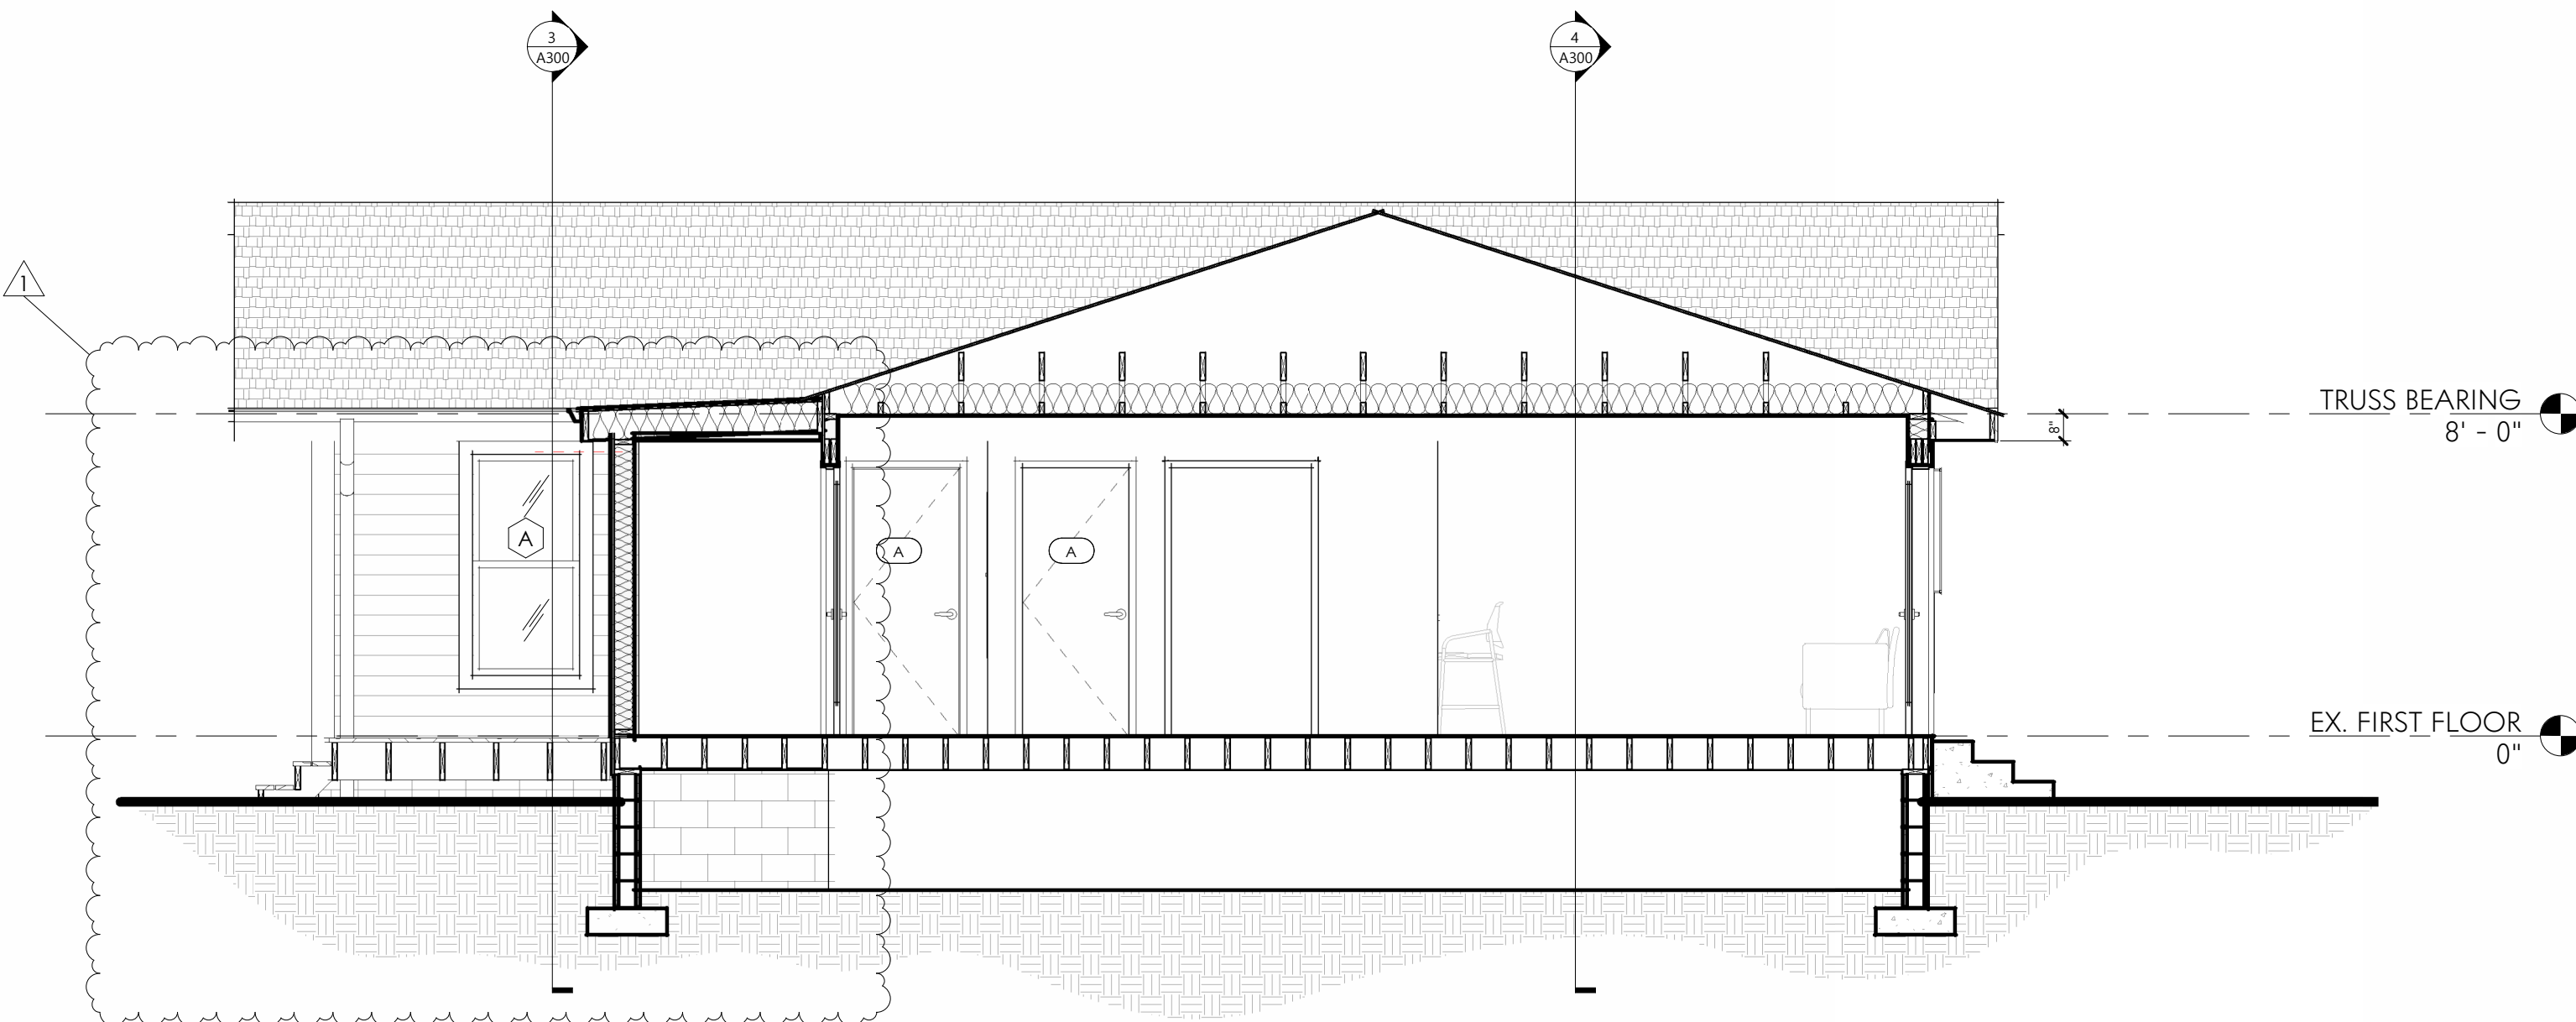

1 BUILDING SECTION A
Scale: 1/4" = 1'-0"

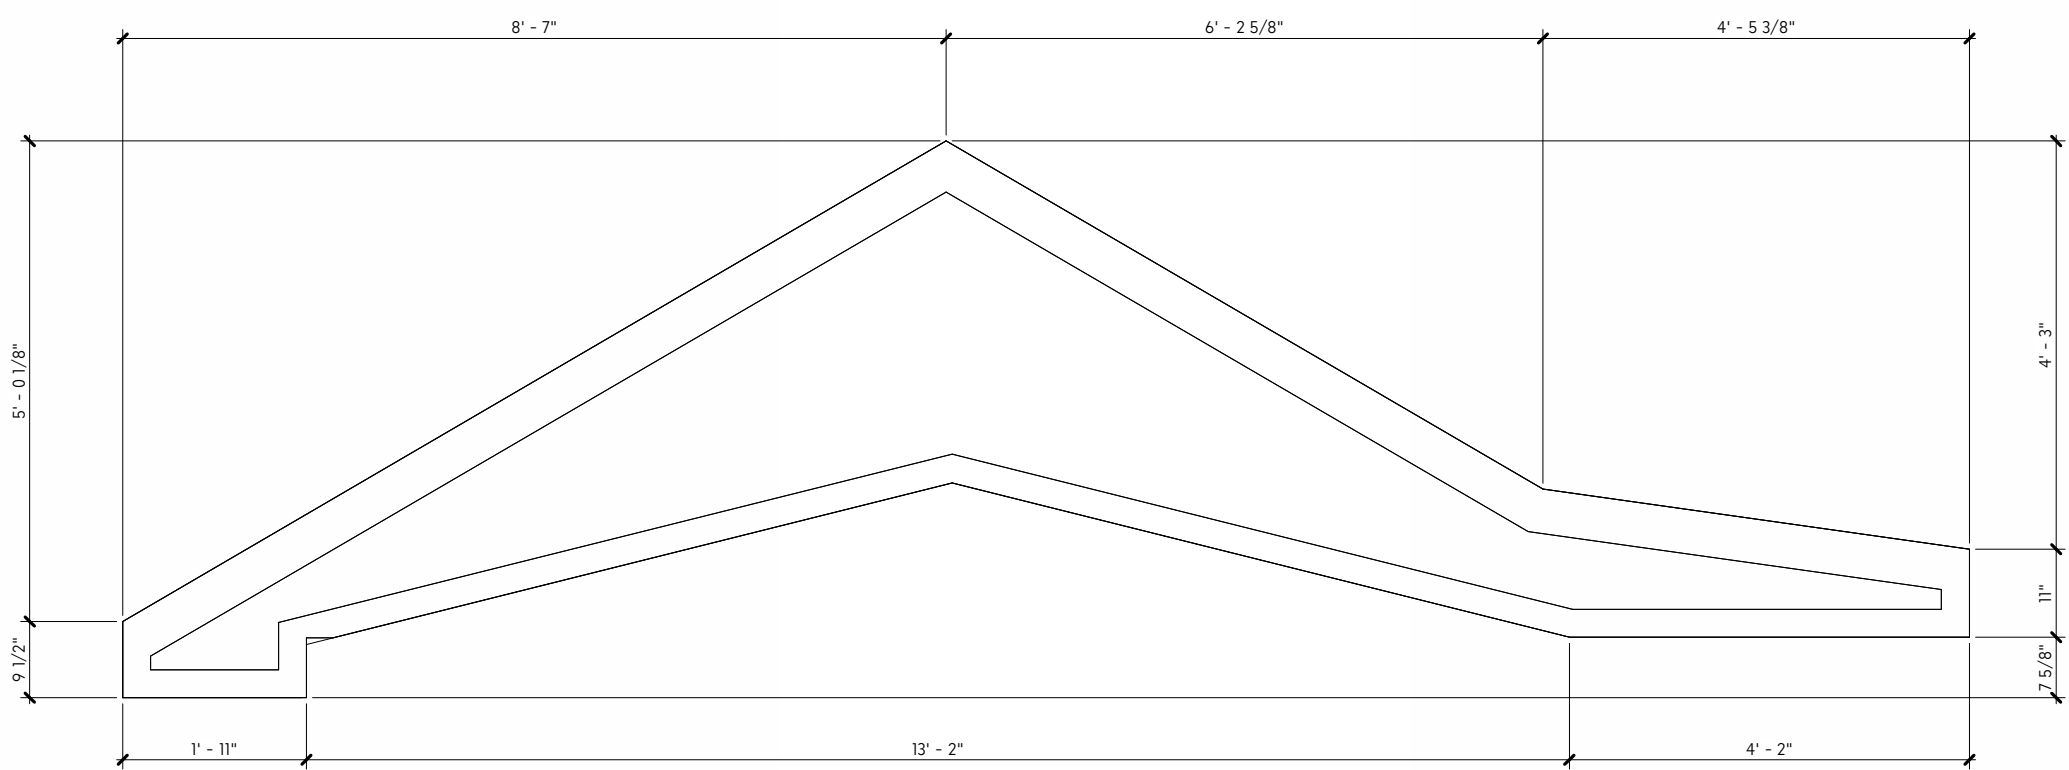

A TRUSS PROFILE A
Scale: 1/2" = 1'-0"

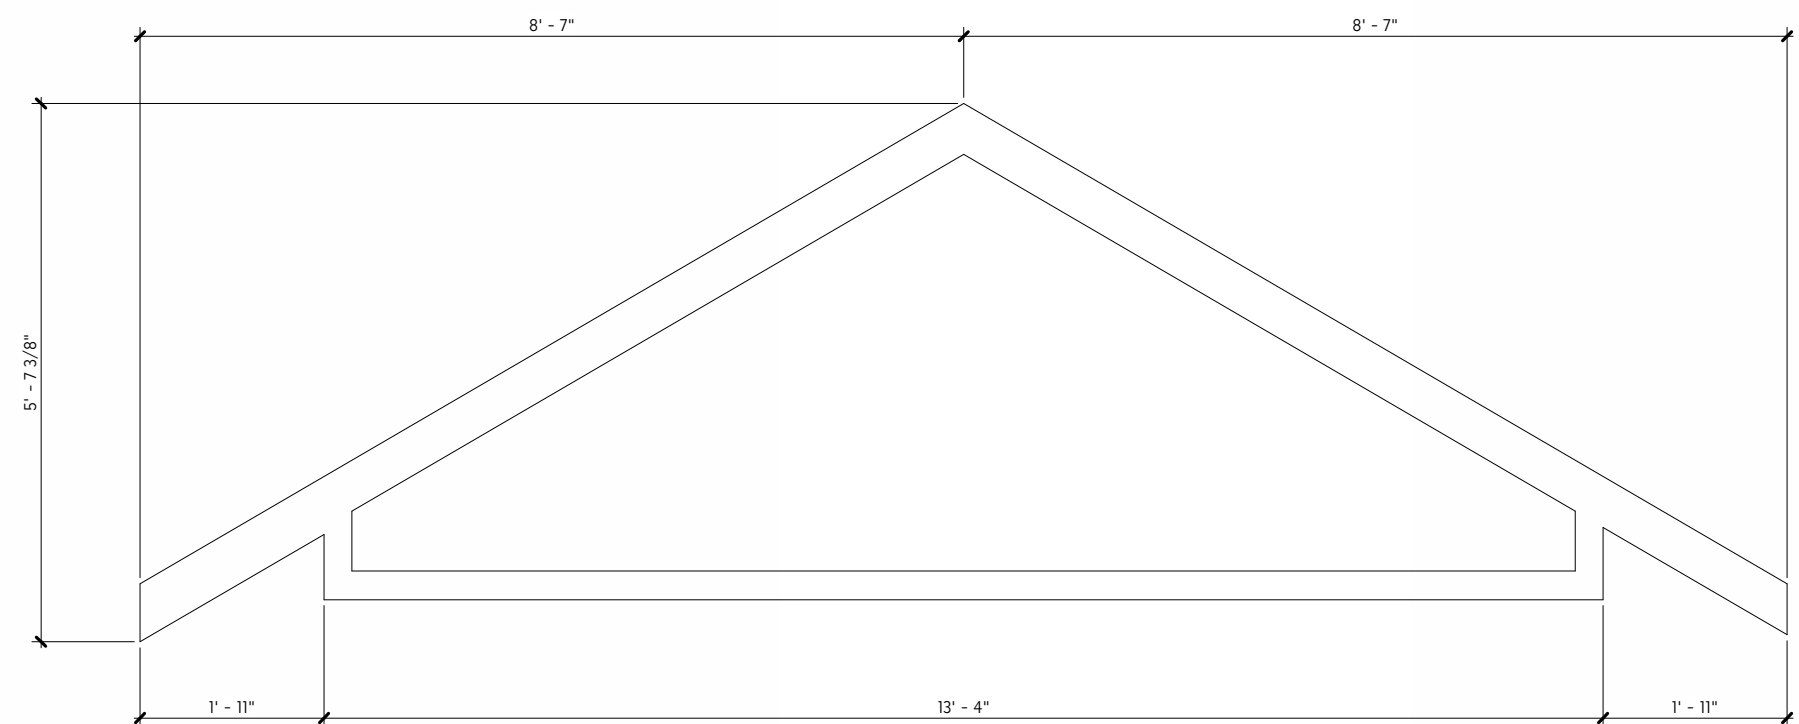

B TRUSS PROFILE B
Scale: 1/2" = 1'-0"



PROJECT STATUS

ZONING VARIANCE

CURRENT ISSUE DATE

3.25.2025

PROJECT NO.

24038

REVISIONS

#	DESCRIPTION	DATE
1	Revision 1	3.11.2025

PROJECT INFORMATION

Morris Residence
Jim & Amanda Morris
3590 Clotts Rd.
Gahanna, OH 43230



MATTHEW TODDY, LICENSE #1616697
EXPIRATION DATE: DECEMBER 31, 2025






SHEET NAME

SECTIONS - WALL

SHEET NUMBER

A301

Type text here

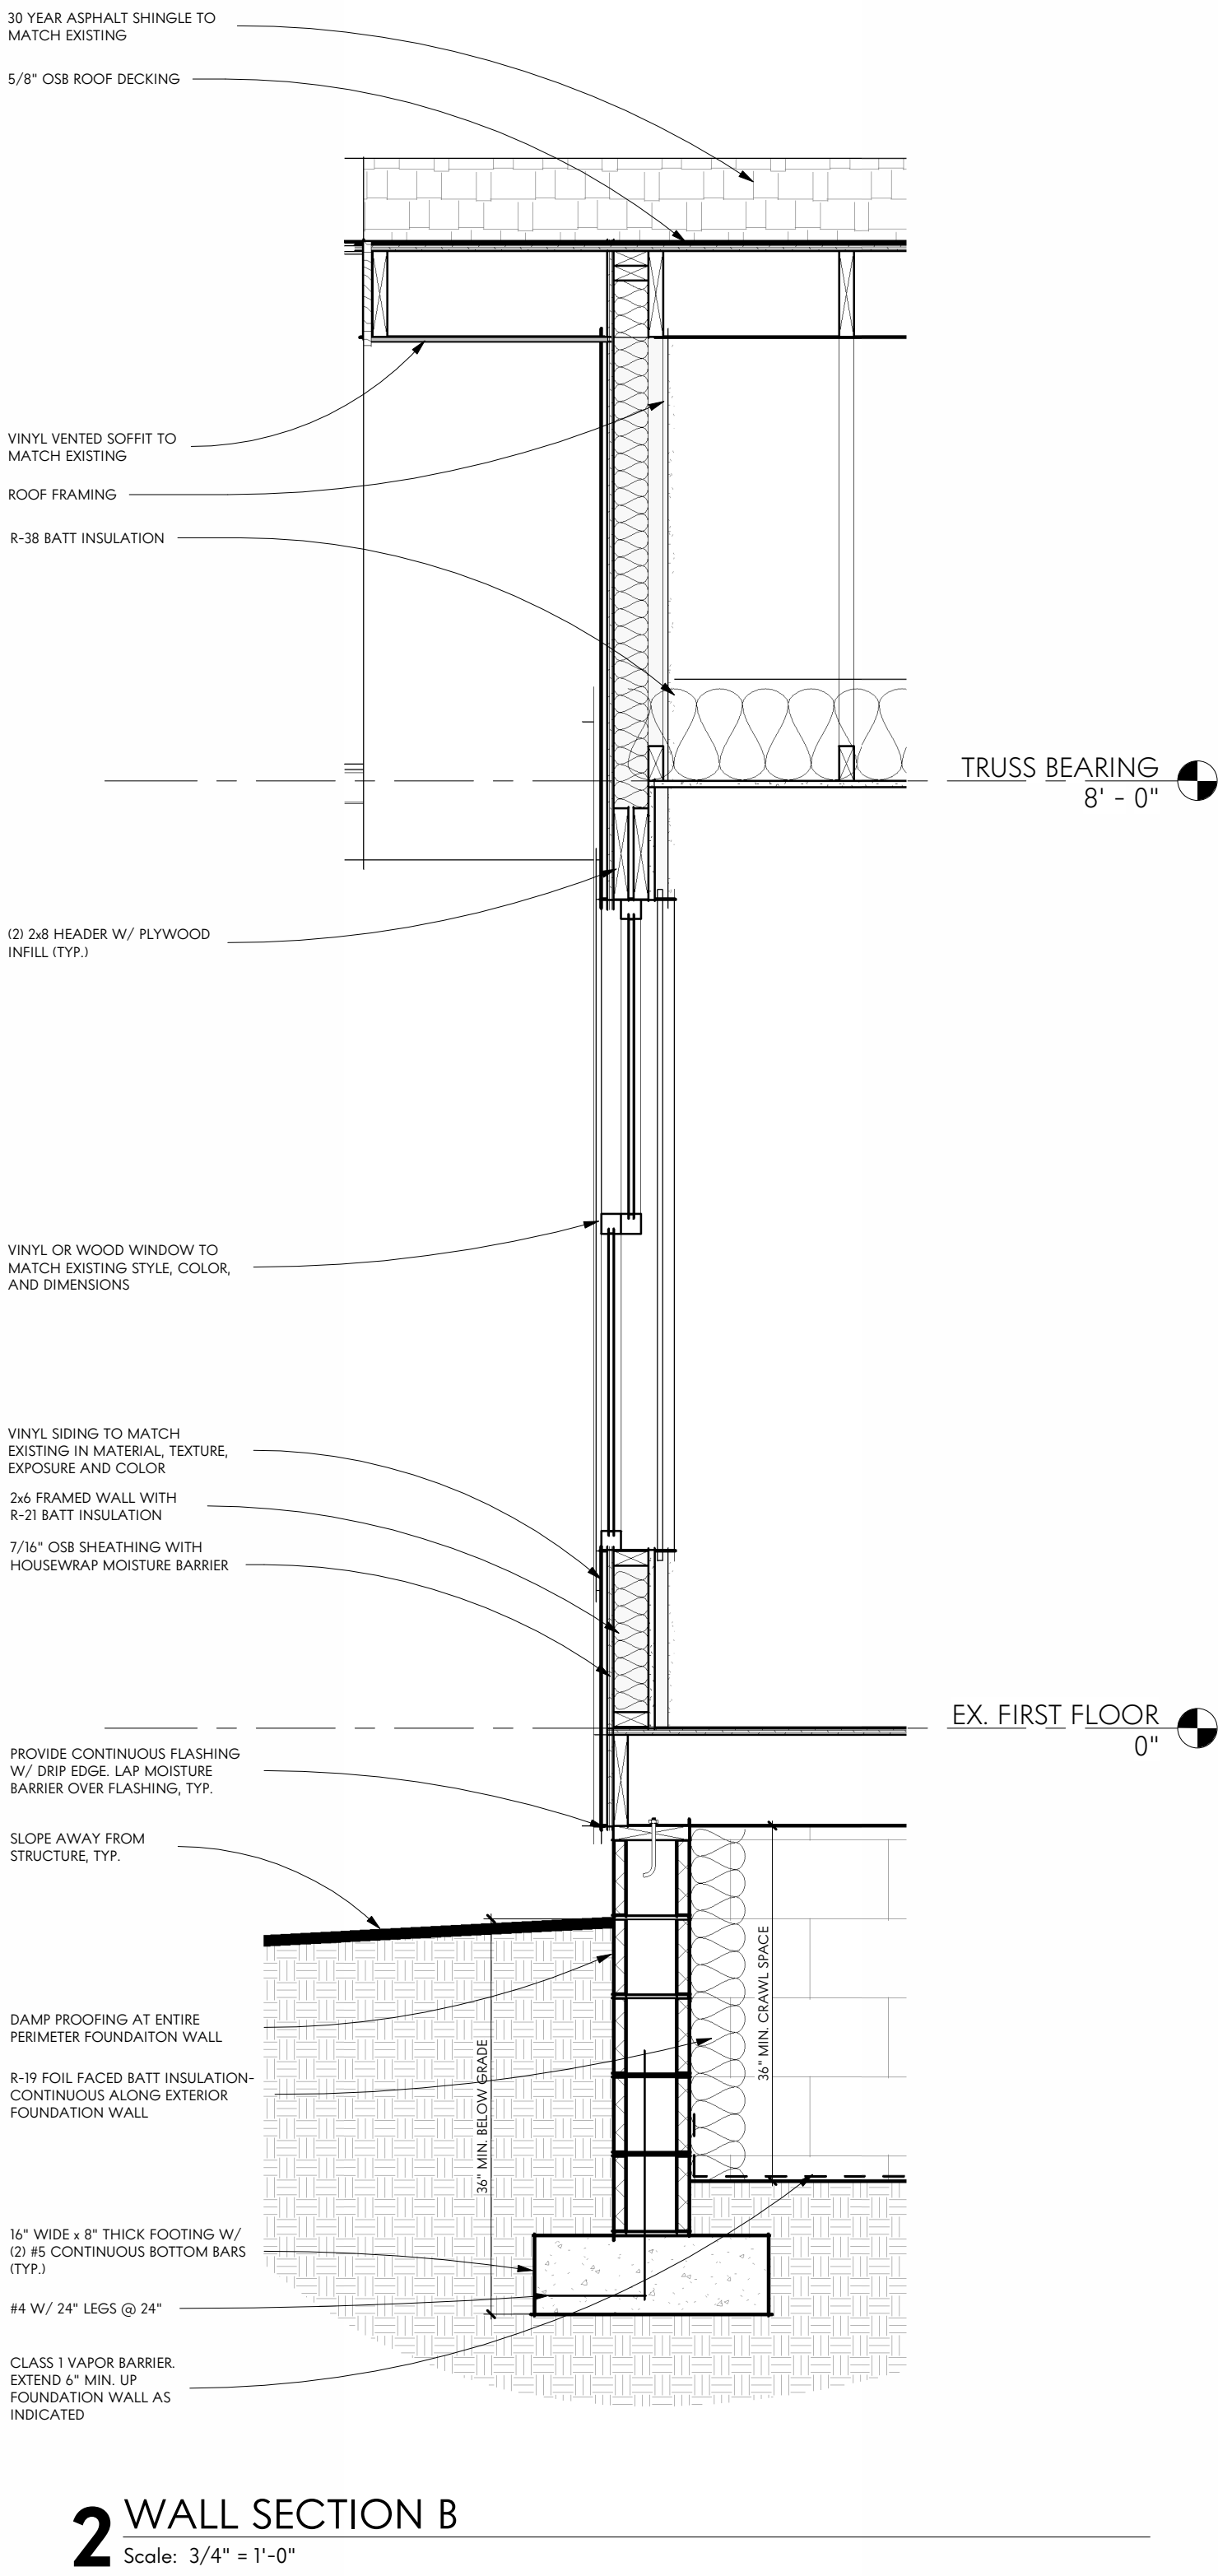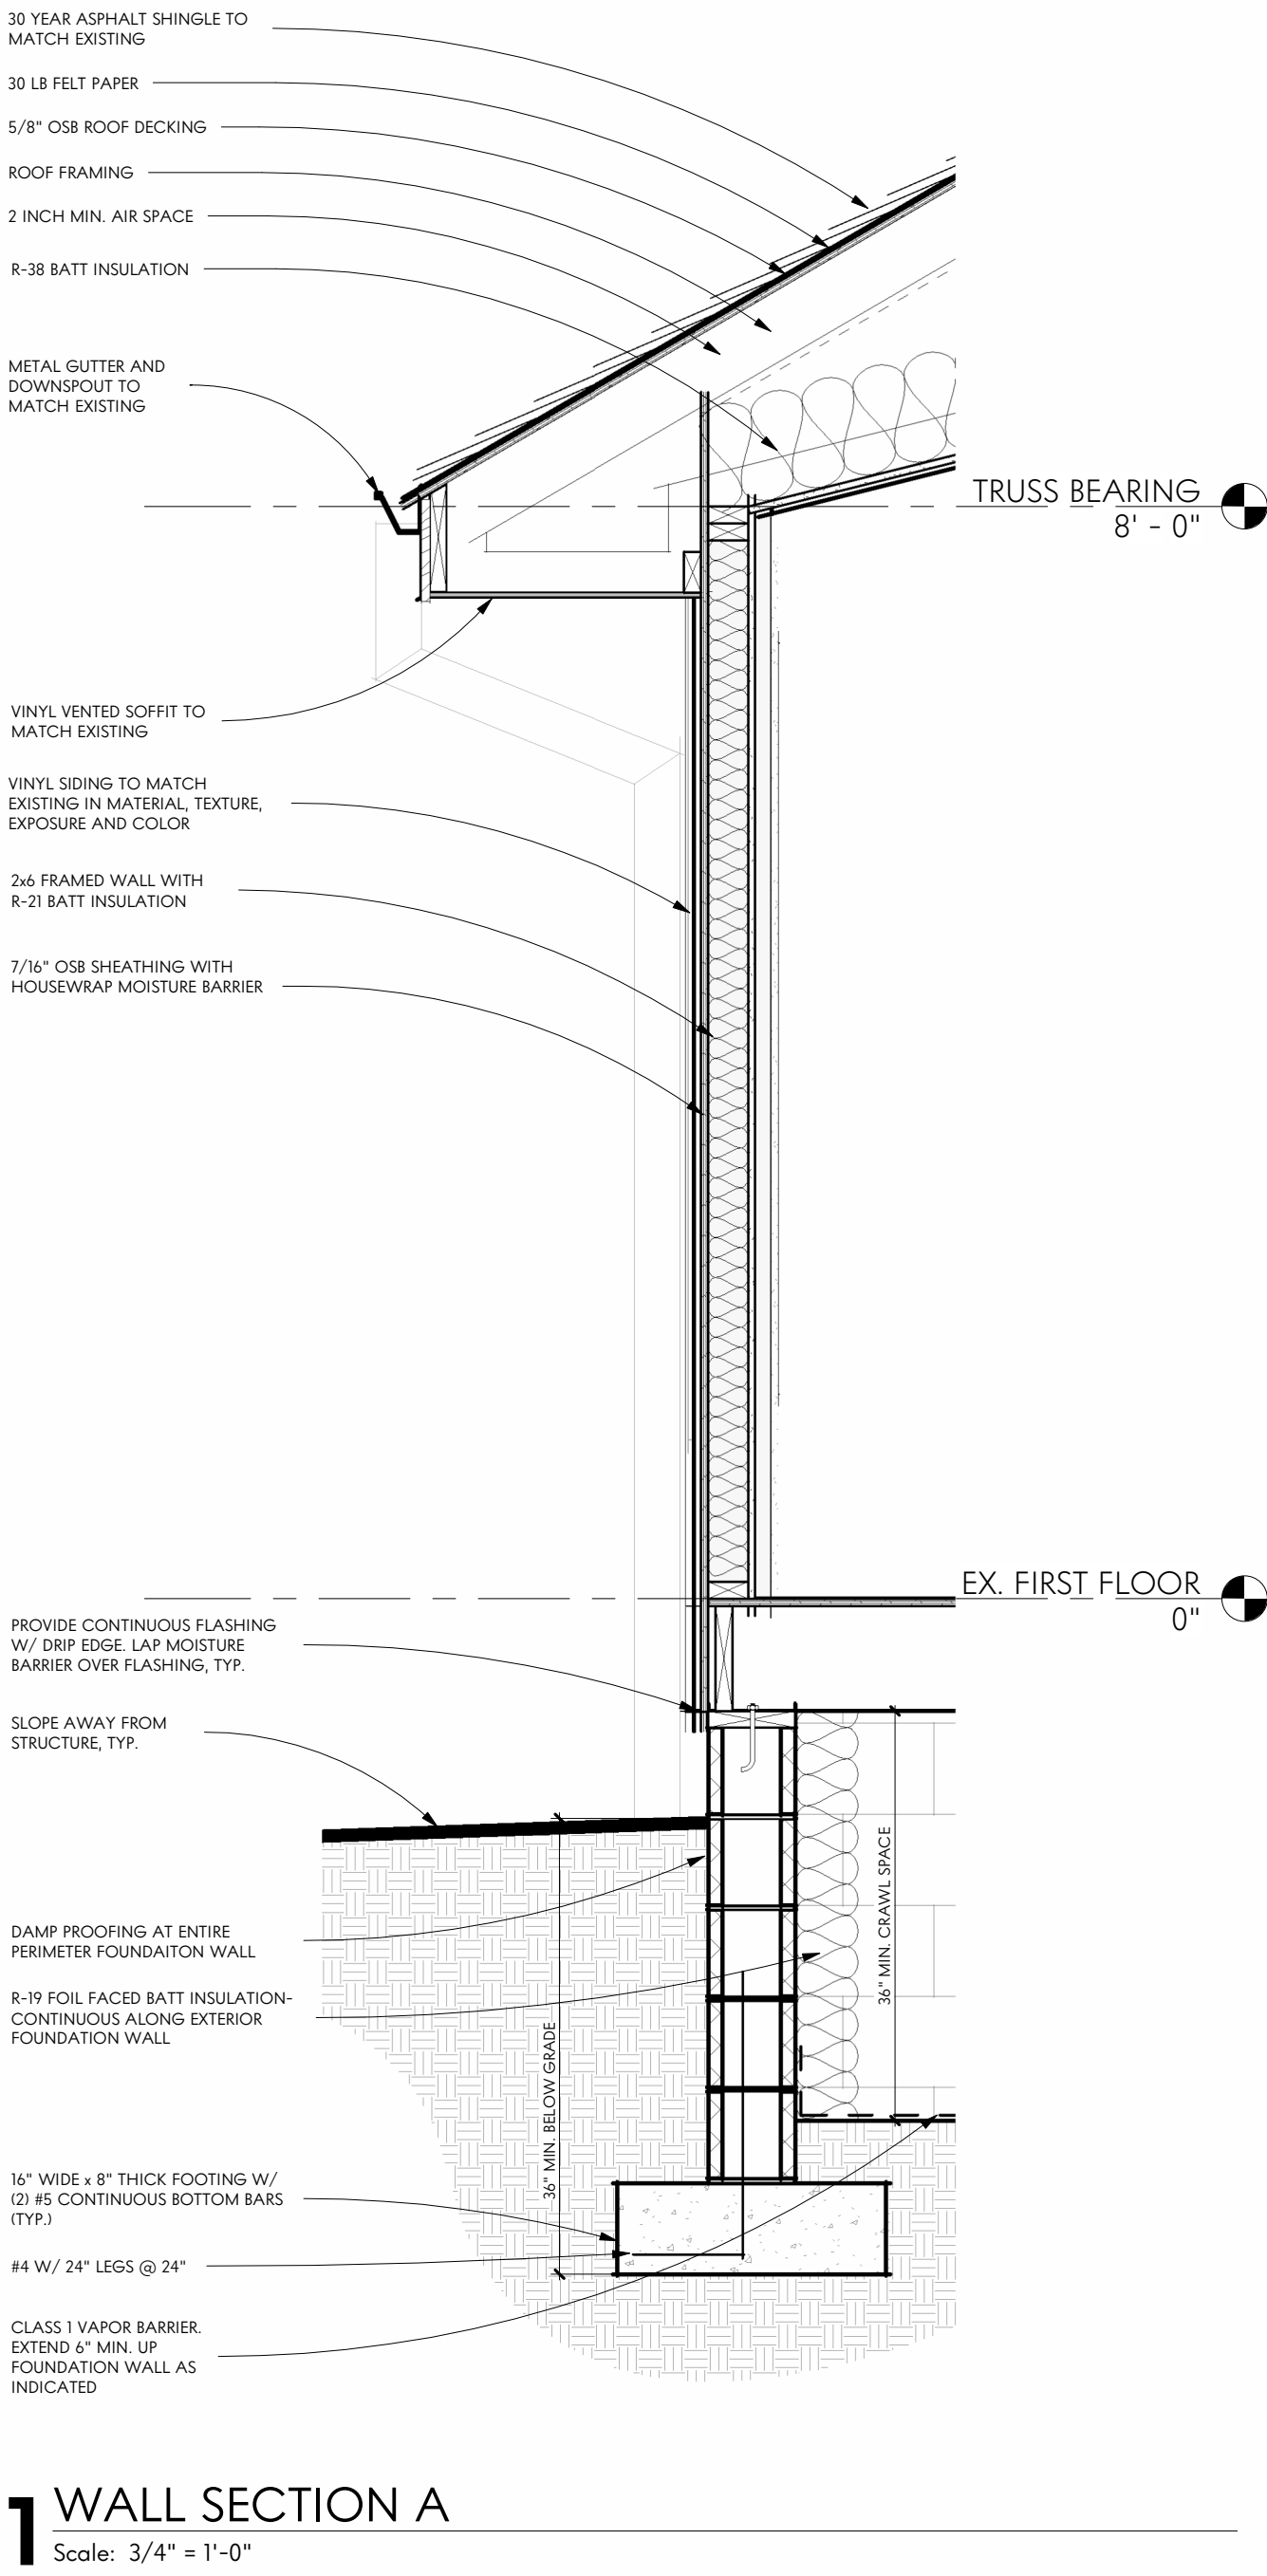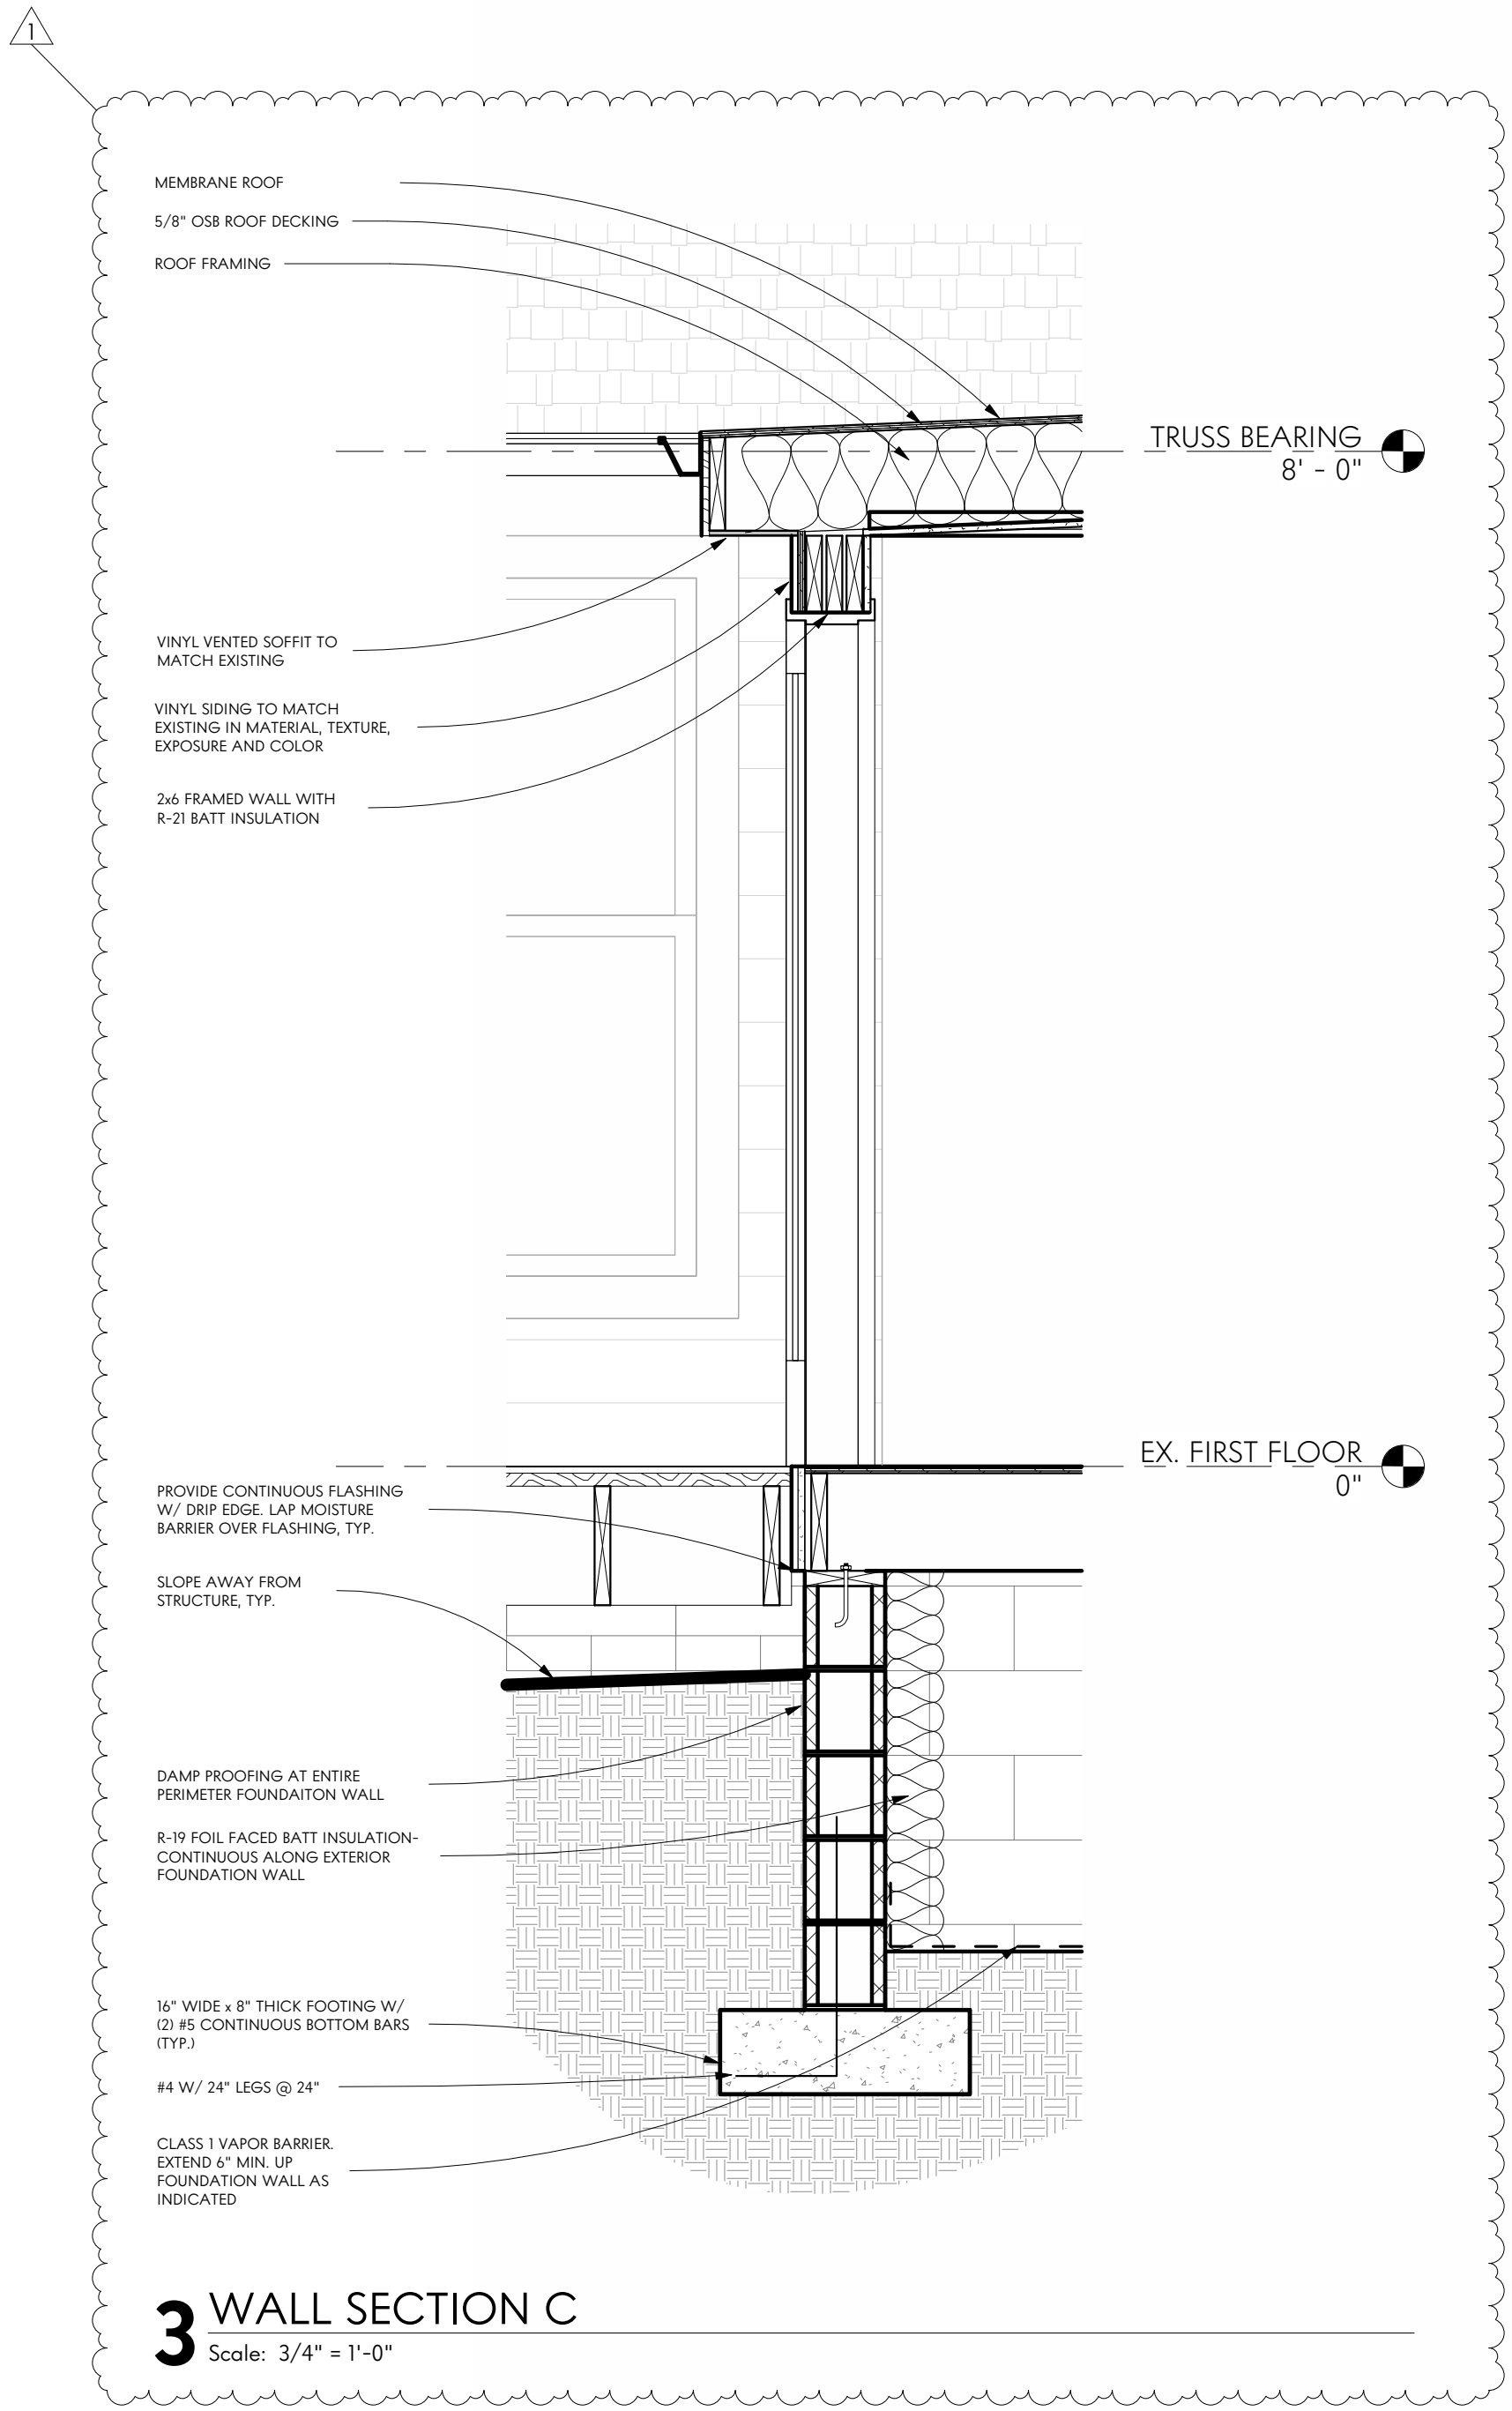

Staff Review

Overview

The applicant is requesting approval of a variance to allow an addition within a side yard setback. The zoning code requires a 15 ft side yard setback for all properties zoned R-1. The addition would be attached to the rear of the existing house and constructed in line with the south façade of the house at 11 ft 2 in from the side property line.

Under the previous zoning code, this property was zoned SF-3, which had a side yard setback of 7.5 ft. The proposed addition would have met all setback requirements under the former code. The house used to meet side yard requirements too but is now considered legal nonconforming.

Review Criteria

Variance (V)

The following variance has been requested:

1. 1103.07(e) – Large Lot Residential
 - a. The principal structure must be at least 15 ft from the side property line.
 - b. The proposed addition is 11 ft 2 in from the side property line.

Before granting a variance, Planning Commission shall find that:

- a) The variance is not likely to result in substantial change to the essential character of the neighborhood;
- b) The variance is not likely to result in damage to adjoining properties;
- c) The variance is not likely to affect the delivery of governmental services (e.g., water, sewer, garbage);
- d) The variance is not likely to result in environmental impacts greater than what is typical for other lots in the neighborhood;
- e) The variance is necessary for the economical use of the property, and such economical use of the property is not easily achieved through some method other than a variance;
- f) The variance is not likely to undermine the objectives of the land use plan;
- g) Whether the variance is substantial and is the minimum necessary to make possible the reasonable use of land or structures; and,
- h) The practical difficulty could be eliminated by some other method, even if the solution is less convenient or more costly to achieve.

Recommendation

Staff recommends approval of the variance as submitted. The addition would be in-line with the existing house and other homes in the area. All other setbacks are met. There are also privacy fences separating this property from all adjacent properties that will partially screen the addition.