



City of Gahanna

200 South Hamilton
Road
Gahanna, Ohio 43230

Signature

Ordinance: ORD-0013-2024

File Number: ORD-0013-2024

AN ORDINANCE AUTHORIZING THE MAYOR TO ENTER INTO CONTRACT WITH STRAWSER PAVING COMPANY FOR THE 2024 STREET AND SIDEWALK PROGRAM (ST-1110)

WHEREAS, on February 13, 2024, bids were opened and reviewed for the 2024 Street and Sidewalk Program (ST-1110); and

WHEREAS, in total, two bids were received; and

WHEREAS, the 2024 Street and Sidewalk Program consists of concrete work, pavement milling, asphalt resurfacing, crack sealing, micro surfacing, street rebuilds, sidewalk rebuilds, sidewalk maintenance, striping, and golf course paths; and

WHEREAS, Strawser Paving Company was the lowest responsive and responsible bidder; and

WHEREAS, the Department of Engineering is recommends entering into contract with Strawser Paving Company for the 2024 Street and Sidewalk Program, awarding the Base bid of \$4,899,580.69, Alternate 1 - Additional Crack seal and Micro Surface of \$29,143.08, Alternate 2 - Golf Course Paths of \$288,287.40, and Alternate 3 - Additional Striping of \$48,395.69, with a 10 percent contingency to cover any unforeseen construction costs, bringing the total to \$5,791,947.55.

NOW, THEREFORE, BE IT ORDAINED BY THE COUNCIL OF THE CITY OF GAHANNA, COUNTY OF FRANKLIN, STATE OF OHIO:

Section 1. That the Mayor is hereby authorized to award the Base bid, with Alternates 1, 2, and 3 and enter into contract with Strawser Paving Company, primary offices located at 1595 Frank Road, Columbus, OH 43223, for the 2024 Street and Sidewalk Program (ST-1110); said contract's terms more particularly described in EXHIBIT A, attached hereto and made a part herein.

Section 2. That funding for this project in the amount of five million seven hundred ninety-one thousand nine hundred forty-seven dollars and fifty-five cents (\$5,791,947.55) has already been appropriated and approved as follows:

from 325.06.550.5500 (2024 Appropriations) Asphalt Overlay: \$2,500,000
from 325.06.550.5500 (2024 Appropriations) Street Rebuild: \$2,500,000
from 325.06.550.5500 (2024 Appropriations) Sidewalk Maintenance: \$421,596.15
from 325.06.550.5500 (2024 Appropriations) Golf Course Path Replacement: \$317,116.14
from 325.06.550.5500 (2024 Appropriations) Traffic Control Upgrades & Maintenance: \$53,235.26

Section 3. That this Ordinance shall be in full force and effect after passage by Council and on date of signature of approval by the Mayor.

At a regular meeting of the City Council on March 18, 2024, a motion was made by Schnetzler,
seconded by Renner, that this Ordinance be Adopted. The vote was as follows:

Ms. Bowers, yes; Ms. Jones, yes; Ms. McGregor, yes; Ms. Padova, yes;
Mr. Renner, yes; Mr. Schnetzler, yes; Mr. Weaver, yes

President Merisa K. Bowers
Merisa K. Bowers

Date 3/19/24

Attest by Jeremy A. VanMeter
Jeremy A. VanMeter
Clerk of Council

Date 3/19/2024

Approved by the Mayor Laurie A. Jadwin
Laurie A. Jadwin

Date 3.19.2024

Approved as to Form PDT
Priya D. Tamilarasan
City Attorney

Date 3/18/24

ORD-0013-2024

EXHIBIT A



City of Gahanna
Department of Engineering
200 South Hamilton Road • Gahanna, OH 43230
614.342.4050 Phone • engineering@gahanna.gov • www.gahanna.gov

INVITATION FOR BID

2024 STREET AND SIDEWALK PROGRAM ST-1110

BID OPENING DATE: FEBRUARY 13, 2024 AT 11:00AM, LOCAL TIME

Strawser Paving Company

Company Name Submitting Bid

1595 Frank Rd

Street Address

Columbus, OH 43223-3737

City, State, Zip

614-276-5273

Telephone Number

TABLE OF CONTENTS

	<u>Page</u>
Notice to Bidders	1
Information & Requirements for Bidders	2
Appendix A: Supplementary Specifications	
Appendix B: Prevailing Wage (State)	
Appendix C: Documents to be Submitted with Bid	
Contractor's Qualification Statement	
Subcontractors List	
Corporate Affidavit	
Contractor's Personal Property Tax Affidavit (O.R.C. §5719.042)	
Noncollusion Affidavit	
Escrow Waiver	
Bid Guaranty and Contract Bond (O.R.C. §153.571)	
Bid Form	
Appendix D: Detail Sheets, Rebuild Profiles, Typical Section, and Street Program Map	
Appendix E: Owner-Contractor Agreement & Administrative Project Documents	
Owner-Contractor Agreement	
Fiscal Officer's Statement of Availability	
Modified Standard General Conditions of the Construction Contract	
State of Ohio Bureau of Worker's Compensation Insurance Certificate Attachment Sheet	
Insurance Certificate Attachment Sheet	
Notice of Commencement of Public Improvement	
Notice of Award to Contractor	
Notice of Award to Surety and Surety's Agent	
Notice to Proceed	
Change Order	
Payroll Information	
Final Payroll Affidavit	
Contractor's Payment Application Checklist	
Contractor's Affidavit with Subcontractors List & Suppliers with any Amounts Withheld	
Contractor's Waiver and Release Agreement	
Subcontractor's/Supplier's Waiver & Release Agreement	
Statement of Claim Form	
Statement of Claim Form Instructions	
Design Professional's Certificate of Substantial Completion	
Appendix F: City of Columbus CMS Supplement	

NOTICE TO BIDDERS

Sealed bids will be received by the City of Gahanna, Ohio ("Owner") until **11 am**, local time, on **February 13, 2024** through the Owner's electronic bidding system for all labor, material, and services necessary for the **2024 Street and Sidewalk Program, ST-1110** (the "Project"), as more fully described in the Contract Documents prepared by the City of Gahanna. Bids received after this time will not be accepted. Bids will be opened publicly and read immediately thereafter. Subject to the right of the Owner to reject any or all bids, the Owner will award contracts to the bidder(s) submitting the lowest and best bid(s).

Engineer's Estimate: \$4,831,000 (Base Bid)

Engineer's Estimate: \$33,000 (Alternate 1 Additional Crack Seal & Micro Surface)

Engineer's Estimate: \$277,000 (Alternate 2 Golf Course Paths)

Engineer's Estimate: \$56,000 (Alternate 3 Additional Striping)

The Owner utilizes an online electronic bidding system through BidExpress as its sole method of bid submission for projects and contracts that are subject to competitive bidding. Bidders new to the Owner's electronic bidding system must first register on the BidExpress website (www.bidexpress.com) to create an InfoTech Digital ID which is used to digitally sign bids. Registration is free. It can take up to five (5) business days to process a digital ID and it is highly recommended that a Digital ID be enabled 48-hours in advance of submitting an electronic bid. Bidders must plan accordingly. For additional guidance regarding the owner's electronic bidding system, bidders must contact Bid Express directly.

The base bid Project consists of concrete work, pavement milling, asphalt resurfacing, crack sealing, micro surfacing, street rebuilds, sidewalk, and striping. It is anticipated that the work will commence on **April 2, 2024**, and be completed by **August 2, 2024**. The Golf Course Paths improvements are to commence on **October 1, 2024** and be substantially completed on or before **November 25, 2024**.

A complete set of the Contract Documents is available for examination at the office of the Director of Public Service and Engineering, 200 South Hamilton Road, Gahanna, Ohio 43230 during its normal business hours without charge. Copies may be obtained through the Owner's electronic bidding system.

All bids must be accompanied by a Bid Guaranty and Contract Bond for the full amount of the bid (including all add alternates) as described in the Information and Requirements for Bidders. If State or Federal Labor Standards Provisions and State Wage Decisions are applicable to this project it will be a part of the Contract Documents.

All bids must be accompanied by a preliminary planned schedule on proposed work and timelines involved with each phase of the project on when they plan to start, duration and complete each.

No Bidder may withdraw its bid within sixty (60) days after the bid opening. The Owner reserves the right to waive irregularities in bids, to reject any or all bids, and to conduct such investigation as necessary to determine the lowest and best bidder for each contract.

Tom Komlanc, Director of Engineering

Advertise: January 23, 2024 & January 30, 2024

INFORMATION AND REQUIREMENTS FOR BIDDERS

Information and Requirements for Bidders Coversheet (the "Coversheet")

Each Bidder shall be responsible for submitting its Bid in accordance with the instructions in this Information and Requirements for Bidders, for the bid opening, before **11 AM** (local time) on **February 13, 2024** (the "Bid Deadline").

The Bid shall be submitted through the Owner's electronic bidding system, as its sole method of bid submission for projects and contracts that are subject to competitive bidding. Bidders new to the Owner's electronic bidding system must first register on the BidExpress website (www.bidexpress.com) to create an InfoTech Digital ID which is used to digitally sign bids. Registration is free. It can take up to five (5) business days to process a Digital ID and it is highly recommended that a Digital ID be enabled 48 hours in advance of submitting an electronic bid. Bidders must plan accordingly. For additional guidance regarding the Owner's electronic bidding system, bidders must contact Bid Express directly. Each Bidder shall be responsible for submitting its electronic Bid as instructed by the Owner, before the Bid Deadline.

The Design Professional (referred to as the "Design Professional" or "Engineer" in the Contract Documents) is:

Phone: _____

Fax: _____

If no other individual is named, then the Director of Engineering shall be considered to be the Project Design Professional.

The Design Professional's Representative is Tom Komlanc, tom.komlanc@gahanna.gov

The Project and Work for the Project consists of all labor, materials, equipment, and services necessary for the **2024 Street and Sidewalk Program, ST-1110** (the "Project").

The Date for Substantial Completion is **August 2, 2024 (Street Program) & November 25, 2024 (Golf Course Paths)**

The total estimated construction cost for the base bid Work on the Project for which bids are being solicited at this time is: **\$4,831,000 (base bid); \$33,000 (Alternate 1 Additional Crack Seal & Micro Surface); \$277,000 (Alternate 2 Golf Course Paths); & \$56,000 (Alternate 3 Additional Striping)**

A complete set of the Contract Documents may be obtained through the Owner's electronic bidding system.

- A. BIDDER'S PLEDGE AND AGREEMENT
- B. EXAMINATION OF CONTRACT DOCUMENTS AND SITE CONDITIONS AND RELIANCE UPON TECHNICAL DATA
- C. OWNER & DESIGN PROFESSIONAL
- D. PROJECT
- E. WORK
- F. ESTIMATE OF COST
- G. CONTRACT DOCUMENTS
- H. PREPARATION OF BIDS
- I. METHOD OF AWARD
- J. EXECUTION OF CONTRACT
- K. SUBSTITUTIONS/NON-SPECIFIED PRODUCTS
- L. ALTERNATES
- M. UNIT PRICES
- N. ADDENDA
- O. INTERPRETATION
- P. STATE SALES AND USE TAXES
- Q. DATE FOR SUBSTANTIAL COMPLETION/LIQUIDATED DAMAGES
- R. OWNER'S RIGHT TO WAIVE DEFECTS AND IRREGULARITIES
- S. MODIFICATION/WITHDRAWAL OF BIDS
- T. COMPLIANCE WITH APPLICABLE LAWS
- U. FINDINGS FOR RECOVERY
- V. PREVAILING WAGES
- W. FEDERAL FUNDING
- X. OHIO PUBLIC WORKS COMMISSION FUNDING

A. BIDDER'S PLEDGE AND AGREEMENT

1. Each Bidder acknowledges that this is a public project involving public funds and that the Owner expects and requires that each successful Bidder adhere to the highest ethical and performance standards. Each Bidder by submitting a bid pledges and agrees that (a) it will act at all times with absolute integrity and truthfulness in its dealings with the Owner and the Design Professional, (b) it will use its best efforts to cooperate with the Owner and the Design Professional and all other Contractors on the Project and at all times will act with professionalism and dignity in its dealings with the Owner, Design Professional, and other Contractors, (c) it will assign only competent supervisors and workers to the Project, each of whom is fully qualified to perform the tasks that are assigned to him/her, and (d) it has read, understands and will comply with the terms of the Contract Documents.

B. EXAMINATION OF CONTRACT DOCUMENTS AND SITE CONDITIONS AND RELIANCE UPON TECHNICAL DATA

1. Each Bidder shall have a competent person carefully and diligently review each part of the Contract Documents, including the Divisions of the Specifications and parts of the Drawings that are not directly applicable to the Work on which the Bidder is submitting its bid. By submitting its bid, each Bidder represents and agrees, based upon its careful and diligent review of the Contract Documents, that it is not aware of any conflicts, inconsistencies, errors, or omissions in the Contract Documents for which it has not notified the Design Professional in writing at least seven (7) days prior to the bid opening. If there are any such conflicts, inconsistencies, errors, or omissions in the Contract Documents, the Bidder (i) will provide the labor, equipment, or materials of the better quality or greater quantity of Work and/or (ii) will comply with the more stringent requirements. The Bidder will not be entitled to any additional compensation for any conflicts, inconsistencies, errors, or omissions that would have been discovered by such careful and diligent review, unless it has given prior written notice to the Design Professional.
2. Each Bidder shall have a competent person carefully and diligently inspect and examine the entire site and the surrounding area, including all parts of the site applicable to the Work for which it is submitting its bid, including location, condition, and layout of the site and the location of utilities, and carefully correlate the results of the inspection with the requirements of the Contract Documents. The Bidder's bid shall include all costs attributable to site and surrounding area conditions that would have been discovered by such careful and diligent inspection and examination of the site and the surrounding area, and the Bidder shall not be entitled to any Change Order, additional compensation, or additional time on account of such conditions.
3. The Bidder may rely upon the general accuracy of any technical data included in the Project Manual (e.g., soils exploration reports, soil boring logs, site survey, or abatement reports) in preparing its bid, but such technical data are not part of the Contract Documents. Except for the limited reliance described in the preceding sentence, Bidder may not, if awarded a contract for the Work, rely upon or make any Claim against the Owner or Design Professional, or any of their agents or employees, with respect to any of the following:
 - (a) the completeness of such reports and drawings for Bidder's purposes, including, but not limited to, any aspects of the means, methods, techniques, sequences, and procedures of construction to be employed by the successful Bidder and safety precautions and programs incident thereto;
 - (b) other data, interpretations, opinions, and information contained in such reports or shown or indicated in such drawings; or

- (c) any interpretation by the successful Bidder of or conclusion drawn from any technical data or any such other data, interpretations, opinions, or information. For example, all interpolations and extrapolations of data performed by the Bidder to estimate locations or quantities of subsurface strata are independent factual assumptions, which Owner does not warrant.
- 4. Each Bidder will be deemed to have actual knowledge of all information provided or discussed at the pre-bid meeting.

C. OWNER & DESIGN PROFESSIONAL

- 1. The Owner is:
 - City of Gahanna
 - Telephone: 614-342-4050
 - Fax: 614-342-4100

The Owner's Representative is **Tom Komlanc**.

- 2. The Design Professional (referred to as the "Design Professional" or "Engineer" in the Contract Documents) is set forth in the Coversheet.

D. PROJECT

- 1. The Project and Work for the Project consists of all labor, materials, equipment, and services necessary for the Project as identified in the Coversheet, all in accordance with the Drawings and Specifications prepared by the Design Professional. The Project will be substantially complete by the Date for Substantial Completion, identified in the Coversheet.

E. WORK

- 1. The Project consists of the contract(s) for work on the Project identified in the Coversheet. Individual bid package estimates are provided for the Bidder's information only.

F. ESTIMATE OF COST

- 1. The total estimated construction cost for the base bid Work on the Project for which bids are being solicited at this time is set forth in the Coversheet.

G. CONTRACT DOCUMENTS

1. The Contract Documents consist of the Contract Documents listed in Section 1 of the Owner-Contractor Agreement.

A complete set of the Contract Documents may be obtained through the Owner's electronic bidding system.

Bidders shall use complete sets of Contract Documents in preparing bids. Neither the Owner nor the Design Professional assumes any responsibility for errors or misinterpretations resulting from the use of incomplete sets of Contract Documents.

The Owner or the Design Professional, in making the Contract Documents available on the above terms, does so only for the purpose of obtaining bids on the Work and does not confer a license or grant for any other use.

H. PREPARATION OF BIDS

1. All bid documents in **Appendix C** must be completed and submitted at the time of the bid opening including but not limited to a Bid Guaranty. See Section H.7 below. All bids must be submitted on the Bid Form furnished with the Contract Documents.
2. Fill in all blank spaces, in ink or typewritten, in words and figures, and in figures only where no space is provided for words: sign the Bid Form. The wording on the Bid Form shall be used without change, alteration, or addition. Any change in the wording or omission of specified accompanying documents may cause the bid to be rejected. If there is an inconsistency or conflict in the bid amount, the lowest amount shall control, whether expressed in numbers or words.
3. Bidders shall note receipt of all Addenda by signing and including as an attachment under the Contractor's Qualifications Statement (Additional Material) section on BidExpress. If the Bidder fails to acknowledge receipt of each Addendum, the Bid shall be deemed non-responsive, unless the Bid amount clearly and unambiguously reflects receipt of the Addendum or the Addendum involves only a matter of form and does not affect the price, quantity, or quality of the Work to be performed in any material manner.
4. Each Bidder shall submit their bid only through the Owner's electronic bidding system as set forth in the Coversheet. A Bidder that is a corporation shall sign its bid with the legal name of the corporation followed by the name of the state of incorporation and the legal signature of an officer authorized to bind the corporation to a contract.
5. The completed Bid Form shall be accompanied by the following documents: All bid documents in **Appendix C** located on BidExpress.
6. The Bidder shall take the following precautions in preparing its bid:
 - a. Sign the bid and check to insure all blank spaces have been filled in with requested information and the specified accompanying documents (listed in Item 5 above).
 - b. When the Bid Form provides for quoting either an addition or deduction for an Alternate item, indicate whether the sum named is an addition or deduction. If it is not indicated, it will be conclusively presumed that the amount is a deduction.
 - c. When the Bid Form provides for quoting a unit price, the Bidder should quote the unit price as set forth in the Bid Documents.
 - d. When applicable, make sure that the Bid Guaranty is properly executed and signed by:

- 1) The Bidder
 - 2) The Surety or Sureties
- e. The form of Bid Guaranty must be a Bid Guaranty and Contract Bond and the amount may be left blank; if an amount is inserted, it must equal the total of the base bid and all add alternates included. If an amount is inserted, the failure to state an amount equal to or greater than the total of the base bid and all add alternates that are accepted shall make the bid non-responsive.
 - f. Make sure that the appropriate bid package and scope of work is inserted in the correct space on the Bid Guaranty and Contract Bond Form. Failure to include work covered by the bid submitted may make the bid non-responsive.
 - g. Combination Bids. The Owner may provide the option of submitting a combination bid on the Bid Form.
 - (1) When there is an option for submitting a combination bid on the Bid Form, a Bidder desiring to submit a combination bid for two or more bid packages shall include both of the following on the Bid Form:
 - (a) the combination bid amount in the space provided, identifying the bid packages included in the combination bid amount; AND
 - (b) separate base bids for each bid package, including alternates, included in the combination bid in the places provided on the Bid Form for the individual bid packages.

NOTE: The individual cost amounts of each base bid need not total the combination bid amount.

7. Bonds and Guarantees

- a. Bid Guaranty: Bidder shall furnish a Bid Guaranty, in the form of a bond for the full amount of the bid in the form of the Bid Guaranty and Contract Bond included in the Contract Documents. Failure to include the Bid Guaranty in such form may make the bid non-responsive. The Bid amount shall be the total of all sums bid, including all add alternates with no deduction for any deduct alternates. NOTE: AIA Bid Bond forms are not acceptable. Alternate bid guaranty forms are not acceptable.
- b. The bond must be issued by a surety company ("Surety") authorized by the Ohio Department of Insurance to transact business in the State of Ohio and acceptable to the Owner. The bond must be issued by a Surety capable of demonstrating a record of competent underwriting, efficient management, adequate reserves, and sound investments. These criteria will be deemed to be met if the Surety currently has an A.M. Best Company Policyholders Rating of "A-" better and has or exceeds the Best Financial Size Category of Class VI. Other Sureties may be acceptable to the Owner, in its sole discretion.
- c. All bonds shall be signed by an authorized agent of an acceptable Surety and by the Bidder.
- d. Surety bonds shall be supported by credentials showing the Power of Attorney of the agent, a certificate showing the legal right of the Surety to do business in the State of Ohio, and a financial statement of the Surety.
- e. The Bid Guaranty, as applicable, shall be in the name of or payable to the order of the Owner.

- f. The name, address, and telephone and fax numbers of the Surety and the Surety's Agent should be typed or printed on each bond.

I. METHOD OF AWARD

1. All bids shall remain open for acceptance for sixty (60) days following the day of the bid opening, but the Owner may, in its sole discretion, release any bid and return the Bid Guaranty prior to that date. The Bid Guaranty shall be subject to forfeiture, as provided in the Ohio Revised Code, if a bid is withdrawn during the period when bids are being held.
2. The Owner reserves the right to reject any, part of any, or all bids and to waive any informalities and irregularities. The Bidder expressly acknowledges this right of the Owner to reject any or all bids or to reject any incomplete or irregular bid. The Owner will award a single contract for each of the bid packages listed above or one or more combined contracts for combinations of the Bid Packages, unless it determines to reject one or more bid packages. Bidders must furnish all information requested on or accompanying the Bid Form. Failure to do so may result in disqualification of the bid.
3. Determination of the Bidder Submitting the Lowest and Best Bid. Subject to the right of the Owner to reject any or all bids, the Owner will award the Contract for the Work to the Bidder submitting the lowest and best bid, taking into consideration accepted alternates. In evaluating bids, the Owner may consider the qualifications of the Bidders, whether or not the bids comply with the prescribed requirements, and alternates and unit prices, if requested, on the Bid Form. The Owner may also consider the qualifications and experience of subcontractors and suppliers. The Owner may conduct such investigations as are deemed necessary to establish the qualifications and financial ability of the Bidder and its subcontractors and suppliers. The factors the Owner may consider in determining which Bidder submitted the lowest and best bid or which Bidders submitted the lowest and best bids include the factors set forth below. The Owner, in its discretion, may consider and give such weight to these criteria as it deems appropriate.
 - a. The Bidder's work history. The Bidder should have a record of consistent customer satisfaction and of consistent completion of projects, including projects that are comparable to or larger and more complex than the Owner's Project, on time and in accordance with the applicable Contract Documents, and the Bidder's claims history. If the Bidder's management operates or has operated another construction company, the Owner may consider the work history of that company in determining whether the Bidder submitted the lowest and best bid.

The Owner may consider the Bidder's prior experience on other projects with the Owner and Design Professional, including the Bidder's demonstrated ability to complete its work on these projects in accordance with the Contract Documents and on time, and will also consider its ability to work with the Owner and Design Professional as a willing, cooperative, and successful team member.

The Bidder authorizes the Owner and its representatives to contact the owners and design professionals (and construction managers, if applicable) on projects on which the Bidder has worked and authorizes and requests such owners and design professionals (and construction managers) to provide the Owner with a candid evaluation of the Bidder's performance. By submitting its bid, the Bidder agrees that if it or any person, directly or indirectly, on its behalf or for its benefit brings an action against any of such owners or design professionals (or construction managers) or the employees of any of them as a result of or related to such candid evaluation, the Bidder will indemnify and hold harmless such owners, design professionals (and construction managers) and the

employees of any of them from any claims whether or not proven that are part of or are related to such action and from all legal fees and expenses incurred by any of them arising out of or related to such legal action. This obligation is expressly intended for the benefit of such owners, design professionals (and construction managers), and the employees of each of them.

- b. The Bidder's financial ability to complete the Contract successfully and on time without resort to its Surety.
 - c. The Bidder's prior experience with similar work on comparable or more complex projects.
 - d. The Bidder's prior history for the successful and timely completion of projects, including the Bidder's history of filing and having claims filed against it.
 - e. The Bidder's equipment and facilities.
 - f. The adequacy, in numbers and experience, of the Bidder's work force to complete the Contract successfully and on time.
 - g. The Bidder's compliance with federal, state, and local laws, rules, and regulations, including but not limited to the Occupational Safety and Health Act, the Ohio Prevailing Wage laws, and Ohio ethics laws.
 - h. The foregoing information with respect to each of the Subcontractors and Suppliers that the Bidder intends to use on the Project.
 - i. The Bidder's participation in a drug-free workplace program acceptable to the Owner, and the Bidder's record for both resolved and unresolved findings of the Auditor of State for recovery as defined in Section 9.24 of the Ohio Revised Code.
 - j. The Owner's prior experience with the Bidder's surety.
 - k. The Bidder's interest in the Project as evidenced by its attendance at any pre-bid meetings or conferences for bidders.
 - l. The Bidder's ability to self-perform the work on the Project with the Bidder's own forces.
 - m. Depending upon the type of the work, other essential factors, as the Owner may determine and as are included in the Specifications.
- 4. Within three (3) business days after the Owner's identification of the apparent low bidder, if requested, the apparent low bidder will complete and submit to the Design Professional a completed Contractor's Qualification Statement (using the form included in the Project Manual), and thereafter will provide the Design Professional with such additional information as the Design Professional may request regarding the Bidder's qualifications. Additionally, upon request from the Design Professional, any other Bidder will promptly complete and submit to the Design Professional a completed Contractor's Qualification Statement and thereafter will provide the Design Professional with such additional information as the Design Professional may request regarding the Bidder's qualifications. A Bidder will submit any requested information within three (3) business days of the date of the request.
 - 5. The failure to submit requested information on a timely basis may result in the determination that the Bidder is not the lowest and best bidder.
 - 6. By submitting its bid, the Bidder agrees that the Owner's determination of which bidder is the lowest and best bidder shall be final and conclusive, and that if the Bidder or any person or association on its behalf challenges such determination in any legal proceeding, the Bidder shall indemnify and hold the Owner and its employees and agents harmless from any claims

included in or related to such legal proceeding, whether or not proven, and from legal fees and expenses incurred by the Owner, its employees, or agents that arise out of or are related to such challenge.

7. Within three (3) business days of receipt of the bids or such longer time as may be permitted in writing by the Design Professional, the apparent low Bidder will submit a list of all proposed Subcontractors and Suppliers.

After approval by the Owner and Design Professional of the list of proposed Subcontractors, Suppliers, and manufactures submitted by the successful Bidder, the list shall not be changed unless written approval of the change is authorized by the Owner and Design Professional.

8. Affidavit as to Personal Property Taxes. Each successful Bidder shall submit, prior to the time of the entry into the Contract, an affidavit in the form required by Section 5719.042, Ohio Revised Code, regarding the status of the Bidder's personal property taxes. A copy of the affidavit form is included with the Contract Documents.
9. No Bidder may withdraw its bid within sixty (60) days after the date bids are opened. The Owner reserves the right to waive any formalities or irregularities or to reject any or all bids.
10. The Owner reserves the right to disqualify bids, before or after opening, upon evidence of collusion with intent to defraud or other illegal practices on the part of the Bidder.
11. Award of Contract. The award of the Contract, when required, will only be made pursuant to a duly adopted resolution of the Owner.

J. EXECUTION OF CONTRACT

1. Within 10 days after award of the Contract, the successful Bidder shall execute and deliver to the Design Professional the required number of copies of the Owner-Contractor Agreement, in the form included in the Contract Documents, and all accompanying documents requested, including, but not limited to, a Contract Bond (if applicable), insurance certificates, and a valid Workers' Compensation Certificate. The award of Contract notwithstanding, the successful Bidder shall have no property interest or rights under the Owner-Contractor Agreement until such time as the Owner-Contractor Agreement is executed by the successful bidder and the Owner.

K. SUBSTITUTIONS/NON-SPECIFIED PRODUCTS

1. Certain brands of material or apparatus may be specified. Each bid will be based on these brands, which may be referred to in the Contract Documents as Standards. The use of another brand (referred to as a substitution or proposed equal in the Contract Documents, when a bidder or the contractor seeks to have a different brand of material or apparatus than that specified approved by the Owner for use in the Project) may be requested as provided herein. Substitutions, however, will not be considered in determining the lowest and best bid.
2. The products specified in the Contract Documents establish a standard of required function, dimension, appearance, and quality.
3. Bidders wishing to obtain approval to bid non-specified products shall submit written requests to the Design Professional a minimum of ten (10) working days before the bid date and hour. To facilitate the submission of requests, the Bidder shall submit a form that includes the name of the material or equipment for which it is to be substituted and a complete description of the proposed substitution, including the name of the proposed manufacturer and/or product and a complete description of the proposed product including manufacturer's name and model number or system proposed, drawings, product literature, performance and test data, color selections or limitations, and any other information necessary for evaluation.

Include a statement including any changes in other materials, equipment, or other work that would be required if the proposed product is incorporated in the materials, equipment, or other work that would be required if the proposed product is incorporated in the work. The burden of proof of the merit of the proposed product is on the proposer. The Design Professional's decision on approval of a proposed product will be final.

The following will be cause for rejection of a proposed substitution:

- a. Requests submitted by subcontractors, material suppliers, and individuals other than Bidders;
 - b. Requests submitted without adequate documentation;
 - c. Requests received after the specified cut-off date.
4. When the Design Professional approves a product submission before receipt of bids, the approval will be included in an Addendum, and Bidders may include the pricing of this product in their bid. Bidders shall not rely on approvals made in any other manner.
 5. In proposing a non-specified product or a substitution, the Bidder represents and warrants that each proposed product will not result in any changes to the Project, including changes to the Work of other contractors, or any decrease in the performance of any equipment or systems to be installed in the Project and agrees to pay any additional costs incurred by the Owner and the Owner's consultants as a result of a non-specified or substitute product that is accepted.
 6. Following the award of the Contract, there shall be no substitutions for specified products, except pursuant to a Change Order. The Owner in its sole discretion may decline to consider a substitution for a Change Order.

L. ALTERNATES

1. The Owner may request bids on alternates. If the Owner requests bids on alternates, the Bidder should include the cost of the alternates requested on its Bid Form.
2. At the time of awarding the contract, the Owner will select or reject alternates as it determines is in its best interest. A Bidder's failure to include on its Bid Form the cost of an alternate selected by the Owner and applicable to the Bidder's work shall render the bid non-responsive and be grounds for the rejection of the bid. Otherwise, the failure to include the cost of an alternate will not be deemed material.
3. The Bidder acknowledges that although there is an estimate for the cost of the Project, the market conditions may and frequently do result in the estimate being different from the sum of the bids received, either higher or lower. The Bidder understands that the Owner may include alternates, which may include deduct alternates as well as add alternates, to give it flexibility to build the Project with the funds available. The Bidder further understands and acknowledges that use of add and deduct alternates is a long held customary practice in the construction industry in the State of Ohio. The Bidder also acknowledges that the Owner will not make a decision about the alternates on which to base the award of contracts until the bids are received, and the Owner can compare its available funds with the base bids and the cost or savings from selecting different alternates. The Bidder understands that the award to the Bidder submitting the lowest and best bid will be based on the lowest base bid plus selected alternates, and may result in an award to a Bidder other than the Bidder that submitted the lowest base bid.

4. If, during the progress of the Work, the Owner desires to reinstate any alternate not included in the Contract, the Owner reserves the right to reinstate the alternate at the price bid by the Contractor provided that such action is taken in sufficient time so as not to delay the progress of the work or cause the Contractor additional expense.

M. UNIT PRICES

1. Where unit prices are requested in the Bid Form for a Prime Contract on which the Bidder submits a bid, the Bidder should quote a unit price. Unless otherwise expressly provided in the Bid Documents, such unit prices shall include all labor, materials, and services necessary for the timely and proper installation of the item for which the unit prices are requested. The unit prices quoted in the bid shall be the basis for any Change Orders entered into under the Owner-Contractor Agreement, unless the Design Professional determines that the use of such unit prices will cause substantial inequity to either the Contractor or the Owner.

N. ADDENDA

1. The Owner reserves the right to issue Addenda changing, altering, or supplementing the Contract Documents prior to the time set for receiving bids. Addenda may be issued to clarify bidders' questions and/or to change, alter, or supplement the Contract Documents.
2. Any explanation, interpretation, correction, or modification of the Contract Documents will be issued in writing in the form of an Addendum, which shall be the only means considered binding; explanations, interpretations, etc., made by any other means shall NOT be legally binding. All Addenda shall become a part of the Contract Documents.
3. Bidders shall submit written questions to the Design Professional in sufficient time in advance of the bid opening to allow sufficient time for the Design Professional to respond. The Owner—after consultation with the Design Professional—shall in its sole discretion determine whether or not an Addendum will be issued. All Addenda will be issued, except as hereafter provided, through the Owner's electronic bidding system to all bidding plan holders, at least (72) hours prior to the published time for the opening of bids, excluding Saturdays, Sundays, and legal holidays. If any Addendum is issued within such seventy-two (72) hour period, then the time for opening of bids shall be extended one (1) week with no further advertising of bids required unless otherwise noted in the Addendum.
4. Copies of each Addendum will be sent only to the Bidders to whom Contract Documents have been issued and to Plan Rooms where copies of the Contract Documents are maintained. Receipt of Addenda shall be indicated by Bidders in the space provided on the Bid Form. Bidders are responsible for acquiring issued Addenda in time to incorporate them into their bid. Bidders should contact the Design Professional prior to the bid opening to verify the number of Addenda issued.
5. Each Bidder shall carefully read and review the Contract Documents and immediately bring to the attention of the Design Professional any error, omission, inconsistency, or ambiguity therein.
6. If a Bidder fails to indicate receipt of all Addenda through the last Addendum issued by the Design Professional on its Bid Form, the bid of such Bidder will be deemed to be responsive only if:
 - a. The bid received clearly indicates that the Bidder received the Addendum, such as where the Addendum added another item to be bid upon and the Bidder submitted a bid on that item; or

- b. The Addendum involves only a matter of form or is one which has either no effect or has merely a trivial or negligible effect on price, quantity, quality, or delivery of the item bid upon.

O. INTERPRETATION

1. If a Bidder contemplating submitting a bid for the proposed Project is in doubt as to the true meaning of any part of the Contract Documents, it may submit a written request for an interpretation thereof to the Design Professional a minimum of five (5) business days prior to the Bid opening date. Any interpretation of the proposed documents will be made by Addendum only, duly signed by the Design Professional, and a copy of such Addendum will be delivered to each Bidder receiving a set of Contract Documents or that has asked to be added to the plan holders list. Addenda and clarifications will be sent via email, unless a different delivery method is requested. The Owner will not be responsible for any other explanation or interpretation of the proposed documents.
2. In interpreting the Contract Documents, words describing materials that have a well-known technical or trade meaning, unless otherwise specifically defined in the Contract Documents, shall be construed in accordance with the well-known meaning recognized by the trade.
3. Bidders are responsible for notifying the Design Professional in a timely manner of any ambiguities, inconsistencies, errors, or omissions in the Contract Documents. The Bidder shall not, at any time after the execution of the Contract, be compensated for a claim alleging insufficient data, incomplete Contract Documents, or incorrectly assumed conditions regarding the nature or character of the Work, if no request was made by the Bidder prior to the bid opening.

P. STATE SALES AND USE TAXES

1. The Owner is a political subdivision of the State of Ohio and is exempt from taxation under the Ohio Sales Tax and Use Tax Laws. Building materials that the successful Bidder purchases for incorporation into the Project will be exempt from state sales and use taxes if the successful Bidder provides a properly completed Ohio Department of Taxation Construction Contract Exemption Certificate to the vendors or suppliers when the materials are acquired. The Owner will execute properly completed certificates on request.

Q. DATE FOR SUBSTANTIAL COMPLETION/LIQUIDATED DAMAGES

1. Date for Substantial Completion. Each successful Bidder shall have its Work on the Project Substantially Complete (as Substantial Completion is defined in the Contract Documents) by the Date of Substantial Completion set forth in the Coversheet, or within the Contract Time, as applicable to the Bidder's scope of work.

The Contract Time shall run from the date of the Notice to Proceed or if there is no Notice to Proceed from the Effective Date of the Owner- Contractor Agreement. The Date for Substantial Completion Date and the Contract Time may be extended only by Change Order, by other Modification, or by a Claim that is Finally Resolved. By submitting its Bid, each Bidder agrees that the period for performing its Work is reasonable.

2. Liquidated Damages. If the successful Bidder does not have its Work Substantially Complete by its Date for Substantial Completion and/or Finally Complete within forty-five (45) days of achieving Substantial Completion, whichever may be applicable, the successful Bidder shall pay the Owner and the Owner may set off from amounts otherwise due the successful Bidder Liquidated Damages. The daily amounts of Liquidated Damages are set forth in the tables

included in the Owner-Contractor Agreement. The total amounts of Liquidated Damages will be calculated based on the total number of calendar days beyond the Date for Substantial Completion that the Bidder's Work is not Substantially Complete and/or to the extent that its Work is not Finally Complete more than forty-five (45) after the Substantial Completion of its Work, i.e., number of late days times the per diem rate(s) for Liquidated Damages in the tables. In addition to such Liquidated Damages, the Bidder shall indemnify, defend, and hold the Owner and its employees and agents harmless from any and all claims, whether or not such claims are proven, and from all costs and expenses incurred as a result of such claims, including but not limited to attorneys' and consultants' fees and expenses, that arise out of or are related to the Bidder's failure to Substantially Complete its Work by its Date for Substantial Completion. The Bidder's obligations under this Section are joint and several.

3. The Bidder acknowledges and agrees, by submitting its bid for the Work and entering into a Contract with the Owner, that such amounts of Liquidated Damages represent a reasonable estimate of the actual damages for loss of or interference with the intended use of the Project that the Owner would incur if the Bidder's Work is not Substantially Complete by its Date for Substantial Completion and/or not Finally Complete by forty-five (45) days of the Date of Substantial Completion. The Bidder further acknowledges, agrees and understands that it may seek an extension of the Contract Time (and its Date for Substantial Completion) to avoid or reduce Liquidated Damages by properly following the Claim procedures in the Contract Documents.

R. OWNER'S RIGHT TO WAIVE DEFECTS AND IRREGULARITIES

1. The Owner reserves the right to waive any and all irregularities provided that the defects and irregularities do not affect the amount of the bid in any material respect or otherwise give the Bidder a competitive advantage.

S. MODIFICATION/WITHDRAWAL OF BIDS

1. Modification. A Bidder may modify its bid by written communication to the Owner addressed to the Owner's Representative at any time prior to the scheduled closing time for receipt of bids, provided such written communication is received by Owner's Representative prior to the bid deadline. The written communication shall not reveal the bid price, but should provide the addition or subtraction or other modification so that the final prices or terms will not be known until the sealed bid is opened. If the Bidder's written instructions with the change in bid reveal the bid amount in any way prior to the bid opening, the bid may be rejected as non-responsive.
2. Withdrawal Prior to Bid Deadline. A Bidder may withdraw its bid at any time for any reason prior to the bid deadline for the opening of bids established in the Legal Notice. The request to withdraw shall be made in writing to and received by the Owner's Representative prior to the time of the bid opening.
3. Withdrawal after Bid Deadline.
 - a. All bids shall remain valid and open for acceptance for a period of at least 60 days after the bid opening; provided, however, that a Bidder may withdraw its bid from consideration after the bid deadline when all of the following apply:
 - (1) the price bid was substantially lower than the other bids;
 - (2) the reason for the bid being substantially lower was a clerical mistake, rather than a mistake in judgment, and was due to an unintentional and substantial error in

arithmetic or an unintentional omission of a substantial quantity of work, labor, or material;

- (3) the bid was submitted in good faith; and
 - (4) the Bidder provides written notice to the Owner, to the attention of the Owner's Representative, within two (2) business days after the bid opening for which the right to withdraw is claimed.
- b. No bid may be withdrawn under this provision if the result would be the awarding of the contract on another bid for the bid package from which the Bidder is withdrawing its bid to the same Bidder.
 - c. If a bid is withdrawn under this provision, the Owner may award the Contract to another Bidder determined by the Owner to be the lowest and best bidder or the Owner may reject all bids and advertise for other bids. In the event the Owner advertises for other bids, the withdrawing Bidder shall pay the costs incurred in connection with the rebidding by the Owner, including the cost of printing new Contract Documents, required advertising, and printing and mailing notices to prospective bidders, if the Owner finds that such costs would not have been incurred but for such withdrawal.

T. COMPLIANCE WITH APPLICABLE LAWS

1. By submitting a bid for Work on the Project, the Bidder acknowledges that it is in compliance with applicable federal, state, and local laws and regulations, including, but not limited to, the following:
 - a. Equal Employment Opportunity/Nondiscrimination. The Bidder agrees that if it is awarded a contract that in the hiring of employees for performance of work under the contract or any subcontract, neither it nor any subcontractor, or any person acting on its behalf or its subcontractor's behalf, by reason of race, creed, sex, disability as defined in Section 4112.01 of the Ohio Revised Code, or color, shall discriminate against any citizen of the state in the employment of labor or workers who are qualified and available to perform work to which the employment relates. The Bidder further agrees that neither it nor any subcontractor or any person on its behalf or on behalf of any subcontractor, in any manner, shall discriminate against or intimidate any employees hired for the performance of the work under the contract on account of race, creed, sex, disability as defined in Section 4112.01 of the Ohio Revised Code, or color.
 - b. Ethics Laws. The Bidder represents that it is familiar with all applicable ethics law requirements, including without limitation Sections 102.04 and 3517.13 of the Ohio Revised Code, and certifies that it is in compliance with such requirements.

U. FINDINGS FOR RECOVERY

1. By submitting its bid, each Bidder certifies for reliance of the Owner that it has no unresolved finding for recovery against it issued by the Auditor of the State of Ohio on or after January 1, 2001, except as permitted by Section 9.24 (F) of the Ohio Revised Code.

V. PREVAILING WAGES

1. For "Construction" projects as defined in Section 4115.03 of the Ohio Revised Code, the successful Bidder and all of its subcontractors, regardless of tier, will strictly comply with its obligation to pay a rate of wages on the Project not less than the rate of wages fixed for this Project under Section 4115.04 of the Ohio Revised Code. Additionally, for such "Construction Projects," the successful Bidder will comply with all other provisions of Chapter 4115 of the

Ohio Revised Code. Where Federal prevailing wage rates apply the successful Bidder and all of its subcontractors, regardless of tier, will strictly comply with its obligation to pay a rate of wages on the Project not less than the rate of wages fixed for this Project under the applicable Federal law. See **Appendix B**.

W. FEDERAL FUNDING

1. If the Project is subject to terms as a result of federal funding, it will be indicated in the Contract Documents.

X. OHIO PUBLIC WORKS COMMISSION FUNDING

1. For projects funded in whole or in part by the Ohio Public Works Commission, the State of *Ohio Equal Employment Opportunity Requirements and Bid Conditions for OPWC-Assisted Construction Projects* shall apply and Bidders must conform to its requirements, including but not limited to furnishing the required certifications with Bidder's bid. These requirements are included in the bid documents.

APPENDIX A

SUPPLEMENTARY SPECIFICATIONS

**2024 STREET & SIDEWALK PROGRAM, ST-1110
SUPPLEMENTAL SPECIFICATIONS**

PROPOSAL – No extra compensation will be paid to the contractor by reason of compliance with any of the requirements indicated in the specifications, but payment shall be deemed to be included among the several items, as bid upon, unless otherwise specifically provided.

COMPLETION DATE – The work under this contract shall be completed in a manner acceptable to the City on or before the date listed in the Notice to Bidders unless an extension of time is granted in writing by the Director of Engineering.

REFERENCE SPECIFICATIONS – The requirements of the City of Gahanna, together with the "Construction and Material Specifications, City of Columbus, Ohio" including all supplements thereto in force on the date of the contract, shall govern all materials and workmanship involved in the improvements, except as such specifications are modified herein.

ITEM 203 EXCAVATION – This item shall include the removal of existing pavement, expansion joints, additional subgrade, abandoned gas piping, and curbs as identified by the Engineer, and any other miscellaneous excavation necessary for the reconstruction of the roadway. Disposal of excavated materials shall be the responsibility of the Contractor.

Also included under this item shall be subgrade fine grading and compaction and any saw cutting necessary between remaining sections and the sections to be removed. Notifications to residents by contractor per schedule provided by the City. Payment for this item will be made at the contract lump sum price.

ITEM 254 PLANING – In accordance with the City of Columbus Construction and Material Specifications. Prior to asphalt concrete placement, all loose material shall be removed and disposed of by the Contractor. The edges of the remaining asphalt concrete shall be painted with RS-1, or an approved equal tack coat.

Planing can be made to a minimum width of 3ft.

The procedure for **1" to 3" Planing** shall be to plane the existing asphalt surface down to the existing concrete surface with the exception of streets with Water-Bound Macadam base where a minimum of ½" of asphalt is to remain. Payment for this item will be made at the contract unit price per square yard.

Known water-bound macadam base streets: None

Butt joints are to be 6' wide at a depth beginning at 2" and tapering to zero to allow for 2" of asphalt to be feathered into an existing asphalt surface. This item shall be included with the unit price bid for ITEM 254 Planing. No separate payment will be made for Butt Joints.

All planed surfaces shall be overlaid within 7 calendar days of planing completion. After the existing surface is planed, "BUMP" signs shall be provided until the surface is overlaid to provide notification of an uneven surface.

ITEM 410 TRAFFIC COMPACTED SURFACE – This item has been included for use in aiding ingress/egress during the construction activities, Traffic Maintenance, and to achieve proper subgrade densities, as directed and approved by the Engineer. Payment for this item will be made at the contract unit price per cubic yard.

ITEM 423 CRACK SEAL – Type I or Type II, in accordance with the City of Columbus Construction and Material Specifications. Payment will be made at the contract unit price per square yard.

ITEM 448 ASPHALT CONCRETE – During the installation of the 448 intermediate and surface asphalt courses, the Contractor must be able to obtain compaction test results that are a minimum of 96% of the Maximum

Theoretical Density. Prior to the start of production, the asphalt supplier shall submit the JMF (Job Mix Formula) proposed for each mix, including the Maximum Theoretical Density values.

During construction, the contractor shall utilize nuclear gauges to continually test the density of the asphalt as it is being installed to ensure that the compaction of the asphalt falls within these ranges. The Contractor shall be responsible for ensuring that proper rolling equipment is utilized to produce the densities specified. In the event the equipment is not capable of producing the densities specified, the placed material shall be removed and replaced at the Contractor's expense. These requirements are in addition to the other requirements contained within the Columbus Construction and Materials Specifications. Contractor is also required to bring any defects, base issues, and possible resolutions to the City's attention during construction and allow the City to decide on best course of action prior to continuation of construction.

All pavement seams and joints shall be crack sealed.

Payment for 448 intermediate and surface courses shall be made at the contract unit bid price per cubic yard according to thickness as specified in the proposal.

Patching is intended to allow for 1-1/2" of asphalt to be placed on top of the milled surface to ensure the transition from the curb ramp to the pavement is compliant, as defined by the Engineer. Payment for this item will be made at the contract unit price per square yard.

ITEM 608 CONCRETE WALK – This work shall include the construction of new sidewalks to the lines, grades, and cross sections required to meet the requirements of ADA and City of Columbus Standard Drawings 2300, where identified in the proposal, shown on the plans, or directed by the Engineer. Concrete walks shall be 4" in thickness and increased to 6" in thickness for residential driveway aprons, and 8" for commercial driveway aprons. On rebuild streets, new sidewalks 5' wide will be installed to PROWAG standards. On overlay streets, sidewalk repairs are to match existing sidewalk widths.

Sidewalks shall be constructed with a 3/16" per foot (1.56%) cross slope. The sidewalk is to be installed in such a manner as to meet the existing drives, in an effort to minimize changes to existing driveways. This item shall include all excavation, removal of existing sidewalk and curb ramps as directed by the project plans or the Engineer including backfill, topsoil, seeding, and disposal of surplus excavation.

Included under this item shall be the adjustment, to grade, of any valve boxes, manholes, or misc. appurtenances encountered during sidewalk construction. The contractor shall furnish and install expansion material around all existing appurtenances and sidewalks as required by the Engineer. Payment for this item will be made at the contract unit price per square foot.

ITEM 608 CURB RAMPS (ADA COMPLIANT RECONFIGURATION) – This work shall include the removal and construction of new concrete curb ramps, including the landing pad and transition panels, at locations specified in the construction documents or as identified by the Engineer. Any concrete curb ramp damaged by the Contractor during construction operations shall be replaced at no additional cost and will be incidental to other work being performed.

Als included under this item shall be the removal and replacement of any stop signs, street name signs, 125 square feet of sidewalk (exclusive of the ramp itself), and 12 linear feet of curb and gutter necessary due to the reconfiguration of the curb ramps for ADA compliance.

Removal of existing curb ramps shall be in accordance with CMSC Item 202. All materials for replacement of curb ramps shall be in accordance with CMSC Item 608. Replacement of concrete curb ramps shall meet the requirements of CMSC Item 608, the Public Right-of-Way Accessibility Guidelines (PROWAG), and specifications identified here within.

Curb ramps shall be constructed to the lines, grades, slopes, and cross sections required to meet ADA compliance. Curb ramps shall conform to the City of Columbus Standard Drawings 2319 Type C, except as modified herein, or otherwise as mutually agreed upon by the Engineer of Record and the City or its authorized agents, or as directed by Engineer. All ramps shall have Type E detectable warnings (Armor Tile panels or approved equal) in accordance with City of Columbus Supplemental Specification 712.14, 1551.01, 1551.02, 1551.03, and 1551.04. The cost of the detectable warnings shall be included in the bid price of the ramp.

Care shall be taken to prevent disturbing the existing pavement. All disturbed pavement shall be repaired with no less than 6" of Columbus Item 448 Type II PG 64-22 asphalt within 10 working days of curb placement at the Contractor's expense.

Completed curb ramps not meeting ADA dimensions and slope requirements shall be reconstructed at the Contractor's expense. If the specifications here within are not met, the contractor must repair to specification at no additional charge within 72 hours of discovery.

Payment for this item shall be made at the unit bid price per ramp. This item shall include adjustment to grade of any valve boxes, manholes, or miscellaneous appurtenances encountered during sidewalk construction; all excavation; removal of existing sidewalk, curb ramps, and curb and gutter as directed by the project plans or Engineer; concrete cutting/sawing; base course material; expansion joint materials; ramp; detectable warnings; flares; backfill; topsoil; seeding and mulching; disposal of surplus excavation, trash, and debris; and any incidentals required to complete the removal and replacement as specified. All disposal is to be completed weekly and will be inspected prior to the weekend.

ITEM 608 CURB RAMPS (TRUNCATED DOME REPLACEMENT) – Curb ramps shall be constructed to the lines, grades, slopes, and cross sections required to meet ADA compliance. Curb ramps shall conform to the City of Columbus Standard Drawings 2319 Type C, except as modified herein or as directed by the Engineer. All ramps shall have Type E detectable warnings (Armor Tile panels or approved equal) in accordance with City of Columbus Supplemental Specification 1551.01, 1551.02, 1551.03, and 1551.04. The cost of the detectable warnings shall be included in the bid price of the ramp. Completed curb ramps not meeting ADA dimensions and slope requirements shall be reconstructed at the Contractor's expense.

This item shall include all excavation and removal of curb ramp truncated domes as directed by the project plans or the Engineer, backfill, seeding and mulching, and disposal of surplus excavation.

Payment for this item shall be made at the unit bid price per ramp. This includes the truncated dome, and all appurtenances required for the replacement, which shall include but not be limited to flared sides, ramp removal and replacement, excavation, restoration, and rolled edges.

ITEM 609 CURB REPLACEMENT – This work shall include the removal and the replacement of combination curb and gutter necessary for the construction of compliant curb ramps or replacement of deteriorated combination curb and gutter sections as identified and marked by the Engineer. Sections of curb to be replaced are to be a minimum length of 4 feet. Areas that pose a hazard will need to be barricaded off while work is not being performed.

Combination curb and gutter shall be installed to the original lines, grades, and cross sections, or when near curb ramps, to the lines, grades, and cross sections required to meet ADA requirements for compliant curb ramps or as directed by the Engineer. Contractor is responsible to check with the City on each street's new curb type prior to starting, as part of the reduction of mountable curbs throughout the City. All existing curb stamps shall be reinstalled in replacement curb sections. When removing curbing across driveway openings, removal must be all at the same time and steel plate (minimum 8' wide) will be provided to maintain resident access during replacement.

This item shall include all excavation; backfill; seeding and mulching; disposal of surplus excavation, trash, debris, and removed curb and gutter; furnishing and installing joint materials; restoration of any damaged

private utilities or property including but not limited to irrigation, invisible dog fences, and mailboxes; and any asphalt patching.

The joint separating the gutter from the street is required to be saw cut in areas where the concrete extends into the area to be paved. The cost of this work is to be included in this item. Also included in this item are any saw cuts necessary to provide a neat joint at the removal limits, as marked by the Engineer. Roof drain openings shall be provided through the curbs at the minimum of one per each side of driveway and for all existing drain lines and prior existing openings not yet used. Roof drains placed for future resident use will have expansion material covering back of curb to prevent soil loss and/or erosion. The cost for providing these openings, and extending all existing drain lines through these openings, shall be included in this item.

Contractor must camera and submit video to the City of all stormwater structures and lines in the construction area both pre- and post-construction on rebuild streets to verify no changes have occurred.

When continuous sections of curb to be replaced exceed 50' in length, the provisions of Item 623 Construction Layout Stakes shall apply. Contractor will not extend length of curbing replacements beyond bid quantities without city prior approval. Contractor will notify city of any additional length quantities and price adjustments prior to proceeding. Contract may choose to perform slip curb installation in place of spot curb replacement at no additional charge if contractor deems it to be of cost savings method.

Payment for this item will be made at the contract unit price per lineal foot of curb replaced.

ITEM 614 MAINTAINING TRAFFIC

Contractor to give Residents notification prior to start as listed by the City. One lane, two-way traffic shall be maintained at all times, except for Restricted Street list: Cam Court, Coldwell Court, Haybrook Drive, Timothy Court, Tim Tam Avenue, Windbourne Street, and Windrow Court. Traffic restrictions on Arterials and Collectors are limited to the hours between 9AM and 3PM, Monday through Friday. All traffic control devices, including lights, signs, and barricades, shall be constructed, erected, and maintained in accordance with the "Ohio Manual of Uniform Traffic Control Devices." Contractor to provide continuous and safe pedestrian traffic routes, signage, and notifications to residents.

Contractor shall perform and finish ALL work relative to sidewalks before performing work in the adjacent roadway. Performing sidewalk work first provides access for the adjacent properties and their residents while the roadway is under construction.

Tim Tam Avenue can be closed to traffic in phases as required for removal and reconstruction of the road. The next phase of a rebuild cannot start until driveway access is permitted for the previous phase and a continuous pedestrian accommodation is made through the zone. All measures should be taken to maintain access to adjacent cul-de-sac's, through phase work, if possible.

Once the road is closed, the construction of the new road shall be continuous so that the roadway can be opened as soon as possible to residents. Closure time shall be kept to a minimum and no longer than 15 business days per phase. Any exception shall be subject to approval in advance by the Engineer. The contractor is responsible for notifying the Engineer or authorized agent and property owners affected by the road rebuilds, resurfacings, and crack seal/slurry seal/microsurface 10 business days and again at 3 business days in advance of the start of construction. **Any associated "No Parking" signs shall be posted a minimum of 3 business days in advance.** "No Parking" signs to include dates and times of parking restrictions. To minimize disruption to the residents, the City will provide a minimum of two (2) wagons per section of rebuild for the entire duration of the road closure.

Unless approved by the City's Director of Engineering, performance of work requiring road closures cannot occur prior to May 28th. Performance of minor work such as survey work, sidewalk replacement/repairs, curb replacement, curb ramps, sidewalks, and similar may occur prior to May 28th. Pedestrian access will need to be maintained on one side of the street at all times with proper signage

and pedestrian traffic controls measures put in place during sidewalk replacements and repairs. Waterline replacement will need to occur prior to any roadway work. Sidewalk replacement will need to be completed prior to roadway work beginning.

Work cannot be performed during the City Events and Holidays. List is available as part of the Supplemental Specifications. Flint Ridge Drive and Olde Ridenour Road shall be open to traffic during the Creekside Blues and Jazz Festival and Independence Day celebration.

A work zone maintenance of traffic plan shall be submitted to the Engineer at the preconstruction conference. All pedestrian traffic must be maintained at all times with temporary signage, crosswalks, and markings to clearly route pedestrians around work zones. Only one side of a street's sidewalks may be worked on at a time to allow pedestrians access and use of safe walking areas during construction. Streets near schools should be scheduled during the summer break times to reduce any pedestrian conflicts.

The contractor shall devise a maintenance of traffic scheme which shall be sealed by a professional engineer, registered in the State of Ohio, and presented and approved by the City of Gahanna at least 15 business days prior to implementation. The maintenance of traffic scheme shall present, in general, the method for conducting the required work in a safe and efficient manner.

Detailed maintenance of traffic plans shall include, but are not limited to, the following components:

- Plan view at an appropriate scale showing:
 - Work area
 - Begin / end stationing of lane width tapers, lane shifts, etc.
 - Location of advance warning and work zone signs, drums, arrow boards, message boards, and/or flaggers
 - References to applicable standard construction drawings
 - Dates and hours of operation

The cost of all lights, signs, barricades, temporary pavement markings, law enforcement officers and watchmen necessary to maintain the aforementioned condition(s) shall be included in the price bid for Item 614 Maintenance of Traffic.

The contractor shall notify the Engineer, the local Fire Department, and the Gahanna Police Department 5 days prior to said closings and shall make provisions for access to the roadway should an emergency require access by either the fire or police department. A quantity of *Item 410 Traffic Compacted Surface* has been included for use in providing and maintaining traffic. The use of this item shall be subject to approval by the Engineer.

After placement of the concrete/roller compacted concrete base, the road shall be opened to traffic within 24 hours. In addition, once the concrete/roller compacted concrete base has been placed, the intermediate and surface courses for Cam Court, Coldwell Court, Haybrook Drive, Timothy Court, Tim Tam Avenue, Windbourne Street, and Windrow Court shall be completed within 7 calendar days.

ITEM 623 CONSTRUCTION LAYOUT STAKES – The Contractor shall provide all staking required to reconstruct Cam Court, Coldwell Court, Haybrook Drive, Timothy Court, Tim Tam Avenue, Windbourne Street, and Windrow Court on present alignment and profile in accordance with the supplied sections within the Appendix, as defined herein, or as directed by the Engineer. All staking shall be completed under the field supervision of a Registered Professional Surveyor. Contractor will submit with their bid package the Registered Professional Surveyor name, State of Ohio professional registration number and company employed by for the City to review. A baseline shall be established at 25-foot stations along each side of the existing curbs to establish horizontal alignment. Elevations of existing profile grade shall be obtained at the 25 foot stations and at curb inlets so that the road can be replaced on present alignment and profile. Survey work must also check to see if any adjustments to street profiles need to be made to maintain compliant driveway approaches, new sidewalk, and curbing within accepted limits allowed per specifications. The existing and proposed grades

shall be submitted to the Engineer, two weeks prior to the start of construction for approval. Payment for this work shall be made at the contract lump sum price.

ITEM 624 MOBILIZATION – To avoid any impacts of work related to the City of Gahanna Sidewalk Maintenance Program, the asphalt resurfacing and associated concrete work on Lincolnshire Road will need to be coordinated. The cost for additional associated mobilizations shall be included in the price bid for Item 624 Mobilization.

ITEM 644 STRIPING – Contractor to notify City 10 business days prior to commencement and signs along designated streets to be posted 3 business days prior to commencement. Notification(s) to the City shall include dates and time(s) of restrictions and starting any and each phase of striping including but not limited to removal of old markings and installation of new or replacement markings. Contractor to follow OMUTCD and CMSC and notify City of any issues recognized that differ from OMUTCD.

ITEM 659 SEEDING AND MULCHING, CLASS 1 – Seeding and mulching, Class 1 shall be in accordance with the City of Columbus Construction and Material Specifications. All aspects of the referenced specification are incidental to this item. These include but are not limited to: placing of 4" of topsoil, preparation of the seed bed, placement and incorporation of seed, fertilizer, water and mulch using hydraulic equipment, weeding, and watering.

The placement of topsoil shall be at a nominal depth of 4" to properly fill all voids and level uneven ground left by construction activities. Repair seeding and mulching is included under this item and shall take place in the fall following the completion of construction and in the spring of the following year. Payment for this item will be made at the contract lump sum price for each project.

It is imperative the Contractor complete restoration in a timely manner. At a minimum, at the end of every two weeks, all work completed in that two-week period shall be restored in accordance with the contract documents. Payment for concrete work will not be made until the restoration is complete in accordance with the contract documents. No separate payment shall be made for temporary seeding.

Weeds that germinate and grow during the growing process of the sown seed shall be completely removed before final acceptance of the item. Any weed prevention spray applications will be included in the lump sum price.

Unless otherwise directed by the Engineer, the Contractor shall water the seedbed daily to maintain adequate soil moisture for proper seed germination. Thereafter, apply watering as required by City of Columbus Construction and Material Specifications Section 659.17.

Any overspray of hydraulic seeding and mulching operations onto paved surfaces shall be cleaned and removed before the end of the workday.

ITEM 661 PLANTING/PRUNING TREES – Contractor will have a certified arborist perform any tree removals, limb pruning, root pruning, or stump grinding required. **Contractor will submit with their bid package the certified arborist name, certification number and company employed by for the City to review.** Contractor will coordinate with City Forester on matters regarding tree removal and maintenance items. All pruning shall follow ANSI 300 & ANSI Z133 standards.

REMOVE/REPLACE BASE OF DRIVES – This item includes the removal, all saw cuts required to remove, disposal, and the replacement of the lower portion of each driveway approach or concrete pad adjacent to the existing curb within the roadway reconstruction limits. Limits of removal shall extend from the back of curb to the sidewalk. The drive shall be concrete 6" in thickness for residential driveways and 8" for commercial driveways from curb to walk and maintain the existing drive depth and material for any removal behind the walk with a minimum depth of 6". Any additional driveway that is to be removed and replaced to create an

acceptable slope (15% max slope) specified by the Engineer shall be included under this item. Payment for this item will be made at the contract unit price per square yard of concrete drive replaced.

PROFESSIONAL FIELD SURVEYING AND DESIGN – This item applies to (8) residential streets to be reconstructed and (95) curb ramps to be replaced under this improvement. The contractor shall employ a registered professional engineer and licensed surveyor within the State of Ohio to develop Line, Grade and Typical Sections, utilizing a combination of field survey and record plans that are consistent with ODOT's L&D Manual Volume 1, with the inclusion of (96) driveways to be laid out pursuant to Section 804 of the Design Manual. Contractor will submit with their bid package the Registered Professional Engineer and Registered Professional Surveyor name, State of Ohio professional registration number and company employed by for the City to review. A resume, 2 to 3 example projects of similar scope, and example deliverables are to be provided for each professional as listed on the Professional Services Form. Drives and adjacent walks are to conform to the City of Columbus' Standard Detail 2201 and 2300. Any additional driveway that is to be removed and replaced to create an acceptable slope specified by the Engineer shall be included under this item. The design professional shall also account for Item 623.02 whereby the Contractor's field forces, under the direction of a Registered Professional Engineer or a Registered Professional Surveyor shall verify plan elevations for proper fit to existing conditions and plan elevations for intended drainage where proposed items meet existing items. Plan formatting shall comply with ODOT's L&D Volume 3 or the City of Columbus' General Design Requirements (2023), Section 8. Each submittal shall carry the stamp and seal of the licensed design professional performing this scope of work. Deliverables are also to include pdfs reproducible to half size 11x17s or full size 22x34 and as-builts. Deliverables are to be submitted to the City for review a minimum of 3 weeks prior to the scheduled start of construction on the subject street or portion thereof. Deliverable submittal dates and backcheck submittal dates are to be included in the schedule with adequate review time accounted for.

RESTORATION AND CLEANUP – It is the intent of the City to keep inconvenience to the property owners to an absolute minimum. All work prescribed and described in these specifications is situated in improved areas. Any street signs or landscaping features removed during construction by the Contractor must be restored by the Contractor in a timely manner. The cost for removing and replacing signs, mailboxes, and landscaping features shall be included in the price bid for the various items as set forth in the proposal. All work is to continue on a uniform basis and on schedule, particularly the restoration and cleanup of disturbed areas after construction. Disturbed areas, such as sidewalks and curb ramps, must be clearly marked by the contractor until the work can be completed. Restoration of disturbed areas shall include the entire tree lawn. **All disturbed areas shall be restored within 2 weeks after completion of construction.** The City will pay only for those items that are completed in their entirety as described in the specifications.

**CITY OF COLUMBUS
PUBLIC SERVICE DEPARTMENT
TRANSPORTATION DIVISION
SUPPLEMENTAL SPECIFICATION 1503
SOIL STABILIZATION**

JULY 8, 2002

1503.01 Description 1503.02 Materials 1503.03 Laboratory Mixture Design 1503.04 Equipment 1503.05 Storage and Handling 1503.06 Construction Methods 1503.07 Curing and Protection 1503.08 Maintenance/Defective Areas 1503.09 Basis of Payment

SOIL STABILIZATION

1503.01 Description. This supplemental specification outlines the requirements for constructing a stabilized soil structure by uniformly mixing an approved chemical stabilizer, such as Lime, Quicklime, Fly-Ash and/or Cement with the soil and compacting the resulting mixture.

The intended purpose is to permanently strengthen and weather-proof the subgrade soil. Credit may be accorded for this process in pavement design, if all parameters of this specification are complied with.

1503.02 Materials. The materials used shall meet the following requirements:

Lime. Hydrated lime and Quicklime shall meet the requirements of section 712.04 (b) of the CMSC.

Cement. Cement shall meet the requirements of section 701 of the City of Columbus Construction and Material Specifications.

Fly Ash. Fly Ash, Class C or F, shall meet the requirements of section 705.13 and ASTM C 618. Fly Ash not conforming to these requirements may be considered, provided performance requirements of this specification can be proven.

Water. Water shall be clean and clear. If the water is of questionable quality, it shall be tested in accordance with the requirements of AASHTO T 26.

Other Materials. It is not the intent of this document to limit the use of other materials, however, it is beyond the scope of this document to focus on materials for which AASHTO and ASTM standards have not been developed. Materials not conforming to the above, may be considered, provided performance requirements of this specification can be proven.

1503.03 Laboratory Mixture Design. Proposed mix design proportions and recommended depth of application shall be submitted to the City by an approved geotechnical firm, selected by the Contractor, sufficiently in advance of the work for review and approval. If pavement design options are to be considered, submittals must be received no less than 45 days in advance of stabilization operations. A sufficient number of samples shall be taken to insure control data, {moisture-density relationship curve(s)}, developed in the laboratory, represents field conditions, and to account for any changes in soil type. A mix design shall be submitted for each anticipated soil type.

The proposed mix design shall yield a minimum CBR value of 20 and a minimum average unconfined compressive strength of at least 100 psi at 7 days, and at least 150 psi at 28 days.

1503.04 Equipment. The Contractor shall use equipment that will produce results meeting the requirements for application of materials, compaction, and finishing as

controlled by these Specifications. Mixing shall be performed using an approved power driven rotary type mixer. Prior to construction, all equipment shall be in satisfactory working condition, and available for inspection by the Project Engineer or his designee.

1503.05 Storage and Handling. Admixtures shall be properly stored and handled in closed weatherproof containers until immediately before distribution. Hydrated lime, Quicklime, or Cement in bags shall be properly stored in weather-protected conditions with adequate protection from ground dampness. The storage facilities shall be approved by the City.

1503.06 Construction Methods.

Temperature and Weather Limitations. Stabilization shall be performed only when ambient air temperature is above 40° F, and when the soil is not frozen. Do not perform this work during wet or unsuitable weather, or when freezing weather is anticipated within 24 hours of mixing/compaction.

Preparation of Existing Roadway. Prior to starting the stabilization process all unsuitable materials, such as stumps, roots, and organic material shall be removed. Construct the area to be stabilized to an elevation such that, upon completion of the operations, the subgrade will conform to the lines, grades, and cross-section shown on the plans.

Spreading of Material. The admixture shall be spread using equipment that will provide uniform distribution over the entire repaired area and in such a manner as to limit scattering and loss by wind.

Tailgate spreading of material will not be permitted.

The material may be spread in either a slurry or dry form at the option of the Contractor.

Mixing. Mixing operations shall be such that all ingredients are distributed evenly throughout the required depth, and provide a uniform mixture, free of segregation, that is satisfactory to the Engineer. The moisture content of the mixture shall be maintained at $\pm 2\%$ of the optimum moisture content.

The material shall be pulverized so that 100% passes the 1 inch sieve and 60% passes the #4 sieve.

Compaction. Immediately upon completion of the spreading/mixing operations, the mixture shall be thoroughly compacted to 98% of the maximum dry density established during the preparation of the laboratory mix design. All soil subgrade shall be compacted to 100%. The number, type, and weight of rollers shall be sufficient to compact the mixture to the required density.

If depressions, defective areas or soft spots develop during the compaction operation, they shall be corrected immediately.

After each section is completed, field density tests shall be made in accordance with COC Supplemental Specification 1501. If the compacted mixture fails to meet the specified density requirements, further evaluation by means of a test roll per section

204.07, may be performed at the discretion of the Project Engineer to evaluate subgrade stability for acceptance. The City may require the area to be reworked as necessary to meet these requirements and may require the Contractor to change compaction equipment and/or methods to obtain the required density.

Finishing. When compaction of the stabilized soil is nearing completion, the surface shall be shaped to the required lines, grades and cross section within the tolerances of item 203.08. Compaction should continue until the required density is obtained.

1503.07 Curing and Protection. After the subgrade has been finished as specified, it shall be cured for a period of at least 5 days above 40°F, or until core samples extracted from the subgrade meet the requirements of 1503.03.

During the curing period, the subgrade shall be protected against drying by applying an approved prime coat or polymer solution to prevent moisture loss.

All traffic or equipment other than curing equipment shall not be allowed on the finished subgrade until completion of curing, unless permitted by the Engineer.

1503.08 Maintenance/Defective Areas. The contractor shall maintain, at his expense the entire stabilized area in a manner satisfactory to the City. Maintenance shall include immediate repairs of any defective or damaged portions of the treated subgrade.

1503.09 Basis of Payment. The accepted quantities of stabilized soil will be paid for at the contract unit price per square yard or cubic yard, (*square meter or cubic meter*), which price and payment shall be full compensation for furnishing and placing all materials.

Item	Unit	Description
1503	Square Yard	Soil Stabilization

**CITY OF COLUMBUS
PUBLIC SERVICE DEPARTMENT
TRANSPORTATION DIVISION**

**SUPPLEMENTAL SPECIFICATION 1551 (*Modified for City of Gahanna*)
DETECTABLE WARNINGS**

March 1, 2004

1551.01 Description 1551.02 Materials 1551.03 Dimensions 1551.04 Application

~~1551.05 Method of Measurement~~ (see page 52)

~~1551.06 Basis of Payment~~ (see page 52)

1551.01 Description.

This work shall consist of furnishing all material, equipment, and labor necessary for the placement of detectable warning devices at curb ramps or other walking surfaces, complete and ready for service at locations shown on the plans. All work shall be in accordance with City of Columbus Standard Drawing 2319 Dr. A and with Section 1108 of the Architectural and Transportation Barriers Compliance Board's "Draft Guidelines For Accessible Public Rights-of-Way", dated June 17, 2002 as amended, supplemented and adopted.

1551.02 Materials.

All products shall receive prior approval by the City Engineer and be included in the City of Columbus, Transportation Division current listing of approved Producers and Products for detectable warning surfaces. New Products shall be submitted for review and approval in accordance with the City's General Policy and Procedures for New Products, Materials, and Construction Procedures.

Detectable warning surfaces shall be textured to provide slip resistance and shall contrast visually with adjacent walking surfaces – either light-on-dark, or dark-on-light. The preferred color for a light background shall be brick red. The preferred color for a dark background shall be safety yellow or light granite. Other colors may be specified or approved by the City Engineer provided that samples are submitted to and approved by the City Engineer at least three (3) working days prior to installation. Color submittals shall include manufacturer's statement of percentage of visual contrast provided according to ADAAG A4.29.2. Color shall be

integral with the detectable warning device and shall not be surface applied. Paints or other surface coatings shall not be used.

Detectable warning surfaces shall be classified by type of material and/or application method:

Type "A" – Pre-Cast, Manufactured Clay and Concrete Pavers - ***Approved for new construction, only.***

Type "B" – Surface-Applied or Surface-Formed Domes – Generally includes truncated domes bonded to the surface of existing curb ramps - ***Approved for retrofit, only.***

Type "C" – Stamped, Color Dyed Concrete - ***Approved for new construction, only.***

Type "D" – Surface-Mounted, Thin Tile and Thin Molded Sheet Goods – Generally includes tiles or mats (rigid & flexible, with preformed truncated domes), bonded and/or anchored to the surface of existing curb ramps - ***Approved for retrofit, only.***

Type "E" – Pre-Manufactured, Wet-Set Products – Generally includes rigid products pressed into freshly formed concrete - ***Approved for new construction, only.***

1551.03 Dimensions.

Truncated domes in a detectable warning surface shall have a base diameter of 0.9 inches (23 mm) minimum to 1.4 inches (36 mm) maximum, a top diameter of 50% of the base diameter minimum to 65% of the base diameter maximum, and a height of 0.2 inches (5 mm).

Truncated domes in a detectable warning surface shall have a center-to-center spacing of 1.6 inches (41 mm) minimum and 2.4 inches (61 mm) maximum, and a base-to-base spacing of 0.65 inches (16 mm) minimum, measured between the most adjacent domes on a square grid.

Detectable warning surfaces shall extend 24 inches (610 mm) minimum in the direction of travel and the full width of the curb ramp, landing, or blended transition.

Pavers shall be laid so that the centers of domes align with a straightedge placed both perpendicular and parallel with the direction of travel. Dome Alignment may not differ by more than 1/4-inch.

The detectable warning surface shall be located so that the edge nearest the curb line is 6 inches (150 mm) minimum and 8 inches (205 mm) maximum from the face of the curb line.

Domes shall be aligned on a square grid, aligned in rows parallel and perpendicular to the predominant direction of travel. Domes must be not be skewed diagonally to the direction of travel.

1551.04 Application.

Detectable warning devices shall be installed in accordance with manufacturer's specifications, except as modified by this specification or as otherwise specified on the plans. The finished surface shall be uniformly profiled to match the adjoining surfaces without lips, obstructions and shall drain completely.

The contractor shall warrant the installed surface to last no less than five years without losing more than two percent of the truncated domes due to delaminating as a result of product failure, and shall further warrant the surface for a minimum of five years against fading, chipping, peeling, cracking, or loss of original shade due to sunlight, salt or exposure to weathering.

Special Application Notes: Type “A” – Pre-Cast, Manufactured Clay and Concrete Pavers:

- Pavers shall be laid on an unreinforced concrete base. Thickness of the base shall be the greater of 4-inches or the specified, nominal thickness of the curb ramp.
- Pavers shall be set into a 1/2-inch thick bed of freshly poured latex or epoxy -modified cement mortar.
- Pavers (exclusive of domes) shall be flush with the surrounding concrete. The surface shall not differ by more than 1/8-inch in height.
- Pavers shall be laid so that the centers of domes align with a straightedge placed both perpendicular and parallel with the direction of travel. Dome Alignment may not differ by more than 1/4inch.
- Joints between pavers and surrounding concrete surface shall be mortared and shall not exceed 1/4-inch in width. Mortared joints shall be flush with top surface and struck so as to give a smooth surface.
- Joint spacing between pavers shall be no greater than 5/32-inch and not less than 1/16-inch. Pavers shall not be directly touching each other unless they have spacing bars
- Joints between pavers shall be sand-filled. Sand shall be washed, nonplastic, well-graded angular material free from deleterious or foreign matter, with maximum particle size not larger than the specified joint spacing. Gradation shall conform to Item 703.02 fine aggregate for concrete. Sweep this material to fill the joints and water with a fine mist. Repeat as necessary to achieve a sand-filled joint. When requested by the Engineer, the Contractor shall submit gradation analysis of the proposed joint material performed in accordance with ASTM C-136.
- Pavers shall consist of full, completely formed domes and shall be crack-free.
- The face of all pavers shall be clean of cement and protected so as to avoid chipping during construction.
- A minimum of 6-inch horizontal edge restraint shall be provided around the full perimeter of the detectable warning pavers. The restraints shall consist of Class “C” cast in place concrete, (City of Columbus CMS item 499).

**CITY OF COLUMBUS
PUBLIC SERVICE DEPARTMENT
TRANSPORTATION DIVISION
SUPPLEMENTAL SPECIFICATION 1523
ROLLER COMPACTED CONCRETE PAVEMENTS (RCC)
February 17, 2009**

1523.01	General provisions
1523.02	Execution
1523.03	Submittal Requirements
1523.04	Materials
1523.05	Mix Design
1523.06	Equipment
1523.07	Construction Requirements
1523.08	Joints
1523.09	Quality Control and Assurance
1523.10	Pavement Thickness and strength
1523.11	Price Adjustments
1523.12	Opening To Traffic
1523.13	Warranty
1523.14	Basis of Payment

ROLLER COMPACTED CONCRETE PAVEMENTS (RCC)

- 1523.01 General Provisions.** This Supplement outlines the requirements for production and construction of Roller Compacted Concrete (RCC) pavement for City streets. In addition to this supplement, items 305, 306, 401, 407, 451 and 700 of the City of Columbus Construction and Material Specifications (CMSC) apply.
- 1523.02 Execution.** This supplemental specification sets forth some requirements regarding materials to be employed and the manner in which the work is to be performed. This supplemental specification also sets forth results to be obtained. The Contractor shall comply with all requirements set forth in this supplemental specification.
- 1523.03 Submittal Requirements.** The Contractor shall submit the following to the Engineer at least 45 days before start of any production of RCC pavement:
- 1523.03.01 Construction schedule for all RCC related operations.
 - 1523.03.02 Paving procedures describing direction of paving operations, paving widths, planned longitudinal and transverse cold joints and curing methods and patterns.
 - 1523.03.03 Certification for aggregate source, quality and sizing as required by the specification.
 - 1523.03.04 Certification for Portland cement and supplementary cementations materials as required by the specification.
 - 1523.03.05 Manufacturers data and specifications including capacities for equipment to be used in mixing, hauling, placing and compacting RCC.
 - 1523.03.06 Layout of plant location showing mixing plant, cement and aggregate storage and water supply.
 - 1523.03.07 Proposed RCC Mix Design. If the proposed mix design is developed by the Contractor or there is a suggested change to the mix design, it must be submitted to the Engineer for approval at least forty five days prior to RCC construction.

This mix design shall include details on aggregate gradation, cementations materials, admixtures (if used), compressive and tensile strengths and required moisture and density to be achieved.

1523.04 Materials. All materials to be used shall be from approved sources as documented on the "Approved Materials List" on file in the City's testing laboratory.

Portland cement shall conform to the standard specification for Portland Cement Type I, ASTM C 150 (latest edition).

Fly Ash shall conform to ASTM C 618 Class F and section 499 of the CMSC.

Ground Granulated Blast Furnace Slag (GGBFS): GGBFS shall conform to sections 499 and 701.11 of the CMSC.

Chemical admixtures shall conform to section 499 of the CMSC.

Fine and course aggregates shall meet the requirements of section 703.02 of the CMSC for Portland Cement Concrete, item 305 and 306. The aggregates shall be well graded to conform to the following composite gradation.

<u>Sieve Size</u>	<u>Percent Passing</u>
1"	100
3/4"	95 – 100
1/2"	70 – 90
3/8"	60 - 85
#4	40 – 70
#16	20 – 40
#100	5 – 20
#200	2 – 8

Mixing water shall be clean, potable and free from oil, acid and strong alkalis or organic.

1523.05 Mix Design. The Contractor/Supplier shall develop a RCC mixture proportioned in accordance with this specification and procedures discussed in ACI 325.10R-95 (Re-approved 2001) "Report on Roller-Compacted Concrete Pavements" sections 4.2, 4.3, and 4.4. Once the mix has been designed, certified test data shall be submitted in accordance with section 101.10 of the CMSC from a recognized testing laboratory that shows the proposed mix design will meet the following requirements based on test results of the cores taken from the test section.

Compressive Strength, Cores: 3500 psi @ 28 days.
Splitting Tensile Strength, Cores: 350 psi @ 7 days.

The minimum Portland cement content shall be 350 pounds per C.Y.

Fly Ash and GGBFS may only be used between April 1 and November 1 unless otherwise authorized by the Project Engineer.

Secondary Cementations material shall not be considered as a substitute for any deficiency in the #100 sieve in section.

Strength properties shall be based on field extracted cores.

1523.06 Equipment.

1523.06.01 **Mixing Plants:** Mixing plants shall be of a design that can produce a RCC pavement mixture of the proportions defined in the approved mix design and within the specified tolerances in ASTM C 94 and ASTM C 685. The mixing plant may be a Central-Mix Drum or a Stationary Continuous-Mixing Twin-Shaft Pug Mill mixer. The plant shall have a minimum manufacturer's rated capacity of 200 tons per hour.

1523.06.02 **Pavers:** RCC shall be placed with a high-density or conventional asphalt type paver subject to approval by the Engineer. The paver shall be capable of placing the RCC at a minimum of 85% of the maximum wet density in accordance with 1523.07.05. The paver shall be of suitable weight and stability to spread and finish the RCC material, without segregation to the required thickness, smoothness, cross-section and grade. Work in areas inaccessible to paving machines shall be performed according to 1523.07.06.

1523.06.03 **Vibratory Rollers:** Vibratory rollers shall be self-propelled, double drum, steel wheel vibratory rollers having a static weight of at least 10 tons. Each roller drum shall be equipped with a properly operating scraper and brush. The rollers shall transmit a dynamic impact to the surface through smooth steel drums by means of revolving weights, eccentric shafts or other equivalent methods. The roller drum shall be between 4 and 5-1/2 foot in diameter and 5-1/2 to 8 feet in width.

Finish rollers shall be self-propelled, double drum, steel wheel rollers having a static weight of between 3 and 10 tons. Each drum shall be equipped with a properly operating scraper and brush. A single drum vibrator roller with a vulcanized rubber coating may be utilized for finish rolling, at the approval of the Engineer.

1523.06.04 **Dump Trucks:** Dump Truck boxes shall be kept free of contaminants while hauling any RCC and shall have protective covers properly secured until discharge into the paver.

1523.07 Construction Requirements

1523.07.01 Preparation of Sub-grade/Sub-base:

Prepare the sub-grade according to section 204 of the CMSC. If required, construct a granular base according to section 304. Moisten the surface of the sub-grade or base without creating mud or ponding water, to minimize absorption of water from RCC mix to be deposited.

1523.07.02 Transportation:

Transport the RCC mixture to the site in dump trucks which meet the requirements of 1523.06.04. The trucks shall dump directly into the hopper of the paver unless placement is by hand as directed by the Engineer. Hauling over the freshly placed RCC will not be permitted except in multi-lift operations to the extent required to dump the fresh RCC into the paver.

1523.07.03 Placing RCC:

Place RCC to the thickness, grade, and lines indicated in the plans. Achieve a minimum of 85% of the maximum wet density out of the paver and 98% of the maximum wet density after final rolling. No compacted lift thickness shall be in excess of ten (10) inches or less than four (4) inches for single or multiple-lift applications unless demonstrated by the test strip. Co-ordinate RCC delivery so the mix can be spread and rolled within the specified time limit and to ensure uniform progress of the paver until the paving operation is complete. The time between mixing and compacting shall not exceed ninety (90) minutes, for all RCC placed, provided that the temperature of the RCC does not exceed 90 degrees (F).

Operate the paver in a manner that will prevent segregation and will produce a smooth continuous surface without tearing, pulling or shoving. If segregation occurs, suspend the paving operation until the cause is determined and corrected. Areas of segregated RCC shall be removed and replaced as specified in 1523.10.

Placing of the RCC mix shall be done in a pattern so that the water from previously placed RCC will not affect the fresh surface or sub-grade. Scarify all areas that require broadcasting or fanning of RCC. The surface must be scarified at least one inch deep prior to broadcasting fresh RCC over the top. Broadcasting must be completed in the allotted time within these specifications.

1523.07.04 For multiple-lift placement,

the total pavement thickness shall be as specified on the plans. The second lift must be placed within sixty (60) minutes of the completion of the first lift. If more than sixty (60) minutes has elapsed, the interface between the first and second lifts shall be considered a cold joint and shall be prepared in accordance with

1523.08.04 Placement of the second lift must be delayed until the first lift has attained design strength as specified in 1523.05.

- 1523.07.05 **Compaction:** Achieve 85% of the maximum wet density, as determined in the laboratory according to ASTM D 1557, directly out of the paver and 98% of the maximum wet density after final rolling.

The contractor shall begin compaction operations within fifteen (15) minutes after spreading of the RCC mix. Any additional delay will result in the coring of the affected area at the Contractors expense to ensure that it meets the requirements of this specification.

- 1523.07.06 **Rolling:** The contractor shall establish a rolling pattern that will achieve the required density with a minimum number of roller passes. During vibratory compaction, the roller shall not be started, stopped, or left standing in vibratory mode. Stagger the stopping point of successive rolling passes to avoid forming depressions on the surface.

The contractor shall continually check the RCC surface while still plastic to ensure surface and grade tolerances are met. Immediately correct excessive variations in accordance with the spreading requirements. The contractor shall remove any roller marks on the surface using a steel drum roller in static mode. Each lane edge shall be constructed with a face within 15-degree of vertical.

The contractor shall spread RCC mix by hand in areas not accessible by the paver and compact to the requirements of 1523.06 and 1523.07.

- 1523.07.07 **Curing:** Keep the RCC surface continuously moist by water, fog spray, wet burlap, an approved membrane-forming curing compound applied at 1.5 times the rate specified by the manufacturer, or polyethylene sheeting for a period of seven (7) days or until the core strengths have meet the requirements of 1523.05.

- 1523.07.08 **Weather Limitation:** RCC shall not be placed on any surface containing frost or frozen material. RCC shall only be placed when the ambient temperature is a minimum of 35°F and rising, unless the procedures set forth in section 451.061 "Depositing and Curing Concrete During Cold Weather", of the CMSC, are strictly enforced. During periods of hot weather or windy conditions, special precautions shall be taken to minimize moisture loss due to evaporation. Precautions may include cooling of aggregate stockpiles by the use of a water spray, protective covers on dump trucks, temporary windbreaks to reduce wind velocity, cooling of concrete mix water, decreasing the allowable time between mixing and final compaction and keeping the surface of the newly placed

RCC pavement damp with a light spray during compaction and finishing operations.

Don't place RCC when rain is imminent. If rain occurs during placement of RCC cease all operation.

1523.08 Joints:

- 1523.08.01 **Fresh Vertical Joint:** A vertical joint shall be considered a fresh joint when an adjacent RCC lane is placed within 90 minutes of placing the previous lane. The contractor shall ensure that the contact face is moist and not segregated. Before rolling, the vertical joint surface should be hand-finish as necessary immediately behind the paver to produce a tight surface. When placing RCC with a fresh longitudinal joint, leave the outer 12 to 18 inches of the paving lane uncompacted during the initial rolling operation. The uncompacted edge is then used to set the height of the paver screed for paving the adjacent lane. After the adjacent lane is placed, the joint is compacted by centering the roller drum over the joint and compacting adjacent lane edges simultaneously. Roll extra passes as necessary to achieve the required density and smoothness in the joint area.
- 1523.08.02 **Cold Vertical Joint:** A cold vertical joint is made when either side of the joint is not compacted within 90 minutes of plant mixing. Saw cut the edge of previous lane back to sound RCC (minimum 6") to form a vertical face prior to placing the next pass. Trimming by grader blade is permitted, if done prior to the end of the workday. Prior to placing fresh RCC mixture against a compacted cold vertical joint, the joint shall be thoroughly cleaned of any loose or foreign material. The vertical joint face shall be wetted and a moist condition immediately prior to placement of the adjacent lane.
- 1523.08.03 **Fresh Horizontal Joint:** For multiple-lift applications, a horizontal joint is considered a fresh joint when a subsequent RCC lift is placed within sixty (60) minutes of placing the previous lift. The surface of the lower lift shall be kept clean and continually moistening the surface prior to placement of the subsequent lift.
- 1523.08.04 **Cold Horizontal Joint:** For multiple-lift applications, a horizontal joint is considered a cold joint when the placing of the subsequent RCC lift is delayed by more than sixty (60) minutes of placing the previous lift. Immediately prior to placing the second lift of RCC, a cement/sand slurry or grout shall be applied to the contact surface of the first lift. The contractor shall delay placing the second lift of RCC until the first lift attains design tensile strength as specified in 1523.05.

1523.08.05 **Contraction Joints:** Transverse and Longitudinal contraction joints shall be made as soon as possible after placement of RCC without damaging the pavement, according to City of Columbus Standard Drawing 2170 or as approved by the Engineer, except that transverse joints shall be spaced at a maximum of 30 foot intervals, or at intervals directed by the Engineer. All pavements shall have at least one center longitudinal contraction joint.

1523.09 **Quality Control and Assurance:** The contractor shall maintain equipment and qualified personnel required to determine the magnitude of the various properties of RCC governed by the specifications. These properties shall be maintained within the limits of this specification. The contractor shall notify the engineer a minimum of 24 hours prior to start of RCC paving.

Testing at the plant and the paving site is the responsibility of the Contractor or Developer and shall be performed by a private Independent Testing Laboratory approved by the City. The Contractor and Supplier shall provide safe and convenient access, acceptable to the Engineer, for the inspection and sampling of the RCC and constituent materials, at both the production plant and the paving site and shall cooperate in the inspection and sampling process at all times.

1523.09.01 **Test Strip:** The contractor shall construct a test section for every project of a thickness equal to the plan thickness and planned construction width with at least 100 tons of RCC. The same equipment proposed for use on the project shall be used for the test strip. The test strip will be used to resolve anticipated problems with equipment, mix behavior, compaction and/or strength characteristics. The test strip shall be constructed at a location chosen by the contractor at least 45 days prior to the start of paving operations. The Contractor must also demonstrate the ability to achieve a smooth, hard, uniform surface free of excessive tears, ridges, spalls and loose material. Also, achieve 85% of the maximum wet density in accordance with ASTM D 1557, directly out of the paver and 98% of the maximum wet density after final rolling. During construction of the test section, the Contractor shall establish an optimum rolling pattern and procedure for obtaining a density of not less than 98% of the maximum wet density. After completion of the test strip, cores will be extracted to verify mix compliance. This will be performed by the Contractor's Independent Testing Laboratory, at the expense of the Contractor. During the trial placement, the City's Testing Personnel shall calibrate their nuclear density gauges in accordance with ASTM C 1040, with a sample of the test section mix. Moisture readings of the gauge shall be calibrated using oven dry samples of the plant-mixed RCC. The contractor shall not commence placement of RCC until all testing has been completed and the City has verified the results are acceptable.

1523.09.02 **Pre-placement:** The Contractor's Independent Testing Laboratory will develop a moisture/density relationship of the actual job materials in accordance with ASTM D 1557. Optimum moisture content and maximum wet densities shall be established and copies of the moisture-density curves shall be provided to the City prior to any RCC placement.

1523.09.03 **During Placement:** The Contractor shall ensure quality control at the plant, by controlling materials, obtaining test samples and ensuring segregation is not occurring while loading haul trucks. The Contractor, in cooperation with the Contractor's Independent Testing Laboratory, shall ensure that compaction and grade specifications are met and time limits are adhered to.

1523.09.04 **Field Density:** The City's Testing Laboratory shall perform density testing of the RCC in accordance with ASTM C 1040, direct transmission mode, directly behind the paver. Only wet density shall be used for evaluation. At least five (5) tests shall be performed at the back of the paver and after final compaction for each 250 cubic yards placed. The required density shall be as specified in 1523.07.05 out of the back of the paver and after final rolling as specified in 1523.07.05. The Contractor shall be responsible for verifying required densities are achieved by the paver and after final rolling.

If density test results do not meet the requirements of 1523.07.05, the Contractor shall determine the source of the problem and take immediate steps to correct the problem. If the problem cannot be resolved to the satisfaction of the Engineer, placement shall be suspended.

1523.09.05 **After Placement:** The City's Testing Laboratory shall core at least nine (9) cylindrical specimens from each Pavement Area. Pavement Area is defined as four thousand (4,000) square yards or each day's placement, whichever is less. Length measurements of the cores and compressive strength testing shall be in accordance with ASTM C 42. Splitting tensile testing shall be in accordance with ASTM C 496.

Testing shall be conducted as follows:

Compressive Strength Testing: Six (6) of the cores obtained for thickness verification will be tested for compressive strength at 28 days.

Splitting Tensile Strength: Three (3) of the cores obtained for thickness verification will be tested for splitting tensile strength at seven (7) days.

All cores tested shall meet the requirements of 1523.05 and 1523.10 or the section of RCC represented by the cores shall be subject to pay adjustment or removal according to 1523.11.

1523.10 Pavement Thickness and Strength

The contractor shall construct the RCC pavement not more than 0.2 inch less than the specified plan thickness, as determined by measurement of cores cut as specified in 1523.09.05. If any core shows a deficiency in thickness of more than $\frac{1}{2}$ inch from the specified plan thickness, take additional cores to determine the limits of the deficiency. Follow the procedures below:

1. Take a core five (5) feet longitudinally on both sides of the deficient core. If both the cores are less than $\frac{1}{2}$ inch deficient in thickness the zone of deficiency has been determined.
2. If either or both cores taken in #1 above are more than $\frac{1}{2}$ inch deficient in thickness, cut a core 50 feet longitudinally from the deficient core(s). If the 50 foot core(s) is more than $\frac{1}{2}$ inch deficient, cut additional cores at 100 foot longitudinal intervals until a core less than $\frac{1}{2}$ inch deficient is obtained; until the pavement ends; or until overlapping an adjacent pavement area's core in the same lane.
3. If a pavement area has cores more than $\frac{1}{2}$ inch deficient in thickness and the pavement area's constructed width is greater than 12 feet, obtain cores transverse to the location of the more than $\frac{1}{2}$ inch deficient cores. Obtain transverse cores at a location half the distance from the deficient core to the furthest edge of pavement. Obtain a transverse core for each core more than $\frac{1}{2}$ inch deficient.
4. The Engineer will use the cores that measure less than $\frac{1}{2}$ inch deficient in thickness to define the limits of the deficiency.

If any core shows a deficiency in thickness of more than 1 inch or compressive strength less than 85% of the compressive strength mix design cited above, determine the extent limits of deficiency by following steps 1 through 4 above. Remove and replace those areas greater than 1 inch deficient in thickness and/or less than 85% of the mix design compressive strength.

The Engineer will calculate average thickness and compressive strength of concrete pavement placed as follows:

1. When zones of deficient thickness greater than $\frac{1}{2}$ inch to 1 inch are allowed to remain in place, the Engineer will calculate two average thicknesses. A Project Average Thickness (PAT) including all cores not more than $\frac{1}{2}$ inch deficient. Cores that exceed the specified thickness by more than $\frac{1}{2}$ inch will be considered as the specified thickness plus $\frac{1}{2}$ inch when calculating the PAT. A second Deficient Zone Average (DZA) will

include all cores with thickness deficiency greater than ½ inch to 1 inch. The pavement represented by each of the two averages, PAT or DZA, will be calculated and paid separately.

2. Determine and apply deductions for thickness deficiency to each separately placed width of pavement.

3. For any pavement areas removed and replaced, re-core those areas replaced following this section of the specifications. Include those core values into the calculations for average pavement thickness and strength.

4. Calculate the compressive strength deficiency area by following the steps cited above for thickness items but substituting “the 0.5 inch thickness deficiency with 90% compressive strength” and the “1.0 inch thickness deficiency” with “less than 85% compressive strength.”

Remedial Actions: Correct deficiencies while RCC is still plastic; otherwise do repairs after seven (7) days. After seven (7) days, the RCC shall be removed by saw cutting full depth before removal. Replace the RCC utilizing a Cast-in-Place concrete meeting the requirements of section 499; Class E Concrete as directed by the Engineer. The new concrete shall be doweled into the existing RCC utilizing epoxy coated reinforcing bars according to section 451 of the CMSC.

Any RCC pavement found to be of unacceptable thickness, or deficient in any testing done in accordance with this specification, shall be subject to removal and replacement by the contractor, at no cost to the City, including removal and replacement of any intermediate and surface asphalt courses.

Grind off high surface variations to a finish acceptable to the Engineer.

Filling of low areas with fresh RCC is not permitted.

If asphalt surfacing is specified, low areas accepted by the Engineer shall be made up with additional surfacing material without extra payment. All repairs are subject to the Engineers approval.

1523.11 Price Adjustments

1523.11.1 Thickness deficiencies:

Based on the pavement average thickness payment will be made as specified in Table 1523-11.1.

TABLE 1523.11.1 PAVEMENT THICKNESS DEFICIENCY	
Deficiency in Thickness as Determined by Cores	Proportional Part of Contract Price to be Paid
0.0 to .2 inch	100 percent
0.3 to 0.5 inch	Ratio $\left[\frac{PAT}{PST} \right]^6$
0.6 to 1.0 inch	Ratio $\left[\frac{DZA}{PST} \right]^6$
Greater than 1.0 inch+	Remove and replace

1523.11.2 **Compressive strength Deficiency:** Where the average strength of a pavement area, as defined in 1523.05, is less the specified strength, but greater than or equal to 90% of the specified strength, payment will be made according to Table 1523.11.2 below.

Table 1523.11.2

Percent of Mix Design Strength*	Payment Deduction Factor
95%- 100%	0%
90% - 95%	10%
85% - 90%	20%
Less than 85%	Remove & Replace

* See Section 1523.05

The Engineer will determine whether deficient pavement areas from 0.6 up to 1 inch in thickness and/or 85% to 90% of the design compressive strength will be allowed to remain in place at the reduced price or must be removed and replaced.

PAT = Project Average Thickness

PST = Plan Specified Thickness

DZA = Deficient Zone Average

In the case of a pavement area having deficiencies in thickness and strength, the greater of the two deductions shall be applied to the payment for this work.

1523.12 Opening to Traffic

The RCC pavement may be opened to traffic or asphalt surfaced as specified on the plans a minimum of seven (7) days after placement or once the strength requirements of section 1523.05 have been met.

1523.13 Warranty

Pavement constructed according to this specification shall be guaranteed by the developer/contractor for a period not less than two (2) years from date of acceptance of the street by the City. The contractor shall sign the warranty agreement attached to this specification.

1523.14 Basis of Payment

1523.14 .1 The accepted quantities of RCC pavement will be paid for at the contract unit price per square yard (*square meter*), which price and payment shall be full compensation for furnishing and placing all materials including reinforcing steel, dowels, and joint materials. The City will pay a reduced price, according to section 1523.11, for RCC pavement found deficient in thickness and/or strength.

1523.14 .2 No additional payment over the unit contract bid price will be made for any pavement which has an average thickness in excess of that shown on the plans.

1523.14 .3 Payment for accepted quantities, complete in place, will be paid for at the contract price for item Supplemental Specification 1523.

Item	Unit	Description
1523	Square Yard (<i>Square Meter</i>)	Roller Compacted Concrete

STANDARD SPECIFICATIONS
FOR
ASPHALT SURFACE PRESERVATION
WITH A MALTENE BASED
ASPHALT REJUVENATING AGENT

ASPHALT REJUVENATING AGENT

I. Scope:

This work shall consist of furnishing all labor, material, and equipment necessary to perform all operations for the application of an asphalt rejuvenating agent to asphaltic concrete surface courses. The rejuvenation of surface courses shall be by spray application of a maltene based cationic rejuvenating agent composed of petroleum oils and resins emulsified with water. All work shall be in accordance with the specifications, the applicable drawings, and subject to the terms and conditions of this contract.

II. Material Specifications:

The asphalt rejuvenating agent shall be an emulsion composed of a petroleum resin oil base uniformly emulsified with water. Each bidder must submit with his bid a certified statement from the asphalt rejuvenator manufacturer showing that the asphalt rejuvenating emulsion conforms to the required physical and chemical requirements.

SPECIFICATIONS

Tests	Test Method		Requirements	
	ASTM	AASHTO Min.	Max.	
Tests on Emulsion:				
Viscosity @ 25°C, SFS	D-244	T-59	15	40
Residue, % W ¹	D-244 (Mod.)	T-59 (Mod)	60	65
Miscibility Test ²	D-244 (Mod.)	T-59 (Mod)	No Coagulation	
Sieve Test, %W ³	D-244 (Mod.)	T-59 (Mod)	-	0.1
Particle Charge Test	D-244	T-59	Positive	
Percent Light Transmittance ⁴	GB	GB	-	30
Tests on Residue from Distillation:				
Flash Point, COC, °C	D-92	T-48	196	-
Viscosity @ 60°C, cSt	D-445	-	100	200
Asphaltenes, %w	D-2006-70	-	-	1.00
Maltene Dist. Ratio	D-2006-70	-	0.3	0.6
 $\frac{PC + A_1^5}{S + A_2}$				
PC/S Ratio ⁵	D-2006-70	-	0.5	-
Saturated Hydrocarbons, S ⁵	D-2006-70	-	21	28

¹ ASTM D-244 Modified Evaporation Test for percent of residue is made by heating 50 gram sample to 149 C (300 F) until foaming ceases, then cool immediately and calculate results.

² Test procedure identical with ASTM D-244-60 except that .02 Normal Calcium Chloride solution shall be used in place of distilled water.

³ Test procedures identical with ASTM D-244-60 except that distilled water shall be used in place of two percent sodium oleate solution.

⁴ Test procedure is attached.

⁵ Chemical composition by ASTM Method D-2006-70:

PC = Polar Compounds, A₁ = First Acidaffins
A₂ = Second Acidaffins, S = Saturated Hydrocarbons

PROCEDURE FOR DETERMINING PERCENT LIGHT TRANSMITTANCE ON ASPHALT REJUVENATING AGENT

A. SCOPE

This procedure covers the determination of percent light transmittance of the asphalt rejuvenating agent.

B. APPARATUS

- 1) Container may be either glass, plastic or metal having a capacity of 6,000 ml.
- 2) Graduated cylinder, 1,000 ml, or greater
- 3) Light transmittance measuring apparatus, such as Bausch and Lomb or Lumetron spectrophotometer
- 4) Graduated pipette having 1 ml capacity to 0.01 ml accuracy
- 5) Suction bulb for use with pipette
- 6) Test tubes compatible with spectrophotometer, 3/4" X 6, Bausch and Lomb, Catalog No. 33-17- 81, (B&L)

C. CALIBRATION OF SPECTROPHOTOMETER

- 1) Calibrate spectrophotometer as follows: (a) Set wavelength at 580 mu, (b) Allow spectrophotometer to warm-up thirty minutes, (c) Zero percent light transmittance (%LT) scale, (d) Rinse test tube three times with tap water and fill to top of circle marking on B&L test tube or approximately 2/3 full, (e) Place tube in spectrophotometer and set %LT scale at 100, and (f) repeat steps (c) and (e) two times or until no further adjustments are necessary.

D. PROCEDURE

- 1) Shake, stir or otherwise thoroughly mix emulsion to be tested. Place sample of emulsion in beaker and allow to stand one minute.
- 2) Place 2,000 ml tap water in container.
- 3) Suck 1.00 ml emulsion into pipette using suction bulb. Wipe off outside of pipette.
- 4) Using suction bulb, blow emulsion into container.
- 5) Rinse pipette by sucking in diluted emulsion solution and blowing out.
- 6) Clean pipette with soap or solvent and water. Rinse with acetone.
- 7) Stir diluted emulsion thoroughly.
- 8) Rinse out tube to be used with the diluted emulsion three times and fill to top of circle.
- 9) Calibrate spectrophotometer.
- 10) Place diluted emulsion sample tube in spectrophotometer, cover and read %LT to nearest tenth.
- 11) Repeat steps 9 and 10 until three identical consecutive readings are achieved.
- 12) The elapsed time between addition of emulsion to dilution of water and final %LT reading should not exceed 5 minutes.

III. Material Performance:

The asphalt rejuvenating agent shall have the capability to penetrate the asphalt pavement surface and performing as follows. The asphalt rejuvenating agent shall be absorbed and incorporated into the asphalt binder. Verification that said incorporation of the asphalt rejuvenating agent into the asphalt binder has been effected shall be by analysis of the chemical properties of said asphalt binder i.e. viscosity shall be reduced by petroleum maltene fraction replacement method to the following extent. For pavements receiving the first or original application of rejuvenating agent the viscosity shall be reduced by a minimum of thirty-five, (35%) percent as determined by dynamic shear rheometer (DSR) method for asphalt testing in accord with AASHTO T315-05. For retreated pavements after an initial treatment with the asphalt rejuvenator the viscosity shall be reduced by petroleum maltene replacement method a minimum of twenty percent(20%)as determined by dynamic shear rheometer (DSR) method for testing in accord with AASHTO T315-05. In addition the phase angle shall be increased. This analysis shall apply to extracted asphalt binder, taken from cores extracted fifteen to thirty days following application, in the upper three eights inch (3/8") of pavement. In addition the treated areas shall be sealed in-depth to the intrusion of air and water.

The rejuvenating agent shall have a record of at least five years of satisfactory service as a petroleum maltene based emulsion asphalt rejuvenating agent and in-depth sealer. Satisfactory service shall be based on the capability of the material to decrease the viscosity of the asphalt binder by petroleum maltene fraction replacement method, increase the phase angle and provide an in-depth seal. Reclamite®, a Tricor Refiners, LLC product manufactured by D&D Emulsion, Inc., Mansfield, Ohio, is a product of known quality and accepted performance.

The bidder must submit with his bid the manufacturer's certification that the material proposed for use is in compliance with the specification requirements. The bidder must submit with his bid previous use documentation and test data conclusively demonstrating that; the rejuvenating agent has been used successfully for a period of five years by government agencies such as Cities, Counties, etc; and that the asphalt rejuvenating agent has been proven to perform, as heretofore required, through field testing by government agencies as to the required change in asphalt binder viscosity and phase angle. Prior testing data shall be submitted indicating such product performance on a sufficient number of projects to insure product consistency. In addition, prior testing data shall be submitted to indicate said product performance as heretofore described over a minimum testing period of three years to insure reasonable life expectancy.

RECLAMITE®, a product of Tricor Refining, LLC is a product of known quality and accepted performance.

IV. Applicator Experience:

The asphalt-rejuvenating agent shall be applied by an experienced applicator of such material. The bidder shall have a minimum of three years experience in applying the product proposed for use. He must submit with his bid a list of five projects on which he applied said rejuvenator. He shall indicate the project dates, number of square yards treated in each and the name and phone number of the government official in charge of each project.

A project superintendent knowledgeable and experienced in application of the asphalt-rejuvenating agent must be in control of each day's work. The bidder shall submit a written experience outline of the project superintendent.

V. PRODUCT STANDARDS AND ALTERNATES:

The product "Reclamite"® for the asphalt rejuvenating agent, a Tricor Refiners LLC product manufactured by D & D emulsions, Inc. Mansfield, Ohio is the standard for these specifications and the prices quoted on the Bid Sheet Base Bid shall be for this standard. Should a bidder wish to submit a bid for alternates to the Standard, said prices shall be entered on the BID SHEET as the "Alternate Bid" for each item. In the event that the bidder submits no bid for the Standard, only the "Alternate Bids" should be completed.

Bidders may offer an ALTERNATE for the Standard specified in the Specifications provided the bidder adheres to the following and submits same with his bid.

(a) List the proposed alternate on the BID SHEET form giving the product name and price.

(b) Furnish complete specifications and descriptive literature for the alternate as well as a one-gallon sample of the material proposed for use. Such descriptive and detailed information shall be complete and at least equal in detail to the agencies requirements for the standard item for which the alternate is offered.

(c) Submit a current Safety Data Sheet for the alternate materials. The agency will give the alternate consideration. The Contractor may furnish only those alternate items included in his proposal and approved by the agency prior to award of a contract.

(d) Furnish all required test data and use documentation as heretofore required.

If no ALTERNATE is indicated on the BID SHEET, the Contractor shall furnish the STANDARD (brand) specified in the attached specifications.

Should the ALTERNATE offered be found unacceptable by the agency based on the data submitted with the bid and no bid is entered on the BID SHEET for the Standard, then said bid will be considered non-responsive.

VI. APPLICATION TEMPERATURE/WEATHER LIMITATIONS:

The temperature of the asphalt rejuvenating emulsion, at the time of application shall be as recommended by the manufacturer. The asphalt-rejuvenating agent shall be applied only when the existing surface to be treated is thoroughly dry and when it is not threatening to rain. The asphalt-rejuvenating agent shall not be applied when the ambient temperature is below 40° F.

VII. HANDLING OF ASPHALT REJUVENATING AGENT:

Contents in tank cars or storage tanks shall be circulated at least forty-five minutes before withdrawing any material for application. When loading the distributor, the asphalt rejuvenating agent concentrate shall be loaded first and then the required amount of water shall be added. The water shall be added into the distributor with enough force to cause agitation and thorough mixing of the two materials. To prevent

foaming, the discharge end of the water hose or pipe shall be kept below the surface of the material in the distributor that shall be used as a spreader. The distributor truck will be cleaned of all of its asphalt materials, and washed out to the extent that no discoloration of the emulsion may be perceptible. Cleanliness of the spreading equipment shall be subject to the approval and satisfaction of the Engineer.

VIII. RESIDENT NOTIFICATION:

The contractor shall distribute by hand, a typed notice to all residences and businesses on the street to be treated. The notice will be delivered no more than 24 hours prior to the treatment of the road. The notice will have a local phone number that residents may call to ask questions. The notice shall be of the door hanger type that secures to the door handle of each dwelling. Unsecured notices will not be allowed. The contractor shall also place the notice on the windshield of any parked cars on the street. Hand distribution of this notice will be considered incidental to the contract.

IX. APPLYING EQUIPMENT:

The distributor for spreading the emulsion shall be self-propelled, and shall have pneumatic tires. The distributor shall be designed and equipped to distribute the asphalt rejuvenating agent uniformly on variable widths of surface at readily determined and controlled rates from 0.04 to 0.08 gallons per square yard of surface, and with an allowable variation from any specified rate not to exceed 5 percent of the specified rate.

Distributor equipment shall include full circulation spray bars, pump tachometer, volume measuring device and a hand hose attachment suitable for application of the emulsion manually to cover areas inaccessible to the distributor. The distributor shall be equipped to circulate and agitate the emulsion within the tank. The distributor shall have a computerized system, acceptable to the Engineer that controls the rate of product application.

A check of distributor equipment as well as application rate accuracy and uniformity of distribution shall be made when directed by the Engineer.

The truck used for applying rock dust, or other aggregate when required and approved by the Engineer, shall be equipped with a spreader that allows the rock dust to be uniformly distributed onto the pavement. The spreader shall be able to apply 1/2 pound to 3 pounds of rock dust or other aggregate per square yard in a single pass. The spreader shall be adjustable so as not to broadcast the rock dust or other aggregate onto driveways or tree lawns.

The rock dust or other aggregate to be used shall be free flowing, without any leaves, dirt, stones, etc. Any wet rock dust shall be rejected from the job site.

Any equipment that is not maintained in full working order, or is proven inadequate to obtain the results prescribed, shall be repaired or replaced at the direction of the Engineer.

X. APPLICATION OF REJUVENATING AGENT:

The asphalt-rejuvenating agent shall be applied by a distributor truck at the temperature recommended by the manufacturer and at the pressure required for the proper distribution. The emulsion shall be so applied that uniform distribution is obtained at all points of the areas to be treated. Distribution shall be commenced with a running start to insure full rate of spread over the entire area to be treated. Areas inadvertently missed shall receive additional treatment as may be required by hand sprayer application.

Application of asphalt rejuvenating agent shall be on one-half width of the pavement at a time. When the second half of the surface is treated, the distributor nozzle

nearest the center of the road shall overlap the previous application by at least one-half the width of the nozzle spray. In any event the centerline construction joint area of the pavement shall be treated in both application passes of the distributor truck.

Before spreading, the asphalt rejuvenating agent shall be blended with water at the rate of two (2) parts rejuvenating agent to one (1) part water, by volume or as specified by the manufacturer for jobsite conditions. The combined mixture of asphalt rejuvenating agent and water shall be spread at the rate of 0.04 to 0.08 gallons per square yard, or as approved by the Engineer following field testing.

Where more than one application is to be made, succeeding applications shall be made as soon as penetration of the preceding application has been completed and the Engineer grants approval for additional applications.

Grades or super elevations of surfaces that may cause excessive runoff, in the opinion of the Engineer, shall have the required amounts applied in two or more applications as directed.

After the rejuvenating emulsion has penetrate and when surface conditions require a light coating of dry rock dust, or other aggregate approved by the Engineer, shall be applied to the surface in sufficient amount to protect the traveling public as required by the Engineer. The rock dust or other approved aggregate shall be swept and removed from the streets and properly disposed of at the Contractor's expense within 24 hours of application.

The Contractor shall furnish a quality inspection report showing the source, manufacturer, and the date shipped, for each load of asphalt rejuvenating agent. When directed by the Engineer, the Contractor shall take representative samples of material for testing.

XI. STREET SWEEPING:

The Contractor shall be responsible for sweeping and cleaning of the streets prior to, and after treatment.

Prior to treatment, the street will be cleaned of all standing water, dirt, leaves, foreign materials, etc. This work shall be accomplished by hand brooming, power blowing or other approved methods. If in the opinion of the Engineer the hand cleaning is not sufficient than a self-propelled street sweeper shall be used.

All rock dust or other approved material used during the treatment must be removed no later than 24 hours after treatment of the street. This shall be accomplished by a combination of hand and mechanical sweeping. All turnouts, cul-de-sacs, etc. must be cleaned of any material to the satisfaction of the Engineer. Street sweeping will be included in the price bid per square yard for asphalt rejuvenating agent.

If, in the opinion of the Engineer, additional rock dust is required said material shall be applied by the contractor. Said rock dust shall be swept up no later than 24 hours following reapplication. No additional compensation will be allowed for reapplication and removal of rock dust.

XII. TRAFFIC CONTROL:

The Contractor shall schedule his operations and carry out the work in a manner to cause the least disturbance and/or interference with the normal flow of traffic over the areas to be treated. Treated portions of the pavement surfaces shall be kept closed and free from traffic until penetration, in the opinion of the Engineer, has become complete and the area is suitable for traffic.

When, in the opinion of the Engineer, traffic must be maintained at all times on a

particular street, then the Contractor shall apply asphalt rejuvenating agent to one lane at a time. Traffic shall be maintained in the untreated lane until the traffic may be switched to the completed lane.

The Contractor shall be responsible for all traffic control and signing required to permit safe travel. The contractor shall notify the police and fire departments as to the streets that are to be treated each day.

If, in the opinion of the Engineer, proper signing is not being used, the Contractor shall stop all operations until safe signing and barricading is achieved.

XIII. METHOD OF MEASUREMENT:

Asphalt rejuvenating agent will be measured by the square yard as provided for in the Contract Documents.

XIV. BASIS FOR PAYMENT:

The accepted quantities, measured as provided for above, will be paid for at the contract unit price for asphalt rejuvenating agent.

Asphalt rejuvenating agent shall be paid for PER SQUARE YARD, which shall be full compensation for furnishing all materials; equipment, labor and incidentals to complete the work as specified and required.

BID SHEET

The undersigned proposes to furnish material, labor, etc. according to the terms and conditions of the attached _____ of _____ Specifications at the following unit prices, to wit:

BASE BID

_____ SQUARE YARDS, MORE OR LESS, CONSTRUCTION SEALING WITH ASPHALT REJUVENATING AGENT FURNISHED AND APPLIED.

_____ \$ _____ PER SQ. YD.
Product Name

CONTRACTOR CAN BEGIN WORK _____ DAYS AFTER WRITTEN NOTICE.

CONTRACTOR WILL COMPLETE WORK BY _____ YES _____ OR NO _____

PRICE TERMS: _____

ALTERNATE BID

_____ SQUARE YARDS, MORE OR LESS, CONSTRUCTION SEALING WITH ASPHALT REJUVENATING AGENT FURNISHED AND APPLIED.

_____ \$ _____ PER SQ. YD.
Product Name

CONTRACTOR CAN BEGIN WORK _____ DAYS AFTER WRITTEN NOTICE.

CONTRACTOR WILL COMPLETE WORK BY _____ YES _____ OR NO _____

PRICE TERMS: _____

BIDDER AUTHORIZED AGENT

BUSINESS ADDRESS

PHONE NUMBER

2024 Events Calendar

Date	Event	Time	Location	Organization	Description
1/27/2024	Soirre at the Sancturary 175	8-11pm	Gahanna Sanctuary	175	175 Event
3/23/2024	Eggs-hilarating Egg Hunt	11-1pm	Hannah Park	GPR	Egg Hunt
4/27/2024	Arty Party	10-4pm	TBD	GLHS	TBD
5/4/2024	Herb Day	10-3pm	Creekside	CVB	Plant Sale
5/10/2024 Tentative	Soirre at the Sancturary 175	TBD	Gahanna Sanctuary	175	175 Event
5/30/2024	Kayak 101	4-6pm	TBD	GPR	Learn to Paddle
6/7/2024	Creekside Live	5-10pm	Creekside	GPR	Summer Concert Series
6/14-6/16	Blues and Jazz Festival	All weekend	Creekside	CVB	City Music Festival
6/21/2024	Moonlight Paddle	7-9pm	Hoover Reservoir	GPR	Evening Float
6/21/2024	Cinema Under the Stars	7-11pm	Friendship Park	GPR	Movie Series
6/22/2024	Celebrating One 5k	6am-12pm	Route B- Creekside	Celebrating One	5k
6/26/2024	Kayak Float		TBD	GPR	River Float
6/28/2024	Creekside Live	5-10pm	Creekside	GPR	Summer Concert Series
6/29/2024	Luau Night	5-9pm	Hunters Ridge	GPR	Evening Luau themed event
7/3/2024	Independence Day Celebration	All Day	Golf Course	GPR	Fireworks
7/4/2024	Independence Day Parade	10:30a	Moving Route	Lions	Parade
7/12/2024	Creekside Live	5-10pm	Creekside	GPR	Summer Concert Series
7/15/2024	Kayak 101	4-6pm	TBD	GPR	Learn to Paddle
7/19/2024	Cinema Under the Stars	7-11pm	Friendship Park	GPR	Movie Series
7/21/2023	Sunrise Paddle	7-10am	Hoover Reservoir	GPR	Evening Float
7/26/2024	Creekside Live	5-10pm	Creekside	GPR	Summer Concert Series
7/27/2024	Adult Summer Camp	3-9pm	GSP	GPR	Adult Camp 21+
8/3/2024	Car Show	11-6pm	Creekside	Corvette Club	Car Show with 200+ vehicles
8/4/2024	Cardboard Boat Regatta	1-6pm	GSP	GPR	Boat Regatta
8/6/2024	National Night Out	6-8pm	Sunpoint Park	GPD	National Night Out
8/9/2024	Creekside Live	5-10pm	Creekside	GPR	Summer Concert Series
8/8-8/11	Gahanna 175	TBD	City Wide	GPR	Birthday
8/16/2024	Cinema Under the Stars	7-11pm	Friendship Park	GPR	Movie Series
8/18/2024	Muddy Miler	1-4pm	Flood Plains	GPR	Muddy 5k
8/19/2024	Moonlight Paddle	7-9am	Hoover Reservoir	GPR	Float
8/23/2024	Creekside Live	5-10pm	Creekside	GPR	Summer Concert Series
8/24/2024	All Day Float	9-3pm	Creekside-Whitehall	GPR	Partner Float
9/6/2024	Paint & Paddle	6-8pm	TBD	GPR	Paint & Paddle
9/7/2024	Hops and Vines	TBD	Creekside	GPRF	Fundraisor for parks and rec
9/8/2024	Kyle Miller Shoes for Kids 5k	7-11am	Route B- Creekside	Kyle Miller	5k
9/8/2024	Doggy Dip	1-4pm	GSP	GPR	Doggy Swim
9/17/2024	Moonlight Paddle	7-9pm	Hoover Reservoir	GPR	Evening Float
9/21/2024	Touch-a-Truck	9-1pm	Hannah Park	GPR	Touch-a-Truck
9/21/2024	Lydies Loop				
9/29/2024	Flea Market	TBD	Creekside	Historical Society	Market
10/25/2024	Goblin Fest	5:30-9:30pm	Academy Park	GPR	Halloween Event
11/15/2024	Murder Mystery	7-10pm	Price Rd.	GPR	Murder Myster 21+
11/24/2024	Holiday Lights	3-6:30pm	Creekside	CVB	Santa is coming to town
TBD	Santa Race	TBD	Creekside	Speedy Sneakers	5k Route A
12/7/2024	Tea for You and Me	10-12pm	Price Rd.	GPR	Tea Party
Wednesdays Jun-Aug	Farmers Market	TBD	TBD	GPR	Farmers Market
Wednesdays Jun-Aug	Midweek at the Creek	6-8pm	Creekside Park	CDC	Free Concert

APPENDIX B

PREVAILING WAGE

AND

FEDERAL FUNDING

Prevailing Wage Contract

Yes* (X)

No ()

If yes:

State (X)

Federal** ()

*If yes, current applicable Prevailing Wage Rates can be found on an enclosed CD-ROM disk. Please request a hard copy from the City if needed.

**If Federal, Contract Documents with contract terms relating to the federal funding are attached. (Please request documents from the City if none are attached.)

STATE OF OHIO REQUEST FOR PREVAILING WAGE RATES

Important: If you wish to retain a copy of this form for your records, please print it prior to clicking on the "Submit" button. When you click the "Submit" button, a prompt should appear which will allow you to obtain the necessary wage rates by clicking on the "view wage rates" button. Submitting this form notifies the Bureau of Labor and Worker Safety of your project. Wage rates will not be sent to you by mail as a result of the submission, rather you should obtain them by clicking on the "view wage rates" button.

Public Authority Information

Owner/Public Authority Name:	City of Gahanna	Date: 01/22/2024 This form must be filled out completely & correctly for us to process your request. Forms not completed correctly will be returned to the sender.
Department Division or Agency:	Engineering	
Street Address:	200 S. Hamilton Road	ODOC Date Stamp
Address 2:		
City, OH	GAHANNA	
ZIP:	43230	
Email:	<div></div> It is required that you list your e-mail address here.	
County of Public Authority:	FRANKLIN ▼	
P.A. Phone:	614-342-4050	

Project Information

Project Name:	2024 Street and Sidewalk Program, ST-1110	ODOC Date Stamp (Bld Tab)
Site Address:	Various Locations in Gahanna	
City, OH	GAHANNA	
ZIP:	43230	
County of Project:	FRANKLIN ▼	
Prevailing Wage Coordinator Name	Jill Webb	
Address:	200 S. Hamilton Road	
City,	GAHANNA	
ZIP:	43230	
Phone:	614-342-4050	
Issuing Authority of Bonds:		
Estimated Total Overall Project Cost:	\$5,197,000.00	
Type of Financing:	Local Funds	
Type of Construction:	<input type="radio"/> New Construction <input checked="" type="radio"/> Old Construction	
This Project is	<input type="radio"/> Residential <input checked="" type="radio"/> Commercial	

Expected Date of Contract Award:	<input type="text" value="04/02/24"/> example 05/31/98
Projected Completion Date:	<input type="text" value="10/01/2024"/> example 05/31/98
Project Comments:	<div><div></div><div>(optional)</div></div>

Important: If you wish to retain a copy of this form for your records, please print it prior to clicking on the "Submit" button. When you click the "Submit" button, a prompt should appear which will allow you to obtain the necessary wage rates by clicking on the "view wage rates" button. Submitting this form notifies the Bureau of Labor and Worker Safety of your project. Wage rates will not be sent to you by mail as a result of the submission, rather you should obtain them by clicking on the "view wage rates" button.

Please contact our [Webmaster](#) with questions or comments.

LAW 1002



- ▶ [forms](#)
- ▶ [contacts](#)
- ▶ [about LAWS](#)
- ▶ [search](#)

Ohio Department of Commerce

Bureau of Wage & Hour Administration

[Consumers](#)
[Business](#)
[License/Permit Holders & Applicants](#)
[Other Government Agencies](#)
[Back to wage rate search](#) [Back to Home](#)
Classification = All, County = FRANKLIN, Union = All

County	Classification	Effective	Posted	Union
FRANKLIN	Asbestos Worker	8/23/2018	8/23/2018	Asbestos Local 207 OH
FRANKLIN	Asbestos Worker	7/5/2023	7/5/2023	Asbestos Local 50 Zone 1
FRANKLIN	Boilermaker	10/1/2013	9/25/2013	Boilermaker Local 105
FRANKLIN	Bricklayer	6/7/2023	6/7/2023	Bricklayer Local 23 Heavy Hwy (A)
FRANKLIN	Bricklayer	6/7/2023	6/7/2023	Bricklayer Local 23 Heavy Hwy (B)
FRANKLIN	Bricklayer	6/1/2023	5/31/2023	Bricklayer Local 23 (Columbus Tile Finisher)
FRANKLIN	Bricklayer	6/1/2023	5/31/2023	Bricklayer Local 23 (Columbus Tile Setter)
FRANKLIN	Bricklayer	6/1/2023	5/31/2023	Bricklayer Local 23 (Columbus)
FRANKLIN	Carpenter	5/10/2023	5/10/2023	Carpenter Millwright Local 1090 Columbus
FRANKLIN	Carpenter	3/5/2014	3/5/2014	Carpenter NE District Industrial Dock & Door
FRANKLIN	Carpenter	5/10/2023	5/10/2023	Carpenter & Pile Driver Local 200
FRANKLIN	Carpenter	5/17/2023	5/17/2023	Carpenter & Piledriver SC District HevHwy
FRANKLIN	Cement	1/10/2024	1/10/2024	Cement Mason Local 132 (Columbus)
FRANKLIN	Cement Mason	5/1/2023	4/26/2023	Cement Mason Statewide HevHwy
FRANKLIN	Electrical	1/1/2024	12/28/2023	Electrical Local 683 Inside
FRANKLIN	Electrical	1/1/2024	12/27/2023	Electrical Local 683 Inside Lt Commercial South West
FRANKLIN	Voice Data Video	5/29/2023	5/24/2023	Electrical Local 683 Voice Data Video
FRANKLIN	Lineman	3/1/2023	3/1/2023	Electrical Local 71 High Tension Pipe Type Cable
FRANKLIN	Lineman	3/1/2023	3/1/2023	Electrical Local 71 Outside Utility Power
FRANKLIN	Lineman	3/1/2023	3/1/2023	Electrical Local 71 Outside (Central OH Chapter)
FRANKLIN	Voice Data Video	1/10/2024	1/10/2024	Electrical Local 71 Voice Data Video Outside
FRANKLIN	Elevator	1/1/2024	12/27/2023	Elevator Local 37
FRANKLIN	Glazier	11/1/2020	10/28/2020	Glazier Local 372
FRANKLIN	Ironworker	6/1/2023	5/31/2023	Ironworker Local 172
FRANKLIN	Laborer Group 1	5/1/2023	4/26/2023	Labor HevHwy 3
FRANKLIN	Laborer	9/20/2023	9/20/2023	Labor Local 423
FRANKLIN	Operating Engineer	5/1/2023	4/26/2023	Operating Engineers - Building Local 18 - Zone III
FRANKLIN	Operating Engineer	5/1/2023	4/26/2023	Operating Engineers - HevHwy Zone II
FRANKLIN	Drywall Finisher	11/22/2023	11/22/2023	Painter Local 1275
FRANKLIN	Painter	11/22/2023	11/22/2023	Painter Local 1275
FRANKLIN	Painter	11/22/2023	11/22/2023	Painter Local 1275 HevHwy
FRANKLIN	Painter	11/22/2023	11/22/2023	Painter Local 1275 Industrial
FRANKLIN	Painter	6/10/2015	6/10/2015	Painter Local 639
FRANKLIN	Painter	3/22/2023	3/22/2023	Painter Local 639 Zone 2 Sign
FRANKLIN	Plasterer	6/1/2023	5/31/2023	Plasterer Local 132 (Columbus)
FRANKLIN	Plumber Pipefitter	6/1/2023	5/31/2023	Plumber Pipefitter Local 189
FRANKLIN	Roofer	9/13/2023	9/13/2023	Roofer Local 86
FRANKLIN	Sheet Metal Worker	8/12/2022	8/12/2022	Sheet Metal Local 24 Columbus
FRANKLIN	Sprinkler Fitter	4/6/2022	4/6/2022	Sprinkler Fitter Local 669
FRANKLIN	Truck Driver	5/1/2023	4/26/2023	Truck Driver Bldg & HevHwy Class 1 Locals 20,40,92,92b,100,175,284,438,377,637,908,957
FRANKLIN	Truck Driver	5/1/2023	4/26/2023	Truck Driver Bldg & HevHwy Class 2 Locals 20,40,92,92b,100,175,284,438,377,637,908,957
FRANKLIN	Truck Driver	5/1/2023	4/26/2023	Truck Driver Bldg & HevHwy Class 3 Locals 20,40,92,92b,100,175,284,438,377,637,908,957

[Back to home](#)

Prevailing Wage Determination Cover Letter

County: FRANKLIN ▼
Determination Date: 01/22/2024
Expiration Date: 04/22/2024

THE FOLLOWING PAGES ARE PREVAILING RATES OF WAGES ON PUBLIC IMPROVEMENTS FAIRLY ESTIMATED TO BE MORE THAN THE AMOUNT IN O.R.C. SEC. 4115.03 (b) (1) or (2), AS APPLICABLE.

Section 4115.05 provides, in part: "Where contracts are not awarded or construction undertaken within ninety days from the date of the establishment of the prevailing wages, there shall be a redetermination of the prevailing rate of wages before the contract is awarded." The expiration date of this wage schedule is listed above for your convenience only. This wage determination is not intended as a blanket determination to be used for all projects during this period without prior approval of this Department.

Section 4115.04, Ohio Revised Code provides, in part: "Such schedule of wages shall be attached to and made a part of the specifications for the work, and shall be printed on the bidding blanks where the work is done by contract..."

The contract between the letting authority and the successful bidder shall contain a statement requiring that mechanics and laborers be paid a prevailing rate of wage as required in Section 4115.06, Ohio Revised Code.

The contractor or subcontractor is required to file with the contracting public authority upon completion of the project and prior to final payment therefore an affidavit stating that he has fully complied with Chapter 4115 of the Ohio Revised Code.

The wage rates contained in this schedule are the "Prevailing Wages" as defined by Section 4115.03, Ohio Revised Code (the basic hourly rates plus certain fringe benefits). These rates and fringes shall be a minimum to be paid under a contract regulated by Chapter 4115 of the Ohio Revised Code by contractors and subcontractors. The prevailing wage rates contained in this schedule include the effective dates and wage rates currently on file. In cases where future effective dates are not included in this schedule, modifications to the wage schedule will be furnished to the Prevailing Wage Coordinator appointed by the public authority as soon as prevailing wage rates increases are received by this office.

"There shall be posted in a prominent and accessible place on the site of work a legible statement of the Schedule of Wage Rates specified in the contract to the various classifications of laborers, workmen, and mechanics employed, said statement to remain posted during the life of such contract." Section 4115.07, Ohio Revised Code.

Apprentices will be permitted to work only under a bona fide apprenticeship program if such program exists and if such program is registered with the Ohio Apprenticeship Council.

Section 4115.071 provides that no later than ten days before the first payment of wages is due to any employee of any contractor or subcontractor working on a contract regulated by Chapter 4115, Ohio Revised Code, the contracting public authority shall appoint one of his own employees to act as the prevailing wage coordinator for said contract. The duties of the prevailing wage coordinator are outlined in Section 4115.071 of the Ohio Revised Code.

Section 4115.05 provides for an escalator in the prevailing wage rate. Each time a new rate is established, that rate is required to be paid on all ongoing public improvement projects.

A further requirement of Section 4115.05 of the Ohio Revised Code is: "On the occasion of the first pay date under a contract, the contractor shall furnish each employee not covered by a collective bargaining agreement or understanding between employers and bona fide organizations of Labor with individual written notification of the job classification to which the employee is assigned, the prevailing wage determined to be applicable to that classification, separated into the hourly rate of pay and the fringe payments, and the identity of the prevailing wage Coordinator appointed by the public authority. The contractor or subcontractor shall furnish the same notification to each affected employee every time the job classification of the employee is changed."

Work performed in connection with the installation of modular furniture may be subject to prevailing wage.

THIS PACKET IS NOT TO BE SEPARATED BUT IS TO REMAIN COMPLETE AS IT IS SUBMITTED TO YOU. (Reference guidelines and forms are included in this packet to be helpful in the compliance of the Prevailing Wage law.)
wh1500

PREVAILING WAGE THRESHOLD LEVELS

IMPORTANT NOTICE

Before advertising for bids, contracting, or undertaking construction with its own forces, to construct a public improvement, the Public Authority shall have the Ohio Department of Commerce-Division of Industrial Compliance, Bureau of Wage and Hour Administration determine the prevailing rates of wages for workers employed on the public improvement. The wage determination must be included in the project specifications and printed on the bidding blanks where work is done by contract.

“New” construction threshold for <i>Building Construction</i>:	\$250,000
---	------------------

“Reconstruction, enlargement, alteration, repair, remodeling, renovation, or painting” threshold level for <i>Building Construction</i>:	\$75,000
---	-----------------

As of January 1, 2022:

“New” construction that involves <i>roads, streets, alleys, sewers, ditches and other works connected to road or bridge construction</i> threshold level has been adjusted to:	\$96,091
---	-----------------

“Reconstruction, enlargement, alteration, repair, remodeling, renovation, or painting” that involves <i>roads, streets, alleys, sewers, ditches and other works connected to road or bridge construction</i> threshold level has been adjusted to:	\$28,789
---	-----------------

- A) Thresholds are to be adjusted biennially by the Director of the Ohio Department of Commerce.
- B) Biennial adjustments to threshold levels are made according to the Building Cost for Skilled Labor Index published by McGraw-Hill’s Engineering News-Record, but may not increase or decrease more than 3% for any year.

If there are questions concerning this notification, please contact:

Ohio Department of Commerce
Division of Industrial Compliance
Bureau of Wage and Hour Administration
6606 Tussing Road, PO Box 4009
Reynoldsburg, Ohio 43068-9009
Phone: 614-644-2239
Fax: 614-728-8639
www.com.ohio.gov

PREVAILING WAGE CONTRACTOR RESPONSIBILITIES

This is a summary of prevailing wage contractors' responsibilities. For more detailed information please refer to Chapter 4115 of the Ohio Revised Code

General Information

Ohio's prevailing wage laws apply to all public improvements financed in whole or in part by public funds when the total overall project cost is fairly estimated to be more than \$250,000 for new construction or \$75,000 for reconstruction, enlargement, alteration, repair, remodeling, renovation, or painting.

Ohio's prevailing wage laws apply to all public improvements financed in whole or in part by public funds when the total overall project cost is fairly estimated to be more than \$91,150 for new construction that involves roads, streets, alleys, sewers, ditches and other works connected to road or bridge construction or \$27,309 for reconstruction, enlargement, alteration, repair, remodeling, renovation, or painting of a public improvement that involves roads, streets, alleys, sewers, ditches and other works connected to road or bridge construction.

- a) Thresholds are to be adjusted biennially by the Administrator of Ohio Department of Commerce, Division of Industrial Compliance and Labor, Bureau of Wage and Hour Administration
- b) Biennial adjustments to threshold levels are made according to the Price Deflator for Construction Index, United States Department of Commerce, Bureau of the Census*, but may not increase or decrease more than 3% for any year

Penalties for violation

Violators are to be assessed the wages owed, plus a penalty of 100% of the wages owed.

Intentional Violations

If an intentional violation is determined to have occurred, the contractor is prohibited from contracting directly or indirectly with any public authority for the construction of a public improvement. Intentional violation means "a willful, knowing, or deliberate disregard for any provision" of the prevailing wage law and includes but is not limited to the following actions:

- Intentional failure to submit payroll reports as required, or knowingly submitting false or erroneous reports.
- Intentional misclassification of employees for the purpose of reducing wages.
- Intentional misclassification of employees as independent contractors or as apprentices.
- Intentional failure to pay the prevailing wage.
- Intentional failure to comply with the allowable ratio of apprentices to skilled workers as required by the regulations established by Ohio Department of Commerce, Division of Industrial Compliance and Labor, Bureau of Wage and Hour Administration.
- Intentionally employing an officer, of a contractor or subcontractor, that is known to be prohibited from contracting, directly or indirectly, with a public authority.

Responsibilities

- A. Pay the prevailing rate of wages as shown in the wage rate schedules issued by the Ohio Department of Commerce, Division of Industrial Compliance and Labor, Bureau of Wage and Hour Administration, for the classification of work being performed.
 - 1. Wage rate schedules include all modifications, corrections, escalations, or reductions to wage rates issued for the project.
 - 2. Overtime must be paid at time and one-half the employee's base hourly rate. Fringe benefits are paid at straight time rate for all hours including overtime.
 - 3. Prevailing wages must be paid in full without any deduction for food, lodging, transportation, use of tools, etc.; unless, the employee has voluntarily consented to these deductions in writing. The public authority and the Director of Ohio Department of Commerce, Division of Industrial Compliance and Labor, Bureau of Wage and Hour Administration - must approve these deductions as fair and reasonable. Consent and approval must be obtained before starting the project.
- B. Use of Apprentices and Helpers cannot exceed the ratios permitted in the wage rate schedules.
 - 1. Apprentices must be registered with the U.S. Department of Labor Bureau of Apprenticeship and Training.
 - 2. Contractors must provide the Prevailing Wage Coordinator a copy of the Apprenticeship Agreement for each apprentice on the project.
- C. Keep full and accurate payroll records available for inspection by any authorized representative of the Ohio Department of Commerce, Division of Industrial Compliance, and Labor, Bureau of Wage and Hour Administration or the contracting public authority, including the Prevailing Wage Coordinator. Records should include but are not limited to:
 - 1. Time cards, time sheets, daily work records, etc.
 - 2. Payroll ledger\journals and canceled checks\check register.
 - 3. Fringe benefit records must include program, address, account number, & canceled checks.
 - 4. Records made in connection with the public improvement must not be removed from the State for one year following the completion of the project.
 - 5. Out-of-State Corporations must submit to the Ohio Secretary of State the full name and address of their Statutory Agent in Ohio.
- D. Prevailing Wage Rate Schedule must be posted on the job site where it is accessible to all employees.
- E. Prior to submitting the initial payroll report, supply the Prevailing Wage Coordinator with your project dates to schedule reporting of your payrolls.
- F. Supply the Prevailing Wage Coordinator a list of all subcontractors including the name, address, and telephone number for each.
 - 1. **Contractors are responsible for their subcontractors' compliance with requirements of Chapter 4115 of the Ohio Revised Code.**



- G. Before employees start work on the project, supply them with written notification of their job classification, prevailing wage rate, fringe benefit amounts, and the name of the Prevailing Wage Coordinator for the project. A copy of the completed signed notification should be submitted to Prevailing Wage Coordinator.
- H. Supply all subcontractors with the Prevailing Wage Rates and changes.
- I. Submit certified payrolls within two (2) weeks after the initial pay period. Payrolls must include the following information:
 - 1. Employees' names, addresses, and social security numbers.
 - a. Corporate officers/owners/partners and any salaried personnel who do physical work on the project are considered employees. All rate and reporting requirements are applicable to these individuals.
 - 2. Employees' work classification.
 - a. Be specific about the laborers and/or operators (Group)
 - b. For all apprentices, show level/year and percent of journeyman's rate
 - 3. Hours worked on the project for each employee.
 - a. The number of hours worked in each day and the total number of hours worked each week.
 - 4. Hourly rate for each employee.
 - a. The minimum rate paid must be the wage rate for the appropriate classification. The Department's Wage Rate Schedule sets this rate.
 - b. All overtime worked is to be paid at time and one-half for all hours worked more than forty (40) per week.
 - 5. Where fringes are paid into a bona fide plan instead of cash, list each benefit and amount per hour paid to program for each employee.
 - a. When the amount contributed to the fringe benefit plan and the total number of hours worked by the employee on all projects for the year are documented, the hourly amount is calculated by dividing the total contribution of the employer by the total number of hours worked by the employee.
 - b. When the amount contributed to the fringe benefit is documented but not the total hours worked, the hourly amount is calculated by **dividing the total yearly contribution by 2080.**
 - 6. Gross amount earned on all projects during the pay period.
 - 7. Total deductions from employee's wages.
 - 8. Net amount paid.
- J. The reports shall be certified by the contractor, subcontractor, or duly appointed agent stating that the payroll is correct and complete; and that the wage rates shown are not less than those required by the O.R.C. 4115.
- K. Provide a Final Affidavit to the Prevailing Wage Coordinator upon the completion of the project.

Many of our staff are teleworking to stop community spread of the coronavirus (COVID-19). Our office will also not be accepting walk-in customers. The Division is still operational, and customers will still be able to drop off plans, applications and other documents, but we ask that you first work through our web portal, where you can also submit payments. There are no convenience fees for online payment. Please call us at 614-644-2223 or email us at IC@com.state.oh.us with any questions. Thanks for your patience.

INSTRUCTIONS FOR PREPARING CERTIFIED PAYROLL REPORTS

General

Contractors and subcontractors are required by law to submit certified payroll reports for work on projects covered by Ohio's Prevailing Wage Law. This form meets the reporting requirements established by Ohio Revised Code Chapter 4115. The use of this form is not mandatory, employers may submit their own forms provided that all of the required information is included. This form may be reproduced, or additional copies obtained from:

Ohio Department of Commerce Division of Industrial Compliance and Labor Bureau of Wage & Hour Administration 6606 Tussing Rd. P. O. Box 4009 Reynoldsburg, OH 43068-9009 Phone: (614) 644-2239

Certified Payroll Heading

Employer name and address: Company's full name and address. Indicate if the company is a subcontractor, if so list the name of the General or Prime. Project: Name and location of the project, including county. Contracting Public Authority: Name and address of the contracting public authority. Week Ending: Month, day, and year for last day of reporting period. Payroll #: Indicates first, second, third, etc. payroll filed by the company for the project. Page indicator: number of pages included in the report. Project Number: Determined by the public authority. If there is no number leave blank.

Information by Column

- 1. Employee Name, Address and Social Security number: This information must be provided for all employees that perform physical labor on the project. Corporate officers, partners, and salaried employees are considered employees and must be paid the prevailing rate. Individual sole proprietors do not have to pay themselves prevailing rate but must report their hours on the project.
- 2. Work Class: List classification of work actually performed by employee. If unsure of work classification, consult the Ohio department of Commerce, Wage and Hour Bureau. Employees working more than one classification should have separate line entries for each classification. Indicate what year/level for Apprentices. Be specific when using laborer and operator classifications; for example, Backhoe Operator or Asphalt Laborer.
- 3. Hours Worked, Day & Date: In the first row of column 3 enter days of pay period example; M T W T H F S S. The second row is for the date that corresponds with each day for the pay period. In the employee information section enter the number of hours worked on the prevailing wage project and which day the hours were worked. Separate rows are labeled for (ST) straight time hours and (OT) overtime hours. All hours worked after 40, must be paid at the appropriate overtime rate.
- 4. Project Total Hours : Total the hours entered for pay period.
- 5. Base Rate: Enter actual rate per hour paid to the employee. The overtime hourly rate is time and one-half the base rate listed in the prevailing wage schedule plus fringe benefits at straight time rate. The prevailing wage schedule lists the base rate plus fringe benefit amounts. These amounts added together equal the total prevailing wage rate. Employers must pay this total amount in one of three ways.
 - Total rate may be paid in entirety in the base rate to the employee; in which case, the cash designation will be checked for fringe benefits.
 - Total rate may be paid as listed in prevailing wage rate schedule with total fringe amounts paid approved plans.
 - Total rate may be paid with a combination of base rate and fringe payments to approved plans in amounts other than those listed in schedule.
- 6. Project Gross: Enter total gross wages earned on the project for straight time and overtime. Project hours X base rate should equal project gross.
- 7. Fringes: If fringe benefits are paid in the hourly base rate, indicate this by marking the cash space. If fringe benefits are paid to approved plans as listed in the prevailing wage rate schedule, mark the space Approved Plans. If fringe benefits are paid partially in the base rate and partially to approved plans, mark the space Cash & Approved plans. List the hourly amount paid to approved plans for each fringe. If payments are not made on a per hour basis, calculate the hourly fringe credit by dividing the yearly employer contribution by the lesser of: hours actually worked in the year (these must be documented) or 2080. Fringe benefits include: Employer's share of health insurance, life insurance, retirement plan, bonus/profit sharing, sick pay, holiday pay, personal leave, vacation, and education/training programs.
- 8. Total Hours All Jobs: Total all hours worked during the pay period including non-prevailing wage jobs.
- 9. Total Gross All Jobs: Gross amount earned in the pay period for all hours worked.
- 10. Self explanatory.
- 11. Self explanatory.
- 12. Self explanatory.

CONTACT US

Division of Industrial Compliance & Labor
6606 Tussing Road
Reynoldsburg, OH 43068

Phone 614.644.2223
Fax 614.644.2618
Email IC@com.state.oh.us

Webmaster
Contact the Webmaster for Questions
or Comments on the Website:
webmaster@com.state.oh.us

CONNECT WITH US**LOOKUP SERVICES**

Registered Contractor List
Boiler Information Database
Building Code Compliance Electronic Plan
Submission
Board Of Building Appeals Case Lookup
Elevator Database Lookup

RESOURCES

Federal Wage and Hour
U.S. Consumer Product Safety
Commission
National Electric, Fire Alarm and Sprinkler
Codes
Minor Labor Law Poster
2017 Minimum Wage Poster
2018 Minimum Wage Poster

**ABOUT INDUSTRIAL
COMPLIANCE**

Director Sheryl Maxfield
Superintendent Geoff Eaton

Ohio.gov

Copyright©2012 Ohio Department of Commerce. All Rights Reserved

Certified Payroll Report

Report for: ☐ Check if Subcontractor¹⁾ Contract No: _____ Payroll No: _____

Company:¹⁾ _____ If Sub, GC/Prime Contractor Name: _____

Address: _____ Project Name & Location: _____ Week Ending: _____

City, State, Zip _____ Public Authority (Owner): _____

Phone No: _____ Sheet:²⁾ _____ of _____

1. Employee Name, Address, & SS# (Last 4 digits if permitted)	2.Work Class ³⁾	3.Prevaling Wage Project Hours Worked - Day & Date							4.Total Hours	5.Base Rate	6.Project Gross	7. Fringes: <input type="checkbox"/> Cash <input type="checkbox"/> Approved Plans <input type="checkbox"/> Cash & Approved Plans						Weekly Payroll Amount			
												Fringe Rate Your Company Pays Per Hour						8.Total Hrs for all Jobs	9. Total Gross on All Jobs	10. Total Deductions	11. Net Pay on All Jobs
												H&W	Pens	Vac	Hol	Other	Total				
		OT																			
		ST																			
		OT																			
		ST																			
		OT																			
		ST																			
		OT																			
		ST																			
		OT																			
		ST																			

1) By signing below, I certify that: (1) I pay, or supervise the payment of the employees shown above; (2) during the pay period reported on this form, all hours worked on this project have been paid at the appropriate prevailing wage rate for the class of work done; (3) the fringe benefits have been paid as indicated above; (4) no rebates or deductions have been or will be made, directly or indirectly from the total wages earned, other than permissible deductions as defined in ORC Chapter 4115; and (5) apprentices are registered with the U.S. Dept. of Labor, Bureau of Apprenticeship and Training. I understand that the willful falsification of any of the above statements may subject the Contractor or Subcontractor to civil or criminal prosecution.

Type or Print Name and Title _____ Signature _____ Date _____



Affidavit of Compliance

Prevailing Wages

I, _____
(Name of person signing affidavit) (Title)

do hereby certify that the wages paid to all employees of

(Company Name)

for all hours worked on the

(Project name and location)

project, during the period from _____ to _____ are in
(Project Dates)

compliance with prevailing wage requirements of Chapter 4115 of the Ohio Revised Code. I further certify that no rebates or deductions have been or will be made, directly or indirectly, from any wages paid in connection with this project, other than those provided by law.

(Signature of Officer or Agent)

Sworn to and subscribed in my presence this _____ day of _____, 20_____.

(Notary Public)

The above affidavit must be executed and sworn to by the officer or agent of the contractor or subcontractor who supervises the payment of employees. This affidavit must be submitted to the owner (public authority) before the surety is released or final payment due under the terms of the contract is made.



- ▶ forms
- ▶ contacts
- ▶ about LAWS
- ▶ search

Ohio Department of Commerce Bureau of Wage & Hour Administration

[Consumers](#)[Business](#)[License/Permit Holders & Applicants](#)[Other Government Agencies](#)

Submitting Union Contract Information

The Ohio Department of Commerce, Bureau of Wage & Hour, will no longer take union contract information for the establishment of prevailing wage rates via the web. The majority of information from the unions submitted in this manner was not supported with an associated mailing of the actual union contract and an affidavit as required. The Bureau will continue to make every effort to post up to date wage rates as efficiently as possible. In order to do so, those submitting information to the Bureau on behalf of the unions must:

- 1) submit contract information in a timely manner via fax, regular US Mail, or other non-electronic method
- 2) contract information submitted must be the actual signed union contract

Please send the appropriate information to:

Bureau of Wage & Hour
Attn: Kathy Peck
6606 Tussing Road, P.O. Box 4009
Reynoldsburg, Ohio 43068-9009

[commerce home](#) / [forms](#) / [contacts](#) / [press room](#) / [feedback](#) / [privacy policy](#)

APPENDIX C

DOCUMENTS TO BE SUBMITTED WITH BID

General Info

Alt Total: \$365,826.17

Total:

\$4,899,580.69

Number	Description
2024 Street and Sidewalk Program, ST-1110	The base bid Project consists of concrete work, pavement milling, asphalt resurfacing, crack sealing, micro surfacing, street rebuilds, sidewalk, and striping.
Deadline	Allows zero unit prices and labor
02/13/2024 11:00 AM EST	Yes
Vendor	Allows negative unit prices and labor
Strawser Paving Company	No
Submitted	
02/13/2024 10:46 AM EST	
Signed by	
Kyle strawser	
Opened	
02/13/2024 11:01 AM EST By jill.webb@gahanna.gov	

VENDOR RESOURCES

Vendor Resources Page
Informational page containing instructional videos for vendors.

BidExpress Customer Support Team
Customer support contact. Available Monday-Friday from
7:00am-8:00pm eastern time.

ATTACHMENT LIST

Notice to Bidders.pdf (90 KB)

Information & Requirements for Bidders.pdf (177 KB)

2024 Supplemental Specifications.pdf (2.18 MB)

2024 Events Calender.pdf (95.1 KB)

Roller Compacted Concrete Pavements.pdf (121 KB)

Reclamite Standard Specifications.pdf (25.9 KB)

PW Documents.pdf (2.86 MB)

2024 Detail Sheets.pdf (734 KB)

Rebuild Profile ST188-Tim Tam E 1 of 2.PDF (36.9 MB)

Rebuild Profile ST238-Haybrook Dr..PDF (42 MB)

Rebuild Profile ST293-Cam Ct..pdf (19 MB)

Rebuild Profile ST364-Coldwell Ct..PDF (8.7 MB)

Rebuild Profile ST366-Windrow Ct..PDF (28.1 MB)

Rebuild Profile ST382-Windbourne St & Timothy Ct..PDF (8.63 MB)

Rebuild Profile ST406-Tim Tam E 2 of 2.PDF (19 MB)

Rebuild Profile ST450-Tim Tam W.PDF (8.88 MB)

Updated Typical Section.pdf (475 KB)

2024 Street Program Map.pdf (1.99 MB)

2024 Sidewalk Program Map.pdf (1.8 MB)

2024-01-15 Gahanna Municipal Golf Course Cart Path Improvements.pdf (4.29 MB)

Owner Contractor Agreement and Admin Docs.pdf (1000 KB)
This is solely for informational purposes. This form is only filled out once the contract award is issued.

CMS Supplement.pdf (102 KB)

2024 Professional Services Form.pdf (97.4 KB)
Please sign & upload a .pdf copy to the Contractor's Qualification Statement, Additional Material section within Bid Express.

Bid Guaranty and Contract Bond.pdf (10.8 KB)

Please sign & upload a .pdf copy to the Bid Guaranty & Contract Bond & Surety Upload section within Bid Express.

Addendum 1_2024 Street and Sidewalk Program ST-1110.pdf (2.2 MB)

Please sign & upload a .pdf copy to the Contractor's Qualification Statement, Additional Material Section within Bid Express

PREVAILING WAGE RATES

Current Prevailing Wage Rates are to be included in the contract. The current rates become part of the contract awarded to the lowest and best bidder. The links listed below provide access to forms, regulations, and general information on prevailing wage compliance. These are for information purposes only.

[Prevailing Wage Rates](#)

[Forms & Publications](#)

CONTRACTOR’S QUALIFICATION STATEMENT

The bidder is required to state the following in full detail as will enable the Director of Public Service and Engineering and Council of the City of Gahanna to judge its responsibility, experience, skill and financial standing to meet the obligations of the Contract.

ORGANIZATION:

(a) Number of years your organization has been in business as a Contractor: *

70

(b) Number of years your organization has been in business under its present business name. List any other or former names your organization has operated under. *

70

(c) If your organization is a corporation, list the following: date of incorporation, state of incorporation, President’s name, Vice President’s name(s), Secretary’s name and Treasurer’s name. If not applicable, state “not applicable.” *

1954, OH
Kyle Strawser - President
Clay Strawser - Vice President
Corey Strawser - Secretary - Treasurer

(d) If your organization is a partnership, list the following: date of organization, type of partnership (if applicable) and name(s) of general partner(s). If not applicable, state “not applicable.” *

n/a

(e) If your organization is individually owned, list the following: date of organization and name of owner. If not applicable, state “not applicable.” *

n/a

(f) If the form of your organization is other than those listed above, describe it and name the principals. If not applicable, state "not applicable." *

n/a

LICENSING:

(a) List jurisdictions and trade categories in which your organization is legally qualified to do business, and indicate registration or license numbers, if applicable. *

Columbus - #G02223
Columbus - #SW00179

(b) List jurisdictions in which your organization's partnership or trade name is filed. *

none

EXPERIENCE:

(a) List the categories of work that your organization normally performs with its own forces. *

asphalt/paving/concrete/milling

(b) List all details of any work your organization has failed to complete. If none, state "none." *

none

(c) List any Claims that your organization or any of its officers have initiated, any Claims initiated against your

organization or any of its officers, any mediation or arbitration proceedings or lawsuits related to any contract your organization or any of its officers have been involved in or is currently involved in, or any judgements or awards outstanding against your organization or any of its officers within the last five (5) years. Please give details for each Claim, including the names and telephone numbers of the persons who are parties, the amount of the Claim, the type of Claim and basis for the Claim, and the outcome. If none, state "none." *

CIVIL CLAIM - CASE 23CV-05-3200 Franklin County Ohio

Note: As used in this document "Claim" means a Claim initiated under the Contract Documents for a contract.

(d) List any officer or principal of your organization that has ever been an officer or principal of another organization when it failed to complete a contract within the last five (5) years. Please give details for each instance, including the names and telephone numbers of the persons who are parties to the contract, and the reason(s) the contract was not completed. If none, state "none." *

none

(e) List contracts your organization has in progress with an original contract sum of more than \$100,000.00, giving the name of contract, owner and its telephone number, design professional and its telephone number if applicable, contract amount, percent complete and scheduled completion date. State total amount of work in progress and under contract. If none, state "none." *

uploaded

(f) Provide the following information for each contract your organization has had during the last five (5) years, including current contracts, where the contract sum is fifty percent (50%) or more of the bid amount for this Contract, including add alternates: name of contract, scope of work, contract sum, name of owner's representative and owner's telephone number. *

uploaded

Note: If there are more than ten (10) of these contracts, only provide information on the most recent ten (10) contracts, including current contracts.

(g) Provide the following information for each contract your organization has had during the last five (5) years, which your organization believes is of comparable or greater size and complexity than the Owner's contract: name of contract, scope of work, contract sum, name of owner's representative and owner's telephone number. *

uploaded

Note: If there are more than five (5) of these contracts, only provide information on the most recent five (5) contracts, including current contracts.

(h) State the average annual amount of contracts your organization has performed during the last five (5) years. *

60000000

(i) If any of the following members of your organization's management, president, chairman of the board, or any director, operates or has operated another company during the last five (5) years, identify the member of management and the name of the company. If none, state "none." *

n/a

(j) If your organization is operating under a trade name registration with the Secretary of State for the State of Ohio, identify the entity for which the trade name is registered. If none, state "none." *

n/a

(k) If your organization is a division or wholly-owned subsidiary of another entity or has another relationship with another entity, identify the entity of which it is a division or wholly-owned subsidiary or with which it has another relationship and also identify the nature of the relationship. If not applicable, state "not applicable." *

n/a

(l) List the education, training and experience for each person who will fill a management role on the Contract, including without limitation the Contract Executive, Contract Manager and Contract Superintendent. For each person listed, include with the other information the last three contracts on which the person worked and the name and telephone number of the owner. *

Corey Strawser - BS Civil Engineering OSU
Marty Blakeway - Associates Degree Construction Management

REFERENCES:

(a) List all trade references. *

Donley CONcrete Cutting
McClellan Company
Shelly Materials

(b) List all bank references. *

Huntington Bank - Hannah Tracy

(c) List the name of your surety bonding company along with the name and address of your surety agent. *

Fidelity and Deposit Company of Maryland

Kernan Insurance Agency
9932 Brewster Lane
Powell, OH 43065

FINANCING:

(a) Attach a financial statement, preferably audited, including your organization's latest balance sheet and income statement

showing the following items: current assets (e.g., cash, joint venture accounts, accounts receivable, notes receivable, accrued income, deposits, materials inventory and prepaid expenses), net fixed assets, other assets, current liabilities (e.g., accounts payable, notes payable, accrued expenses, provision for income taxes, advances, accrued salaries and accrued payroll taxes) and other liabilities (e.g., capital, capital stock, authorized and outstanding shares par values, earned surplus and retained earnings). **(To upload - Refer to Financial Statements Upload area after the Contractor's Qualification Statement of this solicitation).**

(b) List the name and address of the firm preparing attached financial statement, and date thereof. *

Toukan and Associates

(c) State if the attached financial statement for the identical organization is named on page one. If not, explain the relationship and financial responsibility of the organization whose financial statement is provided (e.g., parent-subsidiary). *

yes

(d) State if the organization whose financial statement is attached will act as guarantor of the Contract. *

yes

CERTIFICATION:

The undersigned certifies for the reliance of the Owner that after diligent investigation, to the best of the undersigned's belief, the information provided with this Contractor's Qualification Statement is true, accurate and not misleading.

Company Name: *

Strawser Paving

Signature: *

Kyle Strawser

Date: *

2-12-2024

Printed Name and Title: *

Kyle Strawser President

CONTRACTOR’S QUALIFICATION STATEMENT (FINANCIAL STATEMENT UPLOAD)

Name	Omission Terms	Submitted File
Financial Statement Upload Financial Statement Upload		coc prequal.pdf
1 Required Document		

CONTRACTOR’S QUALIFICATION STATEMENT (ADDITIONAL MATERIAL)

Name	Omission Terms	Submitted File
Optional: Vendor is not required to complete.		
Additional Material Upload #1 Optional Upload as Needed (10MB limit)		Addendum #1 and Kleingers_Gahanna Street Reconstruction (002).pdf
Additional Material Upload #2 Optional Upload as Needed (10MB limit)		EXPERIENCE RECORD 2002 update X.xls
Additional Material Upload #3 Optional Upload as Needed (10MB limit)		Professional Services Info.pdf
3 Required Documents		

SUBCONTRACTORS LIST

The bidder is required to state, in detail, in the space provided below, the name, address, experience and the work to be performed by subcontractors in this Contract, including approximate percentage of the Contract cost by subcontractor. If no subcontractors are to be used, so state. *

Axe Tree Service
20499 Bear Swamp Road
Marysville, OH 43040
\$82,000
Previous Gahanna Street Projects

Complete General Construction - RCC
1221 E 5th Ave, Columbus, OH 43219
\$455,453
Previous Gahanna Jobs

Griffin Pavement Striping - Striping
2383 Harrison Rd, Columbus, OH
\$115,000
Previous Gahanna Jobs

SCI - Micro/Slurry/Crackseal
1595 Frank Road, Columbus, OH 43223
\$295,000

Phenix Stabilization
1595 Frank Road, Columbus, OH 43223
\$206,000
Previous Gahanna jobs

Note: The bidder shall perform within its own organization, work amounting to not less than fifty percent (50%) of the total Contract cost.

CORPORATE AFFIDAVIT

Optional: Vendor is not required to complete.

To be filled in and executed if the contractor is a corporation.

State of: *

Ohio

County of (ss): *

Franklin

being first duly sworn, *

John Strawser

deposes and says that he or she is Secretary of , *

Strawser Paving

a corporation organized and existing under and by virtue of the laws of the state of , *

Ohio

and having its principal office at (Address), *

1595 Frank Road

(City), *

Columbus

(County), * (State). *

Franklin

OH

Affiant further says he or she is familiar with the records, minutes, books and by-laws of the (Name of Corporation). *

Strawser Paving Co., Inc.

Affiant further says that (Name of Officer),

*

Corey Strawser

(Title) *

Secretary - Treasurer

of the Corporation is duly authorized to sign the Contract for the

(Contract) *

2024 Street Program

for said Corporation by virtue of _____ (state whether a provision of by-laws or a resolution of the Board of Directors), *

by laws

resolution, give date of adoption). (if by

Signature: *

Kyle Strawser

CONTRACTOR'S PERSONAL PROPERTY TAX AFFIDAVIT (O.R.C. § 5719.042)

State of: *

Ohio

County of (ss): *

Franklin

_____, Affiant, *

Corey Strawser

being first duly sworn, deposes and says:

1. I am the (Title): *

Secretary - Treasurer

of (Contractor): *

Strawser Paving

2. The Contractor's offices are located at: *

1595 Frank Road Columbus, OH 43223

3. I am the Contractor's duly authorized representative for making this affidavit.

4. Effective this _____ day: *

12th

of _____: *

20 _____: *

February

2024

the Contractor _____ with delinquent personal property taxes on the general list of personal property in any Ohio county. *

is not charged

delinquent personal property taxes:

County:

Amount (include total amount, with penalties and interest thereon):

County:

Amount (include total amount, with penalties and interest thereon):

County:

Amount (include total amount, with penalties and interest thereon):

County:

Amount (include total amount, with penalties and interest thereon):

Signature: *

Kyle Strawser

NONCOLLUSION AFFIDAVIT

State of: *

Ohio

County of (ss): *

Franklin

Contractor, *

Strawser Paving

being first duly sworn, deposes and says that he or she is

_____ *

president

of

(company name), *

Strawser Paving

the party making the foregoing bid; that such bid is not made in the interest of or on behalf of any undisclosed person, partnership, company, association, organization, or corporation; that such bid is genuine and not collusive or sham; that said bidder has not directly or indirectly induced or solicited any other bidder to put in a false or sham bid, and has not directly or indirectly colluded, conspired, connived, or agreed with any bidder or anyone else to put in a sham bid, or that any one shall refrain from bidding; that said bidder has not in any manner, directly or indirectly, sought by agreement, communication or conference with anyone to fix any overhead, profit, or cost element of such bid price, or of that of any other bidder, or to secure any advantage against the Owner awarding the Contract to anyone interested in the proposed Contract; that all statements contained in such bid are true; and further, that said bidder has not, directly or indirectly, submitted its bid price or any breakdown thereof, or the contents thereof, or divulged information or data relative thereto, or paid and will not pay any fee in connection therewith, to any corporation, partnership, company, association, organization, bid depository, or to any member or agent thereof, or to any other individual except to such person or persons as have a partnership or other financial interest with said bidder in its general business.

Signature: *

Kyle Strawser

ESCROW WAIVER

Contractor, *

Strawser Paving

agrees to abide by City of Gahanna Ordinance No. 0077-2017. Pursuant to such ordinance and the City's home rule authority, Contractor waives the requirements of Sections 153.13, 153.14 and 153.63 of the Ohio Revised Code that an escrow account be established relating to the Contract and that interest be paid on retainage.

Signature: *

Kyle Strawser

BID GUARANTY AND CONTRACT BOND & SURETY UPLOADS

Name	Omission Terms	Submitted File
Bid Guaranty and Contract Bond Bid Guaranty and Contract Bond (Form located in Attachement List)		Bid Guaranty and Contract Bond.pdf
Surety Company's Power of Attorney Power of attorney for surety company		Power of Attorney.pdf
Surety Company's Financial Statement Financial statement for surety company		Financial Statement.pdf
Surety Company's Certificate of Complaine from the Ohio Department of Insurance Certificate of complaine from the Ohio Department of Insurance for surety company		Certificate of Compliance.pdf
4 Required Documents		

BID FORM & BIDDER CERTIFICATION

Having carefully reviewed the Information and Requirements for Bidders, Drawings, Specifications and other Contract Documents for the Project including having also received, read, and taken into account any Addenda and likewise having inspected the site and the conditions affecting and governing the Project and confirmed the location of the site utilities and all existing structures, the undersigned hereby proposes to furnish all materials and to perform all labor, as specified and described in the said Specifications and/or as shown on the said Drawings for all Work necessary to complete the Project on a timely basis and in accordance with the Contract Documents regardless of whether expressly provided for in such Specifications and Drawings.

Before completing the Bid Form, the undersigned represents that it has carefully reviewed the Notice to Bidders, Information and Requirements for Bidders, this Bid Form, Form of Bid Guaranty and Contract Bond, Contractor's Affidavit (O.R.C. 5719.042), Owner-Contractor Agreement, General Conditions of the Contract (EJCDC C-700, 2013) (as modified), Drawings, Project Specifications, and all other Contract Documents. Failure to comply with provisions of the Contract Documents may be cause for disqualification of the bid.

BONDS AND CONTRACT: If the undersigned is notified of bid acceptance, it agrees to furnish required bonds as indicated in the Information and Requirements for Bidders.

COMPLETION OF WORK: In submitting a bid, the undersigned agrees to execute the Owner-Contractor Agreement in the form included in the Contract Documents and to substantially complete its Work as required by the Contract Documents.

NOTE A: The wording of the Bid Form shall be used throughout, without change, alteration, or addition. Any change may cause it to be rejected.

NOTE B: Bidder is cautioned to bid only on the Brands or Standards specified.

NOTE C: If there is an inconsistency or conflict in the Bid amount, the lowest amount shall control, whether expressed in numbers or words.

INSTRUCTIONS FOR SIGNING

A. The person signing for a sole proprietorship must be the sole proprietor or his authorized representative. The name of the sole proprietor must be shown below.

B. The person signing for a partnership must be a partner or his authorized representative.

C. The person signing for a corporation must be the president, vice president or other authorized representative; or he must show authority, by affidavit, to bind the corporation.

D. The person signing for some other legal entity must show his authority, by affidavit, to bind the legal entity.

BIDDER CERTIFICATIONS. The Bidder hereby acknowledges that the following representations in this bid are material and not mere recitals:

1. The Bidder acknowledges that this is a public project involving public funds, and that the Owner expects and requires that each successful Bidder adhere to the highest ethical and performance standards. The Bidder by submitting its bid pledges and agrees that (a) it will act at all times with absolute integrity and truthfulness in its dealings with the Owner and the Design Professional, (b) it will use its best efforts to cooperate with the Owner and the Design Professional and all other Contractors on the Project and at all times will act with professionalism and dignity in its dealings with the Owner, Design Professional and other Contractors, (c) it will assign only competent supervisors and workers to the Project, each of whom is fully qualified to perform the tasks that are assigned to him/her, and (d) it has read, understands and will comply with the terms of the Contract Documents.
2. The Bidder represents that it has had a competent person carefully and diligently review each part of the Contract Documents, including the Divisions of the Specifications and parts of the Drawings that are not directly applicable to the Work on which the Bidder is submitting its bid. By submitting its bid, each Bidder represents and agrees, based upon its careful and diligent review of the Contract Documents, that it is not aware of any conflicts, inconsistencies, errors or omissions in the Contract Documents for which it has not notified the Design Professional in writing at least seven (7) days prior to the bid opening. If there are any such conflicts, inconsistencies, errors or omissions in the Contract Documents, the Bidder (i) will provide the labor, equipment or materials of the better quality or greater quantity of Work; and/or (ii) will comply with the more stringent requirements. The Bidder will not be entitled to any additional compensation for any conflicts, inconsistencies, errors or omissions that would have been discovered by such careful and diligent review, unless it has given such prior written notice to Design Professional.
3. The Bidder represents that it has had a competent person carefully and diligently inspect and examine the entire site for the Project and the surrounding area, including all parts of the site applicable to the Work for which it is submitting its bid, including the location, condition and layout of the site and the location of utilities, and carefully correlate the results of the inspection with the requirements of the Contract Documents. The Bidder agrees that its bid shall include all costs attributable to site and surrounding area conditions that would have been discovered by such careful and diligent inspection and examination of the site and the surrounding area, and the Bidder shall not be entitled to any Change Order, additional compensation, or additional time on account of conditions that could not have been discovered by such an investigation.
4. The Bidder represents, understands and agrees that a) the Change Proposal and Claim procedures in the Modified Standard General Conditions are material terms of the Contract Documents, b) if it has a Change Proposal or Claim, it will have its personnel provide complete and accurate information to complete and submit the Change Proposal and / or Statement of Claim form on a timely basis, c) the proper completion and timely submission of a Change Proposal or Statement of Claim form is a condition precedent to any change in the Contract Sum or the Contract Time(s), and d) the proper and timely submission of the Change Proposal or Statement of Claim form provides the Owner and the Design Professional with necessary information so that the Owner may investigate the Claim and mitigate its damages.
5. The Bidder represents that the bid contains the name of every person interested therein and is based upon the Standards specified by the Contract Documents.
6. The Bidder and each person signing on behalf of the Bidder certifies, and in the case of a bid by joint venture, each member thereof certifies as to such member's entity, under penalty of perjury, that to the best of the undersigned's knowledge and belief: (a) the Base Bid, any Unit Prices, Lump Sum Items, and any Alternate bids in the bid have been arrived at independently without collusion, consultation, communication or agreement, or for the purpose of restricting competition as to any matter relating to such Base Bid, Unit Prices, Lump Sum Items, or Alternate bids with any other Bidder; (b) unless otherwise required by law, the Base Bid, any Unit Prices, Lump Sum Items, and any Alternate bids in the bid have not been knowingly disclosed by the Bidder and will not knowingly be disclosed by the Bidder prior to the bid opening, directly or indirectly, to any other Bidder who would have any interest in the Base Bid, Unit Prices, Lump Sum Items, or Alternate bids; (c) no attempt has been made or will be made by the Bidder to induce any other Person to submit or not to submit a bid for the purpose of restricting competition; and (d) the statements made in this Bid Form are true and correct.
7. The Bidder will execute the form of Owner/Contractor Agreement in the form included with the Contract Documents, if a Contract is awarded on the basis of this bid, and if the Bidder does not execute the Contract Form for any reason, other than as authorized by law, the Bidder and the Bidder's Surety are liable to the Owner.
8. The Bidder certifies that upon the award of a Contract, the Contractor will ensure that all of the Contractor's employees, while working on the Project site, will not purchase, transfer, use or possess illegal drugs or alcohol or abuse prescription drugs in any way.
9. The Bidder agrees to furnish any information requested by the Design Professional or the Owner's authorized representative to evaluate that the Bidder is the best bidder and that the bid is responsive to the specifications.
10. The Bidder certifies that it has no unresolved findings for recovery issued by the Auditor of State.
11. The Bidder certifies that it is aware of and in compliance with the requirements of Ohio Revised Code Section 3517.13 regarding campaign contributions.

Legal Name of Bidder: *

Strawser Paving Co., Inc.

Bidder is: *

corporation

Name and Title of Person Legally Authorized to Bind Bidder to a Contract: *

Kyle Strawser

Address: *

1595 Frank Road

City *

Columbus

State *

OH

Zip *

43,223

Telephone Number: *

(614) 276-5273

Fax Number:

Federal Tax ID Number: *

Signature: *

Kyle Strawser

Date: *

2-12-2024

When the Bidder is a partnership or a joint venture, state name and address of each partner in the partnership or participant in the joint venture below:

Name and Address:

n/a

BID FORM (INSTRUCTIONS)

Include the cost of all labor and material for the bid items listed below. Bidder is to fill in all blanks related to the bid items for which a bid is being submitted. If there is a difference between the total bid amount and the total of the individual amounts for labor and materials stated under a bid item, the total of the individual amounts shall be the amount deemed to be inserted in the blank for the total labor and materials for each bid item. If there is an inconsistency or conflict in the bid amount, the lowest amount shall control, whether expressed in numbers or words.

For items the City designates as alternate, enter a negative value if it is to be deducted from the Base Bid. Otherwise the item(s) will be included as an addition to the base bid. If opting out of bidding an alternate item, check mark the box in the optional column located to the left of the item to insert the words "No Bid".

BID FORM

\$4,899,580.69

REF #	ITEM #	DESCRIPTION	QTY	UNIT	MATERIAL	LABOR	Extension
Alternates are not included in bid total.							
1	203	Excavation	6,985.11	CY	\$0.00	\$32.00	\$223,523.52
2	204	Sub Base Lift Material	145.71	CY	\$28.97	\$24.03	\$7,722.63
3	253	Full Depth Pavement Repair	2,543.00	SY	\$29.80	\$45.20	\$190,725.00
4	254	1" to 3" Planing	37,806.00	SY	\$0.00	\$2.50	\$94,515.00
5	SPEC	Cement Stabilization, 12"	15,800.40	SY	\$0.00	\$12.50	\$197,505.00
6	454	Pavement Relief Joints	12.00	EA	\$376.16	\$1,873.84	\$27,000.00
7	307	7" Roller Compacted Concrete Base	13,562.01	SY	\$0.00	\$31.50	\$427,203.32
8	407	Tack Coat (Trackless)	4,892.60	GAL	\$2.75	\$0.65	\$16,634.84
9	410	Traffic Compacted Surface	400.00	CY	\$29.02	\$16.98	\$18,400.00
10	409	Sawing & Sealing Asphalt Concrete Pavement Joint	133.53	LF	\$0.00	\$7.00	\$934.71
11	441	1-1/2" Asphalt Concrete Intermediate Course, Type 2, (448)	2,191.84	CY	\$142.65	\$52.35	\$427,408.80
12	441	1-1/2" Asphalt Concrete Surface Course, Type 1, (448), PG64-22	2,191.84	CY	\$162.41	\$52.59	\$471,245.60
13	SPEC	Professional Design Services-Driveway Profiles (per driveway)	96.00	EA	\$0.00	\$212.00	\$20,352.00
14	608	5' wide Concrete Walk 6" (panels within drives & adjacent transition panels)	376.00	EA	\$108.60	\$201.40	\$116,560.00
15	608	5' wide Concrete walk 4"(panels beyond driveway transition panels)	1,380.80	EA	\$68.10	\$156.90	\$310,680.00
16	608	4' x 5' (4" thick) concrete sidewalk panel	344.00	EA	\$67.42	\$172.58	\$82,560.00
17	608	4' x 5' (6" thick) concrete sidewalk panel	74.00	EA	\$90.82	\$179.18	\$19,980.00
18	608	Curb Ramp, Type C (ADA Compliant	95.00	EA	\$603.87	\$1,321.13	\$182,875.00
							Total: \$4,899,580.69

REF #	ITEM #	DESCRIPTION	QTY	UNIT	MATERIAL	LABOR	Extension
		Reconfiguration)					
19	608	Curb Ramp, Type C (Truncated Dome Replacement)	4.00	EA	\$292.96	\$712.04	\$4,020.00
20	609	Combination Curb & Gutter Inc. 4" Underdrain	10,803.00	LF	\$14.18	\$13.32	\$297,082.50
21	614	Maintenance of Traffic-ALL	1.00	LS	\$0.00	\$78,000.00	\$78,000.00
22	623	Construction Layout Stakes-ALL	8.00	LS	\$0.00	\$5,000.00	\$40,000.00
23	644	Crosswalk Line 12"	3,380.00	LF	\$0.00	\$3.80	\$12,844.00
24	644	Stop Bar	1,032.00	LF	\$0.00	\$8.25	\$8,514.00
25	659	Seeding and Mulching, Class 1	1.00	LS	\$45,535.83	\$154,464.17	\$200,000.00
26	SPEC	Remove/Replace Driveway Aprons (Cols Std Detail 2201)	1,316.00	SY	\$39.01	\$61.99	\$132,916.00
27	624	Reclamite Asphalt Rejuvenating Agent-Rebuilds	50,973.00	SY	\$0.00	\$1.08	\$55,050.84
28	SPEC	Sign Allowance-ALL	12.00	LS	\$0.00	\$1.10	\$13.20
29	609	Curb Replacement	12,811.00	LF	\$13.03	\$31.97	\$576,495.00
30	624	Mobilization-ALL	1.00	LS	\$0.00	\$138,625.00	\$138,625.00
31	604	Manhole/Curb Inlet Full Reconstruction to Grade	7.00	EA	\$165.56	\$834.44	\$7,000.00
32	423	Crack Sealing	38,639.00	SY	\$0.00	\$0.76	\$29,365.64
33	421	Microsurfacing, Surface Course	38,639.00	SY	\$0.00	\$5.31	\$205,173.09
34	644	Center Line (Double)	2.65	MI	\$0.00	\$7,500.00	\$19,875.00
35	644	Edge Line White	0.00	MI	\$0.00	\$0.00	\$0.00
36	644	Lane Lines	6,800.00	LF	\$0.00	\$0.47	\$3,196.00
37	644	"SCHOOL" Marking	1.00	EA	\$0.00	\$820.00	\$820.00
38	644	Lane Indicator - Arrows	36.00	EA	\$0.00	\$95.00	\$3,420.00
39	644	crosswalk Line 24"	12.00	LF	\$0.00	\$10.00	\$120.00
Total: \$4,899,580.69							

REF #	ITEM #	DESCRIPTION	QTY	UNIT	MATERIAL	LABOR	Extension
40	644	Edge Line, Yellow	0.00	MI	\$0.00	\$0.00	\$0.00
41	644	Channelizing Line	200.00	LF	\$0.00	\$2.50	\$500.00
42	644	Transverse Line (Within Crosswalks)	0.00	LF	\$0.00	\$0.00	\$0.00
43	644	Transverse Line, Yellow	668.00	LF	\$0.00	\$8.25	\$5,511.00
44	644	Transverse Line, White	0.00	LF	\$0.00	\$0.00	\$0.00
45	644	Lane Arrow, Combination	1.00	EA	\$0.00	\$135.00	\$135.00
46	644	Word on Pavement, 96"	1.00	EA	\$0.00	\$150.00	\$150.00
47	644	Dotted Line, 6"	748.00	LF	\$0.00	\$3.00	\$2,244.00
48	644	Island Marking	300.00	LF	\$0.00	\$3.25	\$975.00
49	644	Bike Symbol	18.00	EA	\$0.00	\$290.00	\$5,220.00
50	644	Chevrons	180.00	LF	\$0.00	\$5.00	\$900.00
51	807	Adjust valve box / curb box to grade (contengency)	8.00	EA	\$0.00	\$225.00	\$1,800.00
52	SPEC	Corner Manhole Inlet Lid Replacement	0.00	EA	\$0.00	\$0.00	\$0.00
53	SPEC	Catch basin replacement ring and grate	11.00	EA	\$600.00	\$0.00	\$6,600.00
54	254	Spot planing	25.00	SY	\$0.00	\$115.00	\$2,875.00
55	SPEC	Manhole/Curb Inlet Adjusted to Grade	52.00	EA	\$110.84	\$349.16	\$23,920.00
56	SPEC	Tree Removal (includes Stump Grinding)	92.00	EA	\$0.00	\$900.00	\$82,800.00
57	SPEC	Tree Root Prune per 5' panel	7.00	EA	\$116.00	\$599.00	\$5,005.00
58	SPEC	Tree Veg Removal/Pruning	166.00	LF	\$0.00	\$32.00	\$5,312.00
59	SPEC	Sidewalk Grinding	532.00	LF	\$0.00	\$30.00	\$15,960.00
60	SPEC	Vegetation in joint removal	47.00	LF	\$10.11	\$33.89	\$2,068.00
61	SPEC	Professional Desgn Services- Plans,profiles, cross sections of roadways-ALL REBUILDS	1.00	LS	\$0.00	\$75,000.00	\$75,000.00
Total: \$4,899,580.69							

REF #	ITEM #	DESCRIPTION	QTY	UNIT	MATERIAL	LABOR	Extension
62	SPEC	Professional Design Services-Curb Ramp Drawings (per curb ramp)	95.00	EA	\$0.00	\$150.00	\$14,250.00
Total: \$4,899,580.69							

ALTERNATE 1 (CRACK SEAL & MICRO SURFACE)

REF #	ITEM #	DESCRIPTION	QTY	UNIT	MATERIAL	LABOR	Extension
Alternate: Owner-agency may award independently from entire bid.							
Component is not included in bid total.							
Alternates are not included in bid total.							
63	423	Crack Seal	4,538.00	SY	\$0.38	\$0.38	\$3,448.88
64	417	Asphalt Emulsion Slurry Seal, Type A	0.00	SY	\$0.00	\$0.00	\$0.00
65	421	Microsurfacing, Surface Course	4,538.00	SY	\$2.80	\$2.80	\$25,412.80
66	614	Maintenance of Taffic	0.00	LS	\$0.00	\$0.00	\$0.00
67	644	Cross Walk 12"	48.00	LF	\$1.90	\$1.90	\$182.40
68	644	Cross Walk 24"	0.00	LF	\$0.00	\$0.00	\$0.00
69	644	Stop Bar	12.00	LF	\$4.12	\$4.13	\$99.00
						Alternate Total: \$29,143.08	
						Total:	

ALTERNATE 2 (GOLF COURSE PATHS)

REF #	ITEM #	DESCRIPTION	QTY	UNIT	MATERIAL	LABOR	Extension
Alternate: Owner-agency may award independently from entire bid.							
Component is not included in bid total.							
Alternates are not included in bid total.							
70	202	Pavement Removed	305.00	SY	\$0.00	\$11.90	\$3,629.50
71	204	Subgrade Compaction	987.00	SY	\$0.00	\$2.40	\$2,368.80
72	254	Pavement Planing (1.25")	5,977.00	SY	\$0.00	\$3.70	\$22,114.90
73	304	6" Gravel Aggregate Base	165.00	CY	\$29.00	\$167.00	\$32,340.00
74	407	Non-Tracking Tack Coat	418.00	GAL	\$2.75	\$0.65	\$1,421.20
75	659	Seeding and Mulching	1,000.00	SY	\$2.12	\$17.48	\$19,600.00
76	659	Water	1.00	MGAL	\$0.00	\$785.00	\$785.00
77	1530	Asphalt Concrete Surface Course, Type I (448) PG 64-22 (1.25")	242.00	CY	\$161.17	\$147.83	\$74,778.00
78	1530	Asphalt Concrete Intermediate Course, Type 2 (448) (1.75")	339.00	CY	\$142.88	\$117.12	\$88,140.00
79	604	10" ADS N-12 PIPE	308.00	LF	\$15.03	\$39.97	\$16,940.00
80	604	10" ADS Nyloplast Drain Basin	3.00	EA	\$601.08	\$788.92	\$4,170.00
81	SPEC	Construction Staking	1.00	LS	\$0.00	\$10,000.00	\$10,000.00
82	SPEC	Mobilization	1.00	LS	\$0.00	\$12,000.00	\$12,000.00
						Alternate Total: \$288,287.40	
						Total:	

ALTERNATE 3 (ADDITIONAL STRIPING)

REF #	ITEM #	DESCRIPTION	QTY	UNIT	MATERIAL	LABOR	Extension
Alternate: Owner-agency may award independently from entire bid.							
Component is not included in bid total.							
Alternates are not included in bid total.							
83	644	Lane Line	6,800.00	LF	\$0.24	\$0.23	\$3,196.00
84	644	Center Line (Double)	1.56	MI	\$3,992.00	\$3,992.00	\$12,455.04
85	644	Channelizing Line	200.00	LF	\$1.33	\$1.33	\$532.00
86	644	Stop Line	600.00	LF	\$4.39	\$4.39	\$5,268.00
87	644	Crosswalk Line 12"	1,936.00	LF	\$2.02	\$2.03	\$7,840.80
88	644	Transverse Line, Yellow	668.00	LF	\$4.39	\$4.39	\$5,865.04
89	644	School Symbol Marking, 120"	1.00	EA	\$436.48	\$436.48	\$872.96
90	644	Lane Arrow	21.00	EA	\$50.57	\$50.57	\$2,123.94
91	644	Lane Arrow, Combination	1.00	EA	\$71.86	\$71.86	\$143.72
92	644	Word on Pavement, 96"	1.00	EA	\$79.84	\$79.85	\$159.69
93	644	Dotted Line, 6"	748.00	LF	\$1.60	\$1.59	\$2,386.12
94	644	Island Marking	300.00	LF	\$1.73	\$1.73	\$1,038.00
95	644	Bike Symbol	18.00	EA	\$154.36	\$154.35	\$5,556.78
96	644	Chevrons	180.00	LF	\$2.66	\$2.66	\$957.60
						Alternate Total: \$48,395.69	Total:

PREQUALIFIED RESPONSIBLE CERTIFICATE

This certifies that, **Strawser Paving Company**, having complied with and met the city code and policies and procedures of the City of Columbus and the Office of Construction Prequalification, is declared eligible to receive or perform construction service work that is issued by the City of Columbus.

STATUS DETERMINATION DATE:	05/18/2022
RENEWAL PERIOD START DATE:	04/23/2024
RENEWAL PERIOD END DATE:	05/08/2024
STATUS EXPIRES*:	06/07/2024

LOCAL BUSINESS?	<input checked="" type="checkbox"/> YES <input type="checkbox"/> NO
PREQUALIFIED AS:	<input checked="" type="checkbox"/> Potential Bidder <input type="checkbox"/> Subcontract Work Only
CAN PERFORM WORK ON CONSTRUCTION PROJECTS OVER \$2M?	<input checked="" type="checkbox"/> YES <input type="checkbox"/> NO
FEDERAL ID:	#31-4412354

Certified by:

Bianca C. Bell

Bianca C. Bell - Management Analyst II

**The terms of prequalification must continue to be met in order to maintain prequalification status through the status expiration date.*

A new prequalification application must be received during the renewal period, see guide at <http://columbus.gov/prequalification.aspx>

Office of Construction Prequalification / P (614) 645-0359 / F (614) 645-5818

PROJECT TEAM



MEGAN CYR, PE, LEED AP PROJECT PRINCIPAL

EXPERIENCE

19 years; 19 years with The Kleingers Group

REGISTRATION

Professional Engineer
Ohio #PE.77775

EDUCATION

The Ohio State University, BS,
Civil Engineering, 2004

EXPERIENCE / QUALIFICATIONS

Megan brings 19 years of experience leading and designing challenging projects. She performs master planning, budgeting, document preparation and permitting for private and public site development projects, K-12 and higher education facilities, institutional facilities, athletic field design projects, and multi-family residential housing in the greater Columbus area.

KEY PROJECT EXPERIENCE

- **Dublin Sanitary Sewer Extension Area 1B and Trails End Roadway**, Dublin, Ohio
- **Glenn Parkway Turn Lane Improvements**, Delaware, Ohio
- **Harrisburg Pike at Alkire Road Signal Improvements**, Columbus, Ohio
- **Frank Road at Finland Avenue Turn Lane Improvements**, Columbus, Ohio
- **Hague Avenue at Gooden Avenue, Turn Lane Improvements**, Columbus, Ohio



MICHAEL J. COUVREUR, PE, LEED AP, CPESC, CESSWI ENGINEER OF RECORD

EXPERIENCE

21 years; 21 years with The Kleingers Group

REGISTRATION

Professional Engineer
Ohio #PE.70851

EDUCATION

University of Dayton, BS,
Civil Engineering, 2002

EXPERIENCE / QUALIFICATIONS

Michael brings 21 years of experience performing site designs and infrastructure improvements. He has experience working for private and public site development projects, mixed-use development, and K-12 and higher education facilities projects typically in support of architectural firm lead projects. Michael's assignments have included public roadway design, intersection and drainage improvements, storm sewer, culverts, sanitary sewer, waterlines, and utilities.

KEY PROJECT EXPERIENCE

- **Dublin Sanitary Sewer Extension Area 1B and Trails End Roadway**, Dublin, Ohio
- **Harrisburg Pike at Alkire Road Signal Improvements**, Columbus, Ohio
- **Frank Road at Finland Avenue Turn Lane Improvements**, Columbus, Ohio
- **Hague Avenue at Gooden Avenue, Turn Lane Improvements**, Columbus, Ohio
- **Gantz Road Improvements**, Franklin County, Ohio



ADDENDUM # 1


2024 STREET & SIDEWALK PROGRAM, ST-1110

1. The Engineer's Estimate (Base Bid) has been revised to: \$4,856,000 (see the revised Notice to Bidders attached).
2. Item 608 "Concrete Walk" in supplemental specifications has been revised to allow bidders to price using "panel" as unit of measurement and also includes square foot for any additional needs (see the revised Supplemental Specifications attached).
3. Item 661 "Planting/Pruning trees" has been revised to reflect two different sizes of trees to be removed for bidders to give more accurate pricing (see the revised Supplemental Specifications attached).
4. Remove/Replace base of drives has been clarified to explain extension of walkways will go into utility strip and not on private property (see the revised Supplemental Specifications attached).
5. Professional Field Survey and Design has been clarified that sidewalks are part of the survey and design work and CAD or GIS as built(s) will be a require deliverable (see the revised Supplemental Specifications attached).

Please sign and upload a .pdf copy to the Additional Material Upload section located on Bid Express under the Contractor's Qualification Statement due on **February 13, 2024 @ 11:00 AM**.

ADDENDUM # 1 is hereby acknowledged:

Signature and Title

 President

Company Name

STRAWSER PAVING CO., INC.

Date

02/13/2024

Issued: February 5, 2024

PROJECT TEAM



MEGAN CYR, PE, LEED AP PROJECT PRINCIPAL

EXPERIENCE

19 years; 19 years with The Kleingers Group

REGISTRATION

Professional Engineer
Ohio #PE.77775

EDUCATION

The Ohio State University, BS,
Civil Engineering, 2004

EXPERIENCE / QUALIFICATIONS

Megan brings 19 years of experience leading and designing challenging projects. She performs master planning, budgeting, document preparation and permitting for private and public site development projects, K-12 and higher education facilities, institutional facilities, athletic field design projects, and multi-family residential housing in the greater Columbus area.

KEY PROJECT EXPERIENCE

- **Dublin Sanitary Sewer Extension Area 1B and Trails End Roadway**, Dublin, Ohio
- **Glenn Parkway Turn Lane Improvements**, Delaware, Ohio
- **Harrisburg Pike at Alkire Road Signal Improvements**, Columbus, Ohio
- **Frank Road at Finland Avenue Turn Lane Improvements**, Columbus, Ohio
- **Hague Avenue at Gooden Avenue, Turn Lane Improvements**, Columbus, Ohio



MICHAEL J. COUVREUR, PE, LEED AP, CPESC, CESSWI ENGINEER OF RECORD

EXPERIENCE

21 years; 21 years with The Kleingers Group

REGISTRATION

Professional Engineer
Ohio #PE.70851

EDUCATION

University of Dayton, BS,
Civil Engineering, 2002

EXPERIENCE / QUALIFICATIONS

Michael brings 21 years of experience performing site designs and infrastructure improvements. He has experience working for private and public site development projects, mixed-use development, and K-12 and higher education facilities projects typically in support of architectural firm lead projects. Michael's assignments have included public roadway design, intersection and drainage improvements, storm sewer, culverts, sanitary sewer, waterlines, and utilities.

KEY PROJECT EXPERIENCE

- **Dublin Sanitary Sewer Extension Area 1B and Trails End Roadway**, Dublin, Ohio
- **Harrisburg Pike at Alkire Road Signal Improvements**, Columbus, Ohio
- **Frank Road at Finland Avenue Turn Lane Improvements**, Columbus, Ohio
- **Hague Avenue at Gooden Avenue, Turn Lane Improvements**, Columbus, Ohio
- **Gantz Road Improvements**, Franklin County, Ohio



Kleingers performed a survey and civil design to widen approximately **1,100-feet of Frank Road to add a 225-foot left turn lane** from eastbound Frank Road to northbound Finland Avenue.

Frank Road Widening at Finland Avenue

FRANKLIN TOWNSHIP, OHIO

The Kleingers Group prepared a traffic impact study for South-Western City Schools' new Finland Elementary School. The traffic study results warranted an 11-foot wide turn lane from Frank Road onto Finland Avenue. We performed a survey and civil design to widen approximately 1,100-feet of Frank Road to add a 225-foot left turn lane from eastbound Frank Road to northbound Finland Avenue. The project also included utility relocations, storm sewer replacement, driveway replacement, ADA accessibility upgrades, and intersection improvements at Frank Road and Finland Avenue and Frank Road and Hendrix Drive.



As part of the 2024 Street & Sidewalk Program (ST-1110), professional services are to be provided by the following:

Registered Professional Surveyor

Name: Megan Cyr

State of Ohio Registration Number: #PE.77775

Employed by: The Kleingers Group

Document attachments:

Resume ☒ Example Projects (minimum of 2, maximum of 3) ☒

Registered Professional Engineer

Name: Michael J. Courvreur

State of Ohio Registration Number: #PE.70851

Employed by: The Kleingers Group

Document attachments:

Resume ☒ Sample Deliverables ☒ Example Projects (minimum of 2, maximum of 3) ☒

Certified Arborist

Name: Jason Axe

Certification Number: OH-6295A

Employed by: Axe Tree Service

This form has been completed by:

Name: Kyle Strawser

Date: 2-12-24

Company: Strawser Paving

BID GUARANTY AND CONTRACT BOND
(O.R.C § 153.571)

Know all persons by these presents, that we, the undersigned Strawser Paving Co., Inc.
(Contractor) as principal and Fidelity and Deposit Company of Maryland as surety are hereby
held and firmly bound unto the City of Gahanna, as obligee in the penal sum of the dollar amount of the
bid submitted by the principal to the obligee on February 13, 2024, to undertake the
2024 Street and Sidewalk Program, ST-1110 (Project).

The penal sum referred to herein shall be the dollar amount of the principal's bid to the obligee,
incorporating any additive or deductive alternates made by the principal on the date referred to above to
the obligee, which are accepted by the obligee. In no case shall the penal sum exceed the amount of
_____ dollars (\$_____).

(If the foregoing blank is not filled in, the penal sum will be the full amount of the principal's bid,
including add alternates. Alternatively, if the blank is filled in the amount stated must not be less than the
full amount of the bid including add alternates, in dollars and cents. A percentage is not acceptable.) For
the payment of the penal sum well and truly to be made, we hereby jointly and severally bind ourselves,
our heirs, executors, administrators, successors, and assigns.

Signed this 13th day of February, 2024.

The condition of the above obligations is such that whereas the above named principal has submitted a
bid for work on the Contract.

Now, therefore, if the obligee accepts the bid of the principal and the principal fails to enter into a proper
contract in accordance with the bid, plans, details, specifications and bills of material; and in the event the
principal pays to the obligee the difference not to exceed ten percent (10%) of the penalty hereof
between the amount specified in the bid and such larger amount for which the obligee may in good faith
contract with the next lowest bidder to perform the work covered by the bid; or in the event the obligee
does not award the contract to the next lowest bidder and resubmits the contract for bidding, the
principal pays to the obligee the difference not-to-exceed ten percent (10%) of the penalty hereof
between the amount specified in the bid, or the costs, in connection with the resubmission, of printing
new contract documents, required advertising, and printing and mailing notices to prospective bidders,
whichever is less, then this obligation shall be null and void, otherwise to remain in full force and effect; if
the obligee accepts the bid of the principal and the principal within ten (10) days after the awarding of the
contract enters into a proper contract in accordance with the bid, plans, details, specifications and bills of
material, which said contract is made a part of this bond the same as though set forth herein.

Now also, if the said principal shall well and faithfully do and perform the things agreed by said principal
to be done and performed according to the terms of said contract; and shall pay all lawful claims of
subcontractors, materialmen, and laborers, for labor performed and materials furnished in the carrying
forward, performing, or completing of said contract; we agreeing and assenting that this undertaking shall
be for the benefit of any materialman or laborer having a just claim, as well as for the obligee herein; then
this obligation shall be void; otherwise the same shall remain in full force and effect; and surety shall
indemnify the obligee against all damage suffered by failure of the principal to perform the contract
according to its provisions and in accordance with the plans, details, specifications and bills of material
therefor and to pay all lawful claims of subcontractors, materialmen, and laborers for labor performed or
material furnished in carrying forward, performing, or completing the contract and surety further agrees
and assents that this undertaking is for the benefit of any subcontractor, materialman, or laborer having a

just claim, as well as for the obligee; it being expressly understood and agreed that the liability of the surety for any and all claims hereunder shall in no event exceed the penal amount of this obligation as herein stated.

The said surety hereby stipulates and agrees that no modifications, omissions, or additions in or to the terms of the said contract or in or to the plans or specifications therefore shall in any wise affect the obligations of said surety on its bond, and does hereby waive notice of any such modifications, omissions or additions to the terms of the contract or to the work or to the specifications.

Signed and sealed this 13th day of February, 2024.

Strawser Paving Co., Inc.

Principal

Signature

Printed Name and Title


KYLE STRAWSER / PRESIDENT

Fidelity and Deposit Company of Maryland

Surety

Signature

Laura M. Batchelder / Attorney-in-Fact

Printed Name and Title

1299 Zurich Way, Schaumburg, IL 50196-1056

Surety's Address

312-496-9593

Surety's Telephone Number

Surety's Fax Number

Kernan Insurance Agency, Inc.

Surety's Agent

9932 Brewster Lane, Powell, OH 43065

Surety Agent's Address

614-764-0121

Surety Agent's Telephone Number

614-764-6914

Surety Agent's Fax Number

**ZURICH AMERICAN INSURANCE COMPANY
COLONIAL AMERICAN CASUALTY AND SURETY COMPANY
FIDELITY AND DEPOSIT COMPANY OF MARYLAND
POWER OF ATTORNEY**

KNOW ALL MEN BY THESE PRESENTS: That the ZURICH AMERICAN INSURANCE COMPANY, a corporation of the State of New York, the COLONIAL AMERICAN CASUALTY AND SURETY COMPANY, a corporation of the State of Illinois, and the FIDELITY AND DEPOSIT COMPANY OF MARYLAND a corporation of the State of Illinois (herein collectively called the "Companies"), by **Robert D. Murray, Vice President**, in pursuance of authority granted by Article V, Section 8, of the By-Laws of said Companies, which are set forth on the reverse side hereof and are hereby certified to be in full force and effect on the date hereof, do hereby nominate, constitute, and appoint Gerald A. KERNAN, Joseph T. LEMASTERS, Cheryl CRAMER, Laura BATCHELDER, Thomas J. LITMAN of Powell, Ohio, its true and lawful agent and Attorney-in-Fact, to make, execute, seal and deliver, for, and on its behalf as surety, and as its act and deed: **any and all bonds and undertakings**, and the execution of such bonds or undertakings in pursuance of these presents, shall be as binding upon said Companies, as fully and amply, to all intents and purposes, as if they had been duly executed and acknowledged by the regularly elected officers of the ZURICH AMERICAN INSURANCE COMPANY at its office in New York, New York, the regularly elected officers of the COLONIAL AMERICAN CASUALTY AND SURETY COMPANY at its office in Owings Mills, Maryland, and the regularly elected officers of the FIDELITY AND DEPOSIT COMPANY OF MARYLAND at its office in Owings Mills, Maryland, in their own proper persons.

The said Vice President does hereby certify that the extract set forth on the reverse side hereof is a true copy of Article V, Section 8, of the By-Laws of said Companies, and is now in force.

IN WITNESS WHEREOF, the said Vice-President has hereunto subscribed his/her names and affixed the Corporate Seals of the said ZURICH AMERICAN INSURANCE COMPANY, COLONIAL AMERICAN CASUALTY AND SURETY COMPANY, and FIDELITY AND DEPOSIT COMPANY OF MARYLAND, this 05th day of July, A.D. 2022.



ATTEST:
ZURICH AMERICAN INSURANCE COMPANY
COLONIAL AMERICAN CASUALTY AND SURETY COMPANY
FIDELITY AND DEPOSIT COMPANY OF MARYLAND

By: Robert D. Murray
Vice President

By: Dawn E. Brown
Secretary

**State of Maryland
County of Baltimore**

On this 05th day of July, A.D. 2022, before the subscriber, a Notary Public of the State of Maryland, duly commissioned and qualified, **Robert D. Murray, Vice President and Dawn E. Brown, Secretary** of the Companies, to me personally known to be the individuals and officers described in and who executed the preceding instrument, and acknowledged the execution of same, and being by me duly sworn, depose and saith, that he/she is the said officer of the Company aforesaid, and that the seals affixed to the preceding instrument are the Corporate Seals of said Companies, and that the said Corporate Seals and the signature as such officer were duly affixed and subscribed to the said instrument by the authority and direction of the said Corporations.

IN TESTIMONY WHEREOF, I have hereunto set my hand and affixed my Official Seal the day and year first above written.



Constance A. Dunn, Notary Public
My Commission Expires: July 9, 2023

EXTRACT FROM BY-LAWS OF THE COMPANIES

"Article V, Section 8, Attorneys-in-Fact. The Chief Executive Officer, the President, or any Executive Vice President or Vice President may, by written instrument under the attested corporate seal, appoint attorneys-in-fact with authority to execute bonds, policies, recognizances, stipulations, undertakings, or other like instruments on behalf of the Company, and may authorize any officer or any such attorney-in-fact to affix the corporate seal thereto; and may with or without cause modify or revoke any such appointment or authority at any time."

CERTIFICATE

I, the undersigned, Vice President of the ZURICH AMERICAN INSURANCE COMPANY, the COLONIAL AMERICAN CASUALTY AND SURETY COMPANY, and the FIDELITY AND DEPOSIT COMPANY OF MARYLAND, do hereby certify that the foregoing Power of Attorney is still in full force and effect on the date of this certificate; and I do further certify that Article V, Section 8, of the By-Laws of the Companies is still in force.

This Power of Attorney and Certificate may be signed by facsimile under and by authority of the following resolution of the Board of Directors of the ZURICH AMERICAN INSURANCE COMPANY at a meeting duly called and held on the 15th day of December 1998.

RESOLVED: "That the signature of the President or a Vice President and the attesting signature of a Secretary or an Assistant Secretary and the Seal of the Company may be affixed by facsimile on any Power of Attorney...Any such Power or any certificate thereof bearing such facsimile signature and seal shall be valid and binding on the Company."

This Power of Attorney and Certificate may be signed by facsimile under and by authority of the following resolution of the Board of Directors of the COLONIAL AMERICAN CASUALTY AND SURETY COMPANY at a meeting duly called and held on the 5th day of May, 1994, and the following resolution of the Board of Directors of the FIDELITY AND DEPOSIT COMPANY OF MARYLAND at a meeting duly called and held on the 10th day of May, 1990.

RESOLVED: "That the facsimile or mechanically reproduced seal of the company and facsimile or mechanically reproduced signature of any Vice-President, Secretary, or Assistant Secretary of the Company, whether made heretofore or hereafter, wherever appearing upon a certified copy of any power of attorney issued by the Company, shall be valid and binding upon the Company with the same force and effect as though manually affixed.

IN TESTIMONY WHEREOF, I have hereunto subscribed my name and affixed the corporate seals of the said Companies, this 13th day of February, 2024.



MJ Pethick

By: Mary Jean Pethick
Vice President

TO REPORT A CLAIM WITH REGARD TO A SURETY BOND, PLEASE SUBMIT A COMPLETE DESCRIPTION OF THE CLAIM INCLUDING THE PRINCIPAL ON THE BOND, THE BOND NUMBER, AND YOUR CONTACT INFORMATION TO:

Zurich Surety Claims
1299 Zurich Way
Schaumburg, IL 60196-1056
Ph: 800-626-4577

If your jurisdiction allows for electronic reporting of surety claims, please submit to:
reportsfclaims@zurichna.com

Authenticity of this bond can be confirmed at bondvalidator.zurichna.com or 410-559-8790

THE FIDELITY AND DEPOSIT COMPANYOF MARYLAND
1299 Zurich Way Schaumburg, IL 60196**Statement of Financial Condition
As Of December 31, 2020****ASSETS**

Bonds.....	\$ 262,624,334
Stocks	19,715,392
Cash and Short-Term Investments	3,219,781
Reinsurance Recoverable	17,293,466
Federal Income Tax Recoverable.....	114,253
Other Accounts Receivable.....	29,083,530
TOTAL ADMITTED ASSETS.....	\$ 332,050,756

LIABILITIES, SURPLUS AND OTHER FUNDS

Reserve for Taxes and Expenses	\$ 539,588
Ceded Reinsurance Premiums Payable	43,847,005
Remittances and Items Unallocated	0
Payable to parents, subs and affiliates.....	0
Securities Lending Collateral Liability.....	0
TOTAL LIABILITIES.....	\$ 44,413,593
Capital Stock, Paid Up	\$ 5,000,000
Surplus.....	282,637,163
Surplus as regards Policyholders.....	287,637,163
TOTAL	\$ 332,050,756

Securities carried at \$165,065,329 in the above statement are deposited with various states as required by law.

Securities carried on the basis prescribed by the National Association of Insurance Commissioners. On the basis of market quotations for all bonds and stocks owned, the Company's total admitted assets at December 31, 2020 would be \$346,439,970 and surplus as regards policyholders \$302,026,377.

I, LAURA J. LAZARCZYK, Corporate Secretary of the FIDELITY AND DEPOSIT COMPANY OF MARYLAND, do hereby certify that the foregoing statement is a correct exhibit of the assets and liabilities of the said Company on the 31st day of December, 2020.

DocuSigned by:

Laura J. Lazarczyk

42DF60B474374B0...

Corporate Secretary

State of Illinois }
City of Schaumburg } SS:

Subscribed and sworn to, before me, a Notary Public of the State of Illinois, in the City of Schaumburg, this 15th day of March, 2021.



Ryan Horgan
Notary Public

Office of Risk Assessment
50 West Town Street
Third Floor - Suite 300
Columbus, Ohio 43215
(614)644-2658
Fax(614)644-3256
www.insurance.ohio.gov

Ohio Department of Insurance

Mike DeWine - Governor

Judith French - Director

Certificate of Compliance



Issued 03/23/2023

Effective 04/02/2023

Expires 04/01/2024

I, Judith French, hereby certify that I am the Director of Insurance in the State of Ohio and have supervision of insurance business in said State and as such I hereby certify that

FIDELITY AND DEPOSIT COMPANY OF MARYLAND, THE

of Illinois is duly organized under the laws of this State and is authorized to transact the business of insurance under the following section(s) of the Ohio Revised Code:

Section 3929.01 (A)

Allied Lines

Boiler & Machinery

Burglary & Theft

Commercial Auto - Liability

Commercial Auto - No Fault

Commercial Auto - Physical Damage

Credit

Earthquake

Fidelity

Financial Guaranty

Fire

Glass

Inland Marine

Multiple Peril - Commercial

Multiple Peril - Homeowners

Other Liability

Surety

Workers Compensation

FIDELITY AND DEPOSIT COMPANY OF MARYLAND, THE certified in its annual statement to this Department as of December 31, 2022 that it has admitted assets in the amount of \$284,263,392, liabilities in the amount of \$43,395,865, and surplus of at least \$240,867,527.

IN WITNESS WHEREOF, I have hereunto subscribed my name and caused my seal to be affixed at Columbus, Ohio, this day and date.

Judith L. French

Judith French, Director



Date Filed in Office	Debarment Period	Contractors, Subcontractors, & Officers	Address	Regarding Project	Case Number
1/12/2017	7/12/16-7/12/18	GM Mechanical, Inc.	7502 State Route 41 PO Box 12 Covington, OH 45318	Ohio State University Kennedy Commons Renovation	Franklin County C.P. Court No. 12 CV 002988
1/12/2017	7/12/16-7/12/18	CM Mechanical Services, Ltd.	7502 State Route 41 PO Box 12 Covington, OH 45318	Ohio State University Kennedy Commons Renovation	Franklin County C.P. Court No. 12 CV 002988
1/12/2017	7/12/16-7/12/18	Gerald E. Miller	7502 State Route 41 PO Box 12 Covington, OH 45318	Ohio State University Kennedy Commons Renovation	United States District Court, S.D. Ohio No. 2:15-cv-2631
1/12/2017	7/12/16-7/12/18	Cleide F. Miller a/k/a Clayce Miller	7502 State Route 41 PO Box 12 Covington, OH 45318	Ohio State University Kennedy Commons Renovation	United States District Court, S.D. Ohio No. 2:15-cv-2631

Strawser Paving Company
is not on Debarred Contractors
List 2-13-2024 gw



Office of Auditor of State
88 East Broad Street
Post Office Box 1140
Columbus, OH 43216-1140

Auditor of State - Unresolved Findings for Recovery Certified Search

(614) 466-4514
(800) 282-0370

I have searched The Auditor of State's unresolved findings for recovery database using the following criteria:

Contractor's Information:

Name: **Strawser, Kyle**
Organization: **Strawser Paving Company**
Date: **3/1/2024 8:11:39 AM**

This search produced the following list of **12** possible matches:

Name/Organization	Address
Jacoby, Kyle	4828 Pigeon Run Rd. SW
Crane Run Construction	15589 Holman Rd.
Industrial Hydraulics, Mr. Ron Baisden	108 S. 2nd St.
Stragan, Michelle	417 W Wood St.
Streber, Salina	1345 Benson St. SW
Street, Andre	4101 Edgewood Drive
Street, Andre	649 Mesa Verde Dr.
Strickler, Ryan	
Strickling, Vivian	11755 Norbourne Dr., Apt. 1001
Total Deliverance Ministries	105 Spears Court
Urban Strategies & Solutions	850 Lincoln Avenue
Vierstra, Cy	35863 Huston Road

The above list represents possible matches for the search criteria you entered. Please note that pursuant to ORC 9.24, only the person (which includes an organization) actually named in the finding for recovery is prohibited from being awarded a contract.

If the person you are searching for appears on this list, it means that the person has one or more findings for recovery and is prohibited from being awarded a contract described in ORC 9.24, unless one of the exceptions in that section apply.

If the person you are searching for does not appear on this list, an initialed copy of this page can serve as documentation of your compliance with ORC 9.24(E).

Please note that pursuant to ORC 9.24, it is the responsibility of the public office to verify that a person to whom it plans to award a contract does not appear in the Auditor of State's database. The Auditor of State's office is not responsible for inaccurate search results caused by user error or other circumstances beyond the Auditor of State's control.

APPENDIX D

Detail Sheets
Rebuild Profiles
Typical Section
Street Program Map
Sidewalk Program Map
Golf Course Cart Path Plans

Bid Item	Spec Item	Description	Qty Totals	Unit
1	203	Excavation	6985.11	CY
2	204	Sub Base Lift Material	145.71	CY
3	253	Full Depth Pavement Repair	2543	SY
4	254	1" to 3" Planing	37806	SY
5	SPEC	Cement Stabilization, 12"	15800.4	SY
6	454	Pavement Relief Joints	12	EA
7	307	7" Roller Compacted Concrete Base	13562	SY
8	407	Tack Coat (Trackless)	4893	GAL
9	410	Traffic Compacted Surface	400	CY
10	409	Sawing & Sealing Asphalt Concrete Pavement Joint	133.53	LF
11	441	1-1/2" Asphalt Concrete Intermediate Course, Type 2, (448)	2191.84	CY
12	441	1-1/2" Asphalt Concrete Surface Course, Type 1, (448), PG64-22	2191.84	CY
13	SPEC	Professional Design Services-Driveway Profiles (per driveway)	96	EA
14	608	5' wide Concrete Walk 6" (panels within drives & adjacent transition panels)	376	EA
15	608	5' wide Concrete walk 4"(panels beyond driveway transition panels)	1381	EA
16	608	4' x 5' (4" thick) concrete sidewalk panel	344	EA
17	608	4' x 5' (6" thick) concrete sidewalk panel	74	EA
18	608	Curb Ramp, Type C (ADA Compliant Reconfiguration)	95	EA
19	608	Curb Ramp, Type C (Truncated Dome Replacement)	4	EA
20	609	Combination Curb & Gutter Inc. 4" Underdrain	10803	LF
21	614	Maintenance of Traffic-ALL	1	LS
22	623	Construction Layout Stakes-ALL	8	LS
23	644	Crosswalk Line 12"	3380	LF
24	644	Stop Bar	1032	LF
25	659	Seeding and Mulching, Class 1	1	LS
26	SPEC	Remove/Replace Driveway Aprons (Cols Std Detail Z201)	1316	SY
27	624	Reclamite Asphalt Rejuvenating Agent-Rebuilds	50973	SY
28	SPEC	Sign Allowance-ALL	12	LS
29	609	Curb Replacement	12811	LF
30	624	Mobilization-ALL	1	LS
31	604	Manhole/Curb Inlet Full Reconstruction to Grade	7	EA
32	423	Crack Sealing	38639	SY
33	421	Microsurfacing, Surface Course	38639	SY
34	644	Center Line (Double)	2.65	MI
35	644	Edge Line White	0	MI
36	644	Lane Lines	6800	LF
37	644	"SCHOOL" Marking	1	EA
38	644	Lane Indicator - Arrows	36	EA
39	644	crosswalk Line 24"	12	LF
40	644	Edge Line, Yellow	0	MI
41	644	Channelizing Line	200	LF
42	644	Transverse Line (Within Crosswalks)	0	LF
43	644	Transverse Line, Yellow	668	LF
44	644	Transverse Line, White	0	LF
45	644	Lane Arrow, Combination	1	EA
46	644	Word on Pavement, 96"	1	EA
47	644	Dotted Line, 6"	748	LF
48	644	Island Marking	300	LF
49	644	Bike Symbol	18	EA
50	644	Chevrons	180	LF
51	807	Adjust valve box / curb box to grade (contengency)	8	EA
52	SPEC	Corner Manhole Inlet Lid Replacement	0	EA
53	SPEC	Catch basin replacement ring and grate	11	EA
54	254	Spot planing	25	SY
55	SPEC	Manhole/Curb Inlet Adjusted to Grade	52	EA
56	SPEC	Tree Removal (includes Stump Grinding)	92	EA
57	SPEC	Tree Root Prune per 5' panel	7	EA
58	SPEC	Tree Veg Removal/Pruning	166	LF
59	SPEC	SIDEWALK GRINDING	532	LF
60	SPEC	Vegetation in joint removal	47	LF
61	SPEC	Professional Design Services-Plans,profiles, cross sections of roadways-ALL REBUILDS	1	LS
62	SPEC	Professional Design Services-Curb Ramp Drawings (per curb ramp)	95	EA

Alternate 1 (Additional Crack Seal & Micro Surface)

Bid Item	Spec Item	Description	Qty Totals	Unit
1	423	Crack Seal	4538	SY
2	417	Asphalt Emulsion Slurry Seal, Type A	0	SY
3	421	Microsurfacing, Surface Course	4538	SY
4	614	Maintenance of Taffic	0	LS
5	644	Cross Walk 12"	48	LF
6	644	Cross Walk 24"	0	LF
7	644	Stop Bar	12	LF

Alternate 2 (Golf Course Cart Paths)

Bid Item	Spec Item	Description	Quantity	Unit
1	202	PAVEMENT REMOVED	305	SY
2	204	SUBGRADE COMPACTION	987	SY
3	254	PAVEMENT PLANING (1.25")	5977	SY
4	304	6" GRAVEL AGGREGATE BASE	165	CY
5	407	NON-TRACKING TACK COAT	418	GAL
6	659	SEEDING AND MULCHING	1000	SY
7	659	WATER	1	MGAL
8	1530	ASPHALT CONCRETE SURFACE COURSE, TYPE 1 (448) PG 64-22 (1.25")	242	CY
9	1530	ASPHALT CONCRETE INTERMEDIATE COURSE, TYPE 2 (448) (1.75")	339	CY
		STORM SEWER		
10	604	10" ADS N-12 PIPE	308	LF
11	604	10" ADS NYLOPLAST DRAIN BASIN	3	EACH
12	SPEC	CONSTRUCTION STAKING	1	LS
13	SPEC	MOBILIZATION	1	LS

Alternate 3 (Additional Striping)

Bid Item	Spec Item	Description	QTY Totals	Unit
1	644	Lane Line	6800	LF
2	644	Center Line (Double)	1.56	MI
3	644	Channelizing Line	200	LF
4	644	Stop Line	600	LF
5	644	Crosswalk Line 12"	1936	LF
6	644	Transverse Line, Yellow	668	LF
7	644	School Symbol Marking, 120"	1	EA
8	644	Lane Arrow	21	EA
9	644	Lane Arrow, Combination	1	EA
10	644	Word on Pavement, 96"	1	EA
11	644	Dotted Line, 6"	748	LF
12	644	Island Marking	300	LF
13	644	Bike Symbol	18	EA
14	644	Chevrons	180	LF

Street Name CAM CT

COLDWELL CT

HAYBROOK DR

From CHERRYSTONE DR N

MILLSIDE DR

GREEN BANK RD

To END OF COURT

END OF COURT

BROOKHILL DR

Type

Rebuild

Rebuild

Rebuild

Rebuild

Rebuild

Rebuild

Bid Item	Spec Item	Description	Unit	Quantity		Quantity		Quantity	
1	203	Excavation	CY	298.2		1025.0		974.7	
5	SPEC	Cement Stabilization, 12"	SY	808.8		2534.4		2239.2	
6	454	Pavement Relief Joints	EA	1.0		2.0		3.0	
7	307	7" Roller Compacted Concrete Base	SY	694.2		2175.4		1922.0	
8	407	Tack Coat (Trackless)	GAL	68.0		212.0		187.0	
9	410	Traffic Compacted Surface	CY	50.0		50.0		50.0	
10	409	Sawing & Sealing Asphalt Concrete Pavement Joint	LF	4.6		19.4		22.4	
11	441	1-1/2" Asphalt Concrete Intermediate Course, Type 2, (448)	CY	29.0		90.8		80.2	
12	441	1-1/2" Asphalt Concrete Surface Course, Type 1, (448), PG64-22	CY	29.0		90.8		80.2	
13	SPEC	Professional Design Services-Driveway Profiles (per driveway)	EA	4.0		19.0		14.0	
14	608	5' X 5' Concrete Walk 6" (panels within drives & adjacent transition panels)	EA	16.0		76.0		56.0	
15	608	5' Concrete walk 4"(panels beyond driveway transition panels)	EA	58.0		191.0		202.0	
18	608	Curb Ramp, Type C (ADA Compliant Reconfiguration)	EA	2.0		4.0		4.0	
19	608	Curb Ramp, Type C (Truncated Dome Replacement)	EA	0.0		0.0		0.0	
20	609	Combination Curb & Gutter Inc. 4" Underdrain	LF	283.0		1299.0		1462.0	
21	614	Maintenance of Traffic	LS						
22	623	Construction Layout Stakes	LS	1.0		1.0		1.0	
23	644	Crosswalk Line 12"	LF	48.0		0.0		0.0	
24	644	Stop Bar	LF	12.0		0.0		0.0	
25	659	Seeding and Mulching, Class 1	LS						
26	SPEC	Remove/Replace Driveway Aprons (Cols Std Detail 2201)	SY	56.0		266.0		196.0	
27	1540	Reclamite Asphalt Rejuvenating Agent	SY	674.0		2112.0		1866.0	
28	SPEC	Sign Allowance	LS	1.0		0.0		0.0	
2	204	Sub Base Lift Material	CY	0.0		0.0		0.0	
30	624	Mobilization	LS	1.0		0.0		0.0	
53	SPEC	Catch basin replacement ring and grate	EA	0.0		5.0		0.0	
56	SPEC	Tree Removal	EA	3.0		17.0		8.0	
55	SPEC	Manhole/Curb Inlet Adjusted to Grade	EA	1.0		0.0		1.0	
61	SPEC	Professional Desgn Services-Plans,profiles, cross sections of roadways-ALL	LS						
62	SPEC	Professional Design Services-Curb Ramp Drawings (per curb ramp)	EA	2		4		4	

				Street Name	TIMOTHY CT		TIM TAM AVE		TIM TAM AVE	
				From	TIMOTHY DR		RIVA RIDGE BLVD		BOREL CT	
				To	END OF COURT		VENETIAN WAY		CORDERO LN West	
				Type	Rebuild	Rebuild	Rebuild	Rebuild	Rebuild	Rebuild
Bid Item	Spec Item	Description	Unit	Quantity			Quantity		Quantity	
1	203	Excavation	CY	359.8			855.4		1903.3	
5	SPEC	Cement Stabilization, 12"	SY	919.2			1777.2		3651.6	
6	454	Pavement Relief Joints	EA	1.0			2.0		1.0	
7	307	7" Roller Compacted Concrete Base	SY	789.0			1525.4		3134.3	
8	407	Tack Coat (Trackless)	GAL	77.0			149.0		95.0	
9	410	Traffic Compacted Surface	CY	50.0			50.0		50.0	
10	409	Sawing & Sealing Asphalt Concrete Pavement Joint	LF	5.9			25.7		31.3	
11	441	1-1/2" Asphalt Concrete Intermediate Course, Type 2, (448)	CY	32.9			63.7		130.8	
12	441	1-1/2" Asphalt Concrete Surface Course, Type 1, (448), PG64-22	CY	32.9			63.7		130.8	
13	SPEC	Professional Design Services-Driveway Profiles (per driveway)	EA	6.0			11.0		15.0	
14	608	5' Concrete Walk 6" (panels within drives & adjacent transition panels)	EA	24.0			44.0		60.0	
15	608	5' Concrete walk 4"(panels beyond driveway transition panels)	EA	71.0			260.0		307.0	
18	608	Curb Ramp, Type C (ADA Compliant Reconfiguration)	EA	2.0			12.0		8.0	
19	608	Curb Ramp, Type C (Truncated Dome Replacement)	EA	1.0			0.0		1.0	
20	609	Combination Curb & Gutter Inc. 4" Underdrain	LF	417.0			1532.0		3810.0	
21	614	Maintenance of Traffic	LS							
22	623	Construction Layout Stakes	LS	1.0			1.0		1.0	
23	644	Crosswalk Line 12"	LF	0.0			0.0		196.0	
24	644	Stop Bar	LF	0.0			0.0		48.0	
25	659	Seeding and Mulching, Class 1	LS							
26	SPEC	Remove/Replace Driveway Aprons (Cols Std Detail 2201)	SY	84.0			154.0		210.0	
27	1540	Reclamite Asphalt Rejuvenating Agent	SY	766.0			1481.0		3043.0	
28	SPEC	Sign Allowance	LS	0.0			0.0		1.0	
2	204	Sub Base Lift Material	CY	0.0			0.0		0.0	
30	624	Mobilization	LS	0.0			0.0		0.0	
53	SPEC	Catch basin replacement ring and grate	EA	2.0			0.0		0.0	
56	SPEC	Tree Removal	EA	0.0			4.0		20.0	
55	SPEC	Manhole/Curb Inlet Adjusted to Grade	EA	0.0			2.0		8.0	
61	SPEC	Professional Design Services-Plans,profiles, cross sections of roadways-ALL	LS							
62	SPEC	Professional Design Services-Curb Ramp Drawings (per curb ramp)	EA	2			12		8	

Street Name WINDBOURNE ST
From SANDBURR DR (STREET SIGN)
To BLUESTEM AVE
Type

WINDROW CT
MIDHURST RD
Contingency
END OF COURT

Bid Item	Spec Item	Description	Unit	Rebuild		Rebuild		Rebuild		Rebuild	
				Quantity		Quantity		Quantity		Quantity	
1	203	Excavation	CY	774.4		794					
5	SPEC	Cement Stabilization, 12"	SY	1957.2		1913					
6	454	Pavement Relief Joints	EA	1.0		1					
7	307	7" Roller Compacted Concrete Base	SY	1679.9		1642					
8	407	Tack Coat (Trackless)	GAL	164.0		160					
9	410	Traffic Compacted Surface	CY	50.0		50					
10	409	Sawing & Sealing Asphalt Concrete Pavement Joint	LF	8.1		16					
11	441	1-1/2" Asphalt Concrete Intermediate Course, Type 2, (448)	CY	70.1		69					
12	441	1-1/2" Asphalt Concrete Surface Course, Type 1, (448), PG64-22	CY	70.1		69					
13	SPEC	Professional Design Services-Driveway Profiles (per driveway)	EA	10.0		15		2			
14	608	5' Concrete Walk 6" (panels within drives & adjacent transition panels)	EA	40.0		60					
15	608	5' Concrete walk 4"(panels beyond driveway transition panels)	EA	129.0		163		0			
18	608	Curb Ramp, Type C (ADA Compliant Reconfiguration)	EA	0.0		2					
19	608	Curb Ramp, Type C (Truncated Dome Replacement)	EA	0.0		0					
20	609	Combination Curb & Gutter Inc. 4" Underdrain	LF	925.0		1075					
21	614	Maintenance of Traffic	LS								
22	623	Construction Layout Stakes	LS	1.0		1					
23	644	Crosswalk Line 12"	LF	96.0		48					
24	644	Stop Bar	LF	12.0		12					
25	659	Seeding and Mulching, Class 1	LS								
26	SPEC	Remove/Replace Driveway Aprons (Cols Std Detail 2201)	SY	140.0		210					
27	1540	Reclamite Asphalt Rejuvenating Agent	SY	1631.0		1594					
28	SPEC	Sign Allowance	LS	1.0		0		0			
2	204	Sub Base Lift Material	CY	82.0		64					
30	624	Mobilization	LS	0.0		0					
53	SPEC	Catch basin replacement ring and grate	EA	0.0		2		2			
56	SPEC	Tree Removal	EA	0.0		7					
55	SPEC	Manhole/Curb Inlet Adjusted to Grade	EA	2.0		0					
61	SPEC	Professional Desgn Services-Plans,profiles, cross sections of roadways-ALL	LS								
62	SPEC	Professional Design Services-Curb Ramp Drawings (per curb ramp)	EA	0		2					

Street Name

BEAVERBROOK DR

CHALLIS SPRINGS DR

CHERRYSTONE DR N & S

From

BARDEN CT

HARRISON POND DR

TRAPP DR N

To

HUNTERS RUN WEST

CLARK STATE RD

TRAPP DR

Type

Bid Item	Spec Item	Description	Unit	Quantity		Quantity	Total	Resurfacing	
								Quantity	Total
4	254	1" to 3" Planing	SY	4326		7677		4270	
8	407	Tack Coat (Trackless)	GAL	433		768		427	
11	441	1-1/2" Asphalt Concrete Intermediate Course, Type 2, (448)	CY	186		330		184	
12	441	1-1/2" Asphalt Concrete Surface Course, Type 1, (448), PG64-22	CY	186		330		184	
18	608	Curb Ramp, Type C (ADA Compliant Reconfiguration)	EA	0		12		6	
20	609	Curb Replacement	LF	1575		2910		1448	
34	644	Center Line	MI	0		0		0	
23	644	Crosswalk Line 12"	LF	48		288		0	
39	644	Crosswalk Line 24"	LF	0		0		0	
24	644	Stop Bar	LF	12		60		24	
55	604	Manhole/Curb Inlet Adjusted to Grade	EA	2		13		8	
31	604	Manhole/Curb Inlet Full Reconstruction to Grade	EA	0		0		1	
19	608	Curb Ramp, Type C (Truncated Dome Replacement)	EA	0		0		0	
3	253	Full Depth Pavement Repair (Contingency)	SY	2543		0		0	
38	644	Lane Arrow	EA	0		0		0	
35	644	Edge Line	MI	0		0		0	
36	644	Lane Line	LF	0		0		0	
37	644	School	EA	0		0		0	
28	SPEC	New sign	EA	0		0		1	
25	659	Seeding and Mulching, Class 1	LS	1		0		0	
16	604	4' x 5' (4" thick) concrete sidewalk panel	EA	11		17		78	
52	604	Coffin box lid replacement	EA	0		0		0	
27	1540	Reclamite Asphalt Rejuvenating Agent-Rebuilds	SY	4326		7677		4270	
17	604	4' x 5' (6" thick) concrete sidewalk panel	EA	8		8		18	
56	SPEC	Tree Removal (includes Stump Grinding)	EA	1		1		23	
57	SPEC	Tree Root Prune per panel	EA	1		4		2	
58	SPEC	Tree Veg Removal/Pruning	LF	5		83		25	
59	SPEC	Sidewalk Grinding	LF	50		102		132	
51	807	Adjust valve box / curb box to grade	EA	5		0		2	
60	SPEC	Vegitation in joint removal	LF	5		17		5	
62	SPEC	Professional Design Services-Curb Ramp Drawings (per curb ramp)	EA	0		12		6	

StreetName

EASTGATE PKWY

LANG DR

LANG DR

From

BLATT BLVD

RIVA RIDGE BLVD

BRYN MAWR DR

To

DEFFENBAUGH CT

BRYN MAWR DR

END OF COURT

Type

Resurfacing

Resurfacing

Resurfacing

Bid Item	Spec Item	Description	Unit	Quantity	Total	Quantity	Total	Quantity	Total
4	254	1" to 3" Planing	SY	11672		1196		491	
8	407	Tack Coat (Trackless)	GAL	1167		120		49	
11	441	1-1/2" Asphalt Concrete Intermediate Course, Type 2, (448)	CY	502		51		21	
12	441	1-1/2" Asphalt Concrete Surface Course, Type 1, (448), PG64-22	CY	502		51		21	
18	608	Curb Ramp, Type C (ADA Compliant Reconfiguration)	EA	0		6		0	
20	609	Curb Replacement	LF	771		414		0	
34	644	Center Line	MI	1.09		0		0	
23	644	Crosswalk Line 12"	LF	0		96		0	
39	644	Crosswalk Line 24"	LF	0		0		0	
24	644	Stop Bar	LF	12		24		0	
55	604	Manhole/Curb Inlet Adjusted to Grade	EA	7		2		0	
31	604	Manhole/Curb Inlet Full Reconstruction to Grade	EA	0		0		0	
19	608	Curb Ramp, Type C (Truncated Dome Replacement)	EA	0		0		0	
3	253	Full Depth Pavement Repair	SY	0		0		0	
38	644	Lane Arrow	EA	15		0		0	
35	644	Edge Line	MI	0		0		0	
36	644	Lane Line	LF	0		0		0	
37	644	School	EA	0		0		0	
28	Spec	New sign	EA	0		1		0	
25	659	Seeding and Mulching, Class 1	LS	0		0		0	
16	604	4' x 5' (4" thick) concrete sidewalk panel	EA	0		15		0	
52	604	Coffin box lid replacement (Contingency)	EA	0		0		0	
27	1540	Reclamite Asphalt Rejuvenating Agent-Rebuilds	SY	11672		1196		491	
17	604	4' x 5' (6" thick) concrete sidewalk panel	EA	0		4		0	
56	SPEC	Tree Removal (includes Stump Grinding)	EA	0		5		0	
57	SPEC	Tree Root Prune per panel	EA	0		0		0	
58	SPEC	Tree Veg Removal/Pruning	LF	0		0		0	
59	SPEC	Sidewalk Grinding	LF	0		32		3	
51	807	Adjust valve box / curb box to grade	EA	0		0		0	
60	SPEC	Vegetation in joint removal	LF	0		0		0	
62	SPEC	Professional Design Services-Curb Ramp Drawings (per curb ramp)	EA	0		6		0	

Street Name				MISTLETOE ST		SANDBURR DR		SPIREA CT	
From:				MOSS OAK AVE		STYGLER RD		MISTLETOE ST	
To:				THISTLE AVE		WINDBOURNE (STREET SIGN)		END OF COURT	
Type				Resurfacing		Resurfacing		Resurfacing	
Bid Item	Spec Item	Description	Unit	Quantity	Total	Quantity	Total	Quantity	Total
4	254	1" to 3" Planing	SY	3580		4100		494	
8	407	Tack Coat (Trackless)	GAL	358		410		49	
11	441	1-1/2" Asphalt Concrete Intermediate Course, Type 2, (448)	CY	154		176		21	
12	441	1-1/2" Asphalt Concrete Surface Course, Type 1, (448), PG64-22	CY	154		176		21	
18	608	Curb Ramp, Type C (ADA Compliant Reconfiguration)	EA	17		7		2	
20	609	Curb Replacement	LF	2724		2600		234	
34	644	Center Line	MI	0		0		0	
23	644	Crosswalk Line 12"	LF	144		48		48	
39	644	Crosswalk Line 24"	LF	0		0		12	
24	644	Stop Bar	LF	36		12		12	
55	604	Manhole/Curb Inlet Adjusted to Grade	EA	0		6		0	
31	604	Manhole/Curb Inlet Full Reconstruction to Grade (Contingency)	EA	1		0		5	
19	608	Curb Ramp, Type C (Truncated Dome Replacement)	EA	0		0		2	
3	253	Full Depth Pavement Repair	SY	0		0		0	
38	644	Lane Arrow	EA	0		0		0	
35	644	Edge Line	MI	0		0		0	
36	644	Lane Line	LF	0		0		0	
37	644	School	EA	0		0		0	
28	Spec	New Sign	EA	0		0		1	
25	659	Seeding and Mulching, Class 1	LS	0		0		0	
16	604	4' x 5' (4" thick) concrete sidewalk panel	EA	20		196		3	
52	604	Coffin box lid replacement (Contingency)	EA	0		0		0	
27	1540	Reclamite Asphalt Rejuvenating Agent-Rebuilds	SY	3580		4100		494	
17	604	4' x 5' (6" thick) concrete sidewalk panel	EA	4		29		1	
56	SPEC	Tree Removal (includes Stump Grinding)	EA	0		3		0	
57	SPEC	Tree Root Prune per panel	EA	0		0		0	
58	SPEC	Tree Veg Removal/Pruning	LF	0		15		0	
59	SPEC	Sidewalk Grinding	LF	87		77		9	
51	807	Adjust valve box / curb box to grade	EA	1		0		0	
60	SPEC	Vegetation in joint removal	LF	10		5		0	
62	SPEC	Professional Design Services-Curb Ramp Drawings (per curb ramp)	EA	17		7		2	

StreetName				AROYA CT		AVIR CT		BARDEN CT	
From				CHALLIS SPRINGS		BRYN MAWR DR		BEAVERBROOK DR	
To				END OF COURT		END OF COURT		END OF COURT	
Type				Crack Seal / Micro surface		Crack Seal / Micro surface		Crack Seal / Micro surface	
Bid Item	Spec Item	Description	Unit	Quantity	Total	Quantity	Total	Quantity	Total
32	423	Crack Seal	SY	828		928		586	
33	421	Microsurfacing, Surface Course	SY	828		928		586	
21	614	Maintenance of Taffic	LS	1					
23	644	Cross Walk 12"	LF						
39	644	Cross Walk 24"	LF						
24	644	Stop Bar	LF					12	
34	644	Centerline	MI						
35	644	Edgeline	MI						
36	644	Lane Lines	LF						
37	644	"School"	EA						
4	254	1-3" Spot planing	SY						
38	644	Lane Indicator - Arrow	EA						
28	SPEC	Sign	EA					1	
20	609	Curb & Gutter	LF						
16	608	4' concrete walk 4" thick replacements (4' x 5' panel)	EA	3					
17	608	4' concrete walk 6" thick replacements (4' x 5' panel)	EA	1					
19	608	Curb Ramp, (Truncated Dome Replacement)	EA						
18	608	Curb Ramp, (ADA Compliant Reconfiguration)	EA	2				2	
56	SPEC	Tree Removal (includes stump grinding)	EA						
57	SPEC	Tree Root Prune per sidewalk panel	EA						
58	SPEC	Tree Veg Removal/Pruning	LF	18				5	
59	SPEC	Sidewalk Grinding per sidewalk panel	EA	8				8	
51	807	Adjust Valve Box / Curb Box	EA						
60	SPEC	Vegitation in joint removal	LF					5	
62	SPEC	Professional Design Services-Curb Ramp Drawings (per curb ramp)	EA	2				2	

				StreetName		CODET RD		DEBRA LN		FARM CREEK DR	
				From		LINCOLNSHIRE RD		GOSHEN LN		HAVENS CORNERS RD	
				To		PENNY LN		SHARA PARK PL		CAROWAY BLVD	
				Type		Crack Seal / Micro surface		Crack Seal / Micro surface		Crack Seal / Micro surface	
Bid Item	Spec Item	Description	Unit		Quantity	Total		Quantity	Total	Quantity	Total
32	423	Crack Seal	SY		744			2150		6520	
33	421	Microsurfacing, Surface Course	SY		744			2150		6520	
21	614	Maintenance of Taffic	LS								
23	644	Cross Walk 12"	LF		96			48		240	
39	644	Cross Walk 24"	LF								
24	644	Stop Bar	LF		36			12		60	
34	644	Centerline	MI								
35	644	Edgeline	MI								
36	644	Lane Lines	LF								
37	644	"School"	EA								
4	254	1-3" Spot planing	SY								
38	644	Lane Indicator - Arrow	EA								
28	SPEC	Sign	EA		1					2	
20	609	Curb & Gutter	LF								
16	608	4' concrete walk 4" thick replacements (4' x 4')	EA								
17	608	4' concrete walk 6" thick replacements (4' x 4')	EA								
19	608	Curb Ramp, (Truncated Dome Replacement)	EA								
18	608	Curb Ramp, (ADA Compliant Reconfiguration)	EA								
56	SPEC	Tree Removal (includes stump grinding)	EA								
57	SPEC	Tree Root Prune per sidewalk panel	EA								
58	SPEC	Tree Veg Removal/Pruning	LF								
59	SPEC	Sidewalk Grinding per sidewalk panel	EA								
51	807	Adjust Valve Box / Curb Box	EA								
60	SPEC	Vegitation in joint removal	LF								
62	SPEC	Professional Design Services-Curb Ramp Dr	EA								

StreetName				HOWLAND DR		LINCOLNSHIRE		LINE WAY	
From				RICE AVE		KENILWORTH		ALESBURY DR	
To				END OF COURT		PALACE LN		ULVERSTON/AYLESBURY- LINE WAY	
Type				Crack Seal / Micro surface		Crack Seal / Micro surface		Crack Seal / Micro surface	
Bid Item	Spec Item	Description	Unit	Quantity	Total	Quantity	Total	Quantity	Total
32	423	Crack Seal	SY	3134		10518		5776	
33	421	Microsurfacing, Surface Course	SY	3134		10518		5776	
21	614	Maintenance of Taffic	LS						
23	644	Cross Walk 12"	LF						
39	644	Cross Walk 24"	LF						
24	644	Stop Bar	LF	12		24			
34	644	Centerline	MI						
35	644	Edgeline	MI						
36	644	Lane Lines	LF						
37	644	"School"	EA						
4	254	1-3" Spot planing	SY					25	
38	644	Lane Indicator - Arrow	EA						
28	SPEC	Sign	EA	1		1			
20	609	Curb & Gutter	LF					135	
16	608	4' concrete walk 4" thick replacements (4' x	EA						
17	608	4' concrete walk 6" thick replacements (4' x	EA						
19	608	Curb Ramp, (Truncated Dome Replacemen	EA						
18	608	Curb Ramp, (ADA Compliant Reconfiguratio	EA						
56	SPEC	Tree Removal (includes stump grinding)	EA						
57	SPEC	Tree Root Prune per sidewalk panel	EA						
58	SPEC	Tree Veg Removal/Pruning	LF						
59	SPEC	Sidewalk Grinding per sidewalk panel	EA						
51	807	Adjust Valve Box / Curb Box	EA						
60	SPEC	Vegitation in joint removal	LF						
62	SPEC	Professional Design Services-Curb Ramp Dr	EA						

				StreetName		OLD PINE DR		SPRUCE HILL DR		BEAVERBROOK DR	
				From		BRYN MAWR		RICE AVE		BARDEN CT	
				To		RIVA RIDGE BLVD		CAROWAY BLVD		HELMBRIGHT DR	
				Type		Crack Seal / Micro surface		Crack Seal / Micro surface		Crack Seal / Micro surface	
Bid Item	Spec Item	Description	Unit	Quantity	Total	Quantity	Total	Quantity	Total		
32	423	Crack Seal	SY	2308		5147		0			
33	421	Microsurfacing, Surface Course	SY	2308		5147		0			
21	614	Maintenance of Taffic	LS								
23	644	Cross Walk 12"	LF								
39	644	Cross Walk 24"	LF								
24	644	Stop Bar	LF								
34	644	Centerline	MI								
35	644	Edgeline	MI								
36	644	Lane Lines	LF								
37	644	"School"	EA								
4	254	1-3" Spot planing	SY								
38	644	Lane Indicator - Arrow	EA								
28	SPEC	Sign	EA								
20	609	Curb & Gutter	LF								
16	608	4' concrete walk 4" thick replacements (4' x 4')	EA					1			
17	608	4' concrete walk 6" thick replacements (4' x 6')	EA					1			
19	608	Curb Ramp, (Truncated Dome Replacement)	EA								
18	608	Curb Ramp, (ADA Compliant Reconfiguration)	EA					7			
56	SPEC	Tree Removal (includes stump grinding)	EA								
57	SPEC	Tree Root Prune per sidewalk panel	EA								
58	SPEC	Tree Veg Removal/Pruning	LF					15			
59	SPEC	Sidewalk Grinding per sidewalk panel	EA					24			
51	807	Adjust Valve Box / Curb Box	EA								
60	SPEC	Vegetation in joint removal	LF								
62	SPEC	Professional Design Services-Curb Ramp Dr	EA					7			

				StreetName		AFFIRMED CT		BOREL CT		SHAKER DR	
				From		TIM TAM AVE		TIM TAM AVE		TIMOTHY DR	
				To		END OF COURT		END OF COURT		WINDBOURNE ST	
			Type	Crack Seal / Micro surface		Crack Seal / Micro surface		Crack Seal / Micro surface		Crack Seal / Micro surface	
Bid Item	Spec Item	Description	Unit	Quantity	Total	Quantity	Total	Quantity	Total	Quantity	Total
1	423	Crack Seal	SY	1107		751		1226			
3	421	Microsurfacing, Surface Course	SY	1107		751		1226			
4	614	Maintenance of Taffic	LS								
5	644	Cross Walk 12"	LF	0		0		48			
6	644	Cross Walk 24"	LF								
7	644	Stop Bar	LF	0		0		12			

StreetName
From
To

WINDBOURNE ST
BLUESTEM AVE
SHAKER DR

Type

Bid Item	Spec Item	Description	Unit	Crack Seal / Micro surface		Crack Seal / Micro surface		Crack Seal / Micro surface	
				Quantity	Total	Quantity	Total	Quantity	Total
1	423	Crack Seal	SY	1454		0		0	
3	421	Microsurfacing, Surface Course	SY	1454		0		0	
4	614	Maintenance of Taffic	LS						
5	644	Cross Walk 12"	LF						
6	644	Cross Walk 24"	LF						
7	644	Stop Bar	LF						

					Morrison		Morrison		Morrison	
					Tech Center		Taylor		Waterbury	
					Taylor		Waterbury		Intersection	
					Striping		Striping		Striping	
Bid Item	Spec Item	Description		Unit	Quantity	Total	Quantity	Total	Quantity	Total
	644	Edge Line, White		MI						
	644	Edge Line, Yellow		MI						
1	644	Lane Line		LF	6800					
2	644	Center Line		MI			1.44			
3	644	Channelizing Line		LF						
4	644	Stop Line		LF					120	
5	644	Crosswalk Line		LF					248	
	644	Transverse Line (Within Crosswalks)		LF						
6	644	Transverse Line, Yellow		LF	620		48			
	644	Transverse Line, White		LF						
7	644	School Symbol Marking, 120"		EA						
8	644	Lane Arrow		EA	8		10			
9	644	Lane Arrow, Combination		EA						
10	644	Word on Pavement, 96"		EA						
11	644	Dotted Line, 6"		LF			748			
12	644	Island Marking		LF						
	644	Crosswalk Line 24"		LF						
13	644	Bike Symbol		EA						
14	644	Chevrons		LF						

StreetName					Stygler Road-Bike Lane east and west sides		Dunbarton Rd		Autumn Ash Ct	
From To					Chapelfield Rd Ridenour Rd		Bowling Green intersection		Woodmark Dr intersection	
Type					Striping		Striping		Striping	
Bid Item	Spec Item	Description		Unit	Quantity	Total	Quantity	Total	Quantity	Total
	644	Edge Line, White		MI						
	644	Edge Line, Yellow		MI						
1	644	Lane Line		LF						
2	644	Center Line		MI						
3	644	Channelizing Line		LF						
4	644	Stop Line		LF					24	
5	644	Crosswalk Line		LF					48	
	644	Transverse Line (Within Crosswalks)		LF						
6	644	Transverse Line, Yellow		LF						
	644	Transverse Line, White		LF						
7	644	School Symbol Marking, 120"		EA			1			
8	644	Lane Arrow		EA						
9	644	Lane Arrow, Combination		EA						
10	644	Word on Pavement, 96"		EA						
11	644	Dotted Line, 6"		LF						
12	644	Island Marking		LF						
	644	Crosswalk Line 24"		LF						
13	644	Bike Symbol		EA	18					
14	644	Chevrons (2 per bike symbol 4"x5')		LF	180					

					Oaksedge Dr		King George Ave		Muskingum Dr	
					Woodmark Dr		Daventry Ln		Bowling Green Pl	
					intersection		intersection		intersection	
Type					Striping		Striping		Striping	
Bid Item	Spec Item	Description		Unit	Quantity	Total	Quantity	Total	Quantity	Total
	644	Edge Line, White		MI						
	644	Edge Line, Yellow		MI						
1	644	Lane Line		LF						
2	644	Center Line		MI						
3	644	Channelizing Line		LF						
4	644	Stop Line		LF	12		12		12	
5	644	Crosswalk Line		LF	48		48		48	
	644	Transverse Line (Within Crosswalks)		LF						
6	644	Transverse Line, Yellow		LF						
	644	Transverse Line, White		LF						
7	644	School Symbol Marking, 120"		EA						
8	644	Lane Arrow		EA						
9	644	Lane Arrow, Combination		EA						
10	644	Word on Pavement, 96"		EA						
11	644	Dotted Line, 6"		LF						
12	644	Island Marking		LF						
	644	Crosswalk Line 24"		LF						
13	644	Bike Symbol		EA						
14	644	Chevrons		LF						

					Morrison Rd		Imperial Dr		Barwood Dr	
					Taylor Rd		Daventry Ln		Flintwood Dr	
					Intersection		Intersection		Intersection	
					Striping		Striping		Striping	
Bid Item	Spec Item	Description		Unit	Quantity	Total	Quantity	Total	Quantity	Total
	644	Edge Line, White		MI						
	644	Edge Line, Yellow		MI						
1	644	Lane Line		LF						
2	644	Center Line		MI						
3	644	Channelizing Line		LF	200					
4	644	Stop Line		LF	96		12		12	
5	644	Crosswalk Line		LF	248		96		48	
	644	Transverse Line (Within Crosswalks)		LF						
6	644	Transverse Line, Yellow		LF						
	644	Transverse Line, White		LF						
7	644	School Symbol Marking, 120"		EA						
8	644	Lane Arrow		EA	3					
9	644	Lane Arrow, Combination		EA	1					
10	644	Word on Pavement, 96"		EA	1					
11	644	Dotted Line, 6"		LF						
12	644	Island Marking		LF	300					
	644	Crosswalk Line 24"		LF						
13	644	Bike Symbol		EA						
14	644	Chevrons		LF						

				StreetName	Founders Ridge Dr		Founders Ridge Dr		Woodmark Run	
				From	N Stygler Rd		Ridenour Rd		N Stygler Rd	
				To	intersection		intersection		intersection	
				Typ	Striping		Striping		Striping	
Bid Item	Spec Item	Description		Unit	Quantity	Total	Quantity	Total	Quantity	Total
	644	Edge Line, White		MI						
	644	Edge Line, Yellow		MI						
1	644	Lane Line		LF						
2	644	Center Line		MI	0.02				0.02	
3	644	Channelizing Line		LF						
4	644	Stop Line		LF	24		12		12	
5	644	Crosswalk Line		LF	72		60		48	
	644	Transverse Line (Within Crosswalks)		LF						
6	644	Transverse Line, Yellow		LF						
	644	Transverse Line, White		LF						
7	644	School Symbol Marking, 120"		EA						
8	644	Lane Arrow		EA						
9	644	Lane Arrow, Combination		EA						
10	644	Word on Pavement, 96"		EA						
11	644	Dotted Line, 6"		LF						
12	644	Island Marking		LF						
	644	Crosswalk Line 24"		LF						
13	644	Bike Symbol		EA						
14	644	Chevrons		LF						


					Amfield Ct		Trafalger Ct		Dunbarton Rd	
					N Stygler Rd		Watling Rd		Whittenberg St	
					intersection		intersection		intersection	
					Striping		Striping		Striping	
Bid Item	Spec Item	Description		Unit	Quantity	Total	Quantity	Total	Quantity	Total
	644	Edge Line, White		MI						
	644	Edge Line, Yellow		MI						
1	644	Lane Line		LF						
2	644	Center Line		MI						
3	644	Channelizing Line		LF						
4	644	Stop Line		LF	12		12		12	
5	644	Crosswalk Line		LF	84		48		60	
	644	Transverse Line (Within Crosswalks)		LF						
6	644	Transverse Line, Yellow		LF						
	644	Transverse Line, White		LF						
7	644	School Symbol Marking, 120"		EA						
8	644	Lane Arrow		EA						
9	644	Lane Arrow, Combination		EA						
10	644	Word on Pavement, 96"		EA						
11	644	Dotted Line, 6"		LF						
12	644	Island Marking		LF						
	644	Crosswalk Line 24"		LF						
13	644	Bike Symbol		EA						
14	644	Chevrons		LF						

					Bowling Green Pl		Denison Ave		Citadel St	
					Denison Ave		Denison Ct		Denison Ave	
					intersection		intersection		intersection	
					Striping		Striping		Striping	
Bid Item	Spec Item	Description		Unit	Quantity	Total	Quantity	Total	Quantity	Total
	644	Edge Line, White		MI						
	644	Edge Line, Yellow		MI						
1	644	Lane Line		LF						
2	644	Center Line		MI						
3	644	Channelizing Line		LF						
4	644	Stop Line		LF	36				12	
5	644	Crosswalk Line		LF	48		48		48	
	644	Transverse Line (Within Crosswalks)		LF						
6	644	Transverse Line, Yellow		LF						
	644	Transverse Line, White		LF						
7	644	School Symbol Marking, 120"		EA						
8	644	Lane Arrow		EA						
9	644	Lane Arrow, Combination		EA						
10	644	Word on Pavement, 96"		EA						
11	644	Dotted Line, 6"		LF						
12	644	Island Marking		LF						
	644	Crosswalk Line 24"		LF						
13	644	Bike Symbol		EA						
14	644	Chevrons		LF						

					Muskingum Dr		Muskingum Dr		James Rd	
					Citadel St		Albion Way		Lansdowne Ave	
					intersection		intersection		intersection	
					Striping		Striping		Striping	
Bid Item	Spec Item	Description		Unit	Quantity	Total	Quantity	Total	Quantity	Total
	644	Edge Line, White		MI						
	644	Edge Line, Yellow		MI						
1	644	Lane Line		LF						
2	644	Center Line		MI						
3	644	Channelizing Line		LF						
4	644	Stop Line		LF	12		12		12	
5	644	Crosswalk Line		LF	48		48			
	644	Transverse Line (Within Crosswalks)		LF						
6	644	Transverse Line, Yellow		LF						
	644	Transverse Line, White		LF						
7	644	School Symbol Marking, 120"		EA						
8	644	Lane Arrow		EA						
9	644	Lane Arrow, Combination		EA						
10	644	Word on Pavement, 96"		EA						
11	644	Dotted Line, 6"		LF						
12	644	Island Marking		LF						
	644	Crosswalk Line 24"		LF						
13	644	Bike Symbol		EA						
14	644	Chevrons		LF						

					James Rd		Carlin Ct		Ainsworth Ave	
					Johnstown Rd		Ridenour Rd		Ridenour Rd	
					Intersection		Intersection		Intersection	
					Striping		Striping		Striping	
Bid Item	Spec Item	Description		Unit	Quantity	Total	Quantity	Total	Quantity	Total
	644	Edge Line, White		MI						
	644	Edge Line, Yellow		MI						
1	644	Lane Line		LF						
2	644	Center Line		MI	0.08					
3	644	Channelizing Line		LF						
4	644	Stop Line		LF	36		48		24	
5	644	Crosswalk Line		LF			192		192	
	644	Transverse Line (Within Crosswalks)		LF						
6	644	Transverse Line, Yellow		LF						
	644	Transverse Line, White		LF						
7	644	School Symbol Marking, 120"		EA						
8	644	Lane Arrow		EA						
9	644	Lane Arrow, Combination		EA						
10	644	Word on Pavement, 96"		EA						
11	644	Dotted Line, 6"		LF						
12	644	Island Marking		LF						
	644	Crosswalk Line 24"		LF						
13	644	Bike Symbol		EA						
14	644	Chevrons		LF						

					Redmond Way		Camrose Ct			
					Ridenour Rd		Ridenour Rd			
					intersection		intersection			
					Striping		Striping		Striping	
Bid Item	Spec Item	Description		Unit	Quantity	Total	Quantity	Total	Quantity	Total
	644	Edge Line, White		MI						
	644	Edge Line, Yellow		MI						
1	644	Lane Line		LF						
2	644	Center Line		MI						
3	644	Channelizing Line		LF						
4	644	Stop Line		LF	12		12			
5	644	Crosswalk Line		LF	60		48			
	644	Transverse Line (Within Crosswalks)		LF						
6	644	Transverse Line, Yellow		LF						
	644	Transverse Line, White		LF						
7	644	School Symbol Marking, 120"		EA						
8	644	Lane Arrow		EA						
9	644	Lane Arrow, Combination		EA						
10	644	Word on Pavement, 96"		EA						
11	644	Dotted Line, 6"		LF						
12	644	Island Marking		LF						
	644	Crosswalk Line 24"		LF						
13	644	Bike Symbol		EA						
14	644	Chevrons		LF						

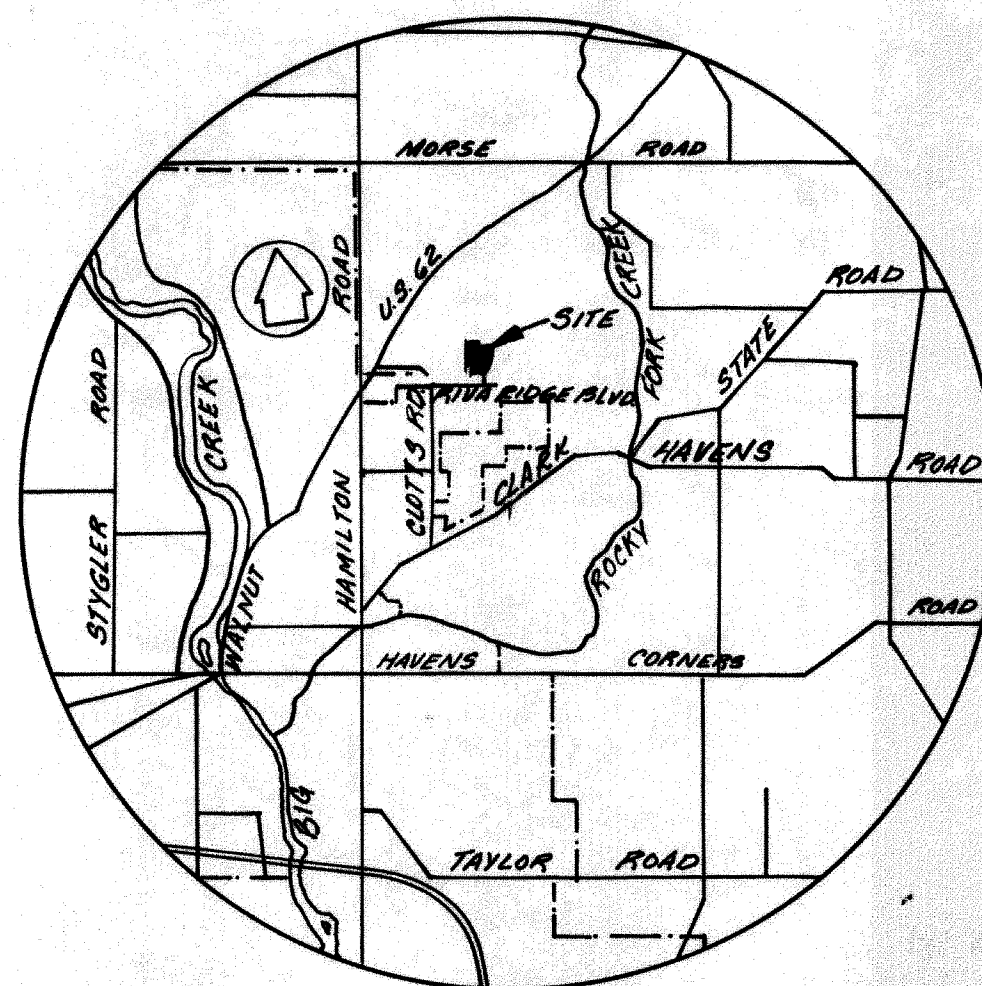

SITE MAP
NO SCALE

STREET, STORM, WATER, & STREET LIGHTING IMPROVEMENT NO. 266

SARATOGA ESTATES

NUMBER TWO PHASE I CITY OF GAHANNA, OHIO

Jerry B. Bower 6-21-79
Superintendent, Division of Water, City of Gahanna, Ohio Date

Robert J. Jurek 6-21-79
Superintendent, Division of Streets, City of Gahanna, Ohio Date

Benjamin A. Brunk 6-21-79
Auditor, City of Gahanna, Ohio Date

William B. Roshon 6-21-79
City Engineer, City of Gahanna, Ohio Date

Richard V. Warren, Jr. 6-21-79
Director of Public Service, City of Gahanna, Ohio Date


Charles A. Bennett 6-21-79
Mayor, City of Gahanna, Ohio Date

ESTIMATE OF QUANTITIES

ITEM	UNIT	QUANT.	DESCRIPTION
STREET			
203	C.Y.	3065	Excavation, Embankment, Clearing & Grubbing
305	S.Y.	6342	7" Portland Cement Concrete Base
402	C.Y.	220	1 1/4" Asphalt Concrete
404	C.Y.	220	1 1/4" Asphalt Concrete
407	Gals.	634	Tack Coat
605	L.F.	4109	4" Pipe Underdrain
609	L.F.	3080	Combined Curb & Gutter
609	L.F.	1069	Mountable Curb
STORM			
202	C.Y.	14	Removal of Existing Headwall
205	C.Y.	78	Removal of Existing Rock Channel Protection
202	L.F.	20	Removal of Existing 36" Pipe
601	C.Y.	12	Rock Channel Protection - Type B
602	C.Y.	1.1	Concrete Masonry
603	L.F.	132	18" Conduit, Type B, 706.01, C.I. III
603	L.F.	71	18" Conduit, Type B, 706.01, C.I. III
603	L.F.	9	18" Conduit, Type B, 706.01, C.I. III
603	L.F.	138	18" Conduit, Type E, 706.01, C.I. III
603	L.F.	57	18" Conduit, Type E, 706.01, C.I. III
603	L.F.	35	18" Conduit, Type B, 706.01, C.I. III
603	L.F.	15	24" Conduit, Type E, 706.02, C.I. III
603	L.F.	30	30" Conduit, Type B, 706.02, C.I. II
603	L.F.	305	30" Conduit, Type E, 706.02, C.I. II
603	L.F.	518	36" Conduit, Type E, 706.02, C.I. II
603	L.F.	30	42" Conduit, Type B, 706.02, C.I. II
603	L.F.	275	42" Conduit, Type E, 706.02, C.I. II
603	L.F.	33	48" Conduit, Type B, 706.02, C.I. II
603	L.F.	170	48" Conduit, Type E, 706.02, C.I. II
603	L.F.	83	36" x 60" Conduit, Type E, 706.04, C.I. II
604	Ea.	4	Type B Manhole
604	Ea.	2	2-3 Catch Basin
604	Ea.	2	2-4 Catch Basin
604	Ea.	10	42" Curb Inlet
604	Ea.	1	Type "A" Manhole
623	S.Y.	1214	Seeding and Mulching
WATER			
L.F.	871	6" Water Line	
L.F.	1341	8" Water Line	
Ea.	6	6" Gate Valves and Boxes (Including Hydrant Valve)	
Ea.	3	8" Gate Valves and Boxes	
Ea.	21	Short, 3/4" Water Service Tap, Complete	
Ea.	19	Long, 3/4" Water Service Tap, Complete	
Ea.	5	Fire Hydrants	

ELECTRICAL SYMBOLS

- Transformer
- Disconnect Fuse @ 35 amps.
- Underground Street Ltg. Wire
- Light Standard & Luminaire Fuse @ 4 amps.
- Street Crossing

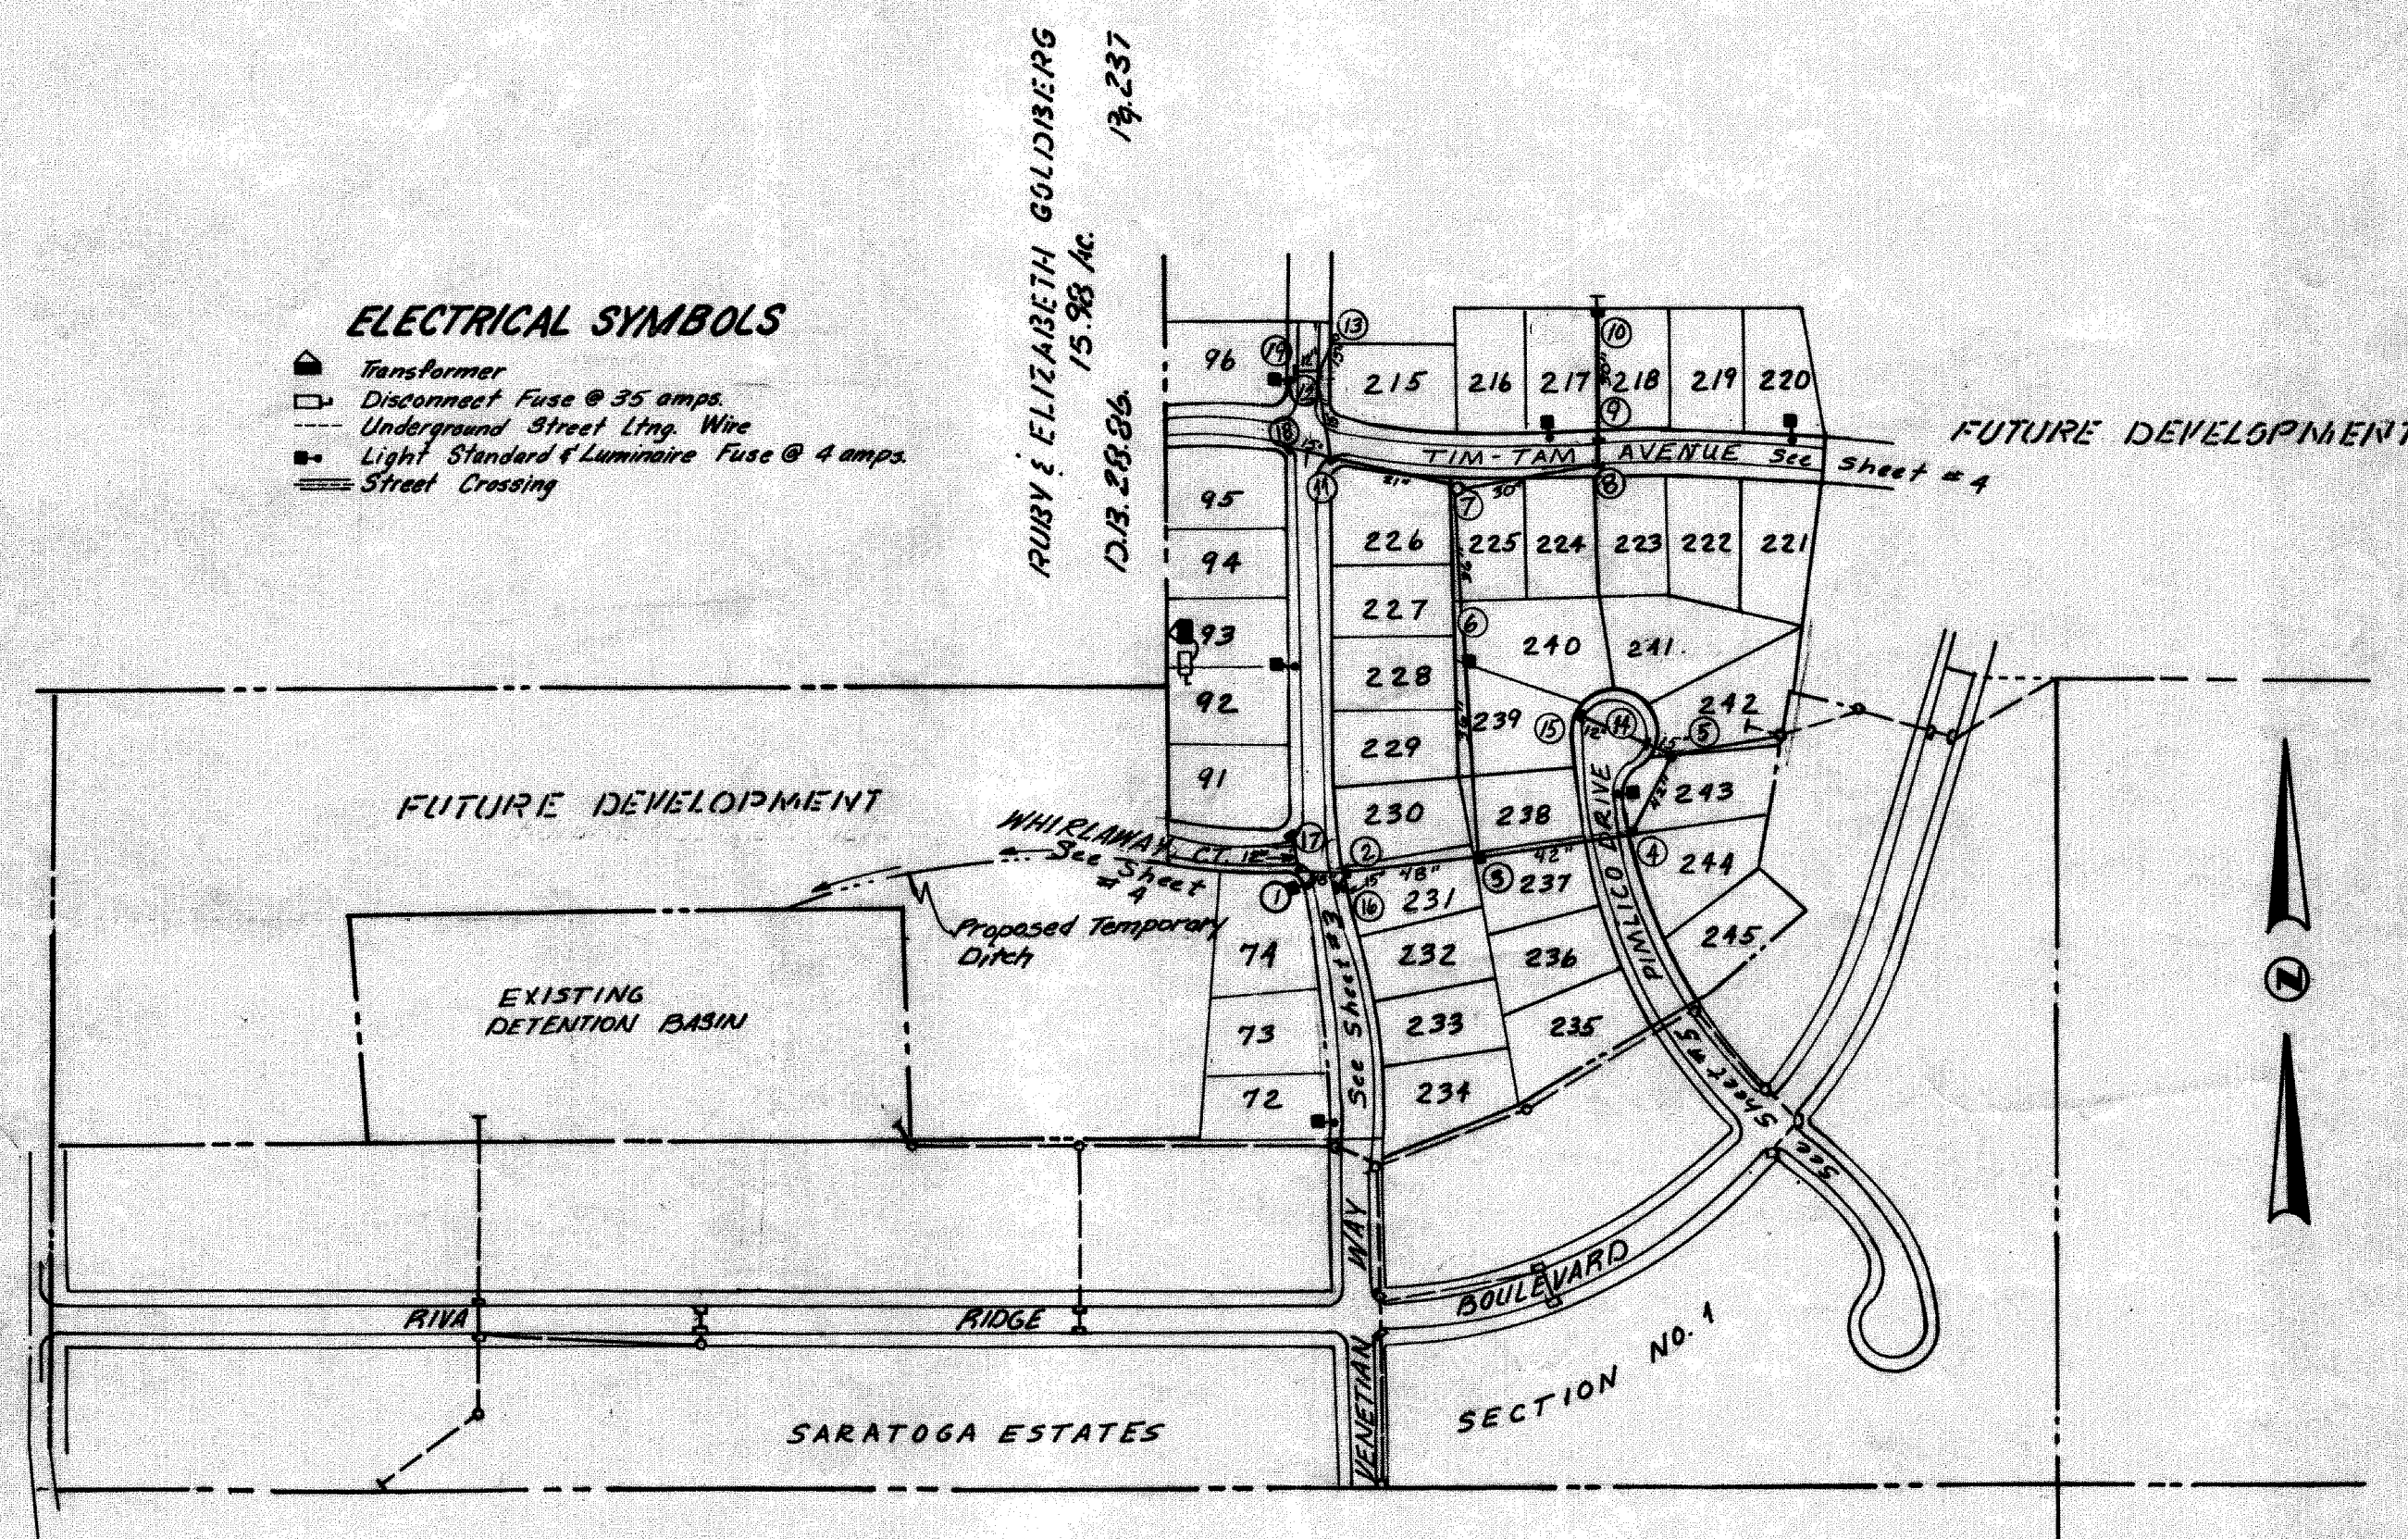

INDEX MAP
SCALE 1" = 200'

BENCH MARKS

Bench Mark No. 4: Top N.W. corner of curb inlet on East side of Pimlico Drive, 10.5' South of the beginning of Section Two. Elevation 918.21.

Bench Mark No. 5: Top W. bolt of fire hydrant on W. side of Riva Ridge Boulevard in Lot No. 31 of Saratoga Estates Section No. One. Elevation 925.76.

Prepared By

r. d. zande & associates, ltd.
consulting engineers
COURT HOUSE SQUARE, 501 SOUTH HIGH ST.
COLUMBUS, OHIO 43260

John Robert Long
Registered Engineer No. 36339

GENERAL NOTES

The requirements of the City of Gahanna, together with the Standard Specifications of the State of Ohio, Department of Transportation, including all Supplements thereto, in force on date of contract shall govern all materials and workmanship involved in the improvements shown on these plans except as such specifications are modified by the following specifications or by the construction details set forth herein.

All items of work called for on the plans for which no specific method of payment is provided shall be performed by the Contractor and the cost of same shall be included in the price bid for the various related items.

All field tile broken during excavation shall be replaced to original condition or connected to either the curb subdrain or to the storm sewer system as directed by the Engineer.

The Contractor shall dispose of all surplus street excavation on the project site where as directed by the Engineer.

Existing utilities are shown on the plans in accordance with available records. However it shall be the Contractor's responsibility, prior to construction, to determine in the field the actual location and elevation of all existing utilities whether shown on the plans or not.

Unless otherwise noted on the plans, all Storm Sewers shall be as hereafter specified: (1) All sizes of storm sewer located within or across proposed or existing pavement areas shall be Type B Conduit, 706.02 with Class B Bedding (2) Storm Sewer located outside pavement areas shall be Type E Conduit, 706.01 Class C Bedding for 15 inch and smaller, and shall be Type E Conduit, 706.02, Class C Bedding for 18 inch and larger. The following modifications to the State of Ohio Department of Transportation shall apply: (1) Type E Conduits shall have sealed joints. (2) Granular backfill material shall be clean uncrushed gravel grits, size No. 9 or No. 10, placed within limits shown on the plan. Granular backfill shall extend from the bottom of the trench to a plane 6 inches below the subgrade.

All Street lighting shall conform to the City of Gahanna standards.

All water pipe 4-inch or larger shall be either Ductile Iron, A.S.A. Class 21, or Asbestos Cement, Class 150. All bands, joint deflections and fittings shall be backed with concrete where and as directed. Where water mains or services cross proposed or existing streets, backfill shall be clean, uncrushed gravel grits, size No. 9 or No. 10, from right-of-way line, extended from the bottom of the trench to a plane 6 inches below the subgrade. The services may be jacked across the street in lieu of open cut and the use of grit backfill.


Curb boxes shall be located one-half foot from the property line, unless otherwise shown on the plans ordered by the Engineer and shall be protected by 2"x2" guard stakes extending 4 feet above grade. The Contractor shall obtain all necessary permits.

Excavation for temporary ditches to be included in the unit price bid for various storm sewer items.

The Contractor shall provide 2 roof drain openings in the curb for each lot. Each opening shall be located not more than 4 feet in from each lot line.

** On dead end water mains in cul-de-sacs, two 3/4" taps shall be installed within one foot of the end of the main and a third 3/4" tap shall be installed within two feet of the end of the main.

The Developer is committed to build an off-site eight (8") inch waterline to feed the waterlines for this and future sections from Clofts Road to the proposed 8" stub in Whirlaway Court and to build off-site 8" waterline in the extension of Riva Ridge Blvd. to connect with extended 8" waterline in Tim-Tam Avenue.

 

STREET, STORM, WATER, & STREET LIGHTING IMPROVEMENT NO. 266

SARATOGA ESTATES

NUMBER TWO PHASE I CITY OF GAHANNA, OHIO








ESTIMATE OF QUANTITIES			
ITEM	UNIT	QUANTITY	DESCRIPTION
STREET			
STORM			
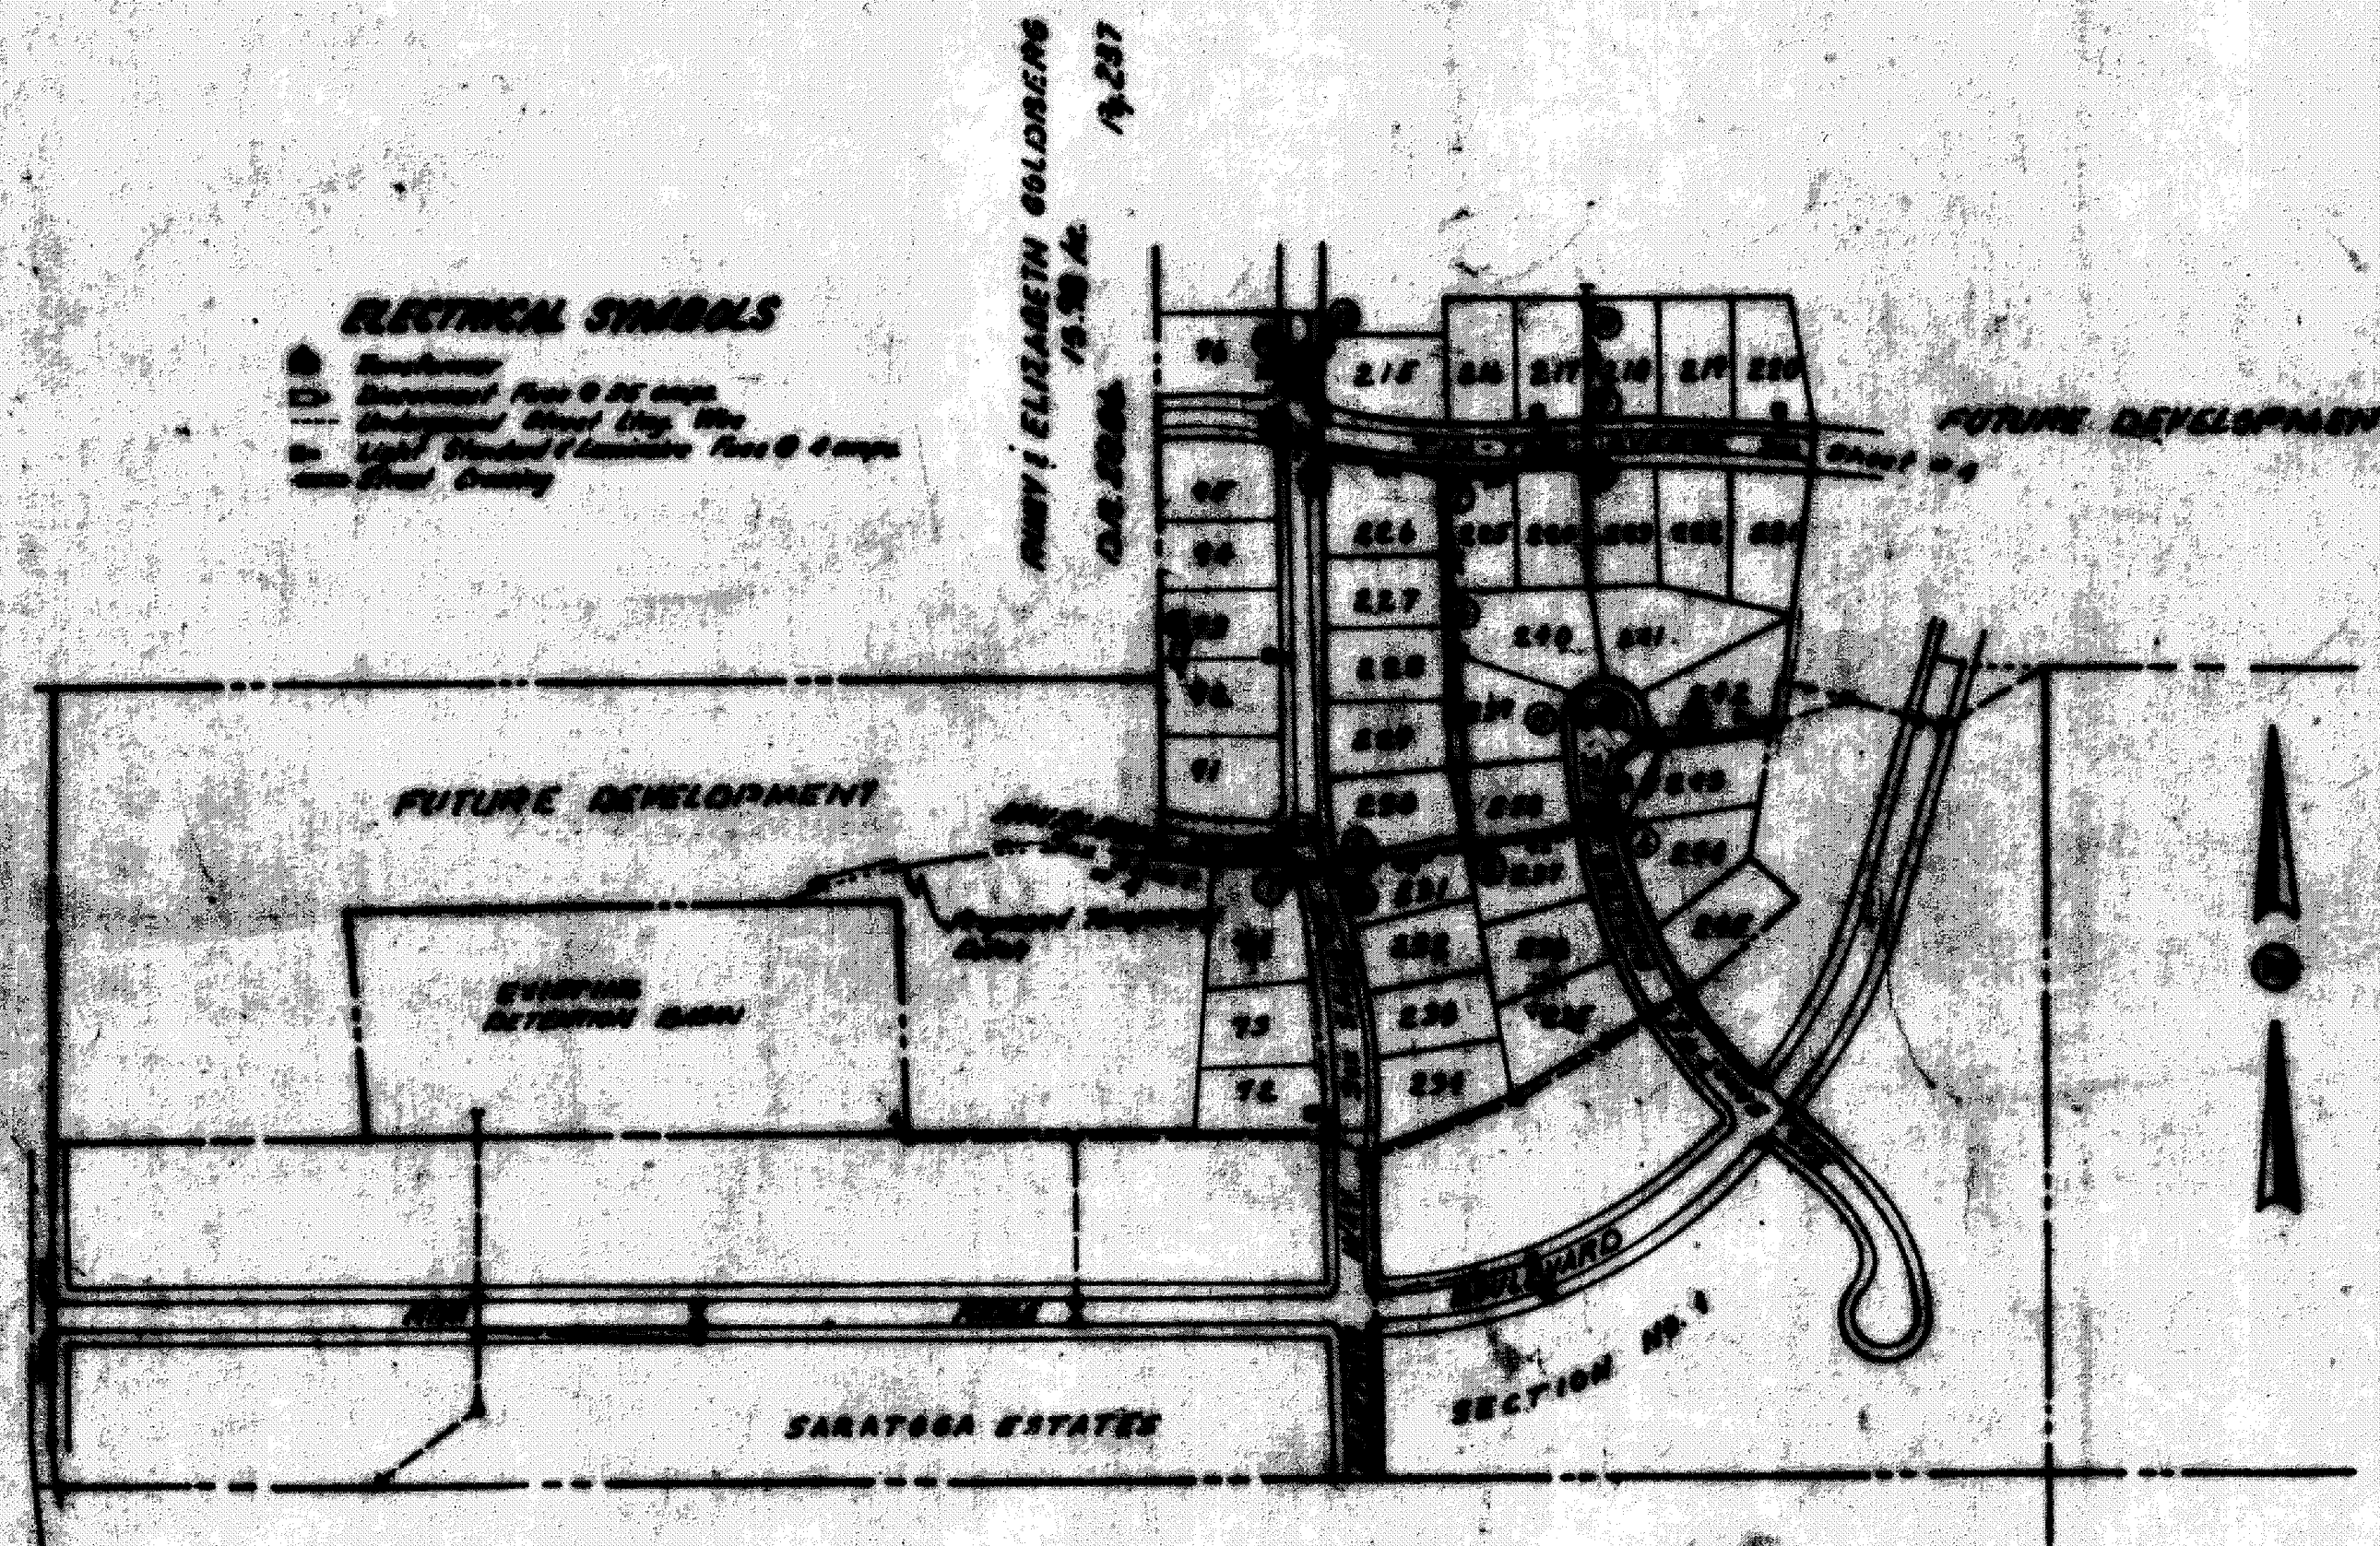

INDEX MAP
Scale 1"=200'

BENCH MARKS

Bench Mark No. 4. Top N.W. corner of curb inlet on East side of Pacific Drive, 105' South of the beginning of Section Two. Elevation 110.21.

Bench Mark No. 5. Top W. butt of fire hydrant on N. side of Elm Ridge Boulevard in lot No. 31 of Saratoga Estates Section No. One. Elevation 105.76.

Prepared By

T. & J. Smith & Associates, Inc.
Consulting Engineers
COURT HOUSE BUILDING, 100 NORTH MAIN ST.
COLUMBUS, OHIO 43260

John Robert Long
Registered Engineer No. 36339

GENERAL NOTES

The requirements of the City of Gahanna, together with the Standard Specifications of the State of Ohio, Department of Transportation, including all Amendments thereto, in force on date of contract shall govern all materials and workmanship involved in the improvements shown on these plans except as such specifications are modified by the following specifications or by the construction details set forth herein.

All items of work called for on the plans for which no specific method of payment is provided shall be performed by the Contractor and the cost of same shall be included in the price bid for the various related items.

All field tile broken during excavation shall be replaced to original condition or connected to either the curb subdrain or to the storm sewer system as directed by the Engineer.

The Contractor shall dispose of all surplus street excavation on the project site where as directed by the Engineer.

Existing utilities are shown on the plans in accordance with available records. However it shall be the Contractor's responsibility, prior to construction, to determine in the field the actual location and depths of all existing utilities whether shown on the plans or not.

Unless otherwise noted on the plans, all Storm Sewers shall be as hereafter specified: (1) All sizes of storm sewer located within or across proposed or existing pavement areas shall be Type B Concrete; (2) Storm Sewer located outside pavement areas shall be Type E Concrete; (3) Class C Building for 15 inch and smaller, and shall be Type E Concrete; (4) Class C Building for 18 inch and larger. The following modifications to the State of Ohio Department of Transportation shall apply: (5) Type E Concrete shall have sand joints. (6) Granular backfill material shall be clean unwashed gravel or sand, size No. 9 or No. 10, placed within limits shown on the plan. Granular backfill shall extend from the bottom of the trench to a plane 6 inches below the subgrade.

All street lighting shall conform to the City of Gahanna standards.

All water pipe 4 inch or larger shall be either Ductile Iron, A.S.A. Class 21, or Cast Iron, Class 20, for both main and service lines, and fittings shall be backed with concrete where and as directed. Where water main or service areas proposed or existing streets, backfill shall be clean, unwashed gravel or sand, size No. 9 or No. 10, from right-of-way line, extended from the bottom of the trench to a plane 6 inches below the subgrade. The services may be jacked across the street in lieu of open cut and the use of grit backfill.


Curb boxes shall be located one-half foot from the property line unless otherwise shown on the plans ordered by the Engineer and shall be protected by 2"x4" guard stakes extending 4 feet above grade. The Contractor shall obtain all necessary permits.

Excavation for temporary ditches to be included in the unit price bid for various storm sewer items.

The Contractor shall provide 2 roof drain openings in the curb for each lot. Each opening shall be located not more than 4 feet in from each lot line.

On each end and water mains in cut-to-secs, two 94" taps shall be installed within one foot of the end of the main and a third 94" tap shall be installed within two feet of the end of the main.



The Developer is committed to build an off-site eight (8) inch waterline to feed the waterline for this and future sections from Cliff's Road to the proposed 8" stub in Whirlaway Court and to build off-site 8" waterline in the extension of Elm Ridge Blvd to connect with extended 8" waterline in Ten-Ten Avenue.

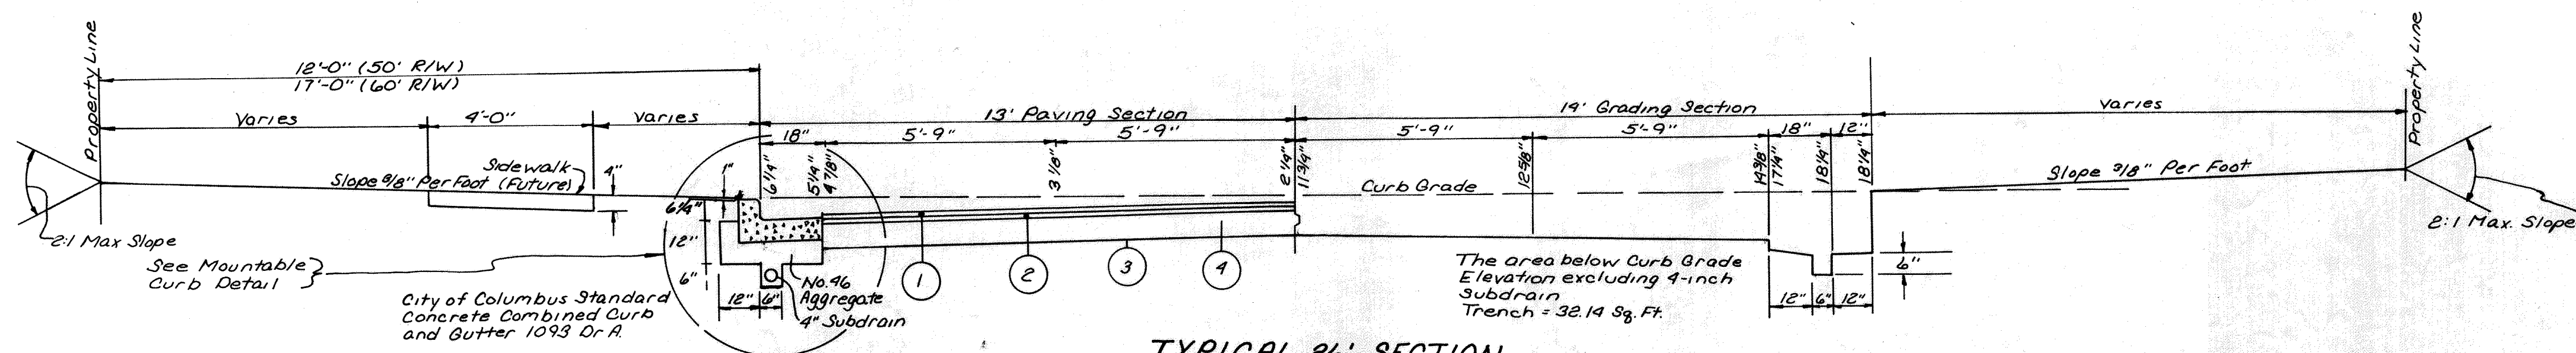


- 1 1 1/4" Hot-mixed, Hot-laid Asphalt Concrete, Item 404 (85-100). *
- 2 1 1/4" Hot-mixed, Hot-laid Asphalt Concrete, Item 402 (85-100).
- 3 Bituminous Tack Coat, Item 407 Bituminous Material 707.02 RC-70 or RC-250 applied 0.1 Gal per Sq. Yd. and cover consisting of crushed gravel or limestone size No. 9.
- 4 7" Portland Cement Concrete Base, Item 305**

* Modification of State Highway Specifications Asphalt Concrete shall contain all crushed aggregate.


** Shall conform to City of Columbus Construction and Material Specification Item 306. The concrete shall contain 4.1 bags of cement per cubic yard, Modified as follows: 5% ± 1% air entrainment. The use of an approved single beam vibrating screed will be required.

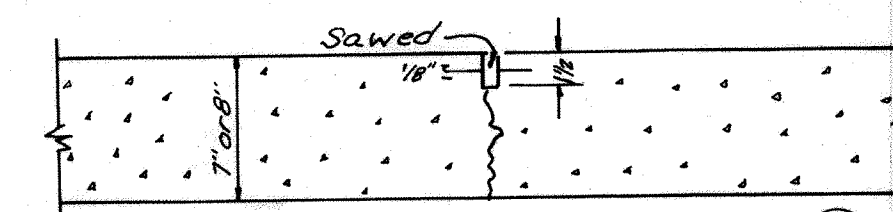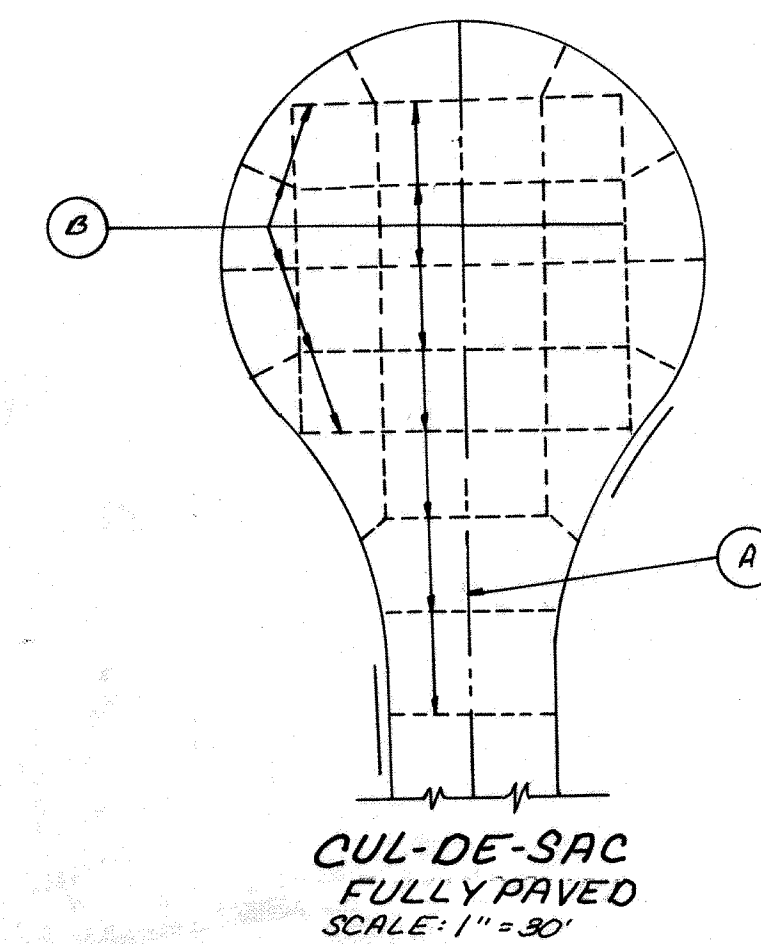

Maximum spacing of Sawed Joints shall be 20'.

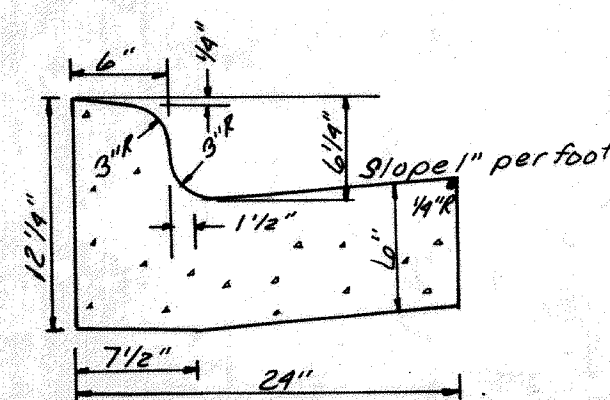


COMBINATION CURB & BUTTER

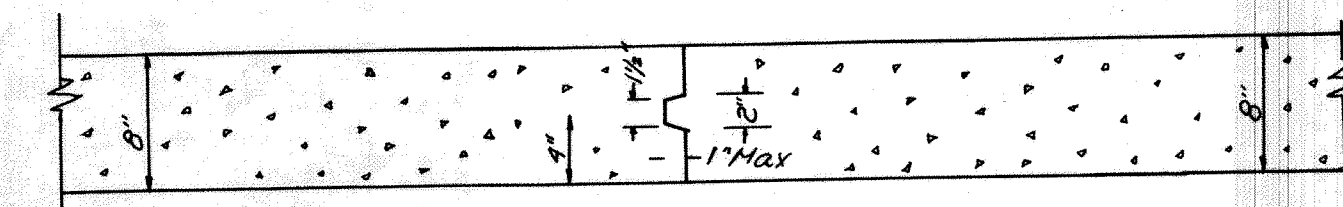

JOINT A & C

THREE-WAY INTERSECTION

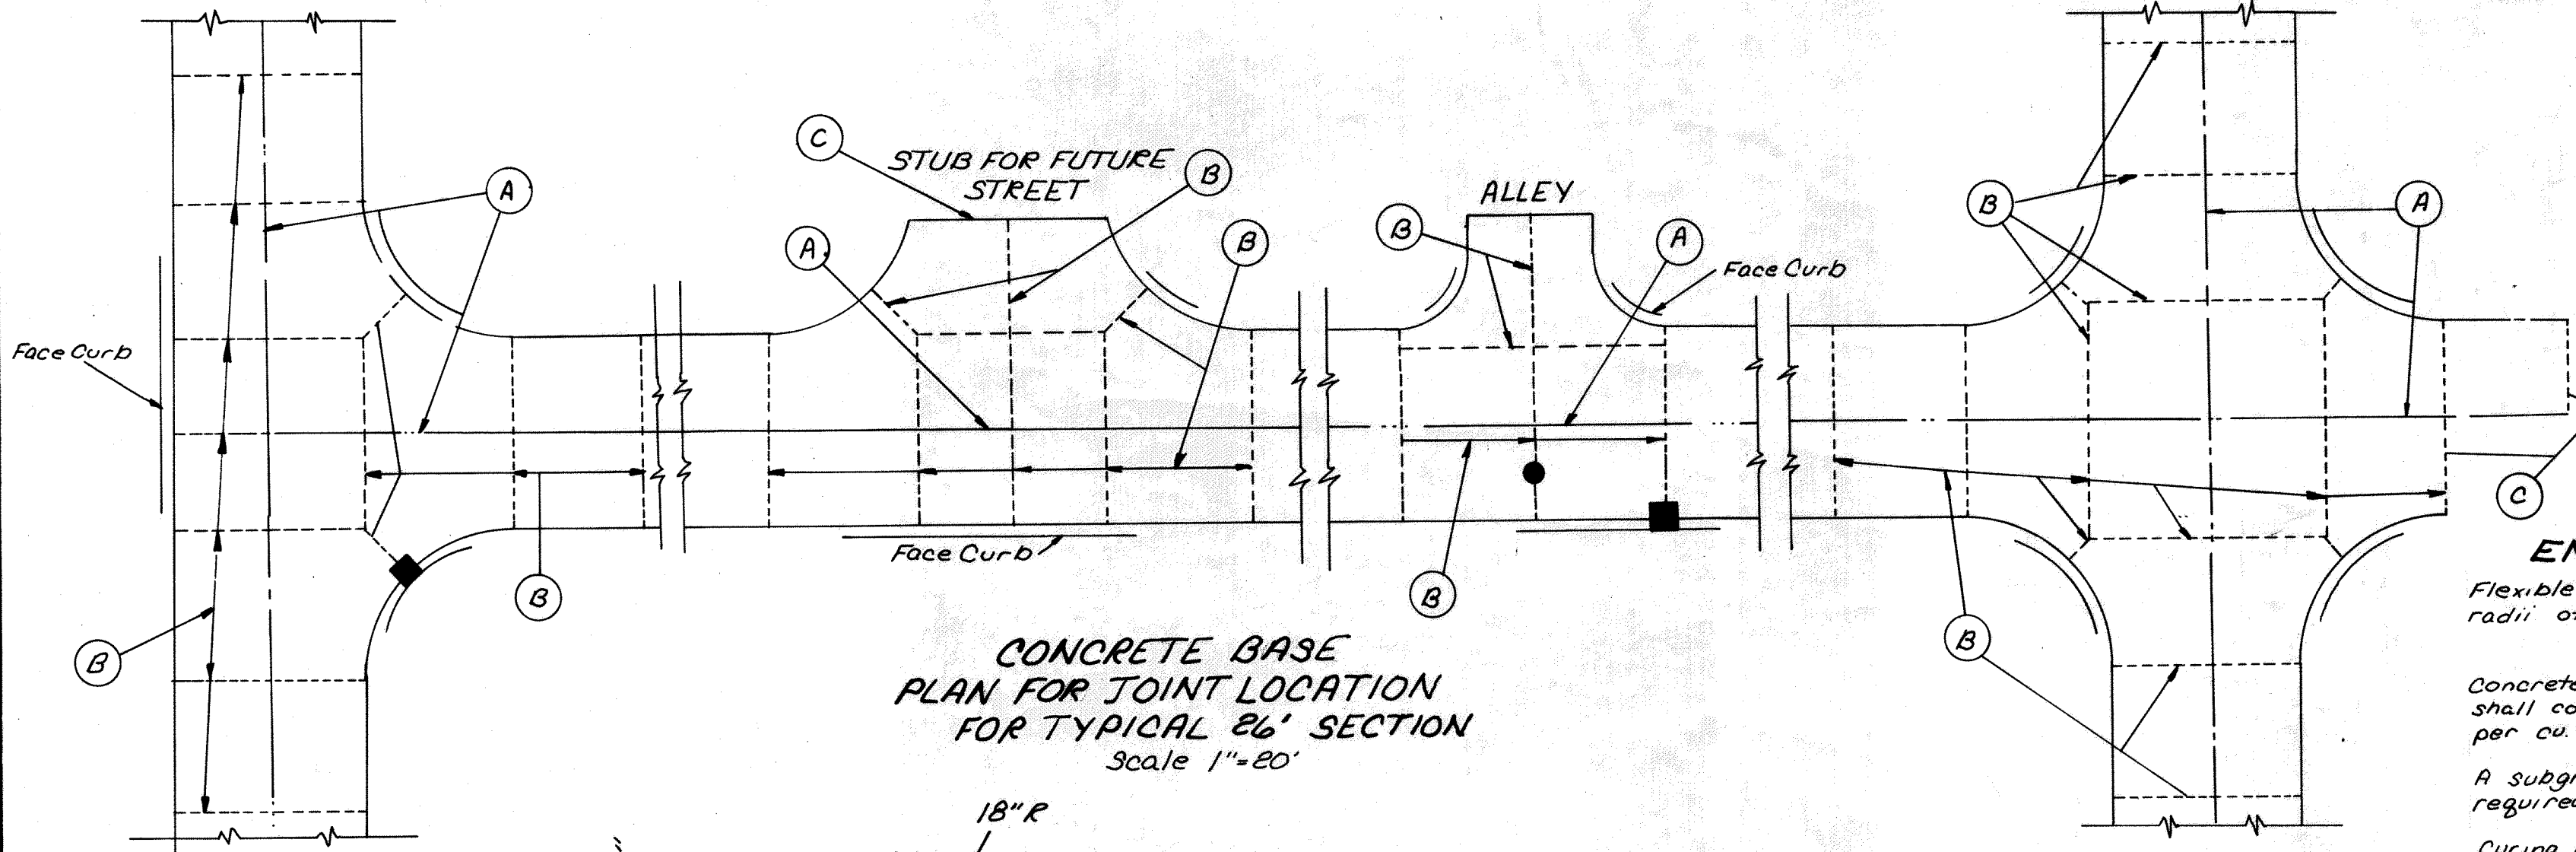

CONCRETE BASE
PLAN FOR JOINT LOCATION
FOR TYPICAL 26' SECTION
Scale 1" = 20'

FOUR-WAY INTERSECTION

END OF DAY'S WORK

Flexible forms shall be used on E radii of 200' or less

Concrete for Curb and Butter, Sidewalks and Drive Ramps shall conform to Item 499 Class C, 6.3 bags of cement per cu. yd. Modified as follows: Air entrainment to be 6% ± 1%

A subgrade planer or an automatic subgrader will not be required.

Curing material shall conform 705.07, Type 2, and shall be applied with a motor driven pump sprayer.


All item numbers are in accordance with the Ohio Department of Highways or City of Columbus Construction and Material Specifications.

When the pavement design shown on the typical sections is not adequate for contemplated heavier load requirements, the proposed street sections shall be designed in accordance and agreement with the City Engineer.

Sidewalk location shall be designed by the City Engineer.


Two or more curb openings for each lot shall be provided for downspout drains at the time of the permanent construction. Cost to be included in the price bid for Item 409. All curbs shall be sawed for downspout placement after the permanent construction is completed. Minimum curb cut shall be one foot.

In the event excavation for the street is from 0" to 6" below that called for on the plans, The Contractor shall replace this excess material with compacted 46 D crushed aggregate as directed and at no extra cost to the owner.

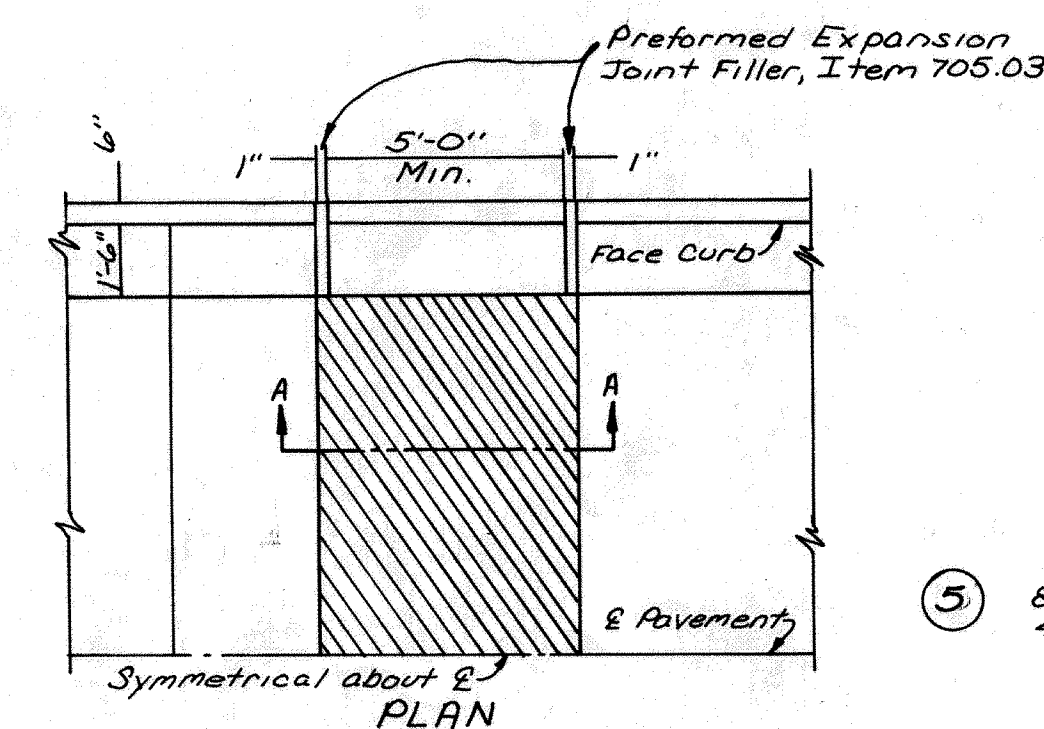

5 8" Bituminous Aggregate Base using 404 (85-100) comp.

DETAIL OF EXPANSION JOINT
Expansion Joints shall be constructed where shown on the plans. The Bituminous Aggregate Base shall be paid for at the price bid per cubic yard for Item 404 Asphalt Concrete.

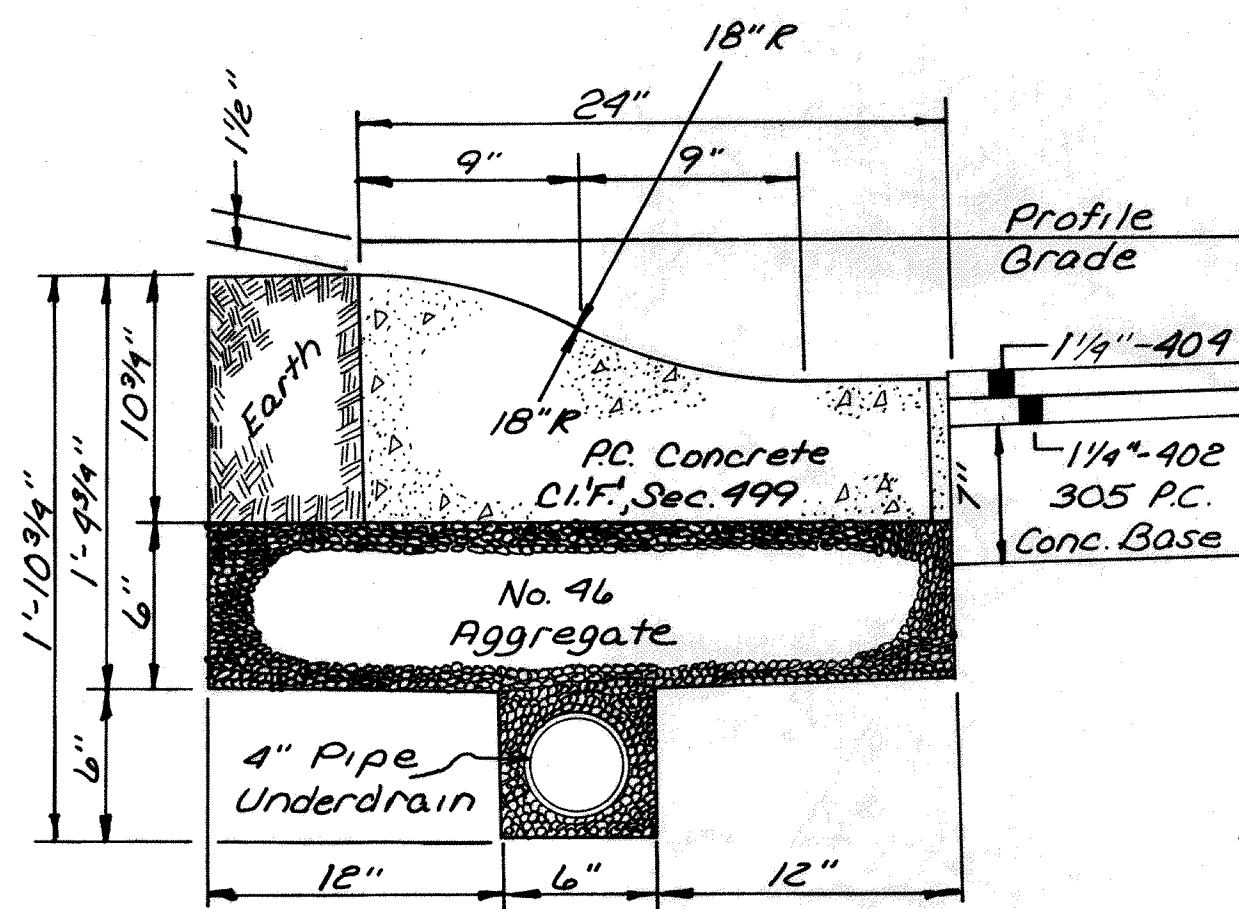

26' MOUNTABLE
CURB



Note: The transition from standard curb to mountable curb is to be accomplished within the last ten feet of the return


* PIMLICO DRIVE
WHIRLAWAY COURT

CITY OF GAHANNA, OHIO
STREET STORM AND WATER
IMPROVEMENTS NO.
SARATOGA ESTATES
SECTION 2 PHASE I

DETAIL SHEET

r. d. zande & associates, ltd
consulting engineer
COURT HOUSE SQUARE, 543 SOUTH HIGH
COLUMBUS, OHIO 43215

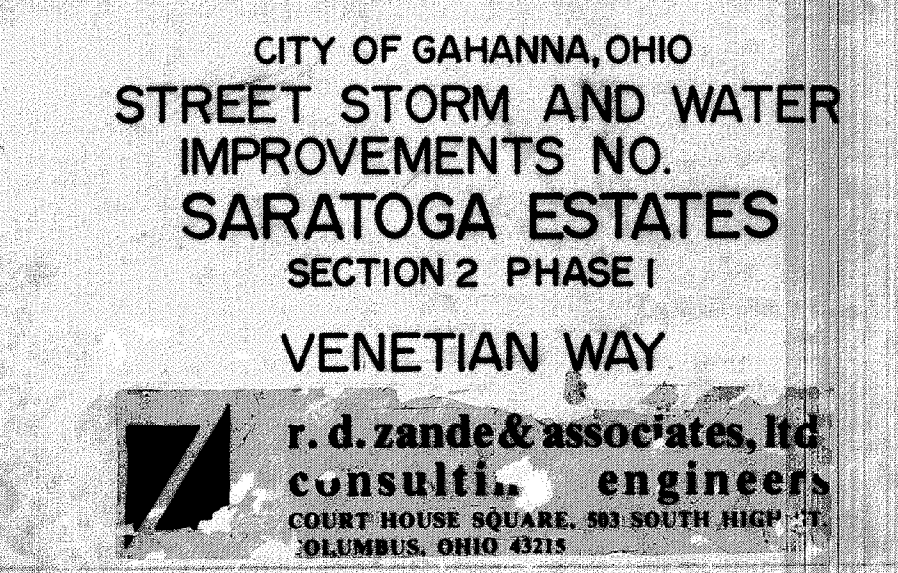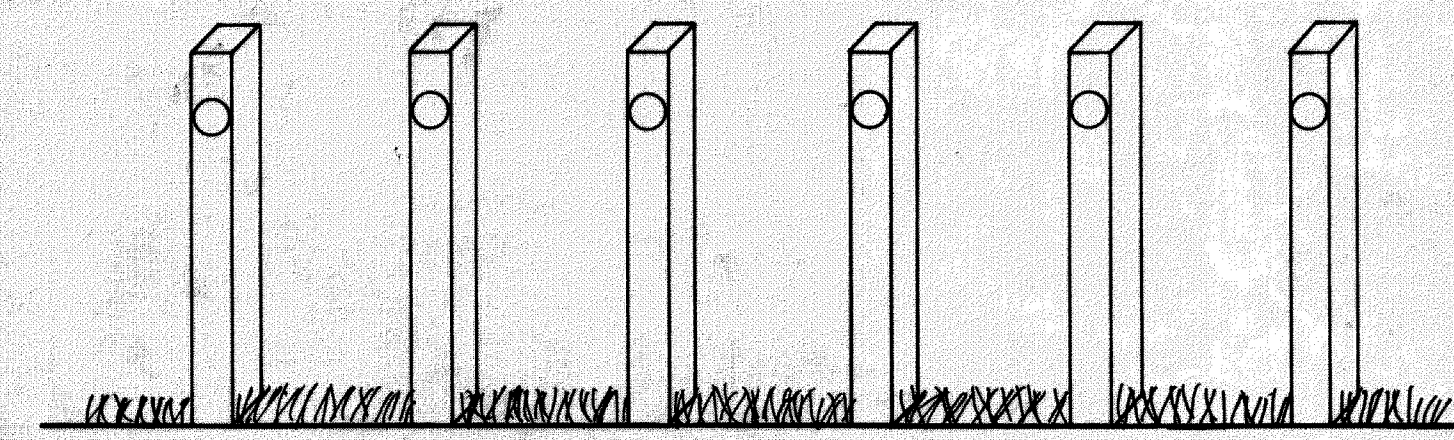


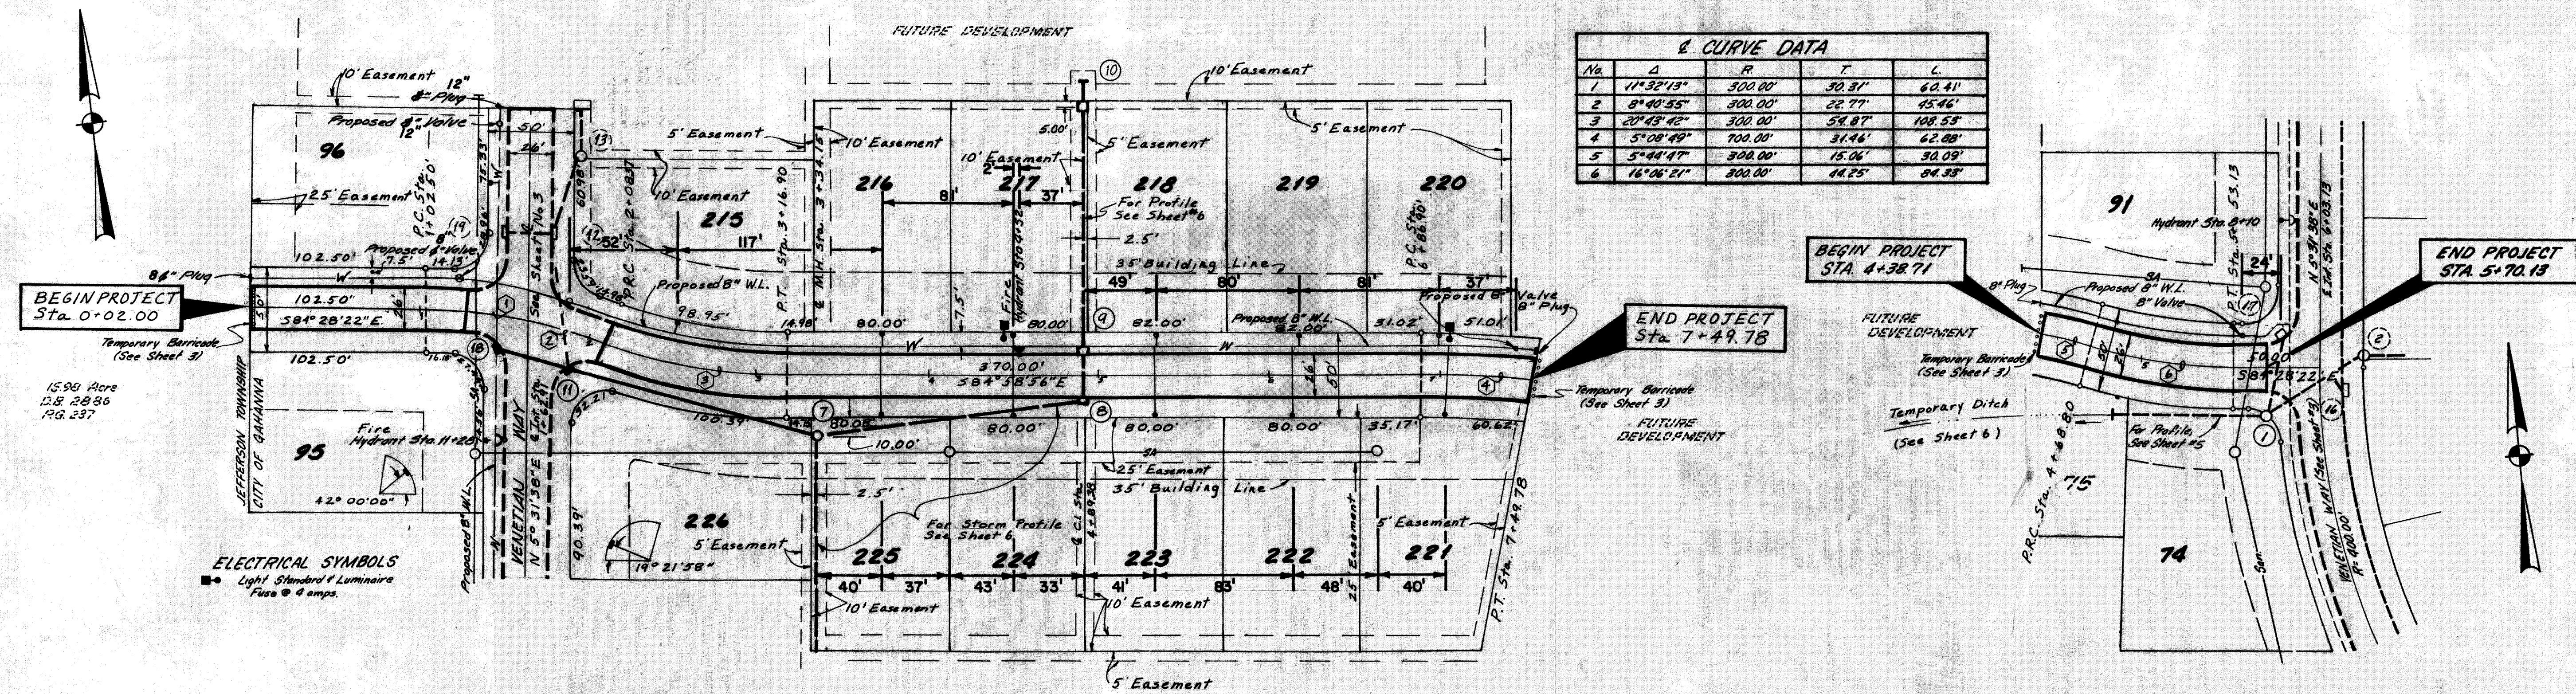


CURVE DATA				
No.	Δ	R	T	L
1	11°32'13"	300.00'	30.31'	60.41'
2	8°40'55"	300.00'	22.77'	45.46'
3	20°45'42"	300.00'	54.81'	108.55'
4	5°08'49"	700.00'	31.46'	62.88'
5	5°44'47"	300.00'	15.06'	30.09'
6	16°06'21"	300.00'	44.25'	88.33'


ELECTRICAL SYMBOLS
Light Standard Luminaire
Fuse @ 4 amps.

TIM-TAM AVENUE
Scale: Horiz. 1"=50'
Vert. 1"=10'




WHIRLAWAY COURT
Scale: Horiz. 1"=50'
Vert. 1"=10'

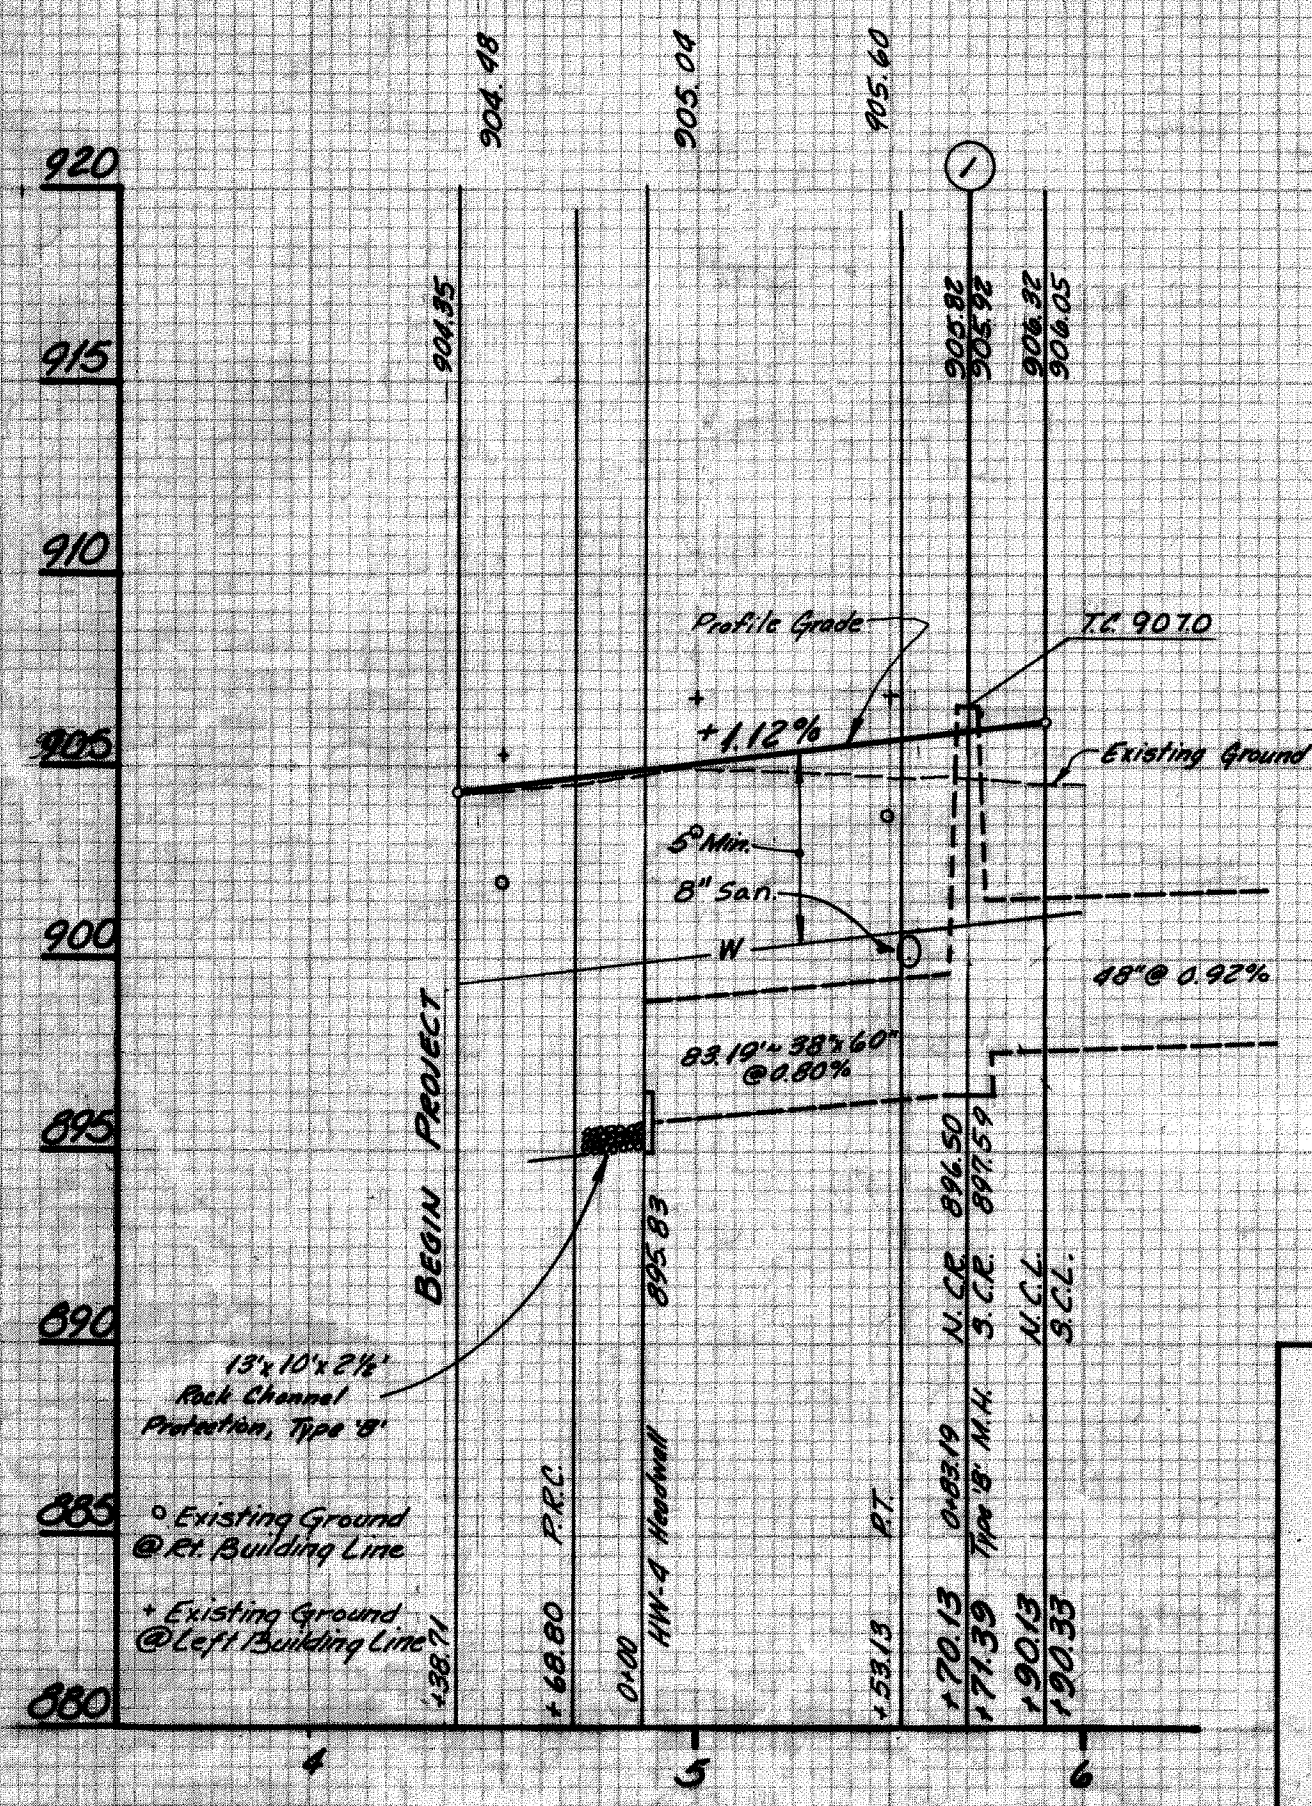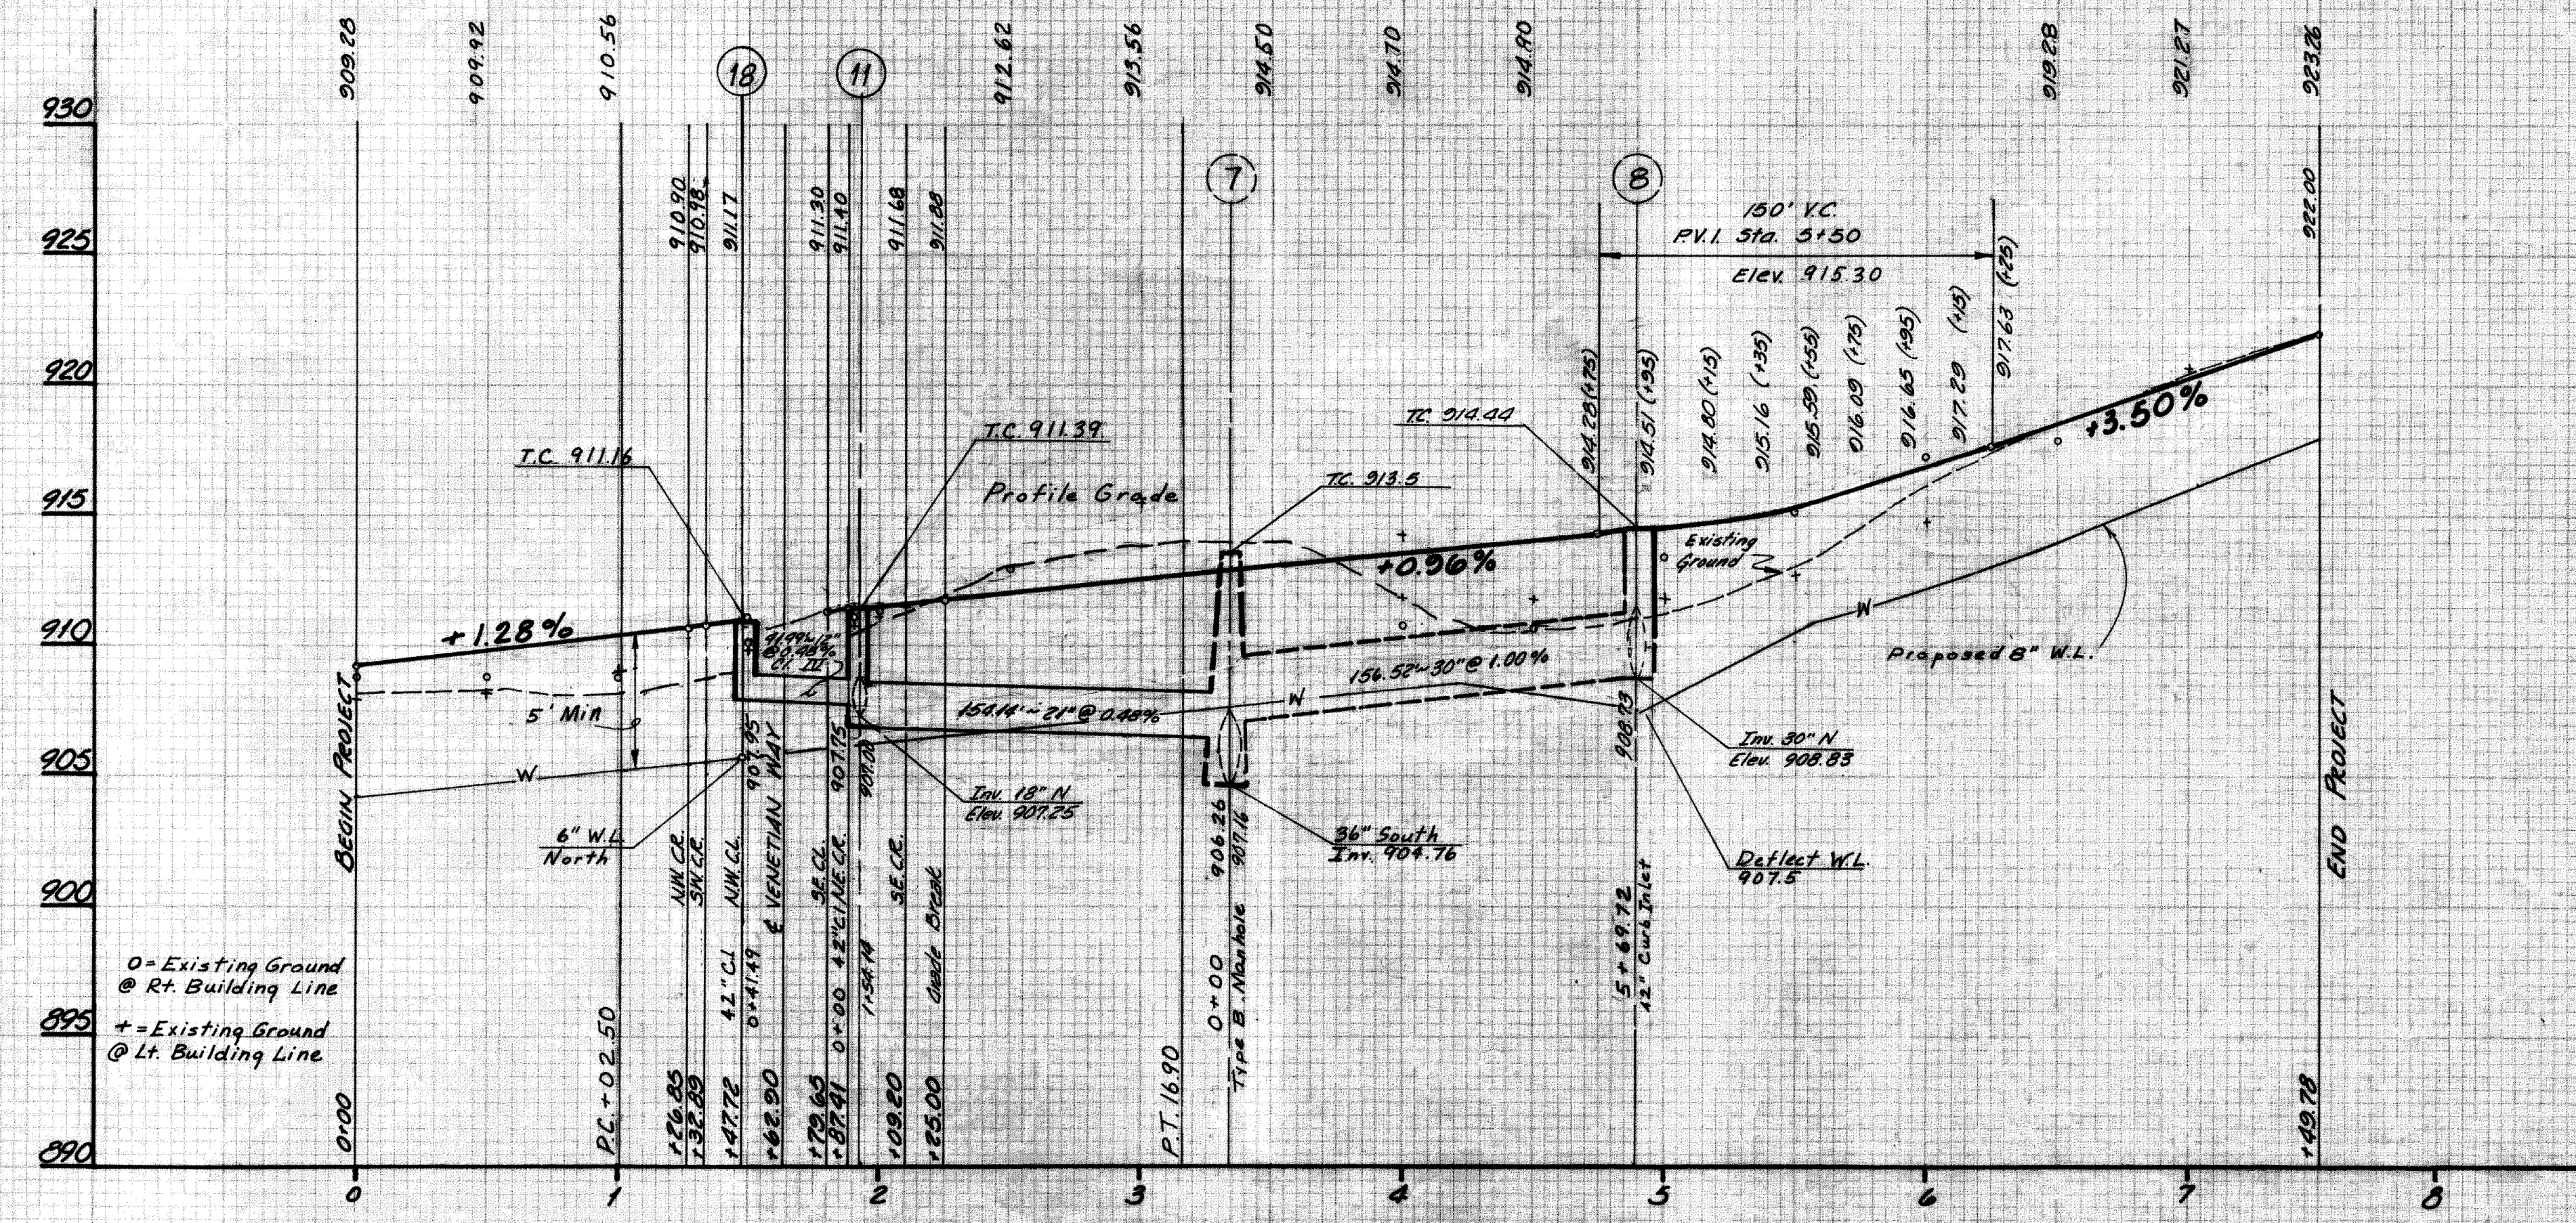






CITY OF GAHANNA, OHIO
STREET STORM AND WATER
IMPROVEMENTS NO.
SARATOGA ESTATES
SECTION 2 PHASE I
TIM-TAM AVENUE
WHIRLAWAY COURT
r. d. zar & associates, ltd.
consulting engineers
COURT HOUSE SQUARE, 563 SOUTH HIC ST.
COLUMBUS, OHIO 43215

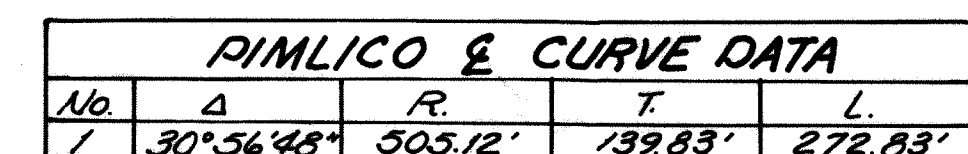

No.	Δ	R	T	L

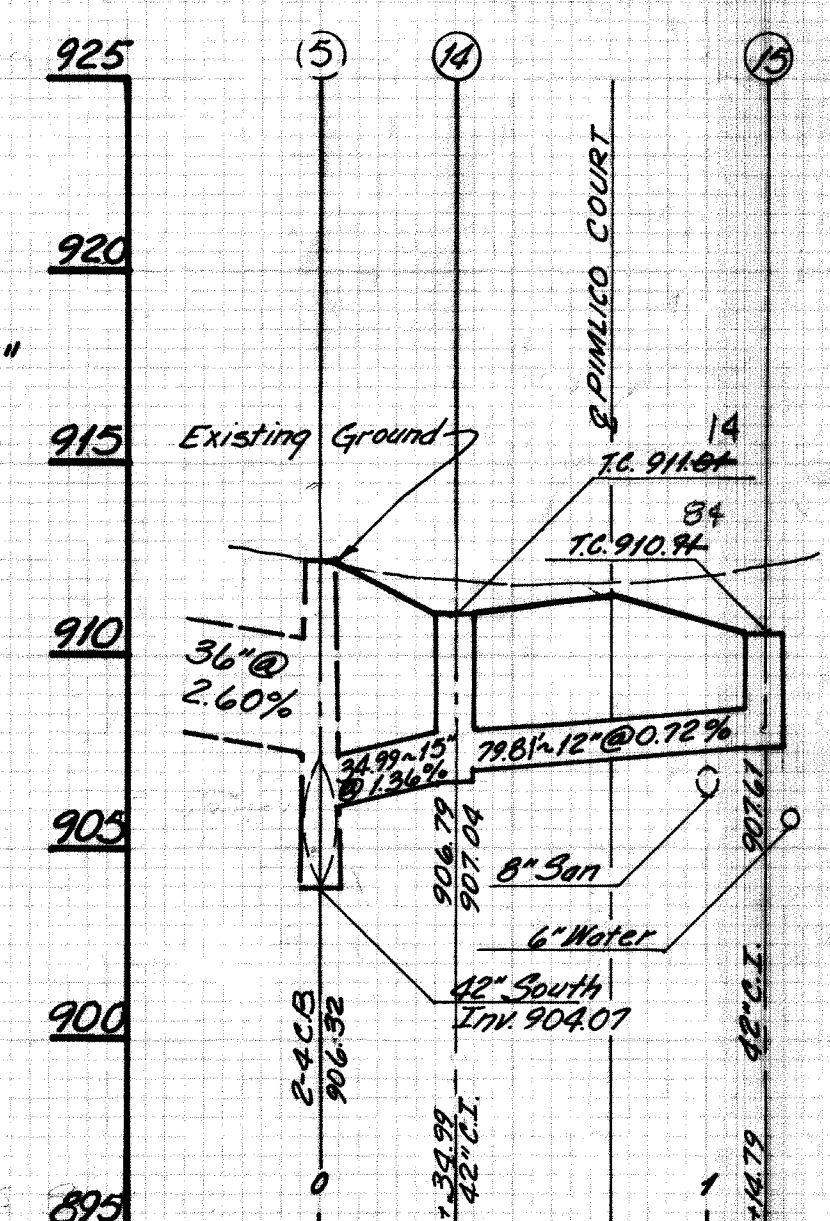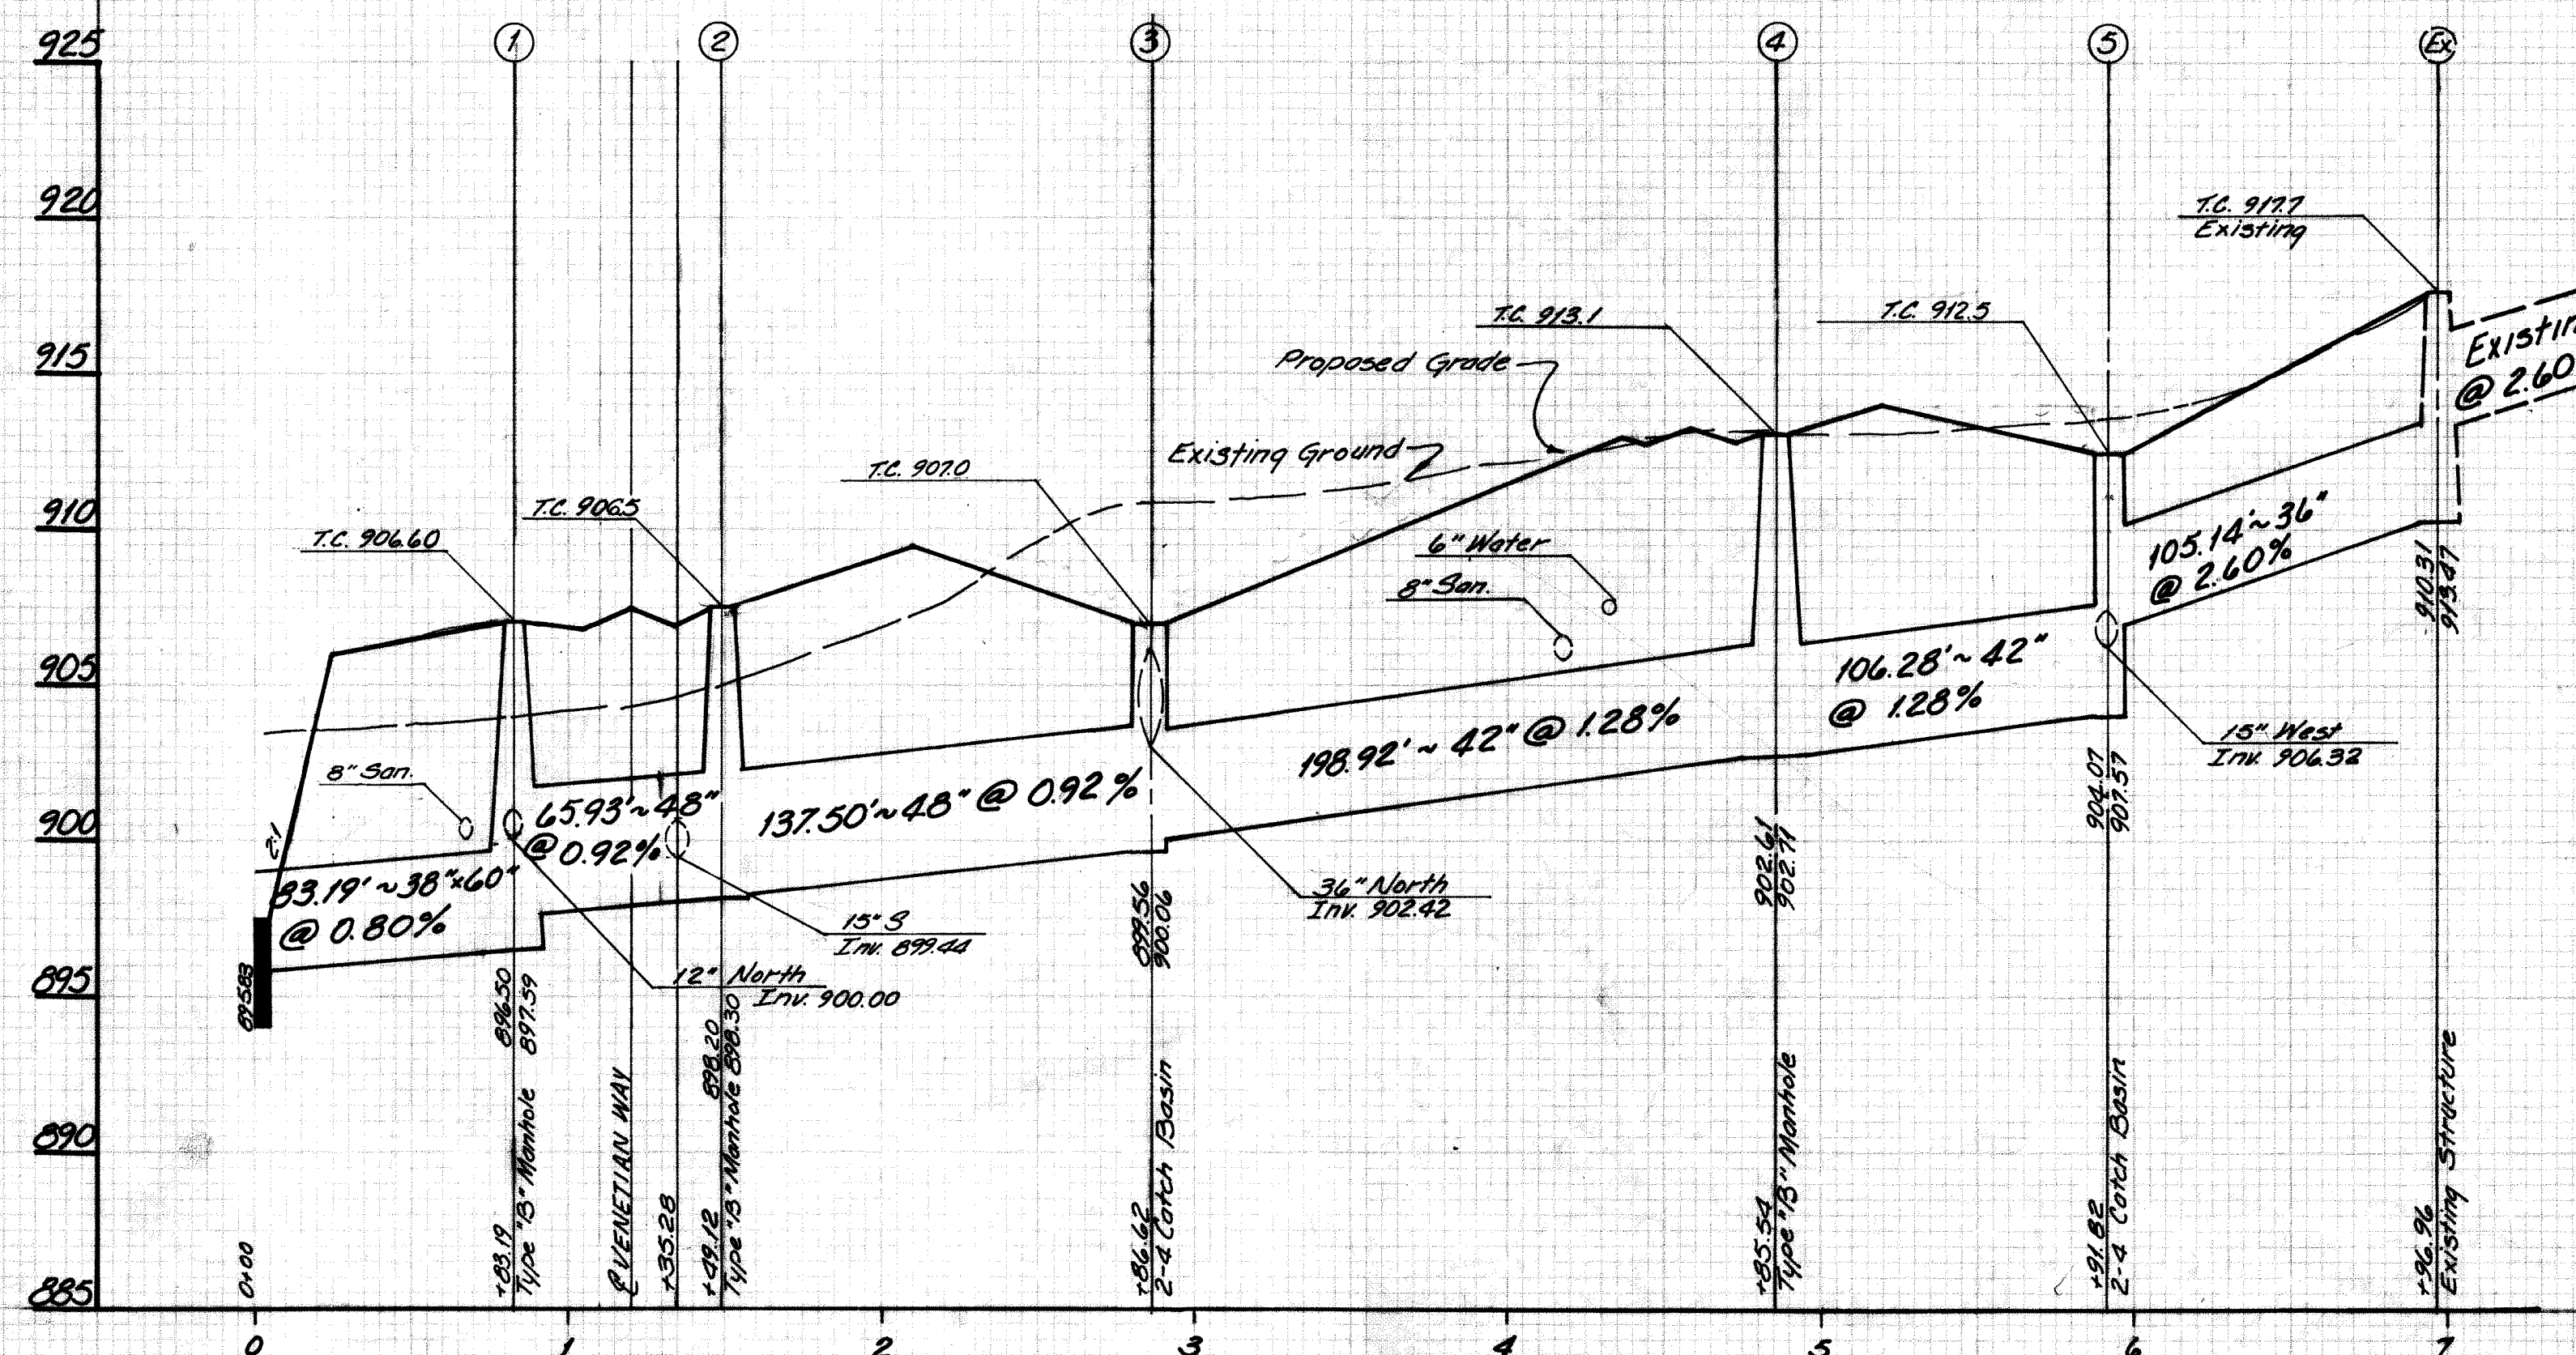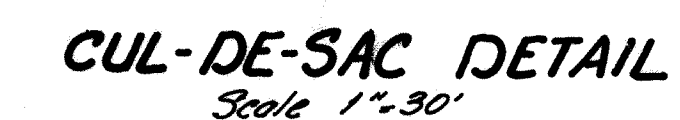

r. d. zande & associates, ltd.
consulting engineers
 COURT HOUSE SQUARE, 503 SOUTH HIGH ST.
 COLUMBUS, OHIO 315

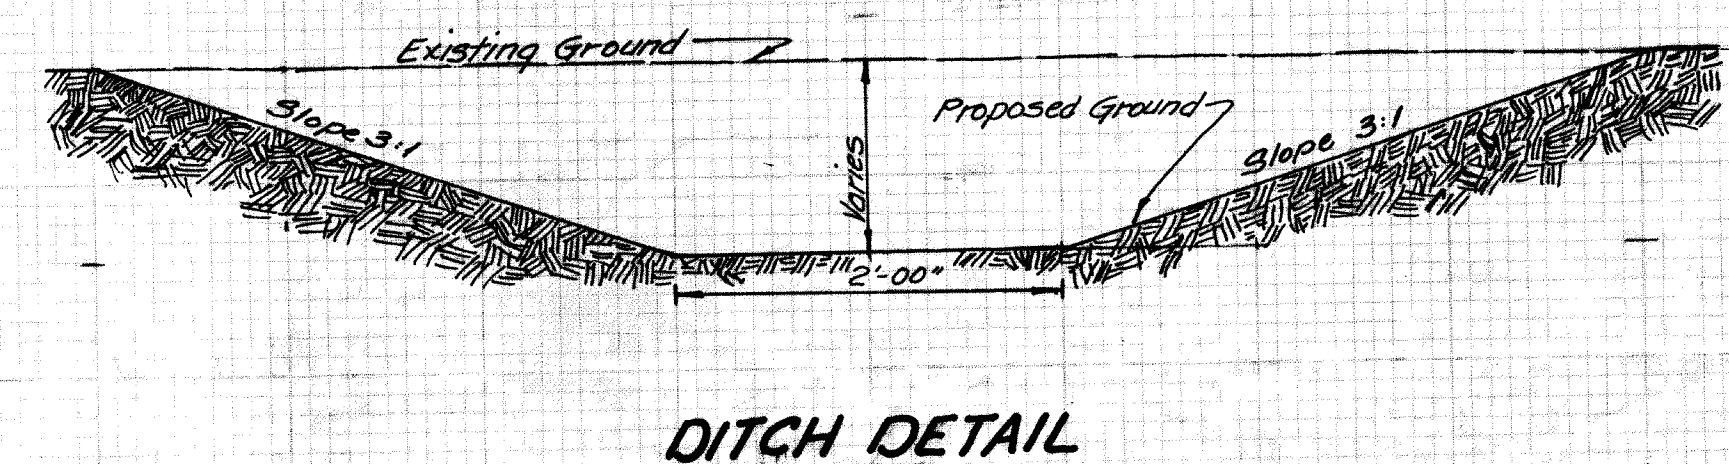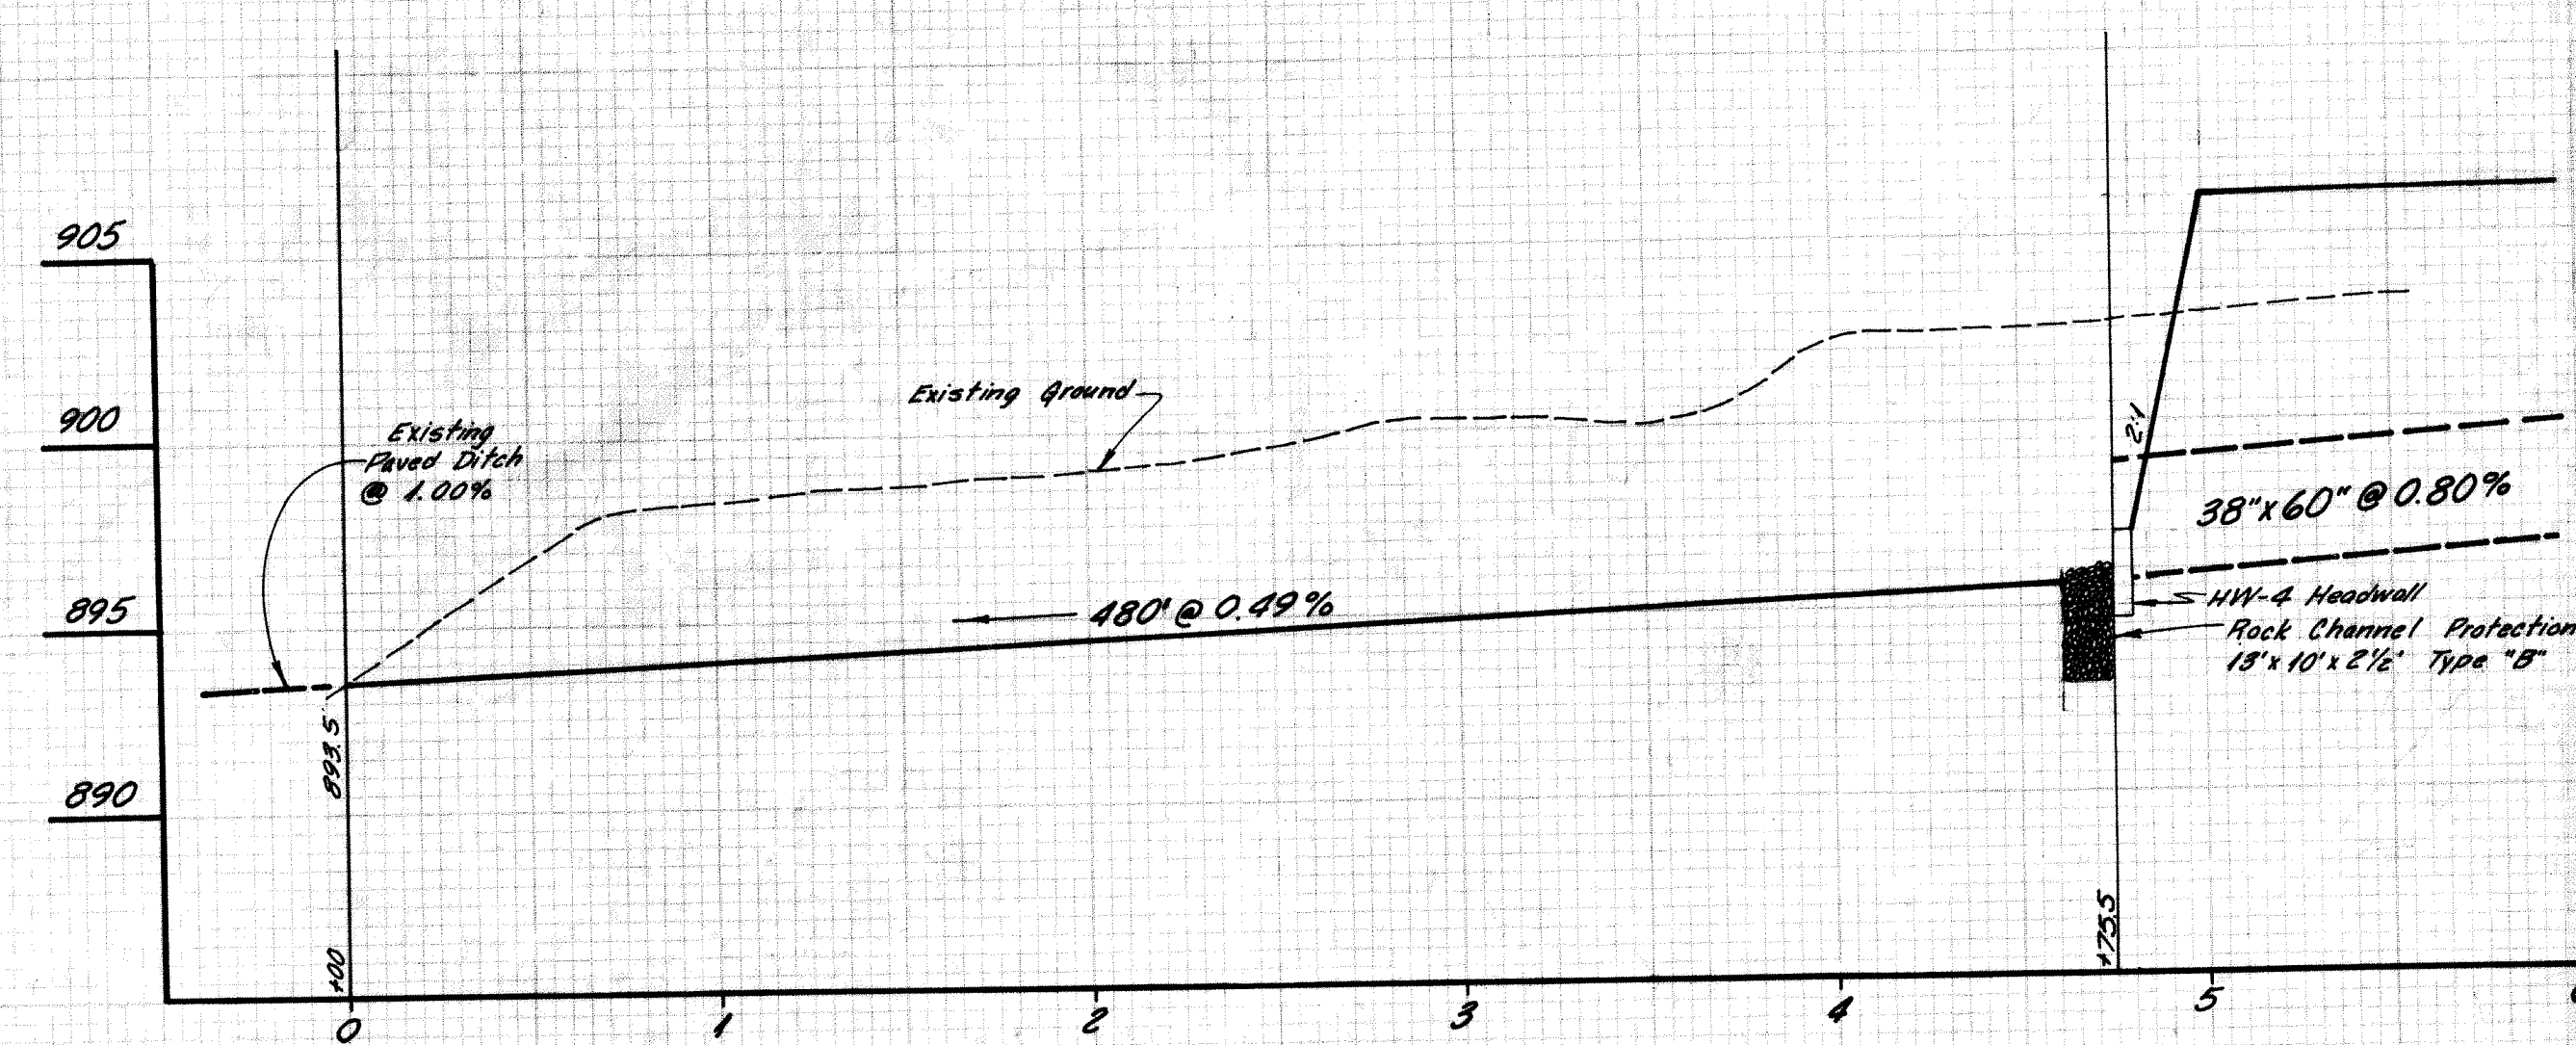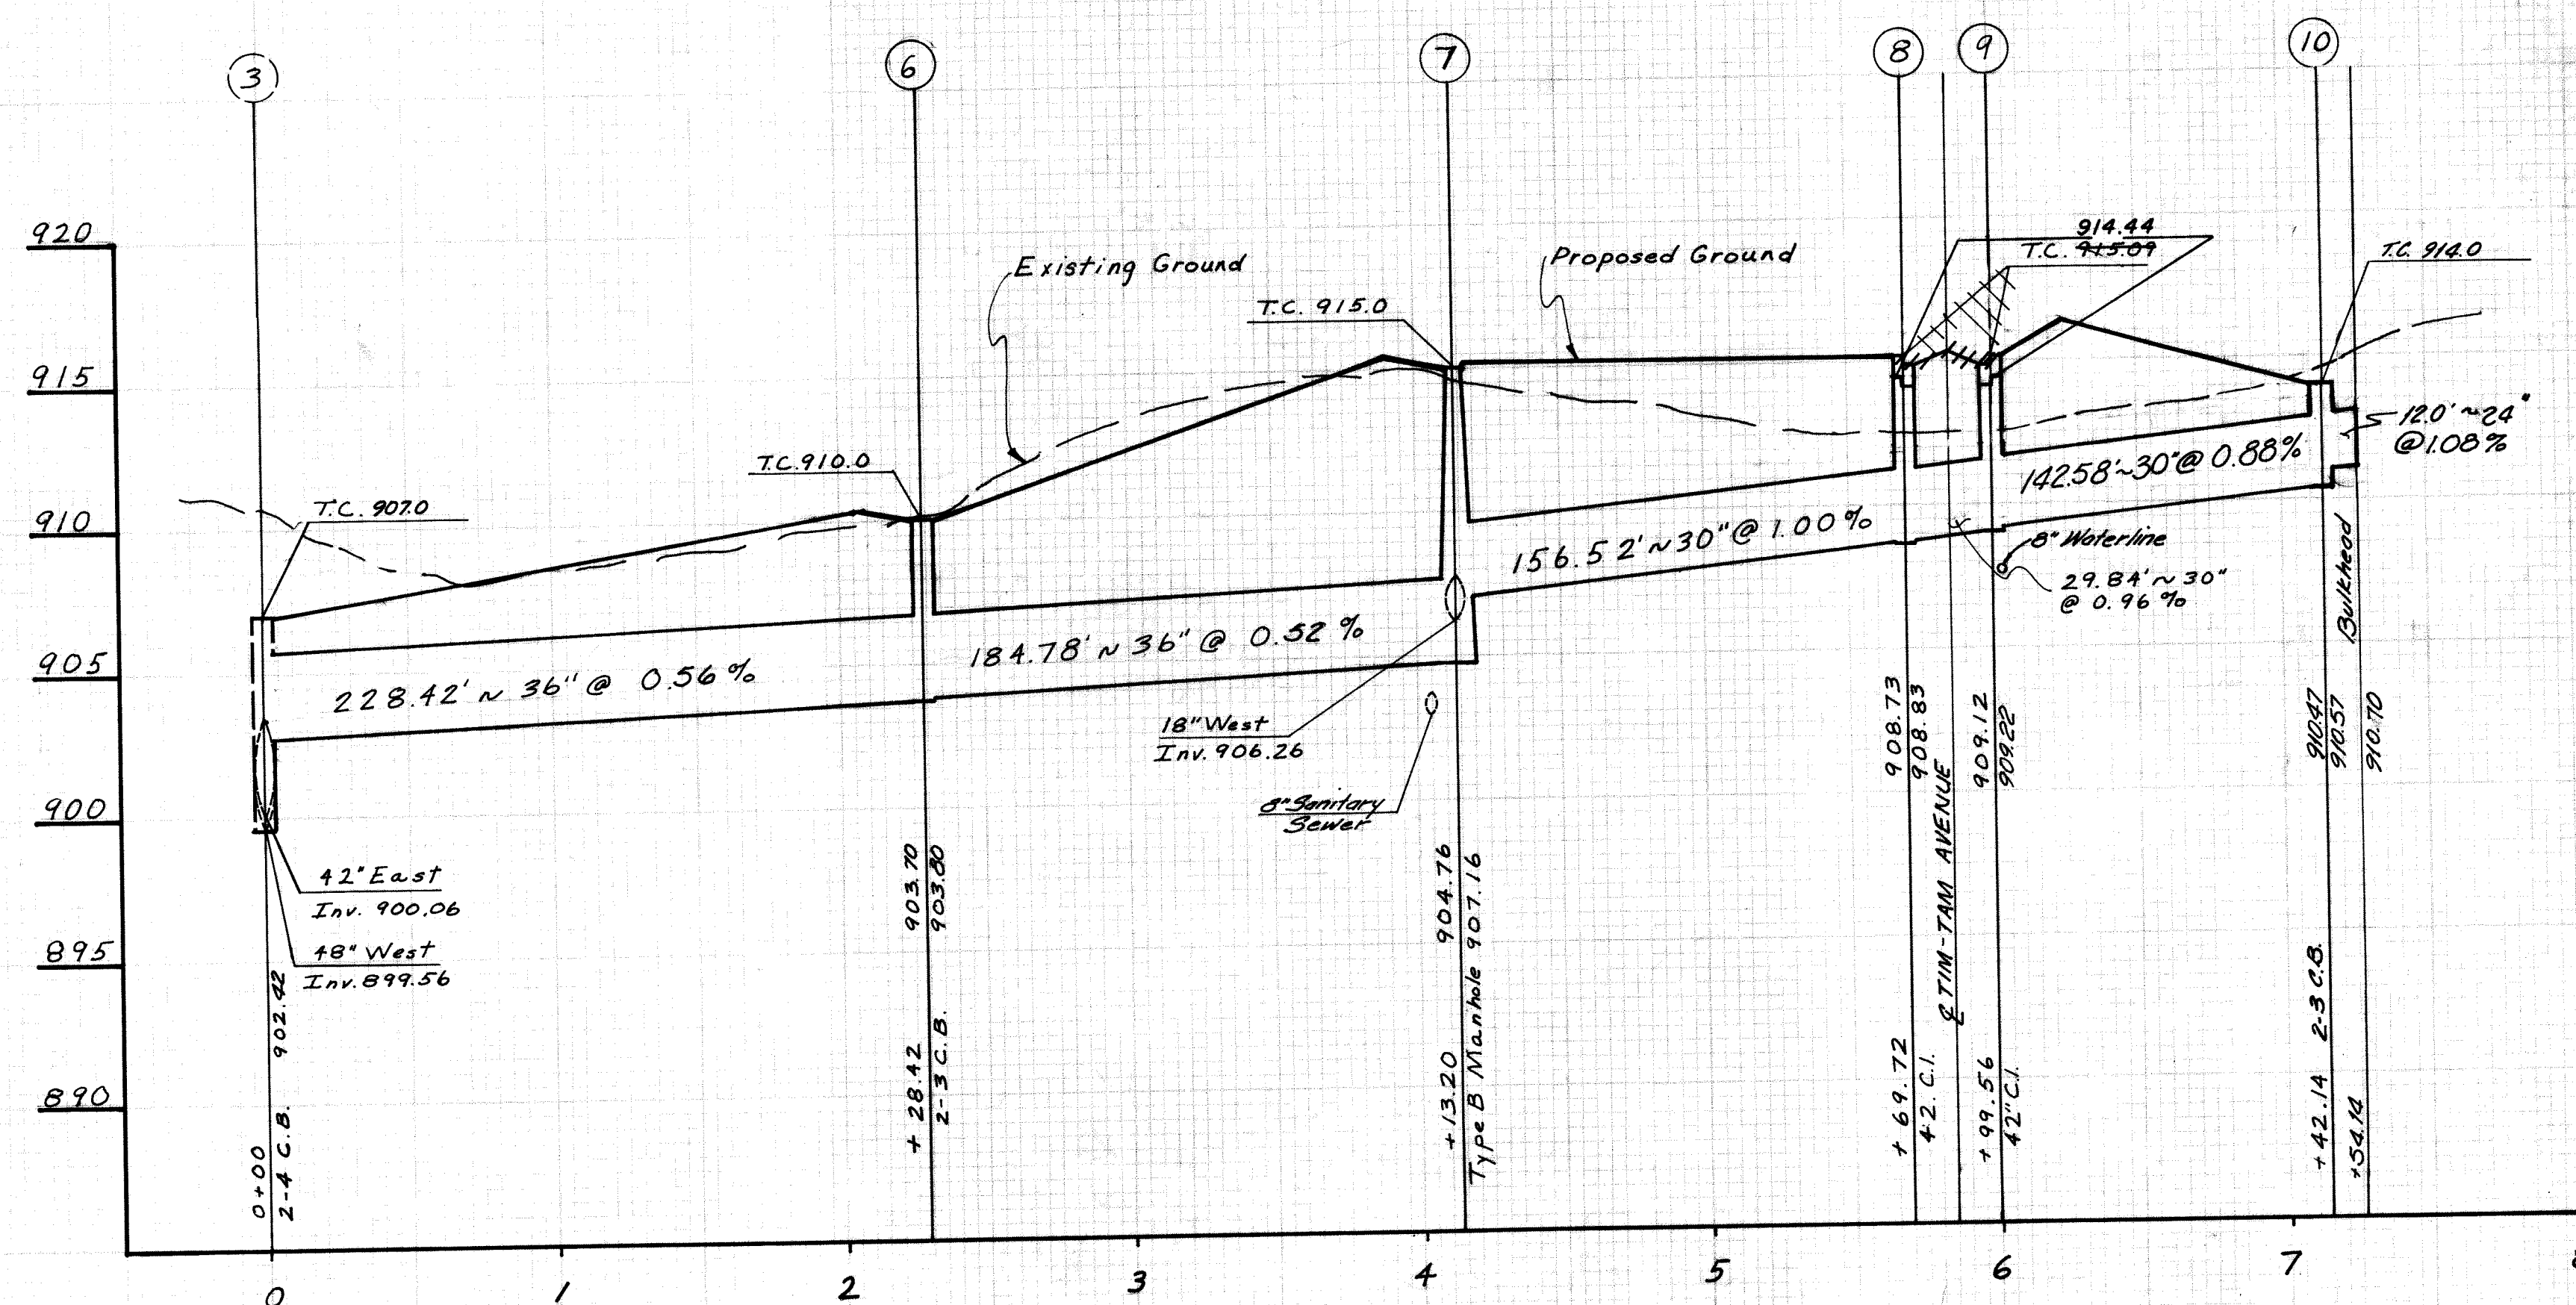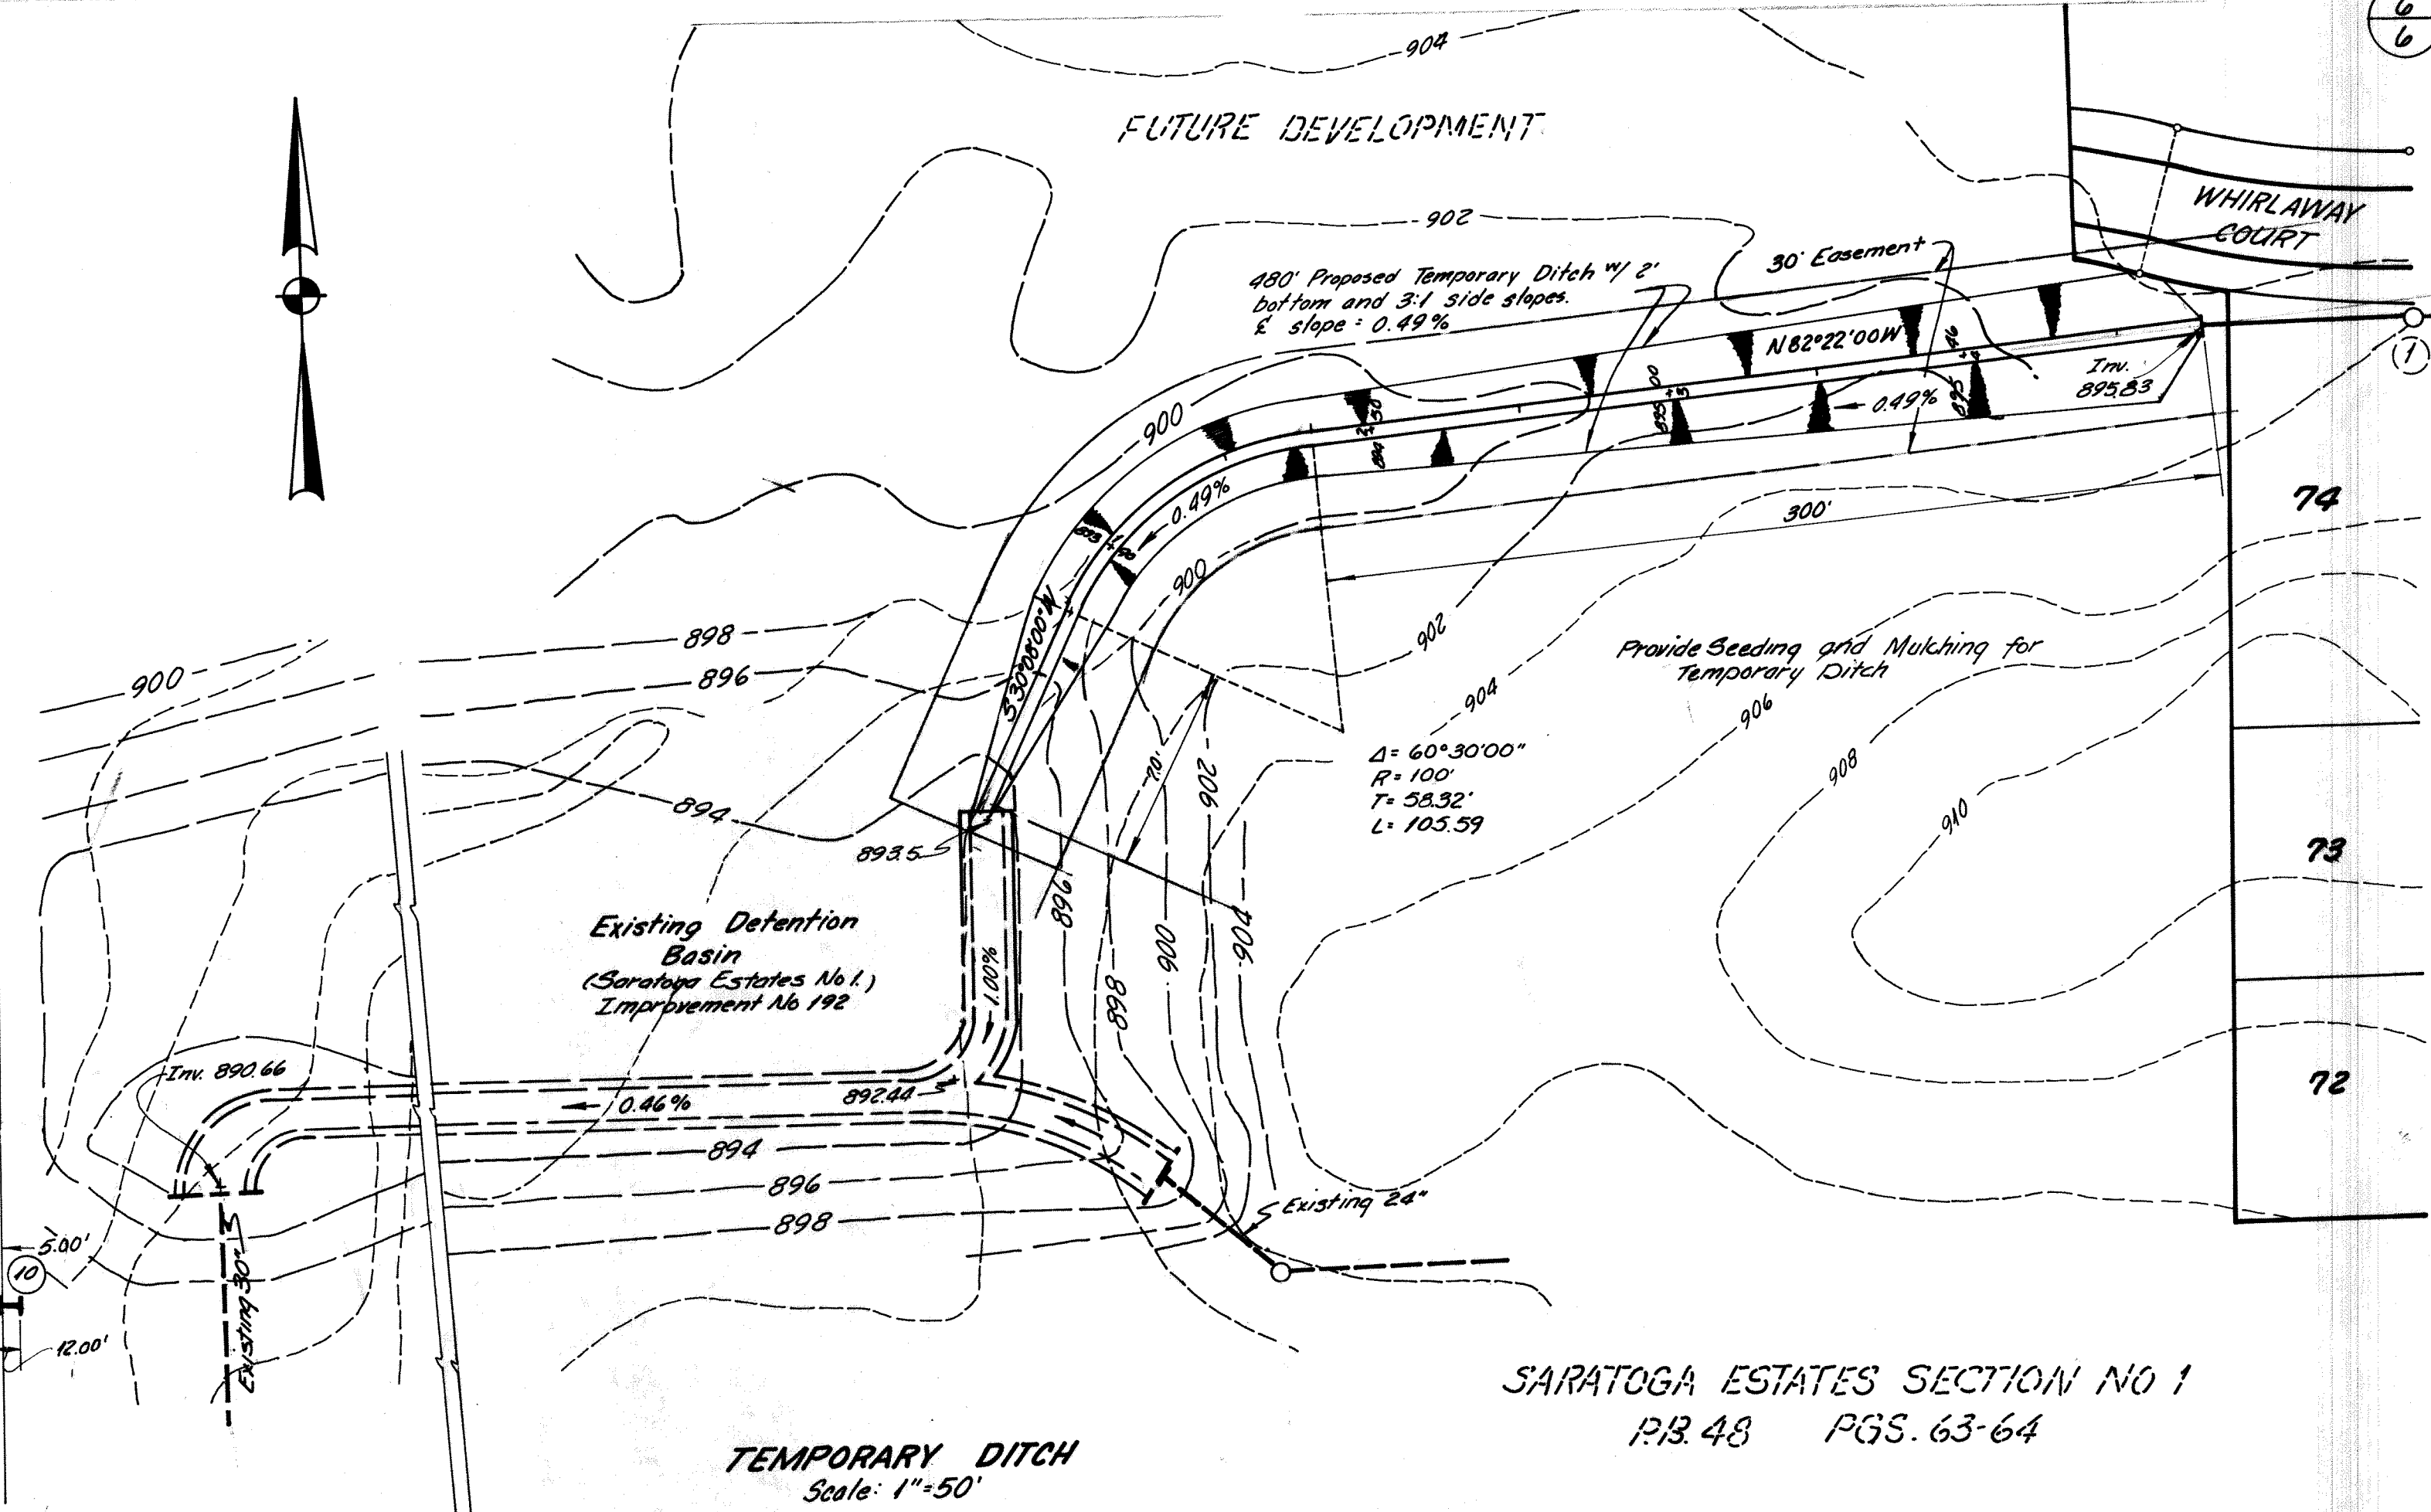
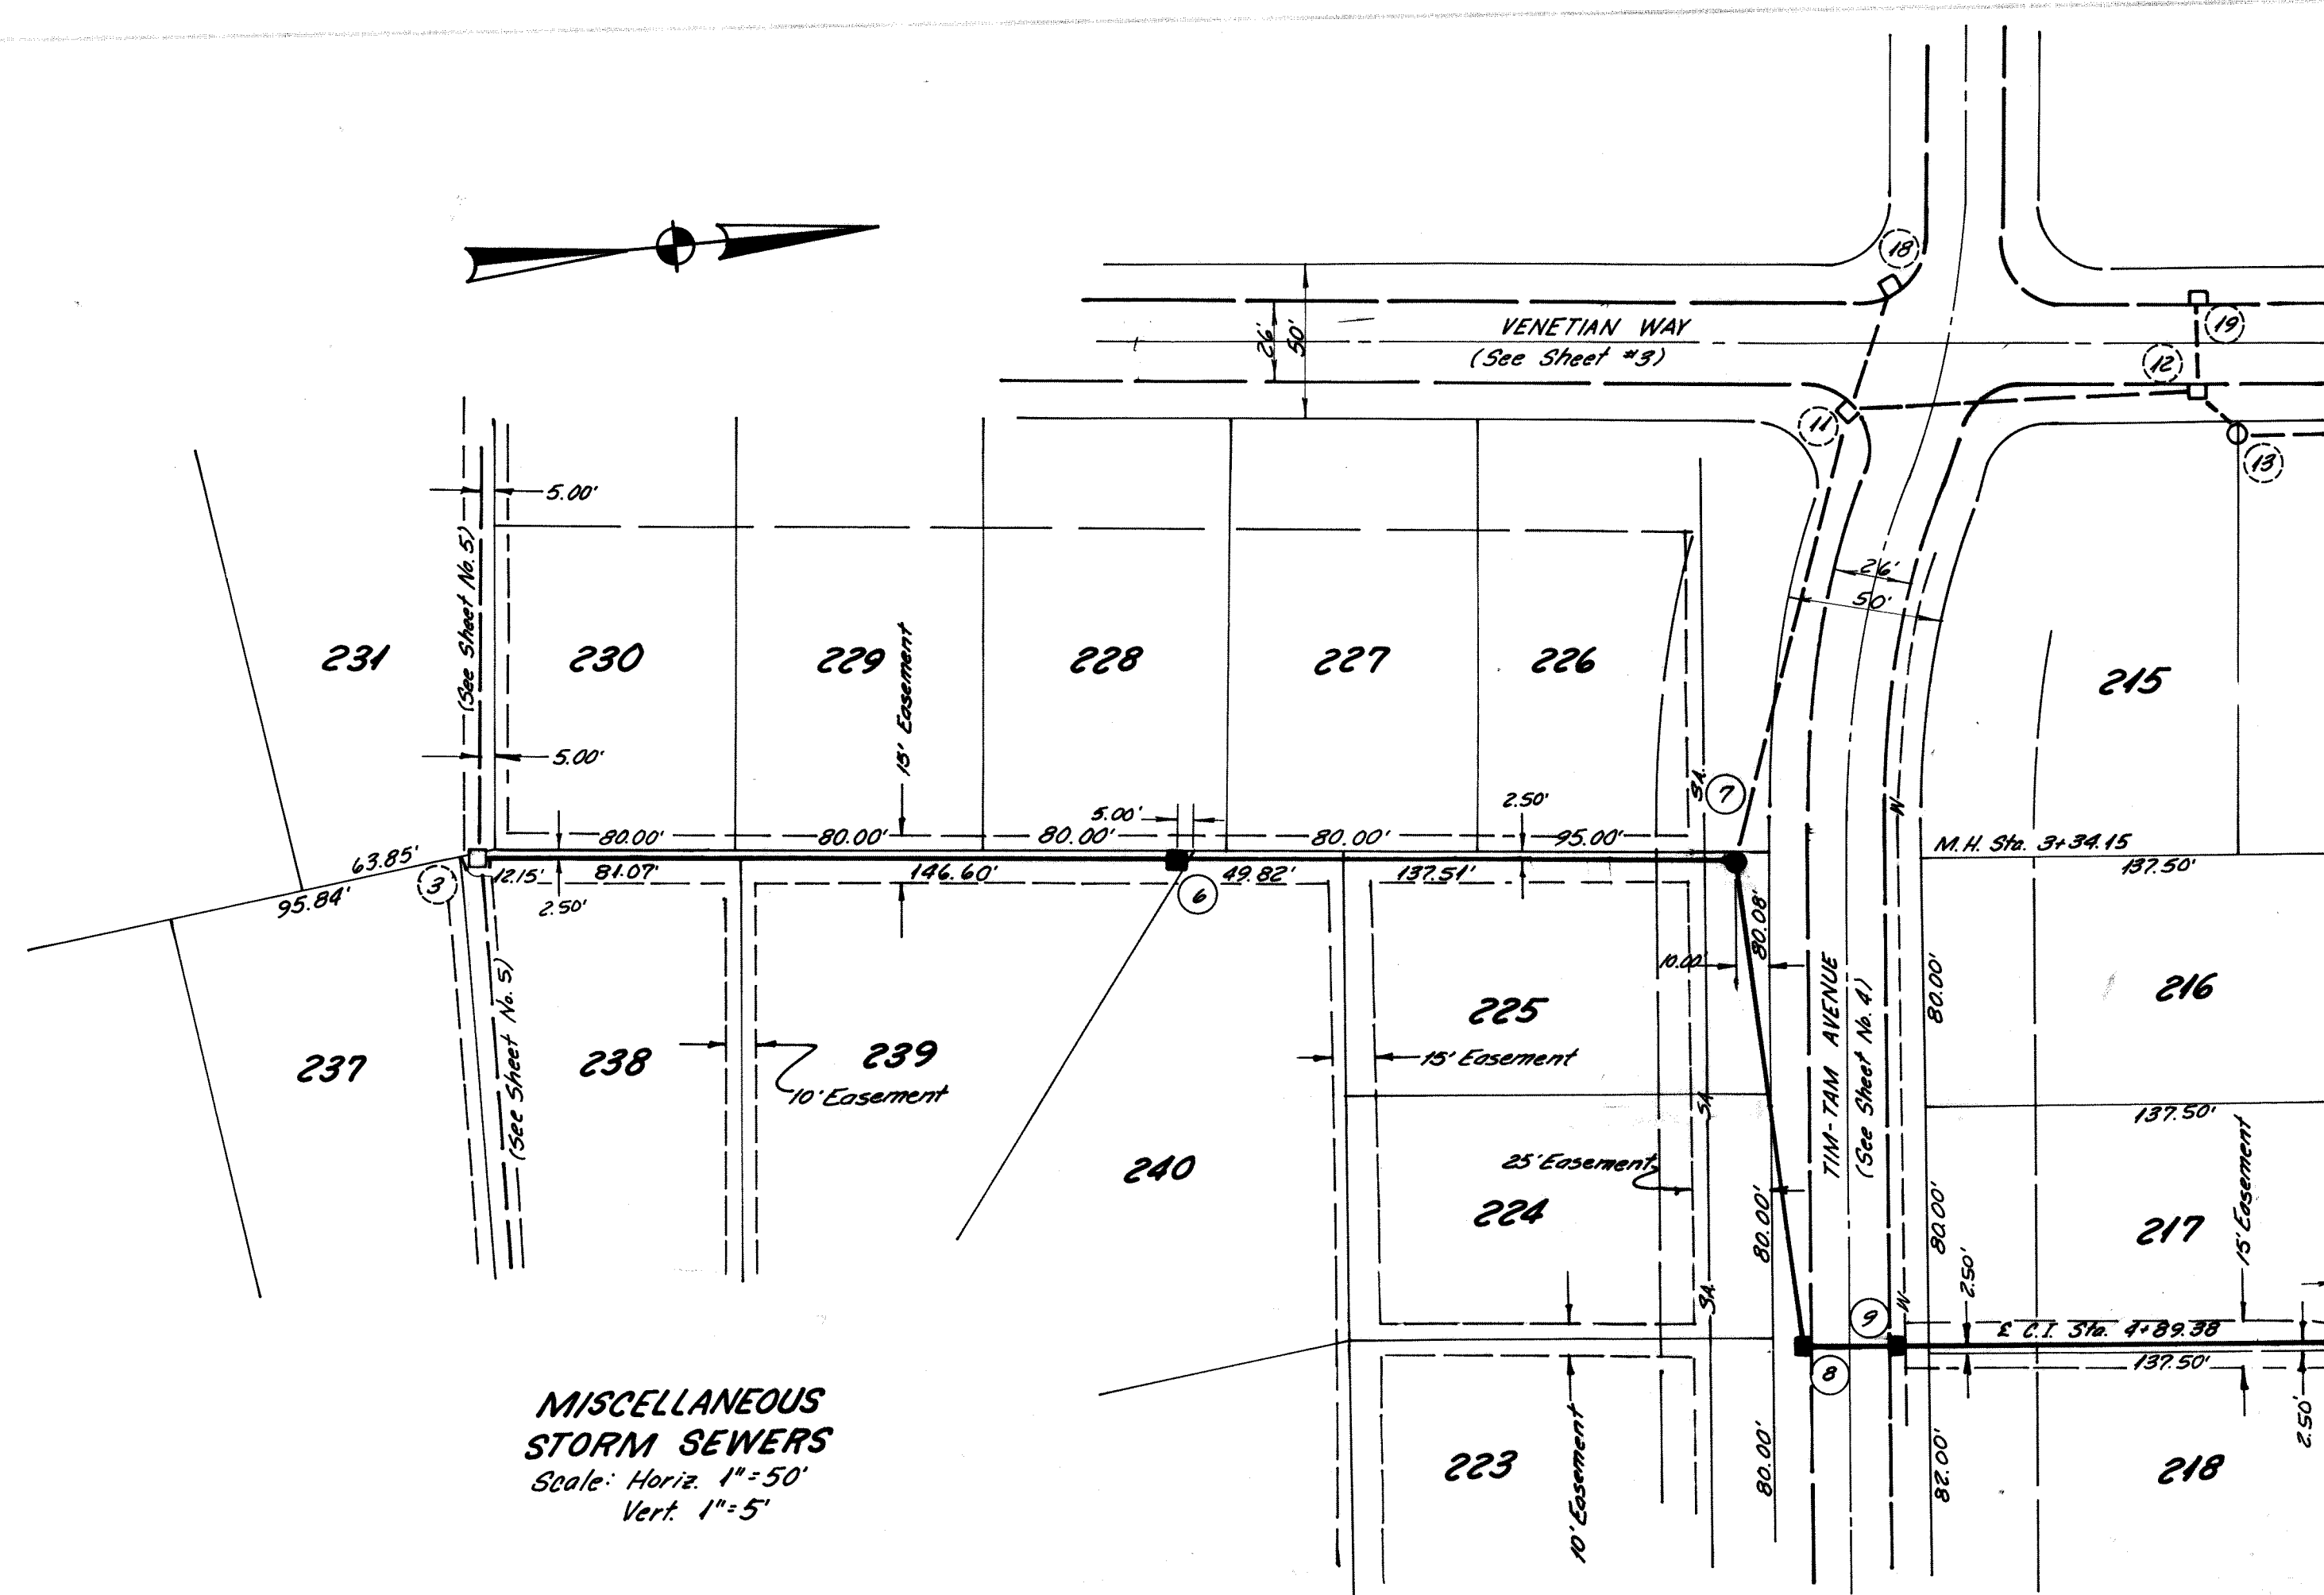


CITY OF GAHANNA, OHIO
STREET, STORM AND WATER
IMPROVEMENTS NO.
SARATOGA ESTATES
SECTION 2 PHASE I

MISCELLANEOUS DETAILS

r. d. zande & associates, ltd.
consulting engineers
COURT HOUSE SQUARE, 563 SOUTH HIGH ST.
COLUMBUS, OHIO 43215


RUBY & ELIZABETH GOLDBERG
15.93 AC.
DB. 2886 PG. 237

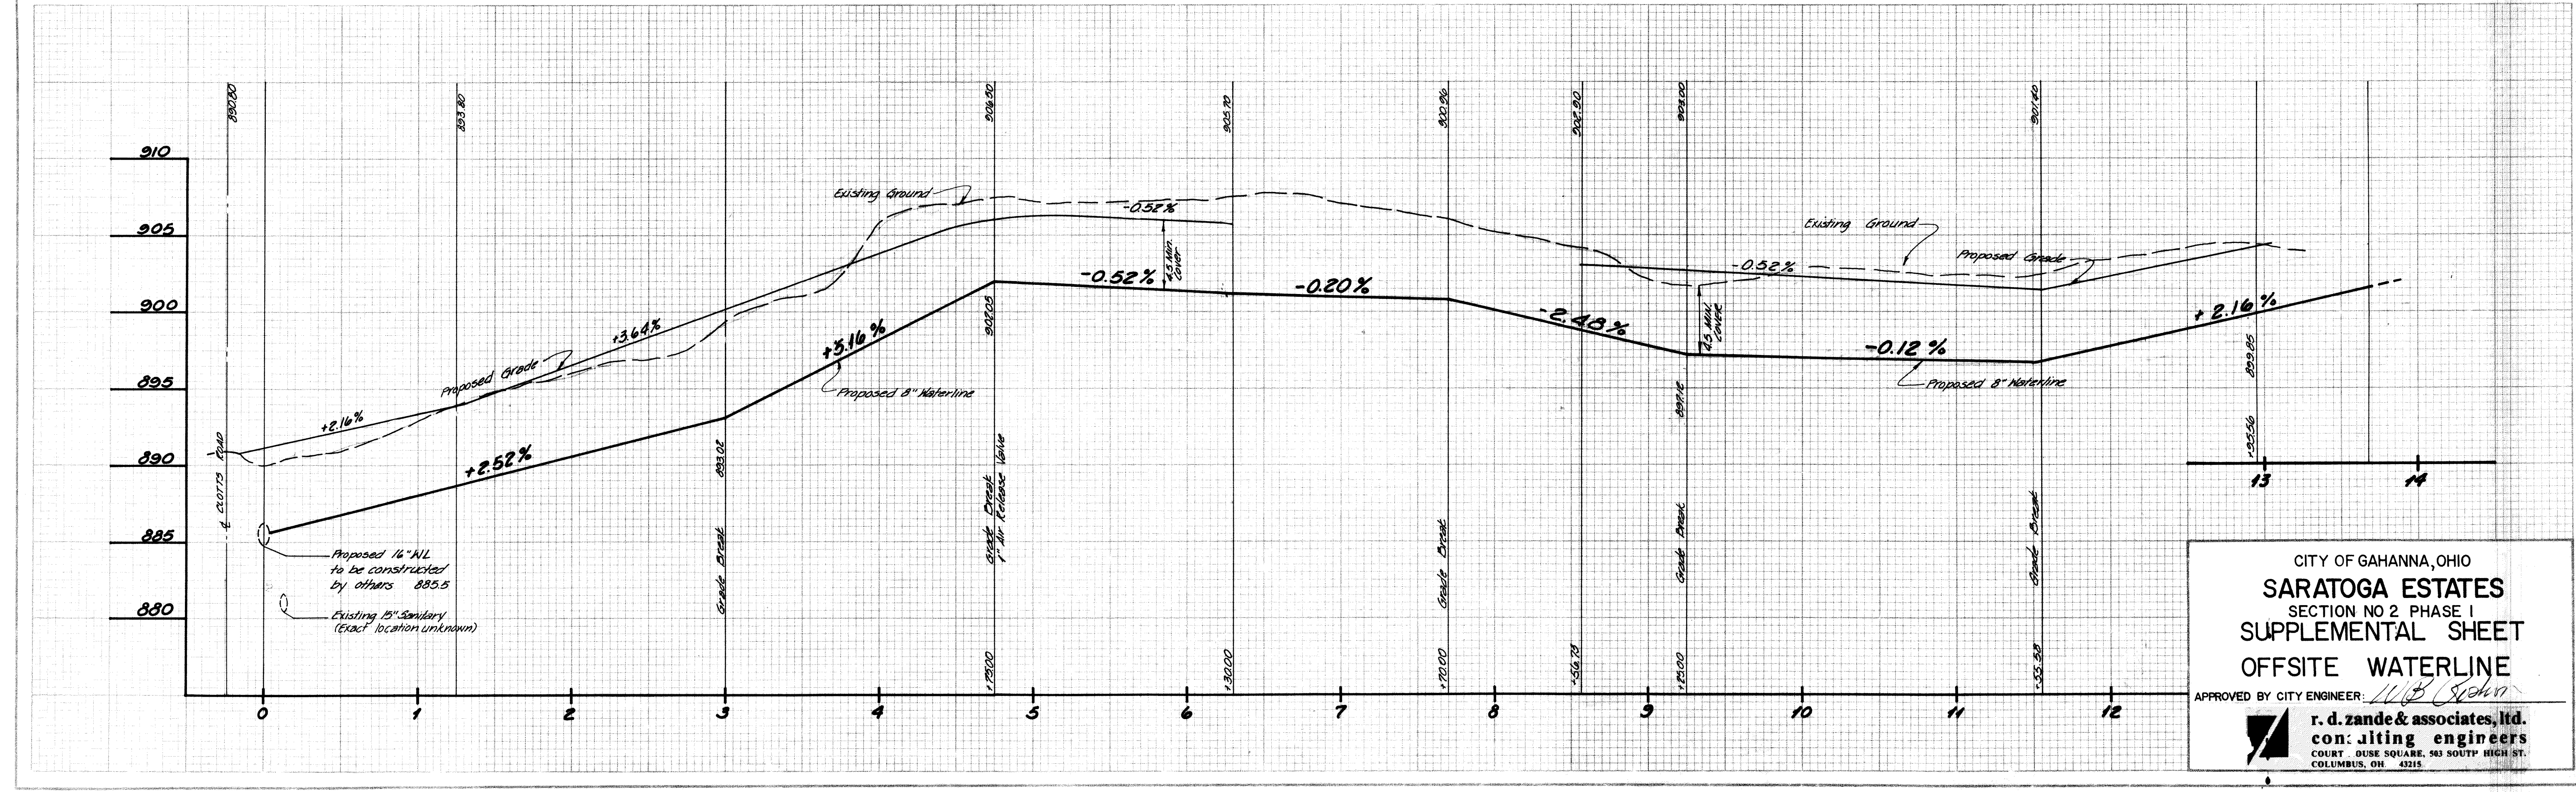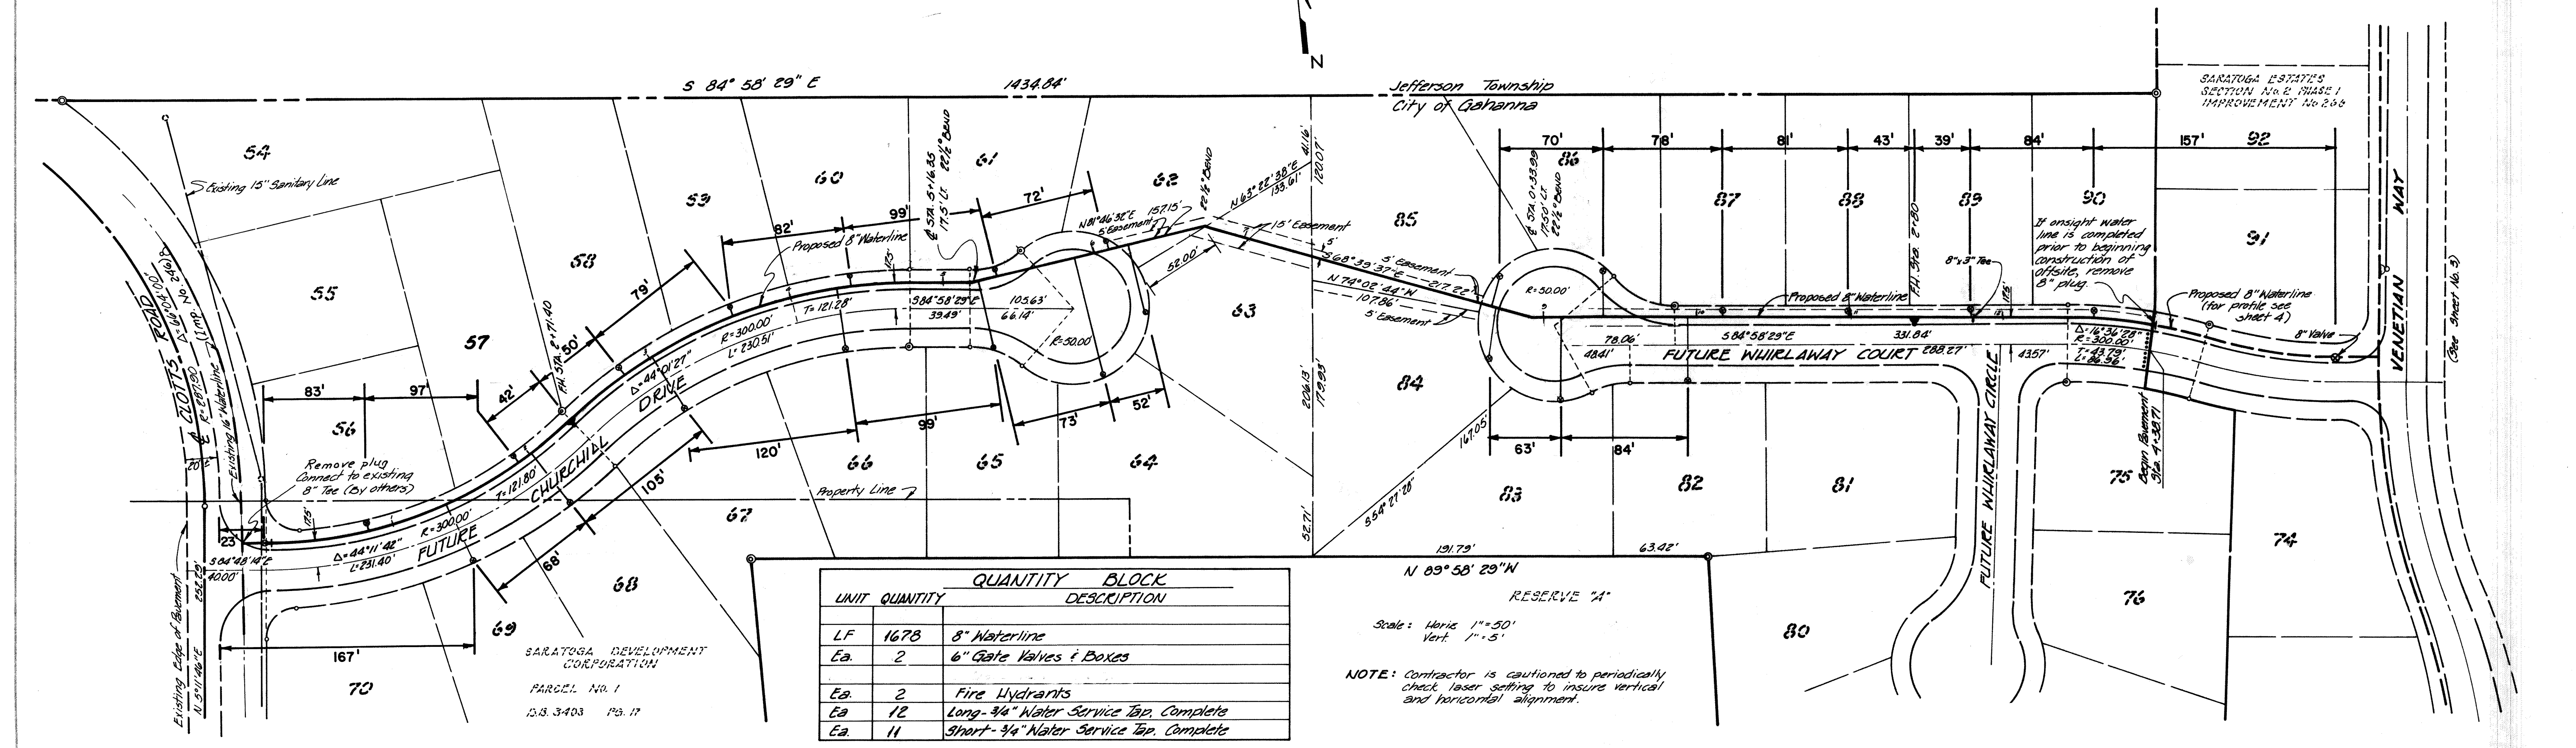

CITY OF GAHANNA, OHIO
SARATOGA ESTATES
SECTION NO. 2 PHASE I
SUPPLEMENTAL SHEET
OFFSITE WATERLINE



APPROVED BY CITY ENGINEER: *[Signature]*

r. d. zande & associates, ltd.
con: jiting engineers
COURT HOUSE SQUARE, 563 SOUTH HIGH ST.
COLUMBUS, OH. 43215

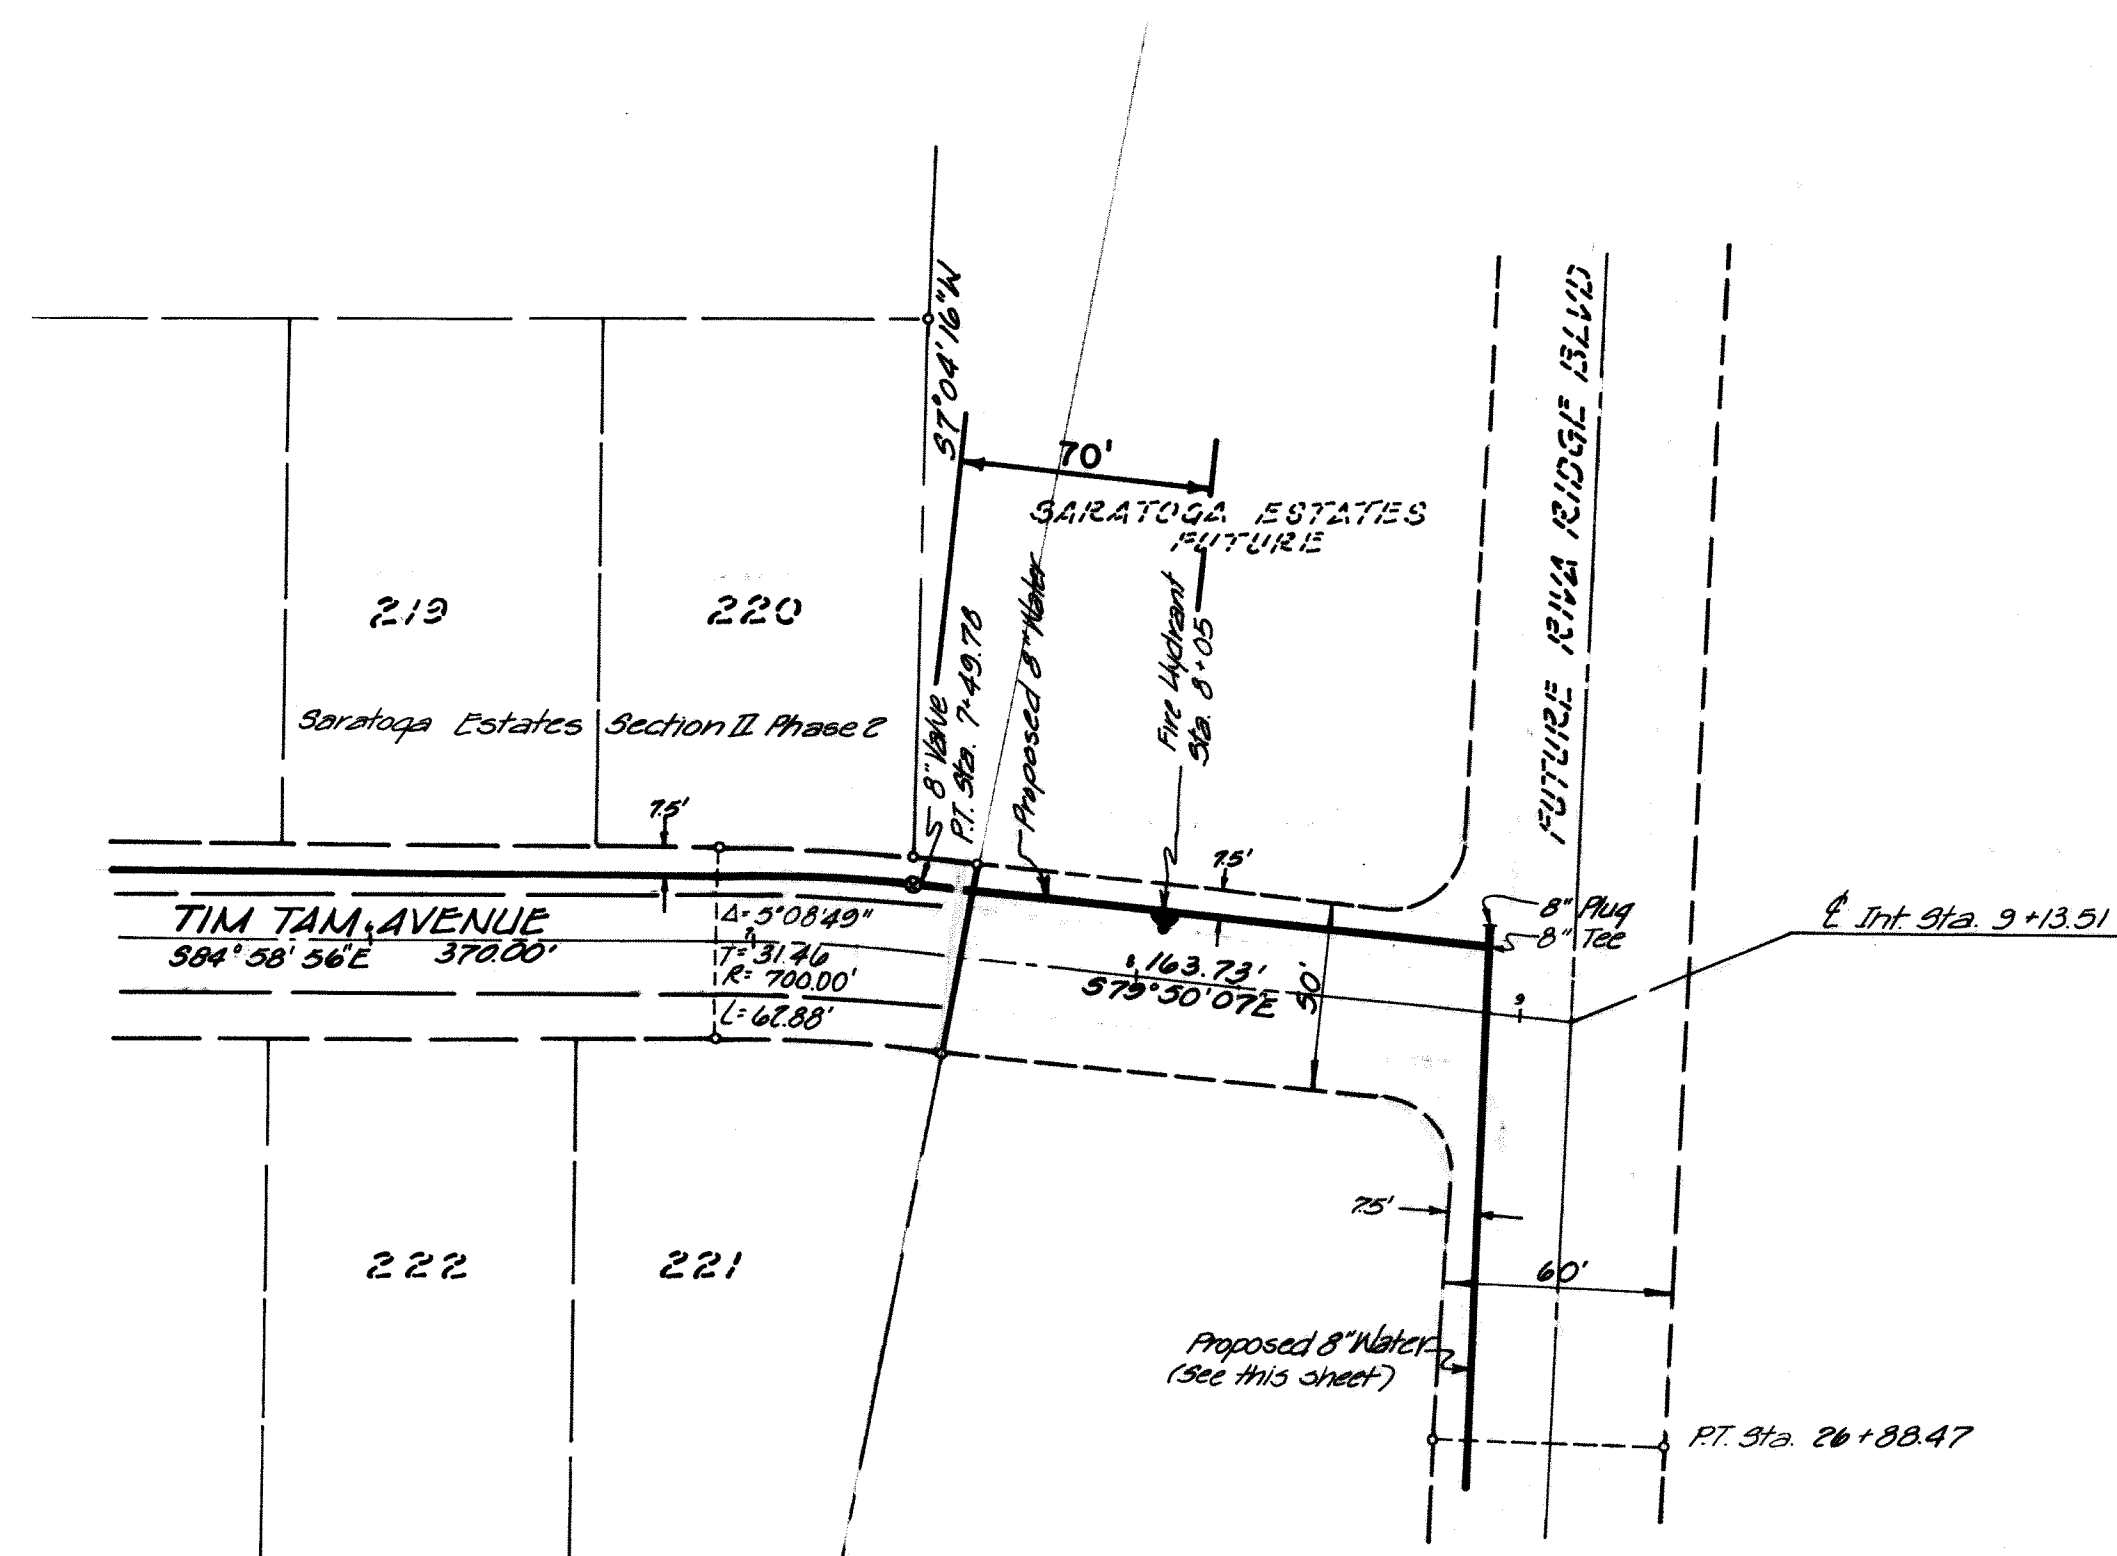



TIM TAM AVENUE

Scale: Horiz. 1"=50'
Vert. 1"=5'

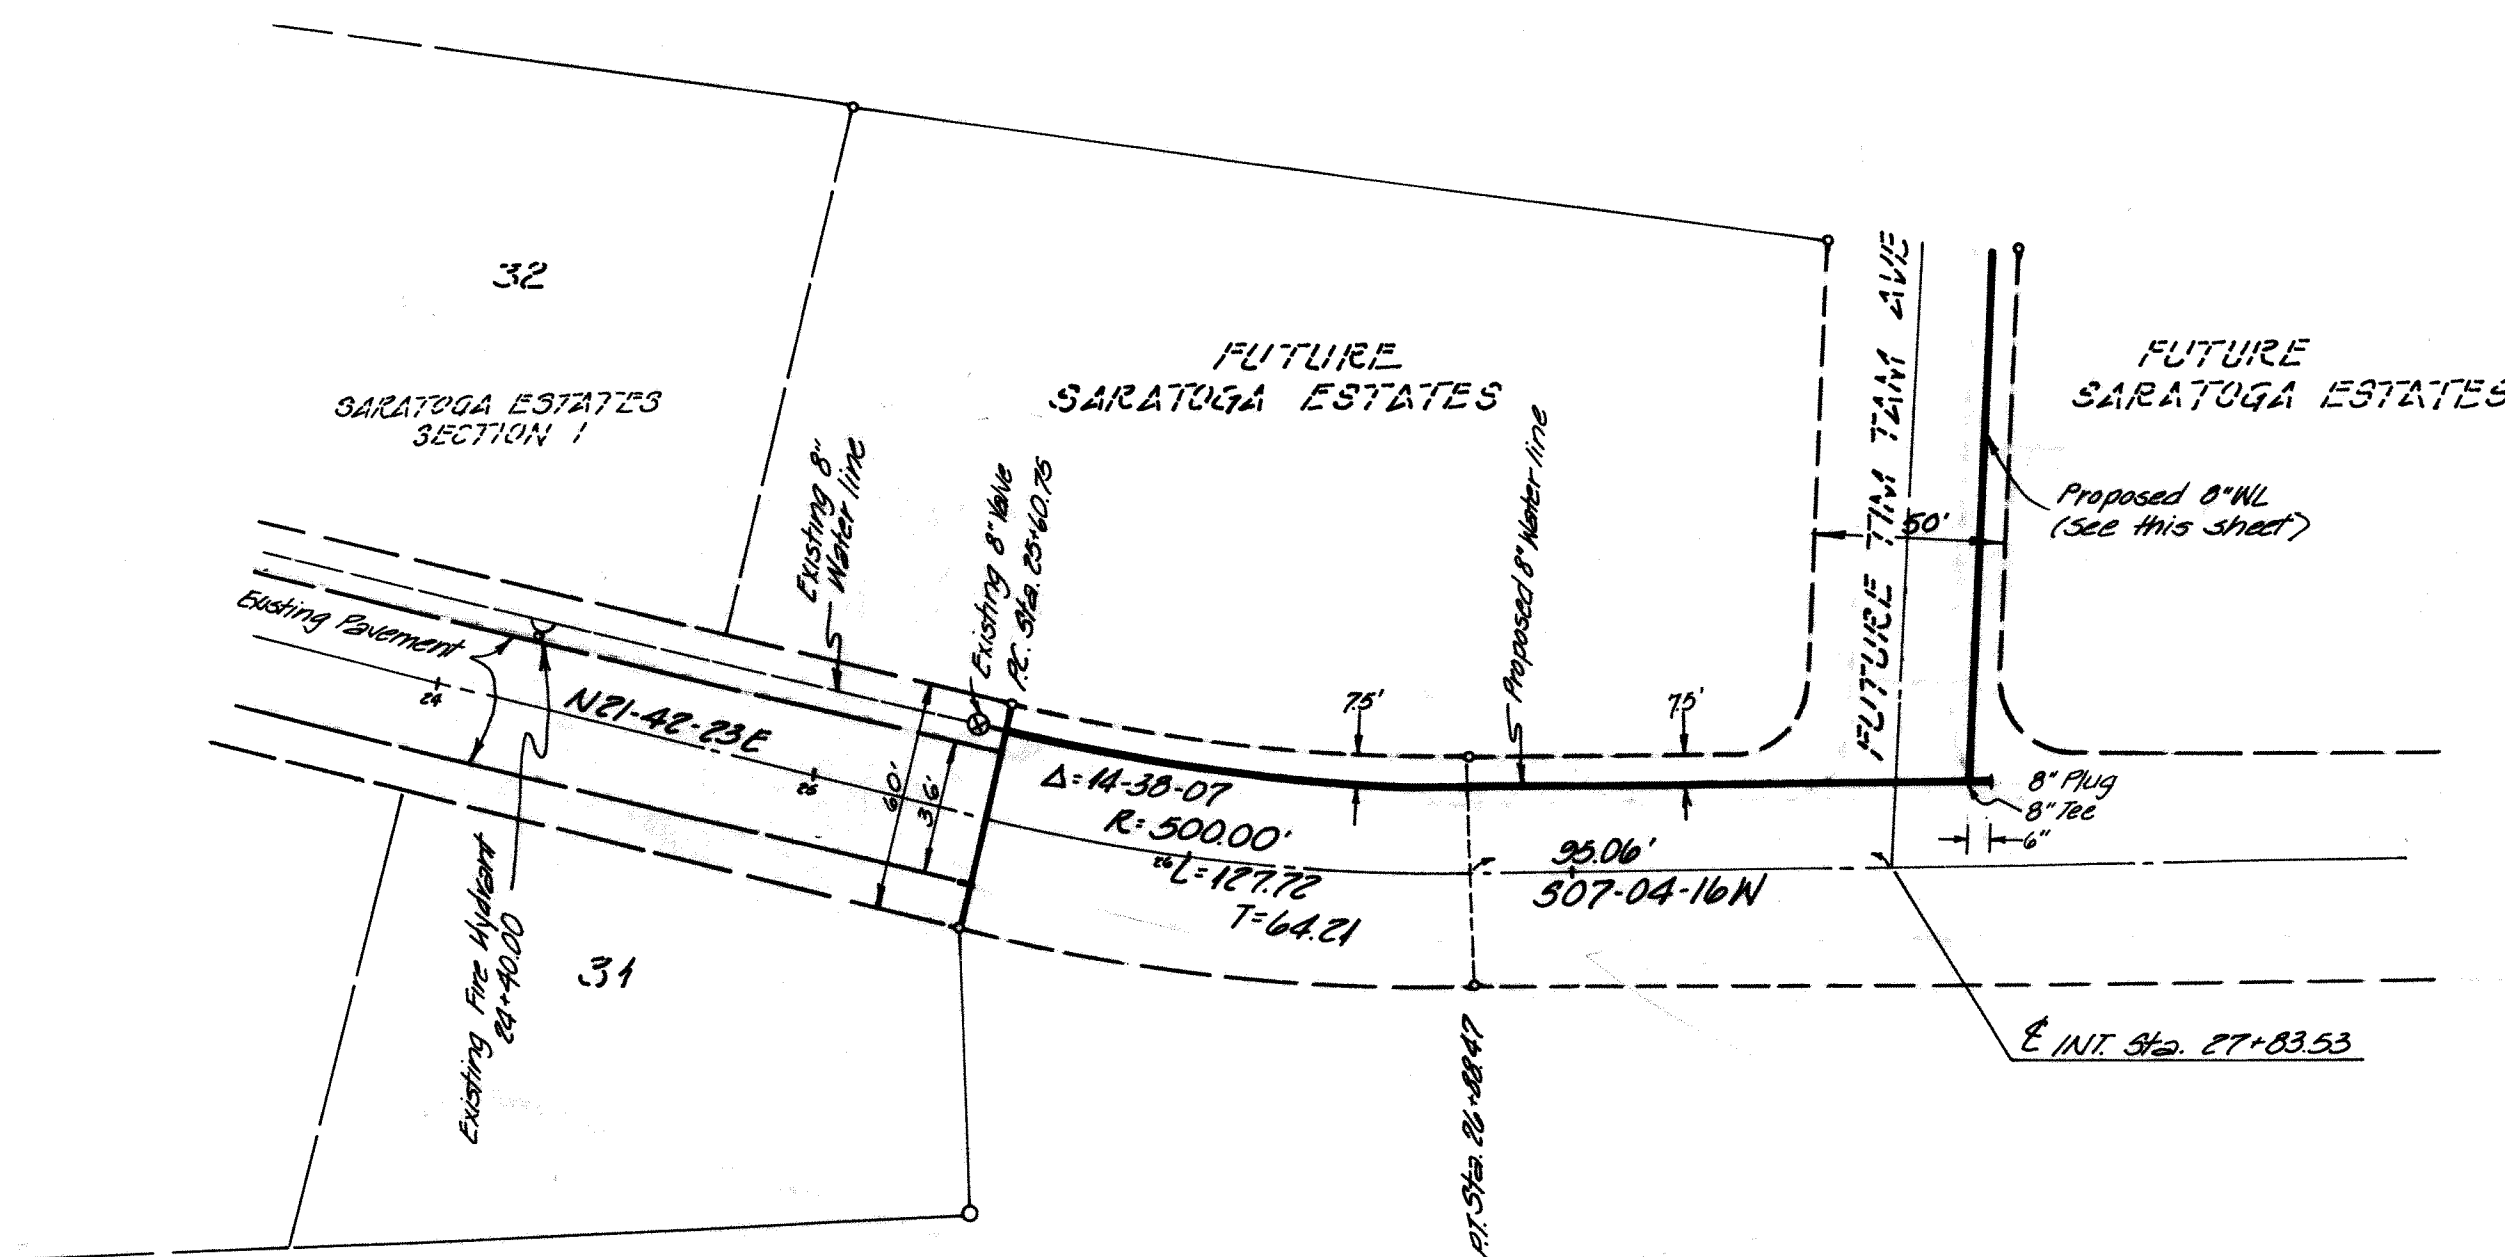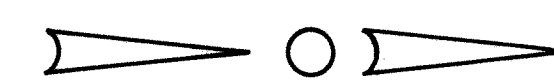

RIVA RIDGE BLVD.

Scale: Horiz. 1"=50'
Vert. 1"=5'

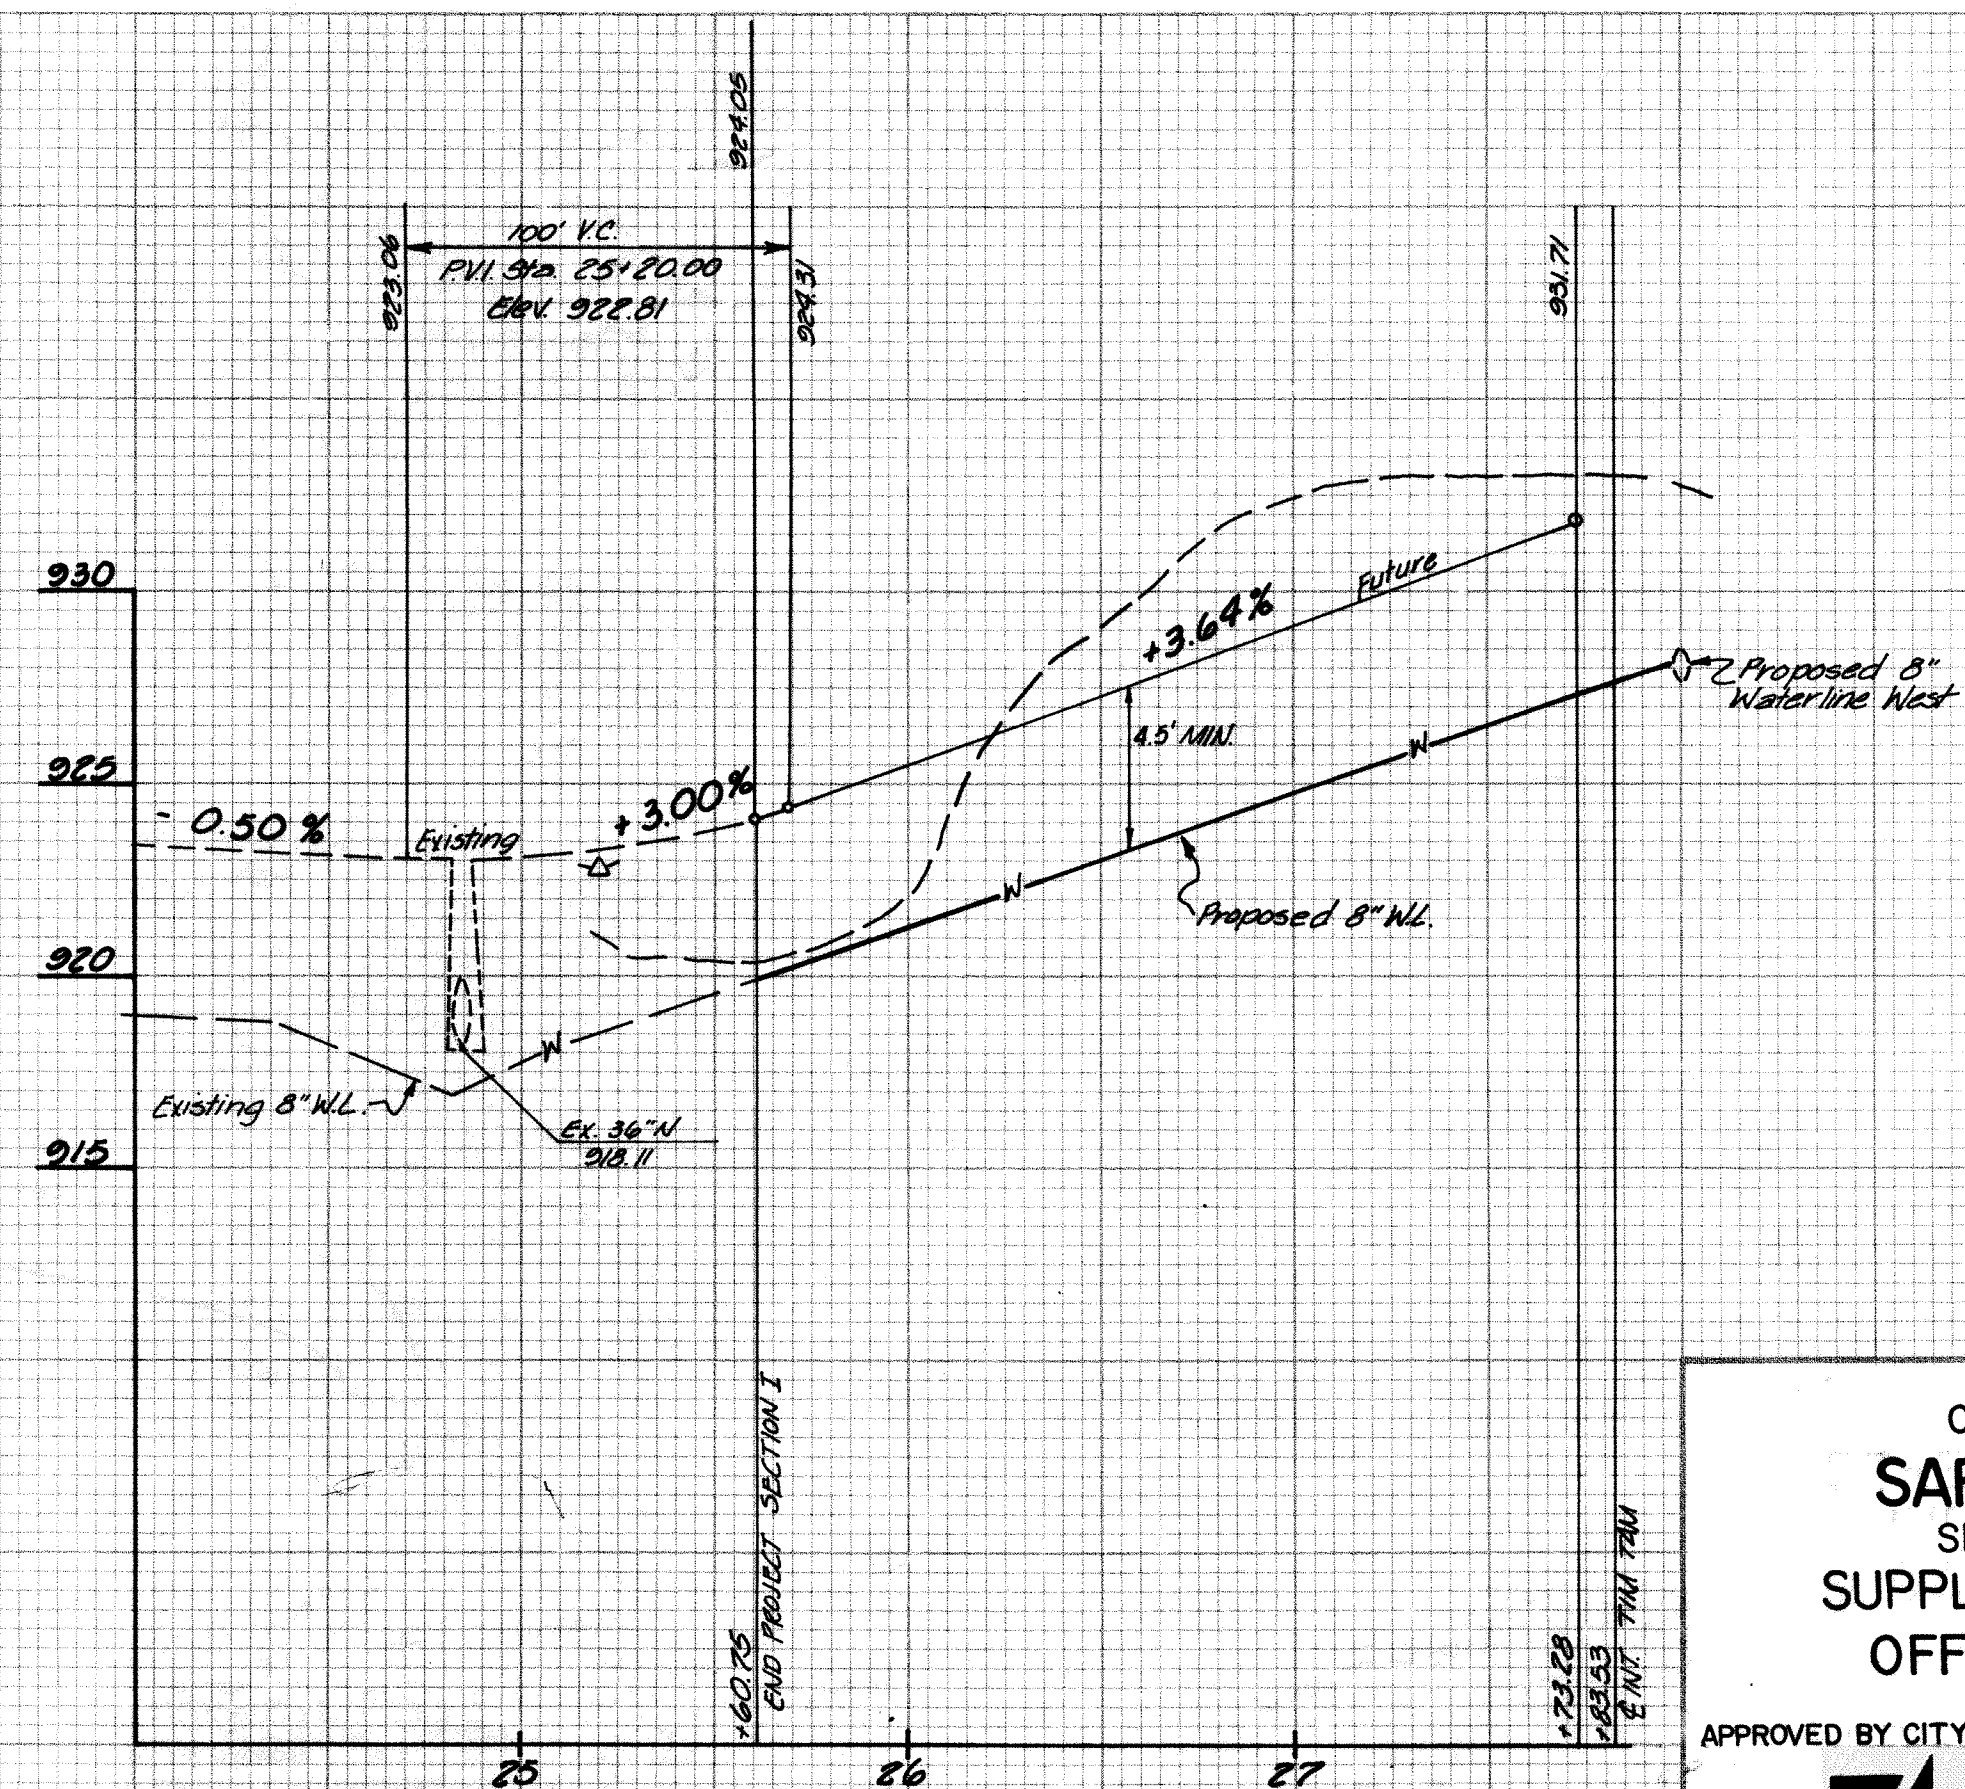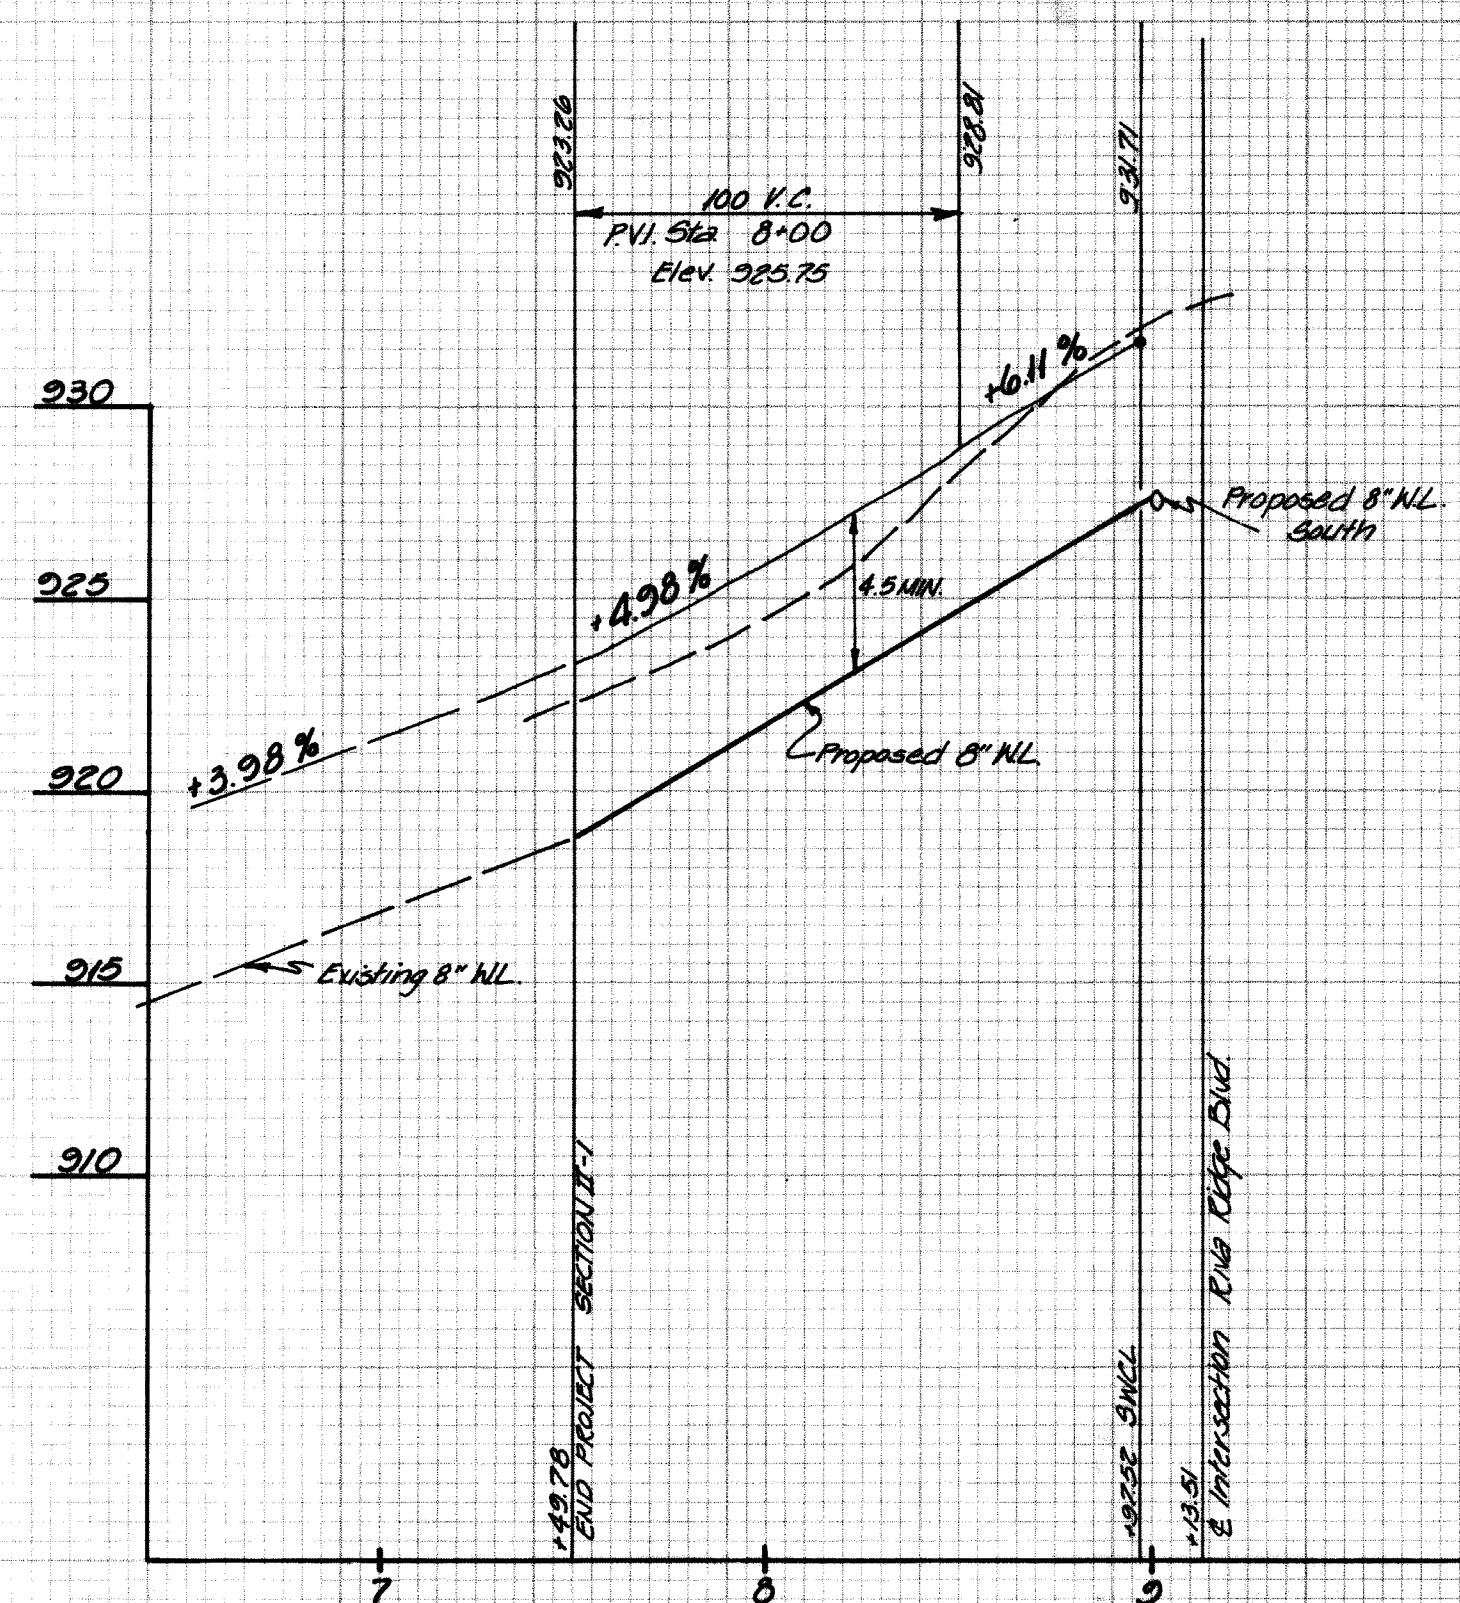

CITY OF GAHANNA, OHIO
SARATOGA ESTATES
SECTION NO 2 PHASE I
SUPPLEMENTAL SHEET 2
OFFSITE WATERLINE

APPROVED BY CITY ENGINEER *[Signature]*
r. d. zande & associates, ltd.
consulting engineers
COURT HOUSE SQUARE, 583 SOUTH HIGH ST.
COLUMBUS, OHIO 43215

PRIVATE STREET AND WATER
AND STREET LIGHTING
IMPROVEMENT NO. 238
RESUBDIVISION OF
CHERRY BOTTOM
CITY OF GAHANNA, OHIO
1985

GENERAL NOTES

SPECIFICATION: The requirements of the City of Gahanna, together with the Standard Specifications of the State of Ohio, Department of Transportation, including all supplements thereto in force on date of contract shall govern all materials and workmanship involved in the improvements shown on these plans except as such specifications are modified by the following specifications or by the construction details set forth herein.

STANDARD CONSTRUCTION DRAWINGS: All pertinent Standard Construction Drawings are available upon request at the office of the City Engineer.

PERMITS: The Contractor shall obtain all necessary permits.

SAFETY REQUIREMENTS: The Contractor and Sub-Contractor shall be solely responsible for all federal, state and local safety requirements, together with exercising precautions at all times for the protection of persons (including employees) and property. It is also the sole responsibility of the Contractor and Sub-Contractor to initiate, maintain and supervise all safety requirements, precautions and programs in connection with this work.

MISCELLANEOUS WORK: All items of work called for on the plans for which no specific method of payment is provided shall be performed by the Contractor and the cost of same shall be included in the price for the various related items.

FIELD TILE: All field tile broken during excavation shall be replaced to its original condition or connected to either the curb subdrain or to the storm sewer system as directed by the Engineer.

SURPLUS EXCAVATION: The Contractor shall dispose of all surplus street excavation on the project site where and as directed by the Owner.

UNAUTHORIZED STREET EXCAVATION: In the event excavation for the street is from 0" to 6" below that called for on the plans, the Contractor shall replace this excess excavated material with compacted 46D crushed aggregate as directed and at no extra cost to the owner.

STORM SEWERS: Unless otherwise noted on the plans all Storm Sewers shall be as hereafter specified: (1) All sizes of storm sewer located within or across proposed or existing pavement areas shall be Type B Conduit, 706.02, with Class B Bedding, (2) Storm Sewer located outside pavement areas shall be Type E Conduit, 706.01, Class C Bedding, for 15 inch and smaller, and shall be Type E Conduit, 706.02, Class C Bedding, for 18 inch and larger. The following modifications to Ohio Department of Transportation Specifications shall apply: (1) Type E Conduits shall have sealed joints; (2) Granular backfill material shall be compacted granular material, Item 310-A placed within limits shown on the plan including around all inlet structures. Granular backfill shall extend from the bottom of the trench to a plane 6 inches below the subgrade.

CURB INLETS: All curb inlets shall be channeled as directed.

ROOF DRAIN OPENINGS: The Contractor shall provide two roof drain openings in the curb for each lot, each opening located not more than 4 feet in from each lot line.

STREET LIGHTING: Standard Electrical Specifications and Standard Construction Drawings, covering Street Lighting for the City of Gahanna, Ohio, shall apply.

EXPANSION JOINTS: It shall be the responsibility of the Contractor to adequately barricade the street in the vicinity of all expansion joints, until such time as the street is open to traffic.

WATER MAINS: All water mains shall be either Ductile Iron Class 53 (4" through 10"), Class 54 (12" and larger), or Polyvinyl Chloride, Class 150. All bends, joint deflections and fittings shall be backed with concrete where and as directed. Where water mains or services cross proposed or existing streets, backfill shall be compacted granular material, Item 310-A, within limits 5 feet outside the edge of pavement or curb extended from the bottom of the trench to a plane 6 inches below the subgrade. The services may be jacked across the street in lieu of open cut and the use of granular backfill.

CURB BOXES: Curb boxes shall be located one-half foot from the property line unless otherwise shown on the plans or ordered by the Engineer.

CHLORINATION OF WATER MAINS: The Contractor shall make arrangements to have the water mains chlorinated by the City of Columbus. The cost of chlorination shall be included in the price bid for the various water main items.

EXISTING UTILITIES: The identity and location of the existing underground utility facilities known to be located in the construction area have been shown on the plans as accurately as provided by the Owner of the underground utility. The City of Gahanna and/or Engineer assumes no responsibility as to the accuracy or the depths of the underground facilities shown on the plans.

Support, protection and restoration of all existing utilities and appurtenances shall be the responsibility of the Contractor. The cost of this work shall be included in the price bid for the various items.


The Contractor shall cause notice to be given to the Ohio Utilities Protection Service (telephone 800-362-2764 - toll free) and to the Owners of underground utility facilities shown on the plans who are not members of a registered underground protection service in accordance with Section 153.64 of the Revised Code. The above mentioned notice shall be given at least 48 hours prior to start of construction.

The following utilities are located within the work limits of this project, and the Owners do not subscribe to a registered underground utility protection service:

UTILITY	OWNER	TELEPHONE NO.
Water & Sewer	City of Gahanna	471-3827

PREPARED BY
EVANS, MECHWART, HAMBLETON & TILTON, INC.
CONSULTING ENGINEERS & SURVEYORS
GAHANNA, OHIO

By Richard H. Dickman Sept. 4, 1985
Registered Engineer Date

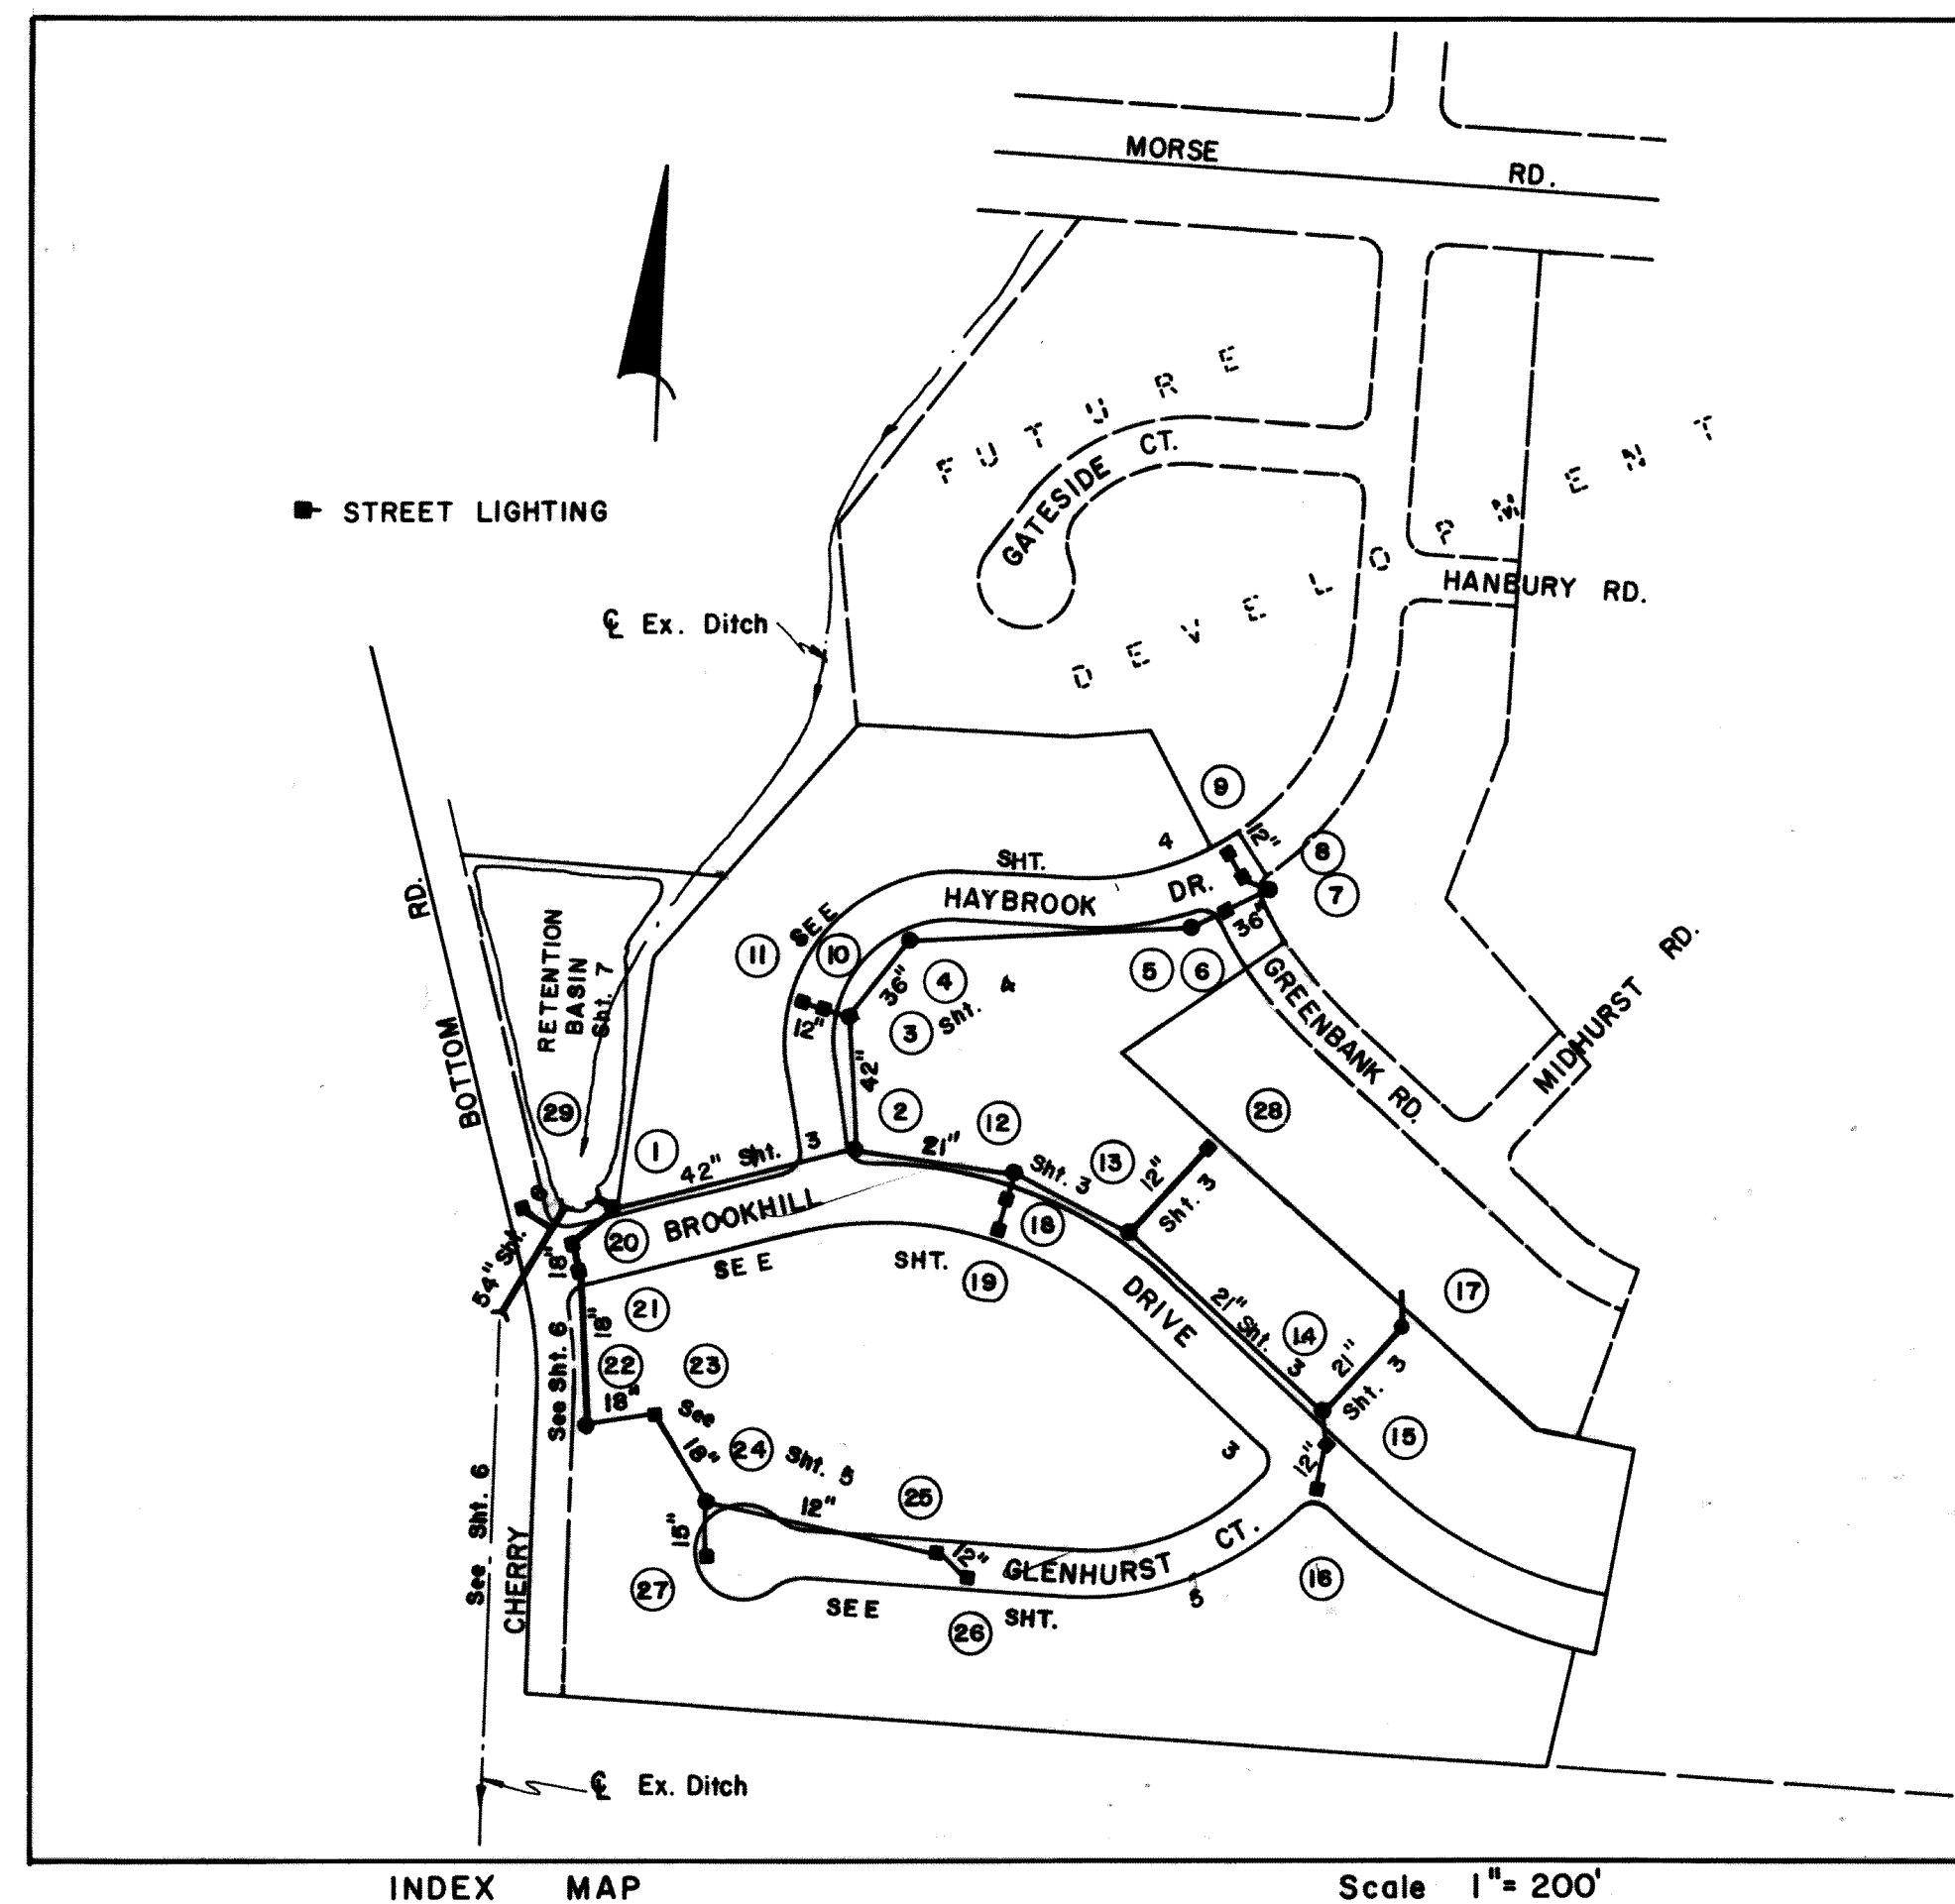

BENCH MARKS

B.M. A-9 Conc. Mon. 35' South of Morse Rd., 14'± East of driveway to Franklin Co. Maintenance Garage
Elev. 905.40

B.M. A-7 Brass plate on N.E. corner of bridge over Big Walnut Creek on Morse Rd.
Elev. 813.01

ESTIMATE		OF		QUANTITIES
ITEM	QUANTITIES	UNIT	DESCRIPTION	
203	7,800	Cu. Yds.	Excavation including Embankment Construction	
305	4,895	Sq. Yds.	8" Portland Cement Concrete Base	
305	3,940	Sq. Yds.	7" Portland Cement Concrete Base	
402	315	Cu. Yds.	Asphalt Concrete	
404	330	Cu. Yds.	Asphalt Concrete	
407	890	Gals.	Bituminous Tack Coat	
605	5,510	Lin. Ft.	4" Shallow Pipe Underdrain	
609	2,585	Lin. Ft.	Concrete Combination Curb & Gutter	
609	2,925	Lin. Ft.	Mountable Curb	
Spec.	3	Each	Temporary Barricade	
603	405	Lin. Ft.	12" Conduit, Type E, 706.01	
603	175	Lin. Ft.	12" Conduit, Type B, 706.02	
603	120	Lin. Ft.	15" Conduit, Type E, 706.01	
603	455	Lin. Ft.	18" Conduit, Type E, 706.02	
603	35	Lin. Ft.	18" Conduit, Type B, 706.02	
603	740	Lin. Ft.	21" Conduit, Type E, 706.02	
603	485	Lin. Ft.	36" Conduit, Type E, 706.02	
603	30	Lin. Ft.	36" Conduit, Type B, 706.02	
603	395	Lin. Ft.	42" Conduit, Type E, 706.02	
603	30	Lin. Ft.	42" Conduit, Type B, 706.02	
603	130	Lin. Ft.	54" Conduit, Type B, 706.02	
604	5	Each	Manhole, Type A	
604	6	Each	Manhole, Type B	
604	3	Each	2-2-B Catch Basin	
604				
604	9	Each	Curb & Gutter Inlet	
604	2	Each	42" Curb Inlet	
604	3	Each	60" Curb Inlet	
604	1	Each	Surface Inlet	
602	26.7	Cu. Yds.	Concrete Masonry	
601	25	Cu. Yds.	Rock Channel Protection, Type A	
601	65	Lin. Ft.	Paved Channel	
203	1,300	Cu. Yds.	Channel Excavation	
Special	Lump	L. S.	Retention Basin	
	955	Lin. Ft.	12" Water Main	
	1,665	Lin. Ft.	8" Water Main	
	610	Lin. Ft.	6" Water Main	
	215	Lin. Ft.	4" Water Main	
	2	Each	12" Valve	
	3	Each	8" Valve	
	8	Each	6" Valve	
	27	Each	3/4" Services (Short)	
	32	Each	3/4" Services (Long)	
	6	Each	Fire Hydrant - Mueller Centurion (4 1/2")	
Spec.	Lump Sum	L. S.	Street Lighting System Complete (2 Controls - 8 Standards)	

James R. Dwyer 9/9/85
Superintendent, Division of Water & Sewer
City of Gahanna, Ohio Date

Buck Jewell 9-9-85
Superintendent of Streets, City of Gahanna, Ohio Date

Charles R. Wolfe 9/9/85
City Engineer, City of Gahanna, Ohio Date

James F. McQuinn 9-10-85
Director of Public Service, City of Gahanna, Ohio Date


James F. McQuinn 9-10-85
Mayor, City of Gahanna, Ohio Date

Charles R. Wolfe 9-10-85
Auditor, City of Gahanna, Ohio Date


Rev. Fire Hyd. Loc., Sht. 5 ORW / B
11-12-85

**HAYBROOK DRIVE
GREENBANK ROAD
GLENHURST COURT**



TYPICAL 26' SECTION (50' R/W)

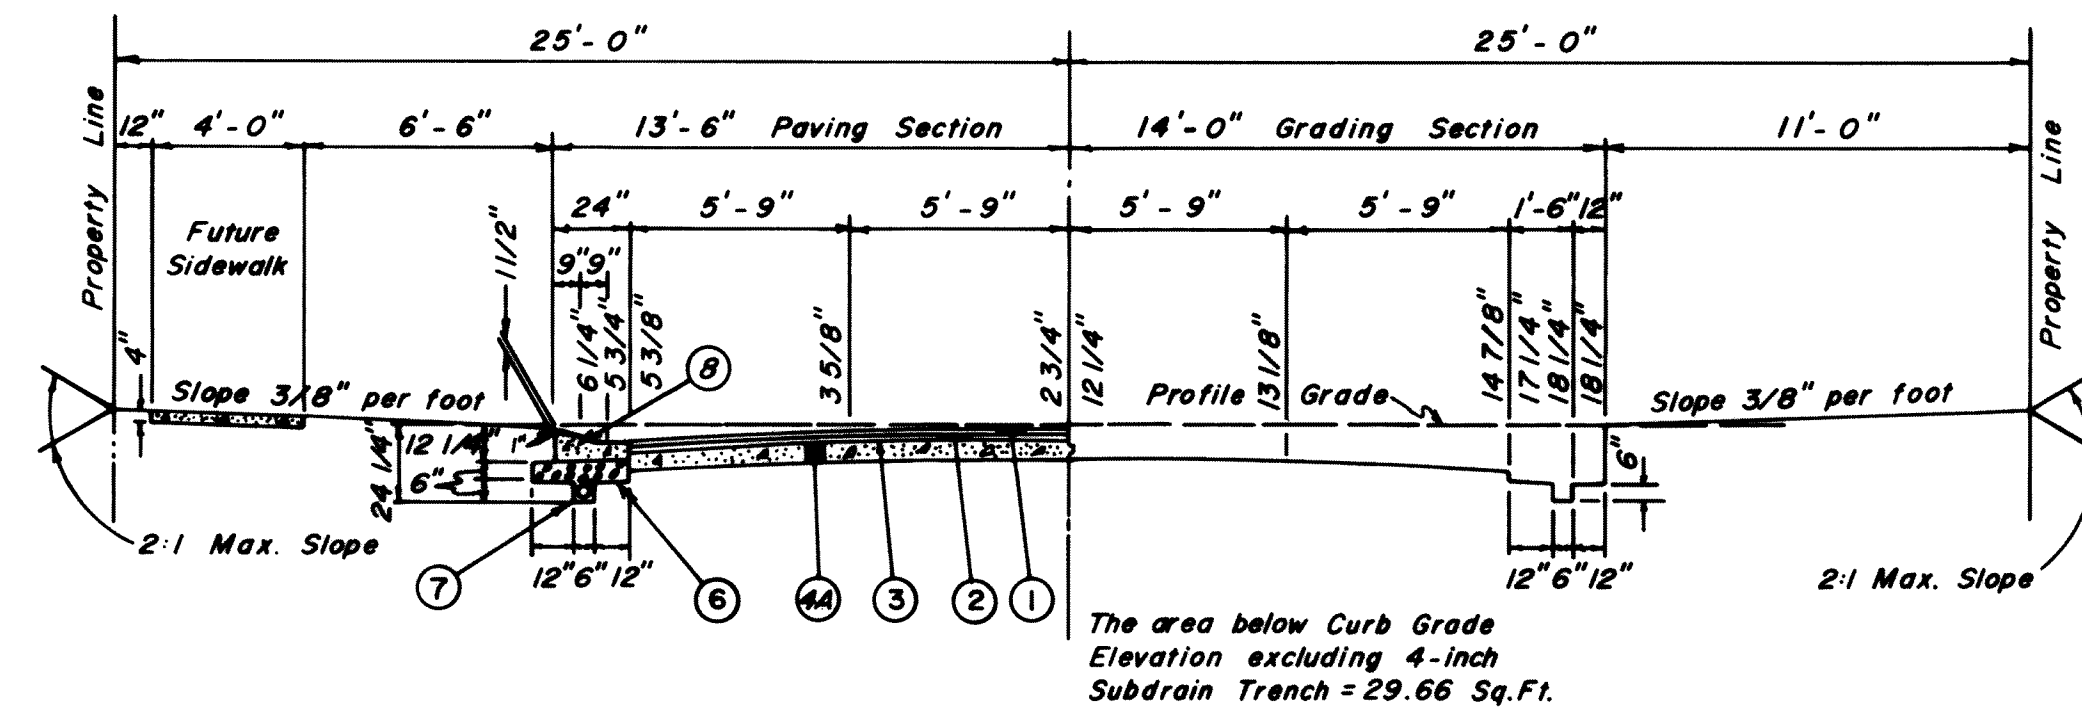


TYPICAL 36' SECTION (60' R/W) BROOKHILL DRIVE

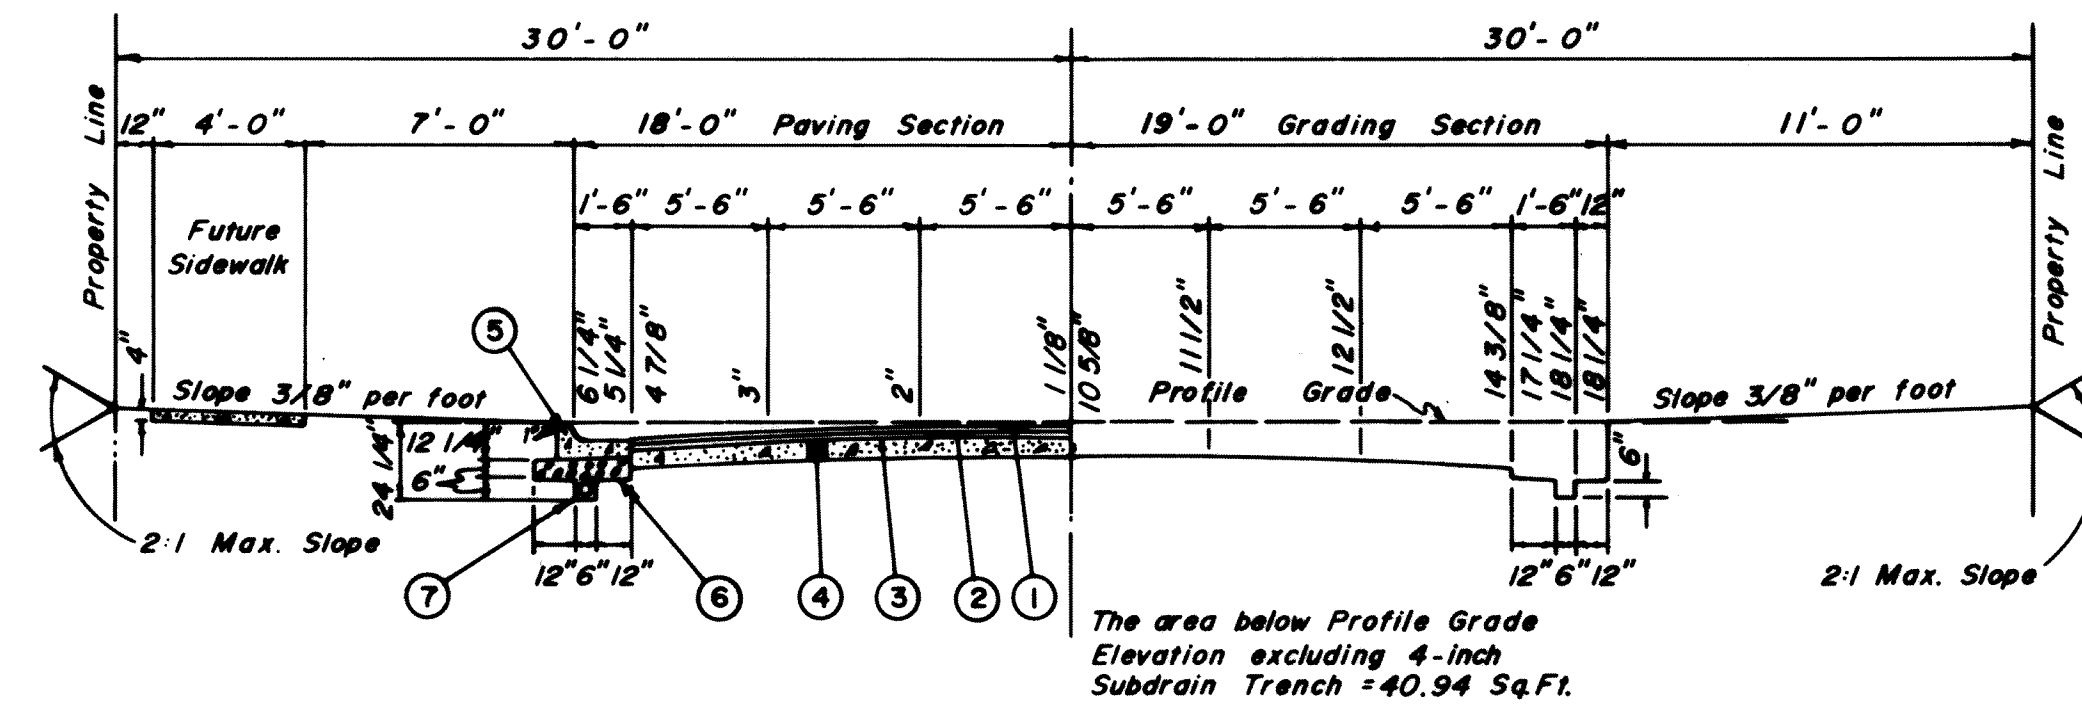

TYPICAL 26' SECTION (50' R/W)

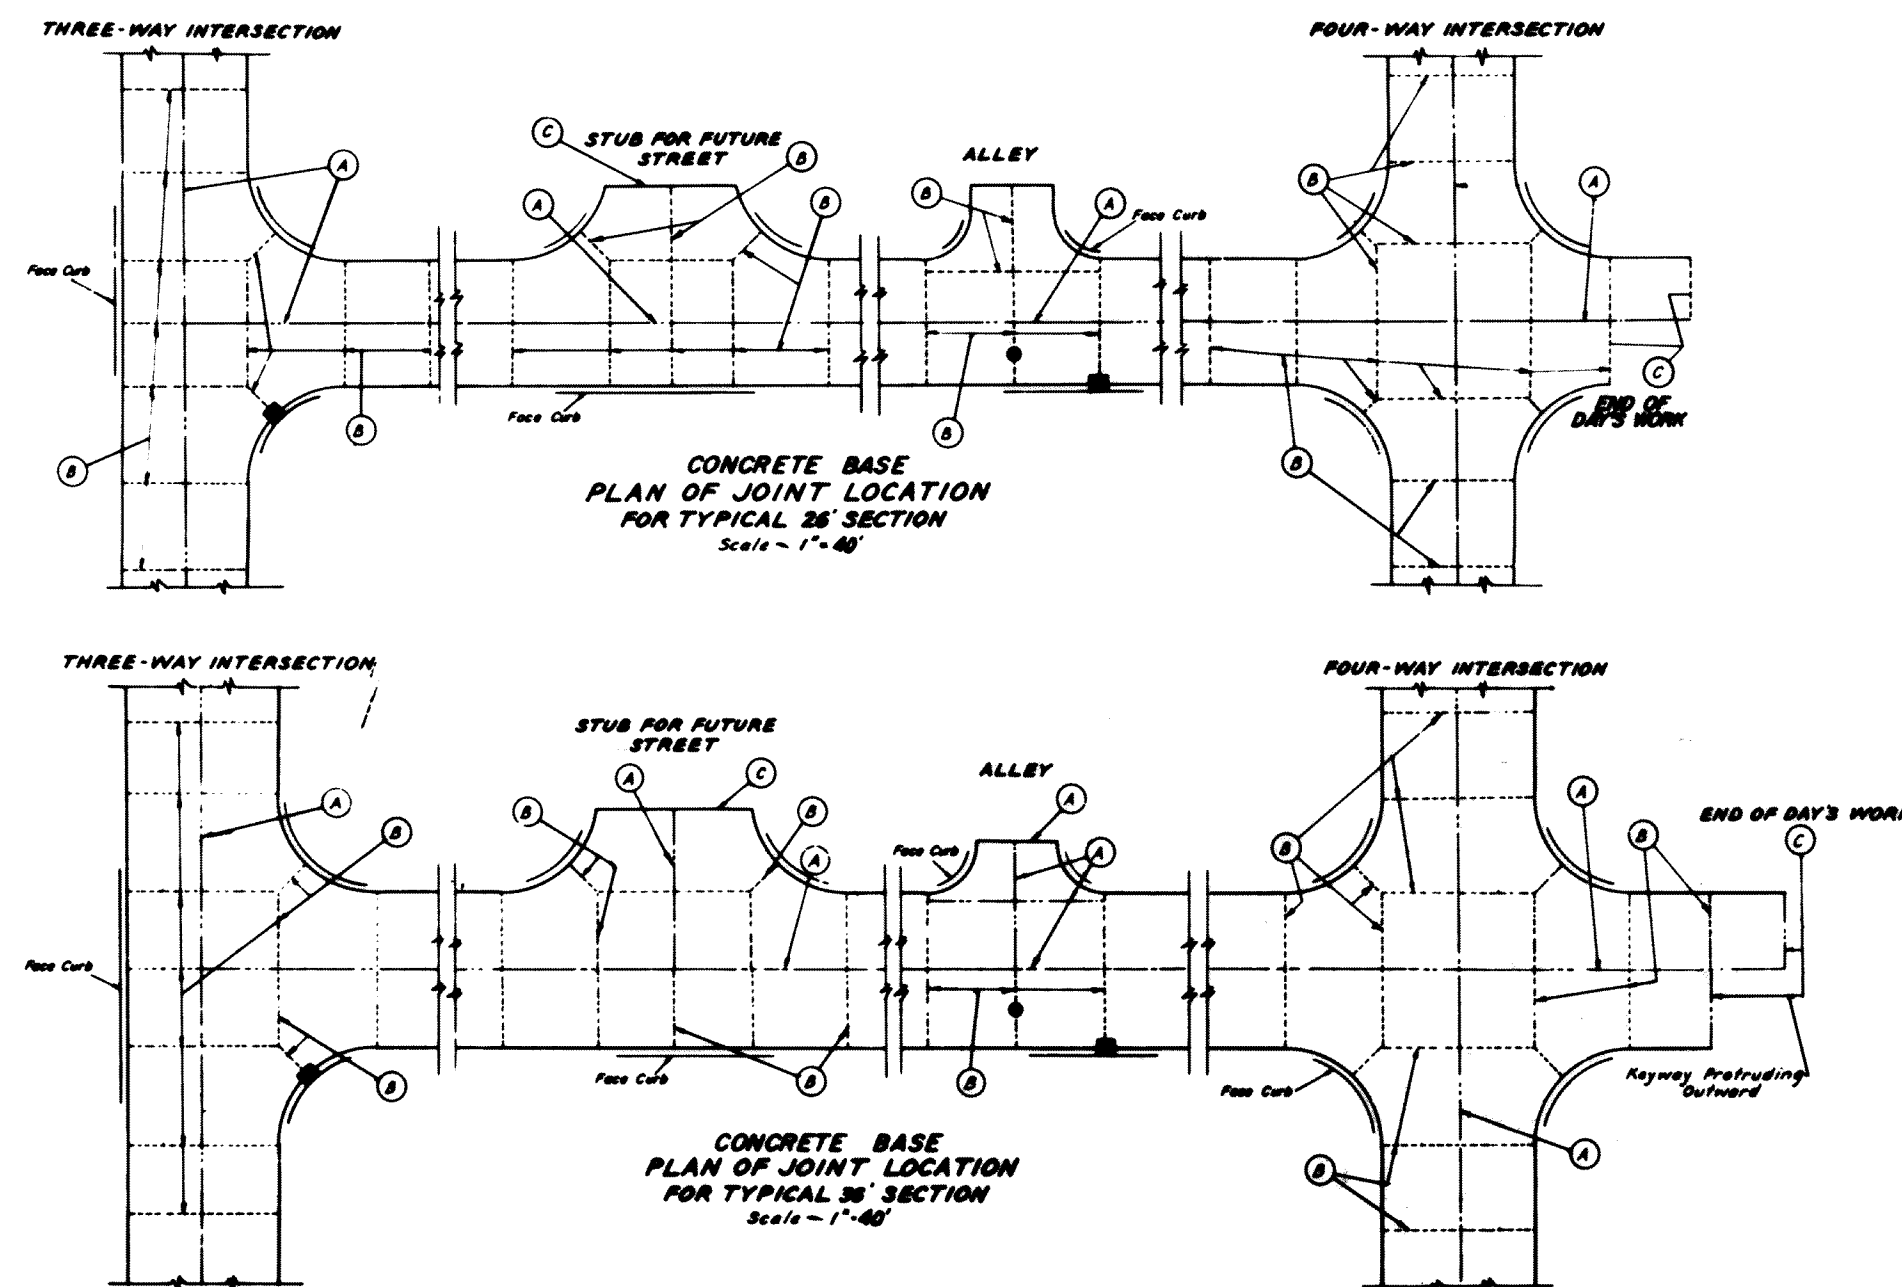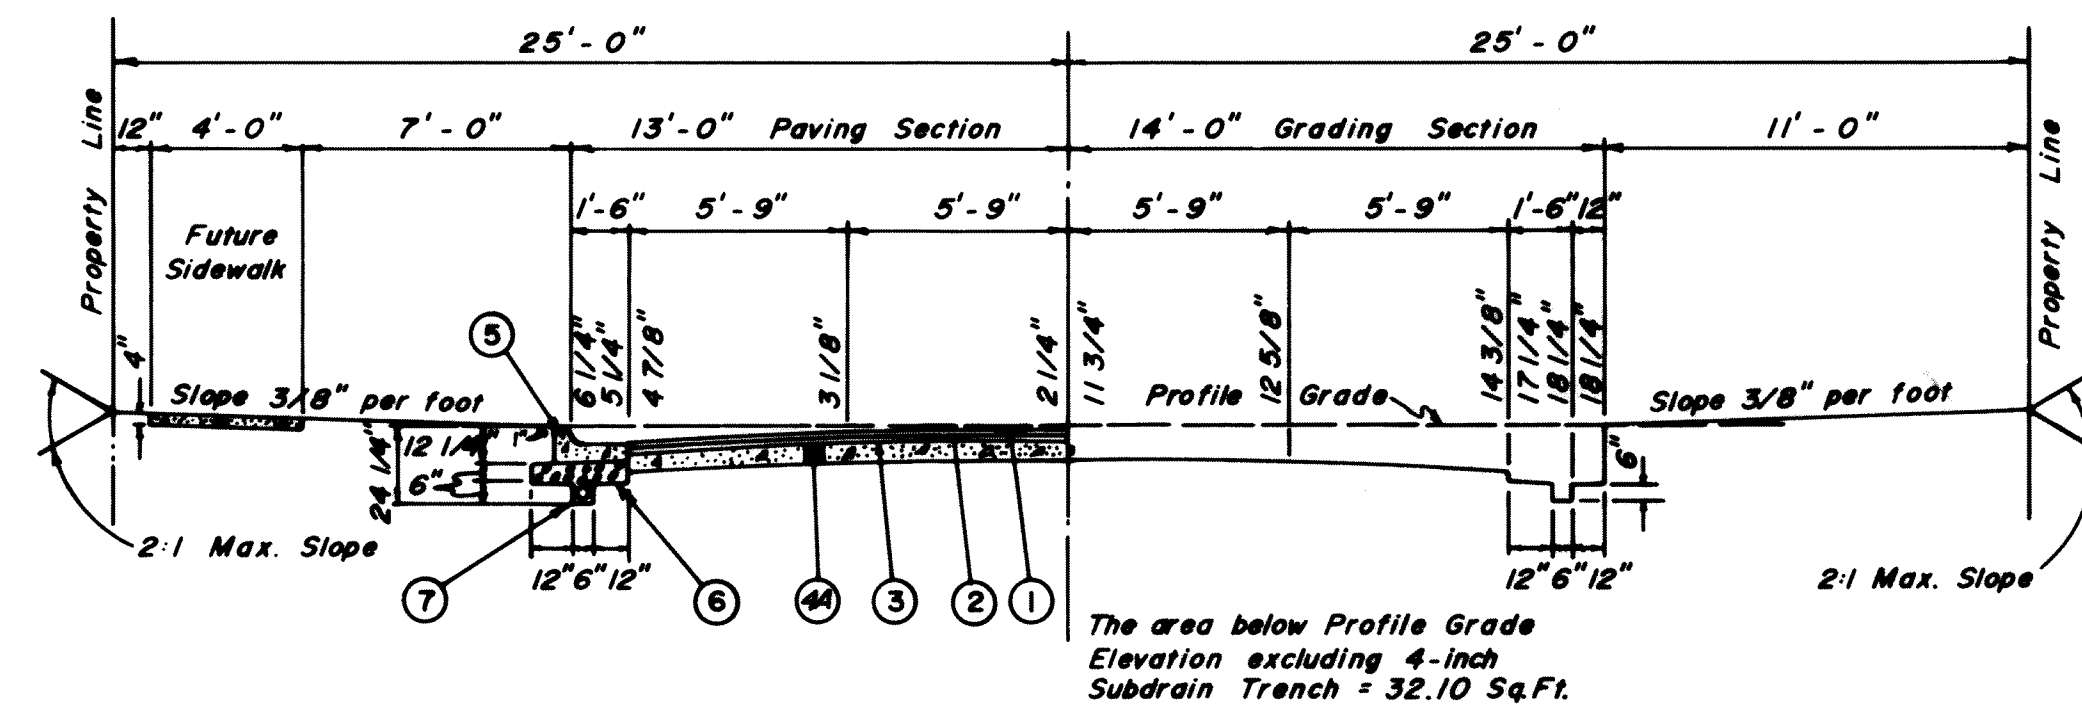

TYPICAL 32' SECTION (60' R/W)

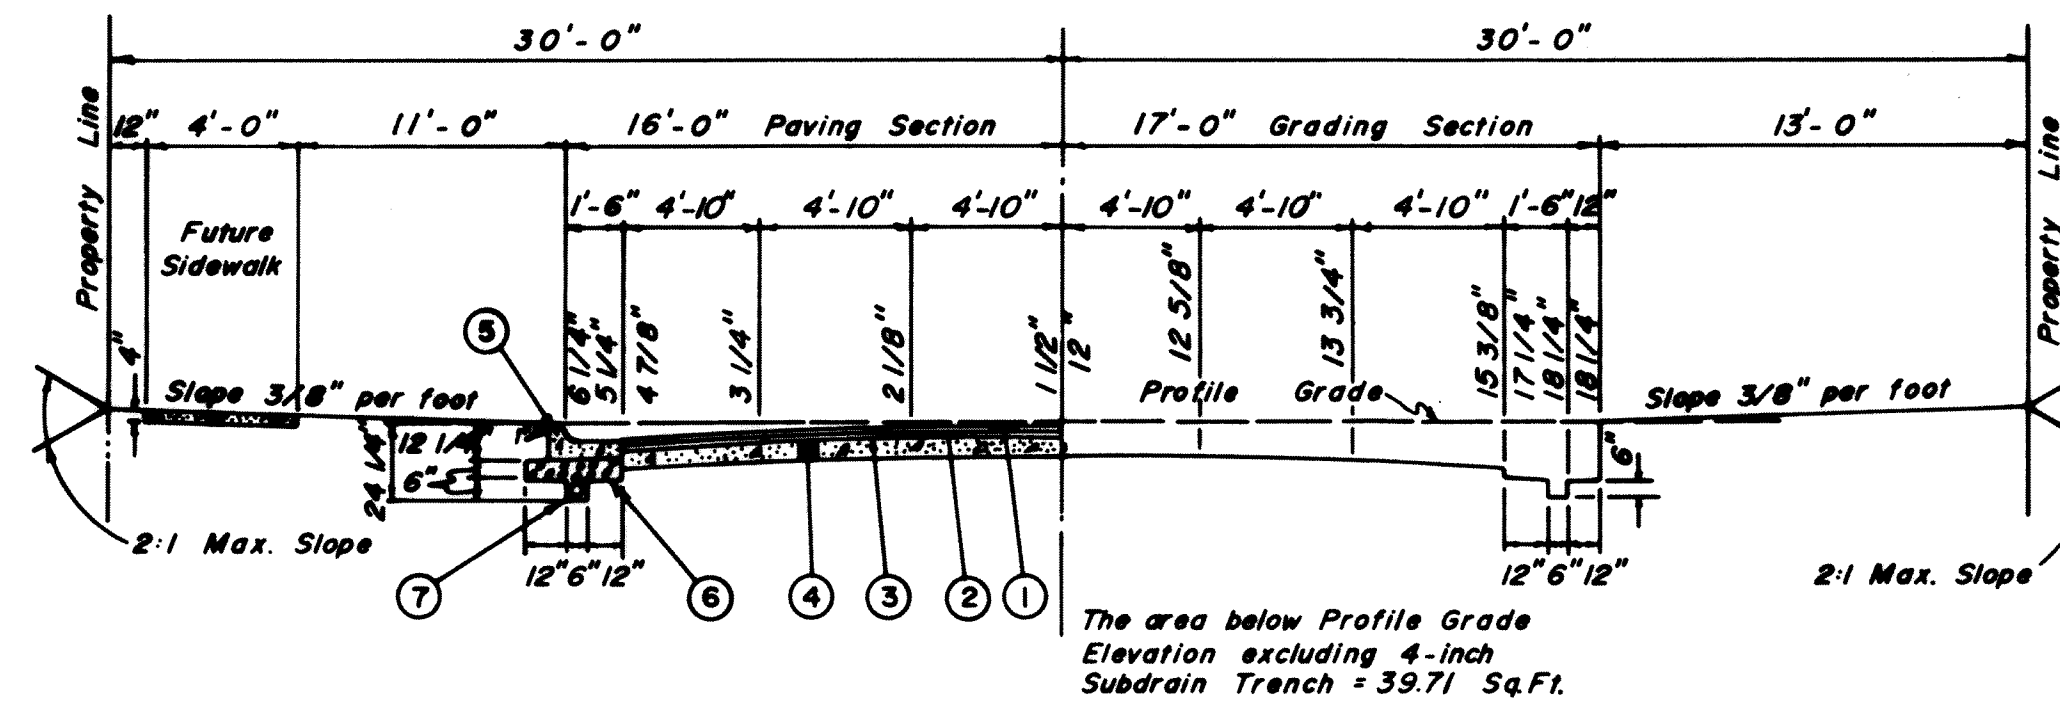

- ①
- ②
- ③
- ④
- ④A
- ⑤
- ⑥
- ⑦
- ⑧

The Specifications of the State of Ohio, Department of Transportation, including all supplements thereto, in force on date of contract, together with the requirements of the City of Gahanna shall govern all materials and workmanship involved in construction.

All item numbers are in accordance with the Ohio Department of Transportation, modified as noted.

① 1 1/4" Hot-Mixed, Hot-Laid Asphalt Concrete, Item 404 (85-100) with Modification to State Highway Specifications Asphalt Concrete shall contain all crushed Aggregate. Joints for Asphalt Concrete shall be staggered.

② 1 1/4" Hot-Mixed, Hot-Laid Asphalt Concrete, Item 402 (85-100).

③ Bituminous Tack Coat, Item 407. Bituminous Material 702.02, RS-1 or an approved equal applied 0.1 Gal. per Sq. Yd. and cover aggregate consisting of crushed gravel or limestone Size No. 9.

④ 8" Portland Cement Concrete Base, Item 305 modified as follows, City of Gahanna, Class E Concrete, 510 lbs. Portland Cement per cubic yard, 3% to 6% Air Entrainment and 3" max. slump. (This item also conforms to City of Columbus Construction & Material Specification Item 305.) The use of an approved single beam vibrating screen will be required and Transverse Contraction Joints shall be sawed as per this plan.

④A 7" Portland Cement Concrete Base, Item 305 modified as follows, City of Gahanna, Class B Concrete, 380 lbs. Portland Cement per cubic yard, 3% to 5% Air Entrainment and 4.5" max. slump. (This item also conforms to City of Columbus Construction & Material Specification, Item 306.) The use of an approved single beam vibrating screen will be required and Transverse Contraction Joints shall be sawed as per this plan.

Centerline Joint for concrete pavement base shall be sawed if pavement base is constructed full width.

A subgrade planer or an automatic subgrader will not be required.

⑤ Concrete Combined Curb & Gutter, Item 609, modified as follows, City of Gahanna, Class F Concrete, 560 lbs. Portland Cement per cubic Yard, 4% to 8% Air Entrainment and 3" max. slump.

⑥ No. 46 Aggregate.

⑦ 4" Pipe Underdrain, Item 605.

⑧ Mountable Curb, Item 609, Concrete, Item 499, modified as follows, City of Gahanna, Class F Concrete, 560 lbs. Portland Cement per cubic yard, 4% to 8% Air Entrainment and 3" max. slump.

Sidewalks and Drive Ramps, Item 608, Concrete, Item 499, modified as follows, City of Gahanna, Class F, 560 lbs. Portland Cement per cubic yard, 4% to 8% Air Entrainment and 4" max. slump.

Curing Material shall conform to 705.07, Type 2, and shall be applied with a motor driven pump sprayer.


Sidewalk location shall be determined by the City Engineer.

When the pavement design shown on the typical sections is not adequate for contemplated heavier load requirements, the proposed street sections shall be designed in accordance and agreement with the City Engineer.

In the event excavation for the street is from 0" to 6" below that called for on the plans, the Contractor shall replace this excess excavation material with compacted 46D crushed aggregate as directed, and at no extra cost to the Owner.


Mountable Curb may be used on 26' Residential Streets, subject to approval by the City Engineer. All other streets shall be built using combined curb and gutter.

Two or more curb openings for each lot shall be provided for downspout drains at the time of the permanent construction. Cost to be included in the price bid for Item 609. All curb openings provided after curb construction shall be drilled or sawed for downspout drain placement. (Saw Cut Width 1'-0")

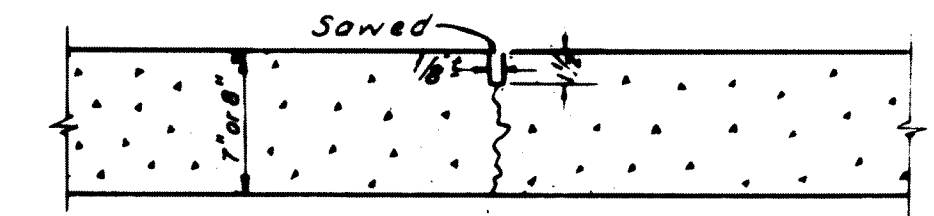


CONTRACTION JOINT ⑧


Maximum spacing of Sawed Joints shall be 20'
Maximum spacing of Sawed Joints for Service Road shall be 15'

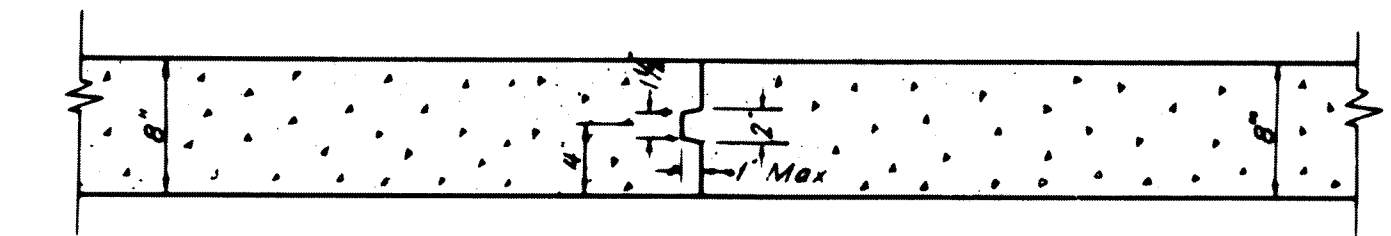


JOINT A & C

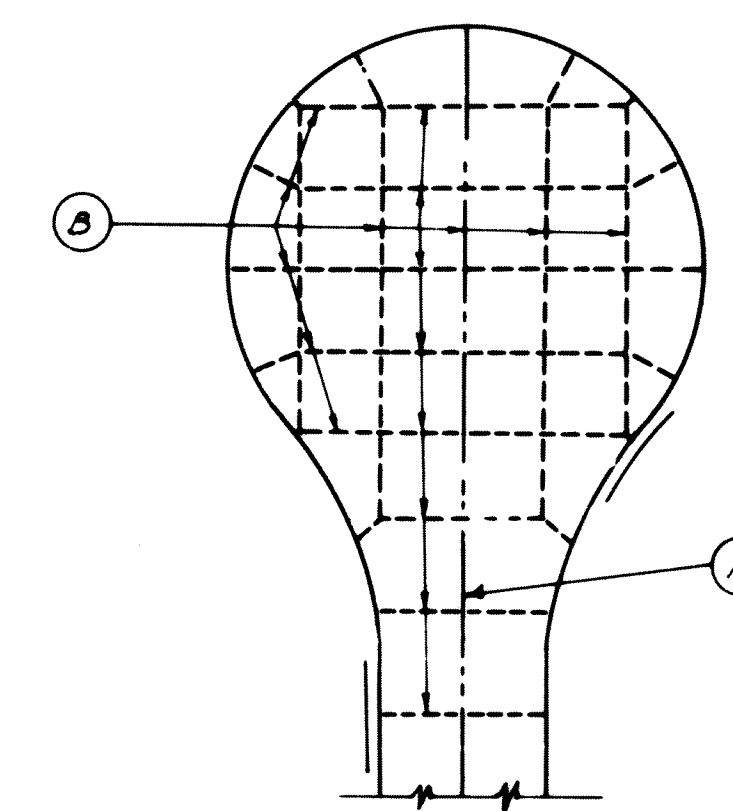

**CUL-DE-SAC
FULLY PAVED
Scale = 1" = 30'**

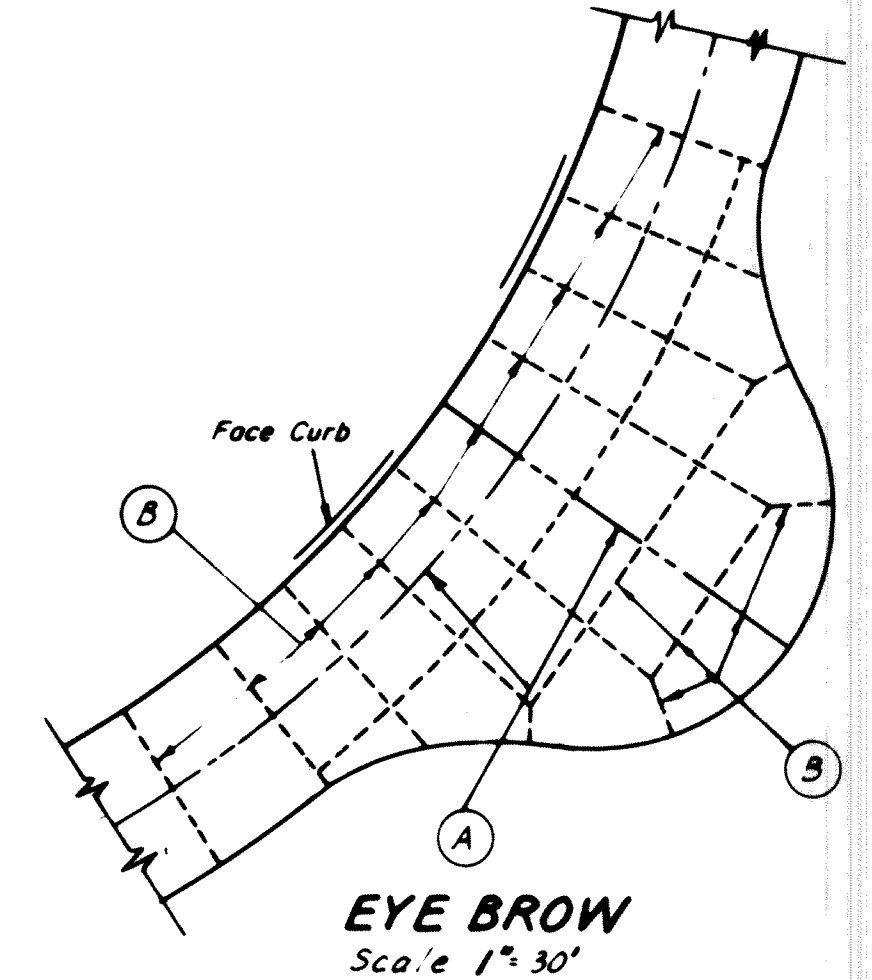


**EYE BROW
Scale 1" = 30'**

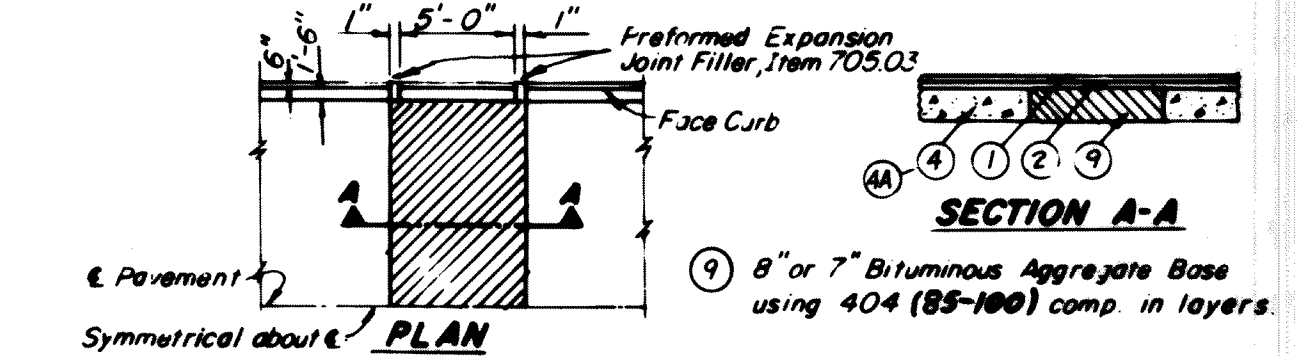


DETAIL OF EXPANSION JOINT


Expansion Joints shall be constructed where shown on the plans. The Bituminous Aggr. Base shall be paid for at the price bid per Cu Yd. for Item 404 Asphalt Concrete.

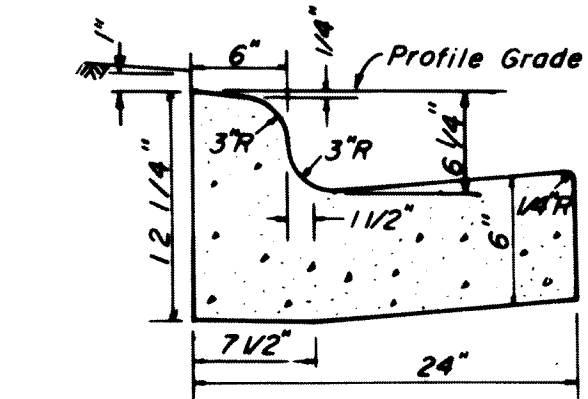

COMBINATION CURB & GUTTER

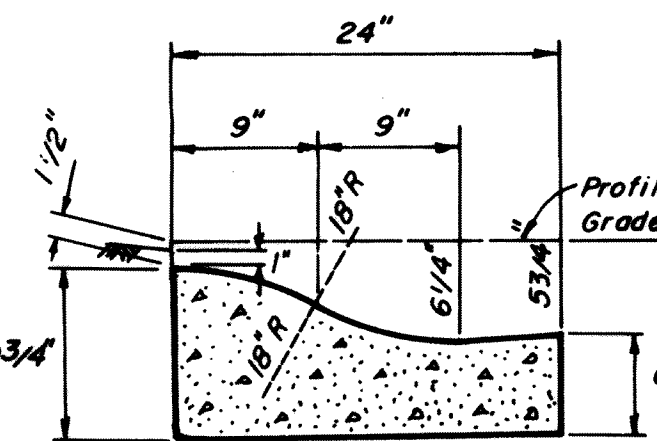

MOUNTABLE CURB

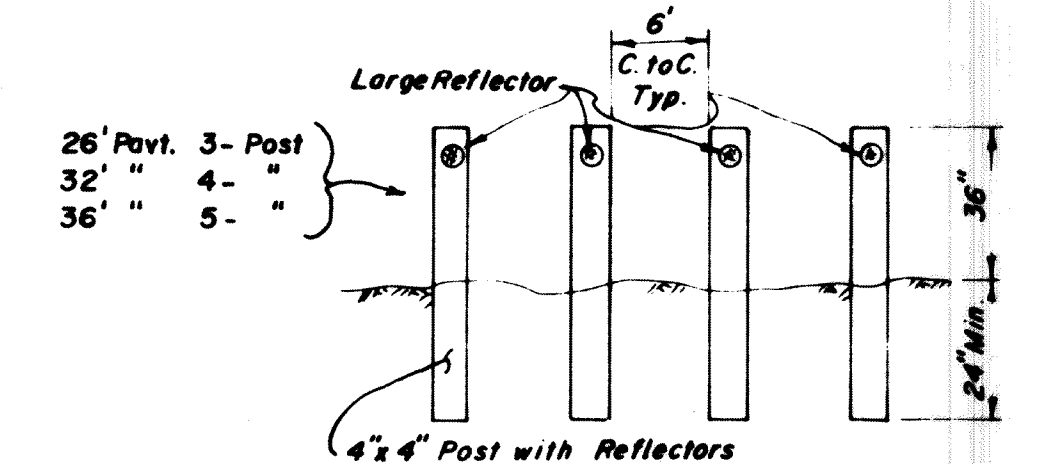

DETAIL OF TEMPORARY BARRICADE

**PRIVATE STREET & WATER IMPROVEMENT # 238
RESUBDIVISION OF CHERRY BOTTOM
SECTION 1**

CITY OF GAHANNA, OHIO	
STANDARD CONSTRUCTION DRAWING	
CONSTRUCTION DETAILS FOR ASPHALT CONCRETE ON P.C. CONCRETE BASE	
Approved: <i>William B. Roeder</i> CITY ENGINEER, GAHANNA OHIO <i>Richard V. Warren</i> DIRECTOR OF PUBLIC SERVICE, GAHANNA OHIO	DATE 2/7





Temporary Repaving-shall consist of spreading and compacting of aggregate base. item 304

Permanent Repaving - shall consist of 6" of 304 aggregate base and 6" of 404 asphalt concrete. Cost to be included in price bid for storm sewer.

Curb Data (N)
 $\Delta = 90^{\circ}00'00''$
 $R = 30'$
 $T = 30'$
 $L = 47.12'$



Curb Data (S)
 $\Delta = 85^{\circ}32'43''$
 $R = 30'$
 $T = 27.75'$
 $L = 44.79'$



NOTE: Approach to be constructed of same material as permanent improvement. Curb height shall vary from 6" to 1" in 20' at ends of returns.

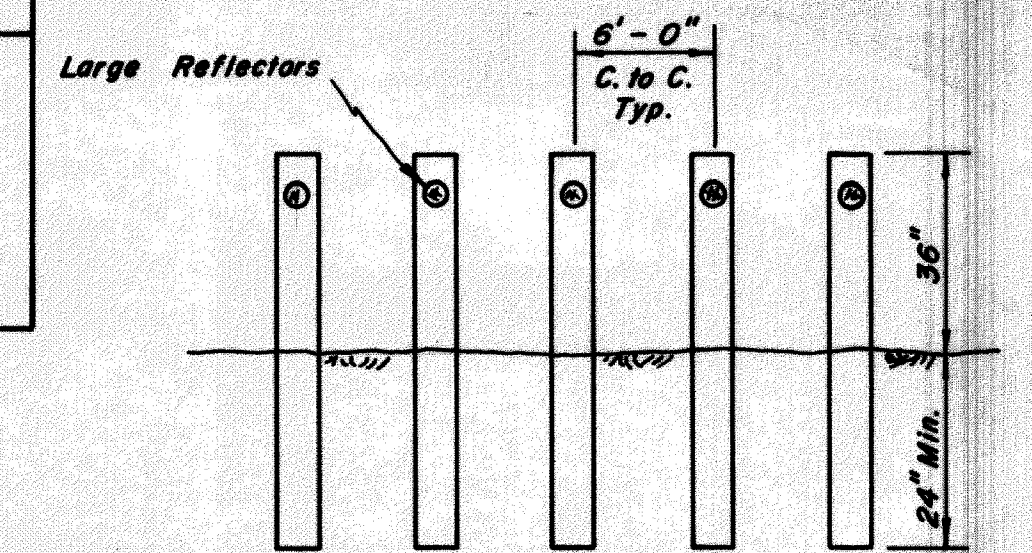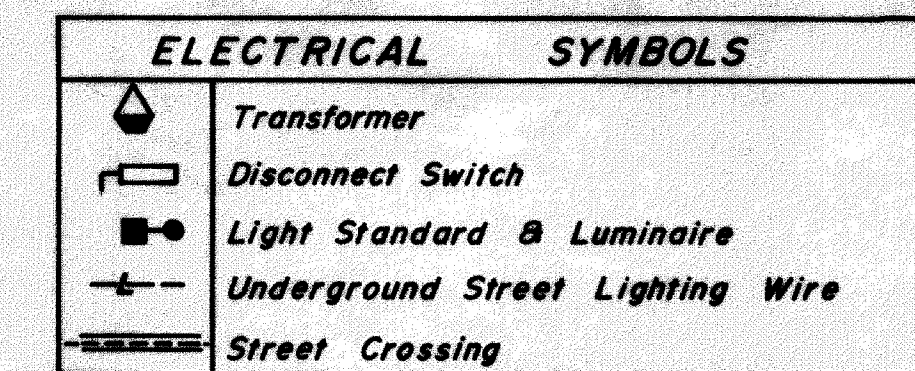

5 - 4" x 4" Post with Reflectors (36' Pavt.)
4 - 4" x 4" Post with Reflectors (26' Pavt.)

DETAIL OF TEMPORARY BARRICADE

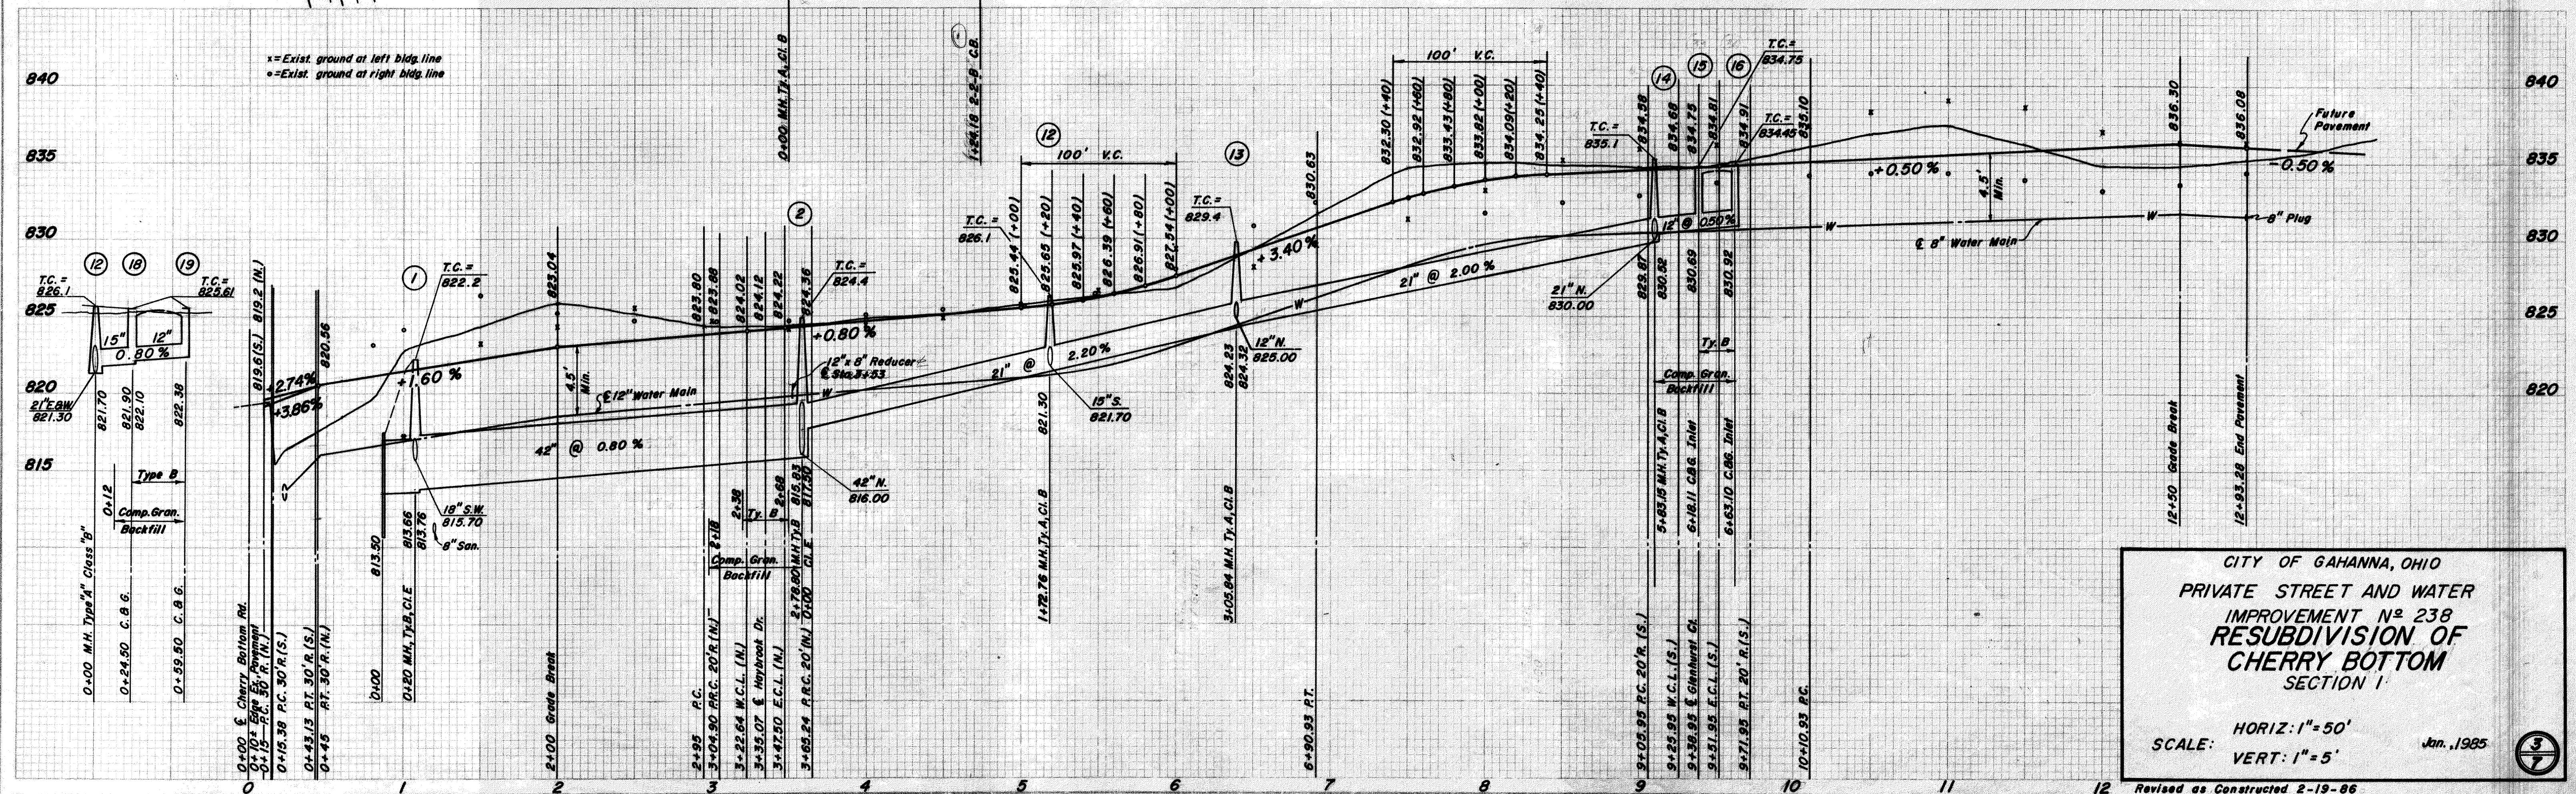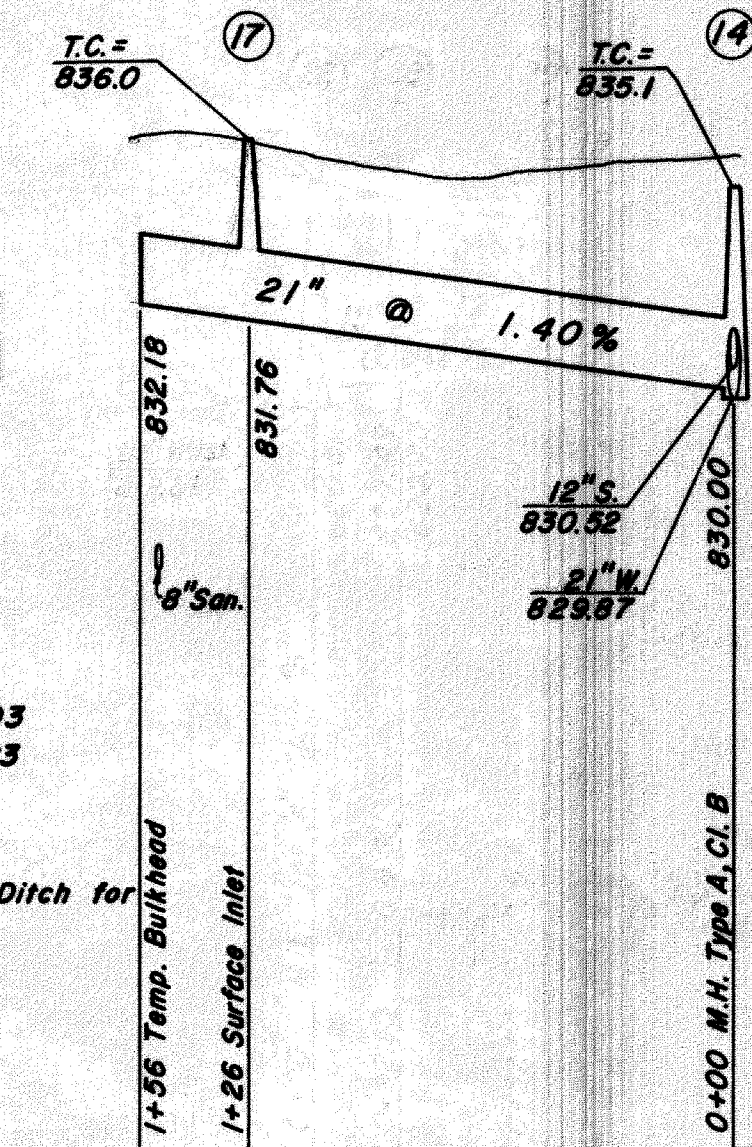

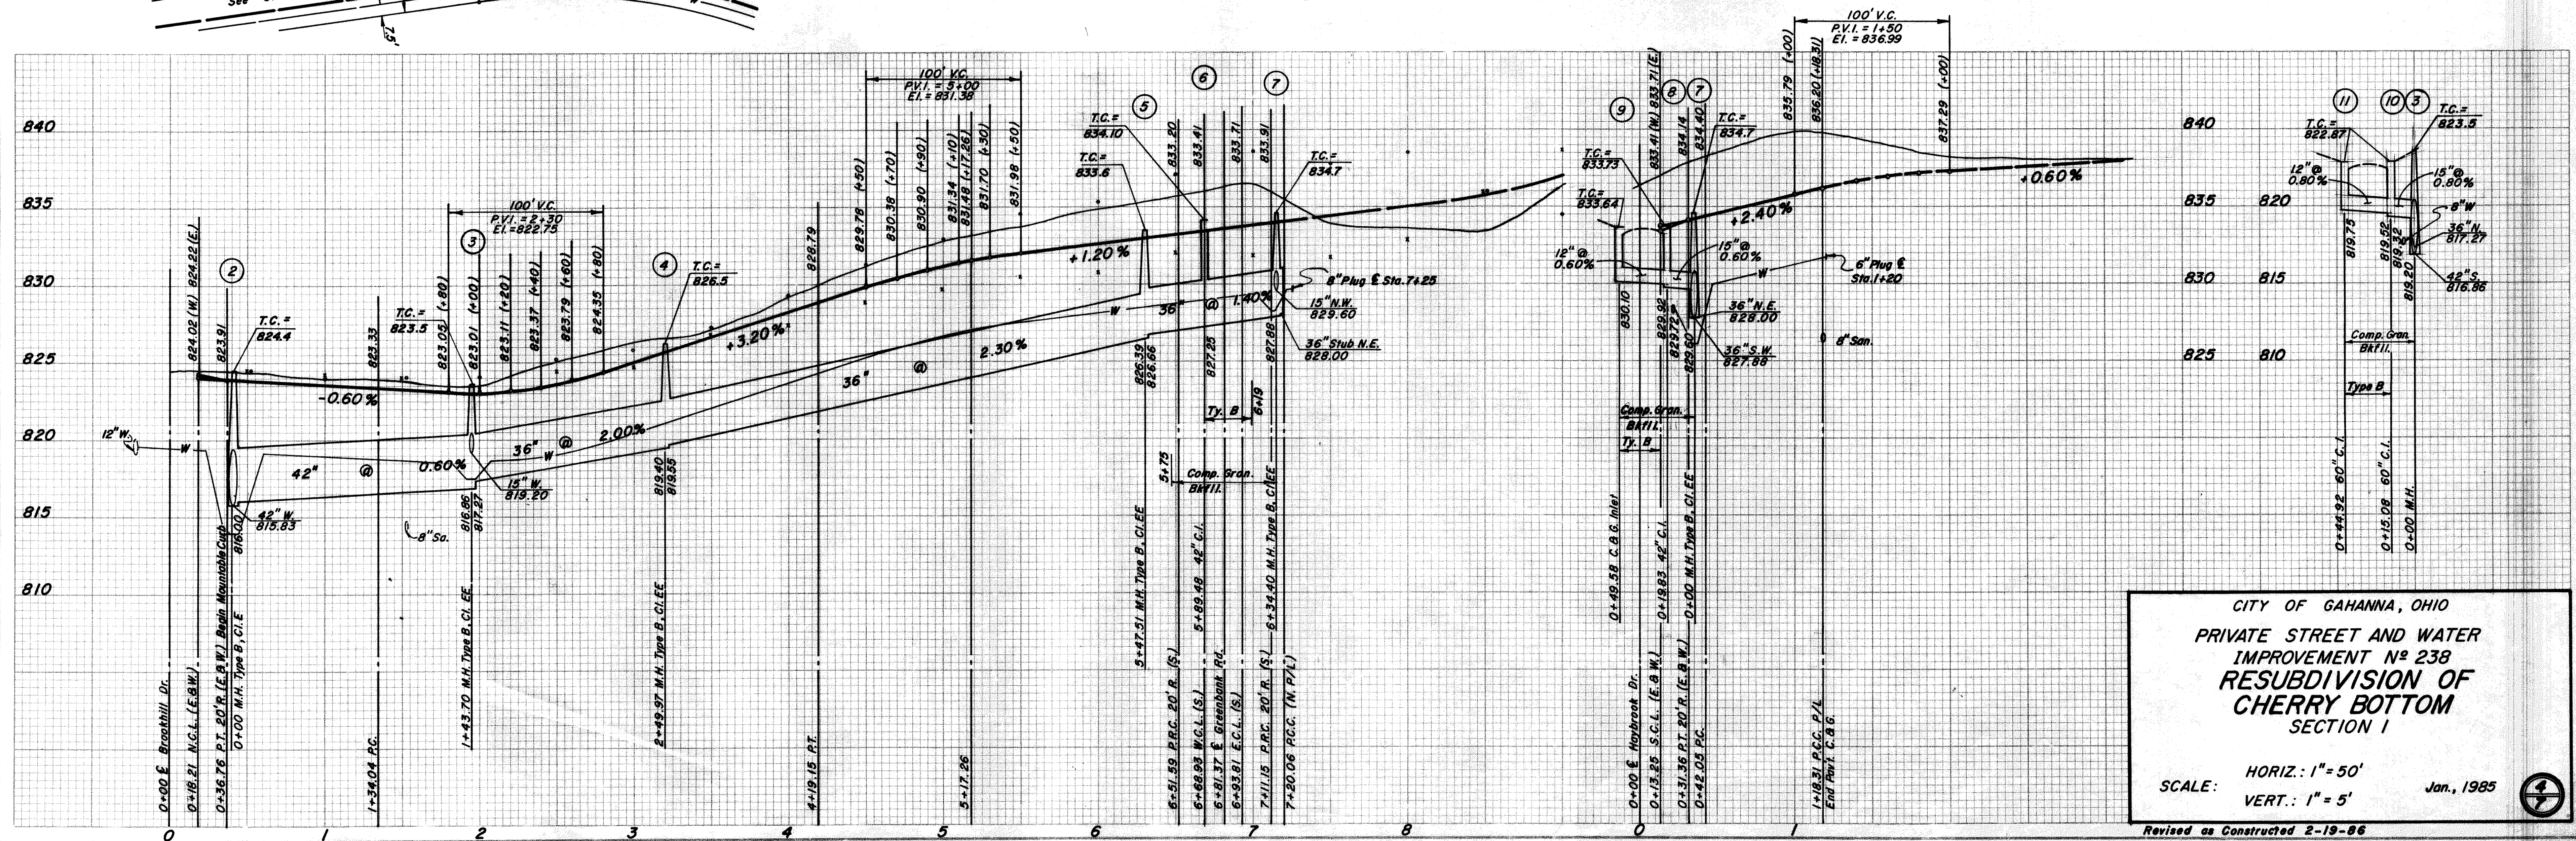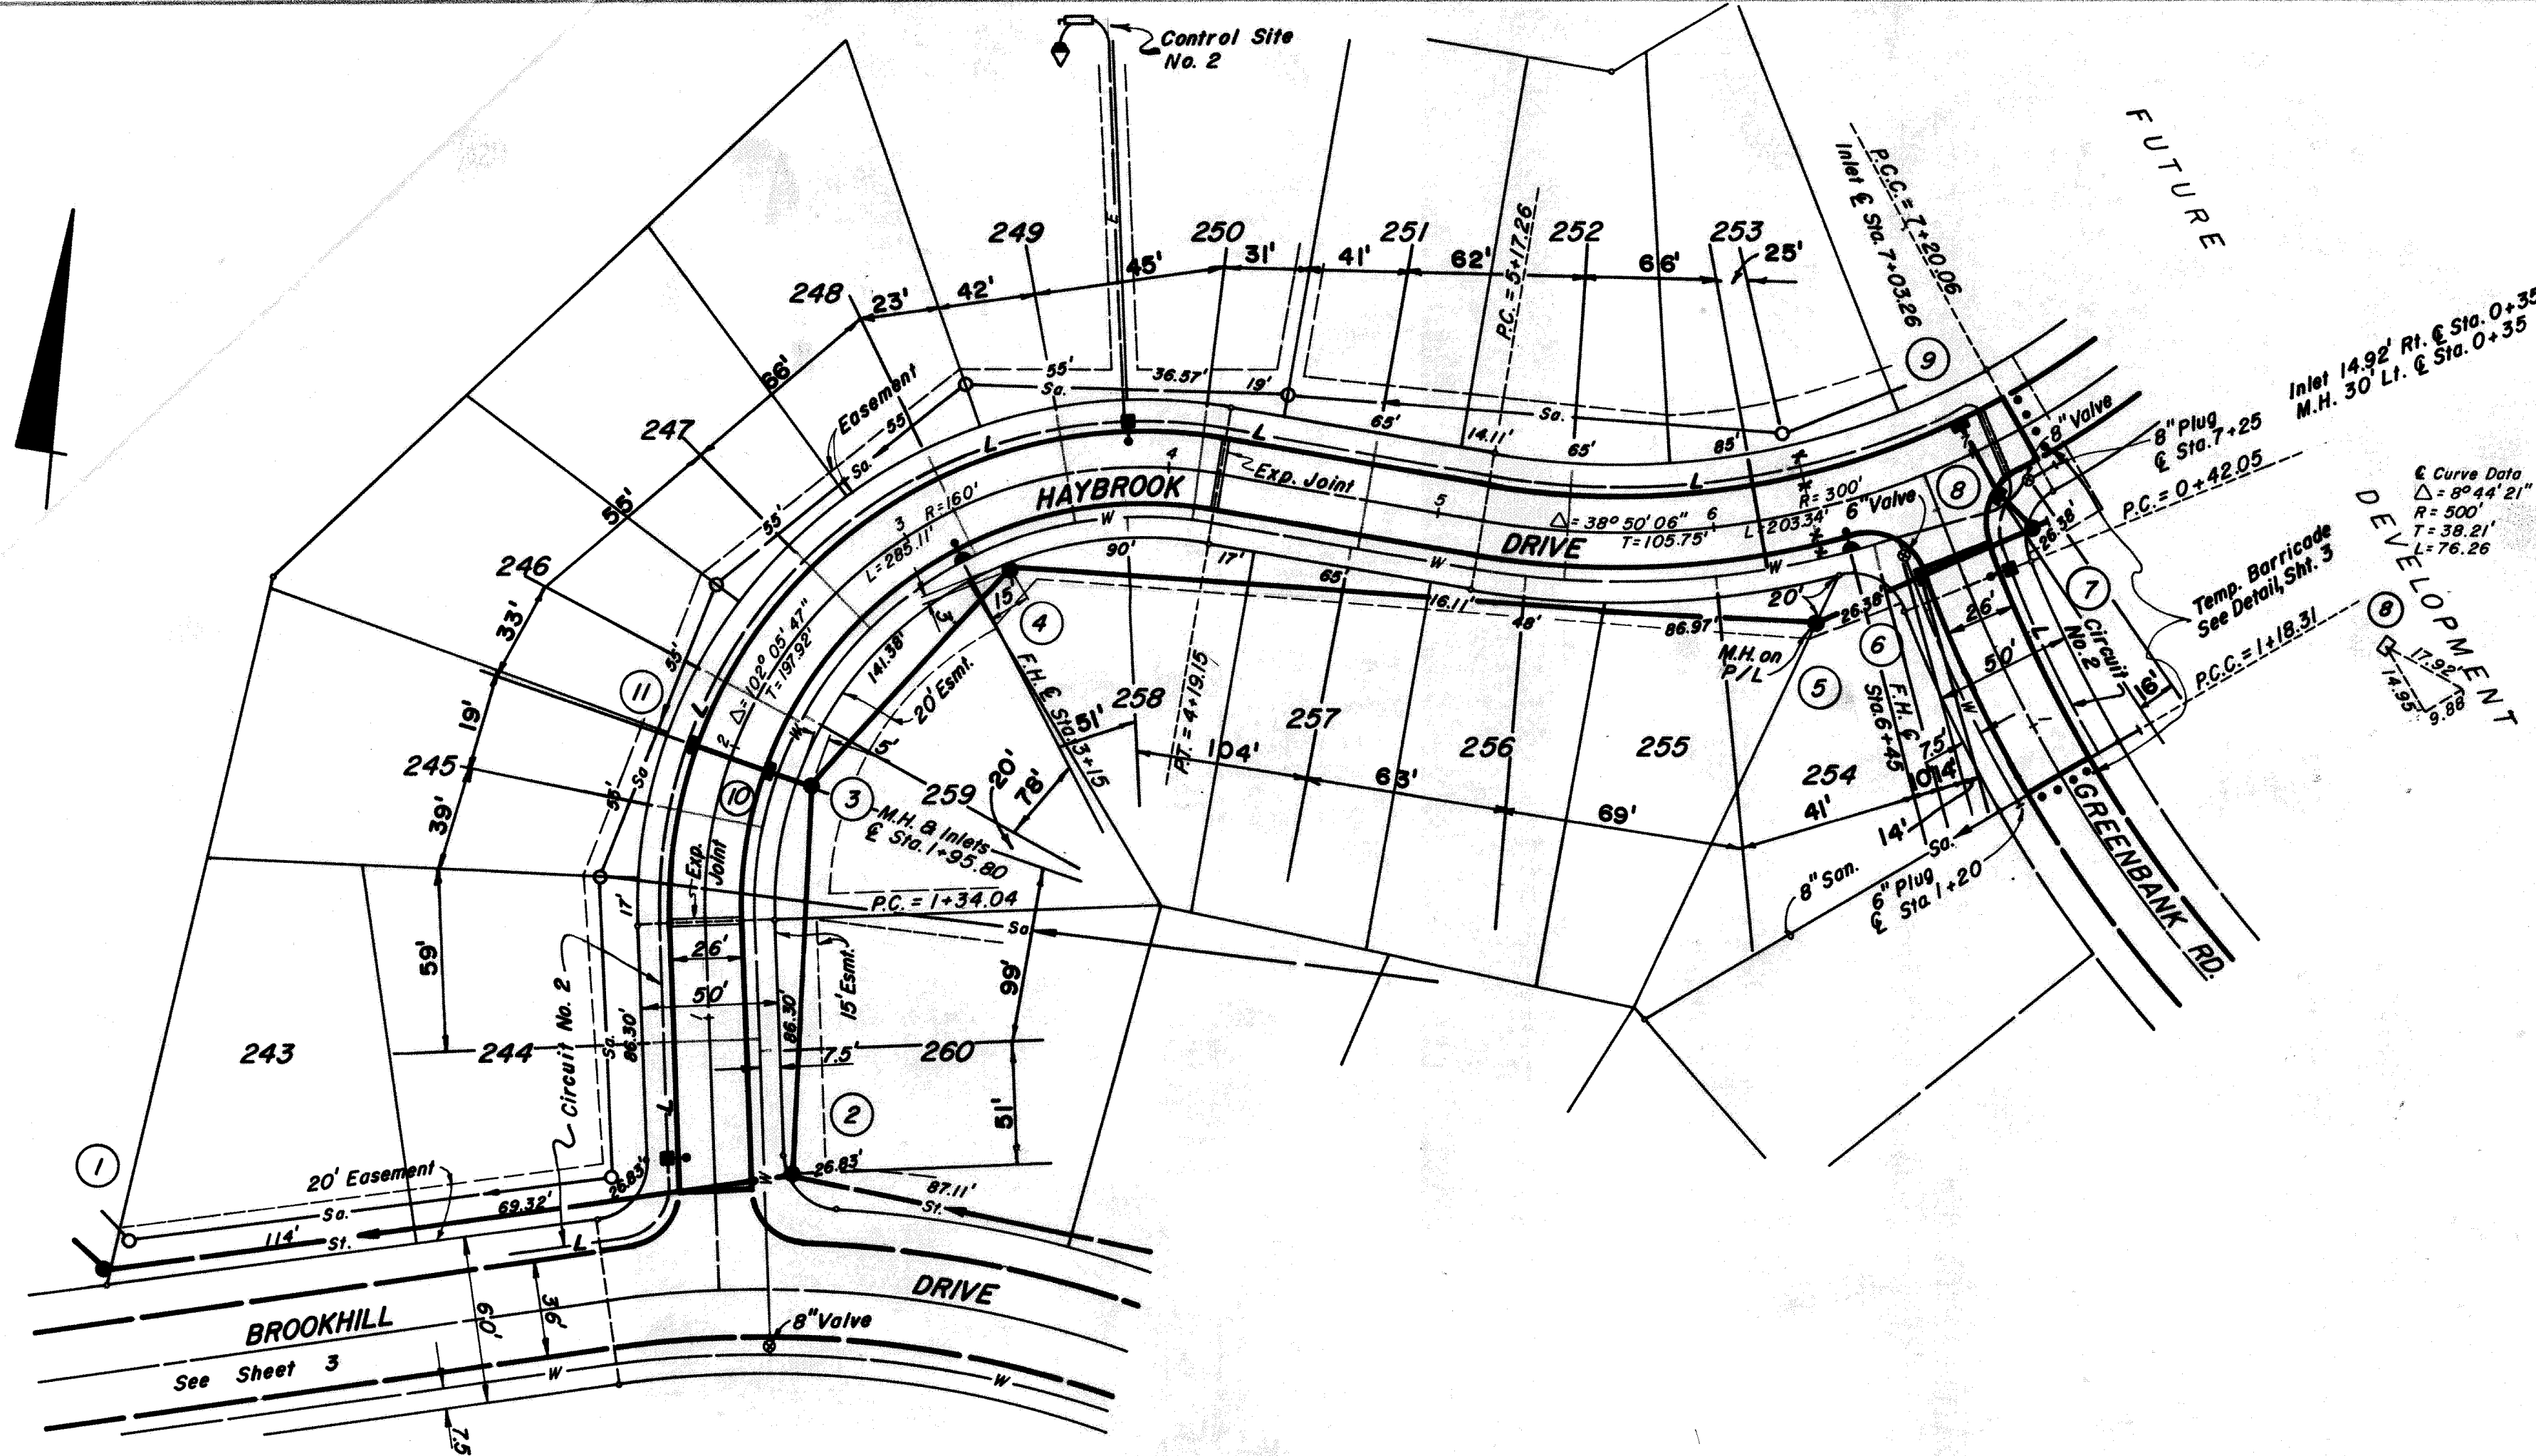


CITY OF GAHANNA, OHIO
 PRIVATE STREET AND WATER
 IMPROVEMENT No 238
 RESUBDIVISION OF
 CHERRY BOTTOM
 SECTION I

SCALE: HORIZ.: 1" = 50'
 VERT.: 1" = 5'

Jan., 1985



Revised as Constructed 2-19-86

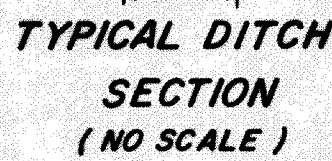

CITY OF GAHANNA, OHIO
PRIVATE STREET AND WATER
IMPROVEMENT No 238
**RESUBDIVISION OF
CHERRY BOTTOM**
SECTION I

SCALE: HORIZ: 1" = 50'
VERT: 1" = 5'

Jan., 1985

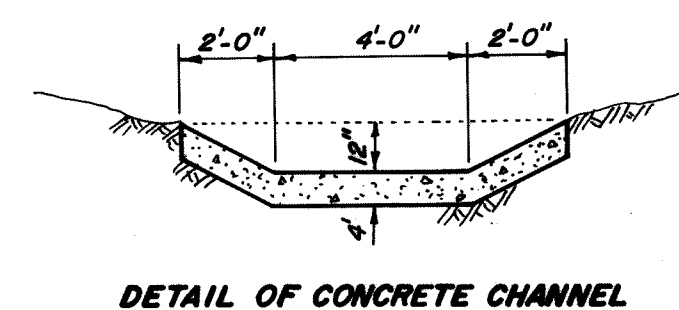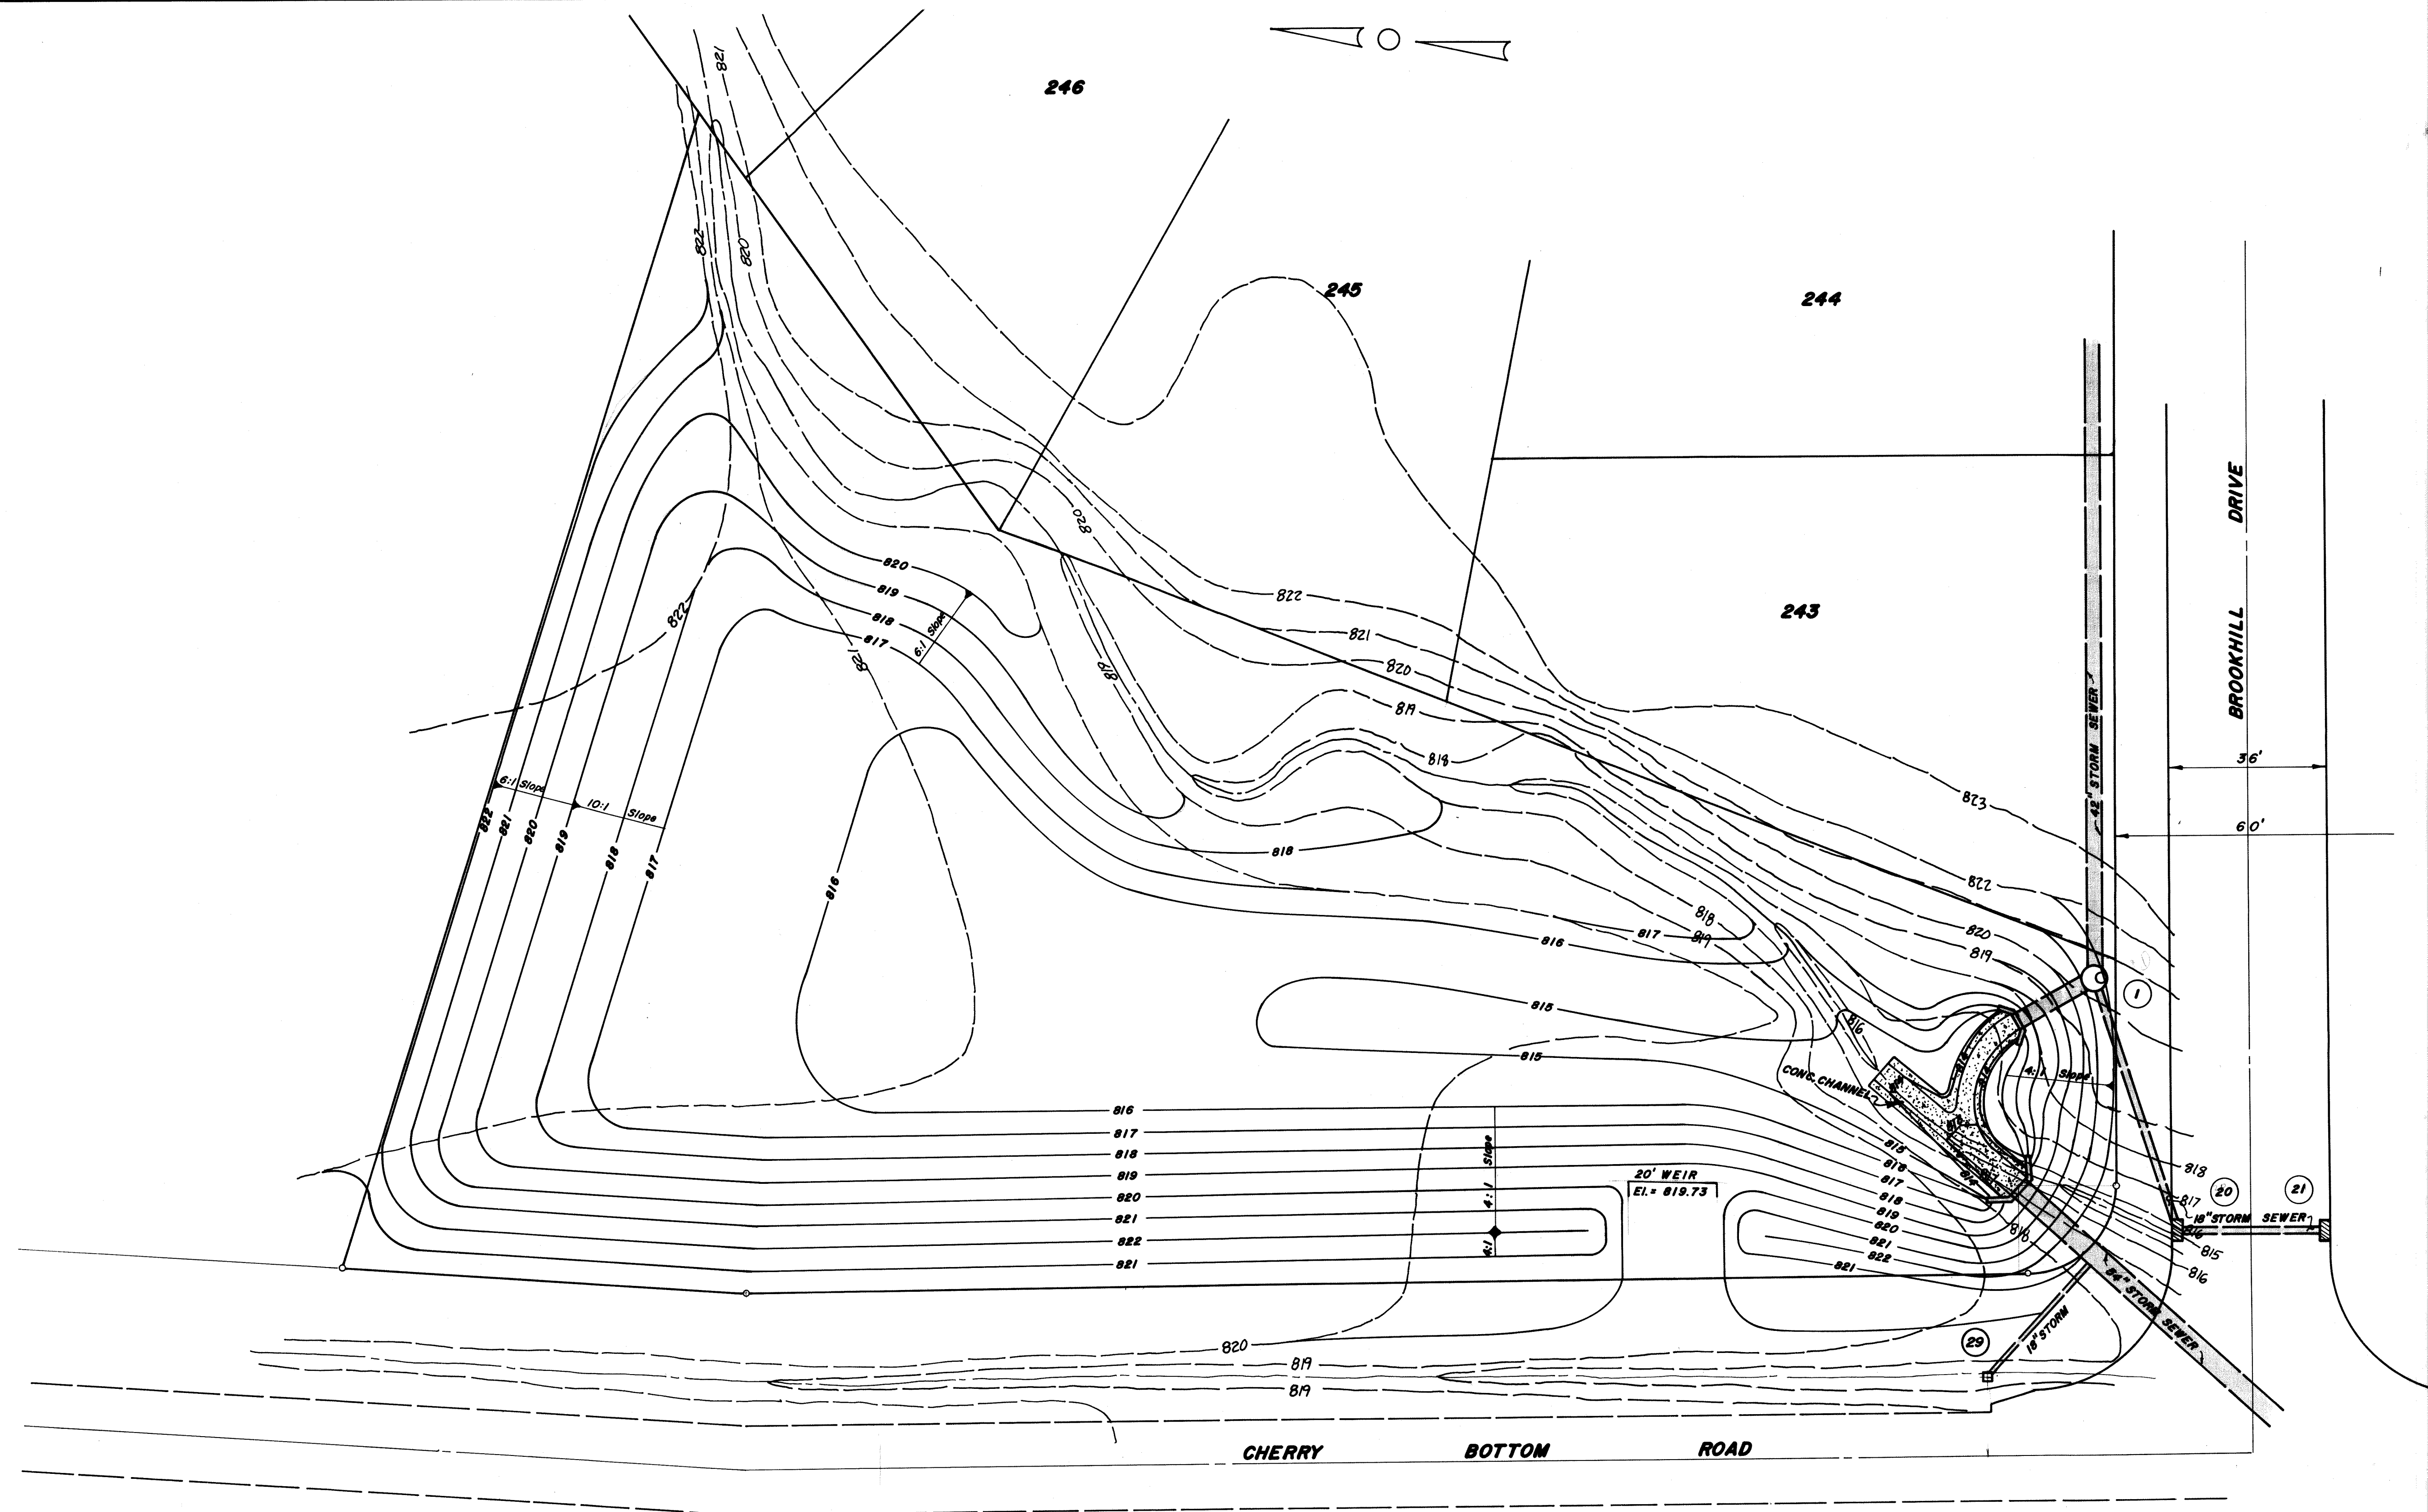

CITY OF GAHANNA, OHIO
PRIVATE STREET AND WATER
IMPROVEMENT NO. 238
**RESUBDIVISION OF
CHERRY BOTTOM
SECTION I**

Scale: 1" = 20'

Jan., 1985



ST-238

GENERAL NOTES

SPECIFICATIONS: The accompanying Specifications, together with the City of Columbus Construction and Material Specifications, including all supplements thereto, in force on date of contract shall govern all materials and workmanship involved in the improvements shown on these plans except as such specifications are modified by the following specifications or by the construction details set forth herein.

PERMITS: The Contractor shall obtain all necessary permits.

SAFETY REQUIREMENTS: The Contractor and Sub-Contractor shall be solely responsible for all federal, state and local safety requirements, together with exercising precautions at all times for the protection of persons (including employees) and property. It is also the sole responsibility of the Contractor and Sub-Contractor to initiate, maintain and supervise all safety requirements, precautions and programs in connection with this work.

MISCELLANEOUS WORK: All items of work called for on the plans for which no specific method of payment is provided, including the restoration of disturbed or damaged property to its original state, shall be performed by the Contractor and the cost of same shall be included in the price for the various related Bid Items.

FIELD TILE: All field tile broken during excavation shall be replaced to its original condition or connected to either the curb subdrain or to the storm sewer system as directed by the Engineer.

WATER MAINS: All water mains shall be either Ductile Iron Class 54 (12" and larger), or Polyvinyl Chloride (PVC) C900. All bends, joint deflections and fittings shall be backed with concrete where and as directed. Where water mains or services cross proposed or existing streets, backfill shall be compacted granular material, Item 310, within limits 5 feet outside the edge of pavement or curb extended from the bottom of the trench to a plane 6 inches below the subgrade. The services may be jacked across the street in lieu of open cut and the use of granular backfill.

CHLORINATION OF WATER MAINS: The Contractor shall make arrangements to have the water mains chlorinated by the City of Columbus. The cost of chlorination shall be included in the price bid for the various water main items.

EXISTING UTILITIES: The identity and location of the existing underground utility facilities known to be located in the construction area have been shown on the plans as accurately as provided by the Owner of the underground utility. The City of Gahanna and/or Engineer assumes no responsibility for the accuracy or the depths of the underground facilities shown on the plans.

Location, support, protection and restoration of all existing utilities and appurtenance shall be the responsibility of the Contractor. The cost of this work shall be included in the price bid for the various items.

The Contractor shall cause notice to be given to the Ohio Utilities Protection Service (telephone 800-362-2764 - toll free) and to the Owners of underground utility facilities shown on the plans who are not members of a registered underground protection service in accordance with Section 153.64 of the Revised Code. The above mentioned notice shall be given at least 72 hours prior to start of construction.

The following utilities are located within the work limits of this project and the Owners do not subscribe to a registered underground utility protection service:

UTILITY	OWNER	TELEPHONE NUMBER
Water & Sewer	City of Gahanna	614-471-3827

The construction of this project is contingent on the approval of the City of Columbus, Ohio, to tap the existing 12" water main along Tishman Road.

Two-way, one-lane traffic may be maintained on Blatt and Taylor Road during construction operations, in accordance with Page C-18 of the Ohio Manual.

All trenches shall be backfilled or securely plated during non-working hours.

Access to all adjoining properties shall be maintained at all times.


Steady-burning, Type "C" lights shall be required on all barricades, drums, and similar control devices in use at night.

CITY OF GAHANNA OHIO

WATER IMPROVEMENT NO. 253

BLATT BLVD. - TISHMAN AVE. - MORRISON RD.

AN ASSESSMENT IMPROVEMENT

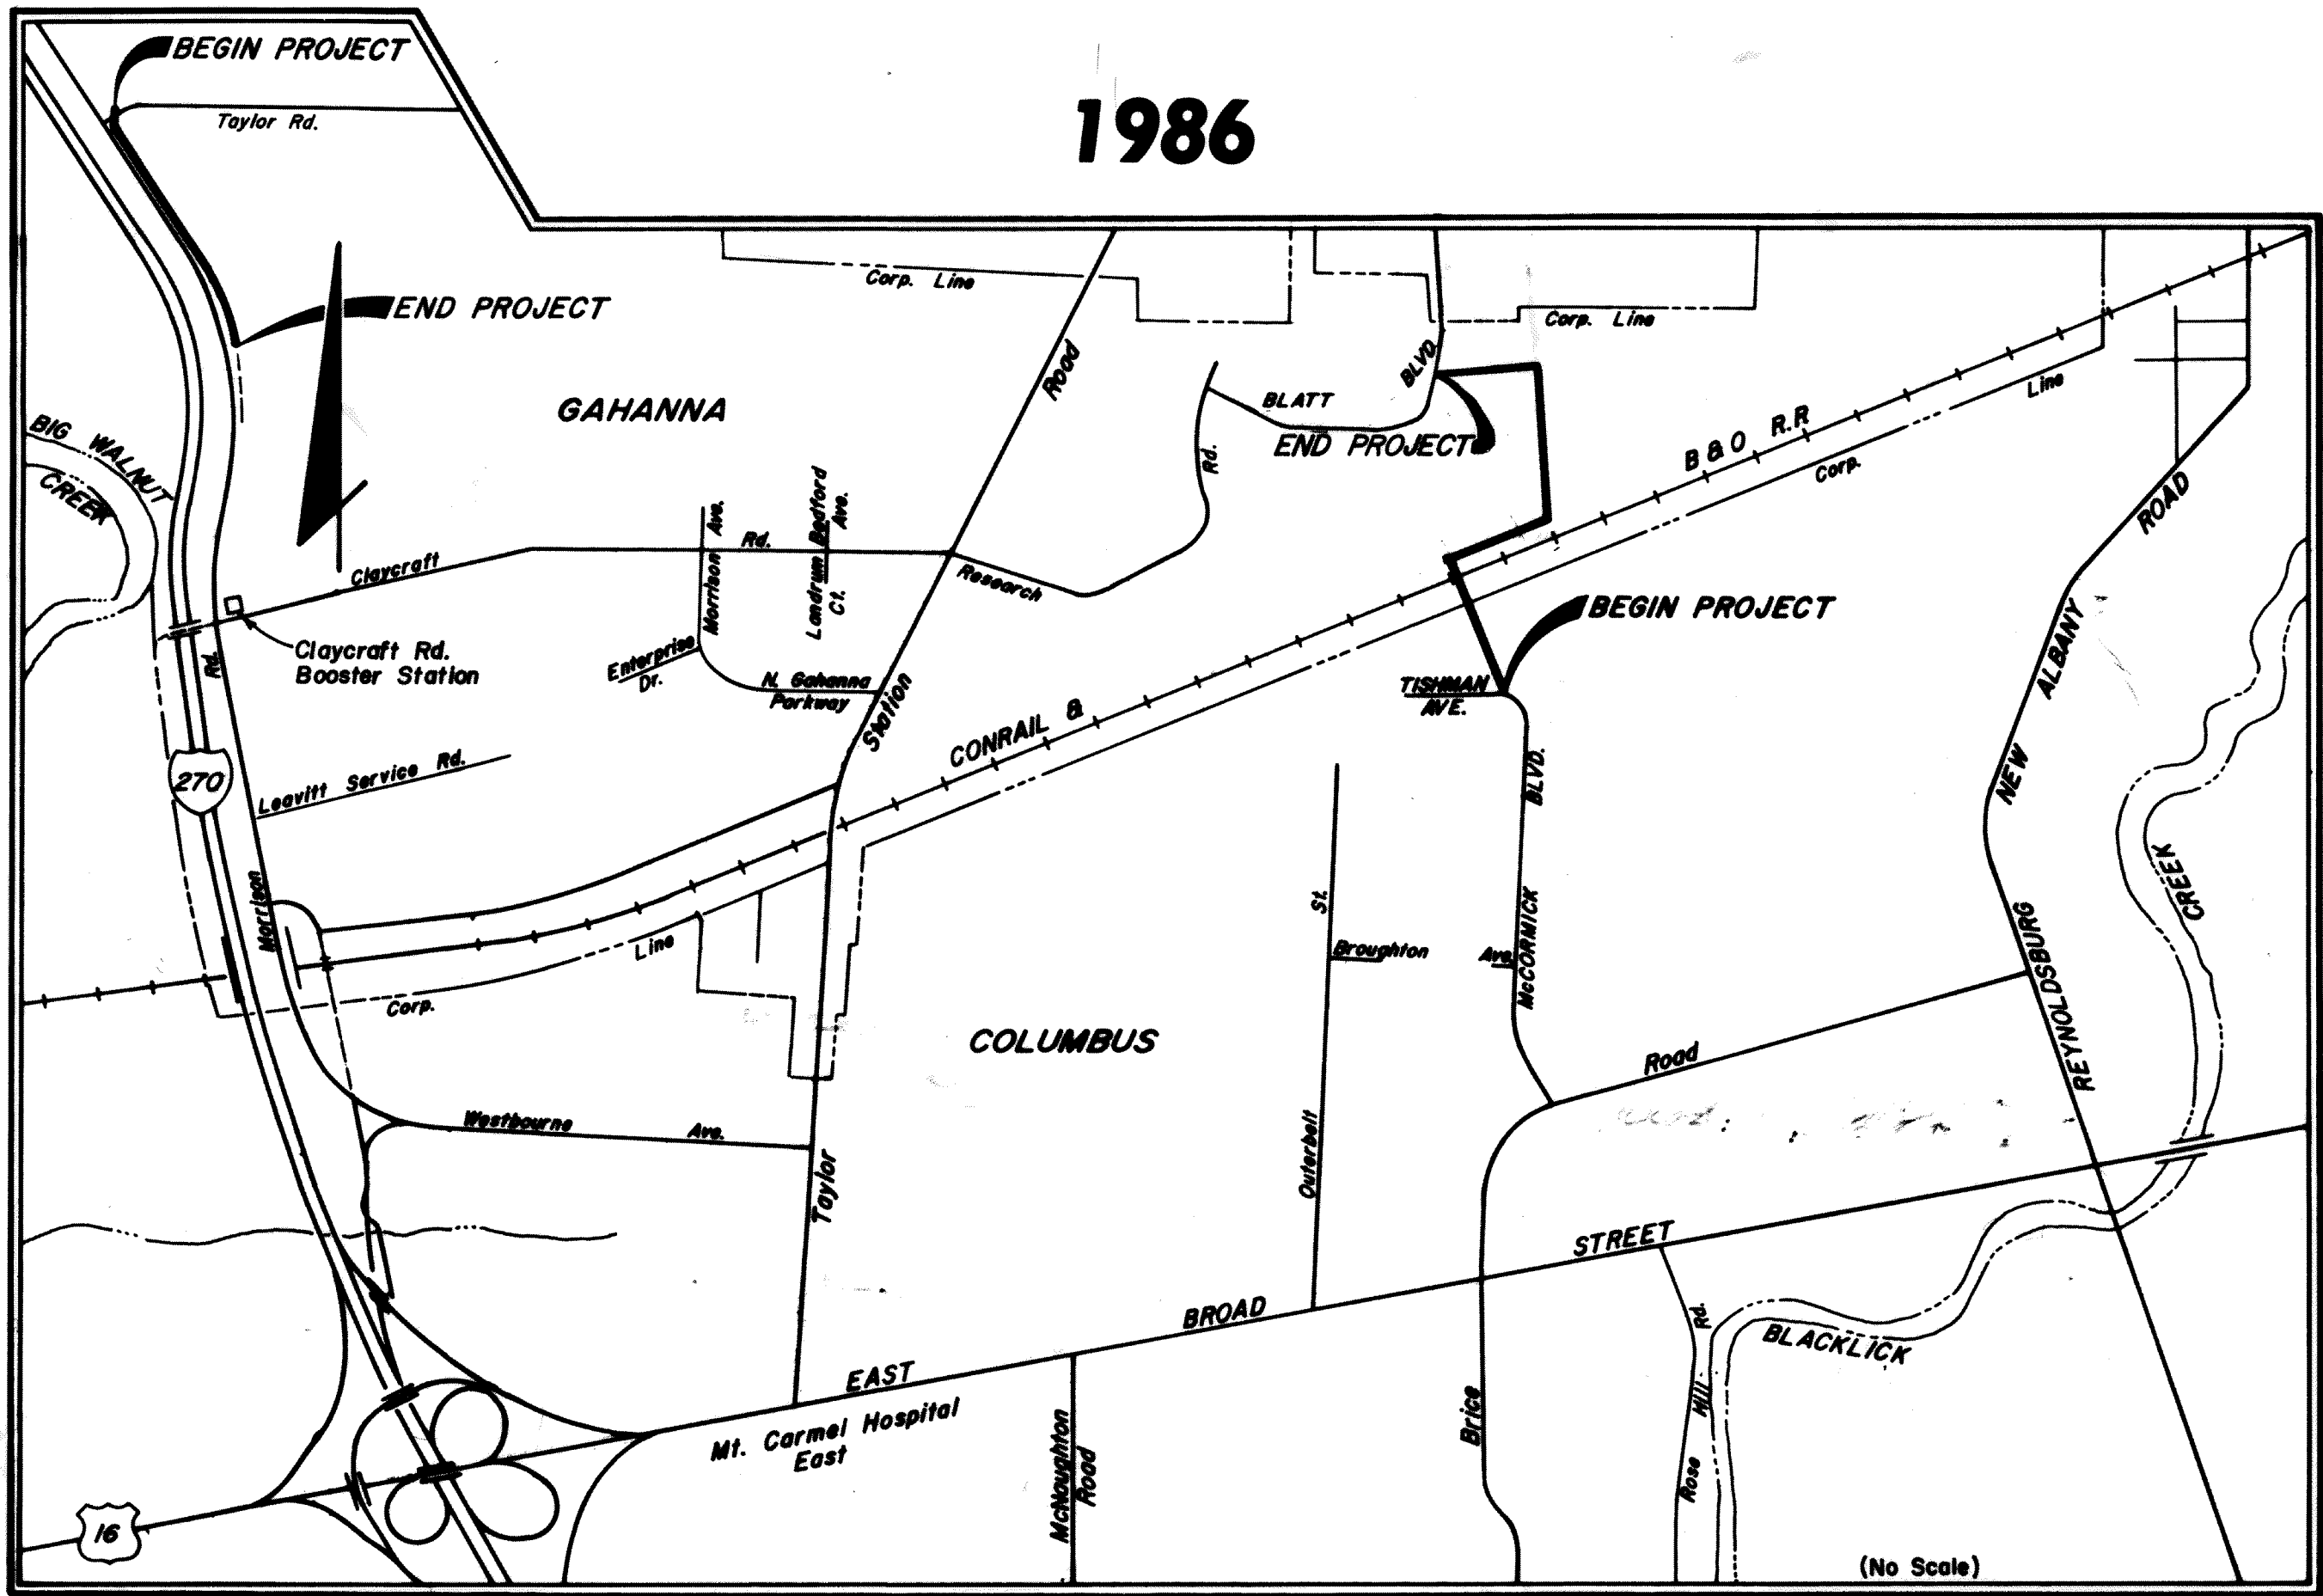

LOCATION MAP

STANDARD CONSTRUCTION DRAWINGS

GAHANNA STANDARDS

Standard Valve Box (Traffic Type).....	G - 2 2
Typical Hydrant Details.....	G - 2 5

COLUMBUS STANDARDS

Pavement Replacement (Temporary).....	1 2 4 7 A
Pavement Replacement (Permanent).....	1 2 4 4 A
Typical Trench.....	L - 6 3 0 9
Backing Vertical Bends.....	L - 6 3 1 0
Backing For Bends.....	L - 6 3 1 1
Backing For Tees.....	L - 6 3 1 2
Heavy Duty Valve Box.....	L - 6 3 1 6
Meter Setting - 1 1/2" thru 10" X 12" Meters.....	L - 6 3 1 7 A
	L - 6 3 1 7 B
Casing Pipe Plugging.....	L - 6 3 2 4
Typical Air Release.....	L - 6 4 7 3
Table of Leakage.....	L - 6 6 4 0 R
Drain Tile Replacement.....	L - 7 0 0 2
Typical Water Line Lowering.....	L - 7 4 0 1

ESTIMATED QUANTITIES (Cont.)

ITEM	QUANT.	UNIT	DESCRIPTION
802	1	Each	12" Valve and Appurtenances
Spec.	1	Lump Sum	Claycraft Road Water Booster Connection

ESTIMATED QUANTITIES			
ITEM	QUANT.	UNIT	DESCRIPTION
801	4530	Lin. Ft.	12" Water Pipe and Fittings
801	245	Lin. Ft.	12" Ductile Iron Water Pipe and Fittings (Std. Restrained)
801	13	Cu. Yds.	Concrete Blocking, Class E
801	100	Lbs.	Fittings, Increase or Decrease
803	3	Each	12" x 12" Tapping Sleeve and Valves and Appurtenances.
804	100	Lbs.	Iron Castings w/ Heavy Duty Valve Box
806	155	Lin. Ft.	24" Steel Pipe Encasement.
811	100	Cu. Yds.	Increase or Decrease in Excavation
812	3	Each	1" Air Release Outlets
815	10	Tons	Crushed Stone or Gravel
821	1	Lump Sum	Meter Pit and Appurtenances, Complete
623	10200	Sq. Yds.	Seeding and Mulching
627	28	Sq. Yds.	Temporary Pavement
628	34	Sq. Yds.	Permanent Pavement Replaced, Type 1 A
801	30	Lin. Ft.	6" Water Pipe and Fittings
802	6	Each	6" Valve and Appurtenances
809	6	Each	Fire Hydrants
Spec.	1	Lump Sum	Remove Existing Meter

PREPARED BY

EVANS, MECHWART, HAMBLETON & TILTON, INC.
CONSULTING ENGINEERS

By David A. Hursey 7-16-86
Registered Engineer Date

APPROVED:


[Signature] 7/17/86
Superintendent, Division of Sewer & Water,
City of Gahanna, Ohio Date

Charles R. Wolfe 7/16/86
City Engineer, City of Gahanna, Ohio Date

Gene Baum 7/16/86
Director of Public Service, City of Gahanna, Ohio Date

James F. McHugh 7/17/86
Mayor, City of Gahanna, Ohio Date

Cheryl S. Young 7/16/86
Auditor, City of Gahanna, Ohio Date

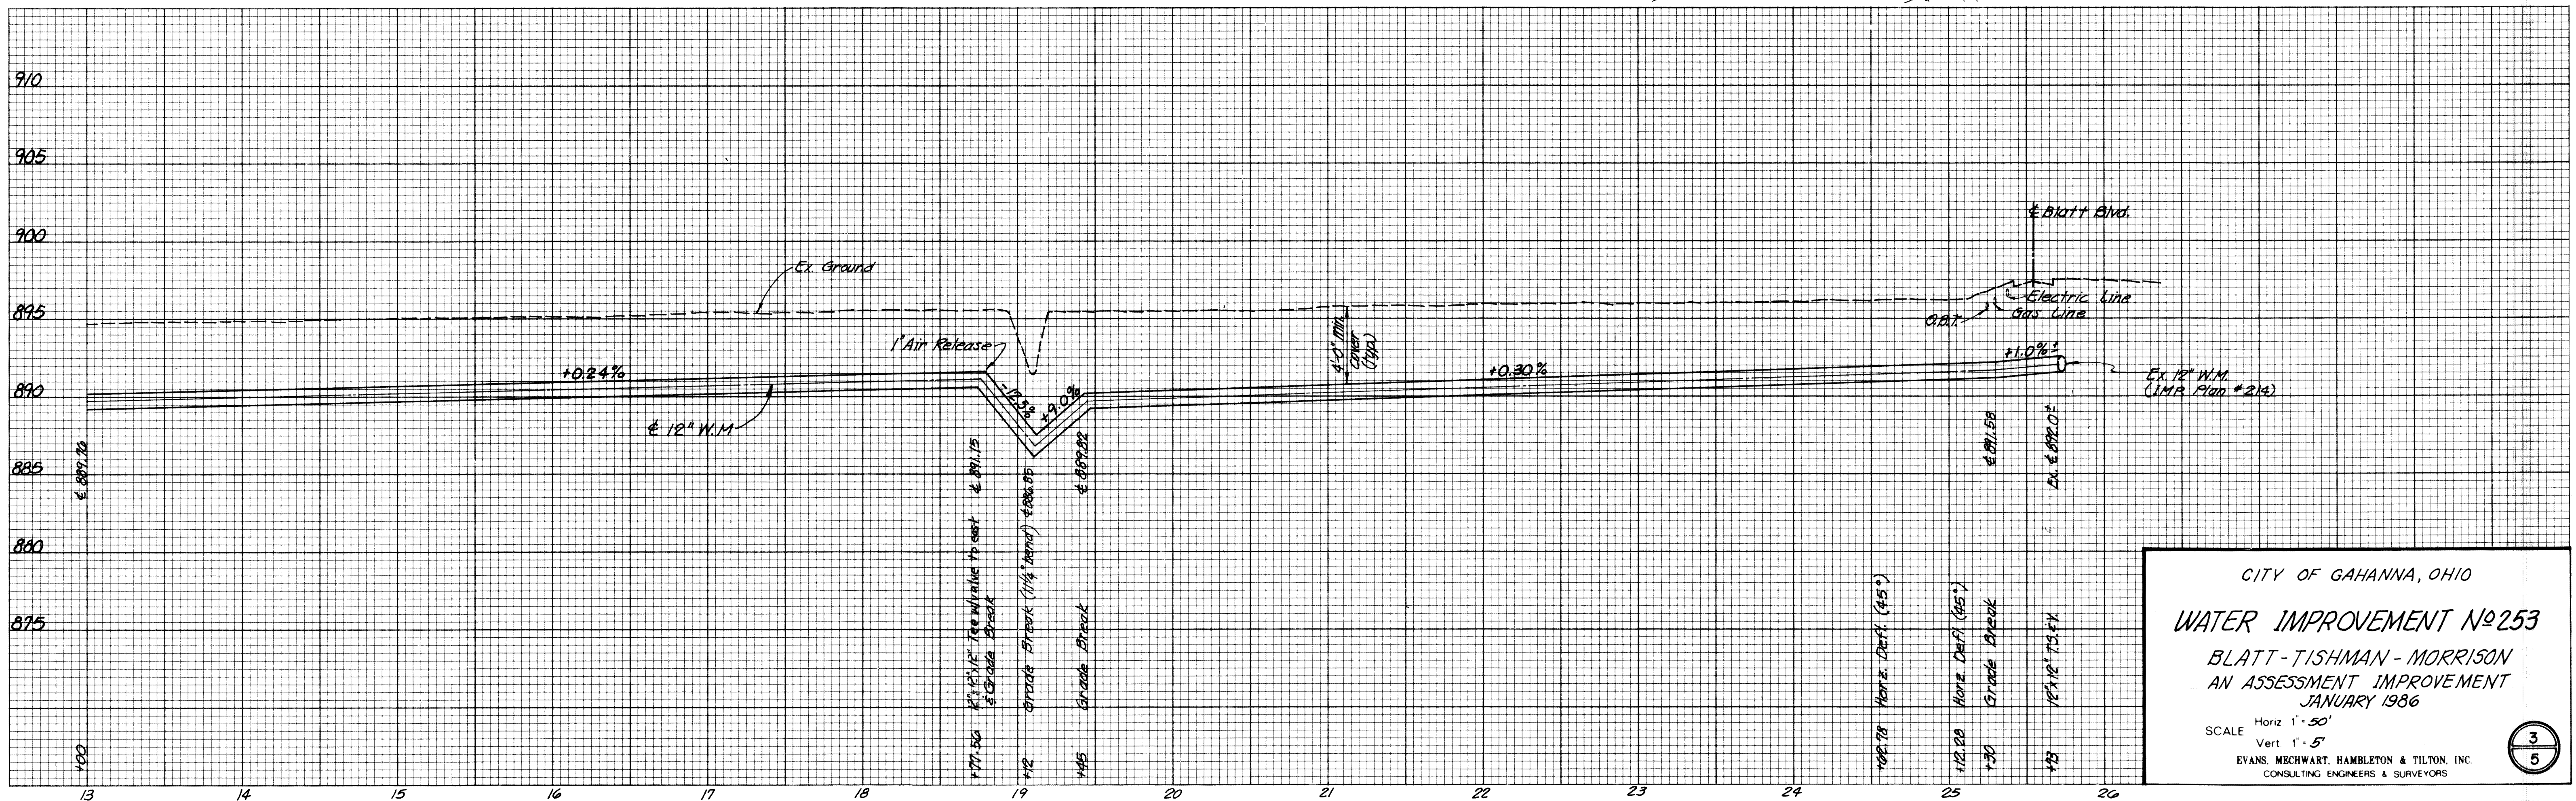

BENCH MARK
Top stem of F.H. Along Taylor Rd.
Sta. 1662+30 210' Lt. EL. = 802.54
=129+00



**TAYLOR ROAD
CURVE DATA**
Dc = 24°54'40"
Δ = 43°39'23" Rt.
T = 92.12'
E = 17.76'
L = 175.25'
R = 230.00'

BENCH MARK
R.R. Spike North side 10' Wild Cherry
Sta. 1000+00 250' Rt. EL. = 799.73
=133+00

**BEGIN PROJECT
BEGIN WORK**


w/12"12" Tapping Valve & Sleeve
and Heavy Duty Valve Box

Pavement replacement
in accordance with
detail on sheet 3/5,
1244 Dr. A, and
1247 Dr. A.

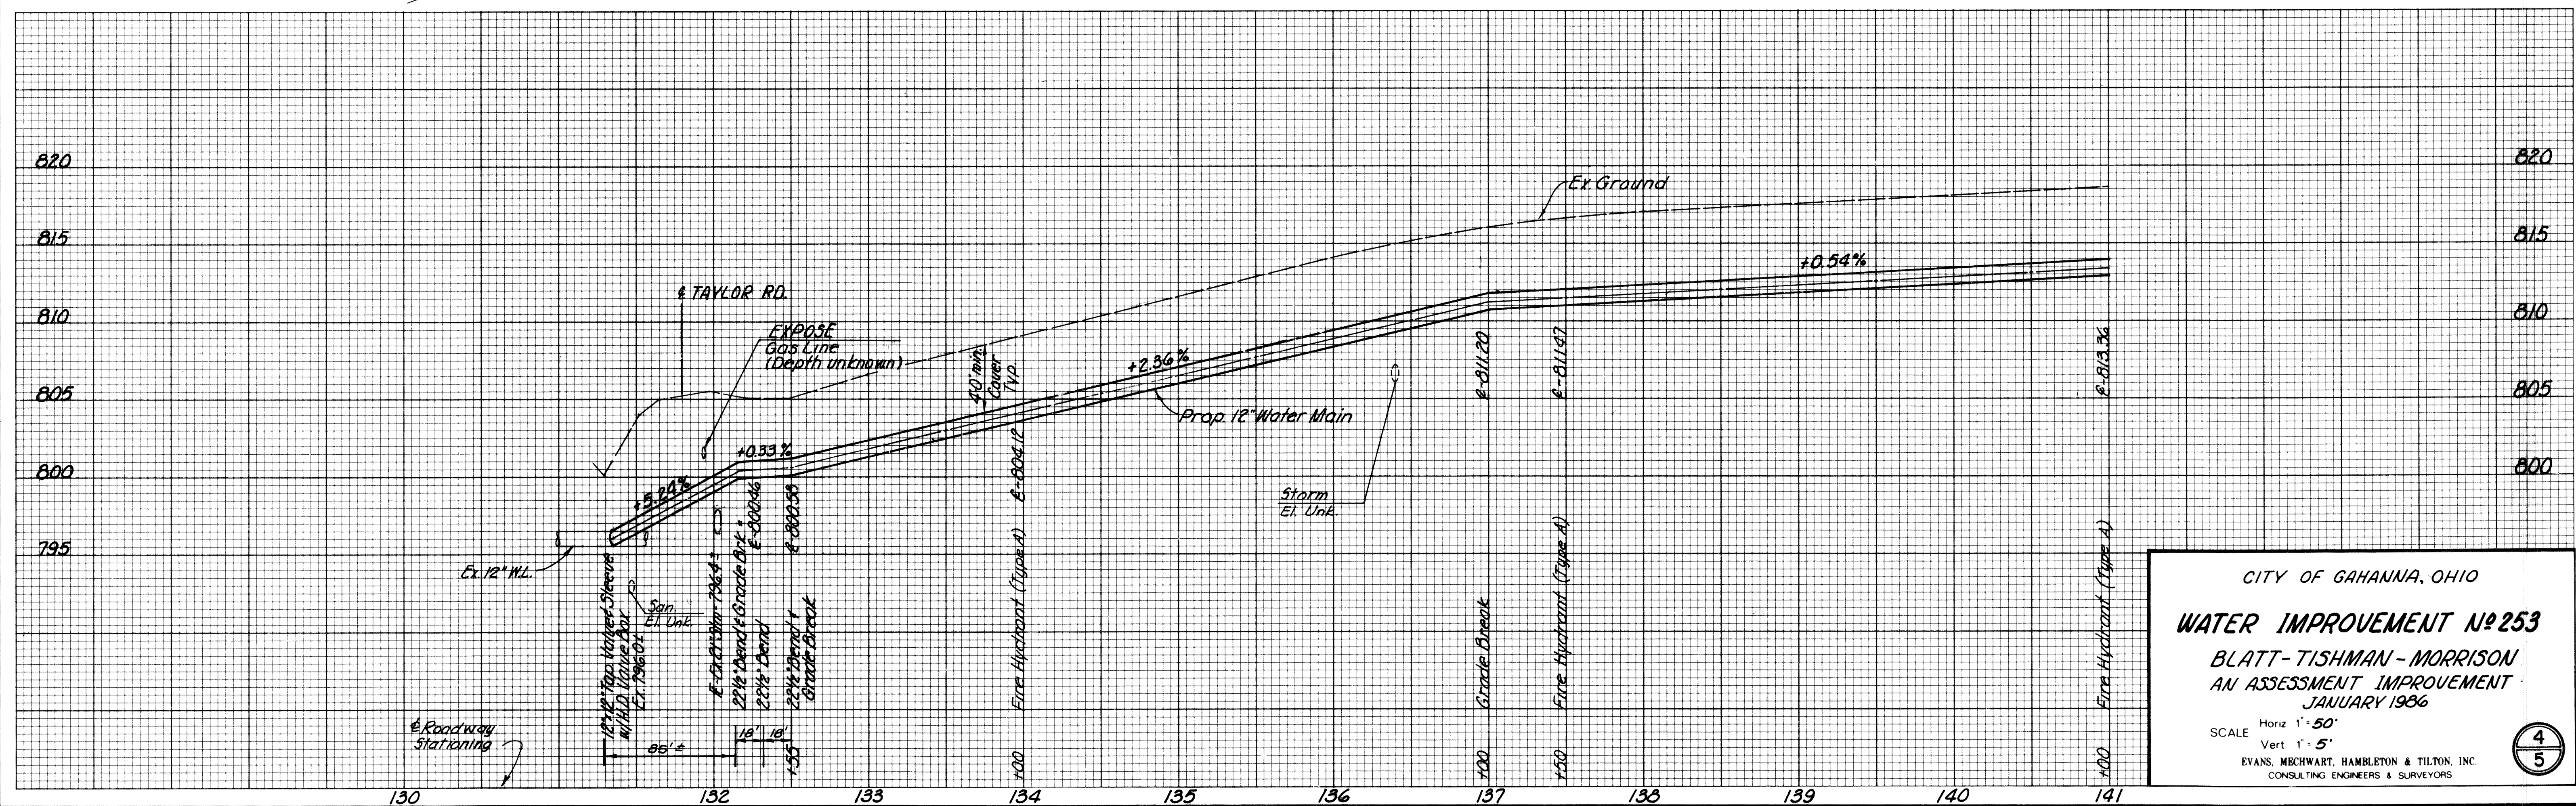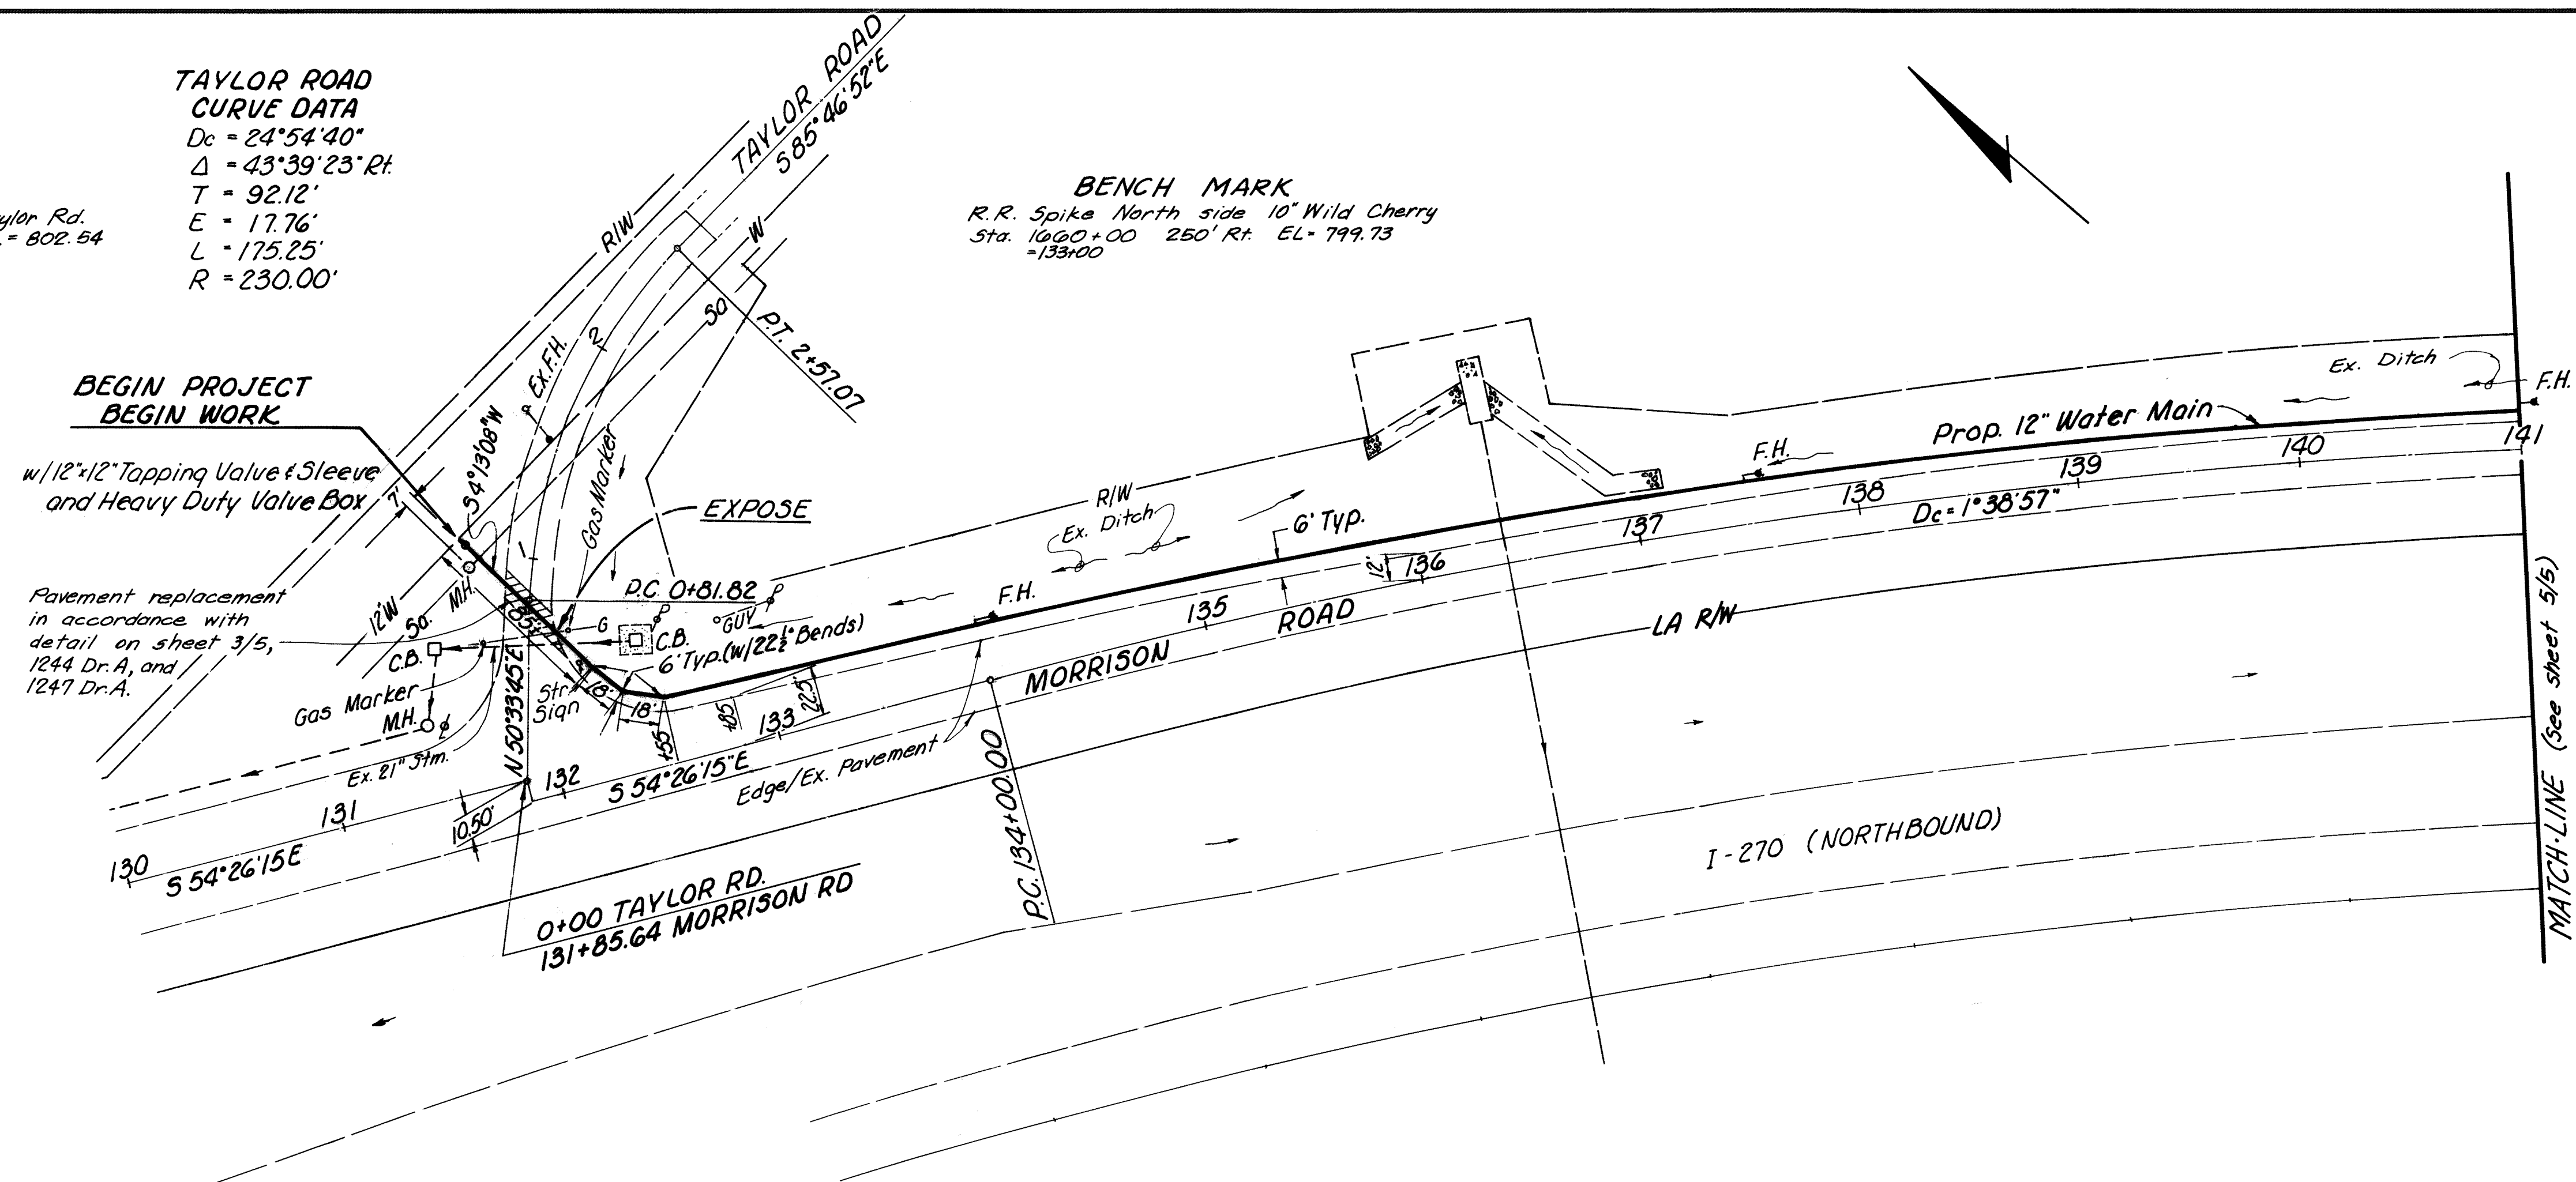

CITY OF GAHANNA, OHIO
WATER IMPROVEMENT No 253
BLATT-TISHMAN-MORRISON
AN ASSESSMENT IMPROVEMENT
JANUARY 1986
SCALE Horiz 1" = 50'
Vert 1" = 5'
EVANS, MECHWART, HAMBLETON & TILTON, INC.
CONSULTING ENGINEERS & SURVEYORS

BENCH MARK
R.R. Spike in West Side 10" Ash
Sta. 1692 + 25 250' Lt. El. = 822.13
= 160 + 50

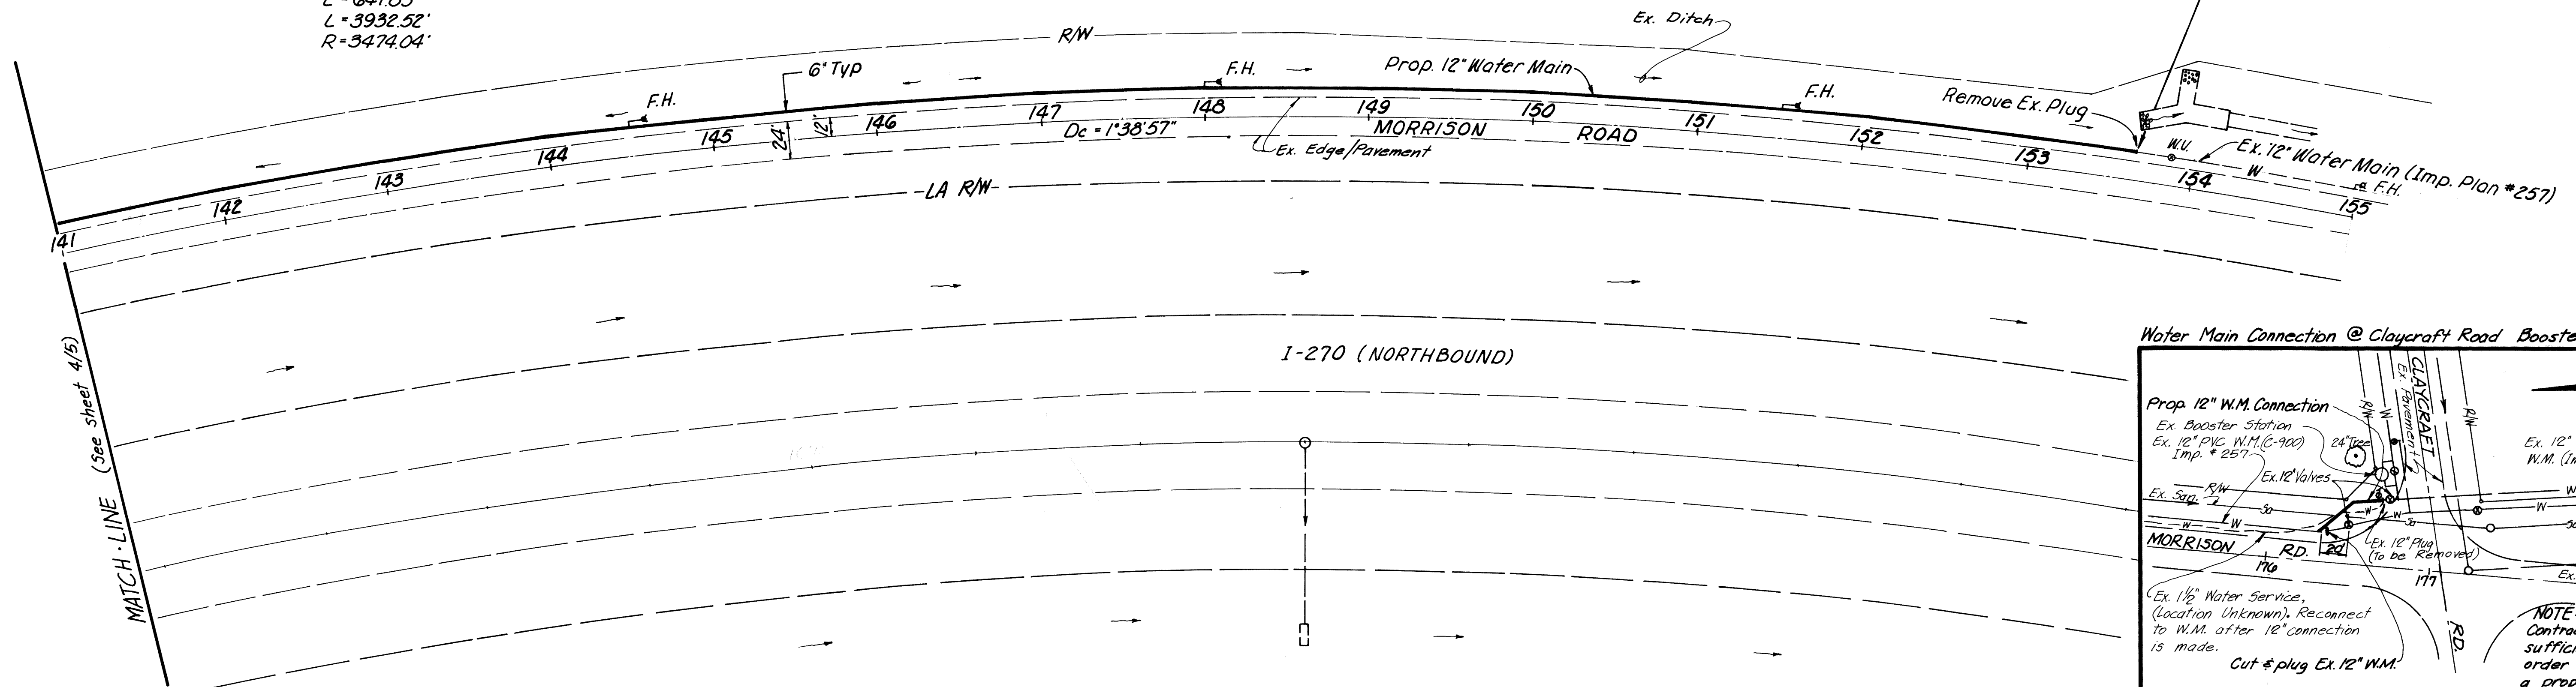

PRIVATE STREET AND WATER
AND STREET LIGHTING
IMPROVEMENT NO. 293

CHERRY BOTTOM GARDENS
SECTION TWO
CITY OF GAHANNA, OHIO
1980

GENERAL NOTES

SPECIFICATION The requirements of the City of Gahanna, together with the Standard Specifications of the State of Ohio, Department of Transportation, including all supplements thereto in force on date of contract shall govern all materials and workmanship involved in the improvements shown on these plans except as such specifications are modified by the following specifications or by the construction details set forth herein.

STANDARD CONSTRUCTION DRAWINGS All pertinent Standard Construction Drawings are available upon request at the office of the City Engineer.

PERMITS The contractor shall obtain all necessary permits.

SAFETY REQUIREMENTS The Contractor and Subcontractor shall be solely responsible for complying with the Occupational Safety and Health Act of 1970 during the conduct and performance on and in connection with this project.

EXISTING UTILITIES Location, support, protection and restoration of all existing utilities and appurtenances shall be the responsibility of the Contractor. The cost of this work shall be included in the price bid for various items. It shall be the responsibility of the Contractor, prior to any construction, to determine in the field the actual locations and elevations of all existing utilities whether shown on these plans or not. The Contractor shall call the Ohio Utilities Protection Service, 1-800-362-2764 (toll free) 72 hours prior to any excavation.

MISCELLANEOUS WORK All items of work called for on the plans for which no specific method of payment is provided shall be performed by the Contractor and the cost of same shall be included in the price for the various related items.

FIELD TILE All field tile broken during excavation shall be replaced to original condition or connected to either the curb subdrain or to the storm sewer system as directed by the Engineer.

SURPLUS EXCAVATION The Contractor shall dispose of all surplus street excavation on the project site where and as directed by the Owner.

UNAUTHORIZED STREET EXCAVATION In the event excavation for the street is from 0" to 6" below that called for on the plans, the Contractor shall replace this excess excavated material with compacted 46 D crushed aggregate as directed and at no extra cost to the owner.

STORM SEWERS Unless otherwise noted on the plans all Storm Sewers shall be as hereafter specified (1) All sizes of storm sewer located within or across proposed or existing pavement areas shall be Type B Conduit, 706.02, with Class B Bedding. (2) Storm Sewer located outside pavement areas shall be Type E Conduit, 706.01, Class C Bedding, for 15 inch and smaller, and shall be Type E Conduit, 706.02, Class C Bedding, for 18 inch and larger. The following modifications to Ohio Department of Transportation Specifications shall apply; (1) Type E Conduits shall have sealed joints; (2) Granular backfill material shall be compacted granular material, Item 310-A placed within limits shown on the plan including around all inlet structures. Granular backfill shall extend from the bottom of the trench to a plane 6 inches below the subgrade.

CURB INLETS All curb inlets shall be channeled as directed.

STREET LIGHTING Standard Electrical Specifications and Standard Construction Drawings, covering Street Lighting for the City of Gahanna, Ohio shall apply.


EXPANSION JOINTS It shall be the responsibility of the Contractor to adequately barricade the street in the vicinity of all expansion joints, until such time as the street is open to traffic.

WATER MAINS All water mains 4-inch and larger shall be either Ductile Iron, Class 3 for 4" thru 10", and Class 4 for 12", or Asbestos Cement, Class 150, or Polyvinyl Chloride, Class 150. All bends, joint deflections and fittings shall be backed with concrete where and as directed. Where water mains or services cross proposed or existing streets, backfill shall be compacted granular material, Item 310-A, within limits 5 feet outside the edge of pavement or curb, extended from the bottom of the trench to a plane 6 inches below the subgrade. The services may be jacked across the street in lieu of open cut and the use of granular backfill.

CURB BOXES Curb boxes shall be located one-half foot from the property line unless otherwise shown on the plans or ordered by the Engineer.

CHLORINATION OF WATER MAINS The Contractor shall make arrangements to have the water mains chlorinated by the City of Columbus. The cost of chlorination shall be included in the price bid for the various water main items.

MAINTAINING TRAFFIC The Contractor shall restrict his operations within the JOHNSTOWN ROAD right-of-way to the hours between 9:00 A.M. and 4:00 P.M., Monday thru Friday maintaining two-way traffic during these hours, at all other times, including the weekend, the full pavement width of JOHNSTOWN ROAD shall be open to traffic, either by backfilling or by the use of steel plates across the open trench.

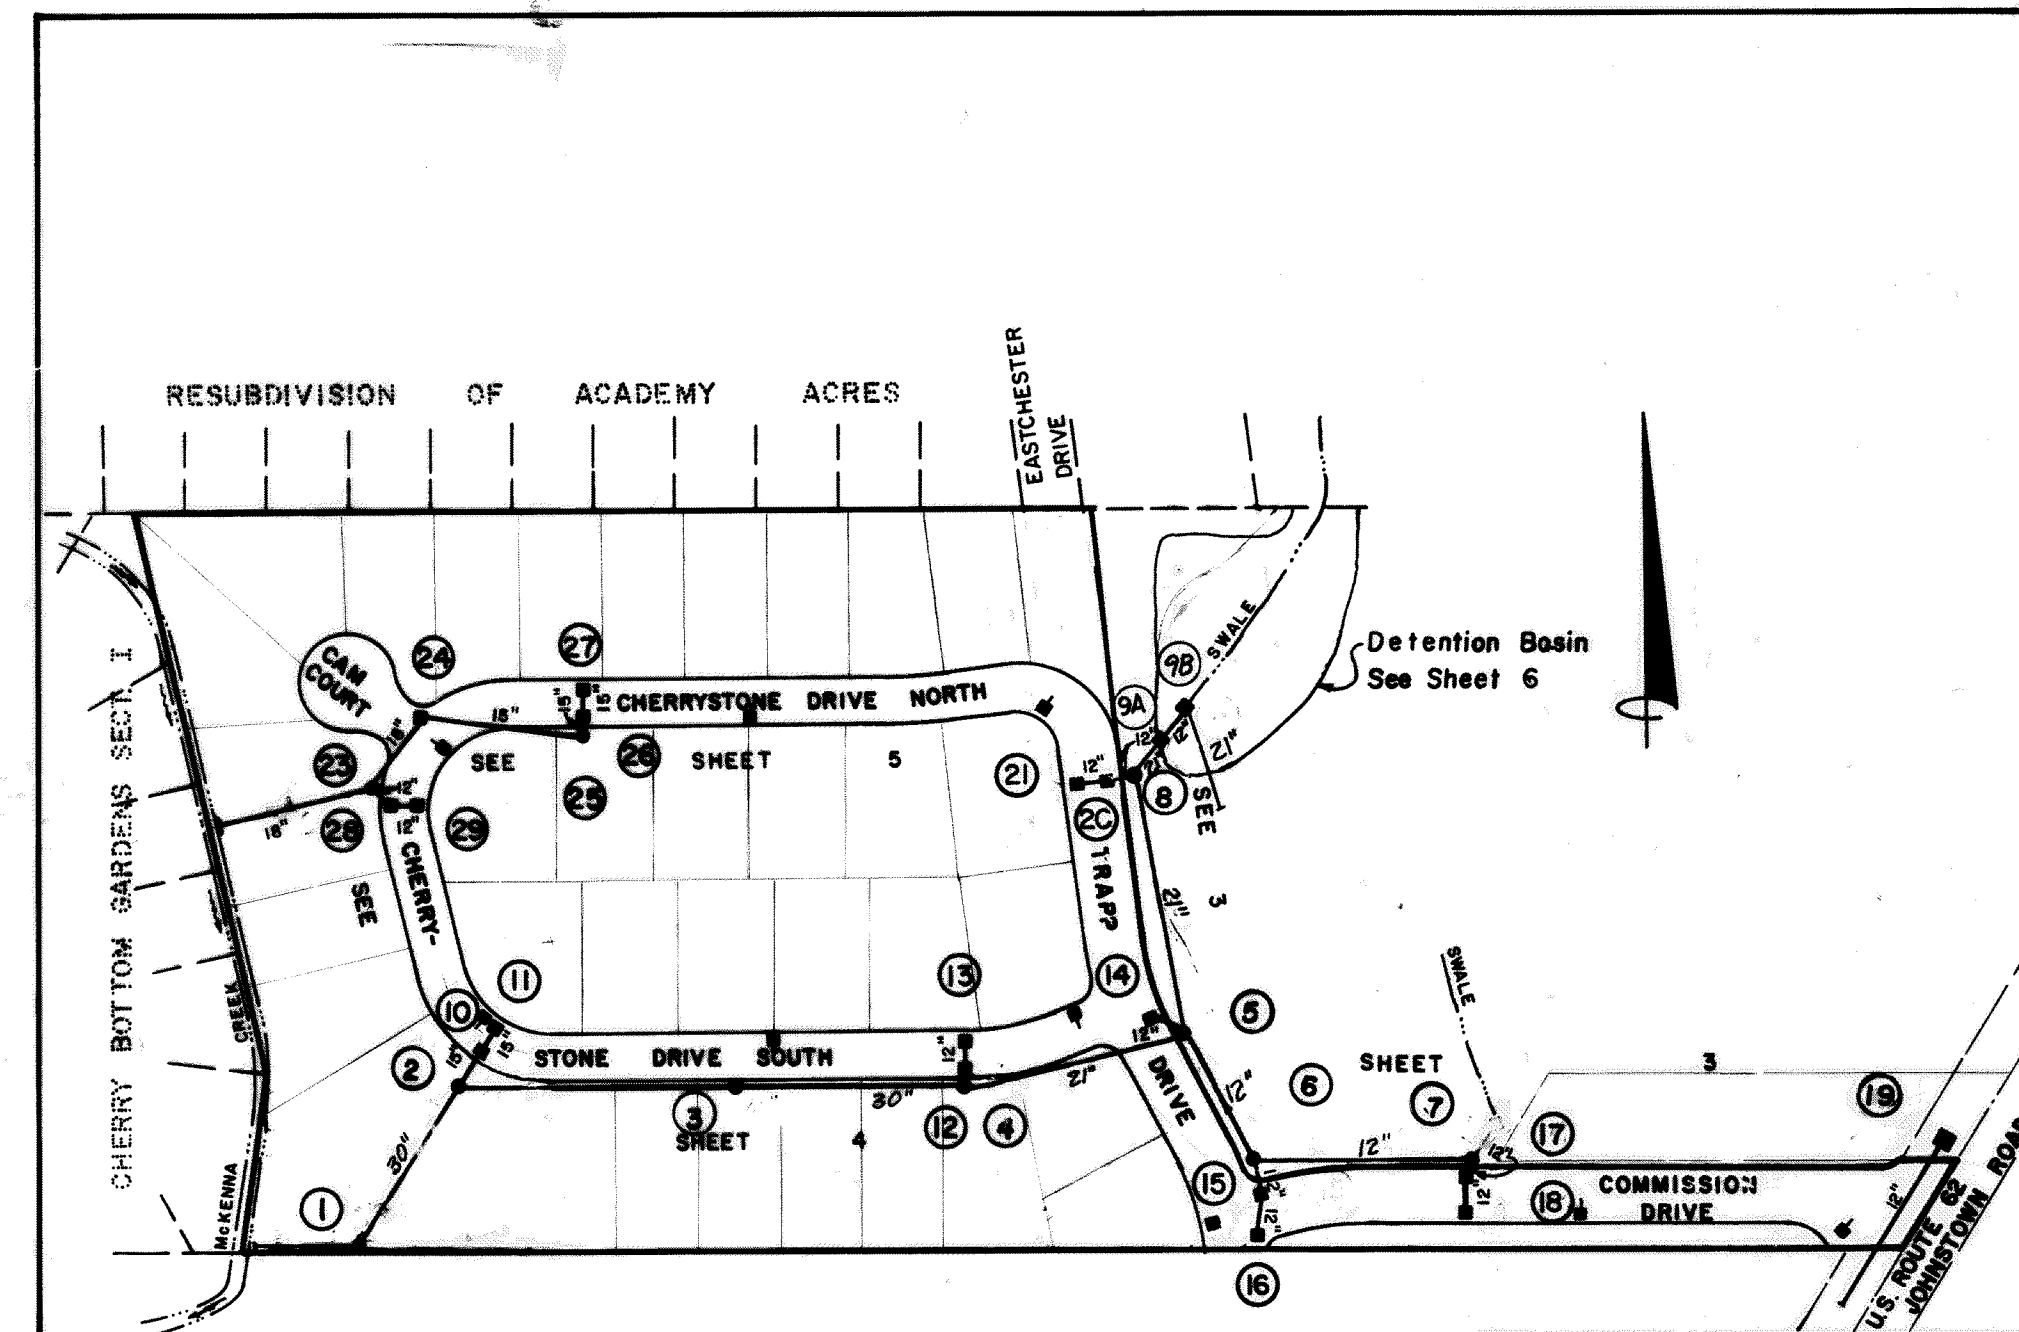

INDEX MAP
SCALE 1" = 200'

■ = STREET LIGHTING (Prop.)
□ = STREET LIGHTING (Exist.)

BENCH MARKS
R.R. Spike S.W. Side of 8" Ash, 70' East of Eastchester Dr. and 10' South of N. P/L of Cherry Bottom Gardens Sec. Two.
Elev. = 848.48
R.R. Spike, N. Side of 15" Twin Walnut near S.W. Corner of Cherry Bottom Gardens Sec. Two.
Elev. = 826.83
R.R. Spike, N.E. Root of 10" Ash, 65' South of Sta. 8+05 Cherrystone Drive South.
Elev. = 832.05

ESTIMATE OF QUANTITIES			
ITEM	QUAN.	UNIT	DESCRIPTION
203	5,660	Cu. Yds.	Excavation Including Embankment Construction
305	6,250	Sq. Yds.	7" Portland Cement Concrete Base
402	300	Cu. Yds.	Asphalt Concrete
404	300	Cu. Yds.	Asphalt Concrete
407	870	Gals.	Bituminous Tack Coat
605	6,105	Lin. Ft.	4" Shallow Pipe Underdrain
609	1,300	Lin. Ft.	Concrete Combination Curb and Gutter
609	4,810	Lin. Ft.	Concrete Mountable Curb and Gutter
608	2,610	Sq. Ft.	4" P.C. Concrete Walk
608	1	Each	Curb Ramp
603	565	Lin. Ft.	12" Conduit, Type E, 706.01 Class II
603	365	Lin. Ft.	12" Conduit, Type B, 706.02 Class II
603	160	Lin. Ft.	15" Conduit, Type E, 706.01 Class II
603	115	Lin. Ft.	15" Conduit, Type B, 706.02 Class II
603	220	Lin. Ft.	18" Conduit, Type E, 706.02 Class II
603	40	Lin. Ft.	18" Conduit, Type B, 706.02 Class II
603	565	Lin. Ft.	21" Conduit, Type E, 706.02 Class II
603	65	Lin. Ft.	21" Conduit, Type B, 706.02 Class II
603	825	Lin. Ft.	30" Conduit, Type E, 706.02 Class II
605	300	Lin. Ft.	8" Pipe Underdrain (Detention Basin)
605	200	Lin. Ft.	6" Pipe Underdrain (Lots 41 & 42)
606	1	Each	Temporary Barricade (Guardrail Posts Only)
601	27	Cu. Yds.	Rock Channel Protection, Type A
602	3.8	Cu. Yds.	Concrete Masonry
604	10	Each	Type A Manhole
604	2	Each	2-2A Catch Basin
604	2	Each	2-3 Catch Basin
604	9	Each	42" Curb Inlet
604	6	Each	60" Curb Inlet
604	2	Each	Curb and Gutter Inlet w/Vaned Grate
203	2800	Cu. Yds.	Excavation Including Embankment Construction (Detention Basin)
659	8000	Sq. Yds.	Seeding and Mulching (Detention Basin)
WATER MAIN ITEMS			
130	Lin. Ft.	4" Water Main	
1,870	Lin. Ft.	6" Water Main	
65	Lin. Ft.	8" Water Main	
1,505	Lin. Ft.	12" Water Main	
8	Each	6" Valve w/Box	
1	Each	8" Valve w/Box	
3	Each	12" Valve w/Box	
22	Each	3/4" Water Service (Short)	
14	Each	3/4" Water Service (Long)	
7	Each	Fire Hydrant	
Lump Sum	Lump Sum	Street Lighting System, Complete (9 Lights)	

EVANS, MECHWART, HAMBLETON & TILTON, INC.

CONSULTING ENGINEERS & SURVEYORS

By David A. Hussey 1-30-81
Registered Engineer Date

PREPARED BY



APPROVED
SUPERINTENDENT, DIVISION OF WATER & SEWERS
CITY OF GAHANNA, OHIO
5/7/81
DATE
SUPERINTENDENT OF STREETS, CITY OF GAHANNA, OHIO
5-7-81
DATE
CITY ENGINEER, CITY OF GAHANNA, OHIO
5-6-81
DATE
DIRECTOR OF PUBLIC SERVICE, CITY OF GAHANNA, OHIO
5-7-81
DATE
MAYOR, CITY OF GAHANNA, OHIO
5-7-81
DATE
AUDITOR, CITY OF GAHANNA, OHIO
5-7-81
DATE

Revised 3-26-86 Relocated Detention Basin & revised
Storm Sewer accordingly


Revised as Constructed 9-24-86

57-293


P-878

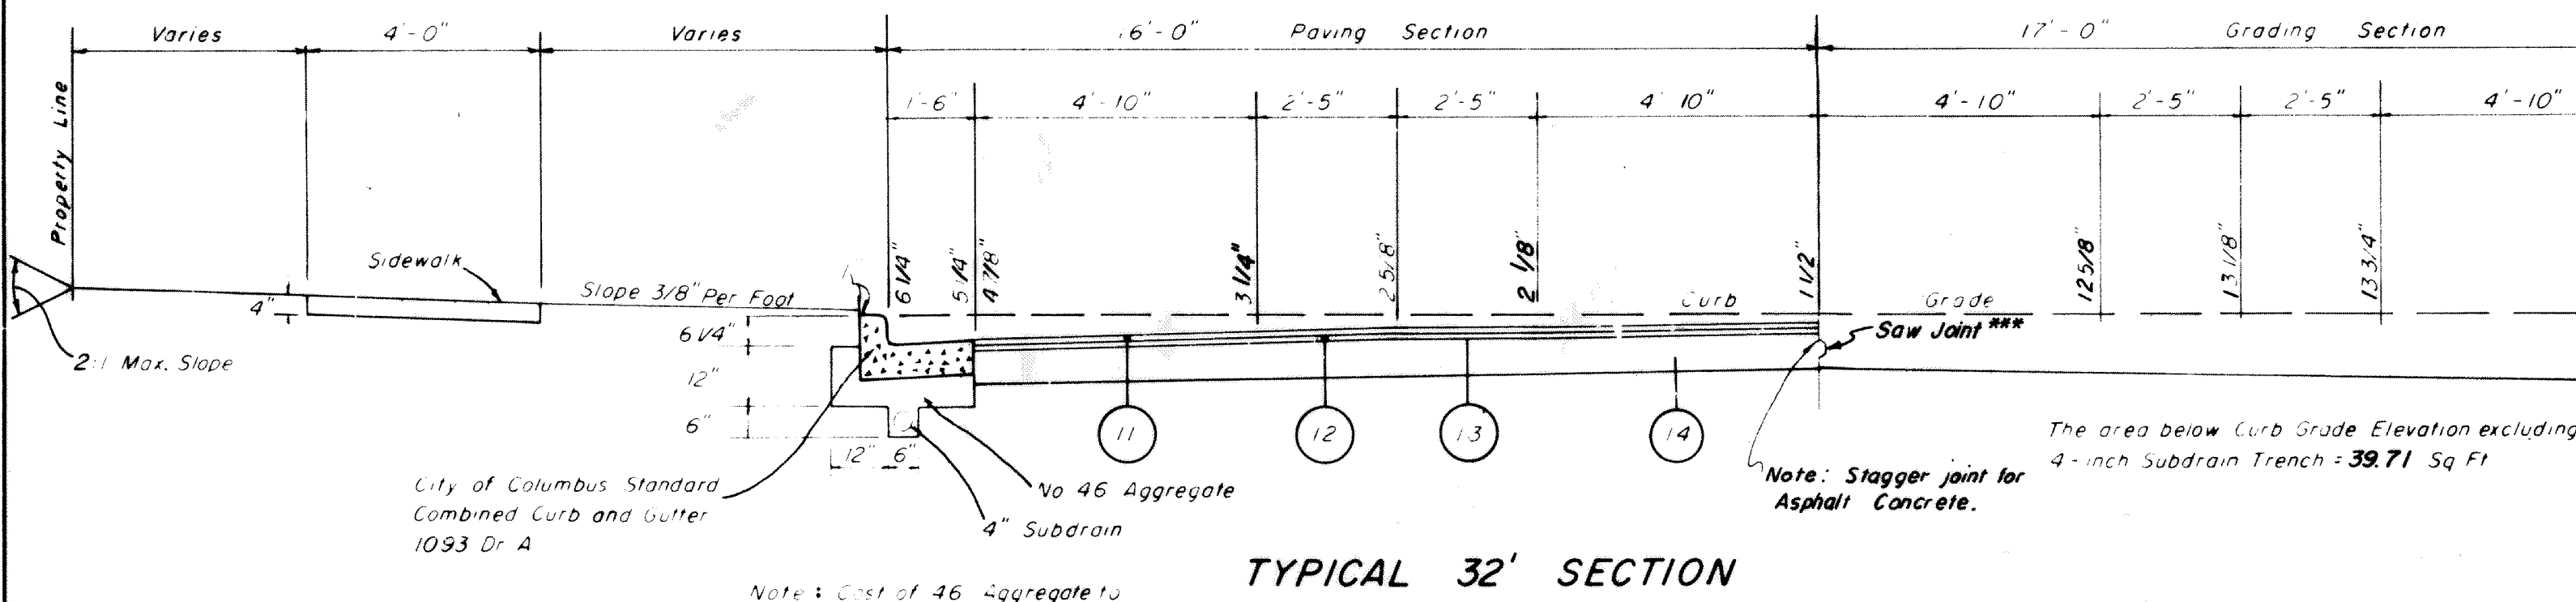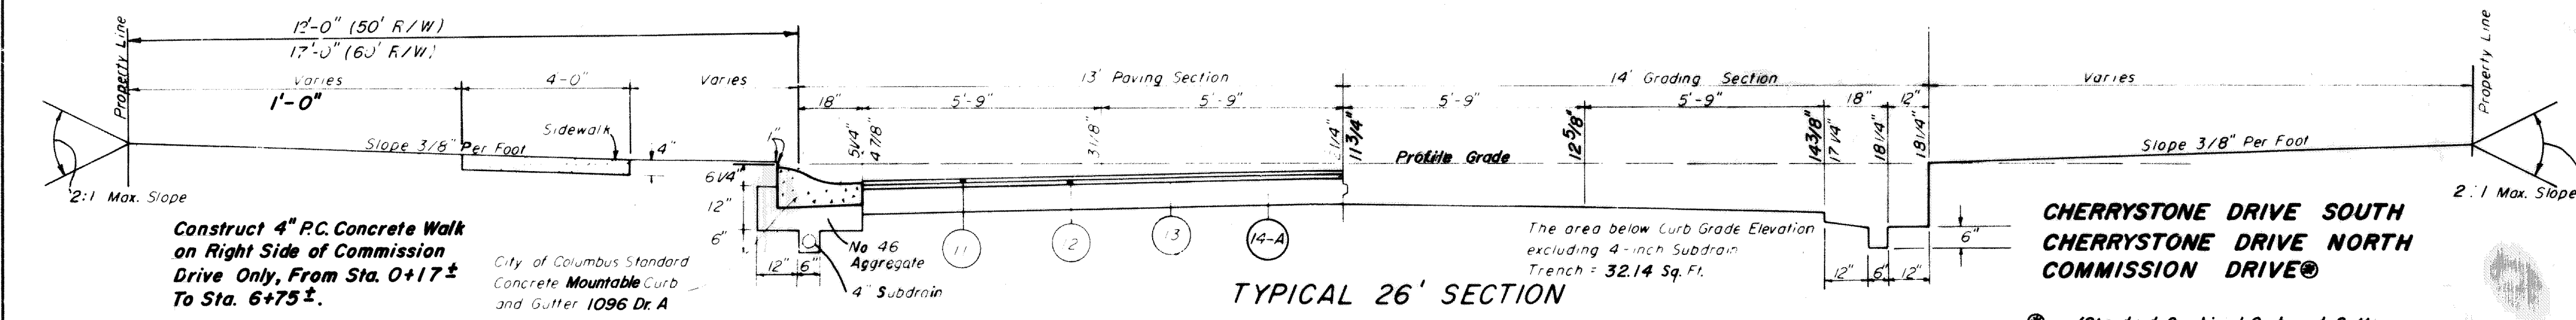


THREE-WAY INTERSECTION

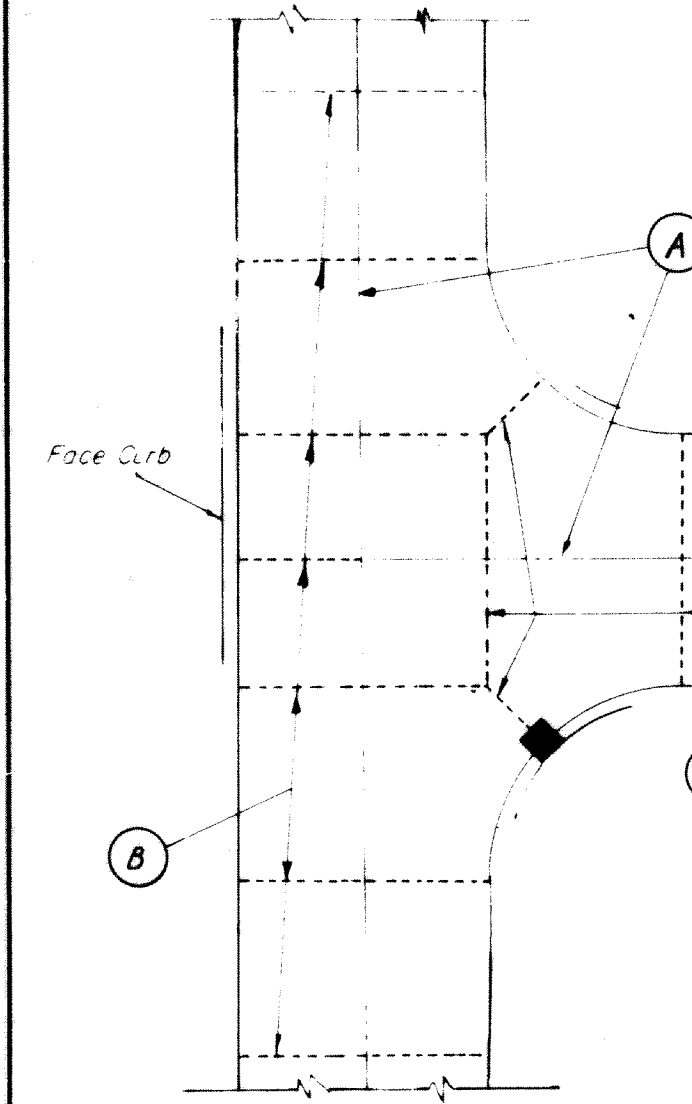


FOUR-WAY INTERSECTION

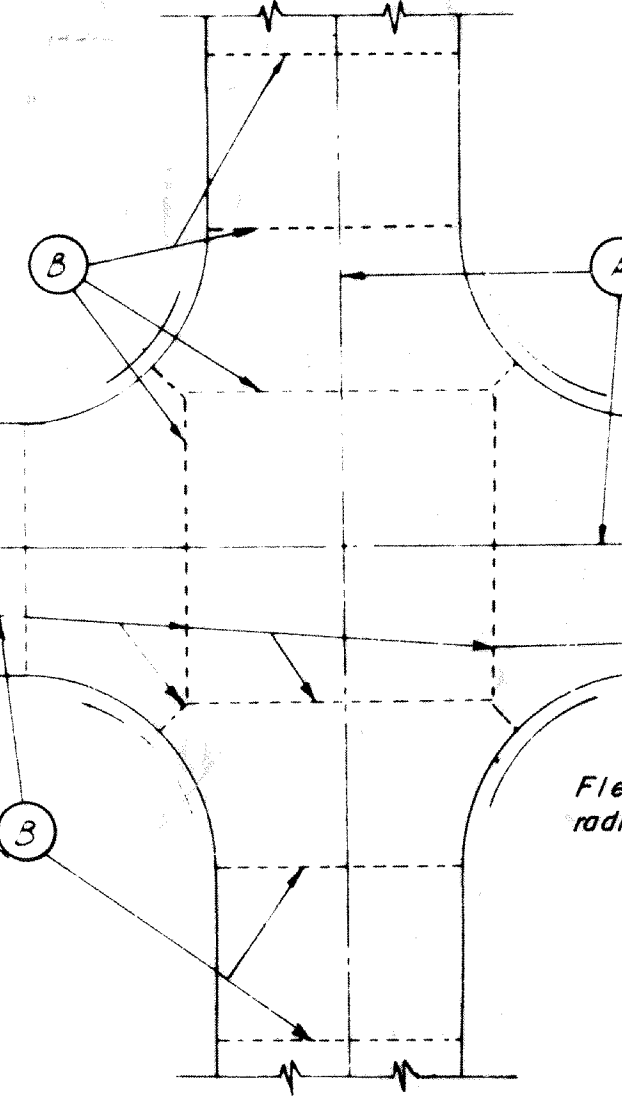


THREE-WAY INTERSECTION

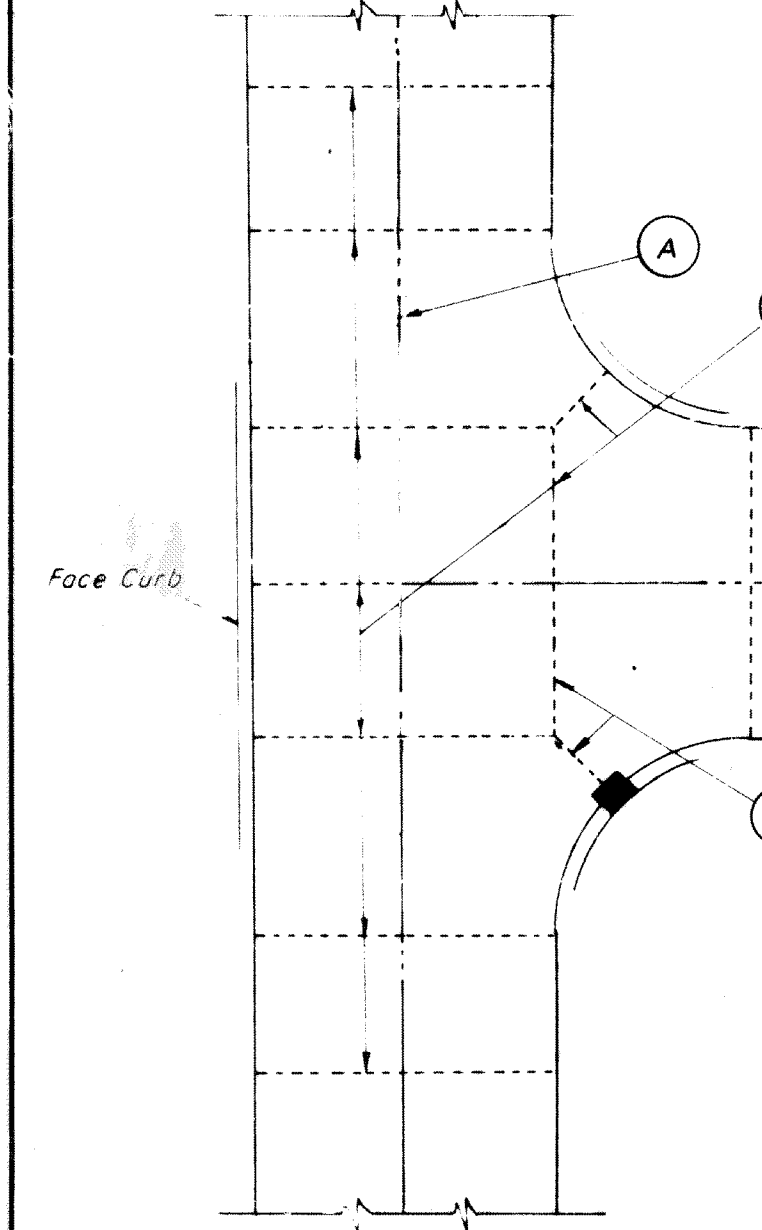

THREE-WAY INTERSECTION

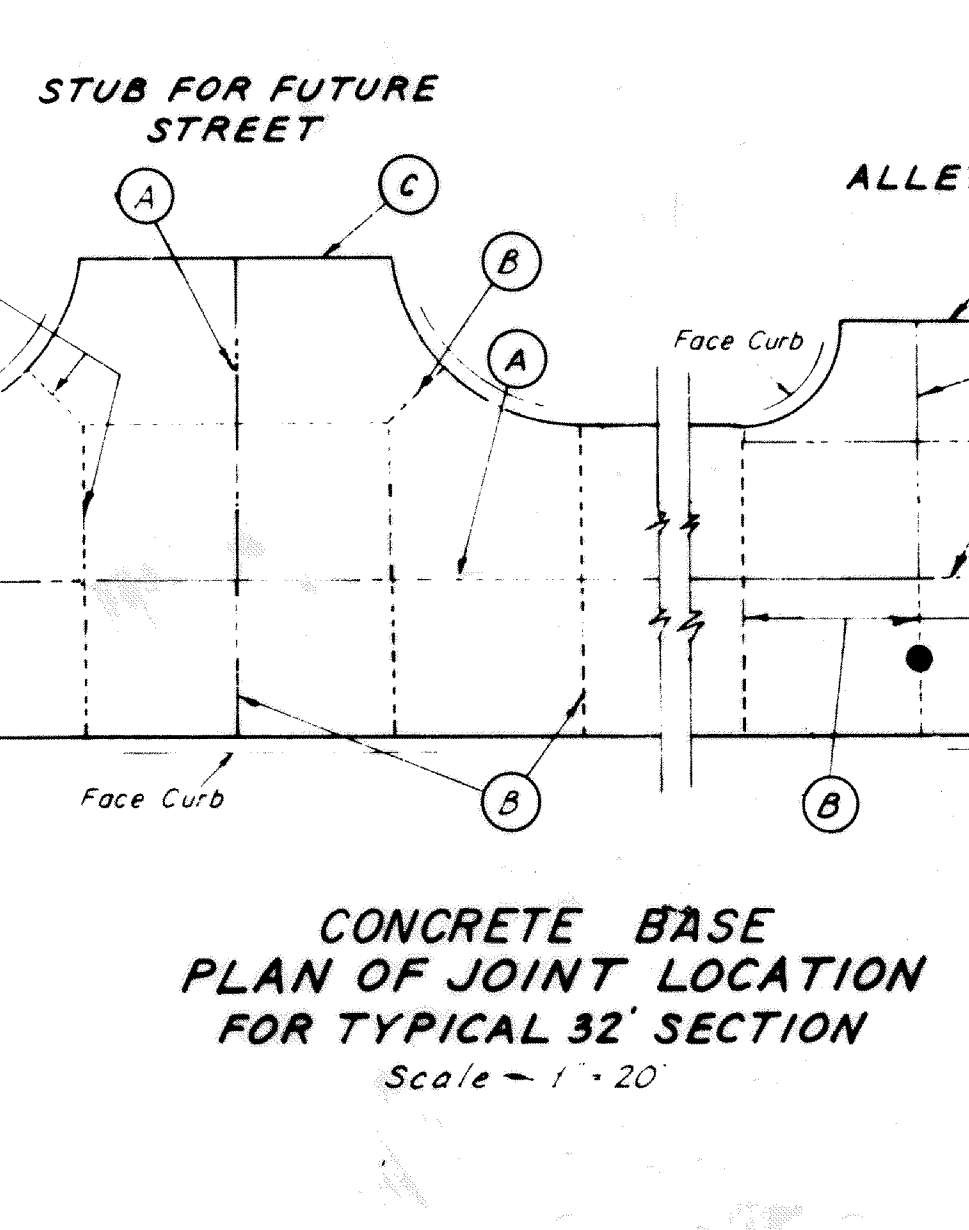

FOUR-WAY INTERSECTION

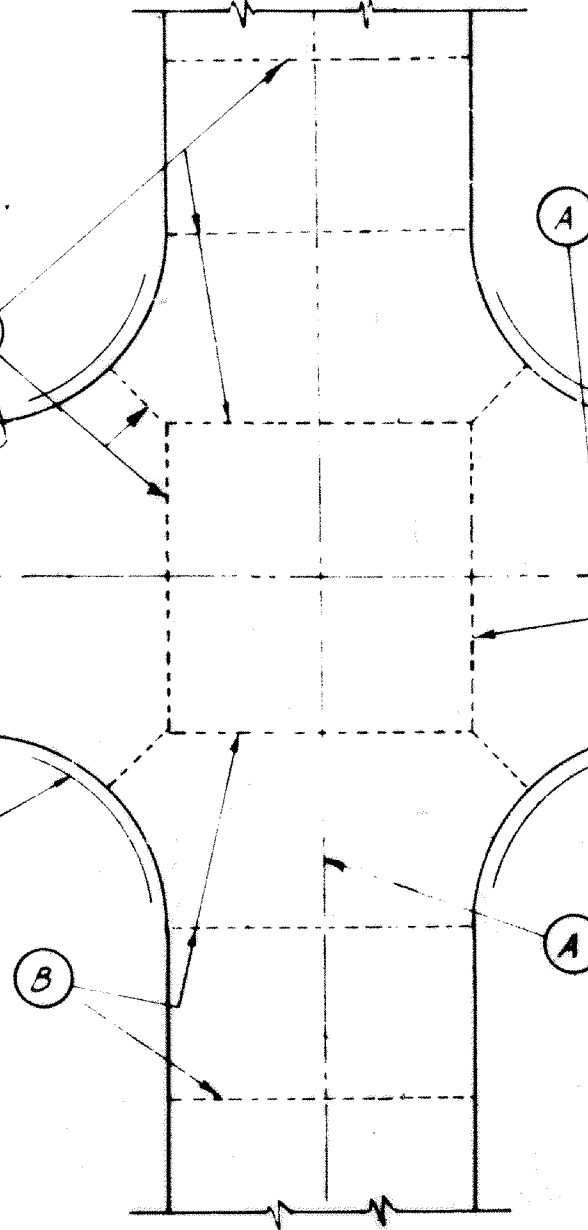

- 11 1 1/4" Hot-mixed, Hot-laid Asphalt Concrete, Item 404 (85-100) *
 - 12 1 1/4" Hot-mixed, Hot-laid Asphalt Concrete, Item 402 (85-100).
 - 13 Bituminous Tack Coat, Item 407 Bituminous Material 70/202, RC-70 or RC-250 applied 0.1 Gal. per Sq. Yd. and cover consisting of crushed gravel or limestone size No. 9.
 - 14 6" Portland Cement Concrete Base, Item 305 **
 - (14-A) 7" Portland Cement Concrete Base, Item 305 **
- *Modification of State Highway Specifications. Asphalt Concrete shall contain all crushed aggregate.
- ** Shall conform to City of Columbus Construction and Material Specification item 306. The concrete shall contain 4.1 bags of cement per cubic yard, Modified as follows: 5% ± 1% air entrainment. The use of an approved single beam vibrating screed will be required.
- *** Sawn joint if constructed full width.

END OF DAY'S WORK

Flexible forms shall be used on E radii of 200' or less.

Concrete for Curb and Gutter, Sidewalks and Drive Ramps shall conform to Item 499 Class C, 6.3 bags of cement per cu. yd. Modified as follows: Air entrainment to be 6% ± 1%.

A subgrade planer or an automatic subgrader will not be required.


Curing material shall conform to 705.07, Type 2, and shall be applied with a motor driven pump sprayer.

**CHERRYSTONE DRIVE SOUTH
CHERRYSTONE DRIVE NORTH
COMMISSION DRIVE**


W/Standard Combined Curb and Gutter

TRAPP DRIVE

MOUNTABLE CURB & GUTTER

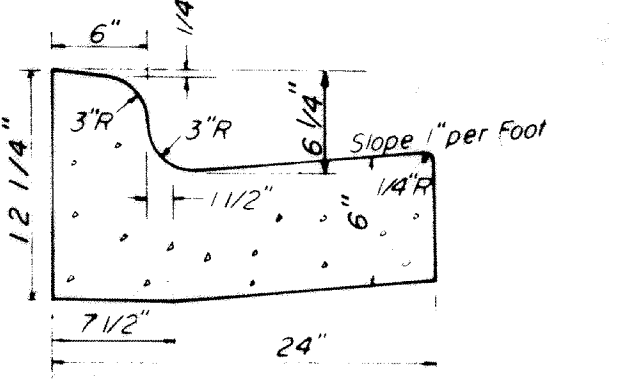

COMBINATION CURB & GUTTER

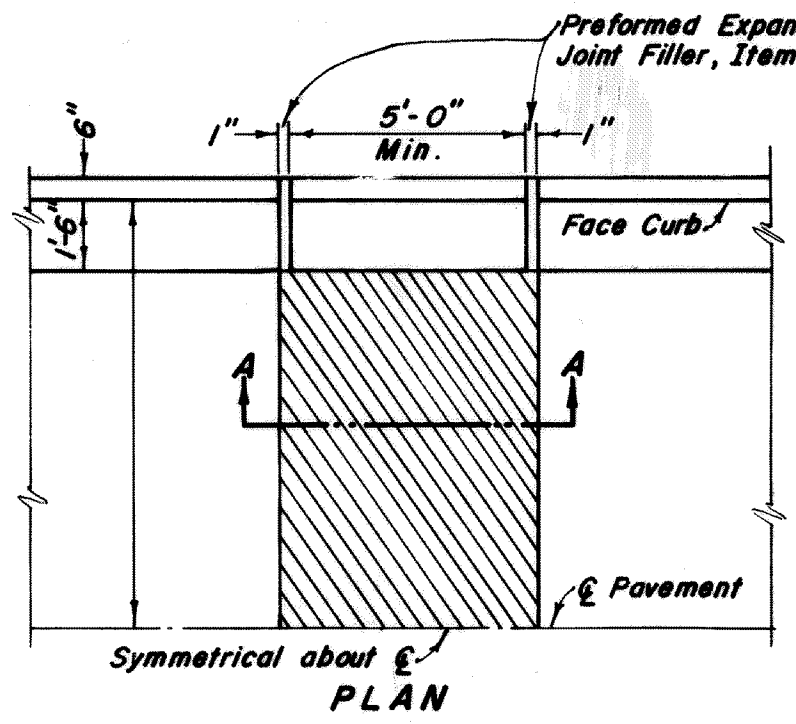


DETAIL OF EXPANSION JOINT

Expansion Joints shall be constructed where shown on the plans. The Bituminous Aggregate Base shall be paid for at the price bid per cubic yard for Item 404 Asphalt Concrete.

CONTRACTION JOINT

Maximum spacing of Sawn Joints shall be 20'

JOINT A & C

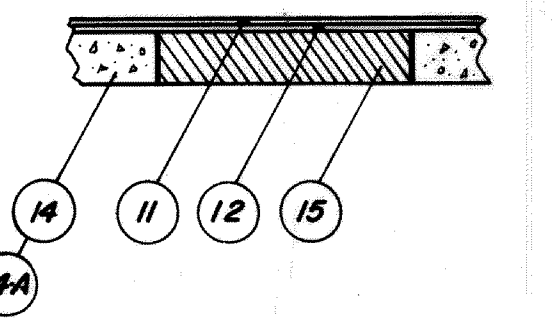

SECTION A-A

15 8" Bituminous Aggregate Base using 404 (85-100) comp.

The Specifications of the State of Ohio, Department of Highways, including all supplements thereto, in force on date of contract, together with the requirements of the City of Gahanna, Ohio shall govern all materials and workmanship involved in construction.

All Item numbers are in accordance with the Ohio Department of Highways or City of Columbus Construction and Material Specifications.



When the pavement design shown on the typical sections is not adequate for contemplated heavier load requirements, the proposed street sections shall be designed in accordance and agreement with the City Engineer.

Sidewalk location shall be determined by the City Engineer.

Two or more curb openings for each lot shall be provided for downspout drains at the time of the permanent construction. Cost to be included in the price bid for Item 609. All curbs shall be sawed for downspout drain placement after the permanent construction is completed. Minimum curb cut shall be one foot.

In the event excavation for the street is from 0" to 6" below that called for on the plans, the Contractor shall replace this excess excavation material with compacted 46D crushed aggregate as directed, and at no extra cost to the owner.

CHERRY BOTTOM GARDENS SECTION TWO	
CITY OF GAHANNA, OHIO	
STANDARD CONSTRUCTION DRAWING	
CONSTRUCTION DETAILS FOR ASPHALT CONCRETE ON P.C. CONCRETE BASE	
APPROVED: EVANS, MECHWART, HAMBLETON & TILTON, INC. CITY ENGINEERS	DATE 1-4-72
BY <i>Robert H. Morris</i> DIRECTOR OF PUBLIC SERVICE	

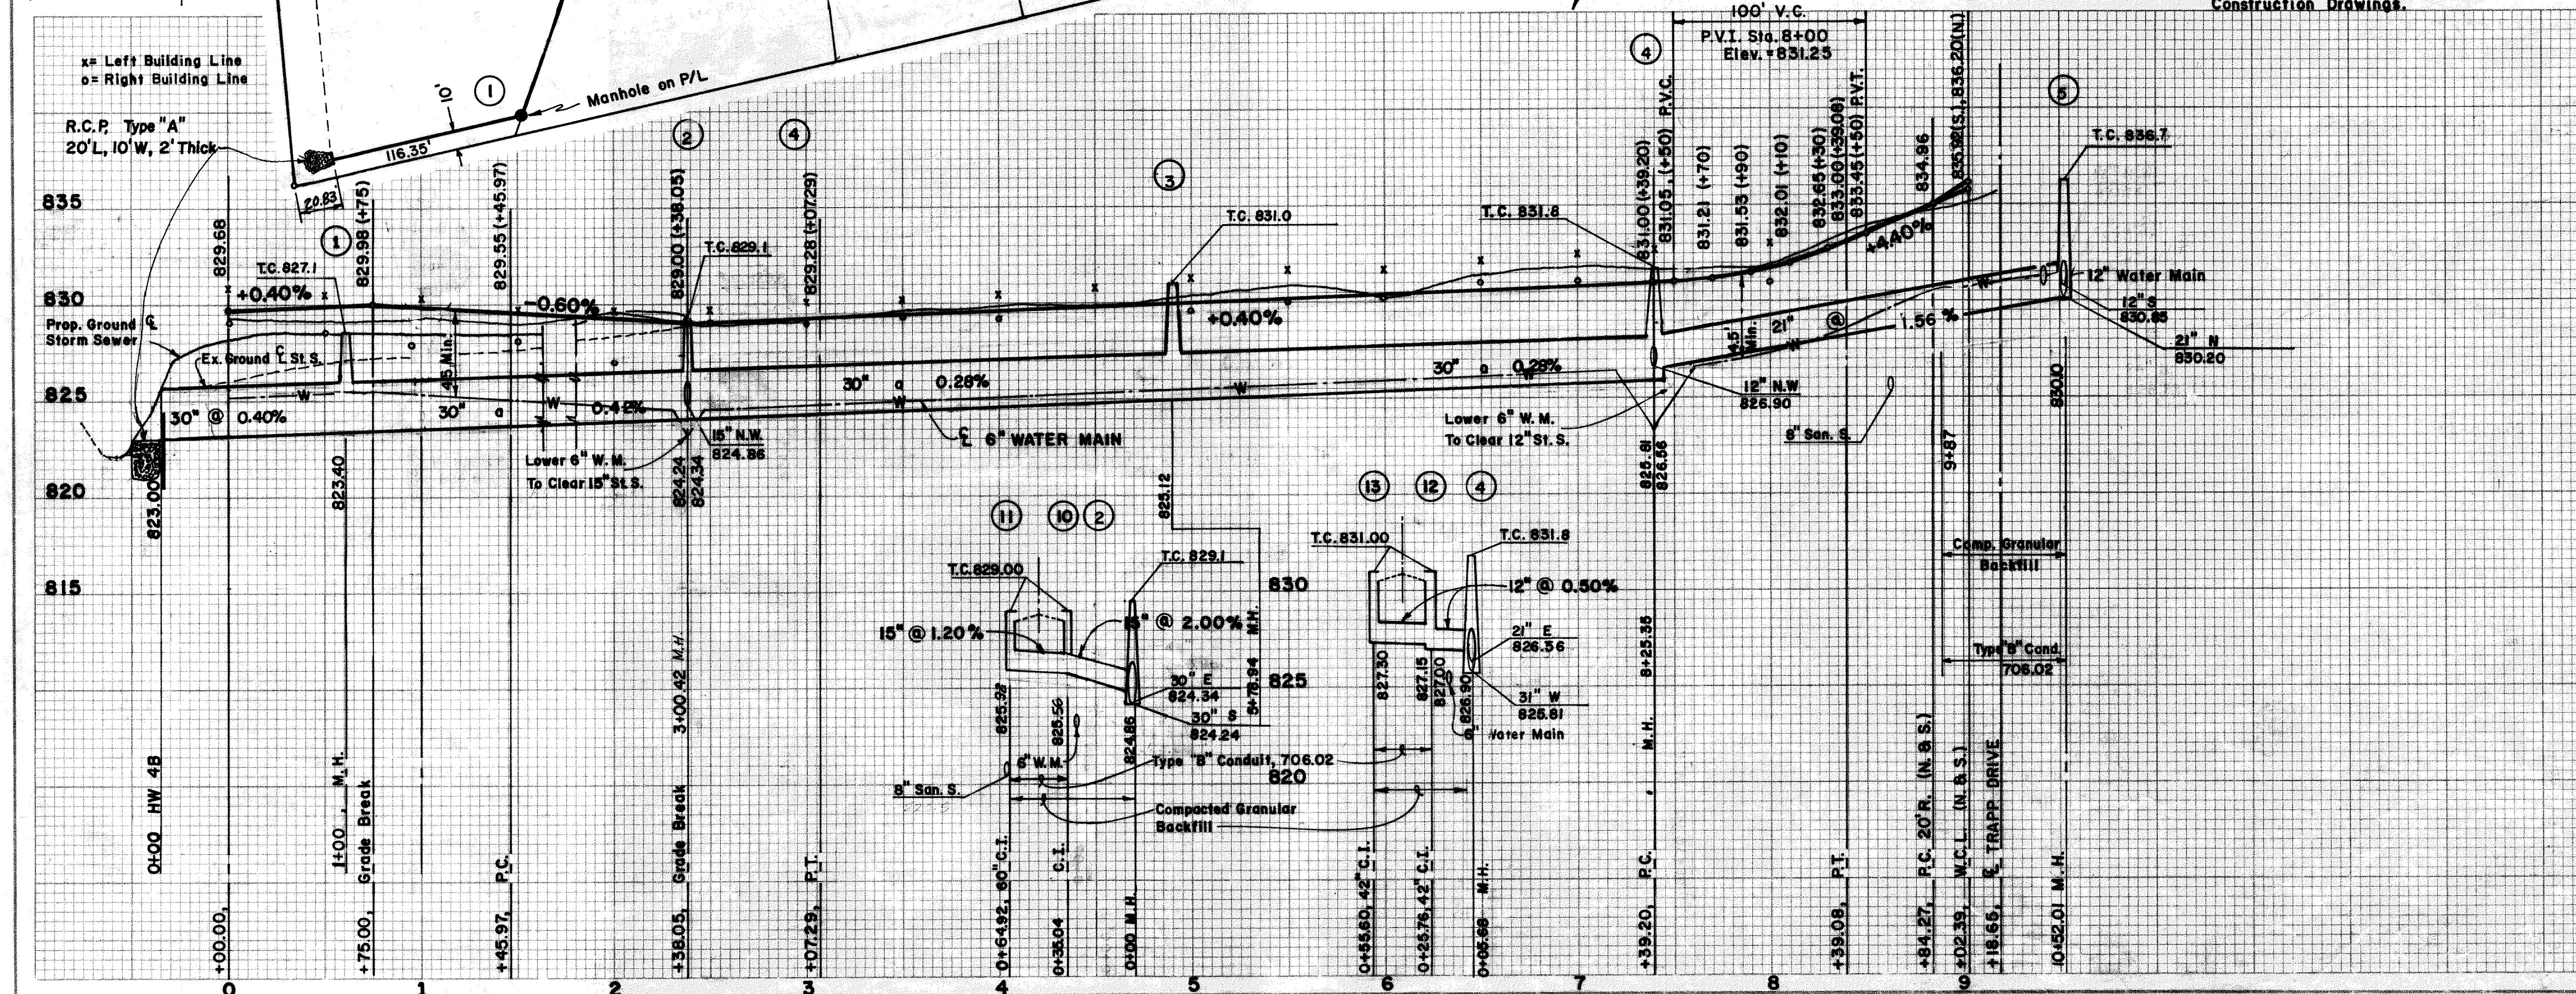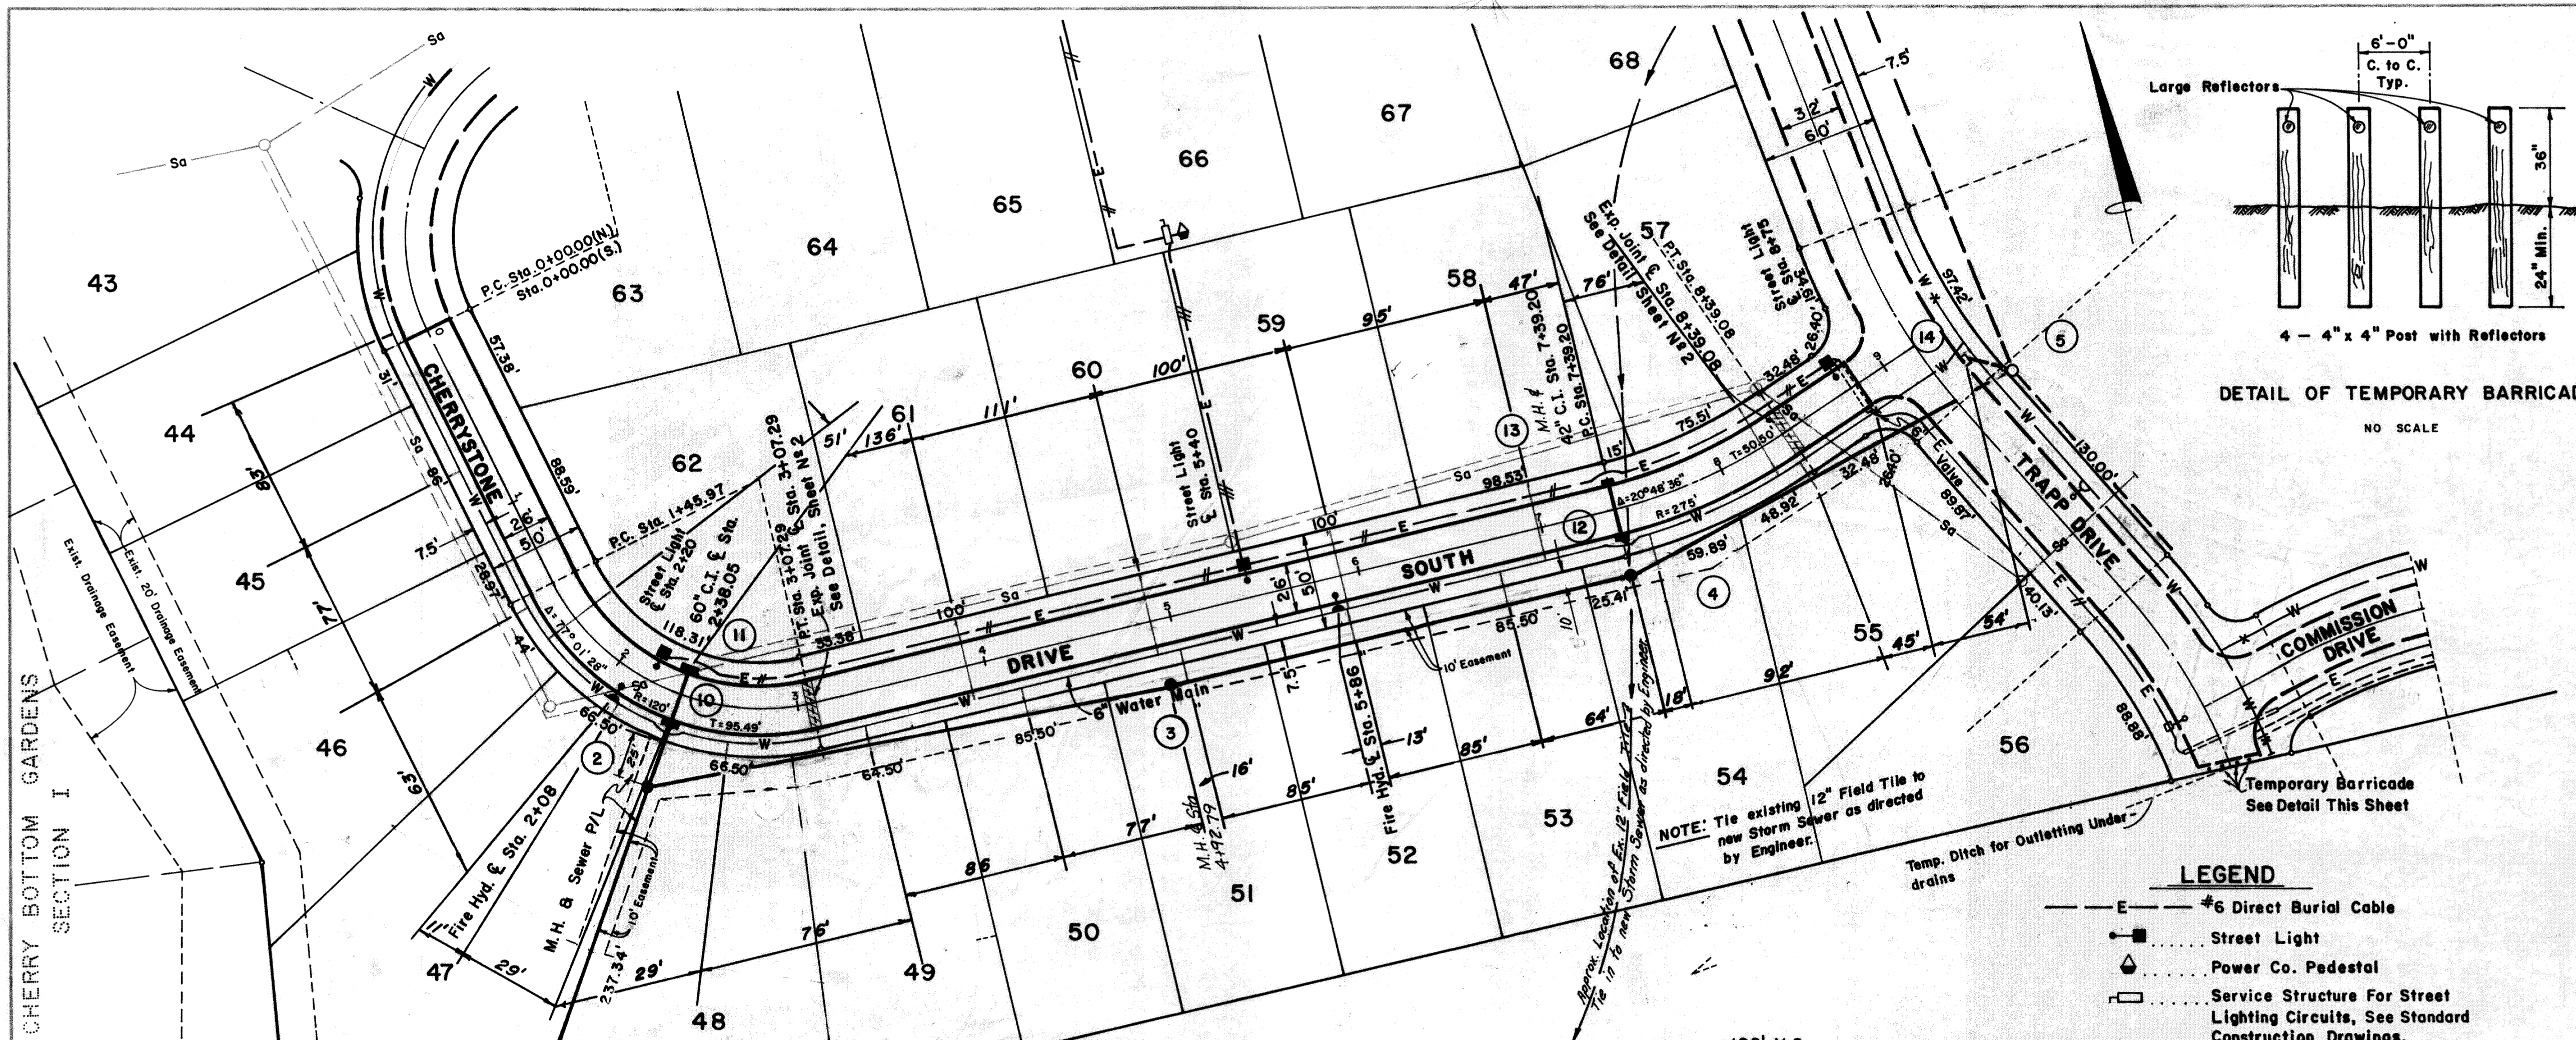

3/4" WATER SERVICE MODIFIED:
The Contractor shall deflect 3/4" Water Service to a point of One Foot min. clearance beneath the proposed storm sewer and extend the water service Five Feet beyond the storm sewer horizontally. Cost of performing this work including all labor and materials shall be included in the unit price bid for 3/4" Water Service (Long or Short).

DETAIL OF TEMPORARY BARRICADE

NO SCALE

LEGEND

— E — #6 Direct Burial Cable
 ● ■ Street Light
 ⬆ Power Co. Pedestal
 □ Service Structure For Street
 Lighting Circuits. See Standard
 Construction Drawings.

CITY OF GAHANNA, OHIO

PRIVATE STREET AND WATER
IMPROVEMENT N^o 293
CHERRY BOTTOM GARDENS
SECTION TWO



SCALE Horz. 1" = 50'
 Vert. 1" = 5'

JULY, 1980




Revised as Constructed 9-24-86

ST-293

P-87

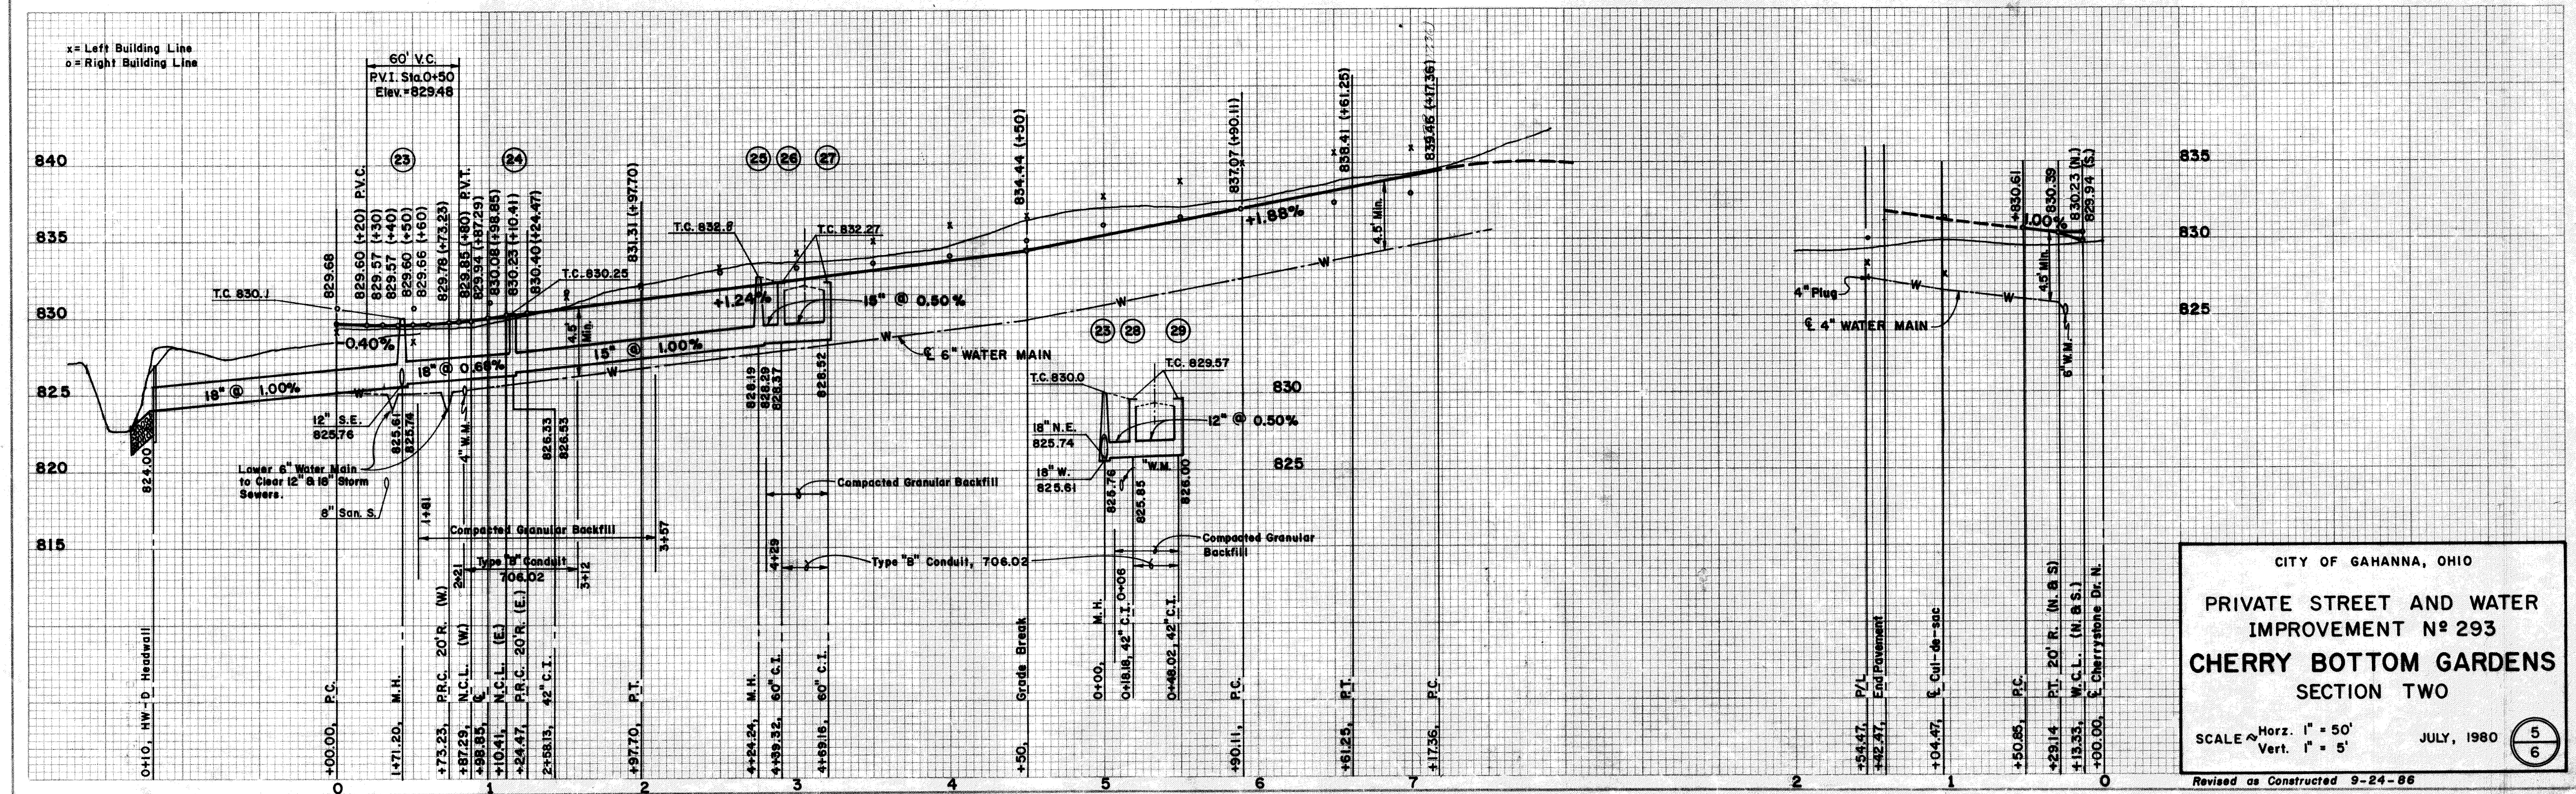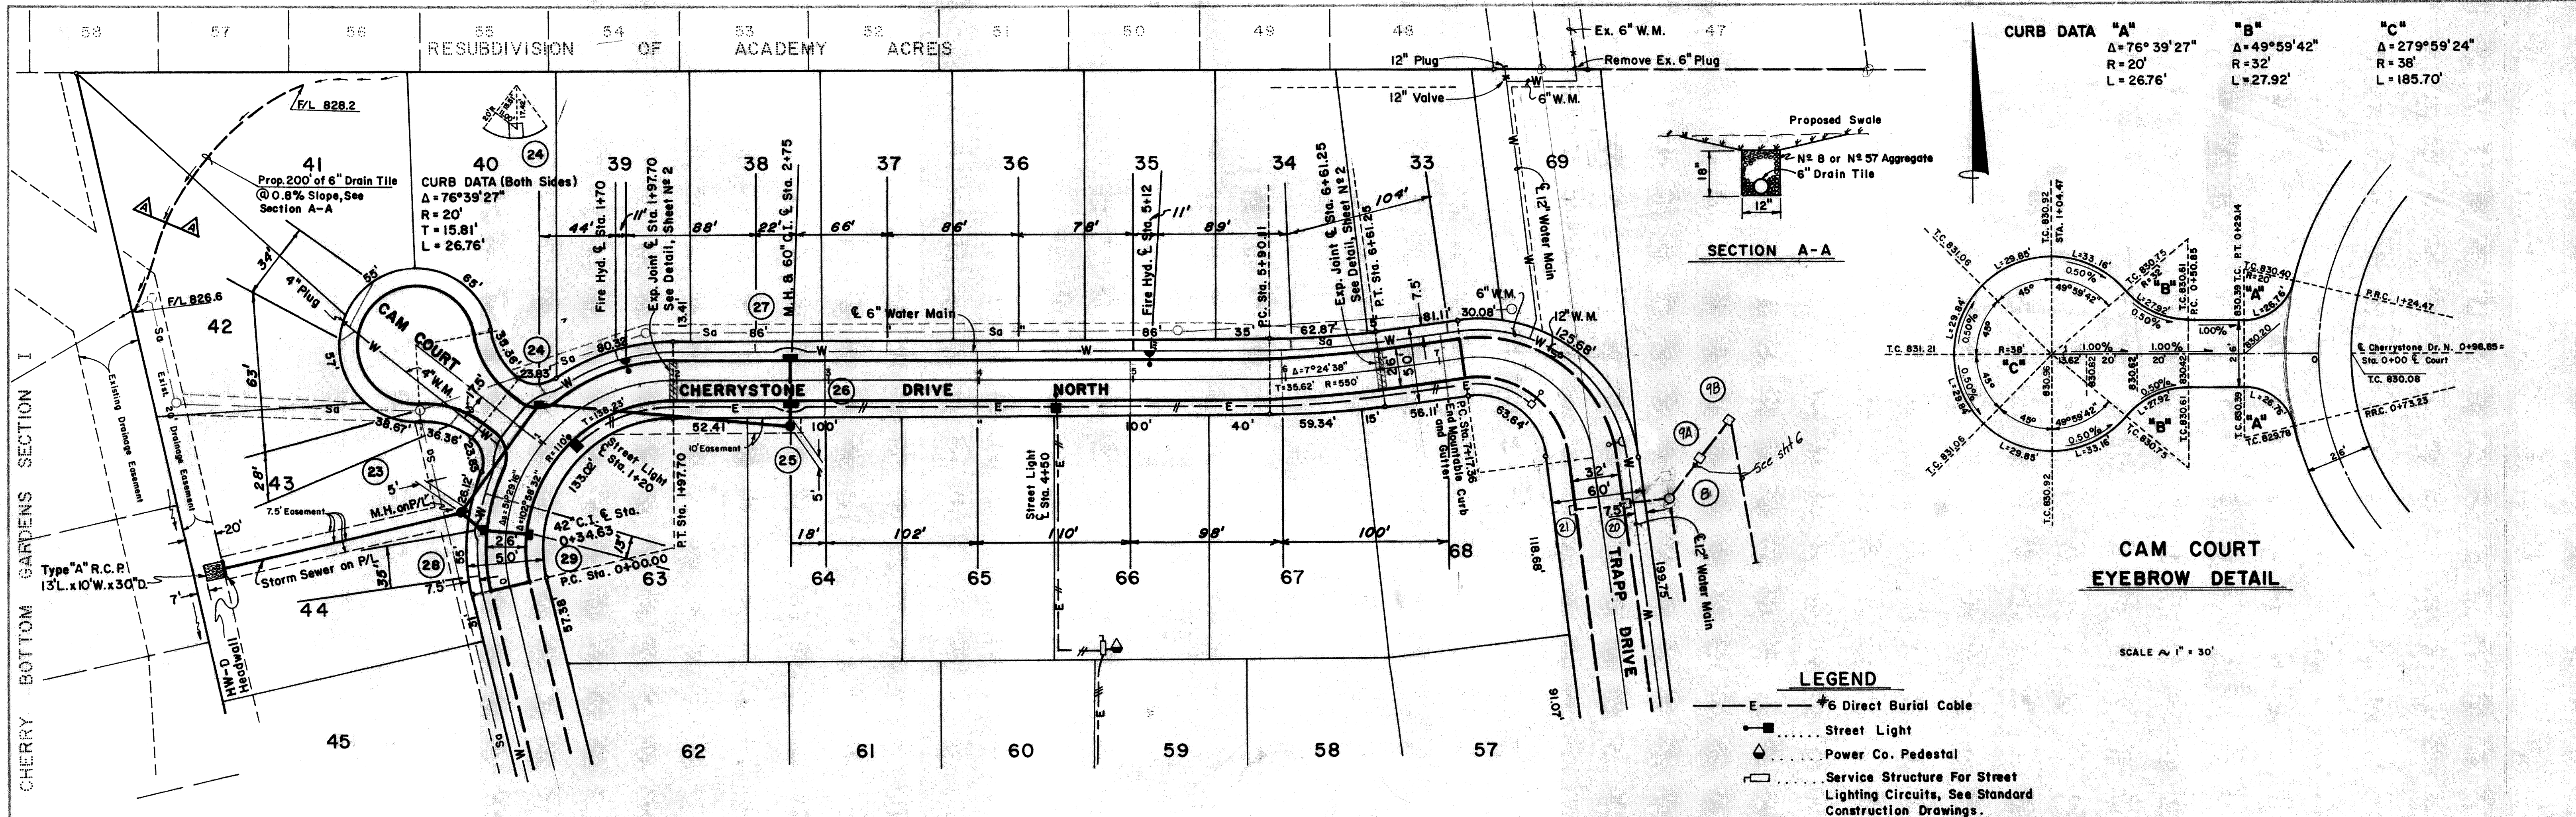

ACADEMY ACRES

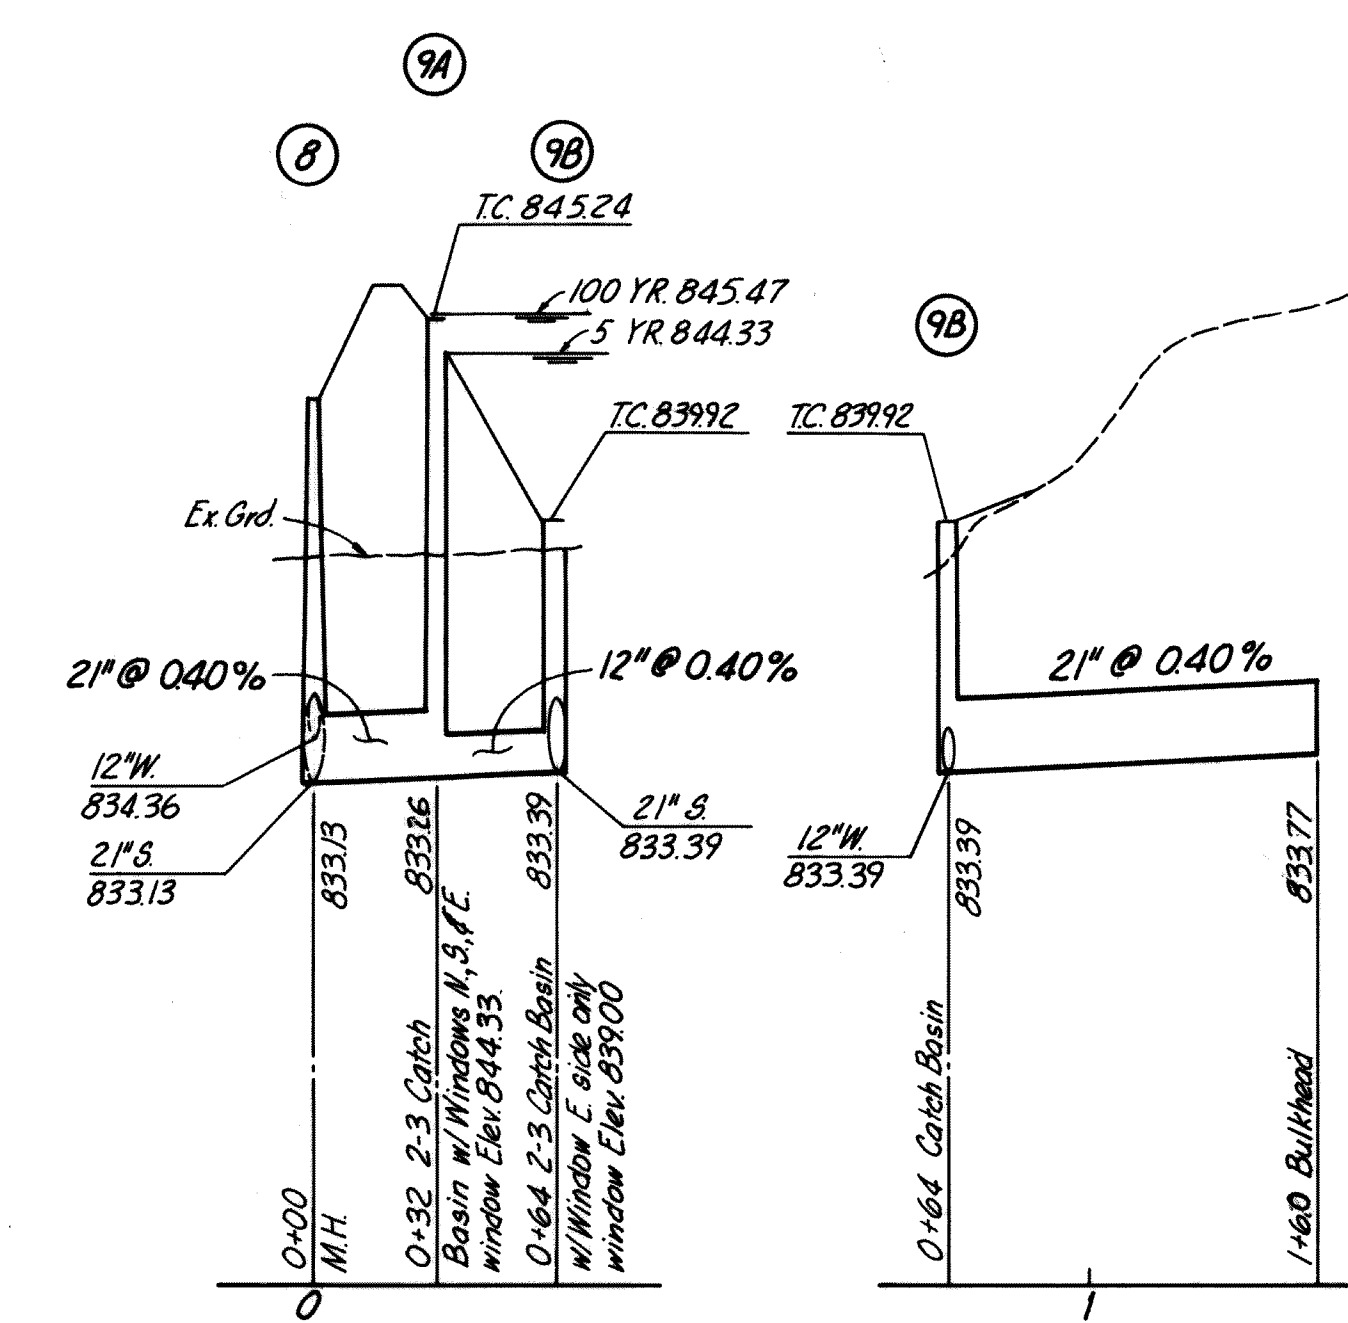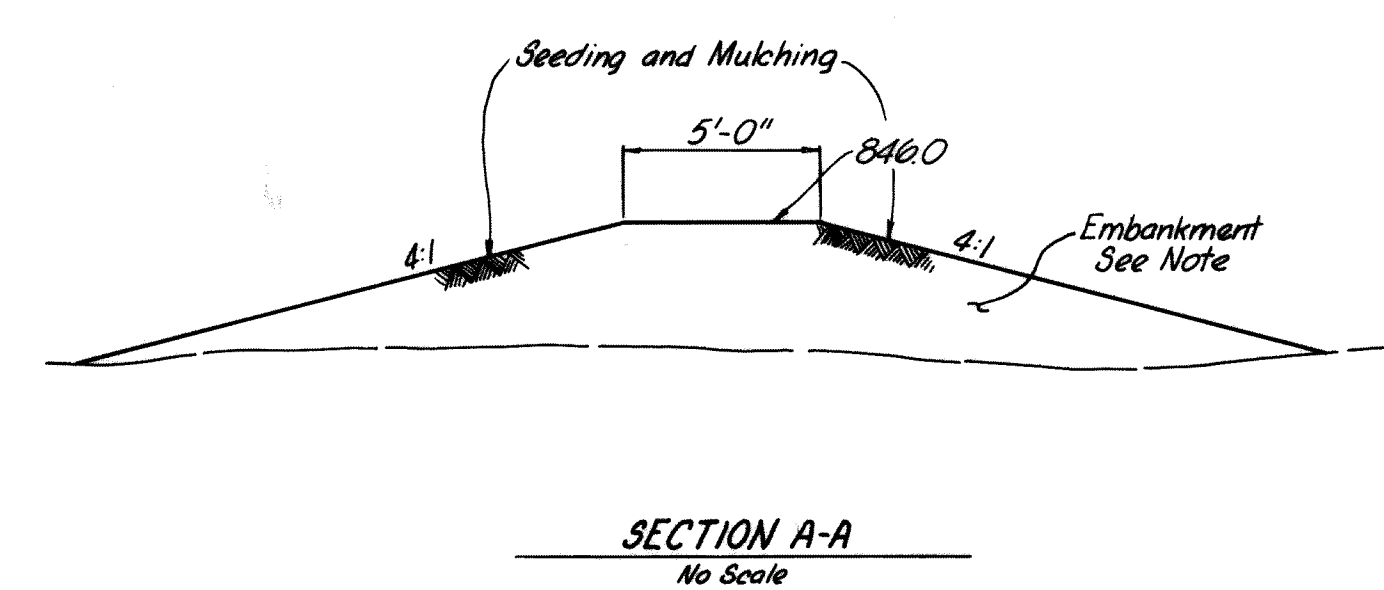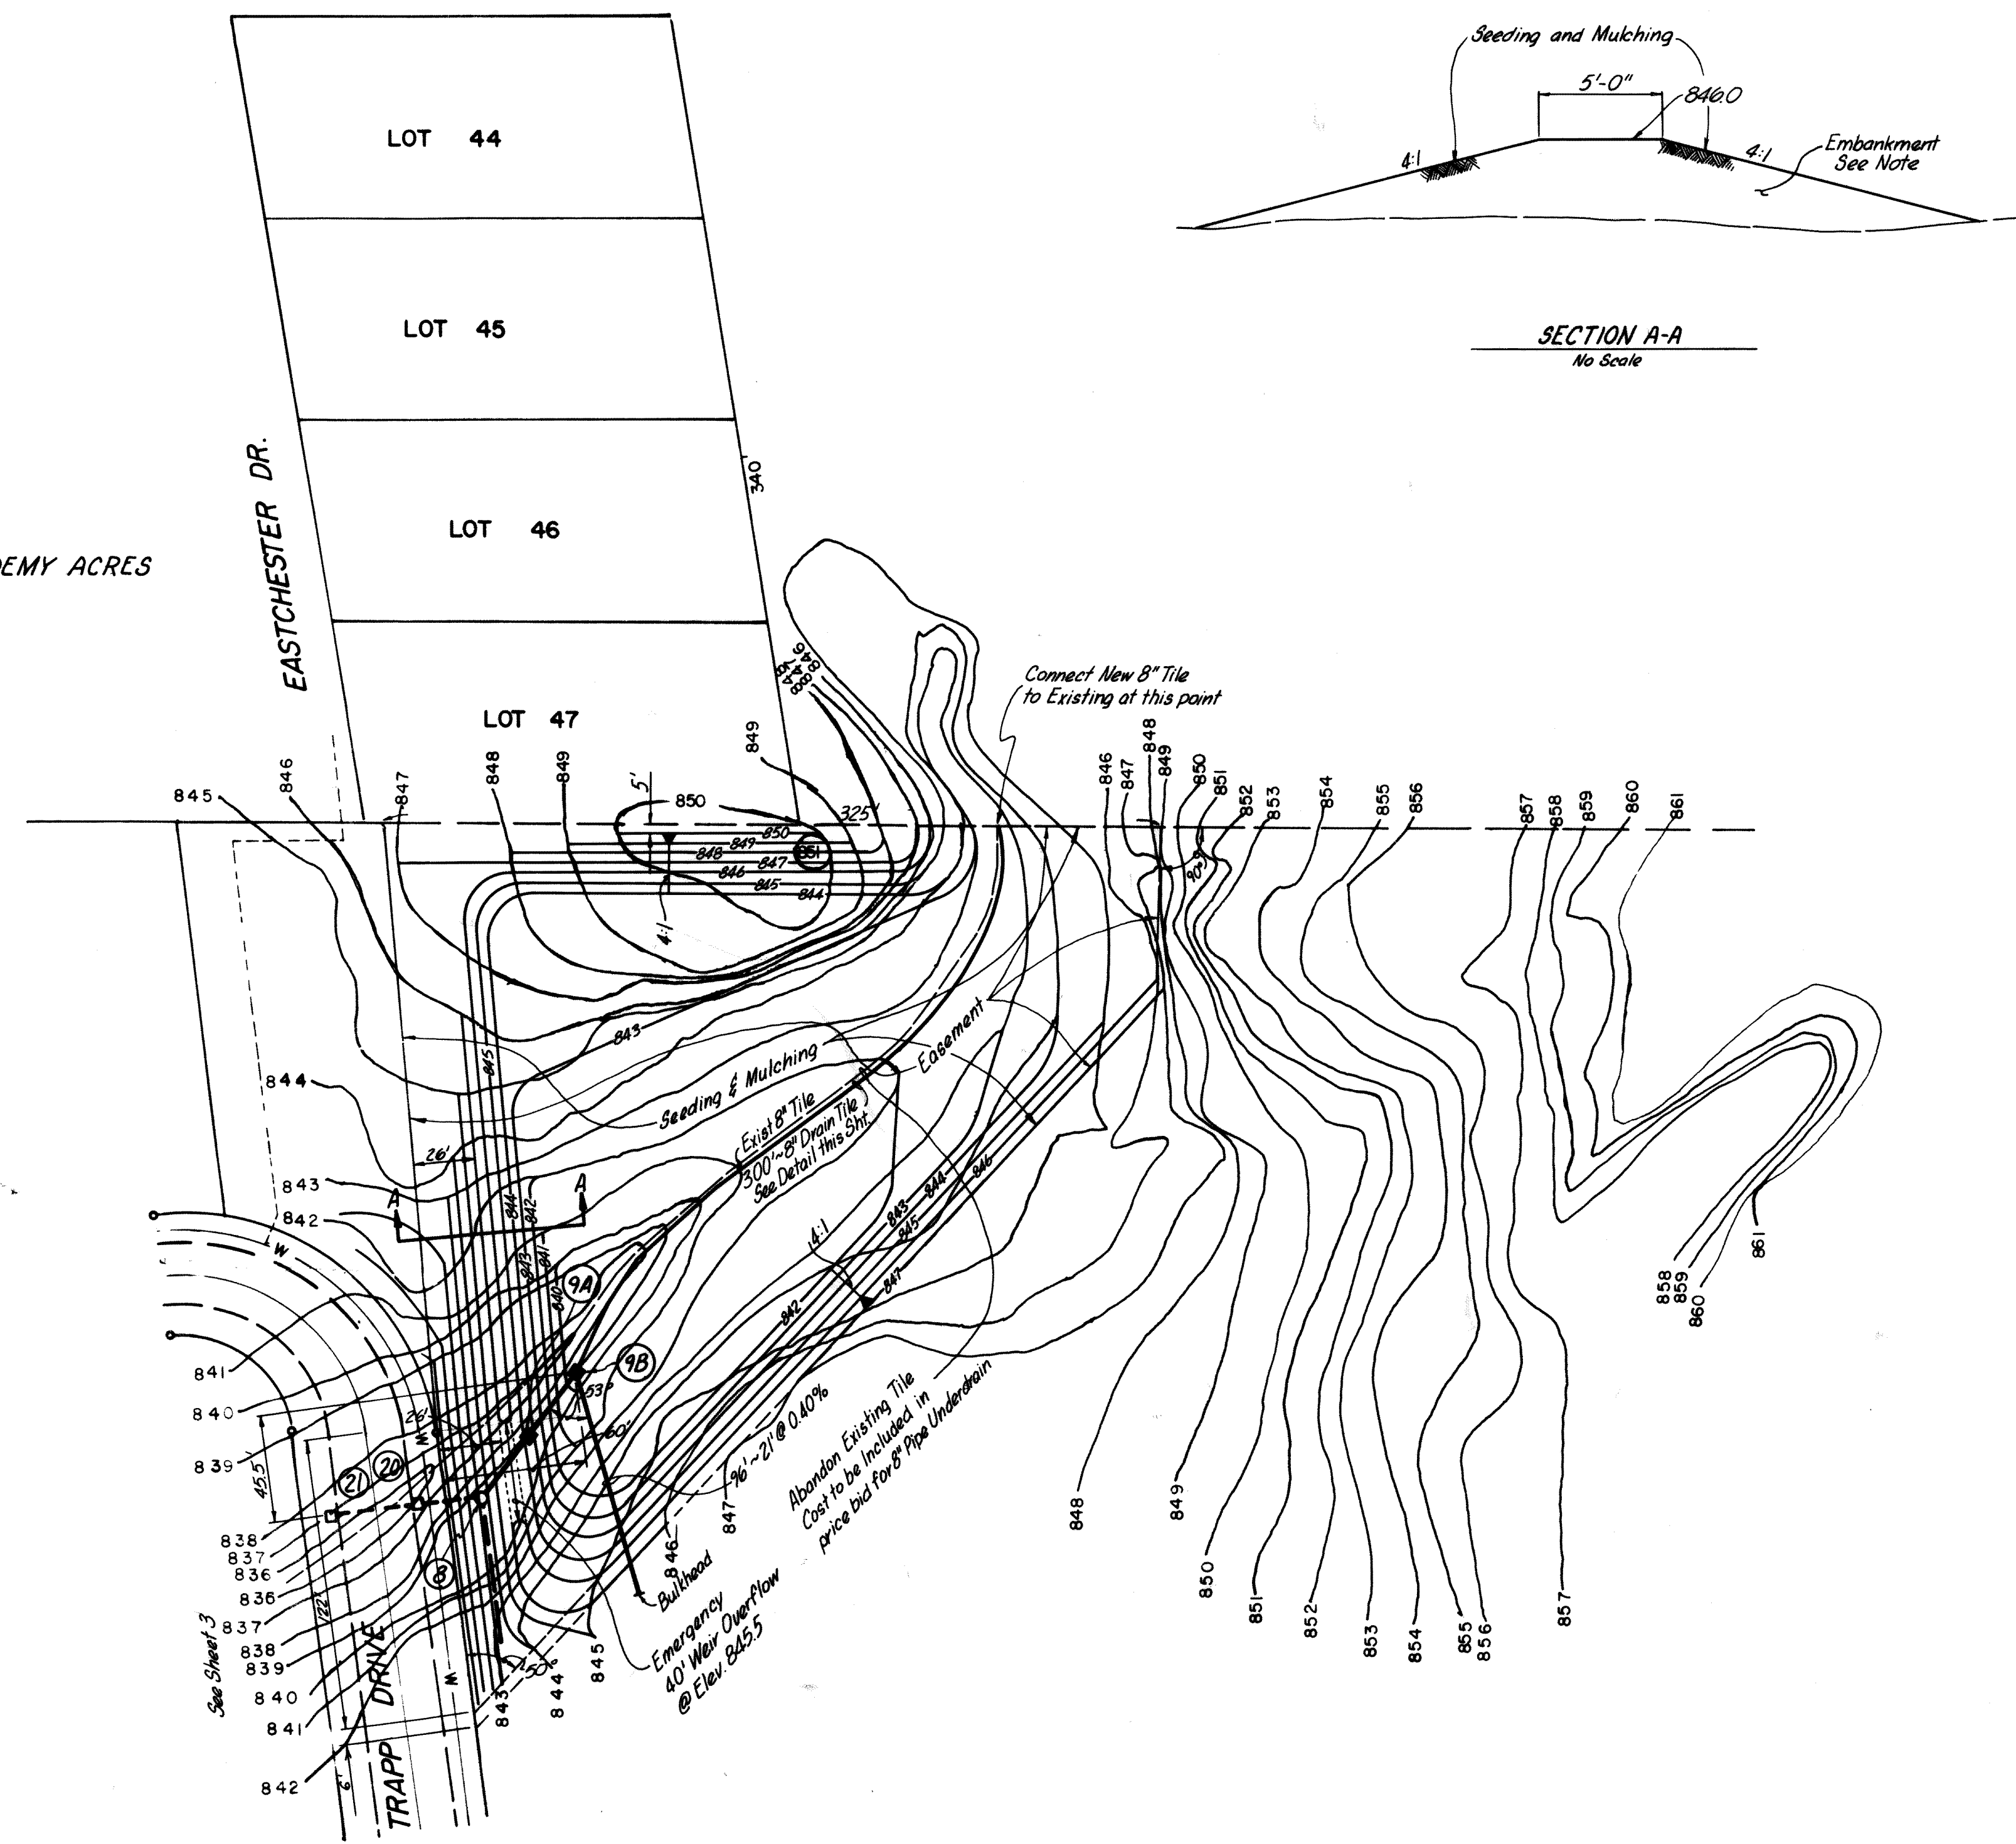

NOTES
(Detention Basin & Storm Sewer Outlet)


EMBANKMENT - All Embankment Construction involved in detention basins shall be in accordance with Section 203.12 of the Ohio Department of Transportation Construction & Material Specifications.

TREES - All trees, whether or not shown on the plans, are to be preserved unless approval to remove is given in writing by the Owner. Cost of tree removal and disposal to be included in price bid for Detention Basin Excavation Item 203.

8\"UNDERDRAIN - The Contractor shall install the 8\"Underdrain in accordance with the details as shown on this plan. The Contractor shall exercise extreme care not to damage the 8\"Underdrain after laying and backfilling 8\" Underdrain.

SEEDING & MULCHING - The Contractor shall seed and mulch all areas as designated on the plans in accordance with Item 659 of the Ohio Department of Transportation Construction and Material Specifications.

CONFORMITY TO PLANS AND DETAILS - The Contractors specific attention is directed to the importance of Constructing Embankments, storm sewer pipes, under drains and structures in conformance with line and grade as shown on the plans and details in order for the Detention Basin to function as intended.

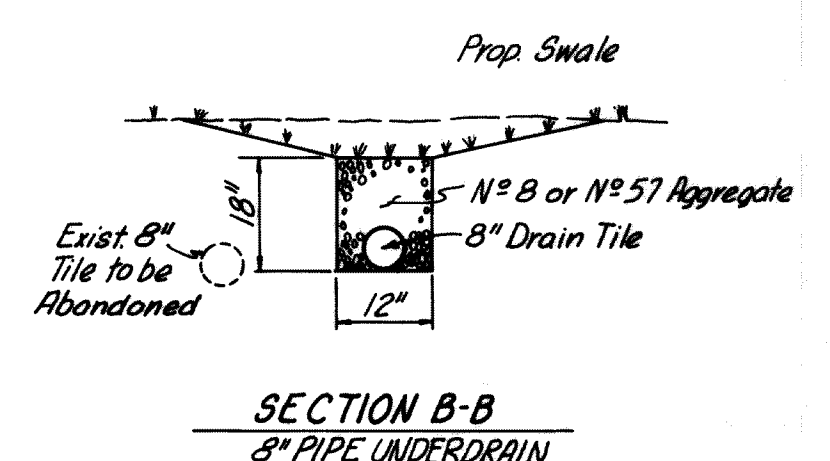

CITY OF SAHANNA, OHIO

PRIVATE STREET AND WATER
IMPROVEMENT N° 293

CHERRY BOTTOM GARDENS
SECTION TWO

SCALE Horiz. 1"=50'
Vert. 1"=5'

EVANS, MICHWART, HAMBLETON & TILTON, INC.
CONSULTING ENGINEERS & SURVEYORS

ST-293 P-878

CITY OF GAHANNA, OHIO
PRIVATE STREET, WATER AND STREET LIGHTING
IMPROVEMENT NO. 364

GENERAL NOTES

SPECIFICATION: The requirements of the City of Gahanna, together with the Standard Specifications of the State of Ohio, Department of Transportation, including all supplements thereto in force on date of contract shall govern all materials and workmanship involved in the improvements shown on these plans except as such specifications are modified by the following specifications or by the construction details set forth herein.

STANDARD CONSTRUCTION DRAWINGS: All pertinent Standard Construction Drawings are available upon request at the office of the City Engineer.

PERMITS: The Contractor shall obtain all necessary permits.

SAFETY REQUIREMENTS: The Contractor and Sub-Contractor shall be solely responsible for all federal, state and local safety requirements, together with exercising precautions at all times for the protection of persons (including employees) and property. It is also the sole responsibility of the Contractor and Sub-Contractor to initiate, maintain and supervise all safety requirements, precautions and programs in connection with this work.

MISCELLANEOUS WORK: All items of work called for on the plans for which no specific method of payment is provided shall be performed by the Contractor and the cost of same shall be included in the price for the various related items.

FIELD TILE: All field tile broken during excavation shall be replaced to its original condition or connected to either the curb subdrain or to the storm sewer system as directed by the Engineer.

SURPLUS EXCAVATION: The Contractor shall dispose of all surplus street excavation on the project site where and as directed by the Owner.

UNAUTHORIZED STREET EXCAVATION: In the event excavation for the street is from 0" to 6" below that called for on the plans, the Contractor shall replace this excess excavated material with compacted 46D crushed aggregate as directed and at no extra cost to the owner.

STORM SEWERS: Unless otherwise noted on the plans all Storm Sewers shall be as hereafter specified: (1) All sizes of storm sewer located within or across proposed or existing pavement areas shall be Type B Conduit, 706.02, with Class B Bedding, (2) Storm Sewer located outside pavement areas shall be Type E Conduit, 706.01, Class C Bedding, for 15 inch and smaller, and shall be Type E Conduit, 706.02, Class C Bedding, for 18 inch and larger. The following modifications to Ohio Department of Transportation Specifications shall apply: (1) Type E Conduits shall have sealed joints; (2) Granular backfill material shall be compacted granular material, Item 310-A placed within limits shown on the plan including around all inlet structures. Granular backfill shall extend from the bottom of the trench to a plane 6 inches below the subgrade.

CURB INLETS: All curb inlets shall be channeled as directed.

ROOF DRAIN OPENINGS: The Contractor shall provide two roof drain openings in the curb for each lot, each opening located not more than 4 feet in from each lot line.

STREET LIGHTING: Standard Electrical Specifications and Standard Construction Drawings, covering Street Lighting for the City of Gahanna, Ohio, shall apply.

EXPANSION JOINTS: It shall be the responsibility of the Contractor to adequately barricade the street in the vicinity of all expansion joints, until such time as the street is open to traffic.

WATER MAINS: All water mains shall be either Ductile Iron Class 53 (4" through 10"), Class 54 (12" and larger), or Polyvinyl Chloride, Class 150. All bends, joint deflections and fittings shall be backed with concrete where and as directed. Where water mains or services cross proposed or existing streets, backfill shall be compacted granular material, Item 310-A, within limits 5 feet outside the edge of pavement or curb extended from the bottom of the trench to a plane 6 inches below the subgrade. The services may be jacked across the street in lieu of open cut and the use of granular backfill.

CURB BOXES: Curb boxes shall be located one-half foot from the property line unless otherwise shown on the plans or ordered by the Engineer.

CHLORINATION OF WATER MAINS: The Contractor shall make arrangements to have the water mains chlorinated by the City of Columbus. The cost of chlorination shall be included in the price bid for the various water main items.

EXISTING UTILITIES: The identity and location of the existing underground utility facilities known to be located in the construction area have been shown on the plans as accurately as provided by the Owner of the underground utility. The City of Gahanna and/or Engineer assumes no responsibility as to the accuracy or the depths of the underground facilities shown on the plans.

Support, protection and restoration of all existing utilities and appurtenances shall be the responsibility of the Contractor. The cost of this work shall be included in the price bid for the various items.


The Contractor shall cause notice to be given to the Ohio Utilities Protection Service (telephone 800-362-2764 - toll free) and to the Owners of underground utility facilities shown on the plans who are not members of a registered underground protection service in accordance with Section 153.64 of the Revised Code. The above mentioned notice shall be given at least 48 hours prior to start of construction.

The following utilities are located within the work limits of this project, and the Owners do not subscribe to a registered underground utility protection service:

UTILITY	OWNER	TELEPHONE NO.
Water & Sewer	City of Gahanna	471-3827

CHERRY BOTTOM
SECTION 4

1986

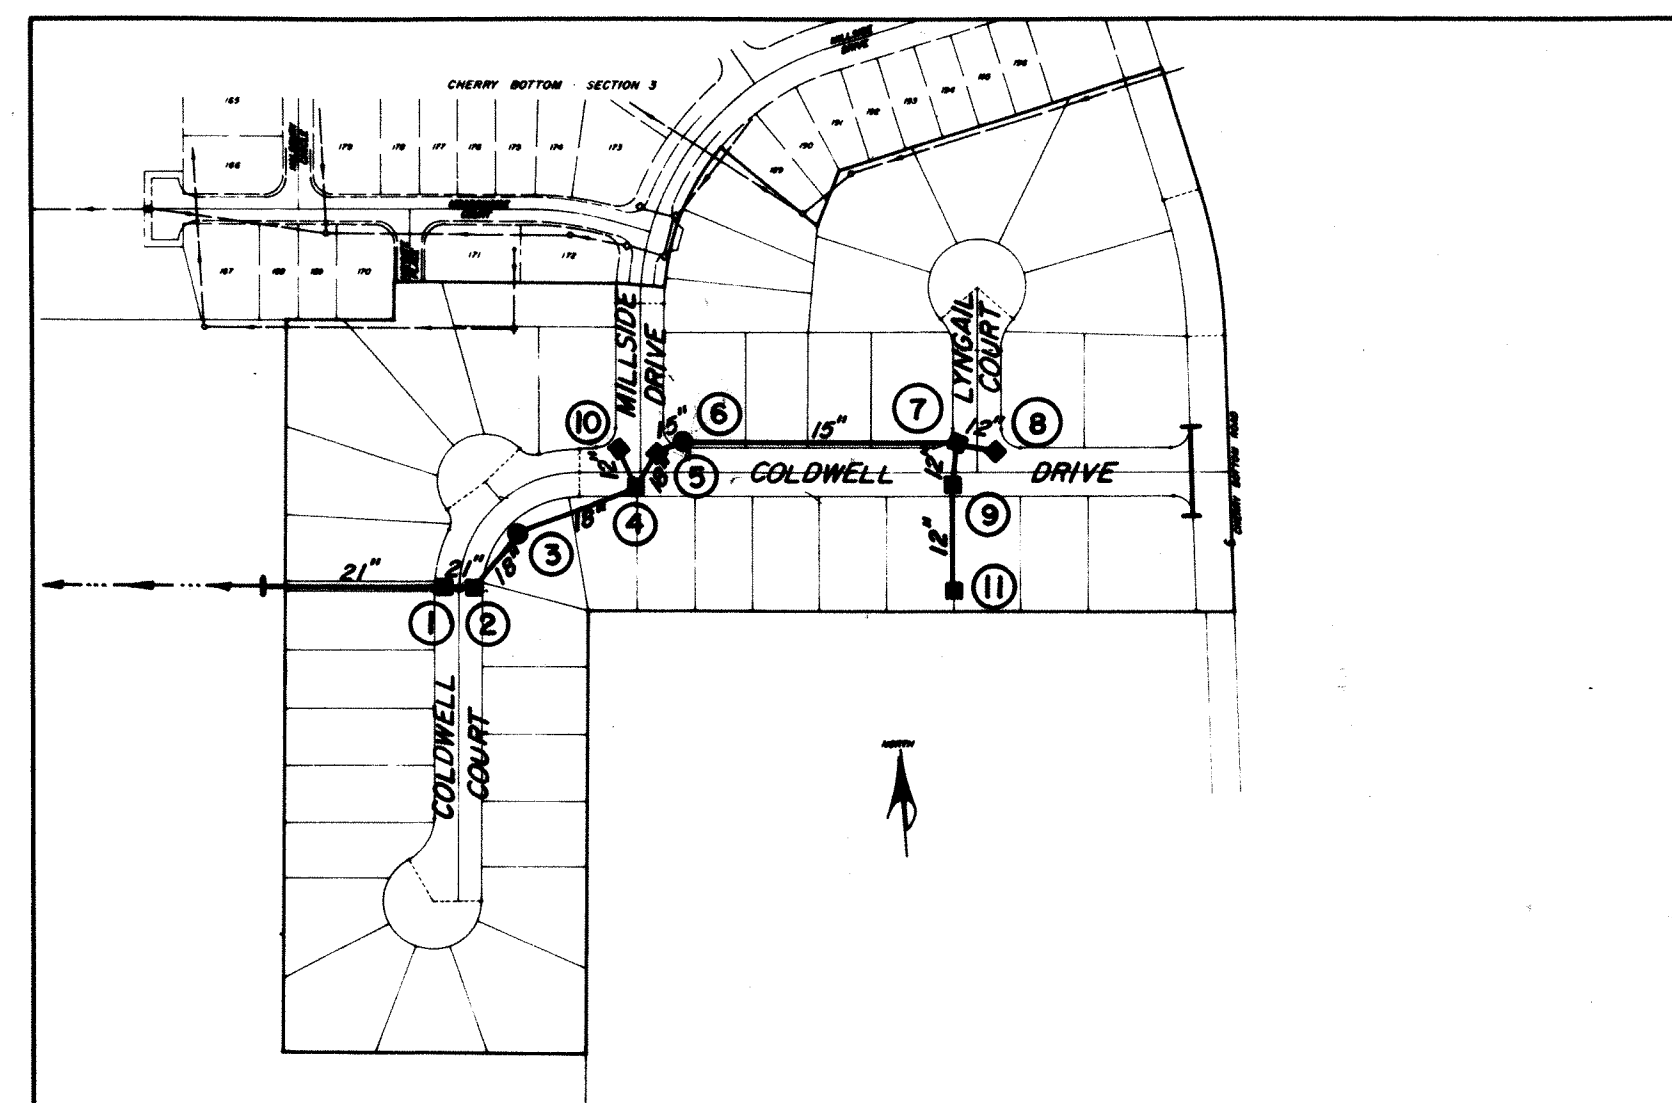

INDEX MAP
SCALE 1"=200'

PREPARED BY
EVANS, MECHWART, HAMBLETON & TILTON, INC.
CONSULTING ENGINEERS & SURVEYORS
GAHANNA, OHIO

By David A. Hussey 7-7-86
Registered Engineer Date

ESTIMATE OF QUANTITIES			
ITEM	QUAN.	UNIT	DESCRIPTION
203	5,675	Cu.Yds.	Excavation Including Embankment Construction (R/W only)
304	4	Cu.Yds.	12" Aggregate Base
305	5,290	Sq.Yds.	7" Portland Cement Concrete Base
402	185	Cu.Yds.	Asphalt Concrete
404	135	Cu.Yds.	Asphalt Concrete
407	535	Gals.	Bituminous Tack Coat
605	3,470	Lin.Ft.	4" Underdrain
608	128	Sq.Ft.	Concrete Curb Ramps
609	395	Lin.Ft.	Concrete Combination Curb & Gutter
609	3,075	Lin.Ft.	Mountable Curb
Spec.	65	Lin.Ft.	Expansion Joints
Spec.	80	Sq.Yds.	Base, Asphalt, Curb & Underdrain Removed and Disposed of
WATER MAIN ITEMS			
603	115	Lin.Ft.	12" Conduit, Type "E", 706.01
603	105	Lin.Ft.	12" Conduit, Type "E", 706.02
603	320	Lin.Ft.	18" Conduit, Type "E", 706.01
603	210	Lin.Ft.	18" Conduit, Type "E", 706.02
603	40	Lin.Ft.	18" Conduit, Type "B", 706.02
603	195	Lin.Ft.	21" Conduit, Type "E", 706.02
603	25	Lin.Ft.	21" Conduit, Type "B", 706.02
623	360	Sq.Yds.	Seeding & Mulching (along Cherry Bottom Road)
Spec.	90	Lin.Ft.	58" x 91" Reinforced Elliptical Concrete Pipe
604	1	Each	Std. Catch Basin
604	2	Each	Type "A" Manhole
604	2	Each	Curb & Gutter Inlet (Mountable)
602	36	Cu.Yds.	Reinforced Concrete Masonry (LW-3 Headwall)
602	0.65	Cu.Yds.	Concrete Masonry (Endwall, 44'-5165)
Spec.	40	Cu.Yds.	Rock Channel Protection, Type "A"
Spec.	2	Each	Exist. 42" Curb Inlet converted into Type "A" Manhole
STREET LIGHTING			
1,730	Lin.Ft.	6" Water Main	
6	Each	6" Valve & Box (Includes Hydrant Valves)	
15	Each	3/4" Service (Short)	
25	Each	3/4" Service (Short)	
4	Each	Fire Hydrant	
Lump Sum	Lump Sum	Street Lighting, Complete	
Lump Sum	Lump Sum	Overlaid Grading	
1	Each	6" x 12" Trapping Sleeve & Valve	
1	Each	3/4" Service (Short) installed on Exist. 6" Water Main	

BENCH MARKS

B.M. - Top of R.R. Spike Centerline Intersection of Cherry Bottom Road and Morse Road. Elev. 820.96

B.M. - R.R. Spike West side Power Pole N°1007, West side Cherry Bottom Road, 1st Pole South of Millside Drive. Elev. 819.82

B.M. - North bolt of Hydrant @ N.E. corner of "Cherry Bottom Gardens." Elev. 812.58

James F. McHugh 7/10/86
Superintendent, Division of Water & Sewer
City of Gahanna, Ohio Date







Charles R. Wolfe 7/19/86
Superintendent of Streets, City of Gahanna, Ohio Date

James F. McHugh 7/14/86
Director of Public Services, City of Gahanna, Ohio Date






James F. McHugh 7/14/86
Mayor, City of Gahanna, Ohio Date

Charles A. Young 7-11-86
Auditor, City of Gahanna, Ohio Date

AS CONSTRUCTED 12-17-86

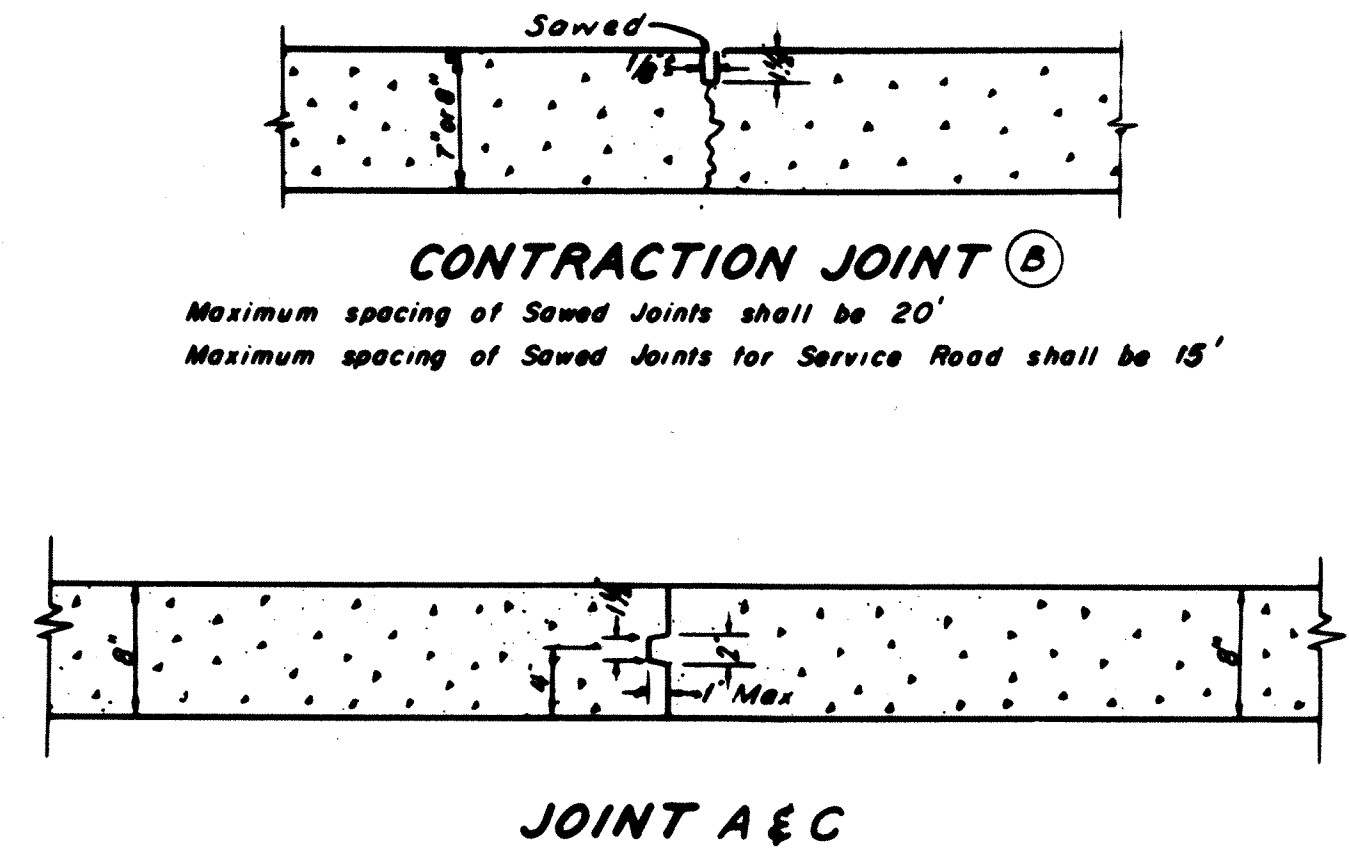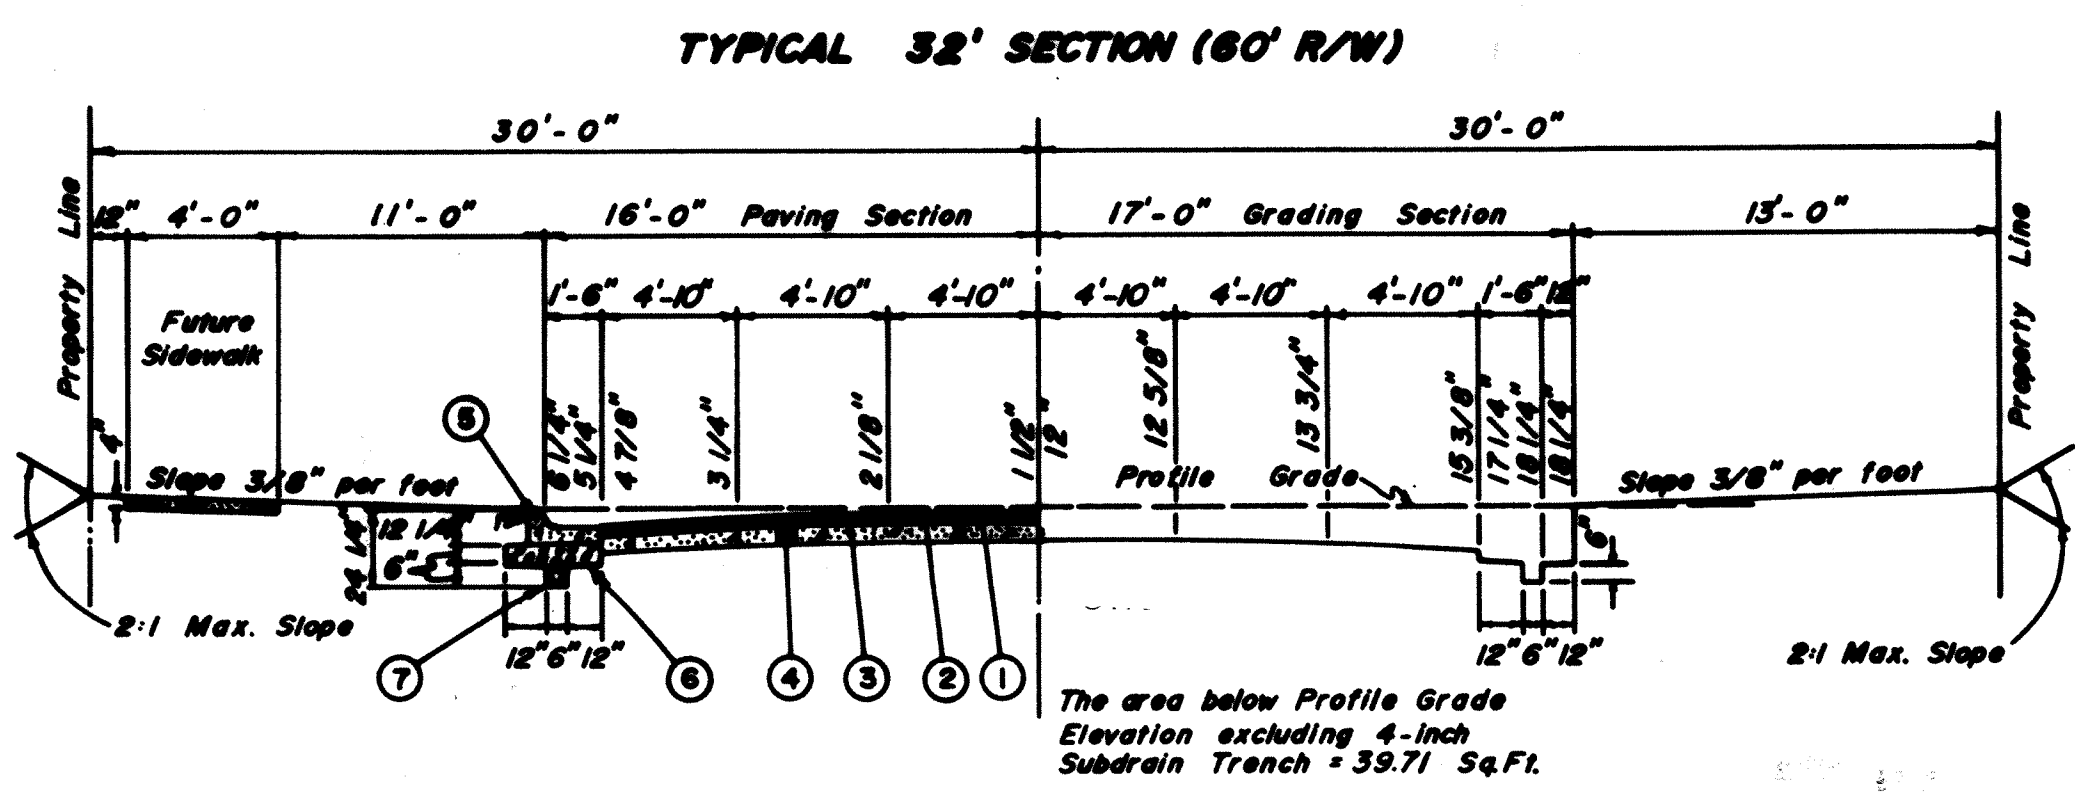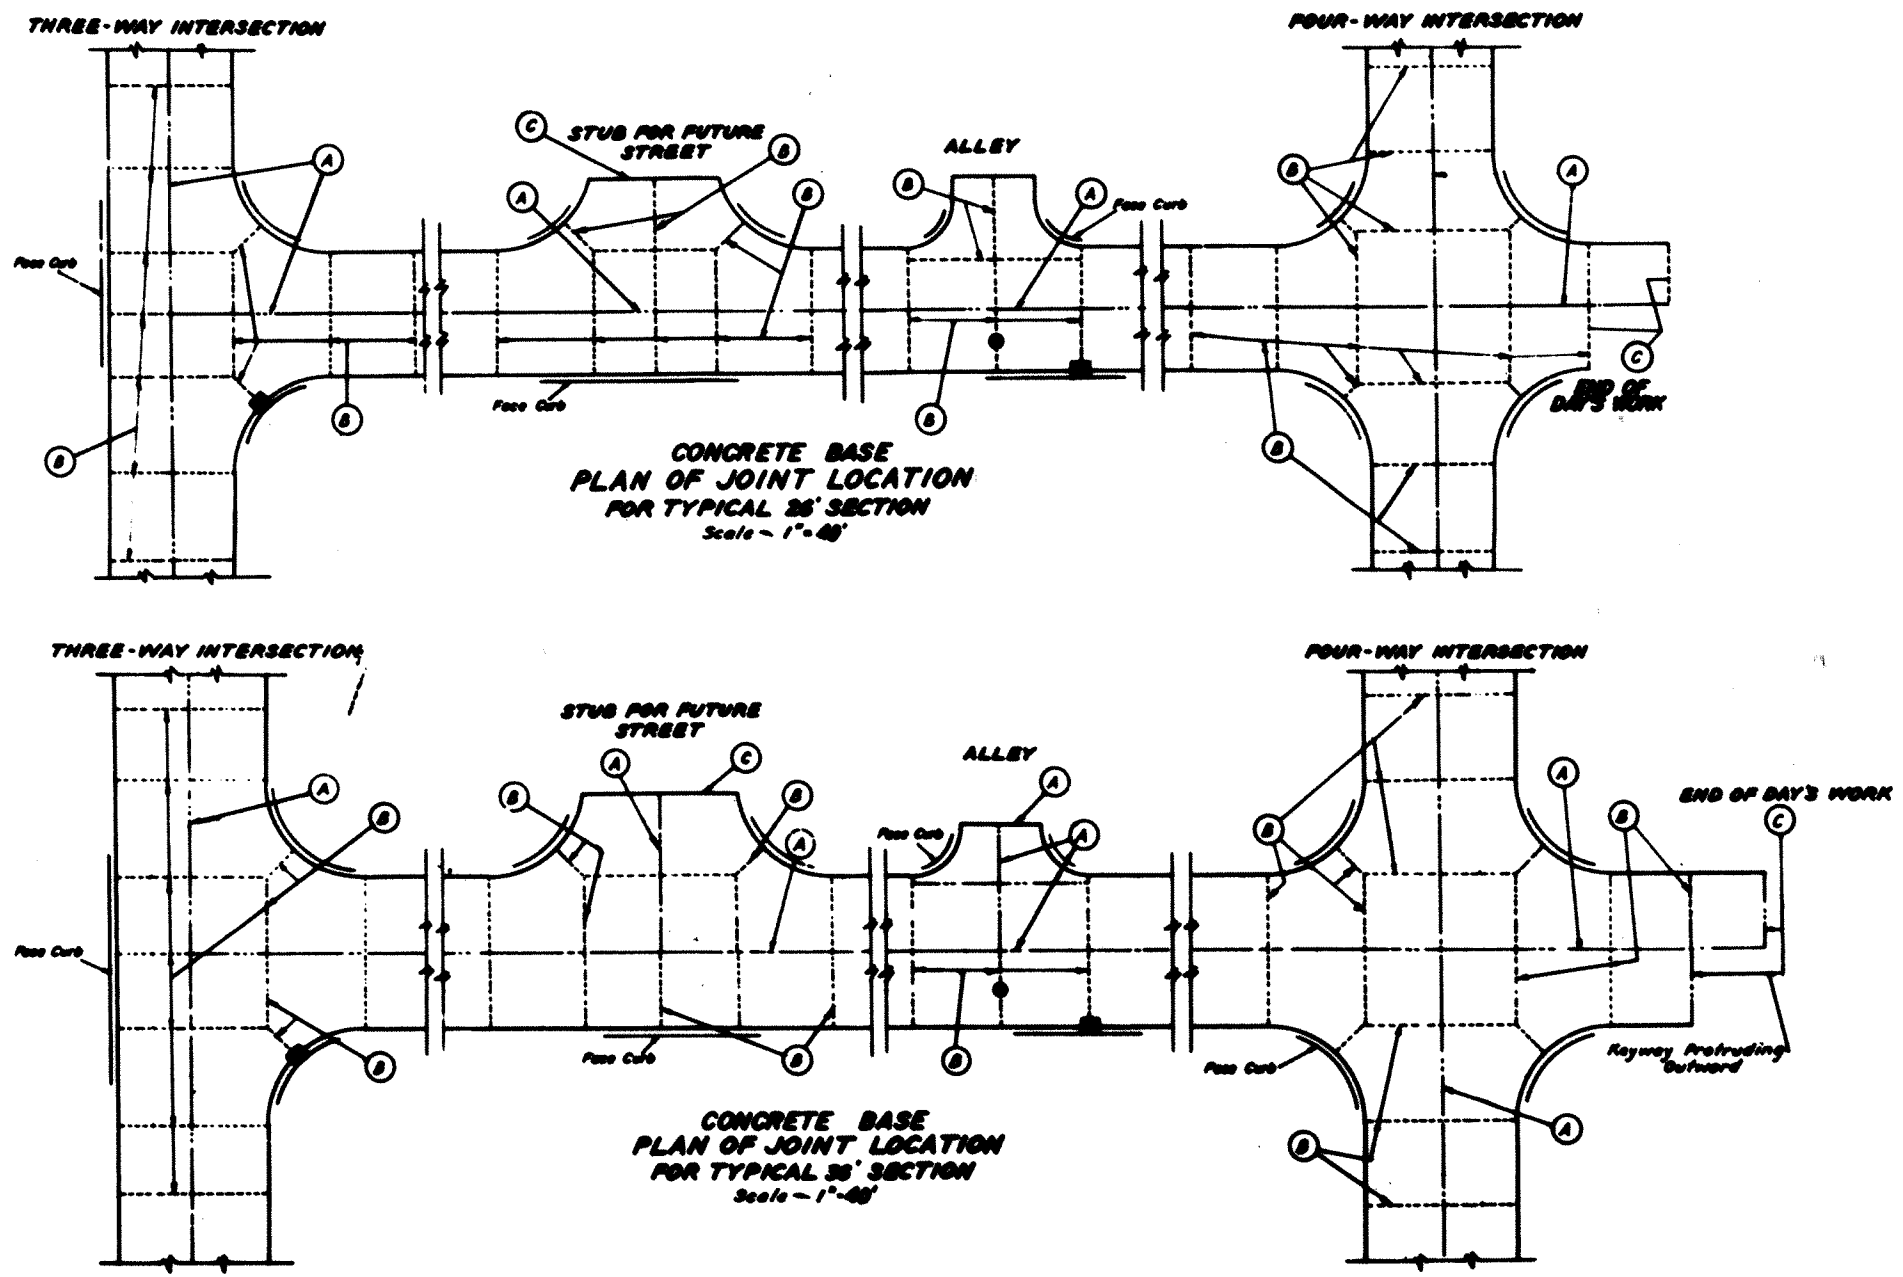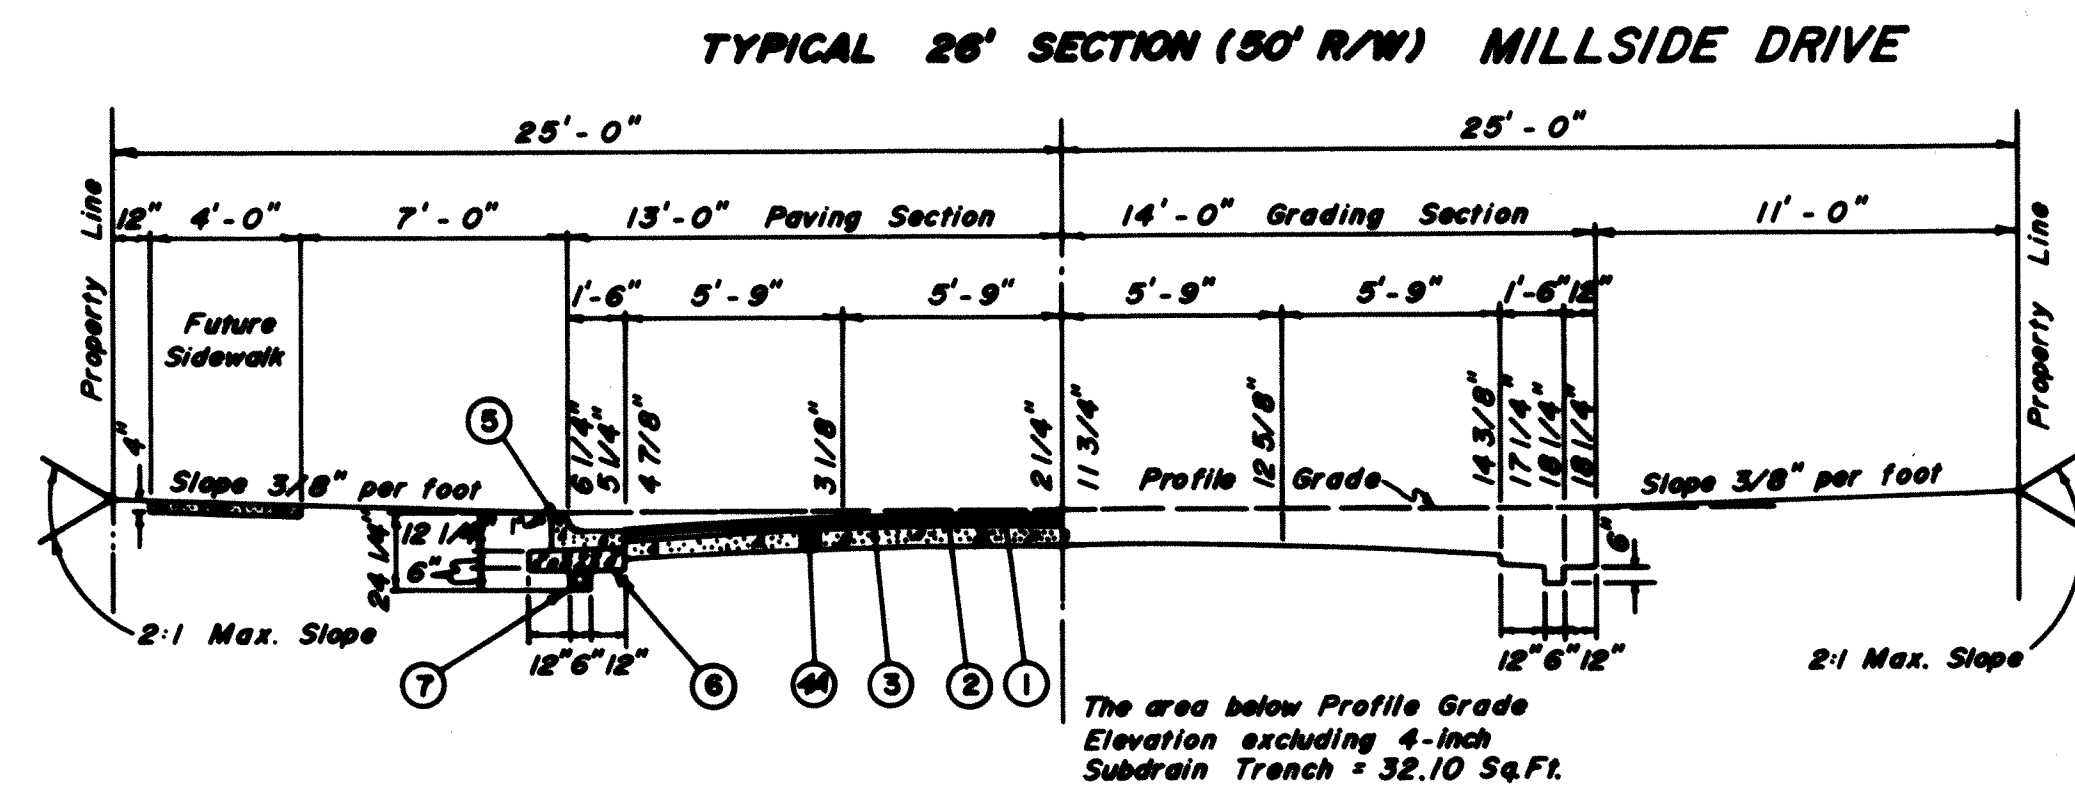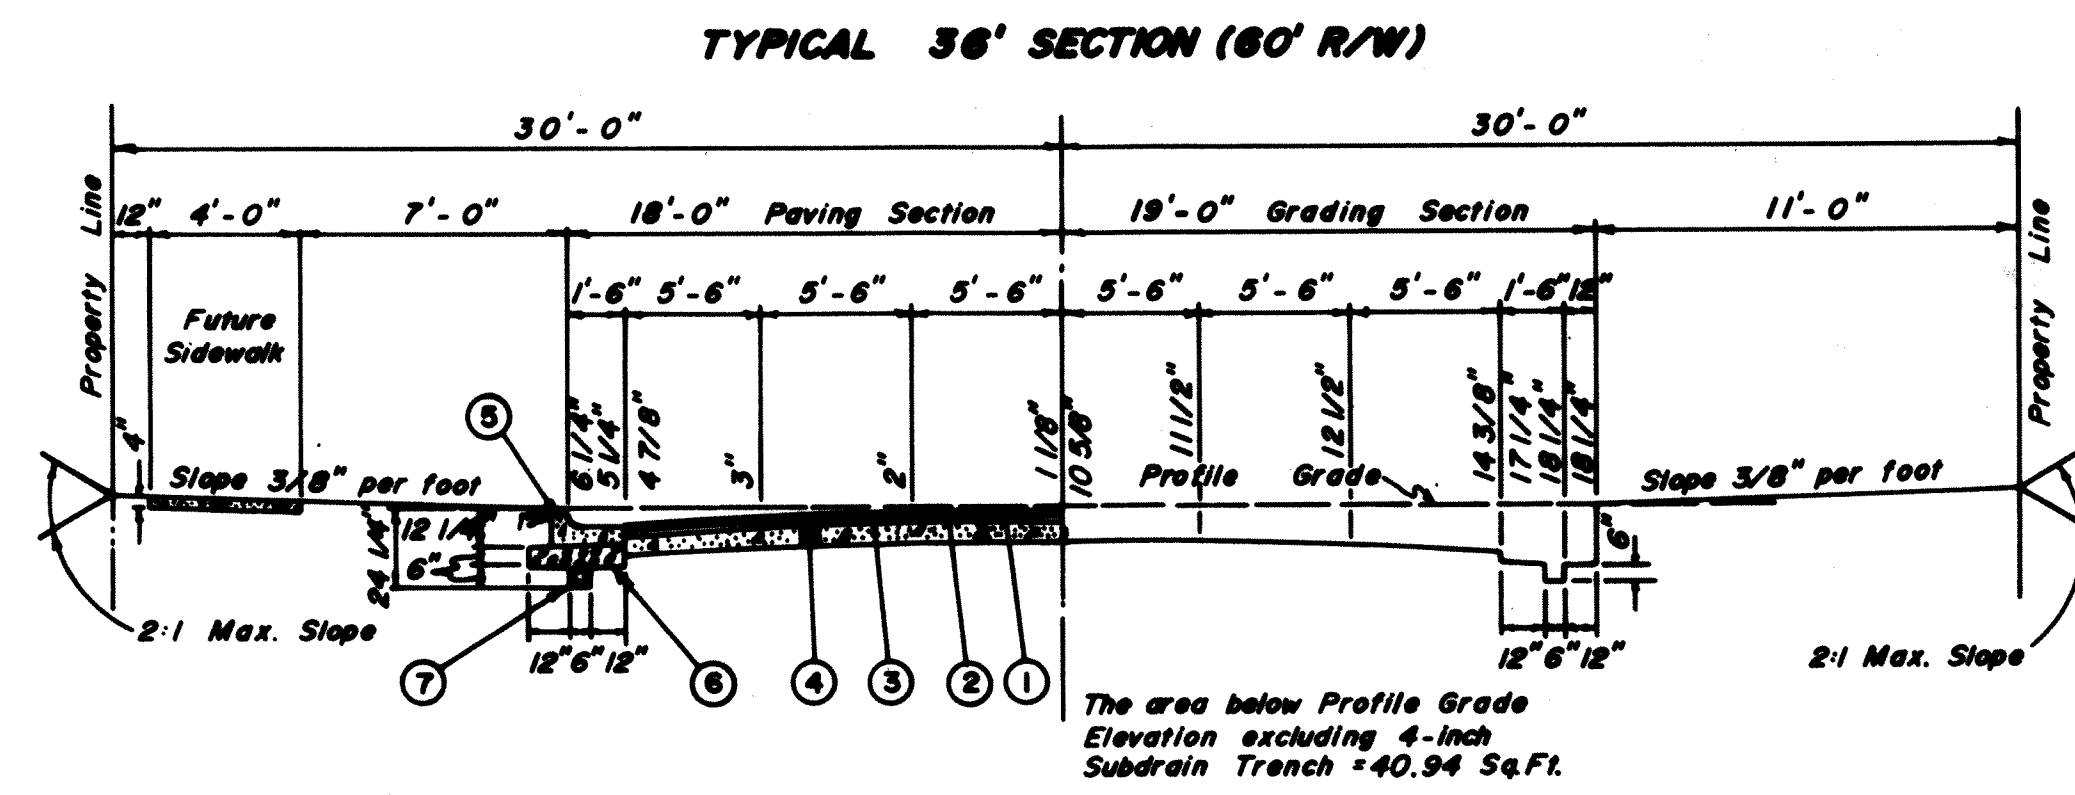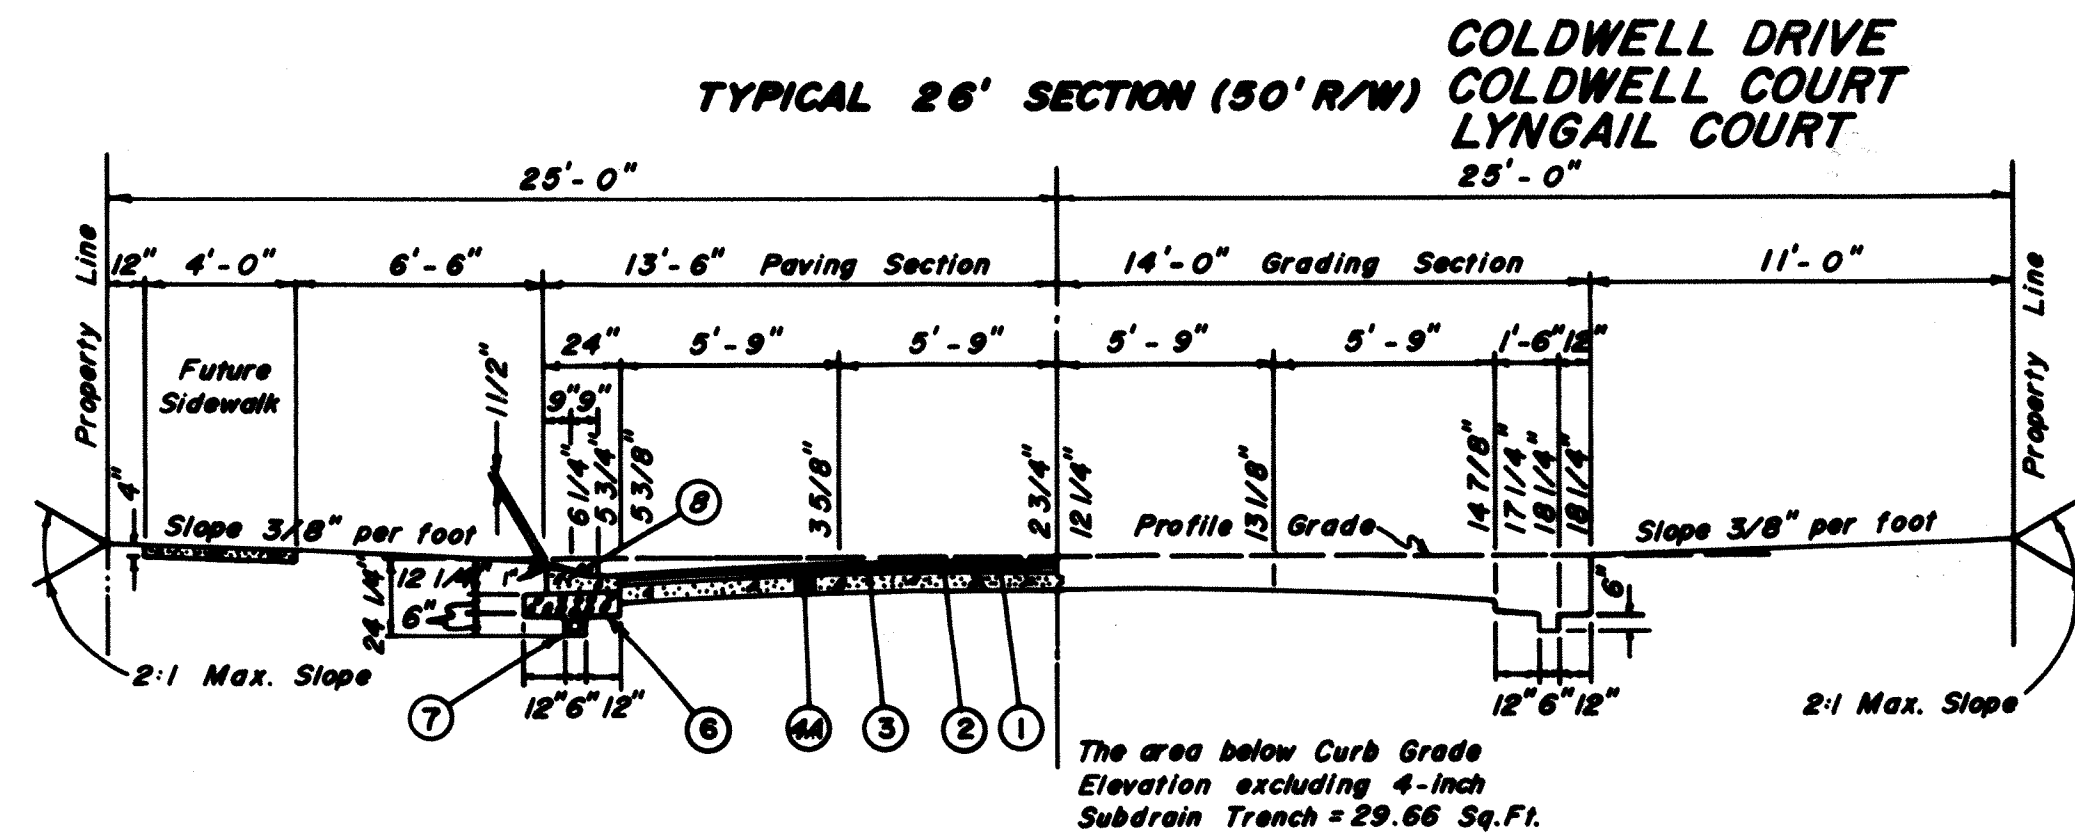

- The Specifications of the State of Ohio, Department of Transportation, including all supplements thereto, in force on date of contract, together with the requirements of the City of Gahanna shall govern all materials and workmanship involved in construction.
- All item numbers are in accordance with the Ohio Department of Transportation, modified as noted.
- 1 1 1/4" Hot-Mixed, Hot-Laid Asphalt Concrete, Item 404 (85-100) with Modification to State Highway Specifications Asphalt Concrete shall contain all crushed Aggregate. Joints for Asphalt Concrete shall be staggered.
 - 2 1 1/4" Hot-Mixed, Hot-Laid Asphalt Concrete, Item 402 (85-100).
 - 3 Bituminous Tack Coat, Item 407. Bituminous Material 702.02, RS-1 or an approved equal applied 0.1 Gal. per Sq. Yd. and cover aggregate consisting of crushed gravel or limestone Size No. 9.
 - 4 8" Portland Cement Concrete Base, Item 305 modified as follows, City of Gahanna, Class E Concrete, 510 lbs. Portland Cement per cubic yard, 3% to 6% Air Entrainment and 3" max. slump. (This item also conforms to City of Columbus Construction & Material Specification Item 305.) The use of an approved single beam vibrating screen will be required and Transverse Contraction Joints shall be sawed as per this plan.
 - 4A 7" Portland Cement Concrete Base, Item 305 modified as follows, City of Gahanna, Class B Concrete, 380 lbs. Portland Cement per cubic yard, 3% to 5% Air Entrainment and 4.5" max. slump. (This item also conforms to City of Columbus Construction & Material Specification Item 306.) The use of an approved single beam vibrating screen will be required and Transverse Contraction Joints shall be sawed as per this plan.
 - Centerline Joint for concrete pavement base shall be sawed if pavement base is constructed full width.
 - A subgrade planer or an automatic subgrader will not be required.
 - 5 Concrete Combined Curb & Gutter, Item 609, modified as follows, City of Gahanna, Class F Concrete, 560 lbs. Portland Cement per cubic Yard, 4% to 8% Air Entrainment and 3" max. slump.
 - 6 No. 46 Aggregate.
 - 7 4" Pipe Underdrain, Item 605.
 - 8 Mountable Curb, Item 609, Concrete, Item 499, modified as follows, City of Gahanna, Class F Concrete, 560 lbs. Portland Cement per cubic yard, 4% to 8% Air Entrainment and 3" max. slump.
- Sidewalks and Drive Ramps, Item 608, Concrete, Item 499, modified as follows, City of Gahanna, Class F, 560 lbs. Portland Cement per cubic yard, 4% to 8% Air Entrainment and 4" max. slump.
- Curing Material shall conform to 705.07, Type 2, and shall be applied with a motor driven pump sprayer.
- Sidewalk location shall be determined by the City Engineer.
- When the pavement design shown on the typical sections is not adequate for contemplated heavier load requirements, the proposed street sections shall be designed in accordance and agreement with the City Engineer.
- In the event excavation for the street is from 0" to 6" below that called for on the plans, the Contractor shall replace this excess excavation material with compacted 46D crushed aggregate as directed, and at no extra cost to the Owner.
- Mountable Curb may be used on 26' Residential Streets, subject to approval by the City Engineer. All other streets shall be built using combined curb and gutter.
- Two or more curb openings for each lot shall be provided for downspout drains at the time of the permanent construction. Cost to be included in the price bid for Item 609. All curb openings provided after curb construction shall be drilled or sawed for downspout drain placement. (Saw Cut Width 1'-0")

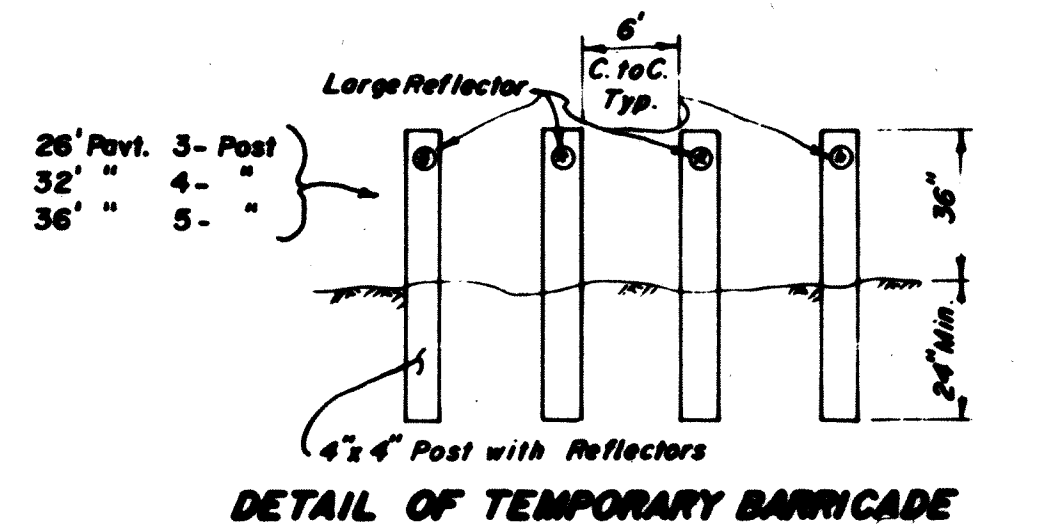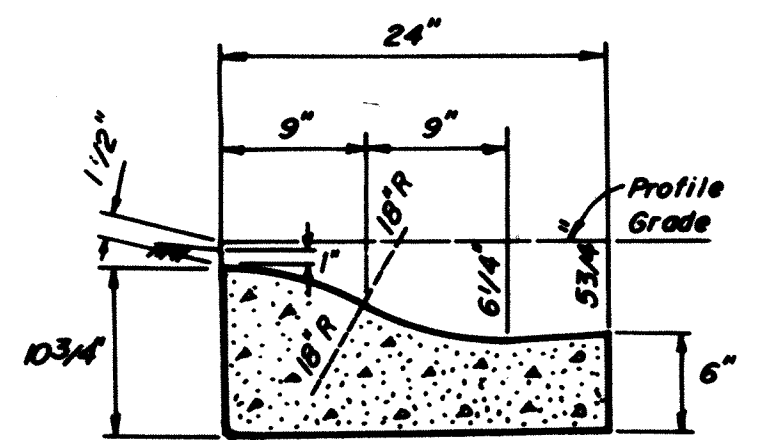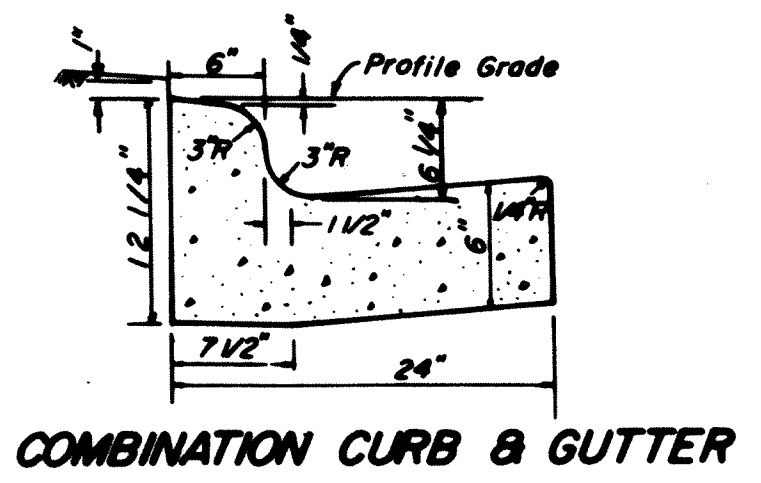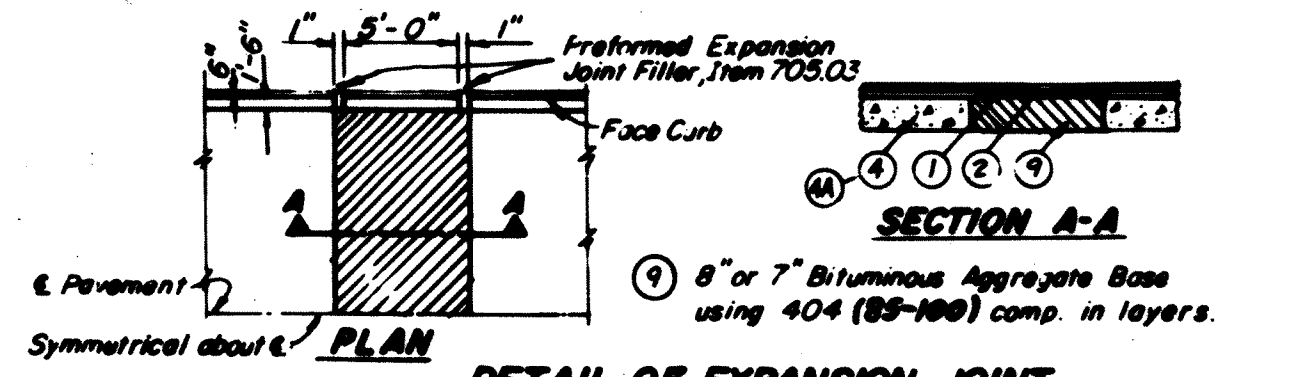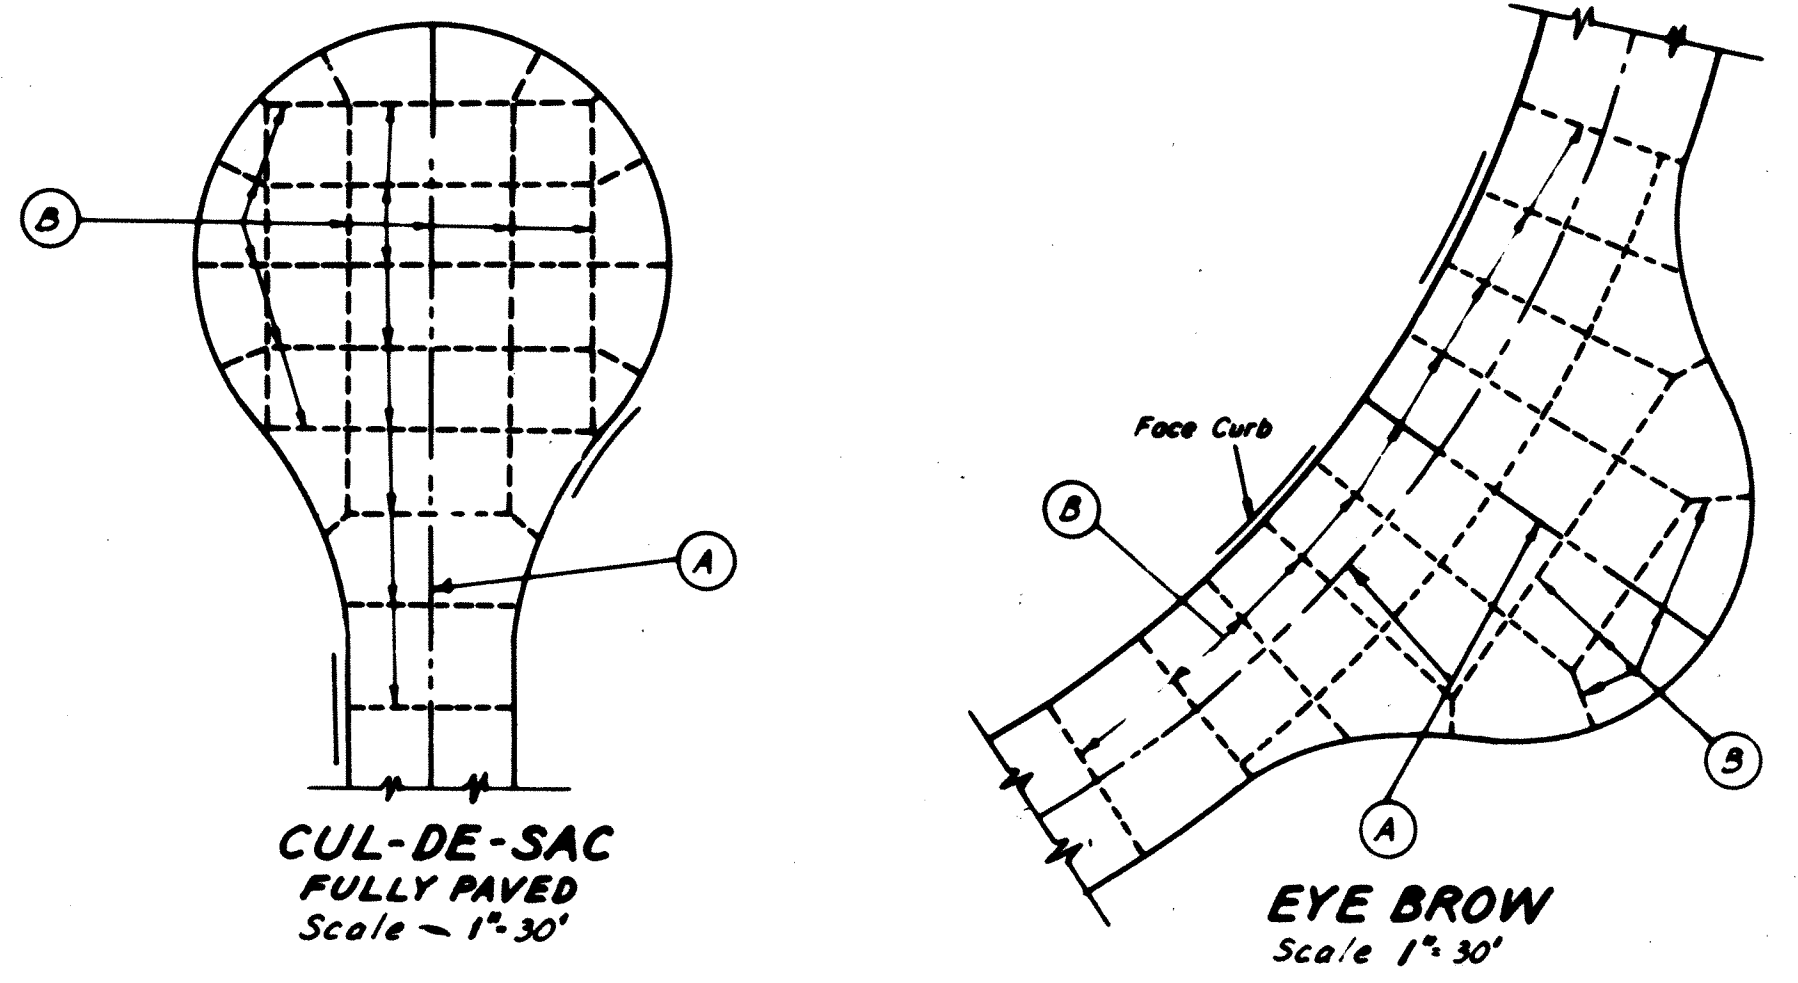

CHERRY BOTTOM SEC. 4 - IMP. N#364

CITY OF GAHANNA, OHIO



STANDARD CONSTRUCTION DRAWING

**CONSTRUCTION DETAILS FOR
ASPHALT CONCRETE ON P.C. CONCRETE BASE**

Approved: *William B. Roach*
CITY ENGINEER, GAHANNA OHIO

Richard V. Warren
DIRECTOR OF PUBLIC SERVICE, GAHANNA OHIO

DATE: **2/4**

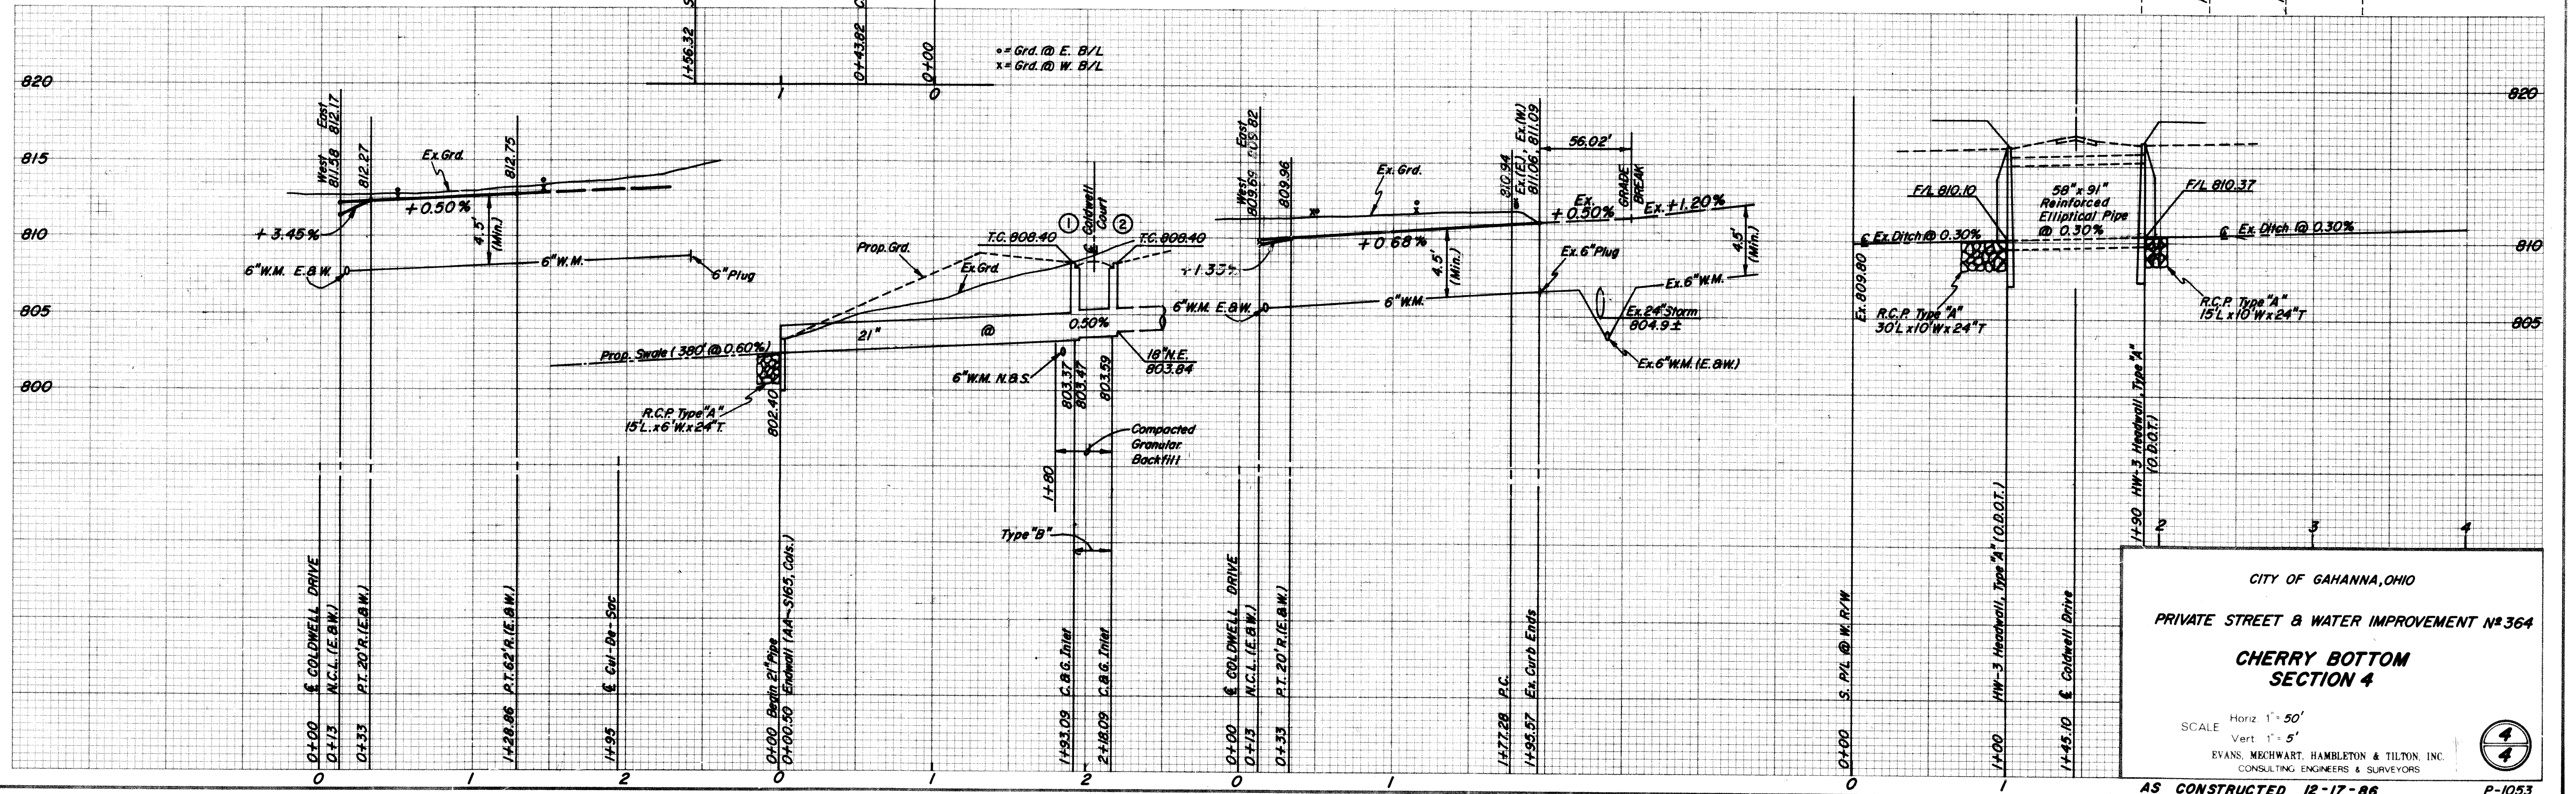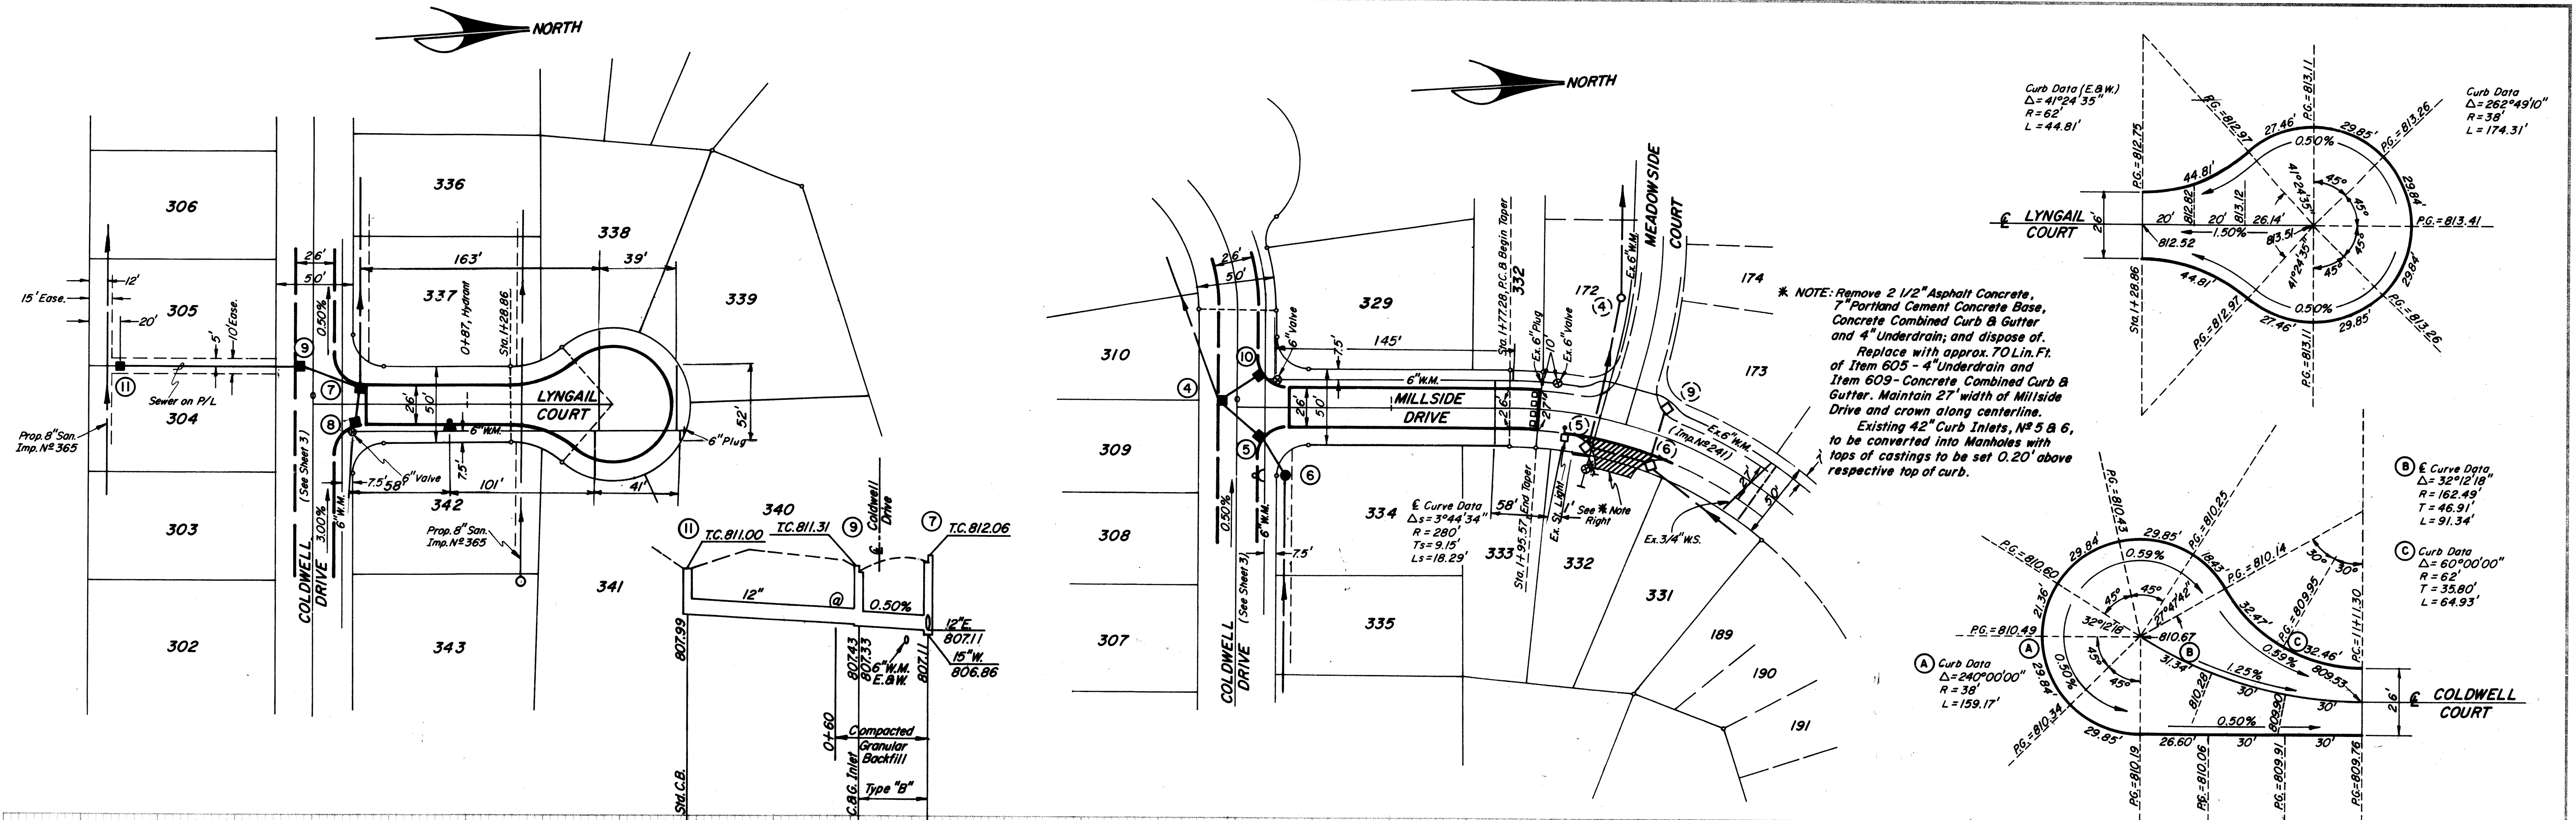

CITY OF GAHANNA, OHIO

PRIVATE STREET & WATER IMPROVEMENT NO 364

CHERRY BOTTOM SECTION 4

SCALE Horiz 1" = 50'
 Vert 1" = 5'

EVANS, MECHWART, HAMBLETON & TILTON, INC.
 CONSULTING ENGINEERS & SURVEYORS

AS CONSTRUCTED 12-17-86 P-1053

CITY OF GAHANNA, OHIO PRIVATE STREET, WATER AND STREET LIGHTING IMPROVEMENT NO. 366

CHERRY BOTTOM GLADE

PHASE I & II
1986

GENERAL NOTES

SPECIFICATION: The requirements of the City of Gahanna, together with the Standard Specifications of the State of Ohio, Department of Transportation, including all supplements thereto in force on date of contract shall govern all materials and workmanship involved in the improvements shown on these plans except as such specifications are modified by the following specifications or by the construction details set forth herein.

STANDARD CONSTRUCTION DRAWINGS: All pertinent Standard Construction Drawings are available upon request at the Office of the City Engineer.

PERMITS: The Contractor shall obtain all necessary permits.

SAFETY REQUIREMENTS: The Contractor and Sub-Contractor shall be solely responsible for all federal, state and local safety requirements, together with exercising precautions at all times for the protection of persons (including employees) and property. It is also the sole responsibility of the Contractor and Sub-Contractor to initiate, maintain and supervise all safety requirements, precautions and programs in connection with this work.

MISCELLANEOUS WORK: All items of work called for on the plans for which no specific method of payment is provided shall be performed by the Contractor and the cost of same shall be included in the price for the various related items.

FIELD TILE: All field tile broken during excavation shall be replaced to its original condition or connected to either the curb subdrain or to the storm sewer system as directed by the Engineer.

SURPLUS EXCAVATION: The Contractor shall dispose of all surplus street excavation on the project site where and as directed by the Owner.

UNAUTHORIZED STREET EXCAVATION: In the event excavation for the street is from 0" to 6" below that called for on the plans, the Contractor shall replace this excess excavated material with compacted 46D crushed aggregate as directed and at no extra cost to the owner.

STORM SEWERS: Unless otherwise noted on the plans all Storm Sewers shall be as hereafter specified: (1) All sizes of storm sewer located within or across proposed or existing pavement areas shall be Type B Conduit, 706.02, with Class B Bedding. (2) Storm Sewer located outside pavement areas shall be Type E Conduit, 706.01, Class C Bedding, for 15 inch and smaller, and shall be Type E Conduit, 706.02, Class C Bedding, for 18 inch and larger. The following modifications to Ohio Department of Transportation Specifications shall apply: (1) Type E Conduits shall have sealed joints; (2) Granular backfill material shall be compacted granular material, Item 310-A placed within limits shown on the plan including around all inlet structures. Granular backfill shall extend from the bottom of the trench to a plane 6 inches below the subgrade.

CURB INLETS: All curb inlets shall be channeled as directed.

ROOF DRAIN OPENINGS: The Contractor shall provide two roof drain openings in the curb for each lot, each opening located not more than 4 feet in from each lot line.

STREET LIGHTING: Standard Electrical Specifications and Standard Construction Drawings, covering Street Lighting for the City of Gahanna, Ohio, shall apply.

EXPANSION JOINTS: It shall be the responsibility of the Contractor to adequately barricade the street in the vicinity of all expansion joints, until such time as the street is open to traffic.

WATER MAINS: All water mains shall be either Ductile Iron Class 53 (4" through 10"), Class 54 (12" and larger), or Polyvinyl Chloride, Class 150. All bends, joint deflections and fittings shall be backed with concrete where and as directed. Where water mains or services cross proposed or existing streets, backfill shall be compacted granular material, Item 310-A, within limits 5 feet outside the edge of pavement or curb extended from the bottom of the trench to a plane 6 inches below the subgrade. The services may be jacked across the street in lieu of open cut and the use of granular backfill.

CURB BOXES: Curb boxes shall be located one-half foot from the property line unless otherwise shown on the plans or ordered by the Engineer.

CHLORINATION OF WATER MAINS: The Contractor shall make arrangements to have the water mains chlorinated by the City of Columbus. The cost of chlorination shall be included in the price bid for the various water main items.


EXISTING UTILITIES: The identity and location of the existing underground utility facilities known to be located in the construction area have been shown on the plans as accurately as provided by the Owner of the underground utility. The City of Gahanna and/or Engineer assumes no responsibility as to the accuracy or the depths of the underground facilities shown on the plans.

Support, protection and restoration of all existing utilities and appurtenances shall be the responsibility of the Contractor. The cost of this work shall be included in the price bid for the various items.

The Contractor shall cause notice to be given to the Ohio Utilities Protection Service (telephone 800-362-2764 - toll free) and to the Owners of underground utility facilities shown on the plans who are not members of a registered underground protection service in accordance with Section 153.64 of the Revised Code. The above mentioned notice shall be given at least 48 hours prior to start of construction.

The following utilities are located within the work limits of this project, and the Owners do not subscribe to a registered underground utility protection service:

UTILITY	OWNER	TELEPHONE NO.
Water & Sewer	City of Gahanna	471-3827

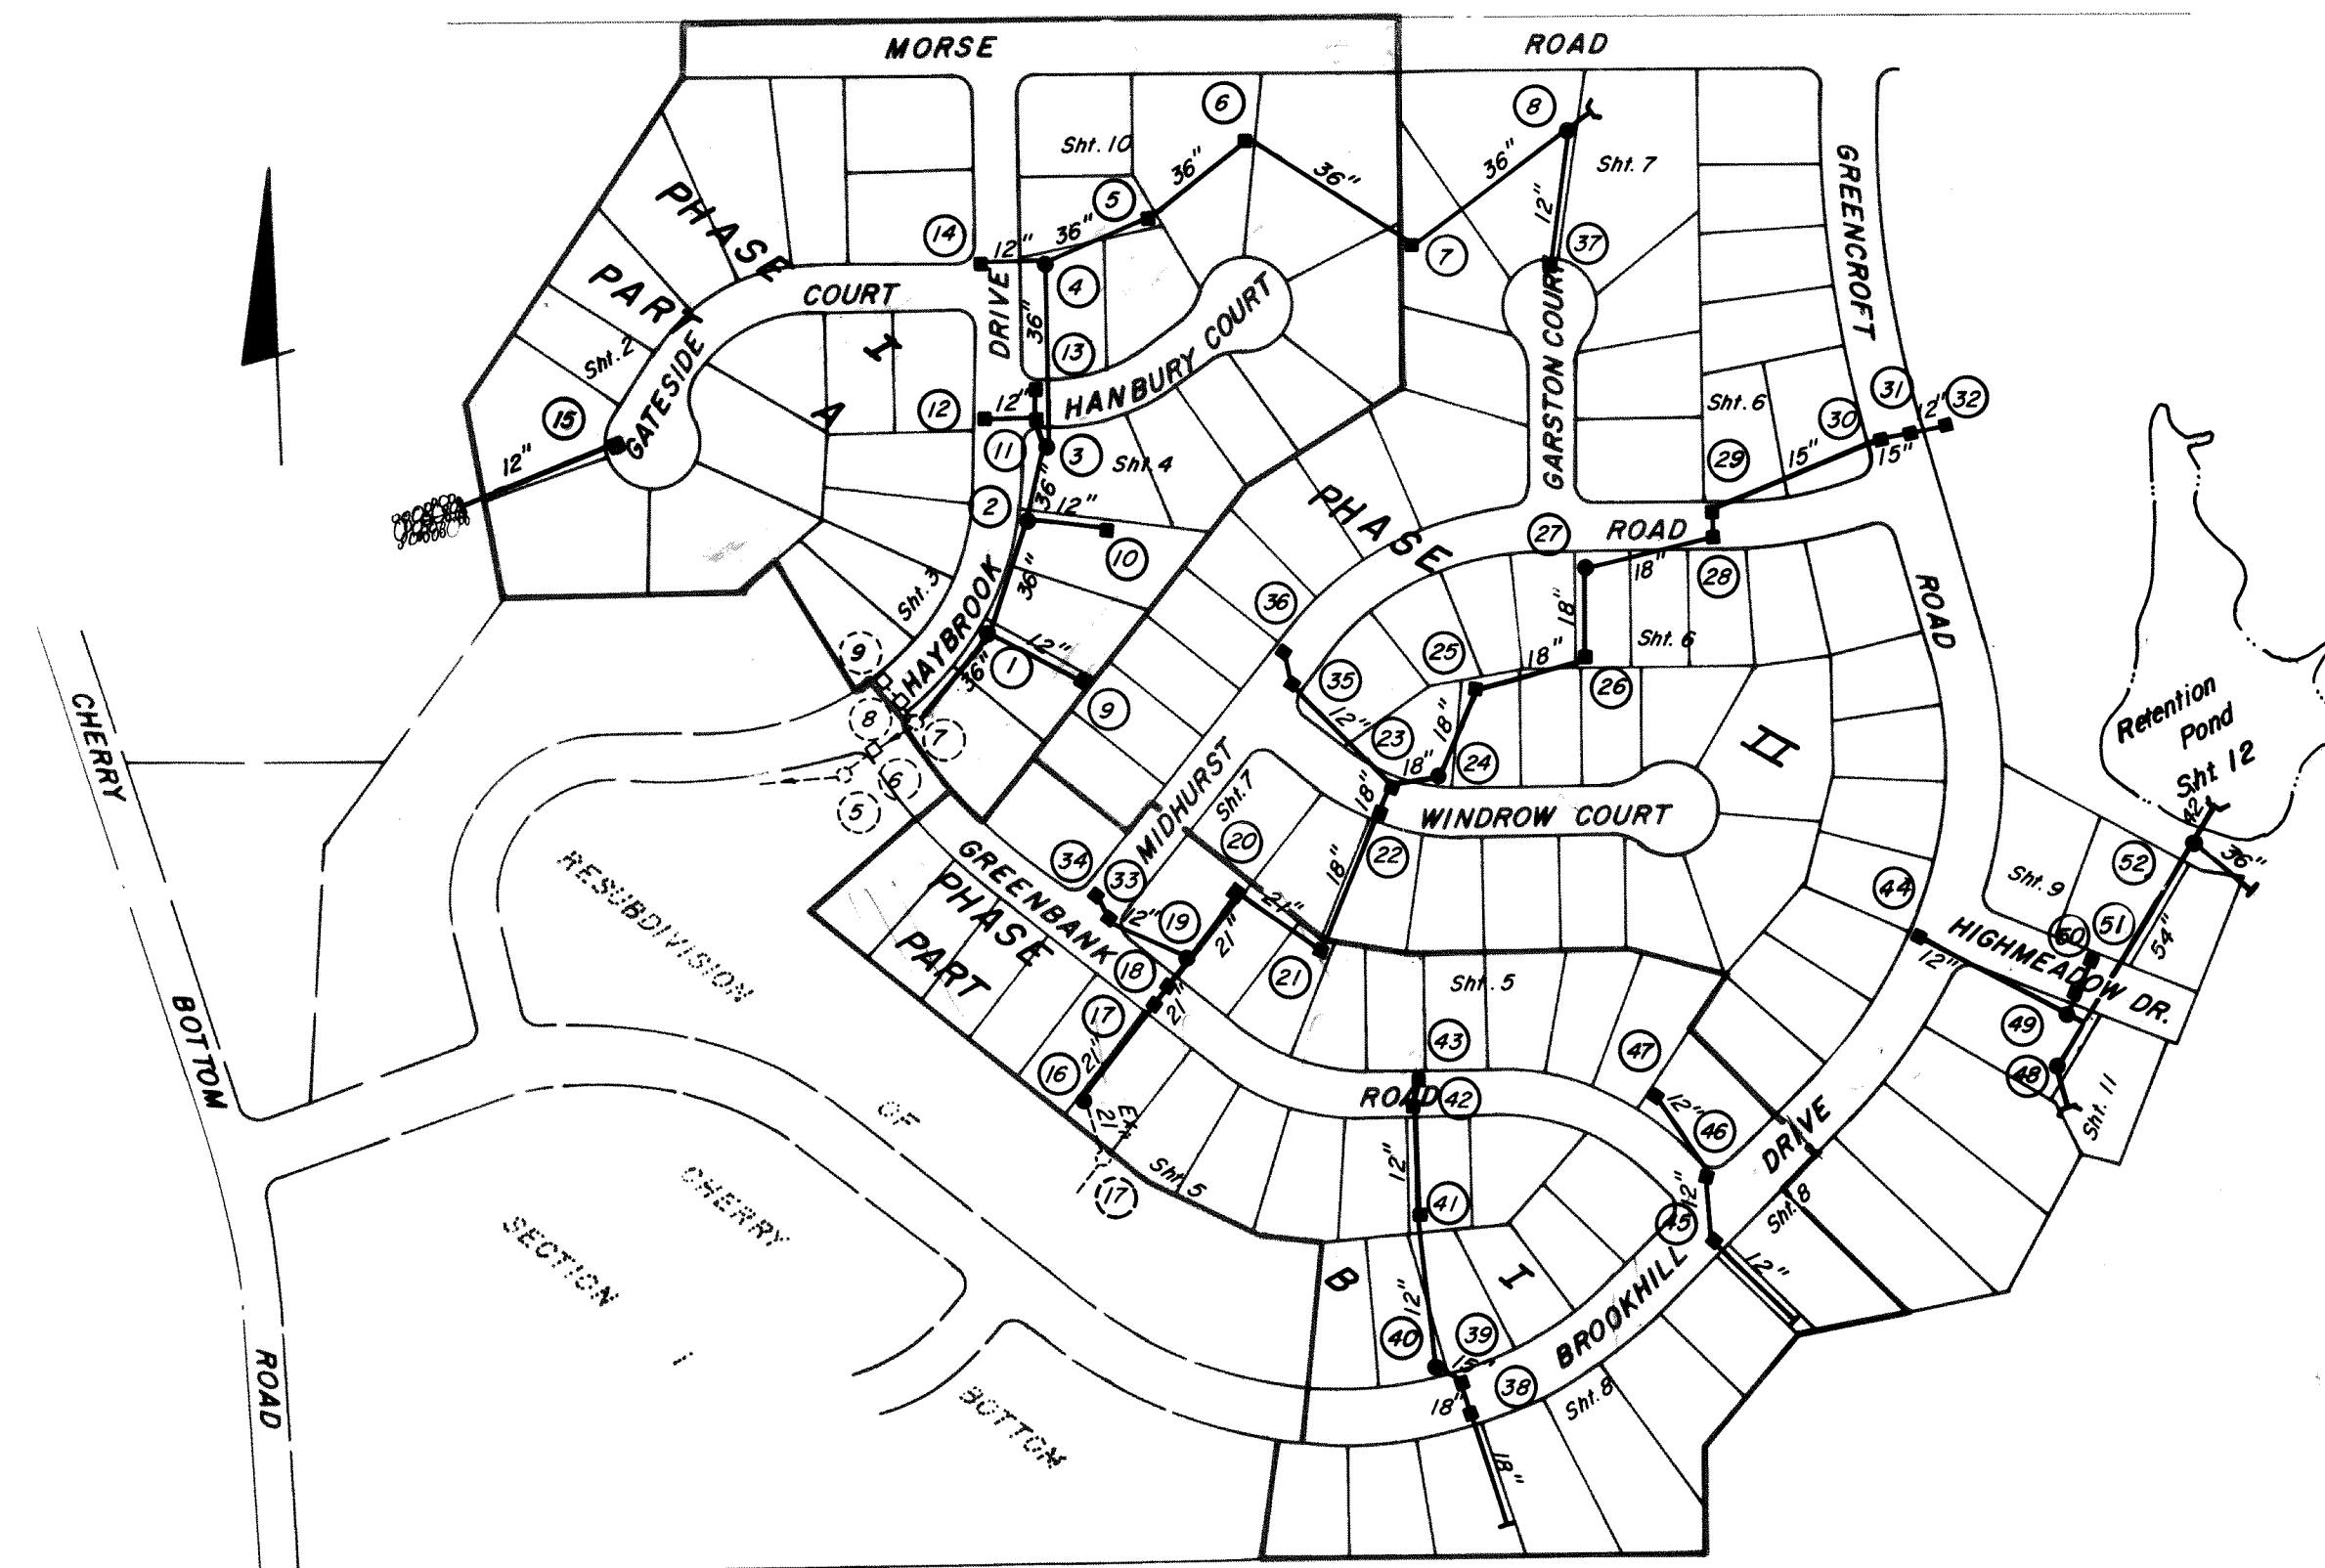

PREPARED BY
EVANS, MECHWART, HAMBLETON & TILTON, INC.
CONSULTING ENGINEERS & SURVEYORS
GAHANNA, OHIO

By David A. Hussey 8-12-86
Registered Engineer Date








Rev. Approved By
[Signature]
City Engineer Date

Rev. Shl. 1, 11, 12
(Retention Pond)

PHASE I		PHASE II		ESTIMATE OF QUANTITIES	
PART A PART B					
ITEM	QUANTITY		UNIT	DESCRIPTION	
203	6,650	5,950	8,500	C.Y.	Excavation, Including Embankment Construction
301	40	0	50	C.Y.	7" Bituminous Aggregate Base
305	0	2,275	5,260	S.Y.	8" P.C. Concrete Base
305	4,465	2,890	5,020	S.Y.	7" P.C. Concrete Base
402	180	180	360	C.Y.	Asphalt Concrete
404	170	190	375	C.Y.	Asphalt Concrete
407	455	520	1,035	Gals.	Bituminous Tack Coat
605	3,105	3,390	6,360	L.F.	4" Shallow Pipe Underdrain
609	0	1,340	3,025	L.F.	Combination Concrete Curb and Gutter
609	3,105	2,135	3,335	L.F.	Concrete Mountable Curb
Spec.	0	2	1	Ea.	Temporary Barricade
608	128	128	255	S.F.	Concrete Curb Ramps (Wheel Chair Ramps)
603	30	40	0	L.F.	12" Conduit Type B, 706.02 with Concrete Encasement
603	105	95	335	L.F.	12" Conduit Type B, 706.02
603	425	610	390	L.F.	12" Conduit Type E, 706.01
603	0	0	60	L.F.	15" Conduit Type B, 706.02
603	0	25	200	L.F.	15" Conduit Type E, 706.01
603	0	35	25	L.F.	18" Conduit Type B, 706.02
603	0	120	725	L.F.	18" Conduit Type E, 706.02
603	0	25	0	L.F.	21" Conduit Type B, 706.02
603	0	380	0	L.F.	21" Conduit Type E, 706.02
603	30	0	0	L.F.	36" Conduit Type B, 706.02
603	1,195	0	90	L.F.	36" Conduit Type E, 706.02
603	0	0	40	L.F.	54" Conduit Type B, 706.02
603	0	0	280	L.F.	54" Conduit Type E, 706.02
604	0	4	3	Ea.	Manhole Type A
604	5	0	2	Ea.	Manhole Type B
604	0	1	1	Ea.	Surface Inlet
604	2	3	2	Ea.	2'-2" Catch Basin
604	3	0	0	Ea.	2'-4" Catch Basin (omit windows)
604	0	4	5	Ea.	Curb and Gutter Inlet (Std. Curb)
604	5	6	7	Ea.	Curb and Gutter Inlet (Mountable Curb)
Special				L.S.	Retention Basin
602	7.3	0.9	18.1	C.Y.	Concrete Masonry
601	0	415	180	C.Y.	Rock Channel Protection Type A
601	45	0	30	C.Y.	Rock Channel Protection Type B
203	0	600	250	C.Y.	Channel Excavation
659	9,000	1,000	7,000	S.Y.	Seeding and Mulching
660	0	0	90	S.Y.	Sodding
WATER MAIN ITEMS					
	780	1,195	2,500	L.F.	8" Water Main
	625	20	610	L.F.	6" Water Main
	585	0	600	L.F.	2" P.V.C. Water Pipe, 200 p.s.i., S.D.R. 21
	1	3	4	Ea.	8" Valve with Box
	6	4	10	Ea.	6" Valve with Box (includes hyd. valves)
	24	21	31	Ea.	3/4" Water Service (short)
	9	16	28	Ea.	3/4" Water Service (long)
	4	4	8	Ea.	Fire Hydrant - Mueller Centurion (4 1/2")
Spec.	Lump			L.S.	Street Lighting System Complete (1 - Controls - 5 Standards)
Spec.		Lump		L.S.	Street Lighting System Complete (1 - Controls - 5 Standards)
Spec.			1 lump	L.S.	Street Lighting System Complete (0 - Controls - 9 Standards)

<u>[Signature]</u> Superintendent, Division of Water & Sewer City of Gahanna, Ohio	8/24/86 Date
<u>[Signature]</u> Superintendent of Streets, City of Gahanna, Ohio	8/22/86 Date
<u>[Signature]</u> Charles R. Wolfe City Engineer, City of Gahanna, Ohio	8/15/86 Date
<u>[Signature]</u> Director of Public Service, City of Gahanna, Ohio	8/22/86 Date
<u>[Signature]</u> Mayor, City of Gahanna, Ohio	8/22/86 Date
<u>[Signature]</u> Auditor, City of Gahanna, Ohio	8/22/86 Date

1
12

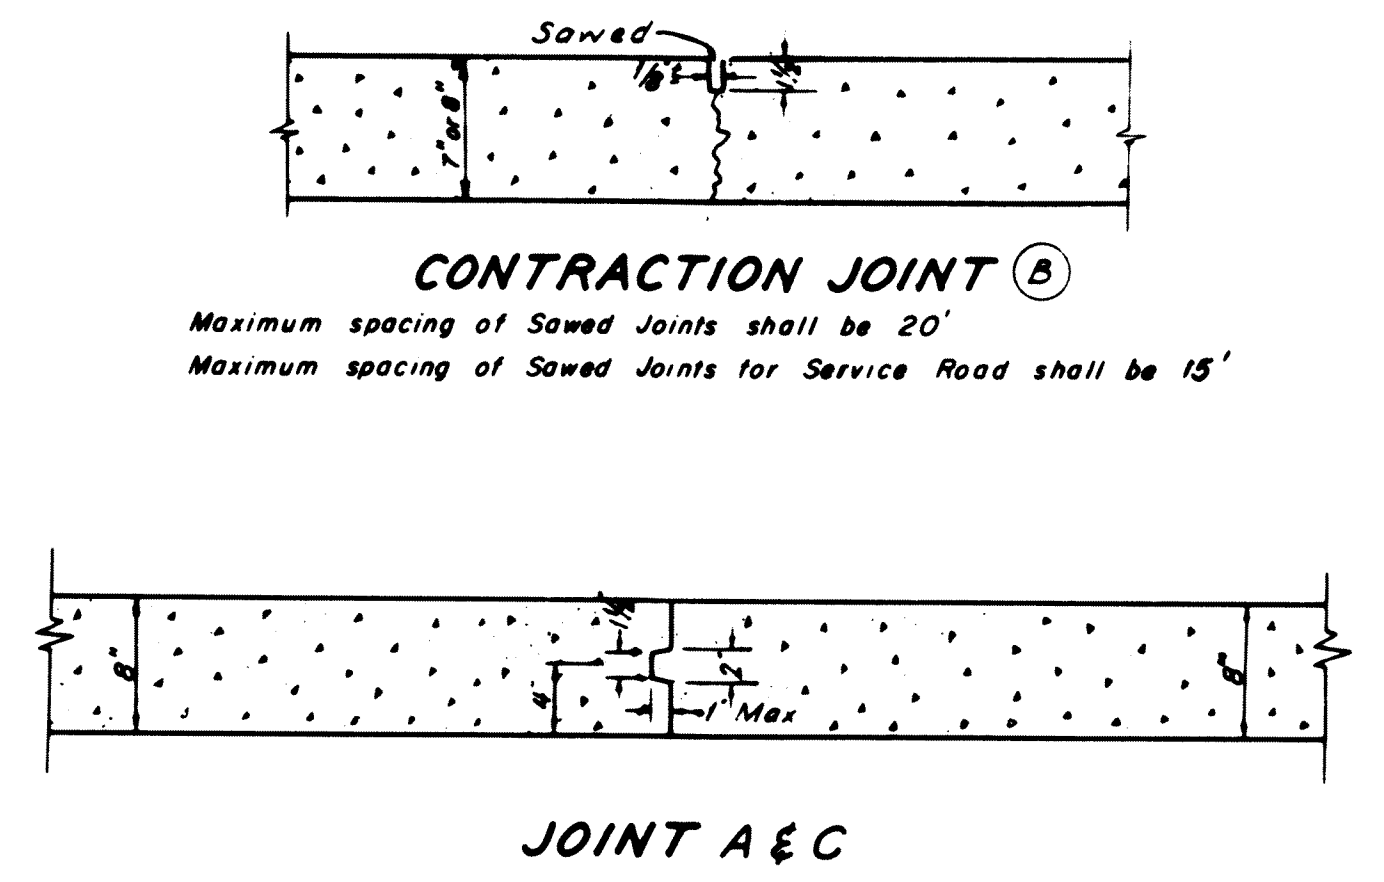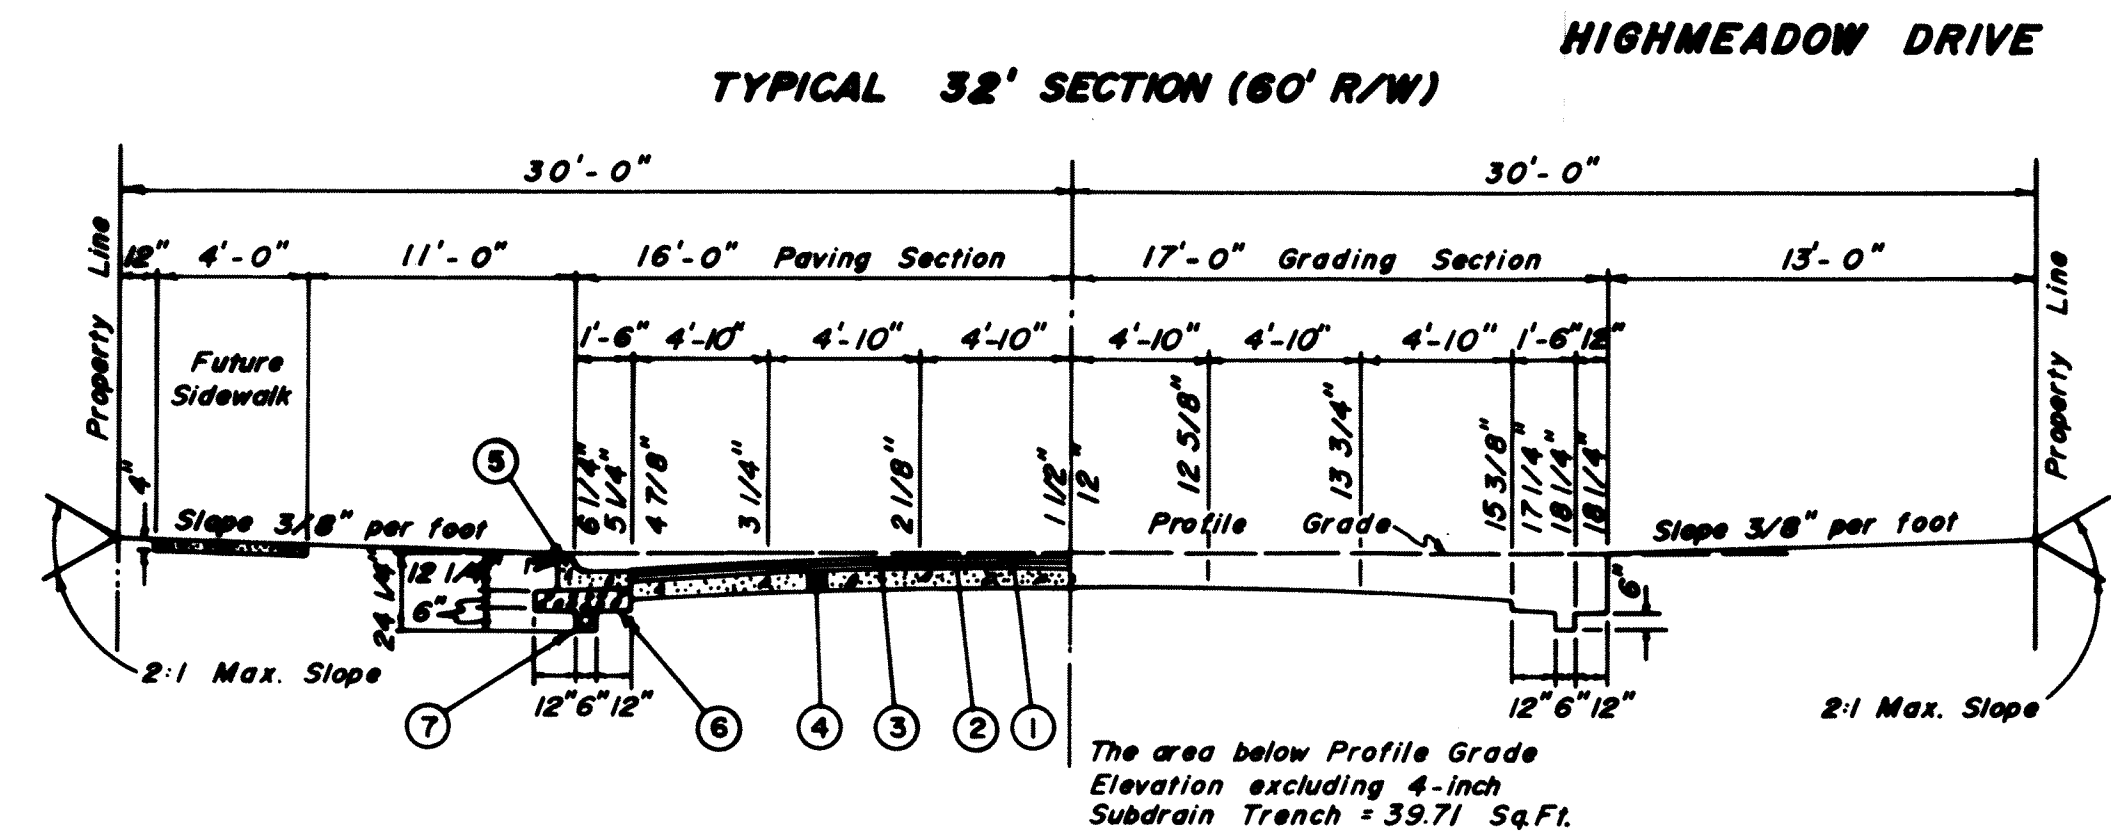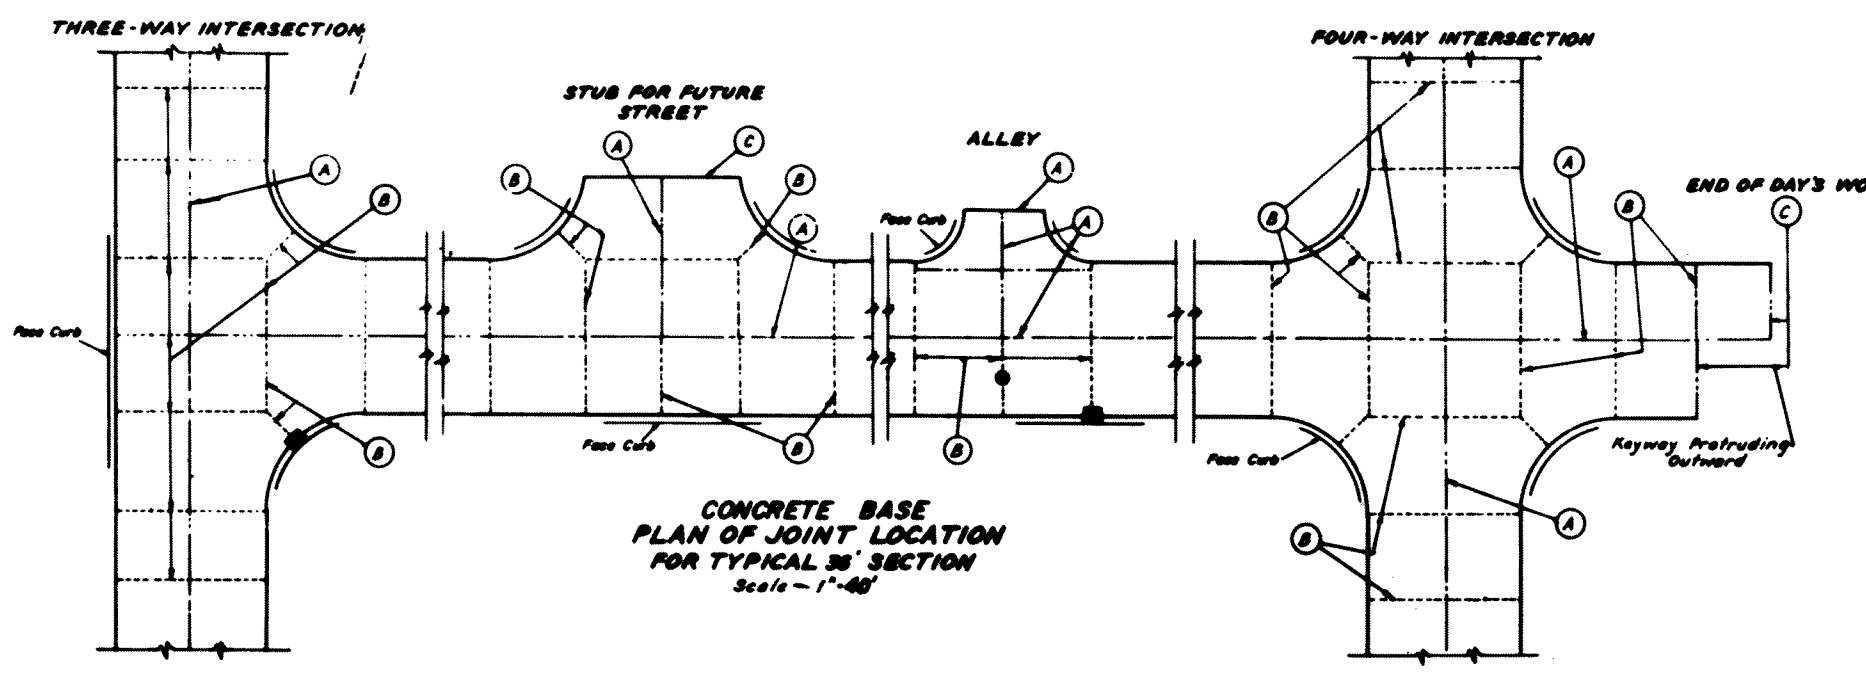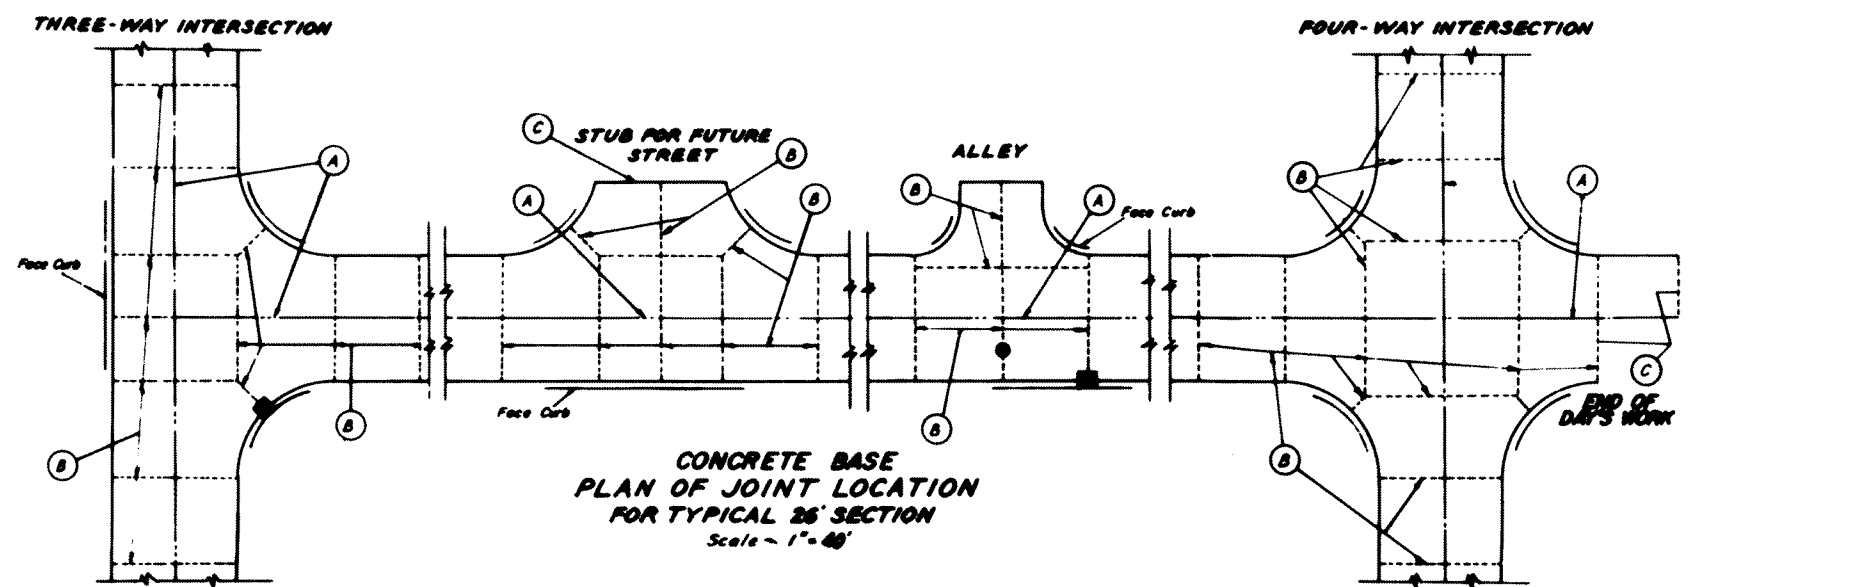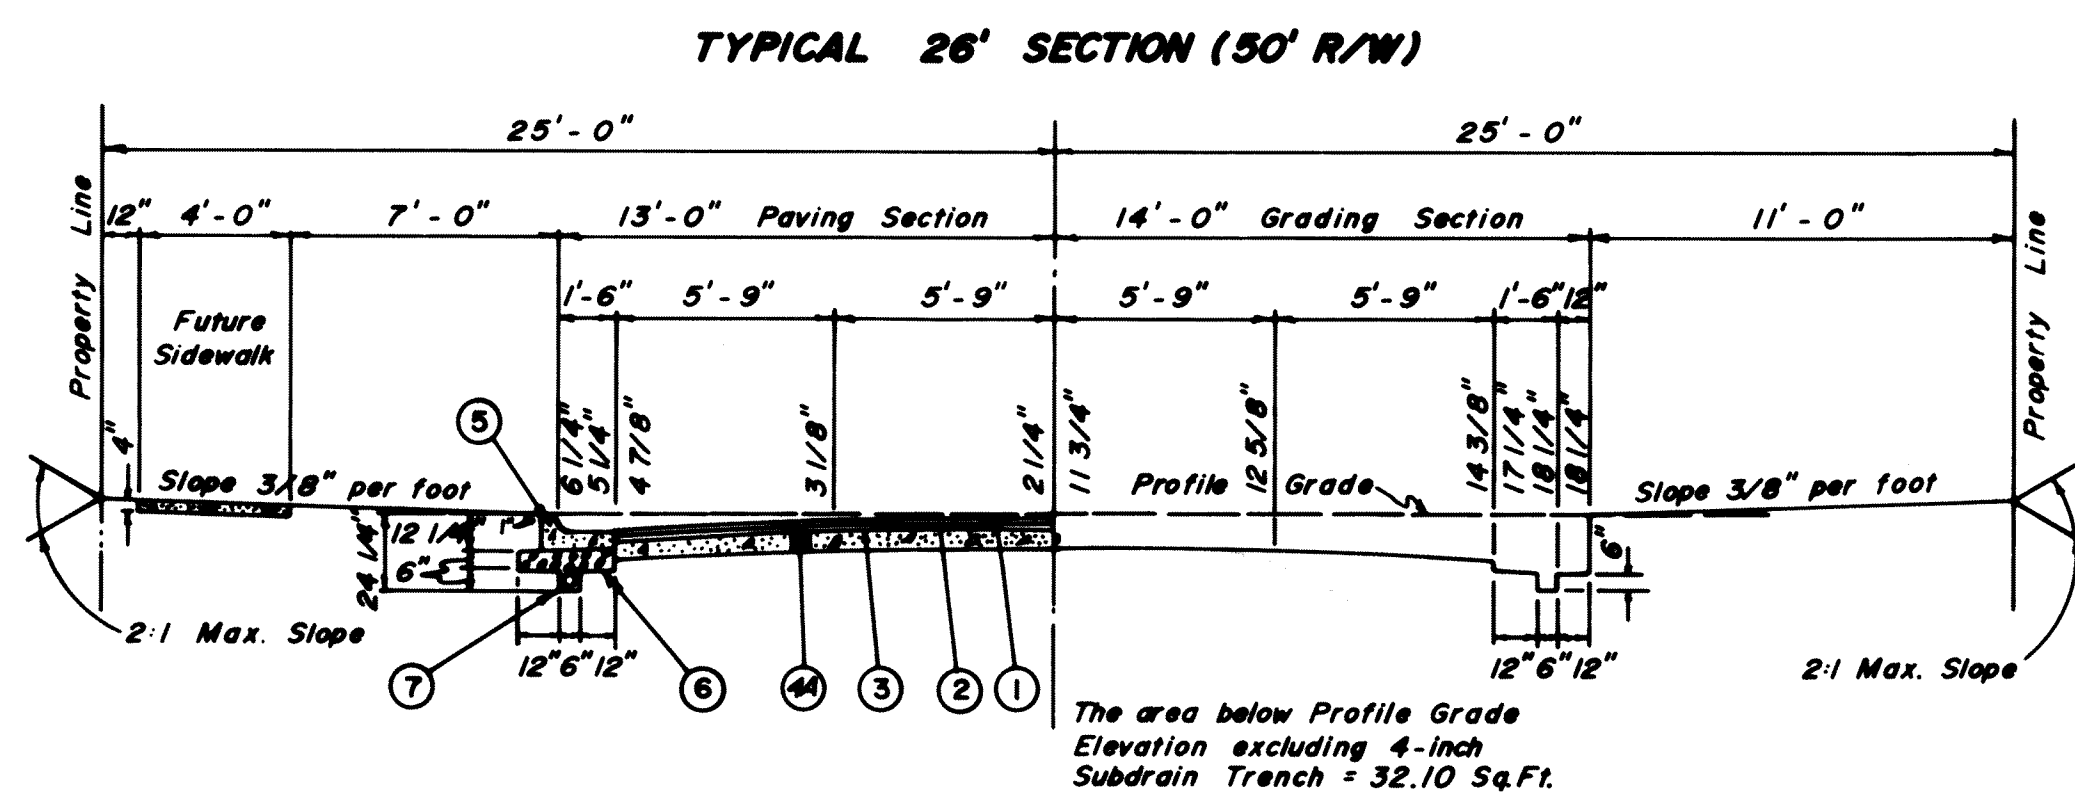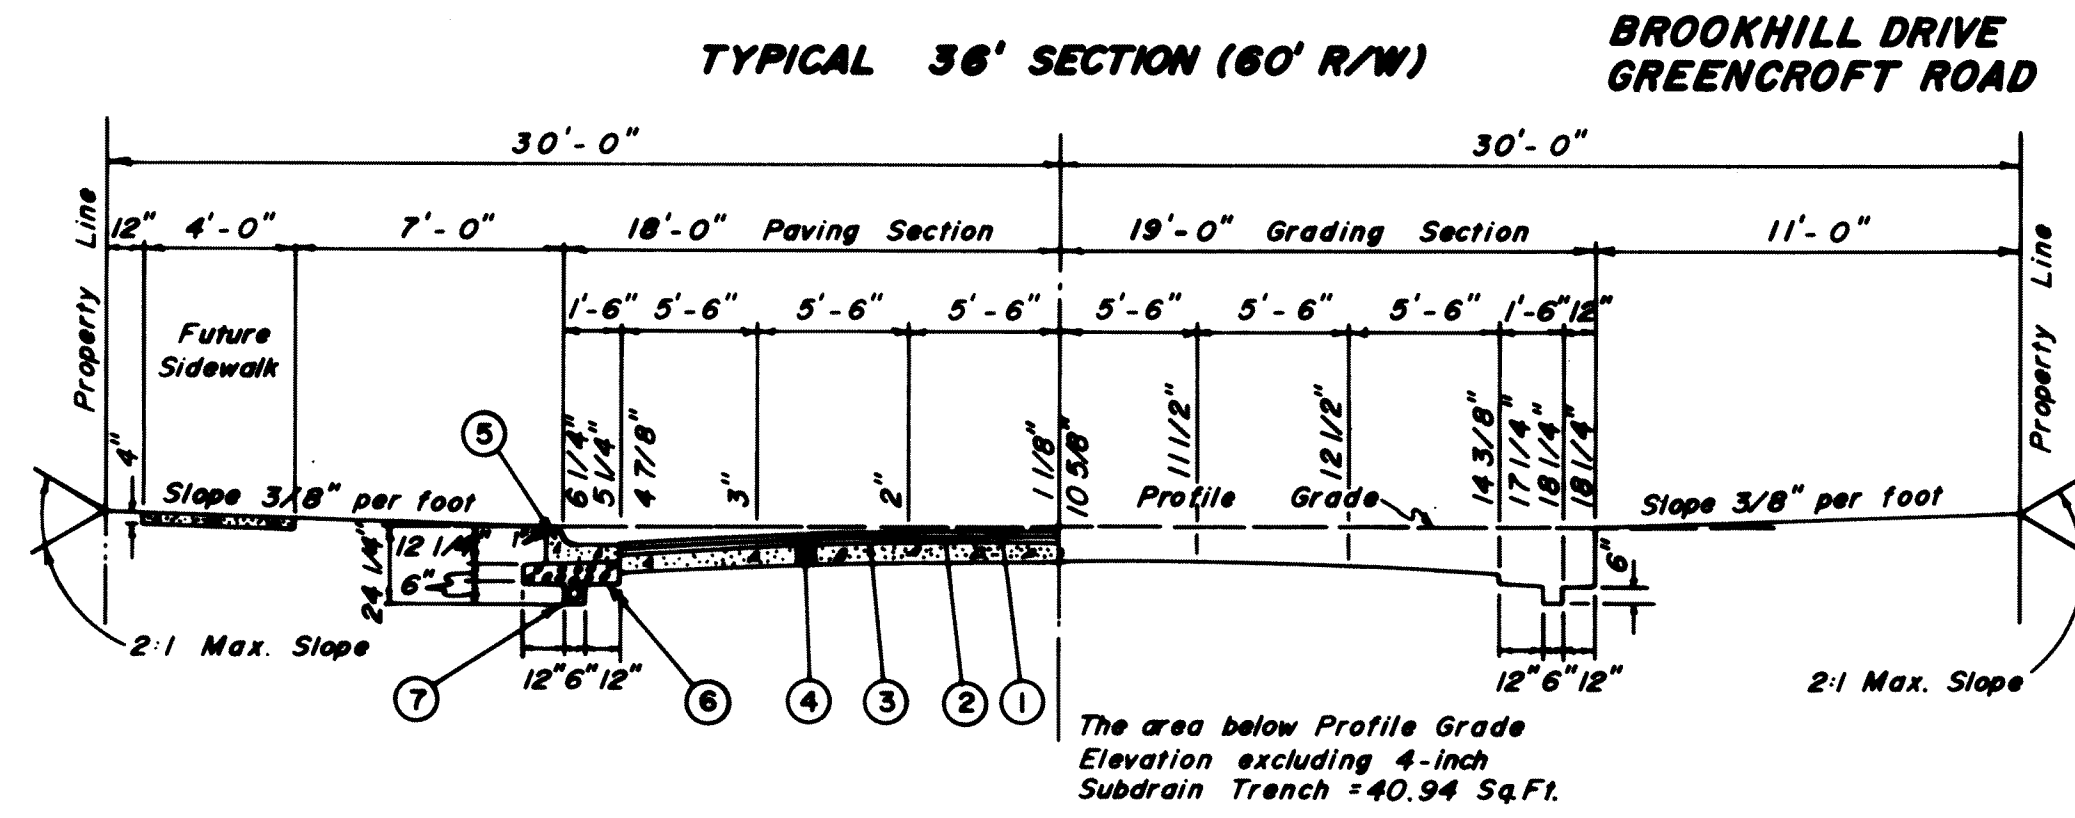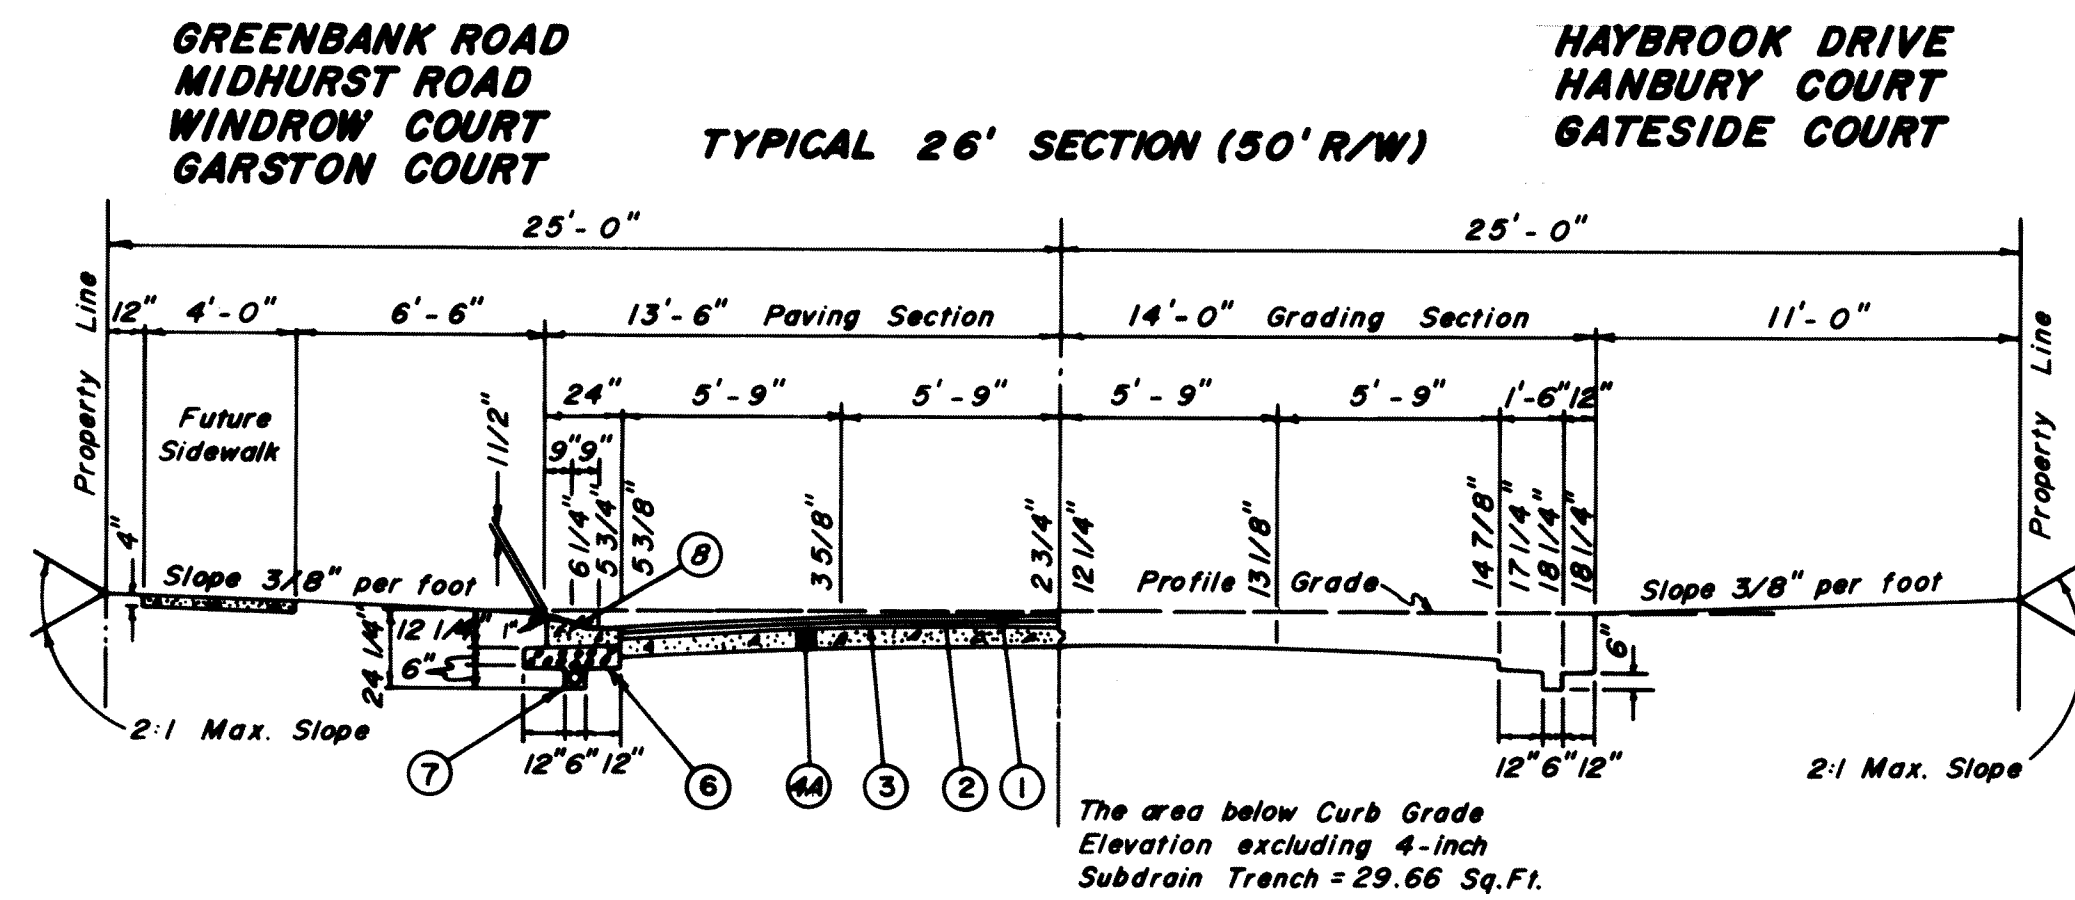







- The Specifications of the State of Ohio, Department of Transportation, including all supplements thereto, in force on date of contract, together with the requirements of the City of Gahanna shall govern all materials and workmanship involved in construction.
- All item numbers are in accordance with the Ohio Department of Transportation, modified as noted.
- 1 1 1/4" Hot-Mixed, Hot-Laid Asphalt Concrete, Item 404 (85-100) with Modification to State Highway Specifications Asphalt Concrete shall contain all crushed Aggregate. Joints for Asphalt Concrete shall be staggered.
 - 2 1 1/4" Hot-Mixed, Hot-Laid Asphalt Concrete, Item 402 (85-100).
 - 3 Bituminous Tack Coat, Item 407. Bituminous Material 702.02, RS-1 or an approved equal applied 0.1 Gal. per Sq. Yd. and cover aggregate consisting of crushed gravel or limestone Size No. 9.
 - 4 8" Portland Cement Concrete Base, Item 305 modified as follows, City of Gahanna, Class E Concrete, 510 lbs. Portland Cement per cubic yard, 3% to 6% Air Entrainment and 3" max. slump. (This item also conforms to City of Columbus Construction & Material Specification Item 305.) The use of an approved single beam vibrating screen will be required and Transverse Contraction Joints shall be sawed as per this plan.
 - 4A 7" Portland Cement Concrete Base, Item 305 modified as follows, City of Gahanna, Class B Concrete, 380 lbs. Portland Cement per cubic yard, 3% to 5% Air Entrainment and 4.5" max. slump. (This item also conforms to City of Columbus Construction & Material Specification, Item 306.) The use of an approved single beam vibrating screen will be required and Transverse Contraction Joints shall be sawed as per this plan.
 - Centerline Joint for concrete pavement base shall be sawed if pavement base is constructed full width.
 - A subgrade planer or an automatic subgrader will not be required.
 - 5 Concrete Combined Curb & Gutter, Item 609, modified as follows, City of Gahanna, Class F Concrete, 560 lbs. Portland Cement per cubic Yard, 4% to 8% Air Entrainment and 3" max. slump.
 - 6 No. 46 Aggregate.
 - 7 4" Pipe Underdrain, Item 605.
 - 8 Mountable Curb, Item 609, Concrete, Item 499, modified as follows, City of Gahanna, Class F Concrete, 560 lbs. Portland Cement per cubic yard, 4% to 8% Air Entrainment and 3" max. slump.
- Sidewalks and Drive Ramps, Item 608, Concrete, Item 499, modified as follows, City of Gahanna, Class F, 560 lbs. Portland Cement per cubic yard, 4% to 8% Air Entrainment and 4" max. slump.
- Curing Material shall conform to 705.07, Type 2, and shall be applied with a motor driven pump sprayer.
- Sidewalk location shall be determined by the City Engineer.

When the pavement design shown on the typical sections is not adequate for contemplated heavier load requirements, the proposed street sections shall be designed in accordance and agreement with the City Engineer.


In the event excavation for the street is from 0" to 6" below that called for on the plans, the Contractor shall replace this excess excavation material with compacted 46D crushed aggregate as directed, and at no extra cost to the Owner.

Mountable Curb may be used on 26' Residential Streets, subject to approval by the City Engineer. All other streets shall be built using combined curb and gutter.

Two or more curb openings for each lot shall be provided for downspout drains at the time of the permanent construction. Cost to be included in the price bid for Item 609. All curb openings provided after curb construction shall be drilled or sawed for downspout drain placement. (Saw Cut Width 1'-0")

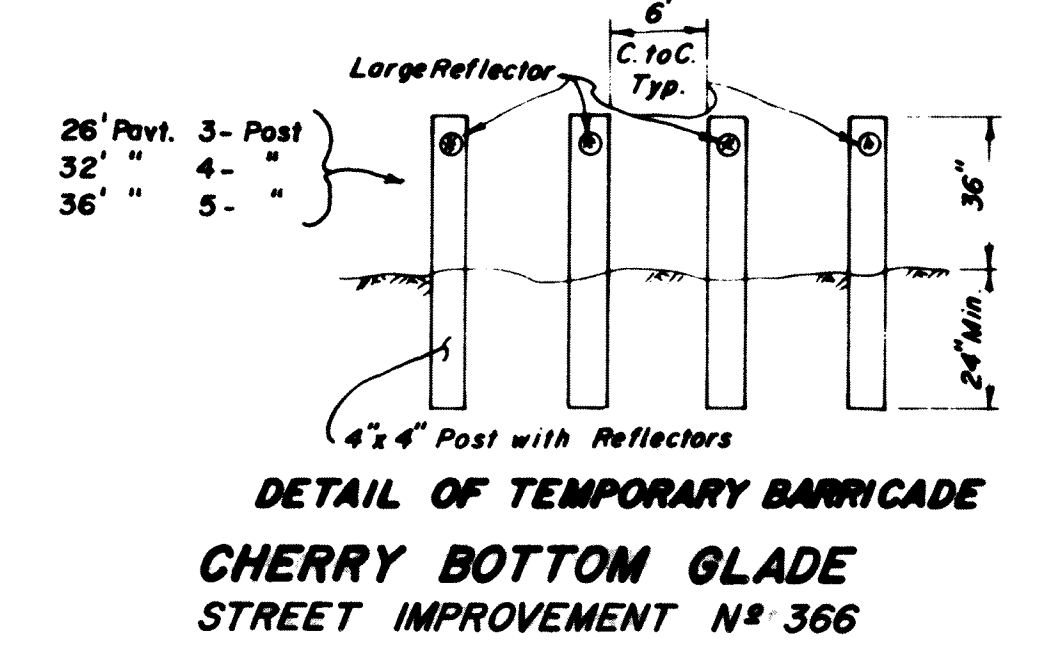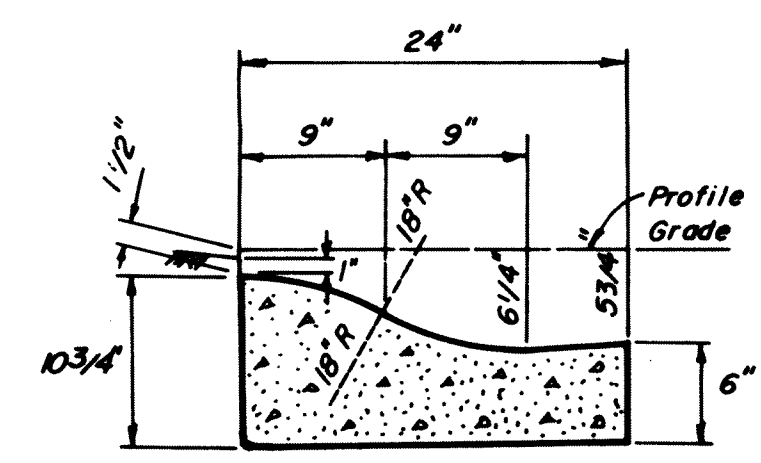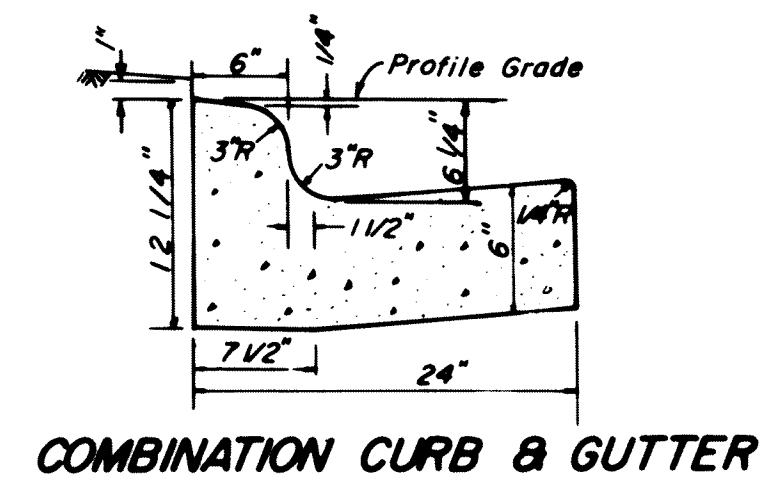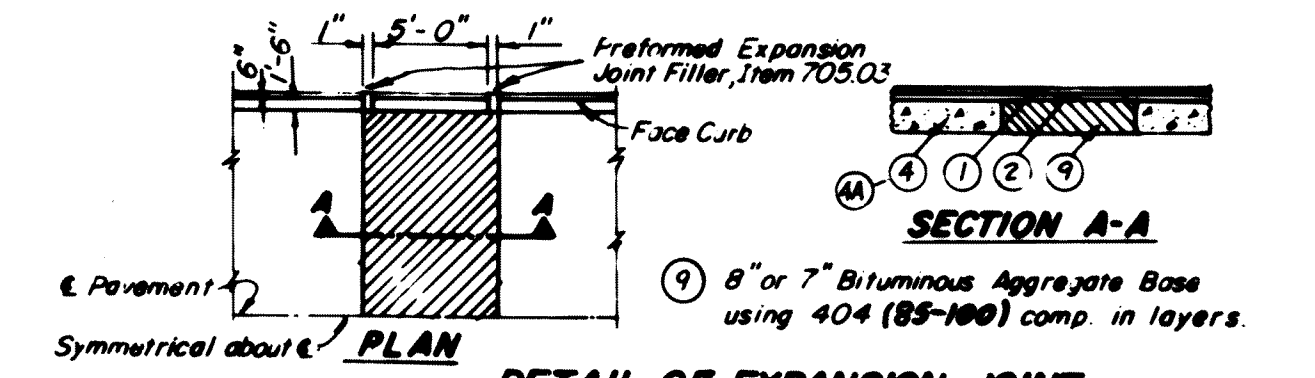
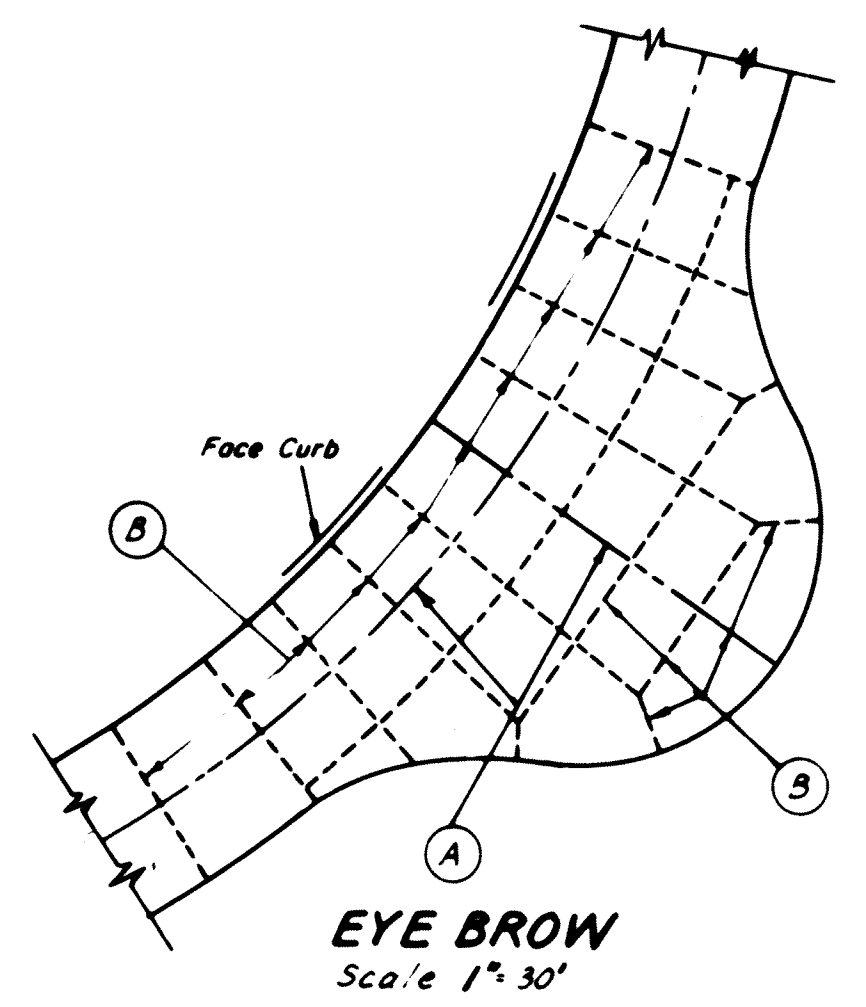
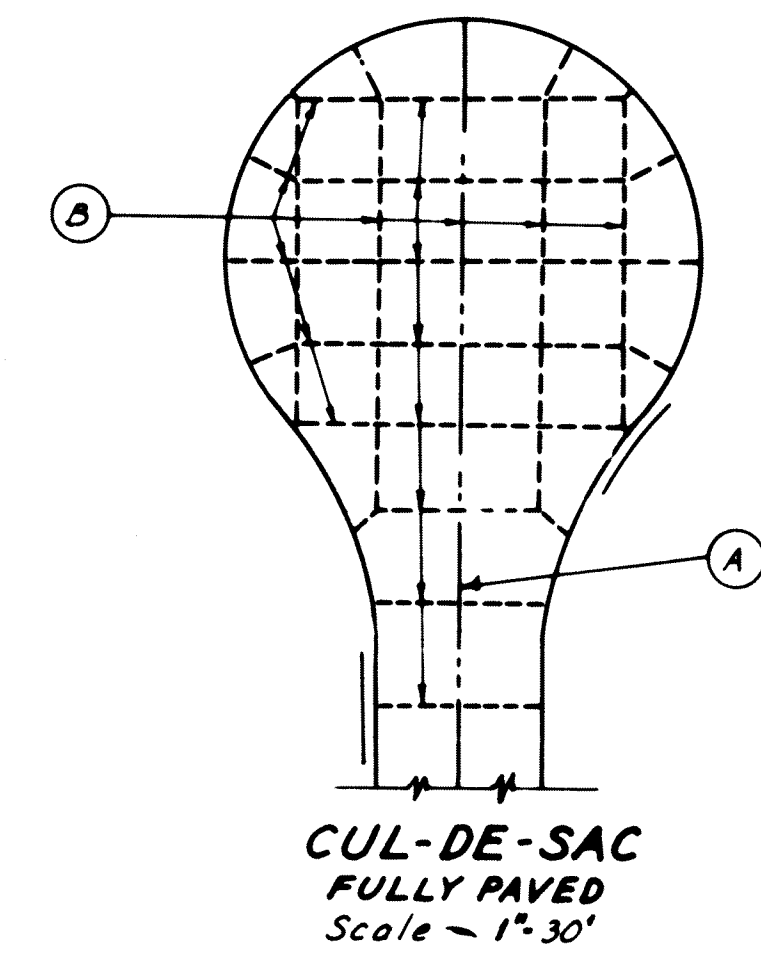


CITY OF GAHANNA, OHIO	
STANDARD CONSTRUCTION DRAWING	
CONSTRUCTION DETAILS FOR ASPHALT CONCRETE ON P.C. CONCRETE BASE	
Approved: <i>William B. Parker</i> CITY ENGINEER, GAHANNA OHIO	DATE 12-13-86
<i>Richard V. Warren</i> DIRECTOR OF PUBLIC SERVICE, GAHANNA OHIO	2/12

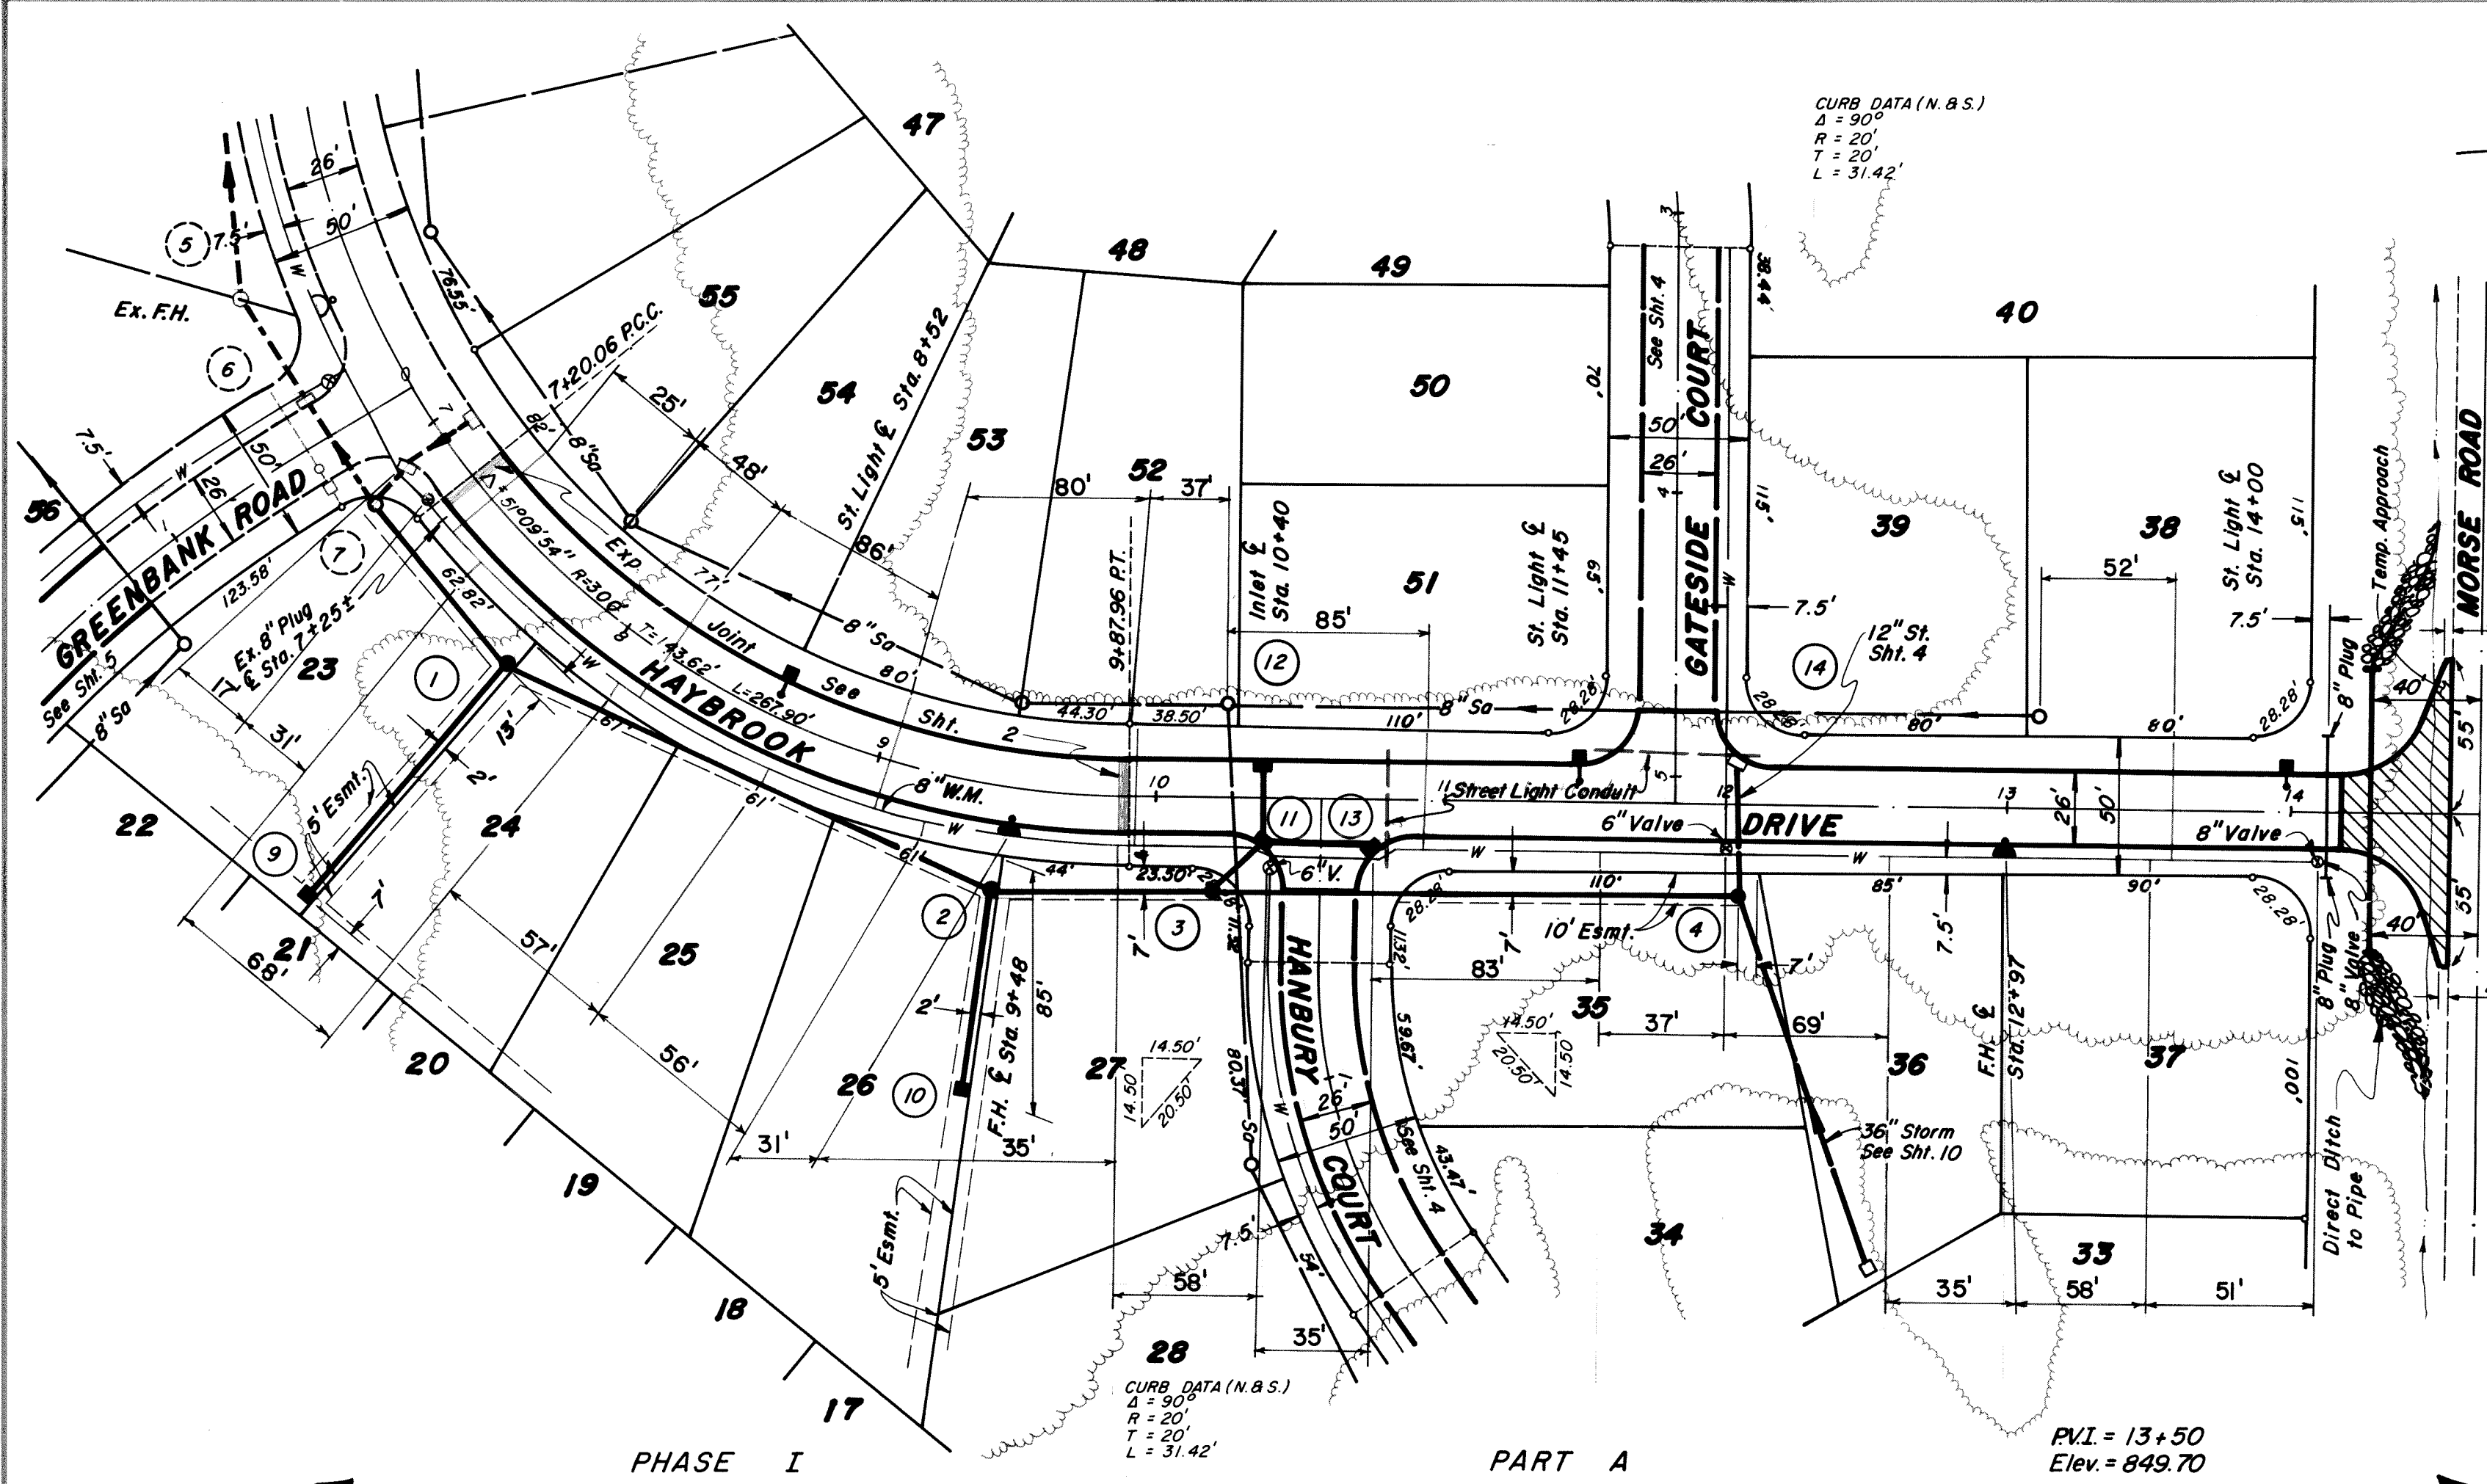

Temporary Approach

Temporary Approaches shall be built as directed by the Engineer and shall consist of 7" Bituminous Aggregate Base (Item 301) covered with 1 1/4" Asphalt Concrete Intermediate Course (Item 402) and 1 1/4" Asphalt Concrete Surface Course (Item 404).

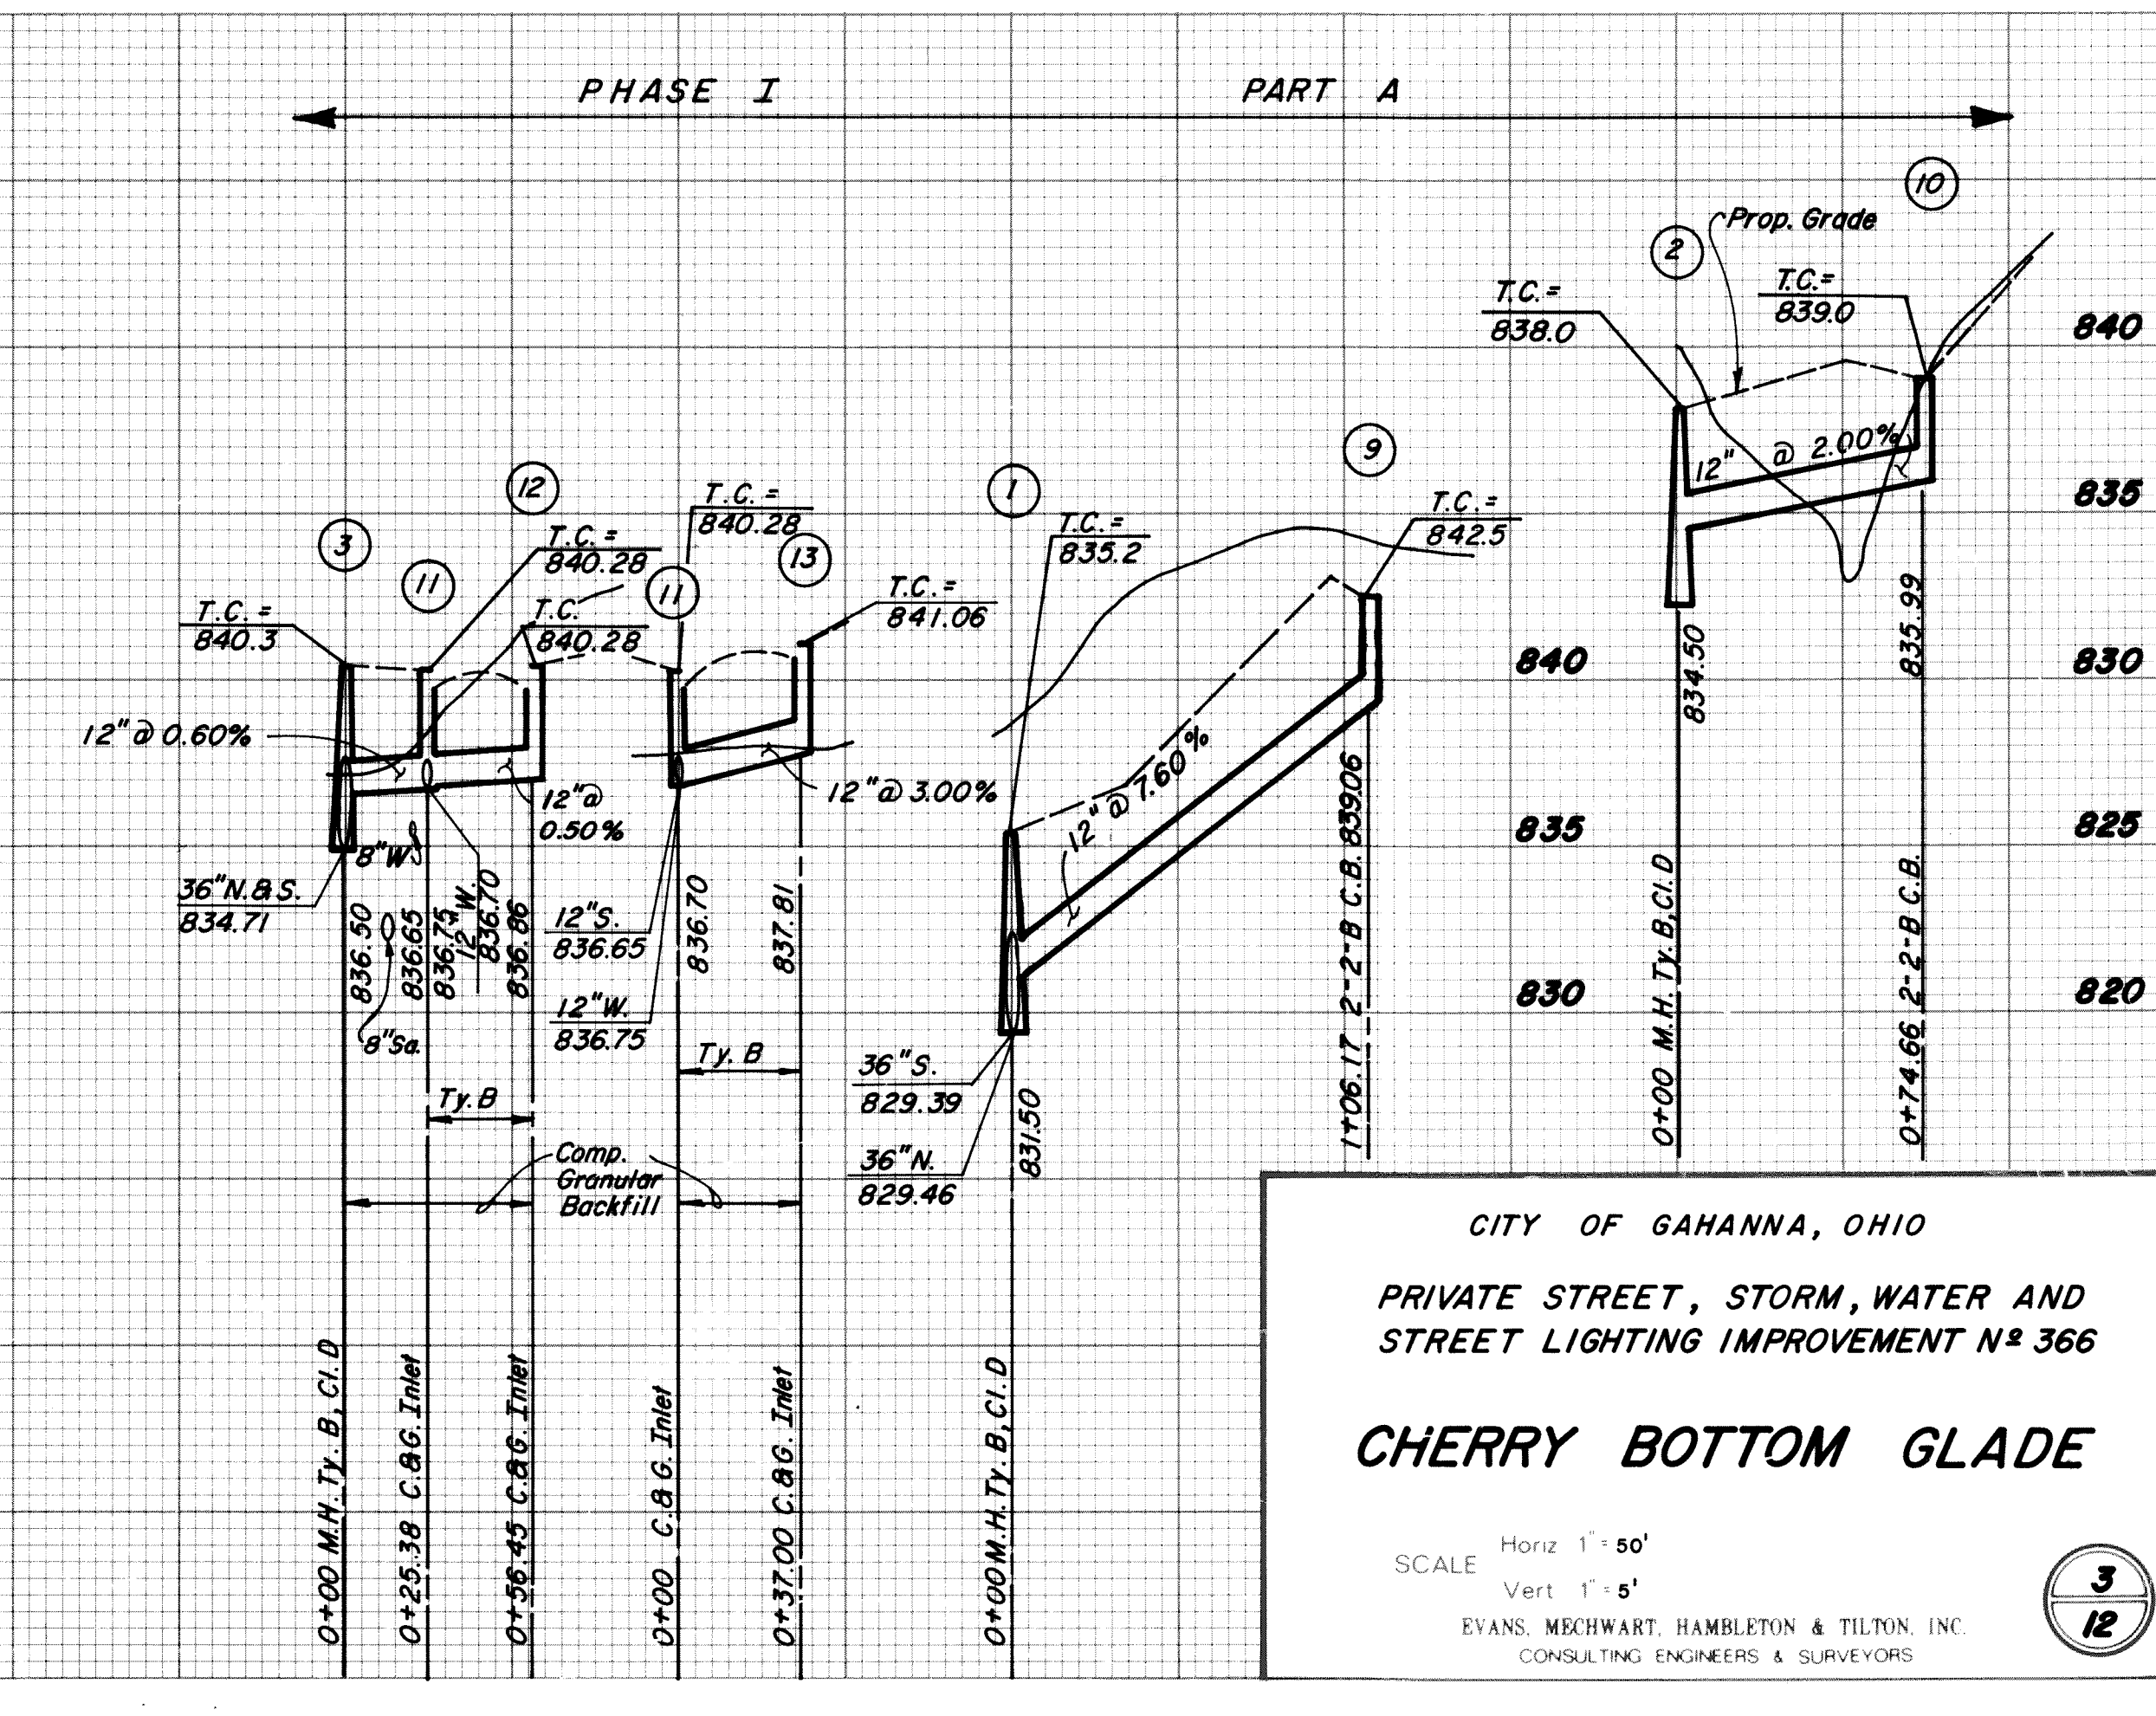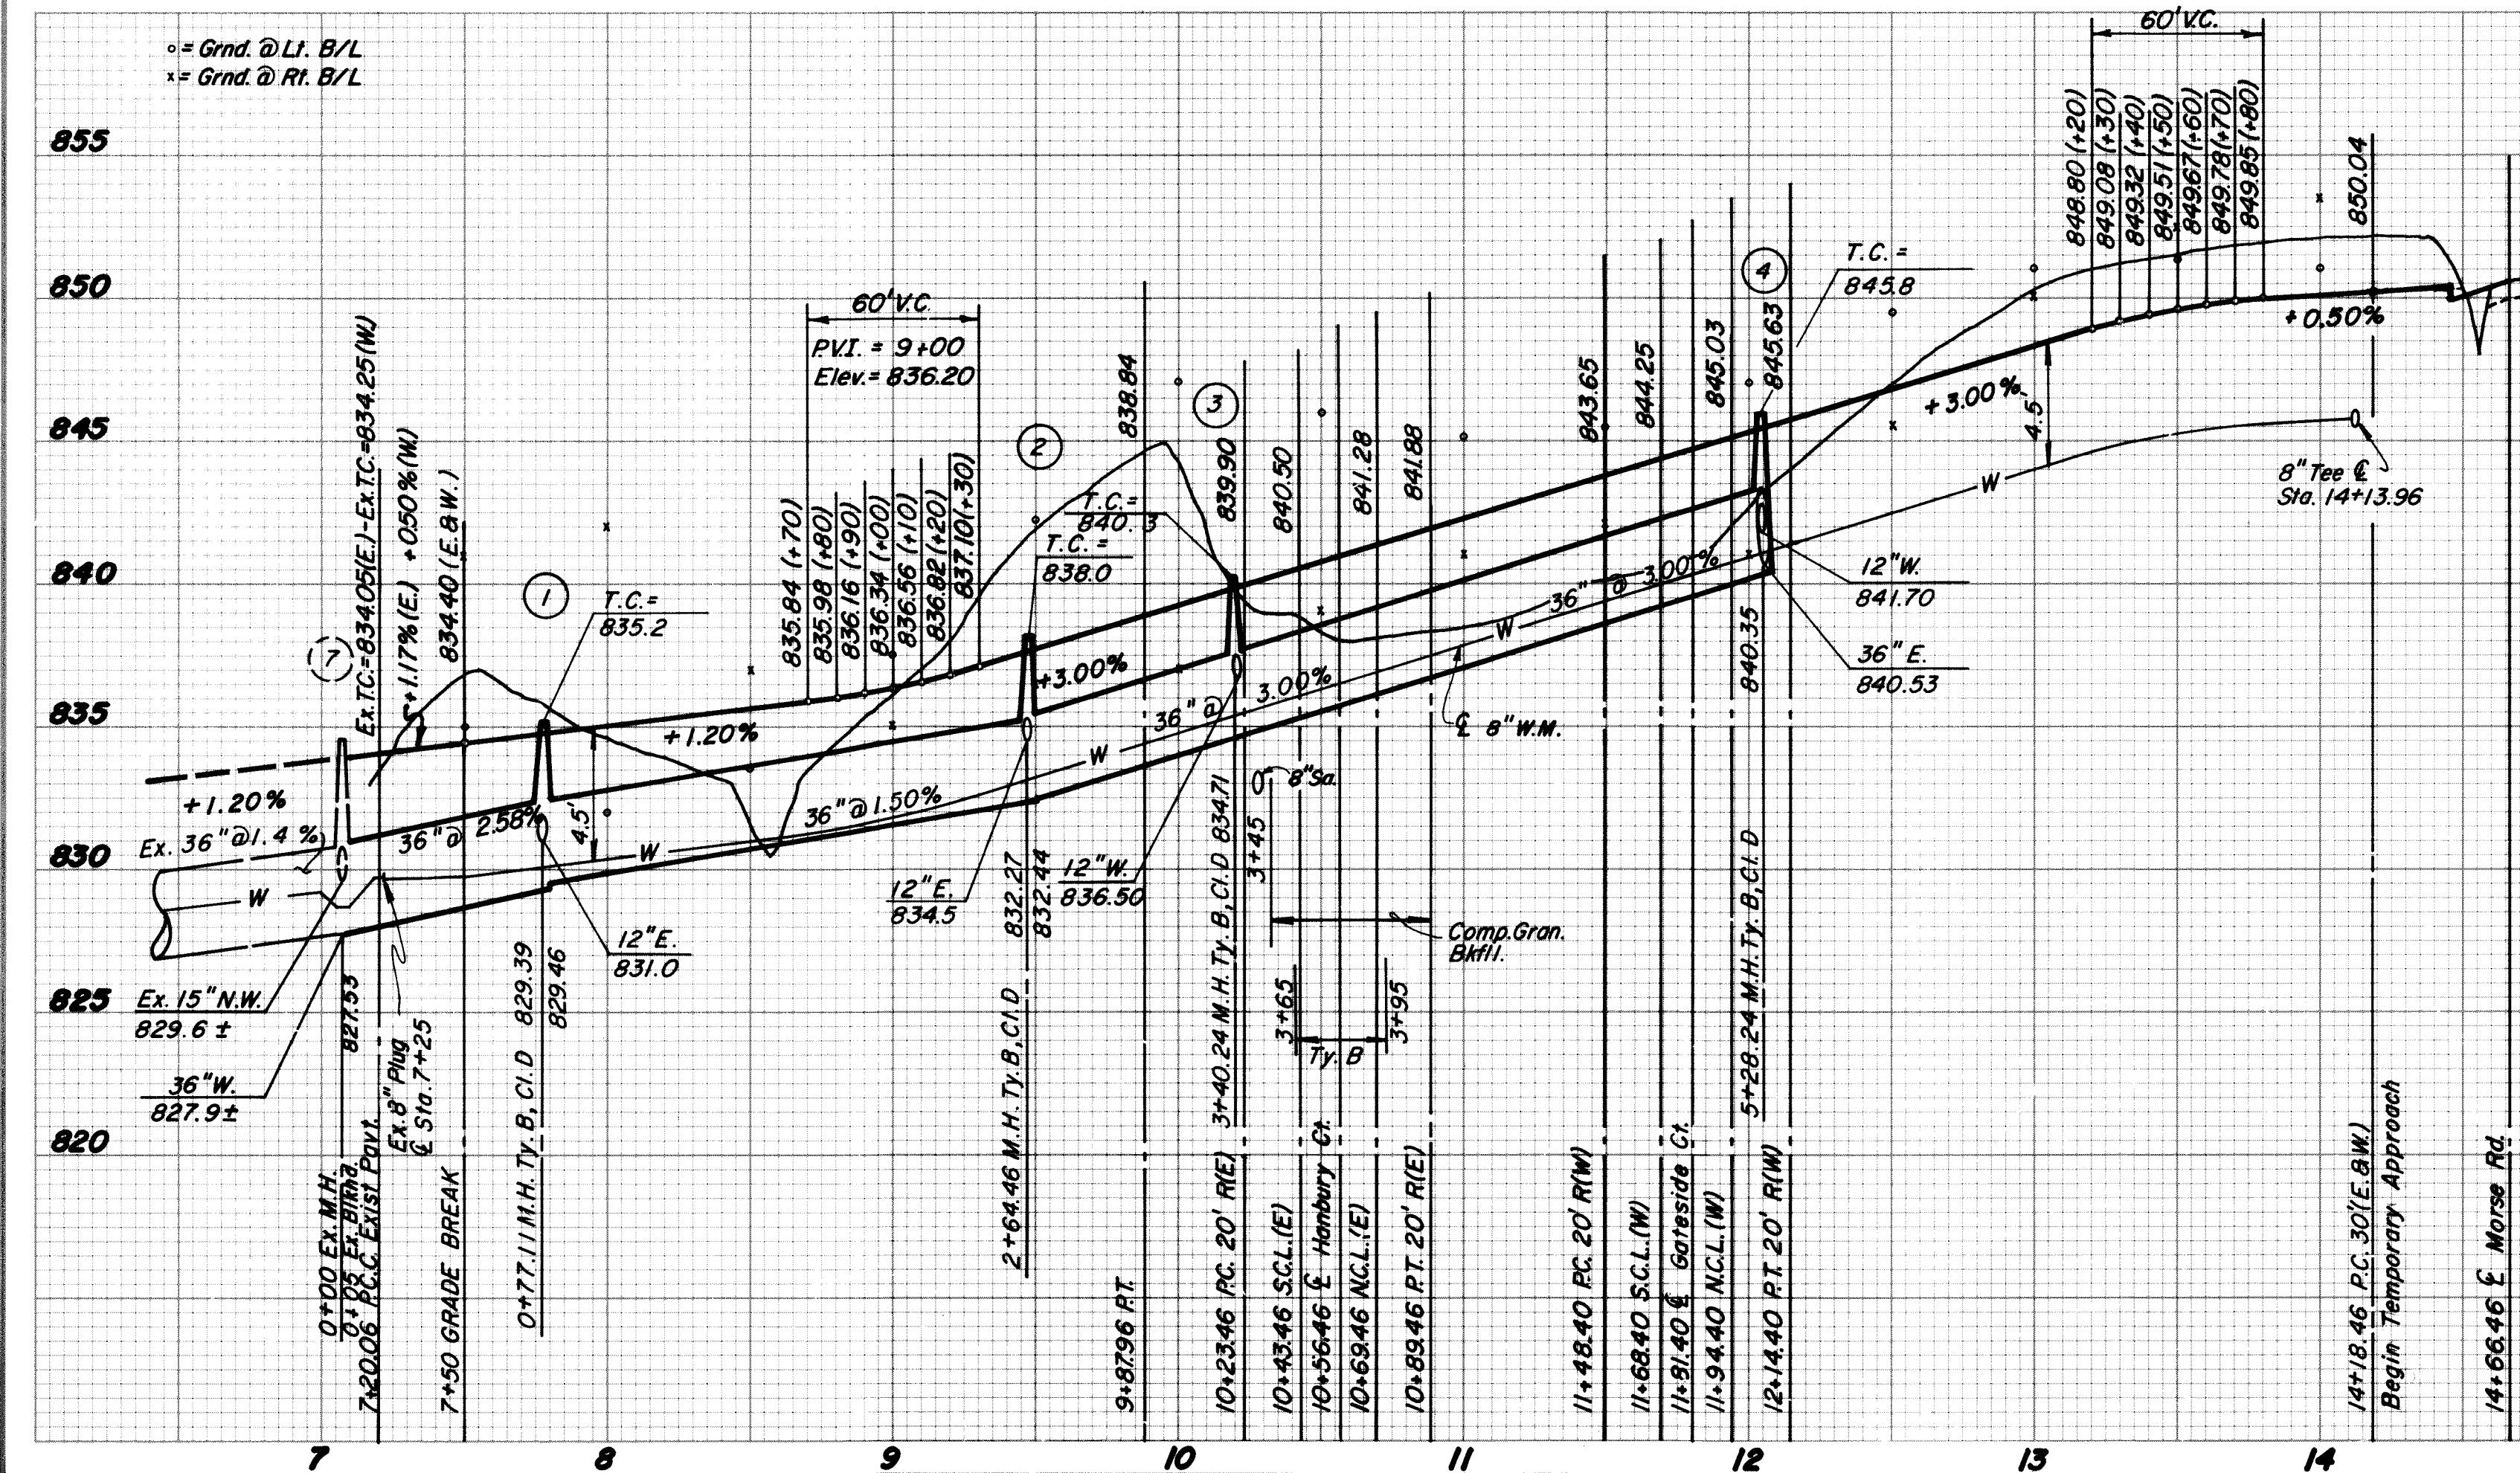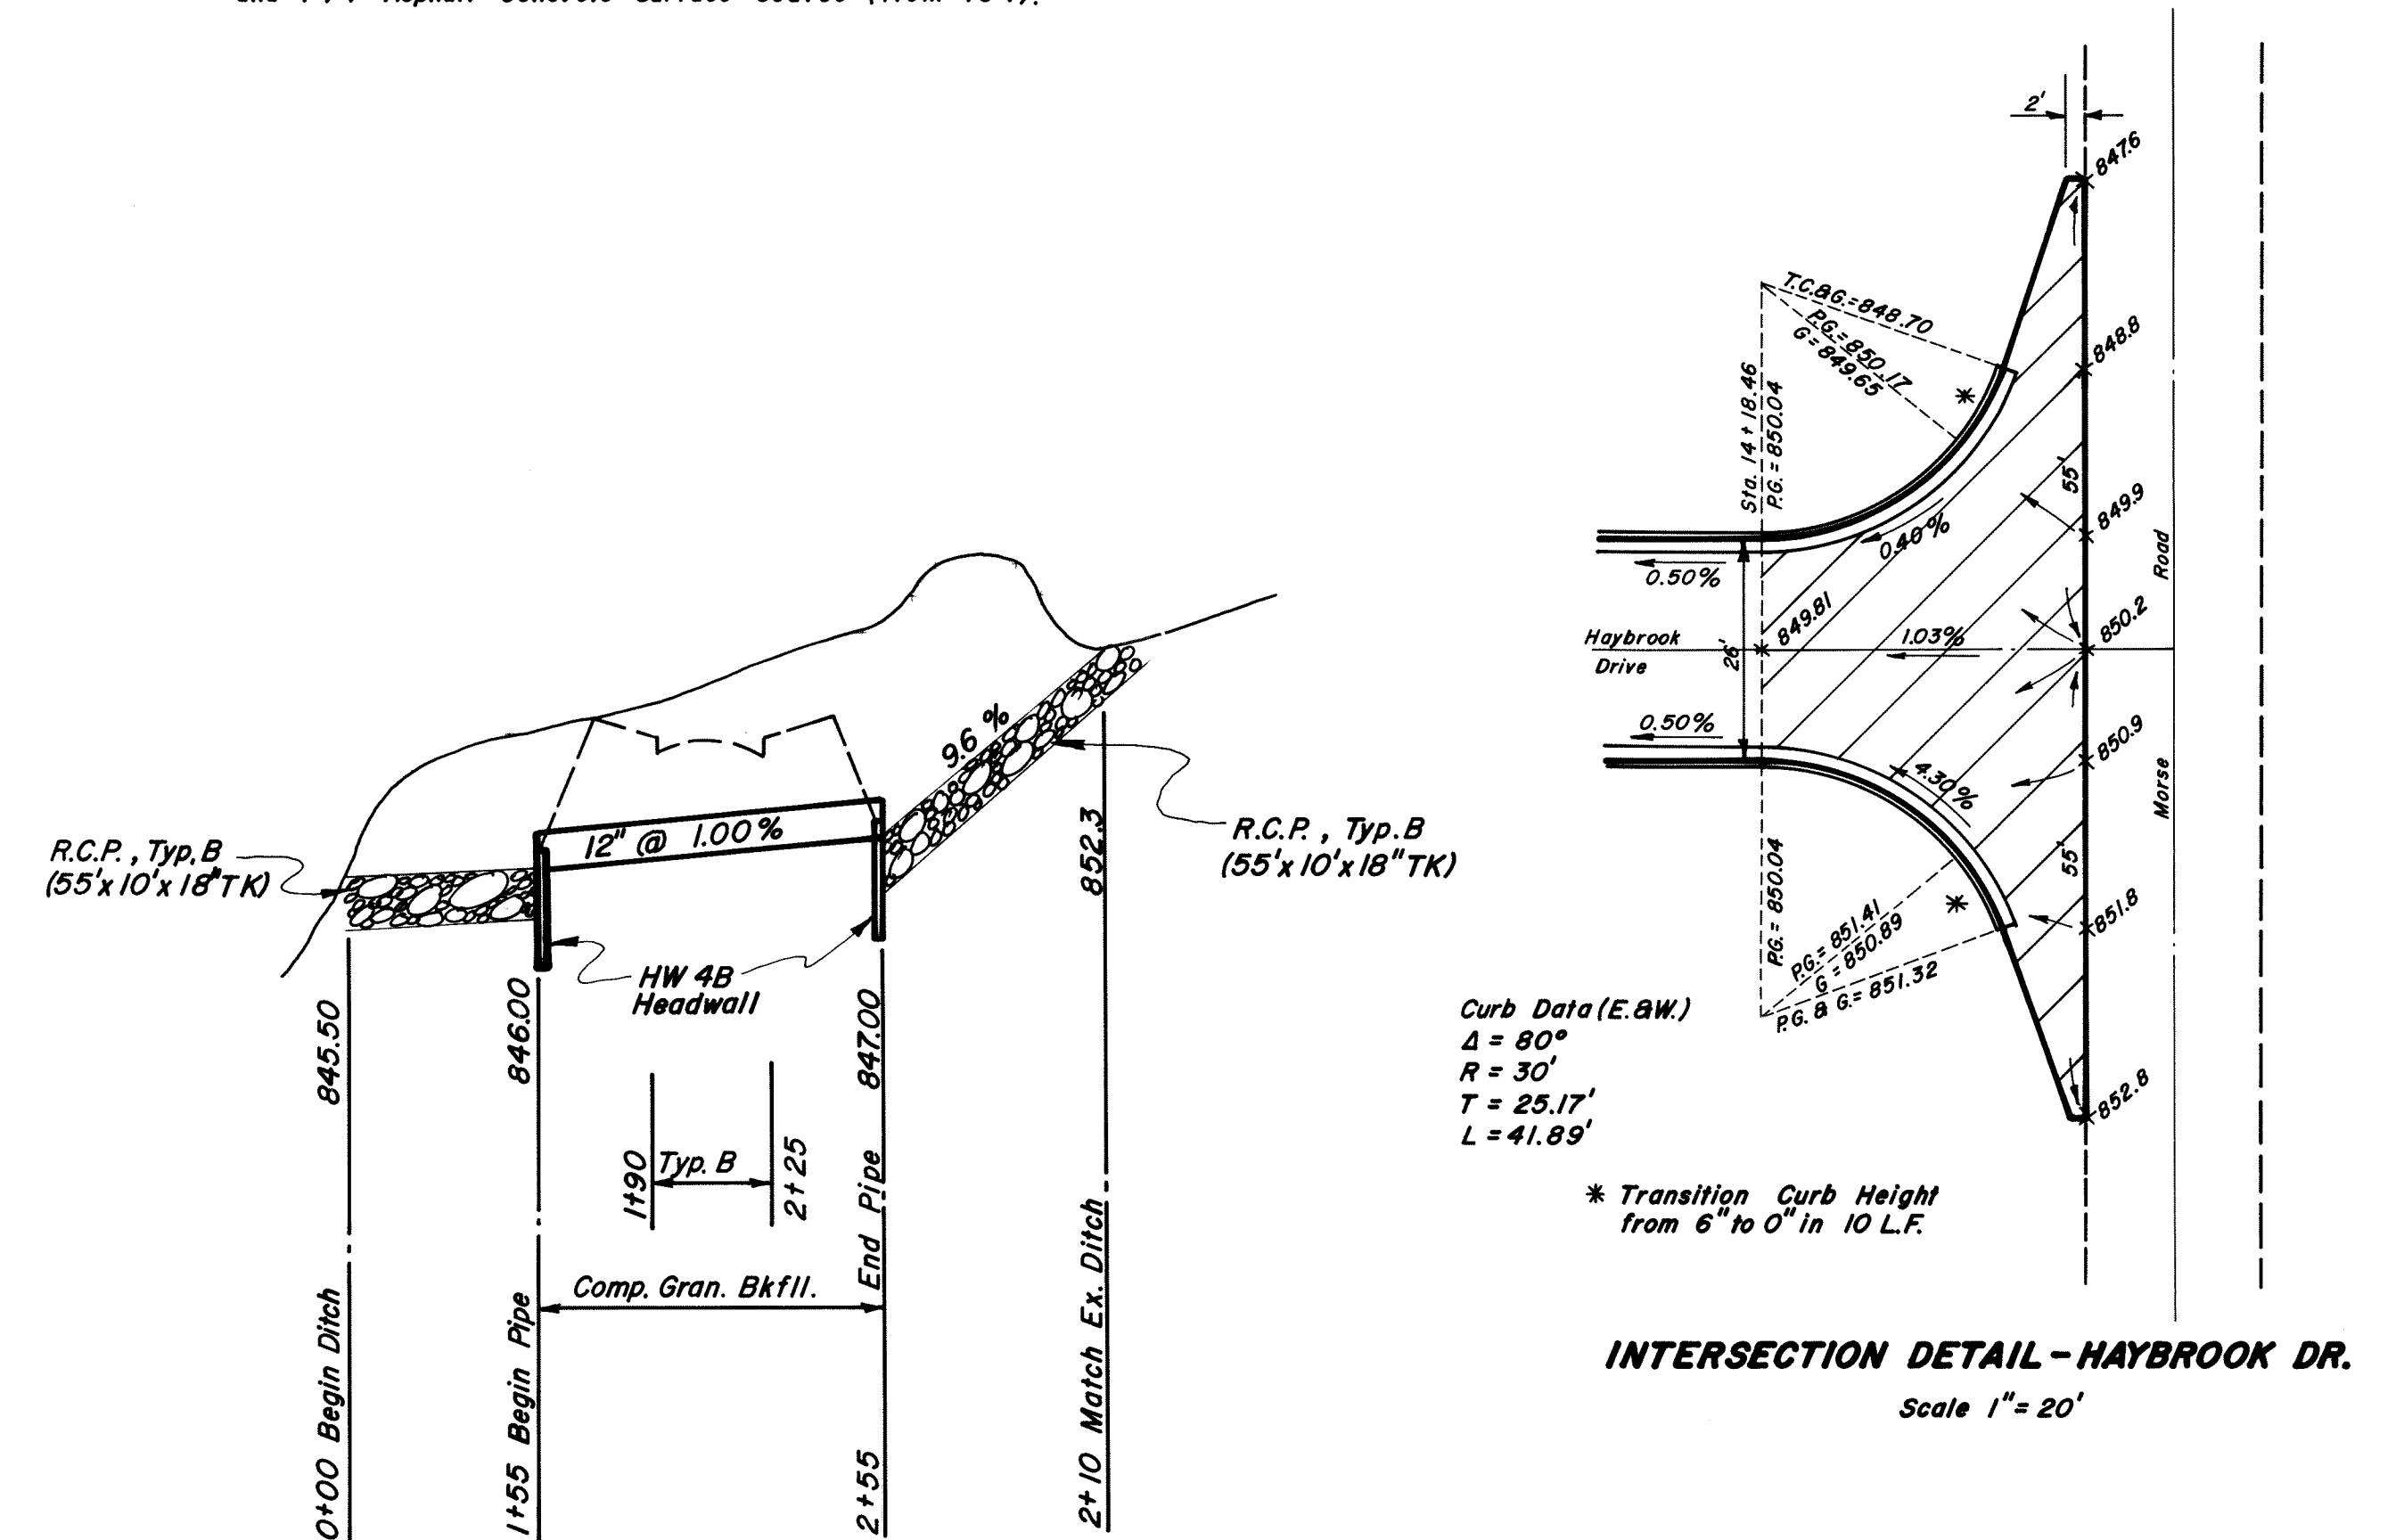

CITY OF GAHANNA, OHIO



PRIVATE STREET, STORM, WATER AND STREET LIGHTING IMPROVEMENT N° 366


CHERRY BOTTOM GLADE

SCALE Horiz 1" = 50'
Vert 1" = 5'

EVANS, MECHWART, HAMBLETON & TILTON INC.
CONSULTING ENGINEERS & SURVEYORS


3
12

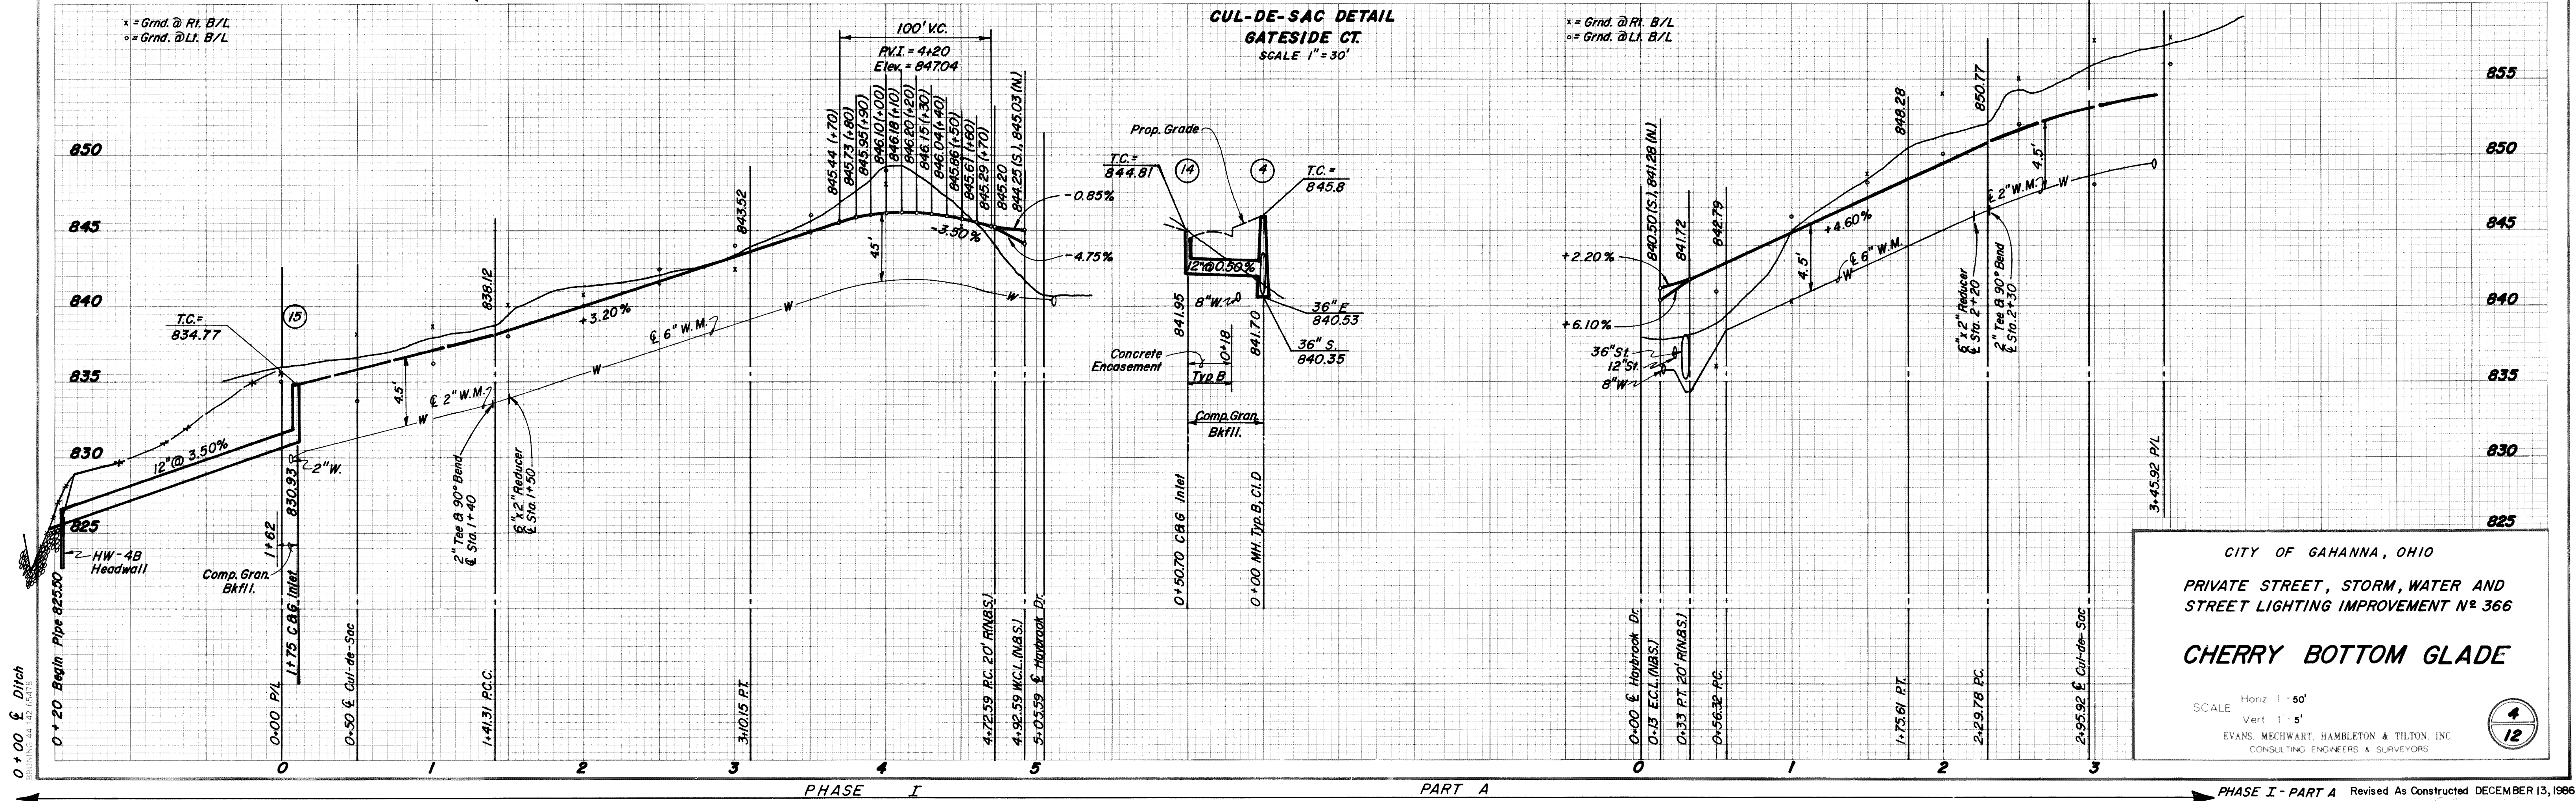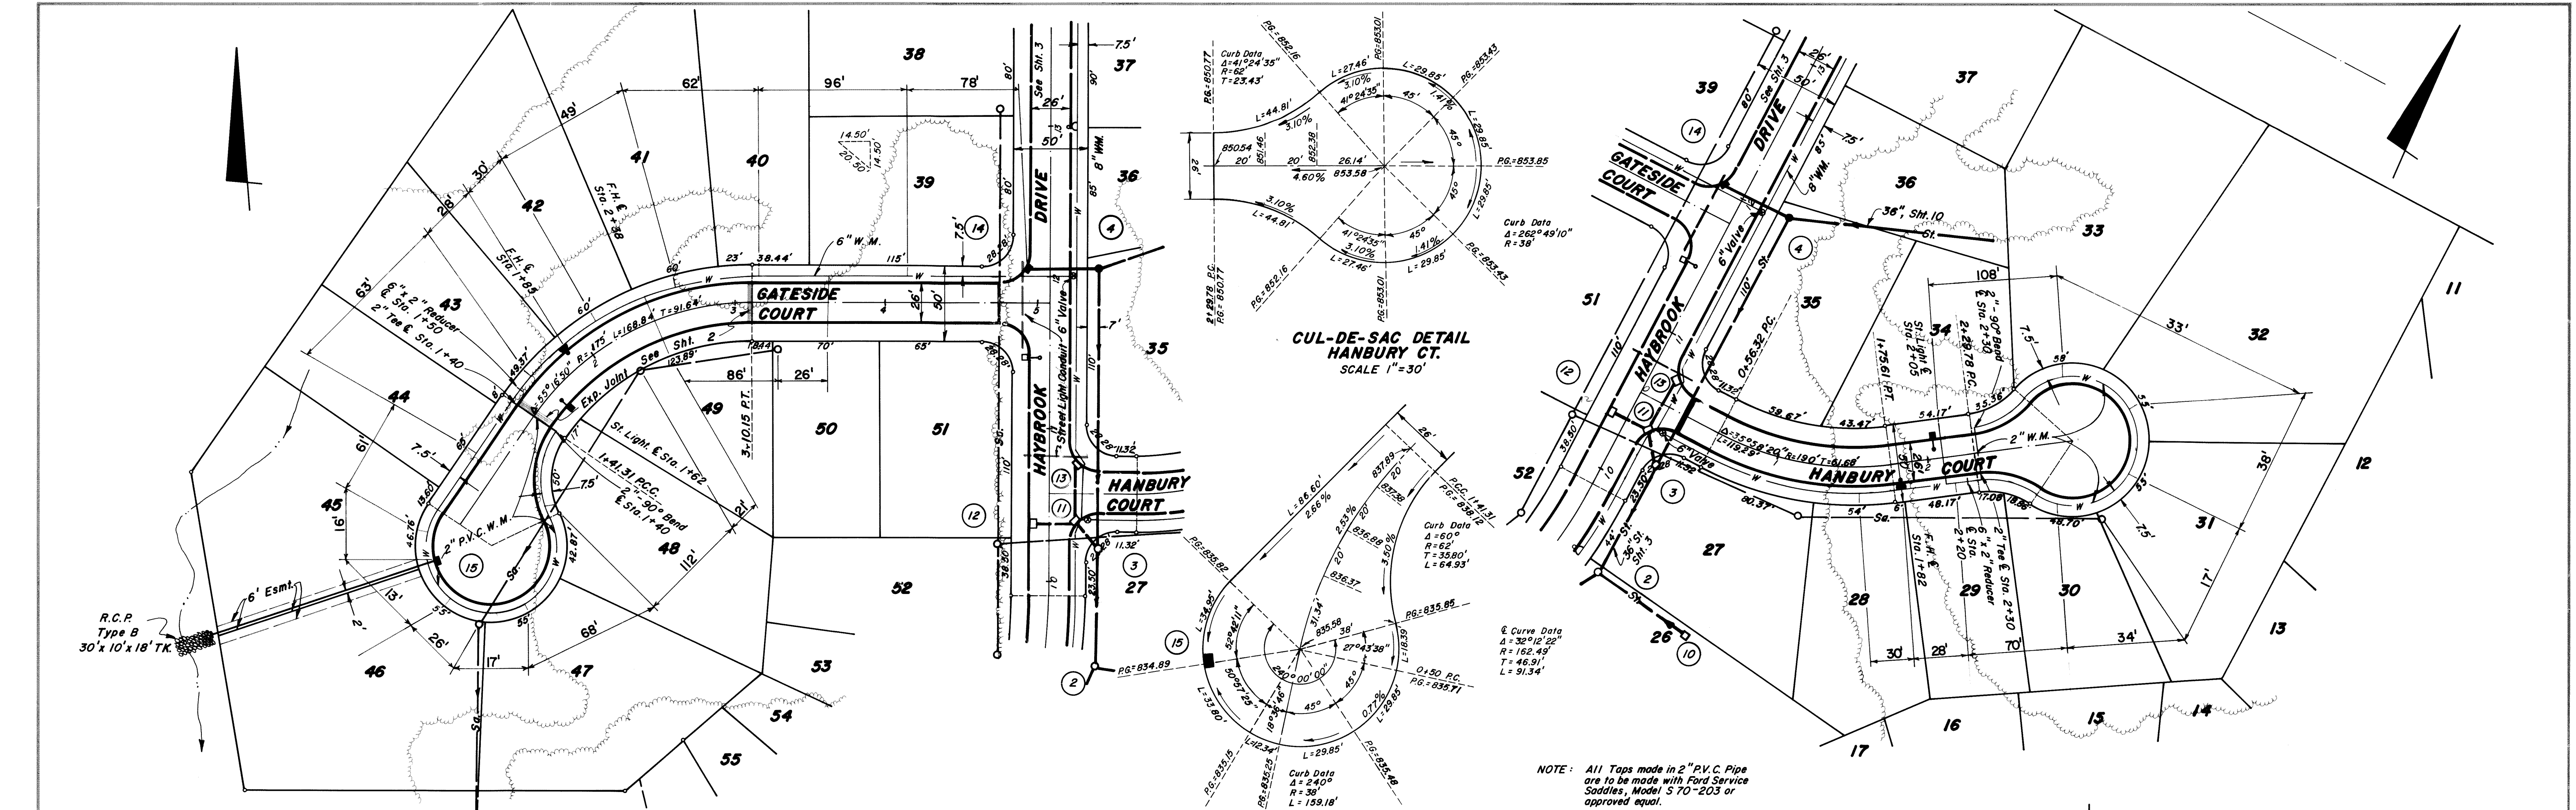

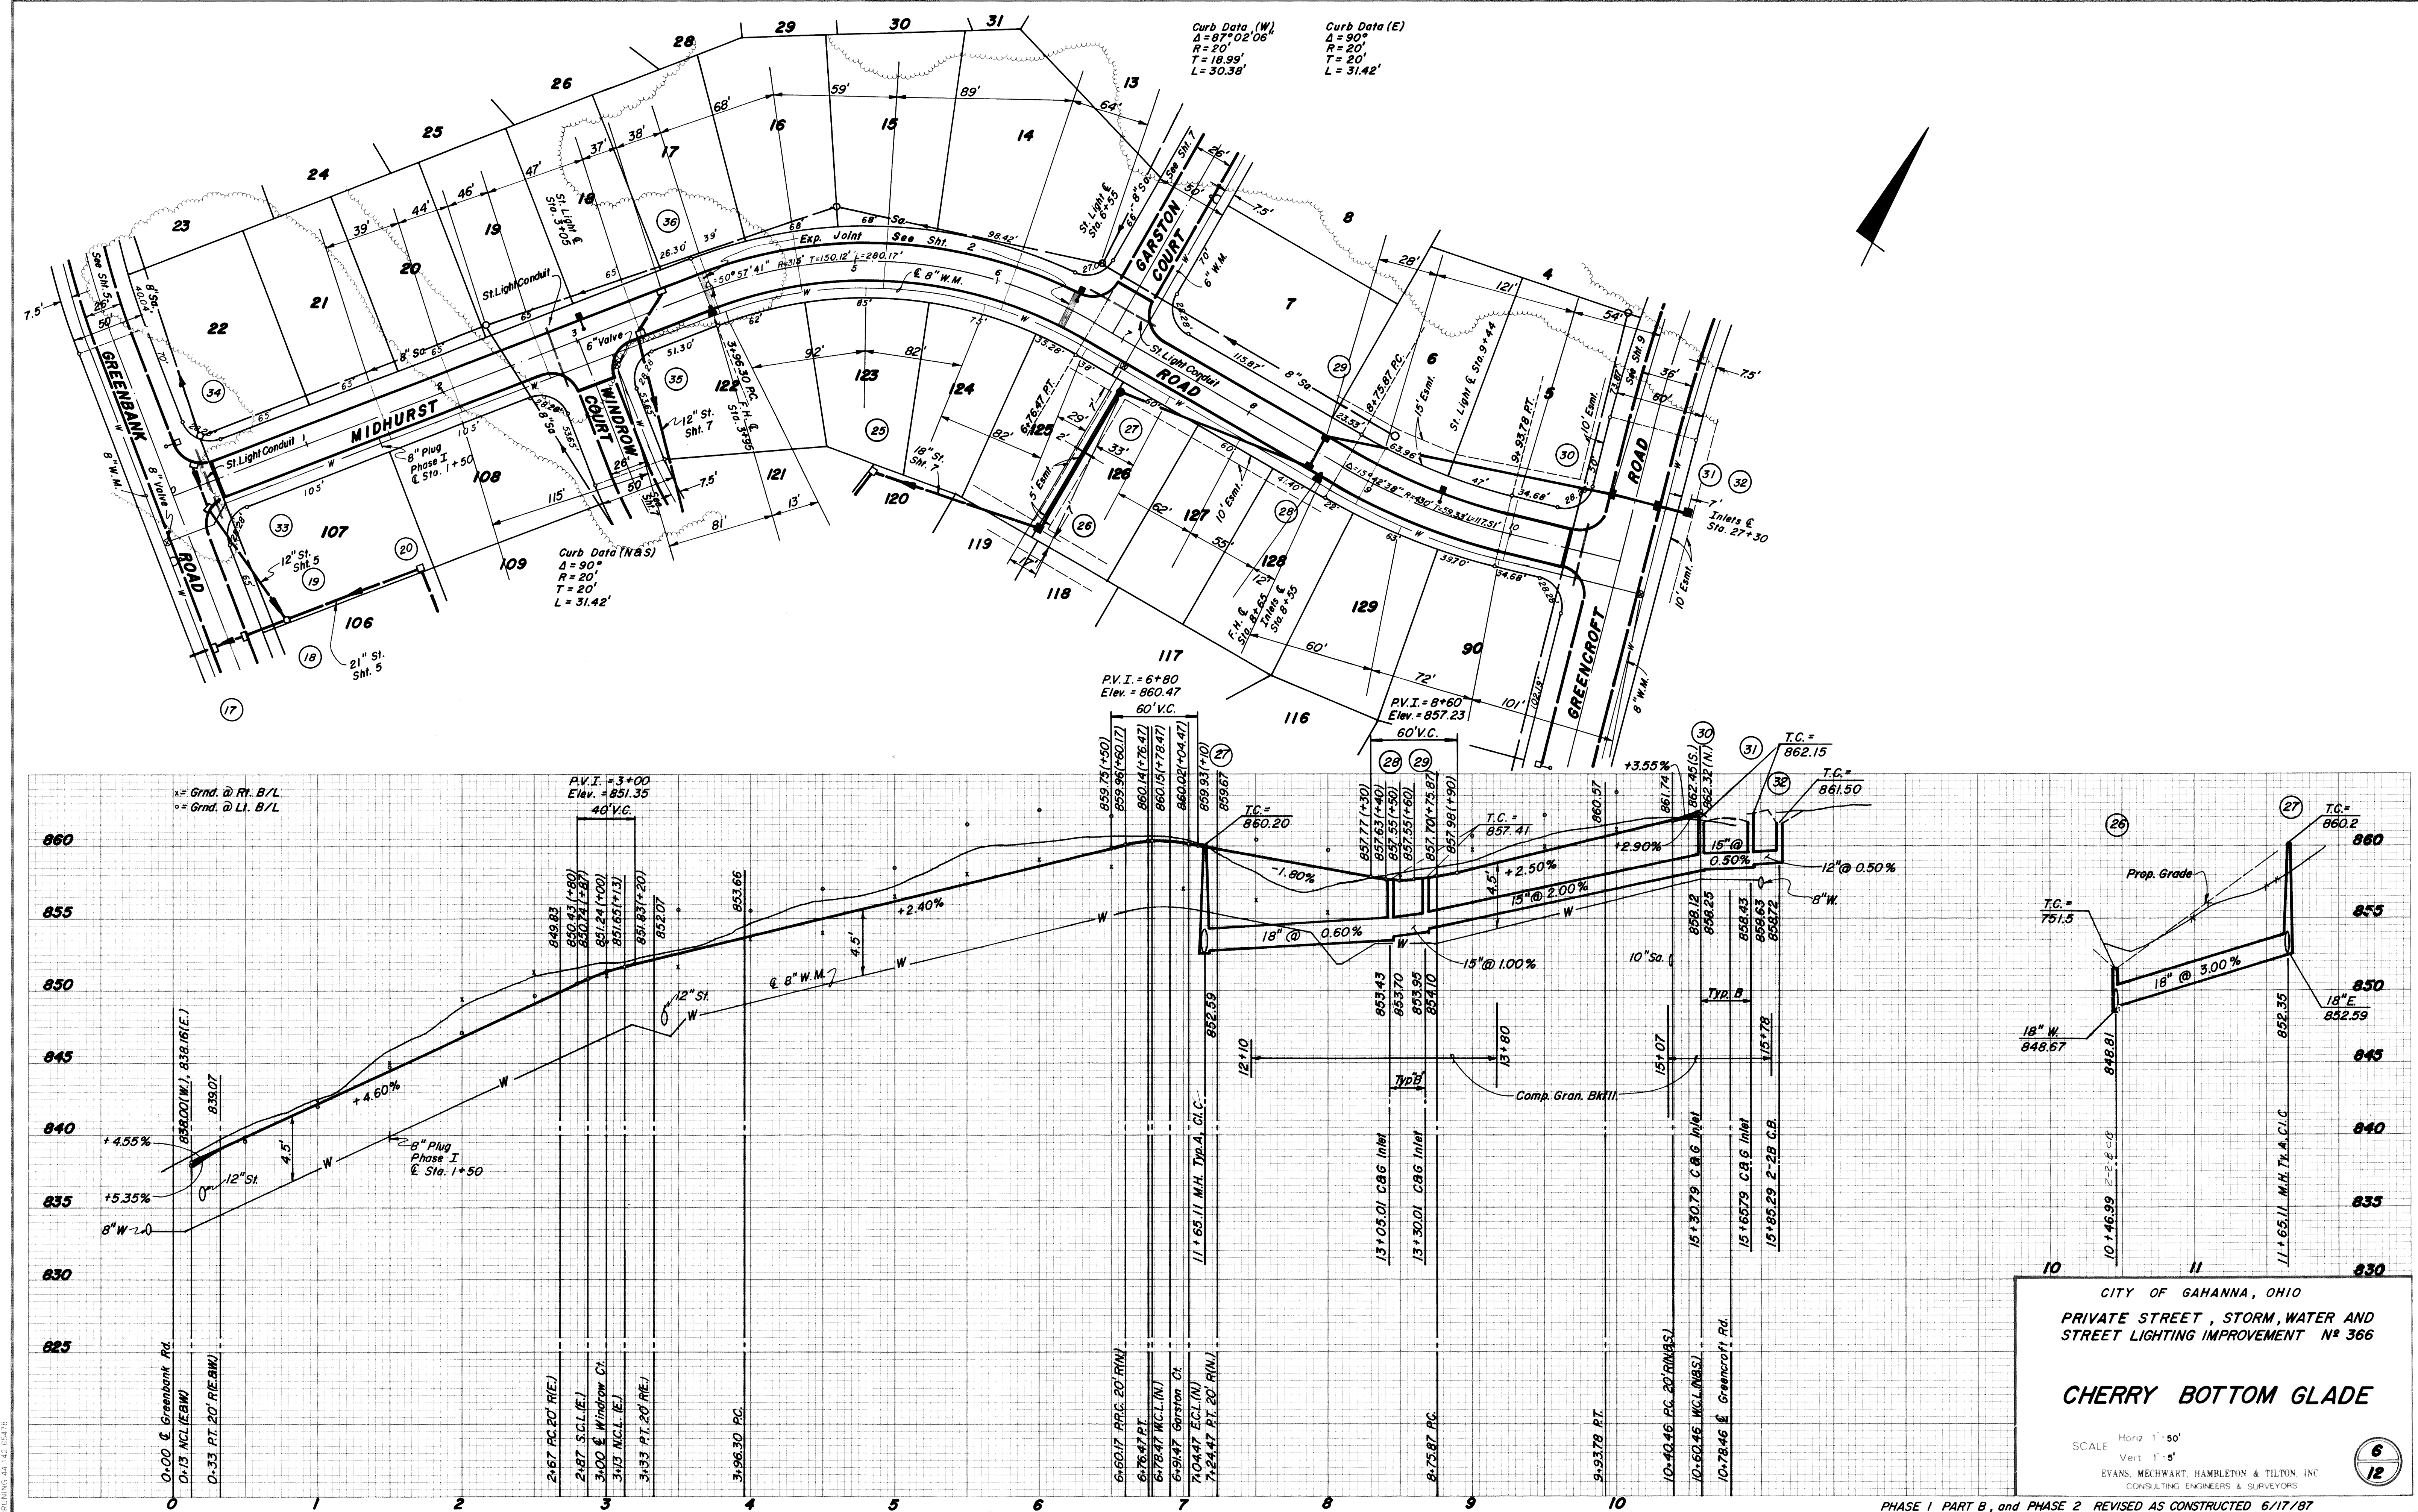




BRUNING 44 42 65478





PHASE 1 PART B, and PHASE 2 REVISED AS CONSTRUCTED 6/17/87


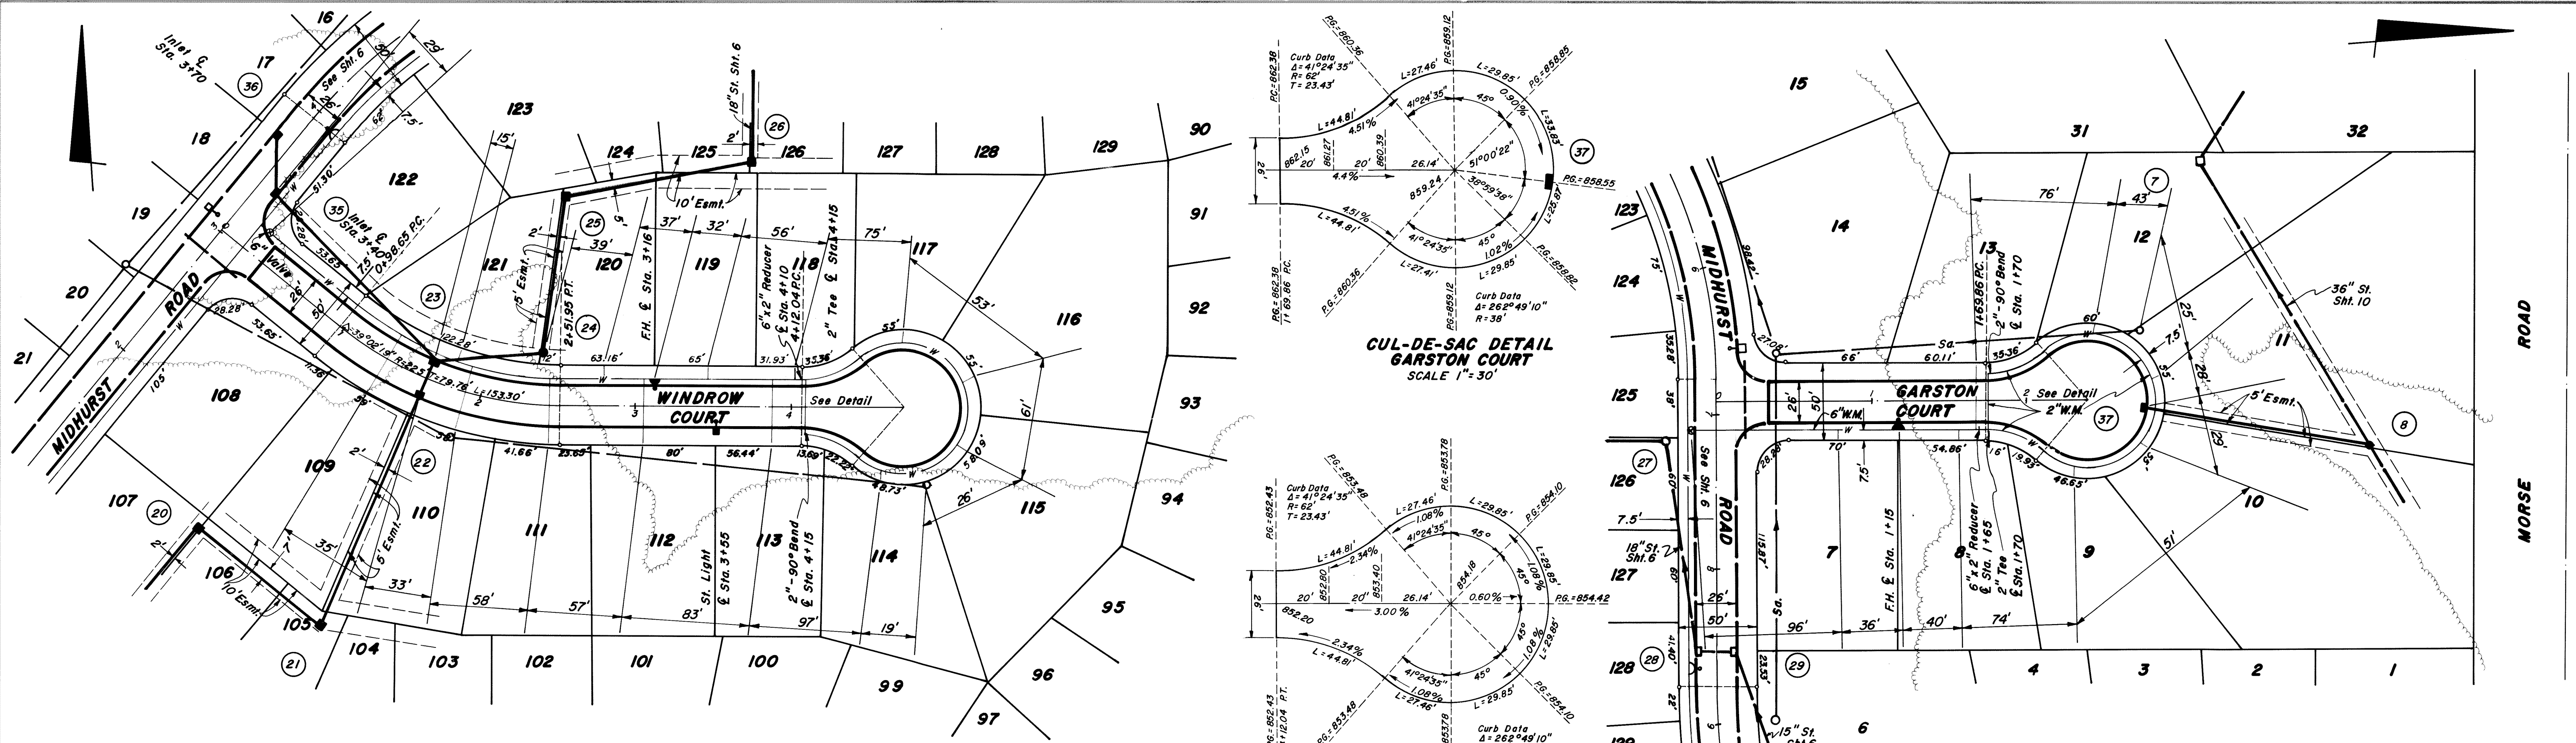


NOTE:
All taps made in 2" P.V.C. Pipe are to be made
with Ford Service Saddles, Model S 70-203 or
approved equal.


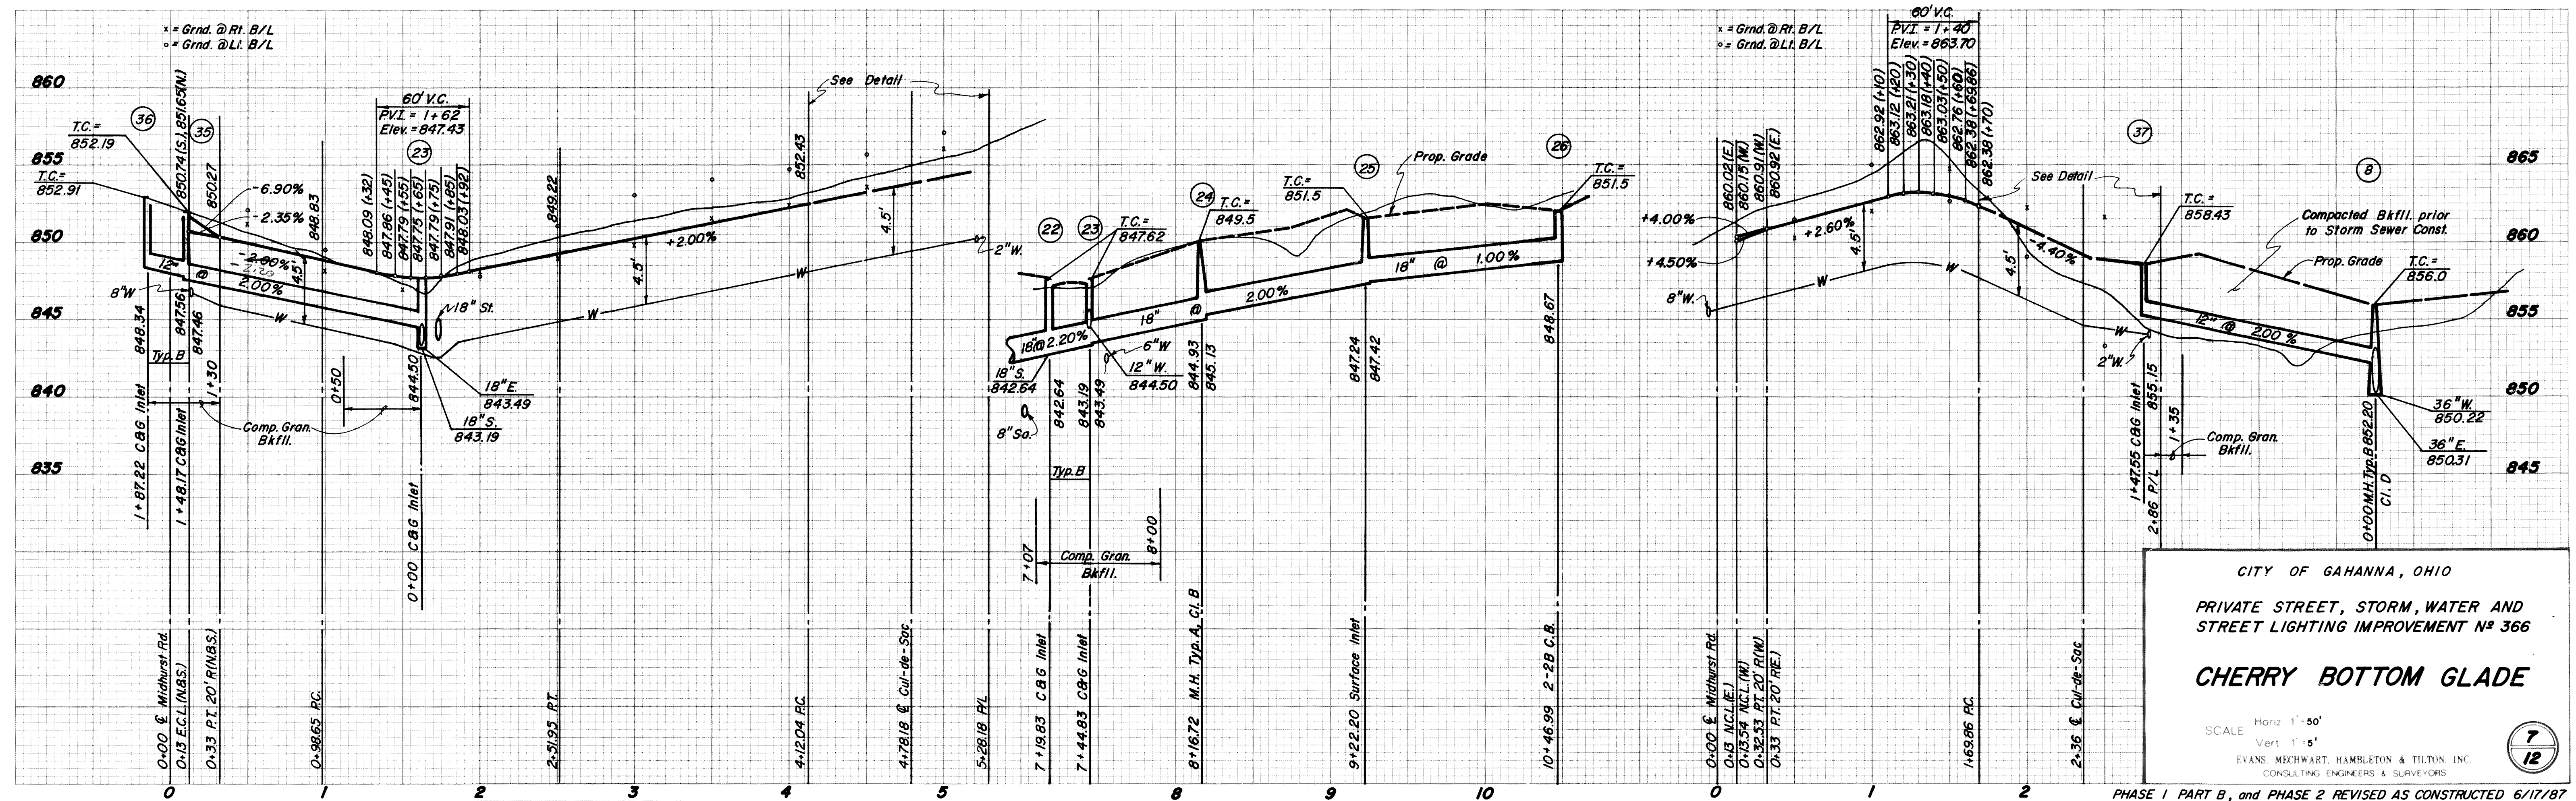


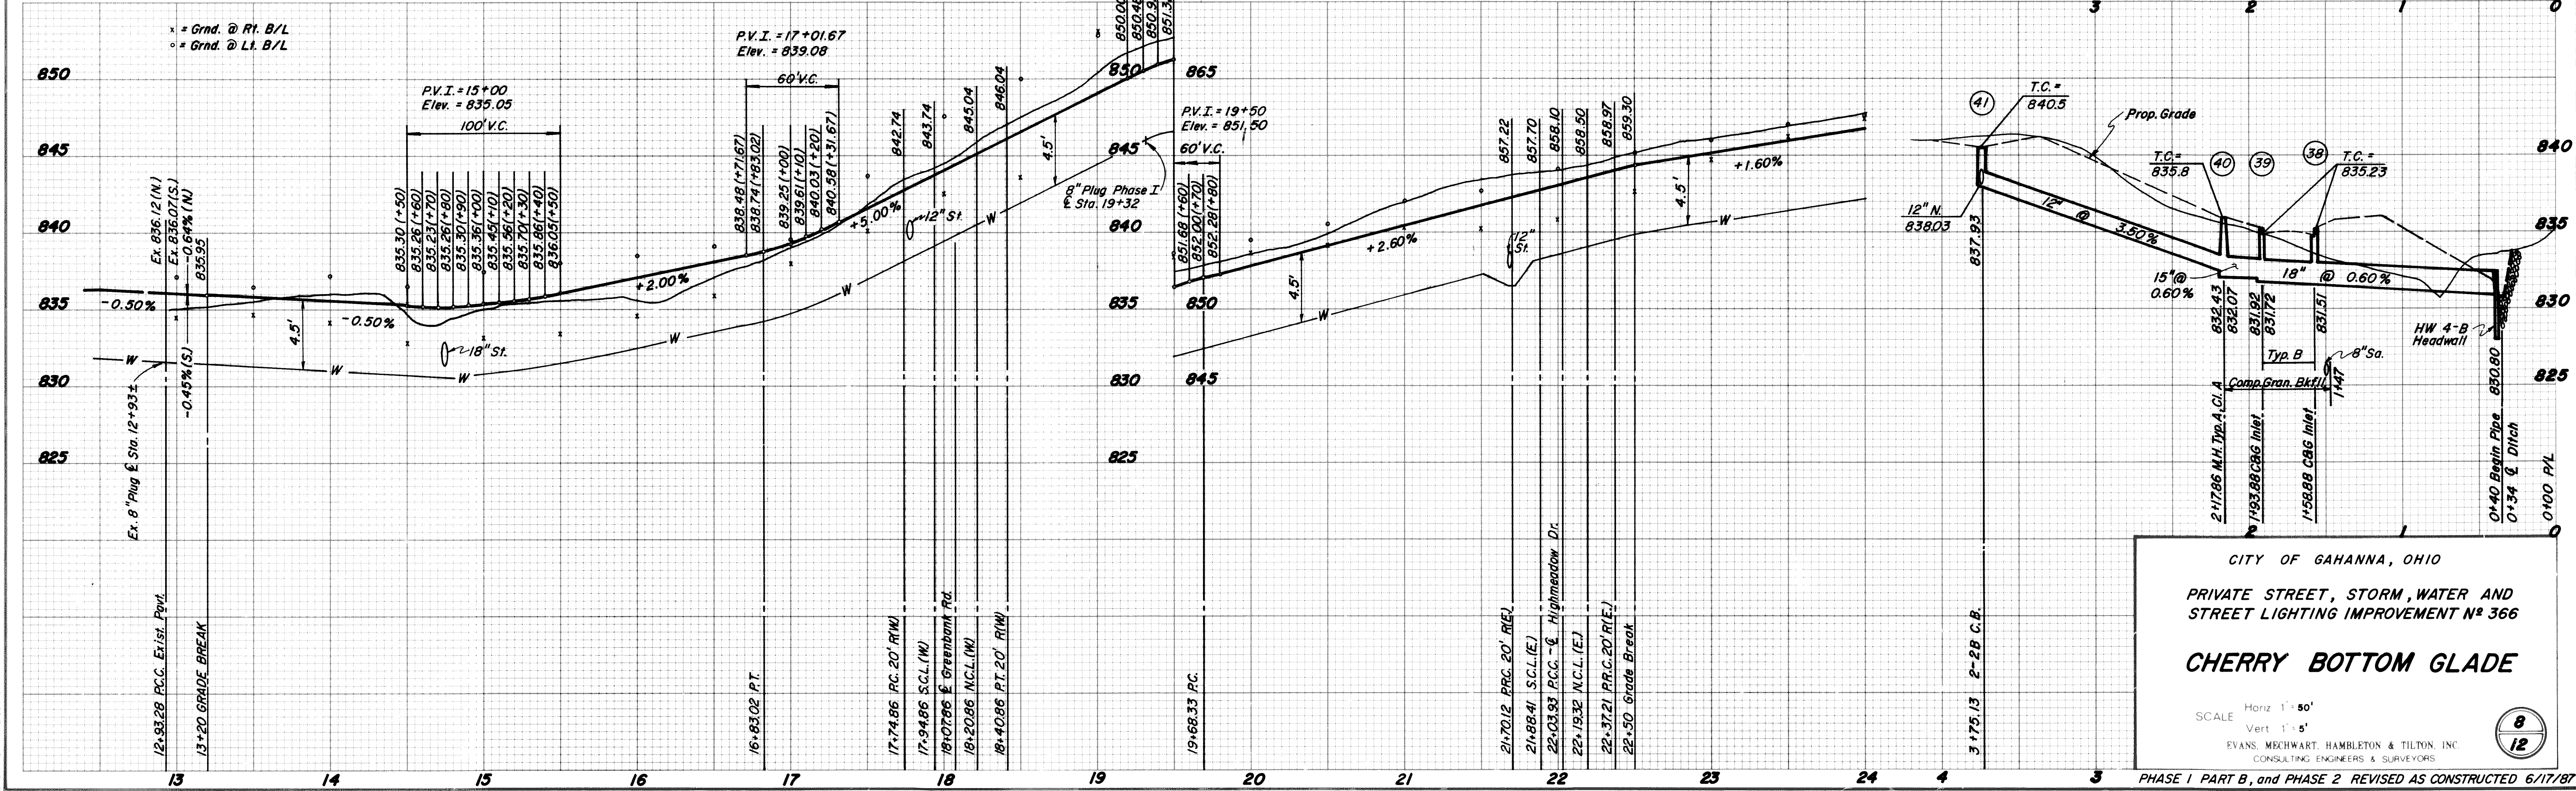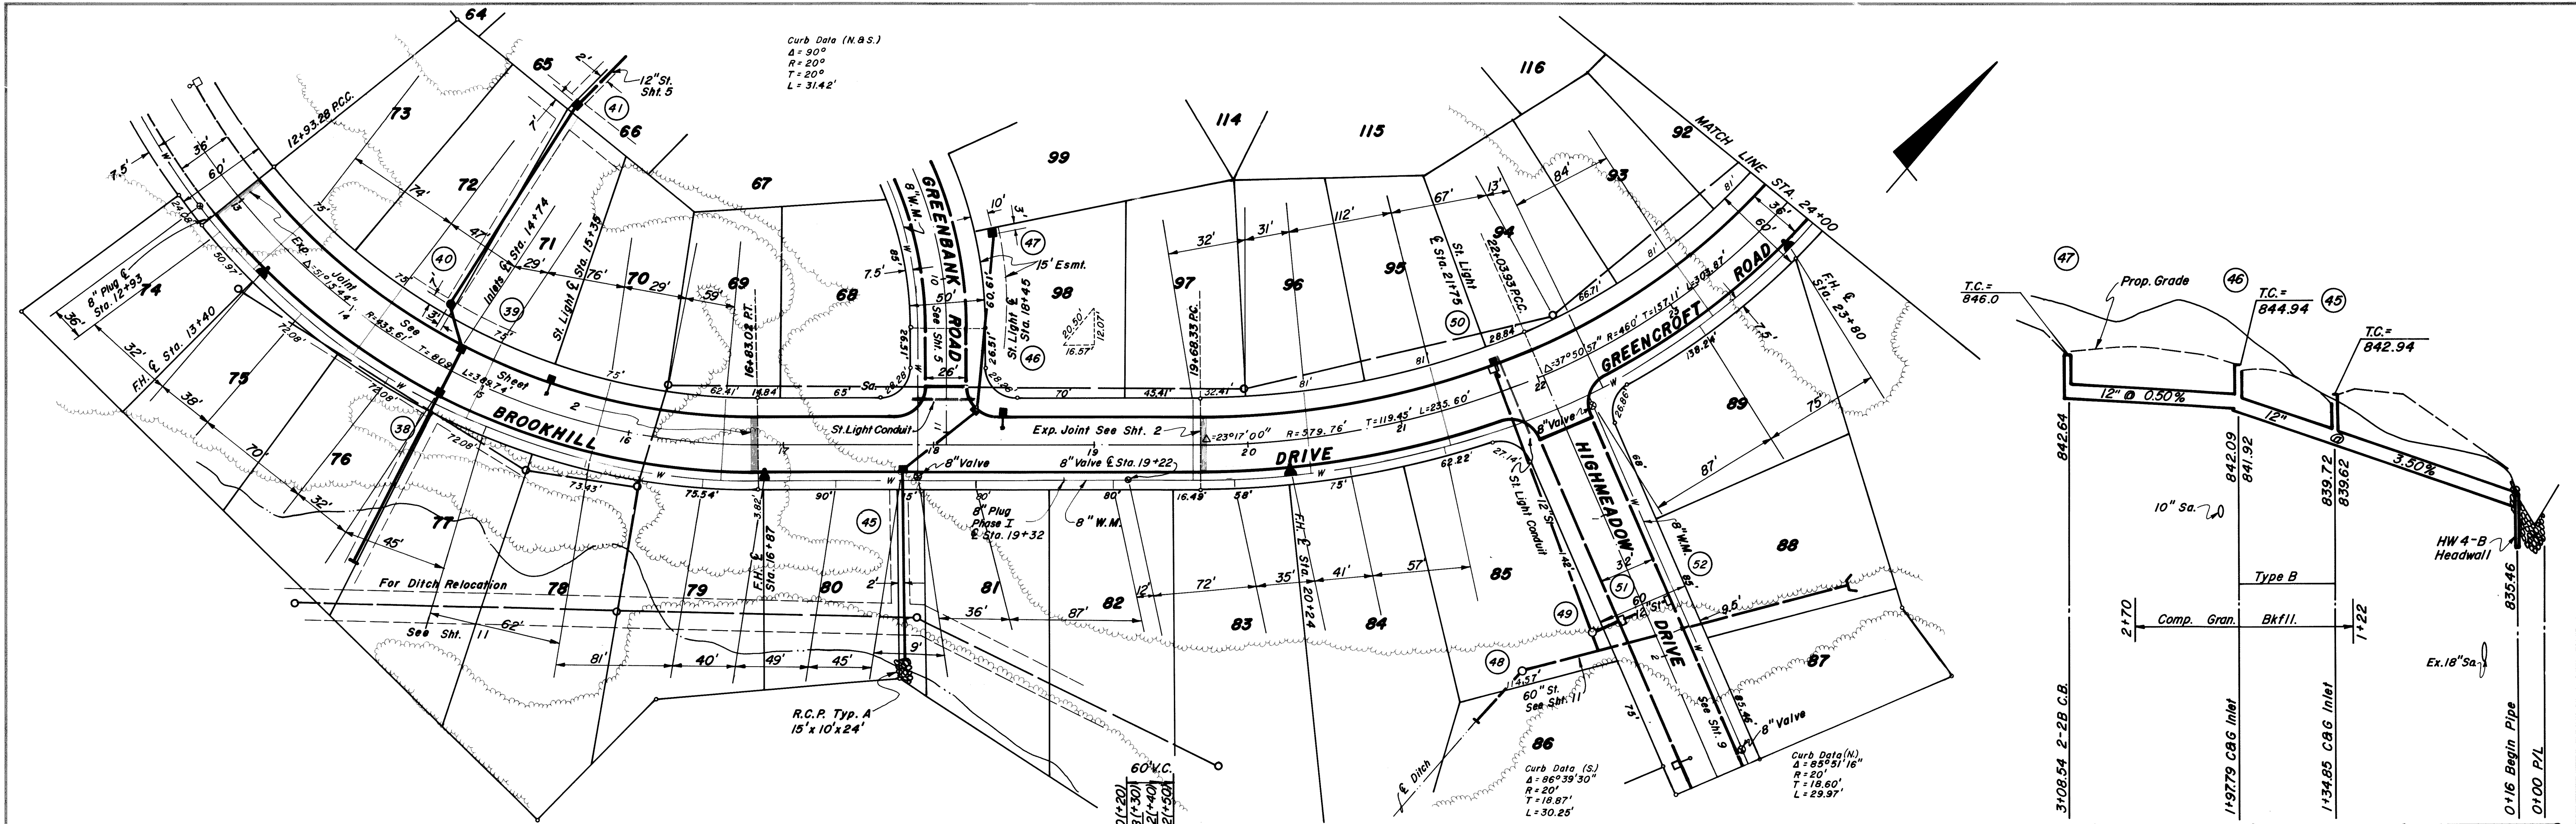

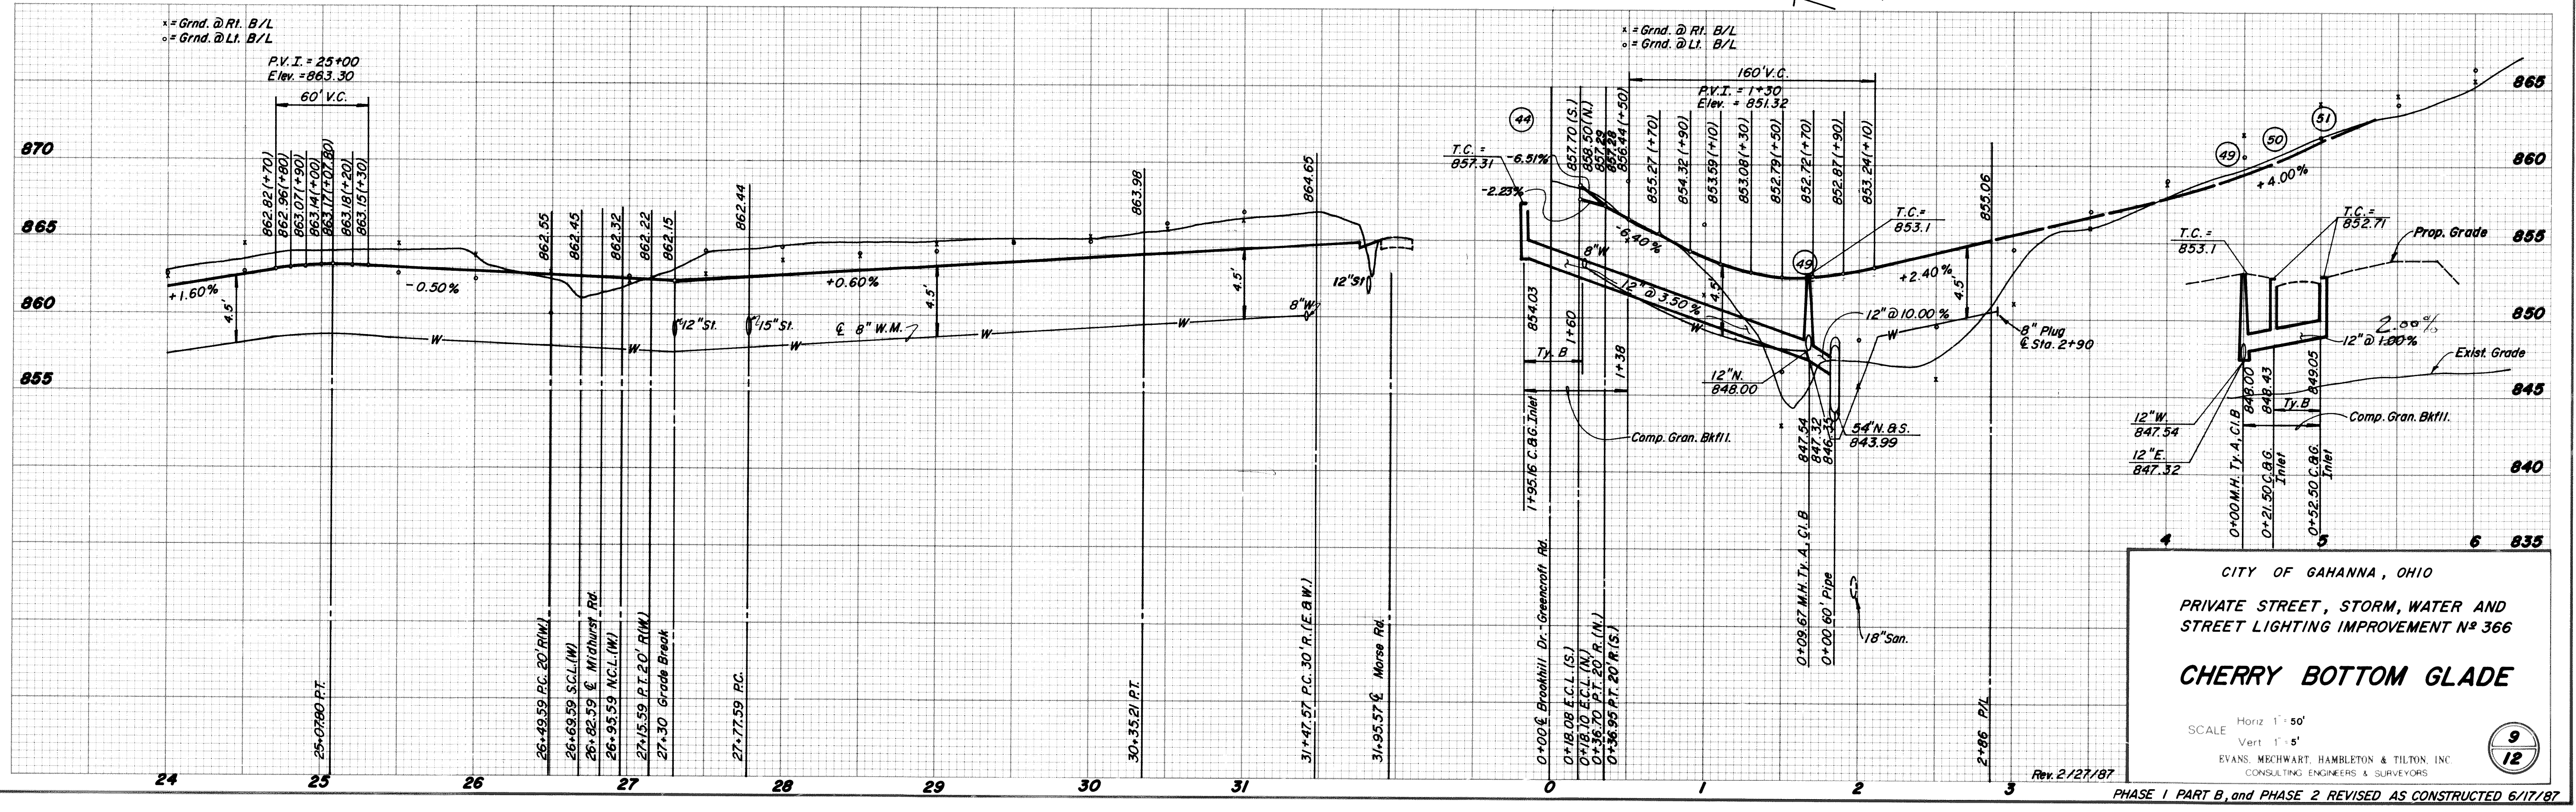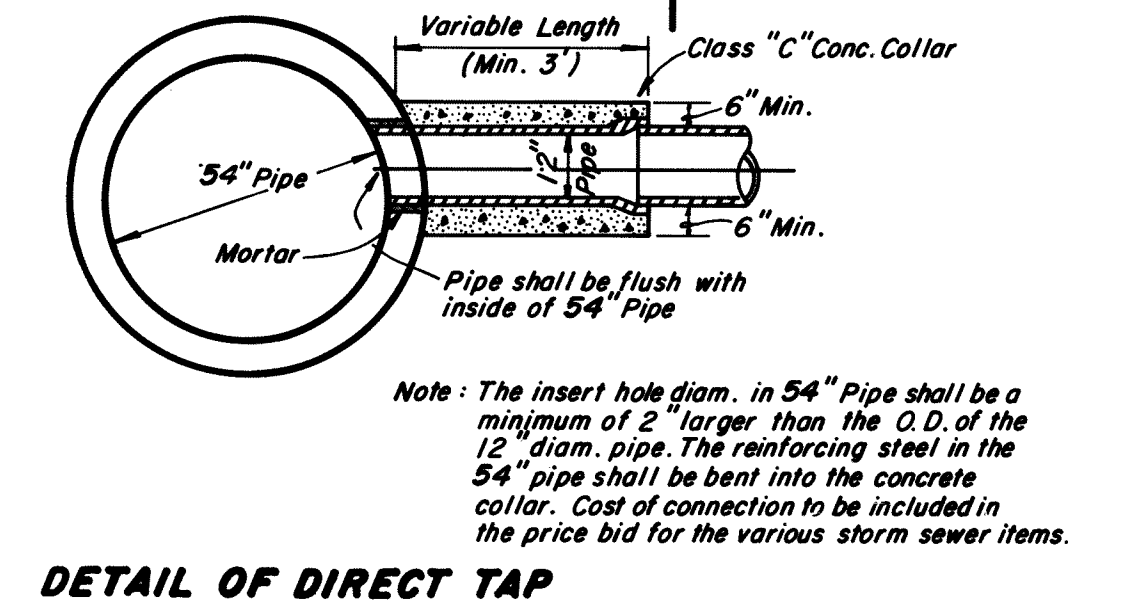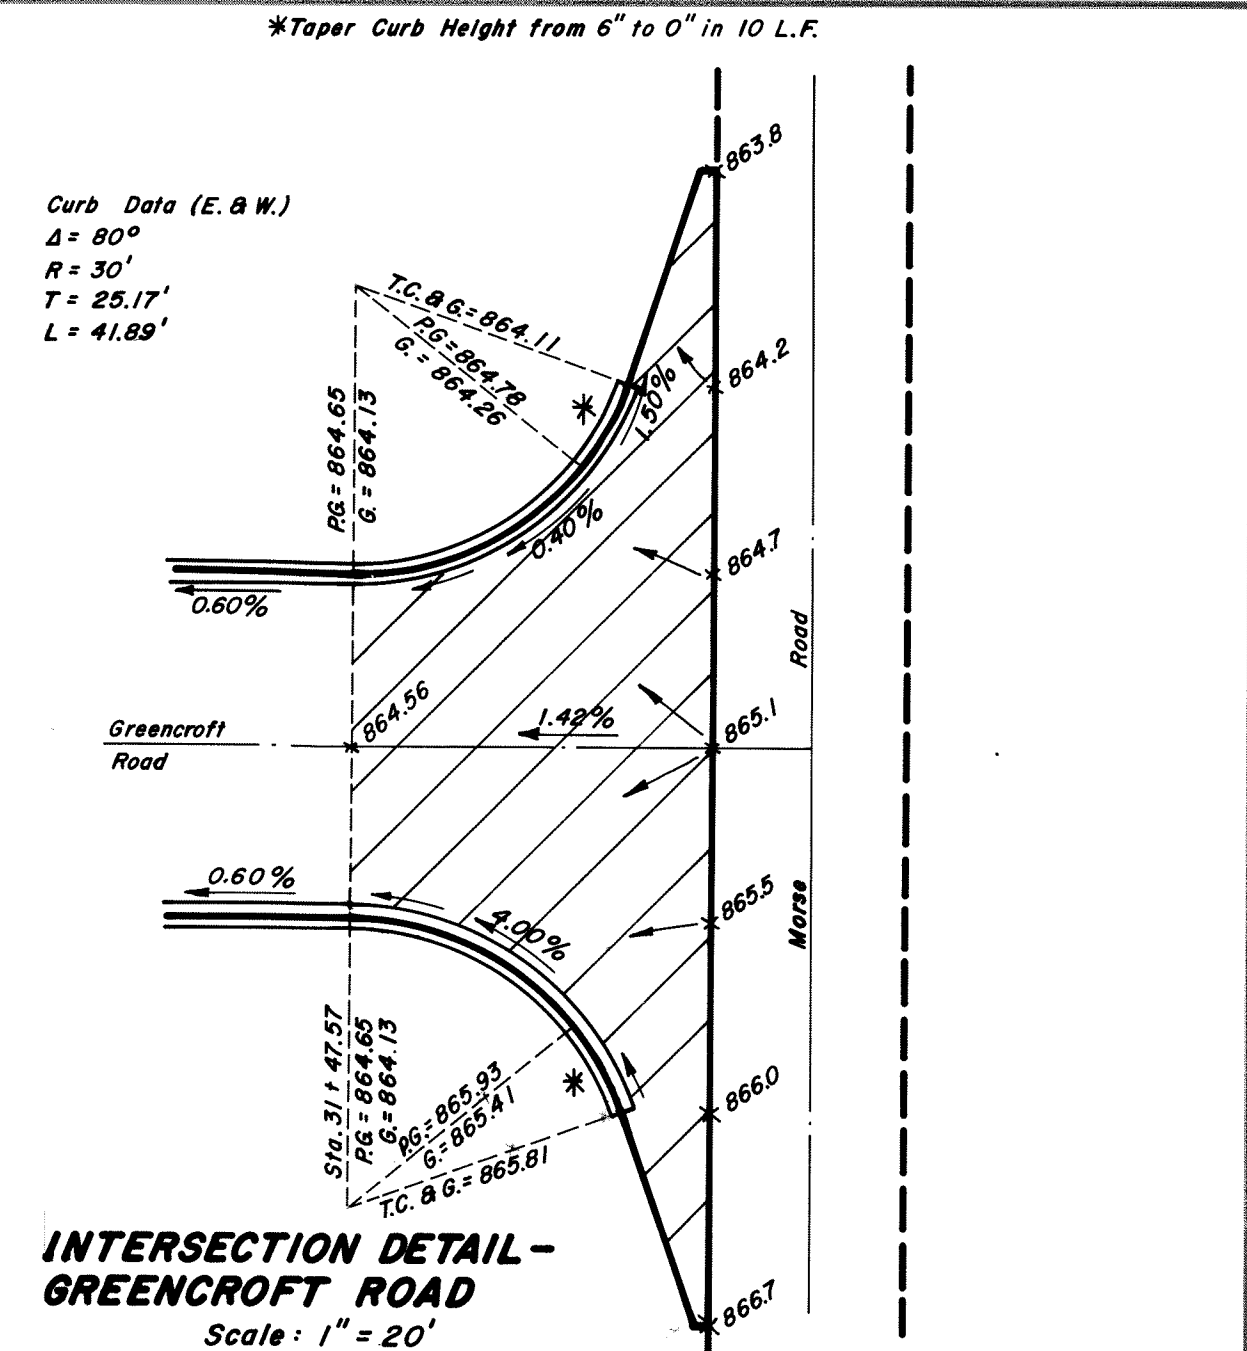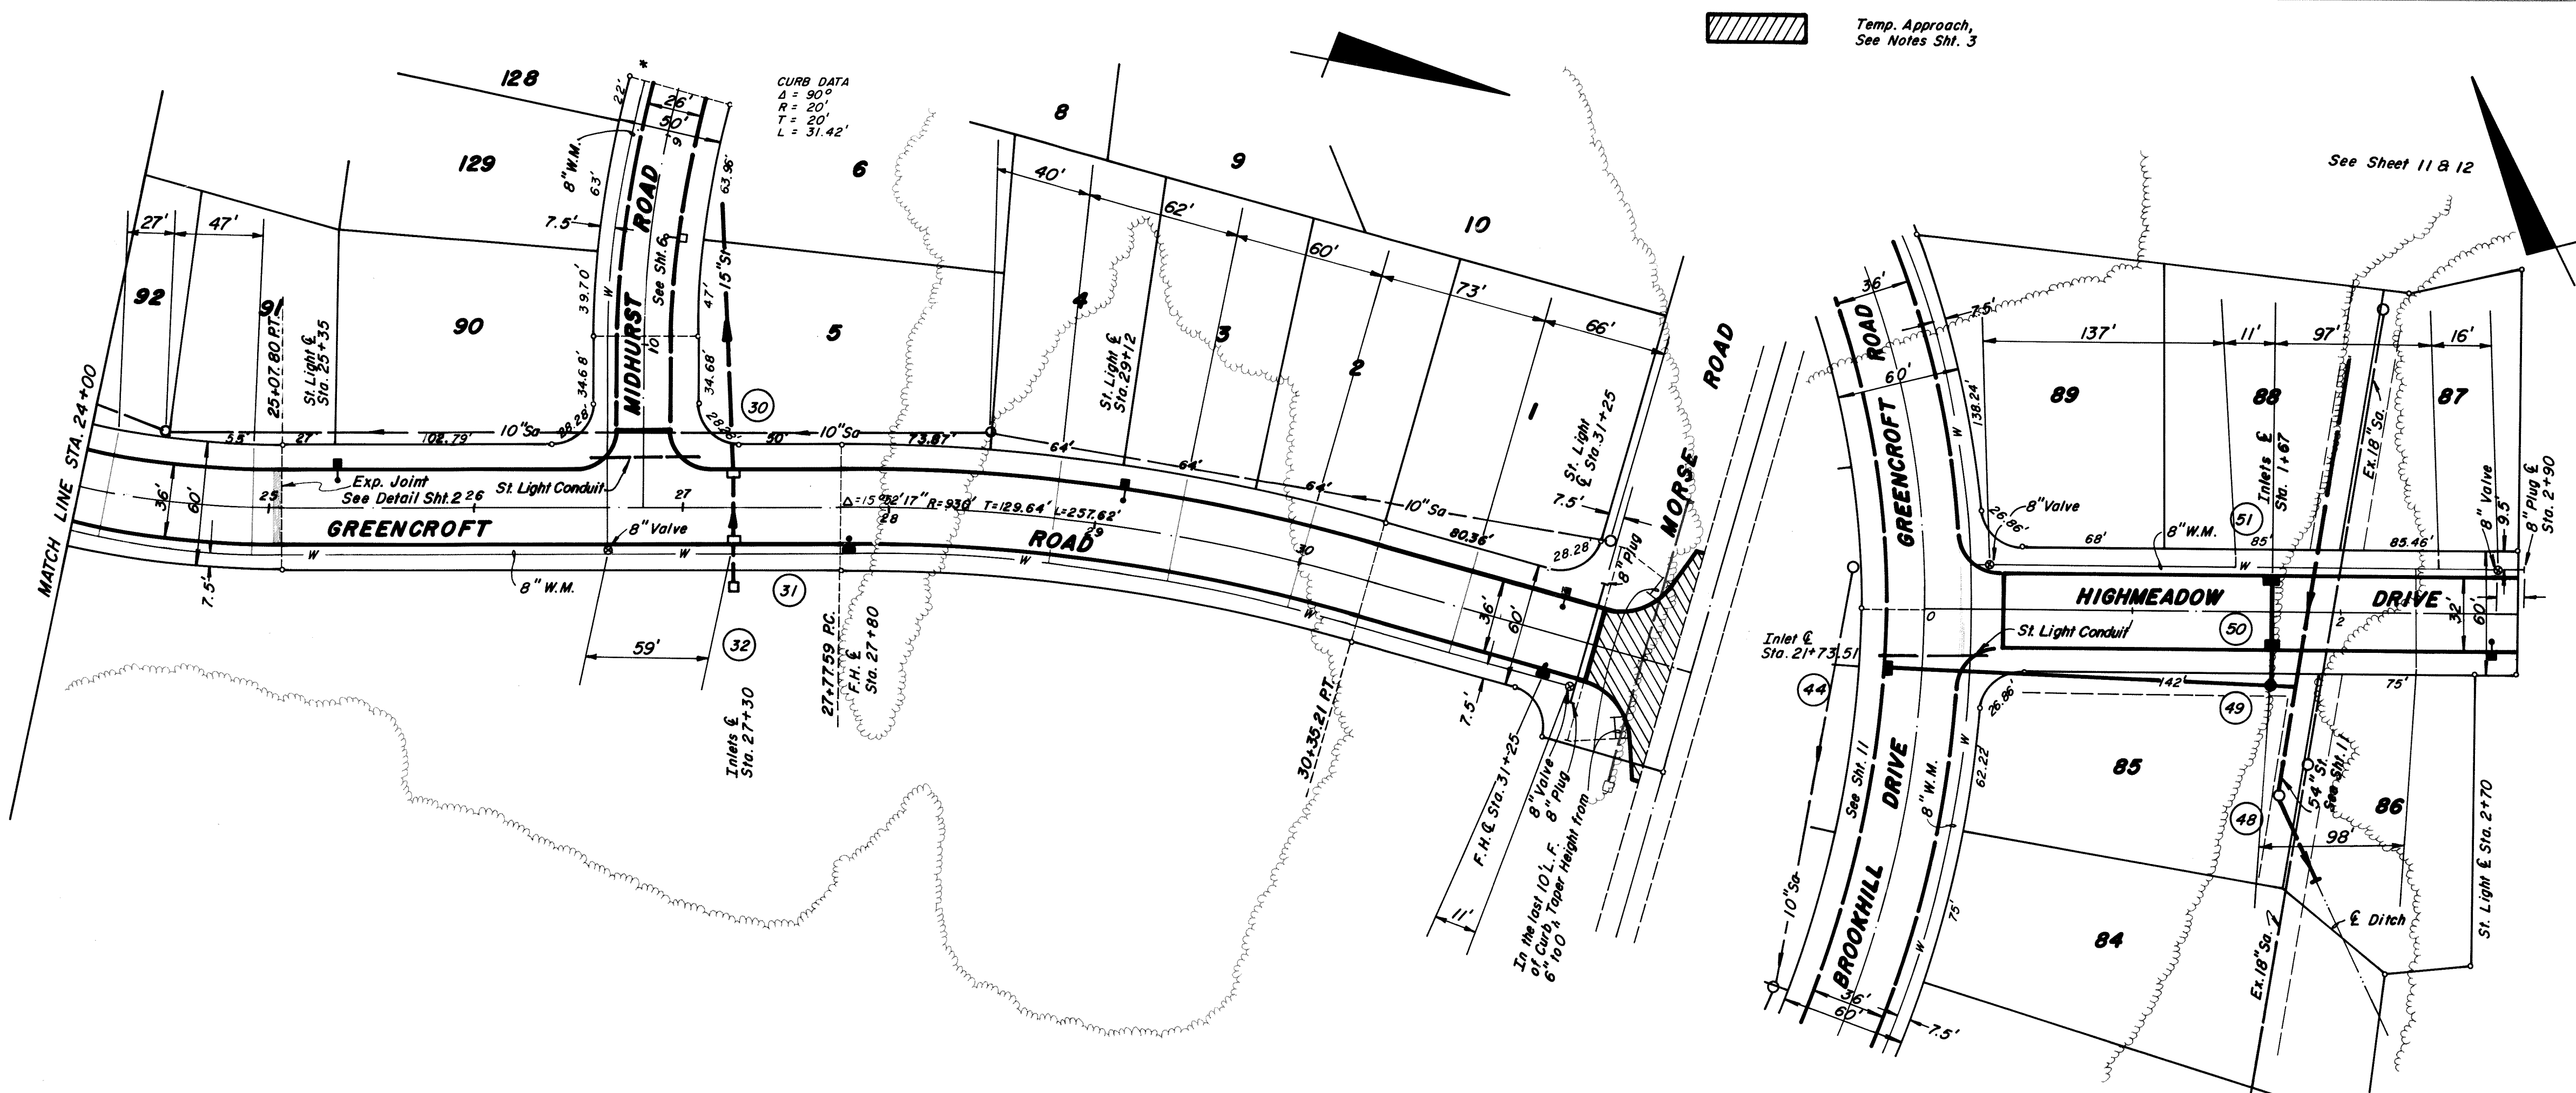

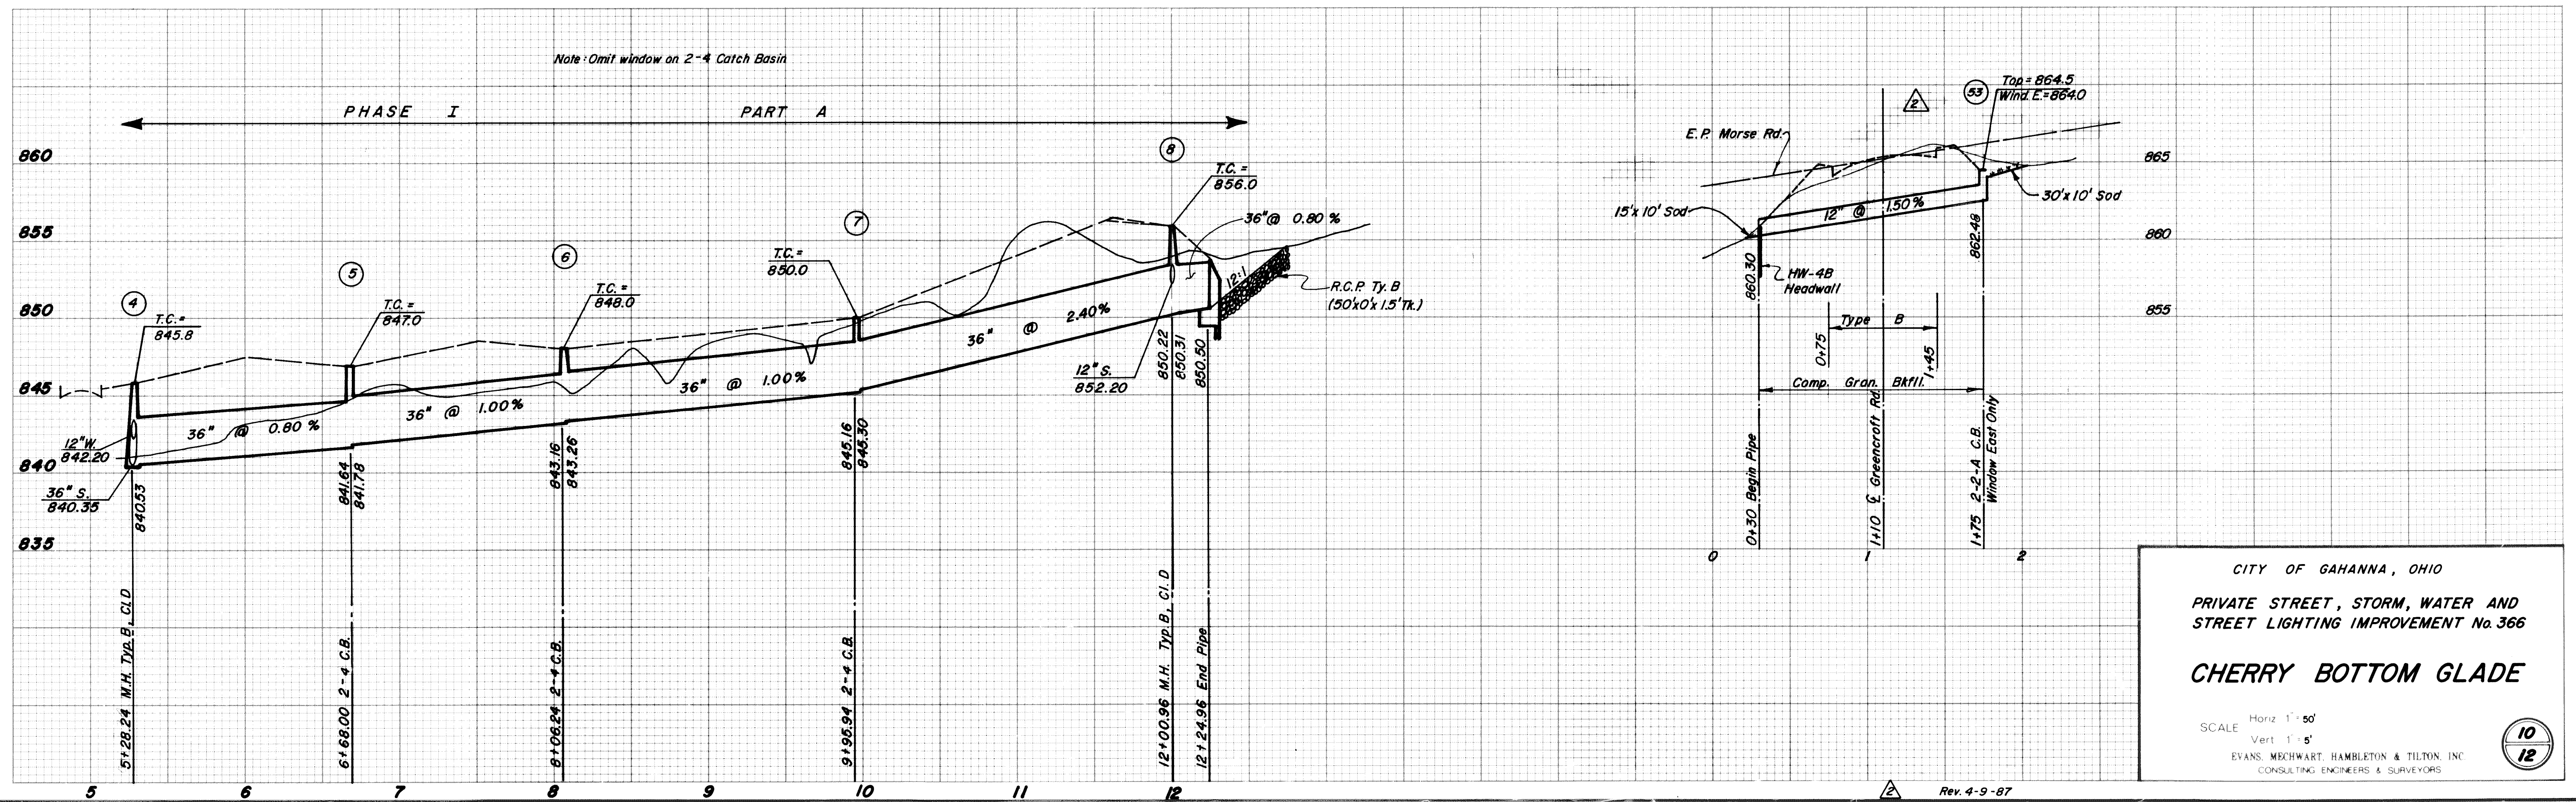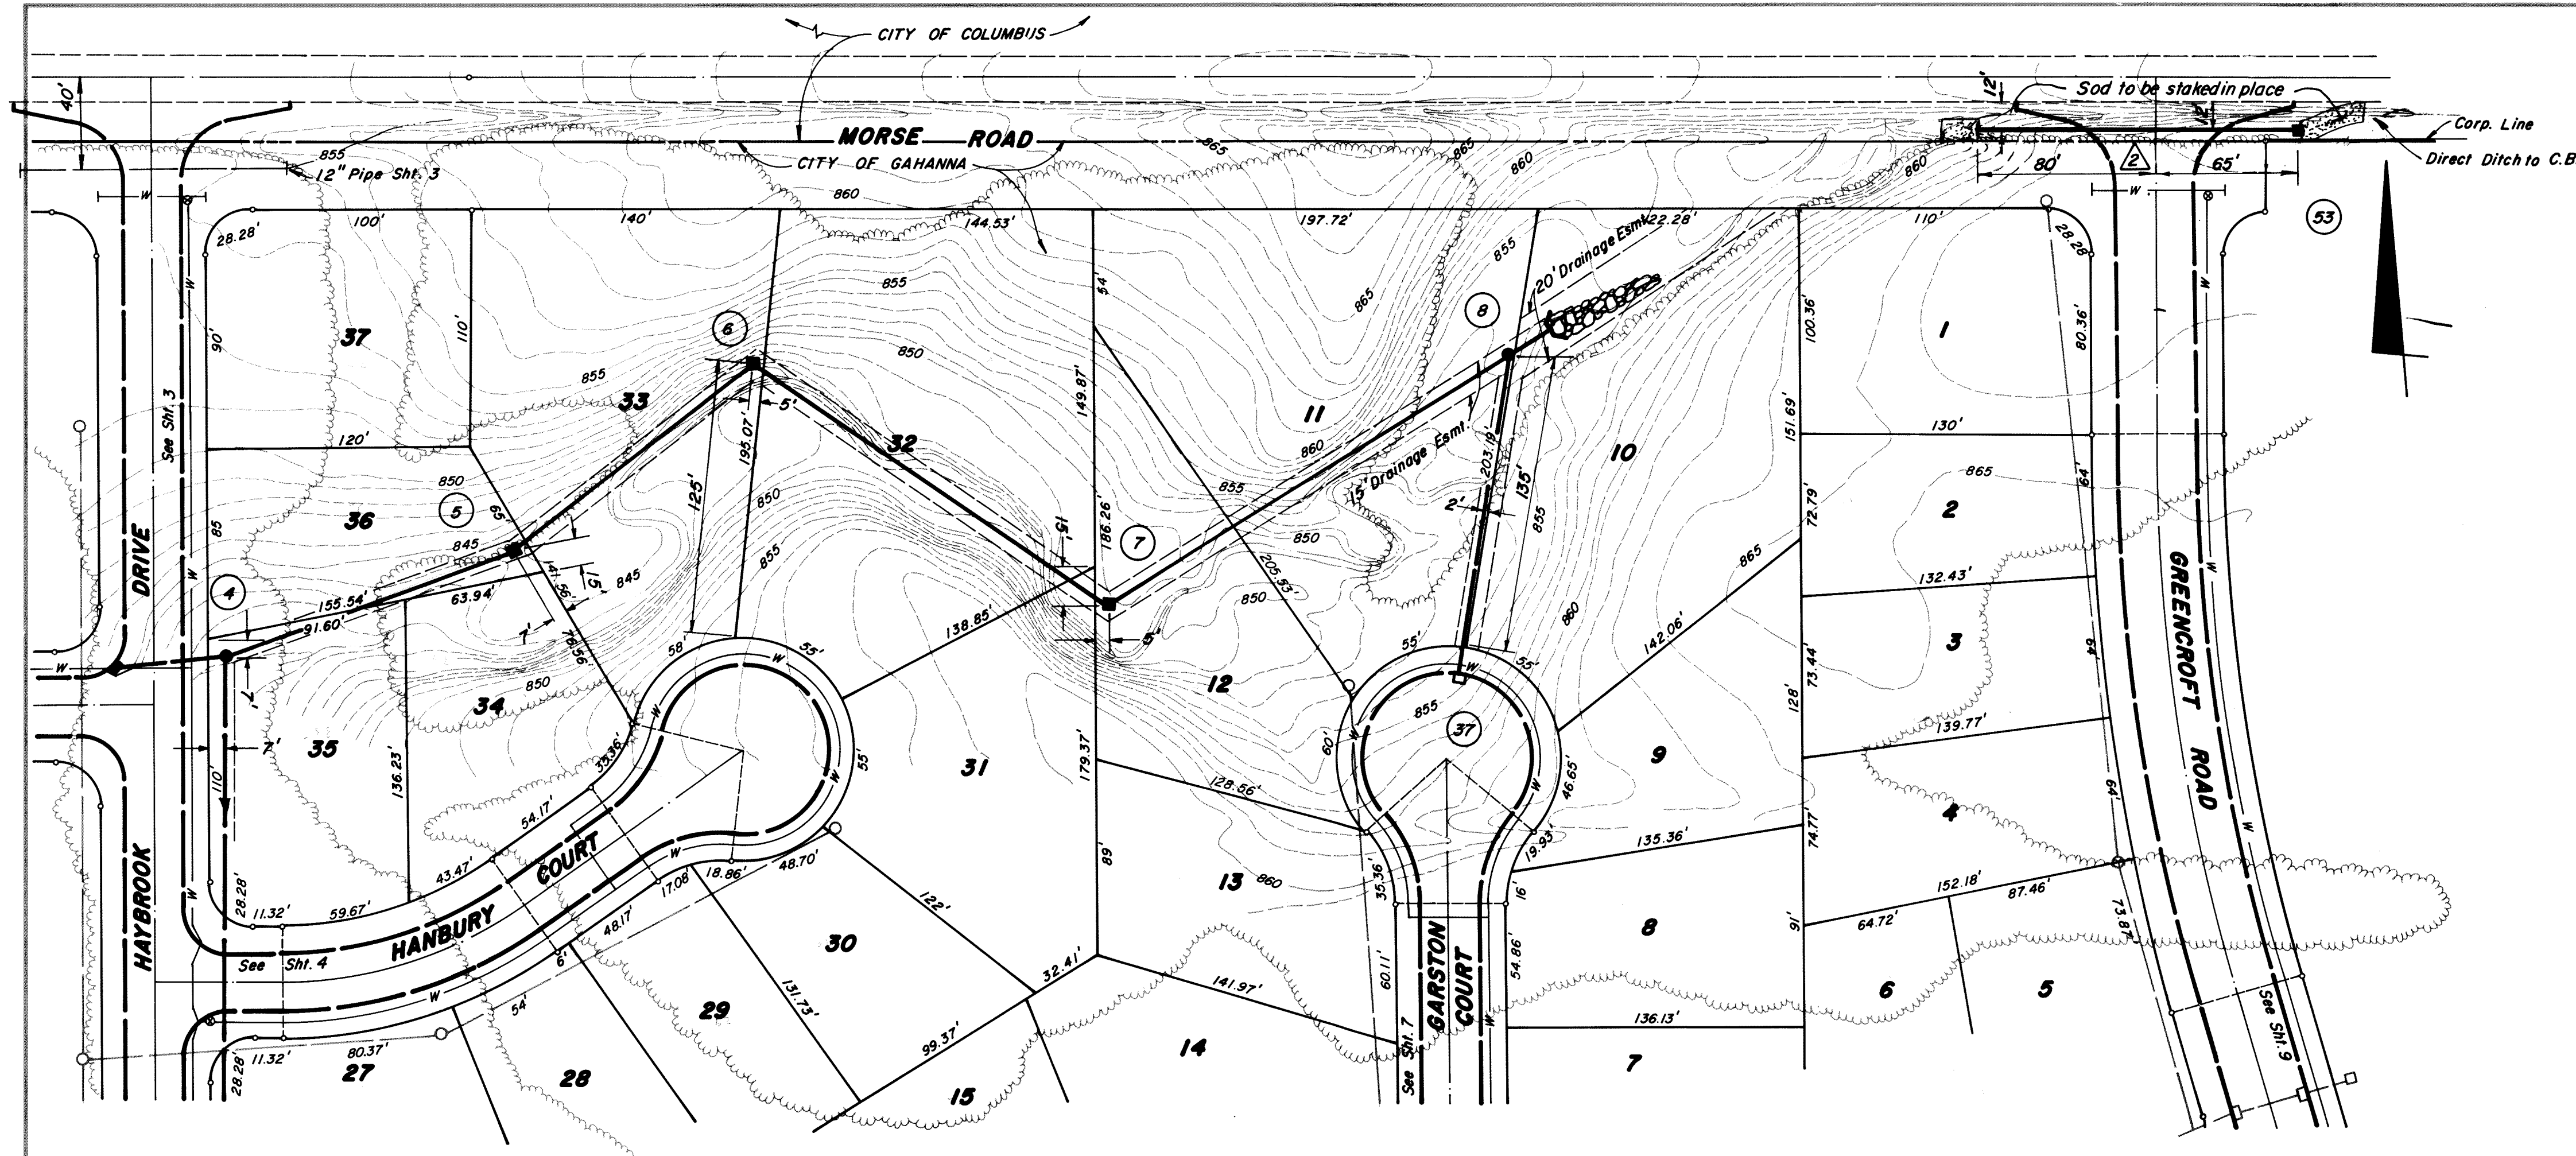

CITY OF GAHANNA, OHIO
 PRIVATE STREET, STORM, WATER AND
 STREET LIGHTING IMPROVEMENT No. 366
CHERRY BOTTOM GLADE
 SCALE Horiz 1" = 50'
 Vert 1" = 5'
 EVANS, MECHWART, HAMBLETON & TILTON, INC.
 CONSULTING ENGINEERS & SURVEYORS

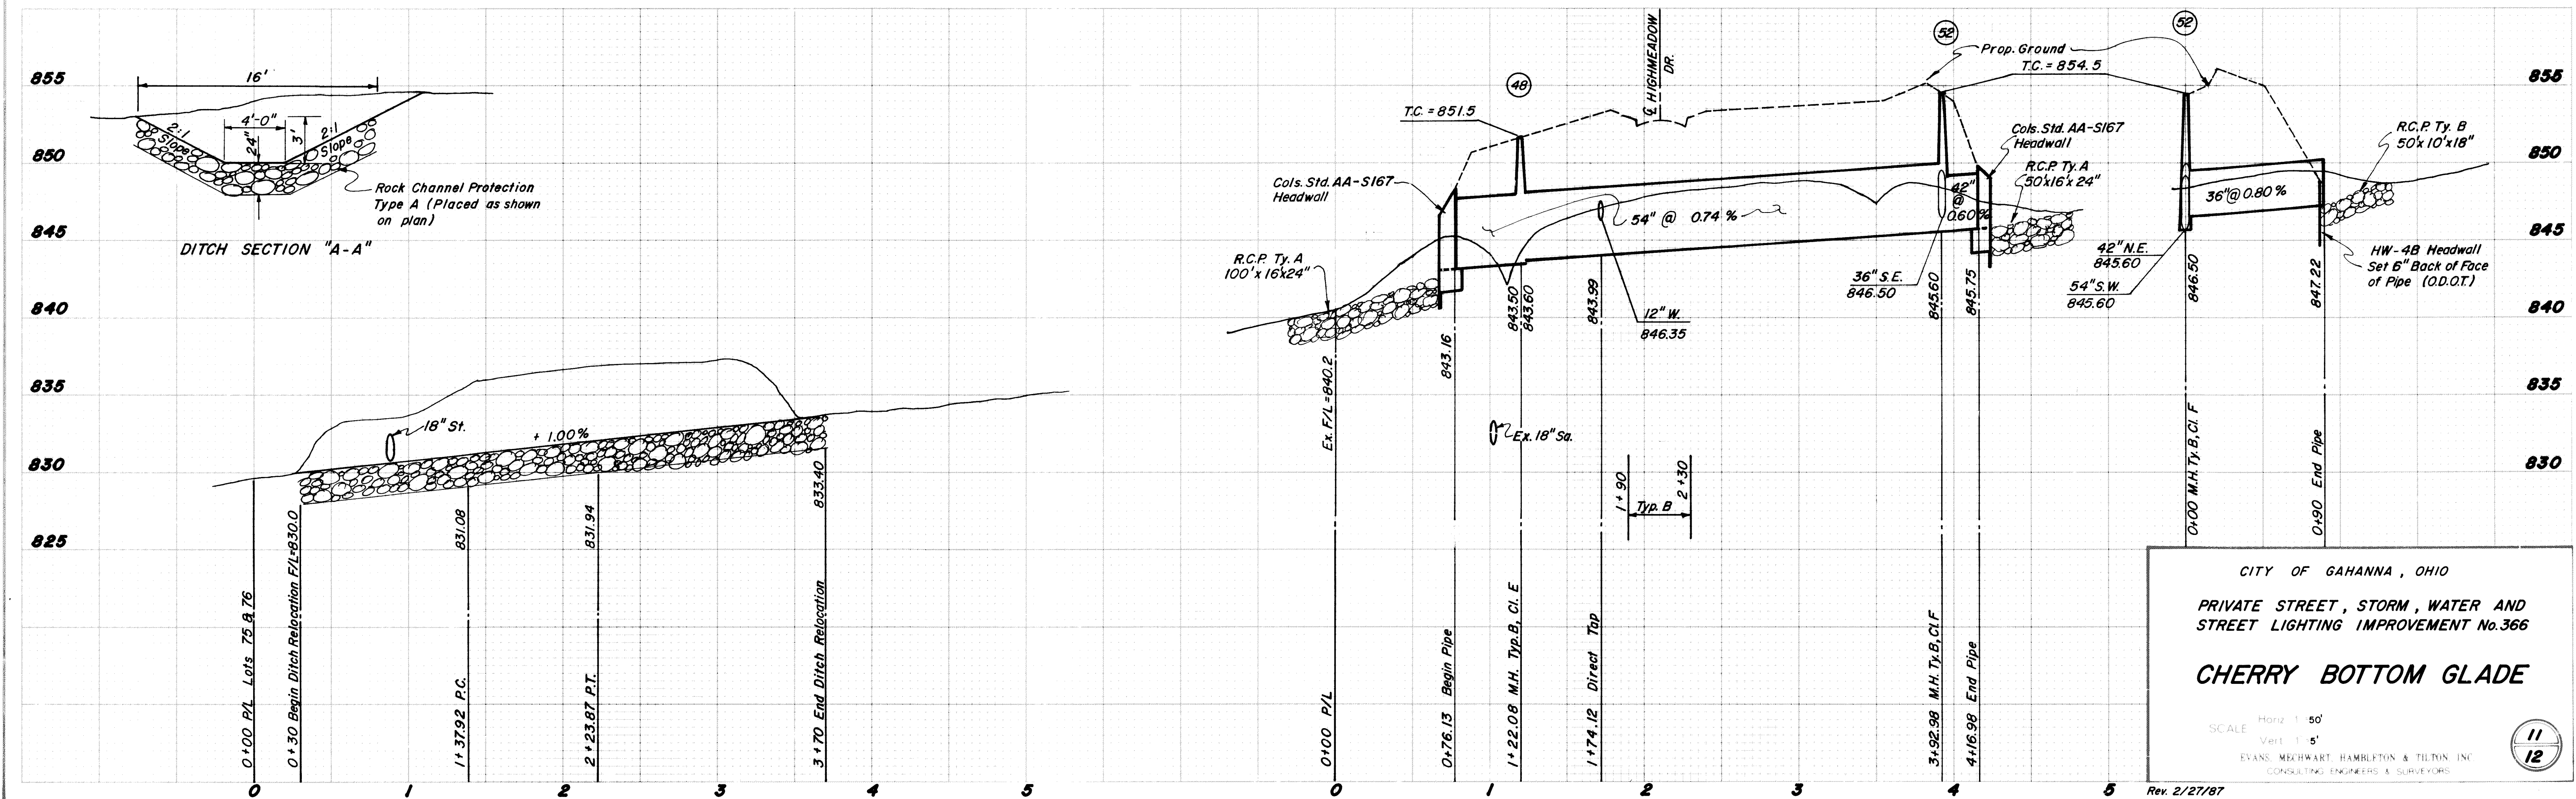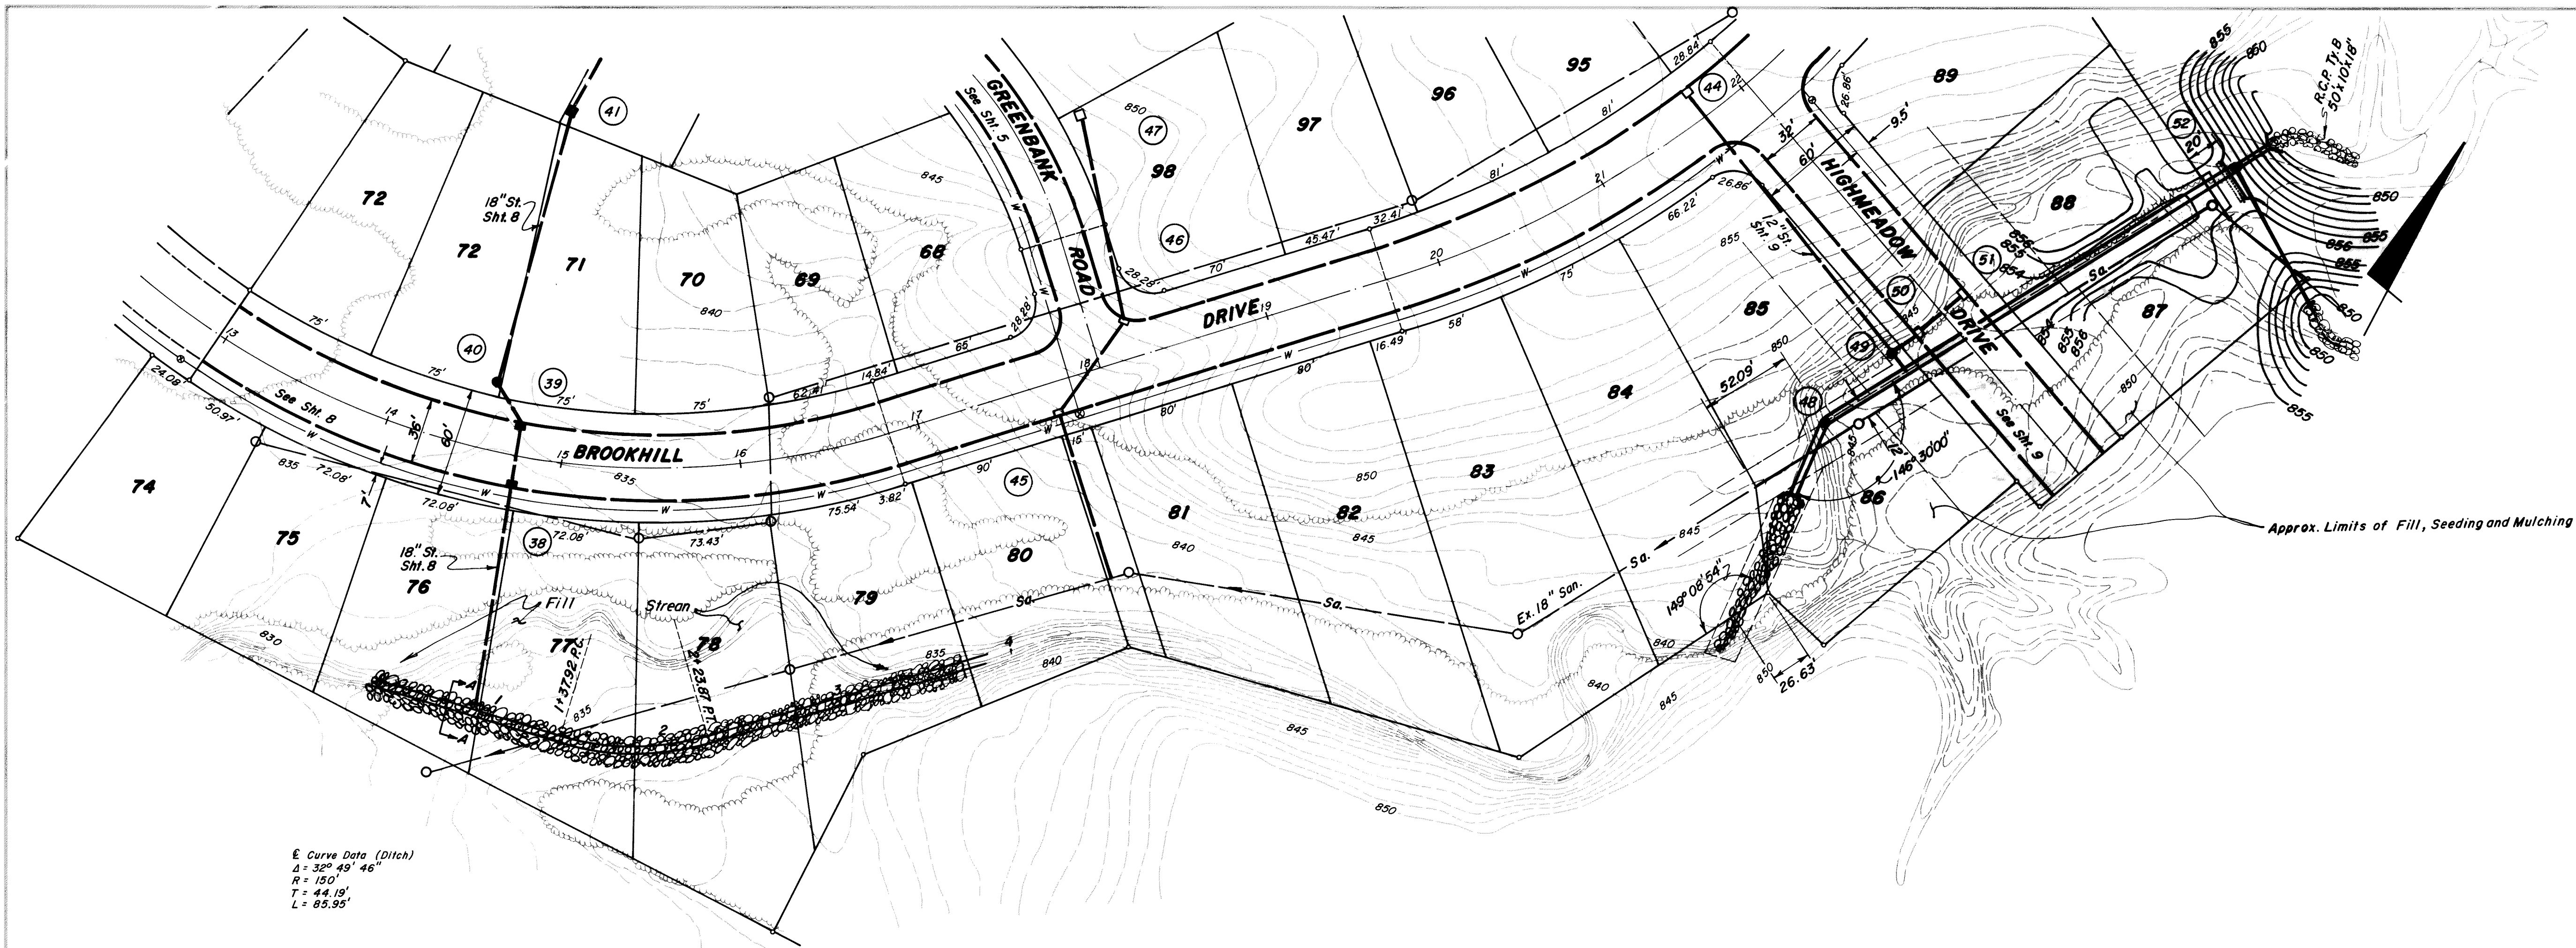

CITY OF GAHANNA, OHIO

PRIVATE STREET, STORM, WATER AND STREET LIGHTING IMPROVEMENT No.366



CHERRY BOTTOM GLADE

SCALE Horiz 1" = 50'
Vert 1" = 5'

EVANS, MECHWART, HAMBLETON & TILTON, INC.
CONSULTING ENGINEERS & SURVEYORS

Rev. 2/27/87

11
12

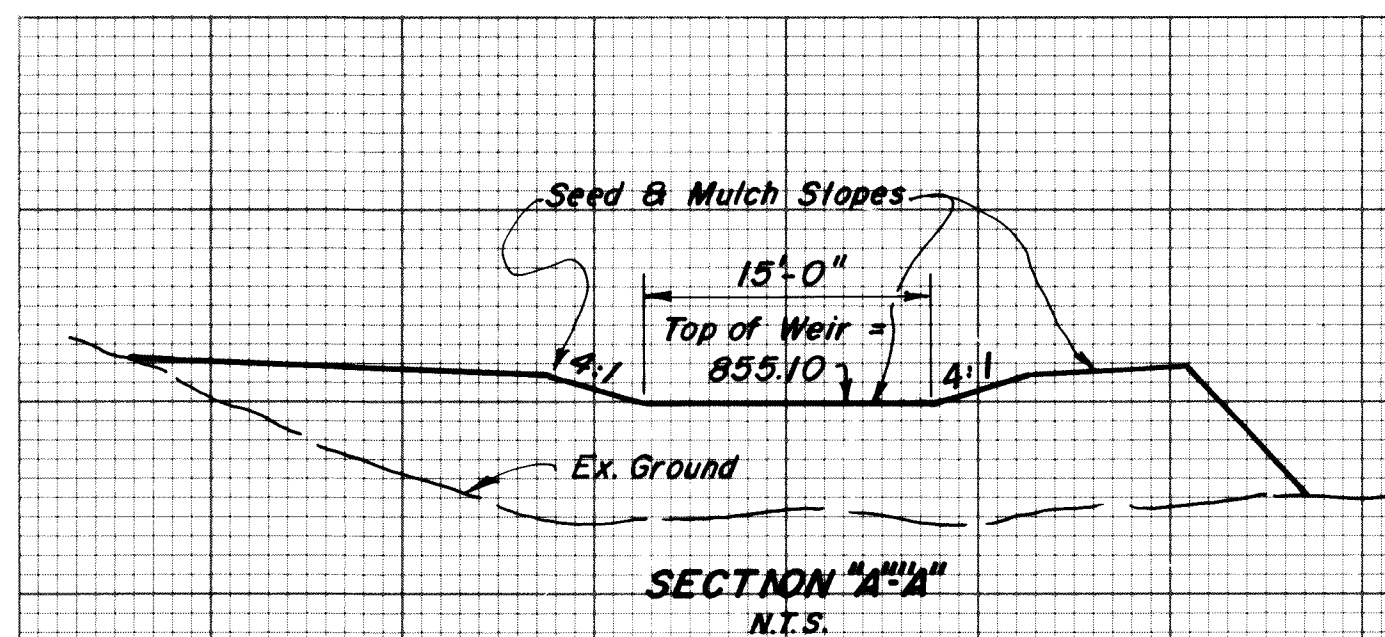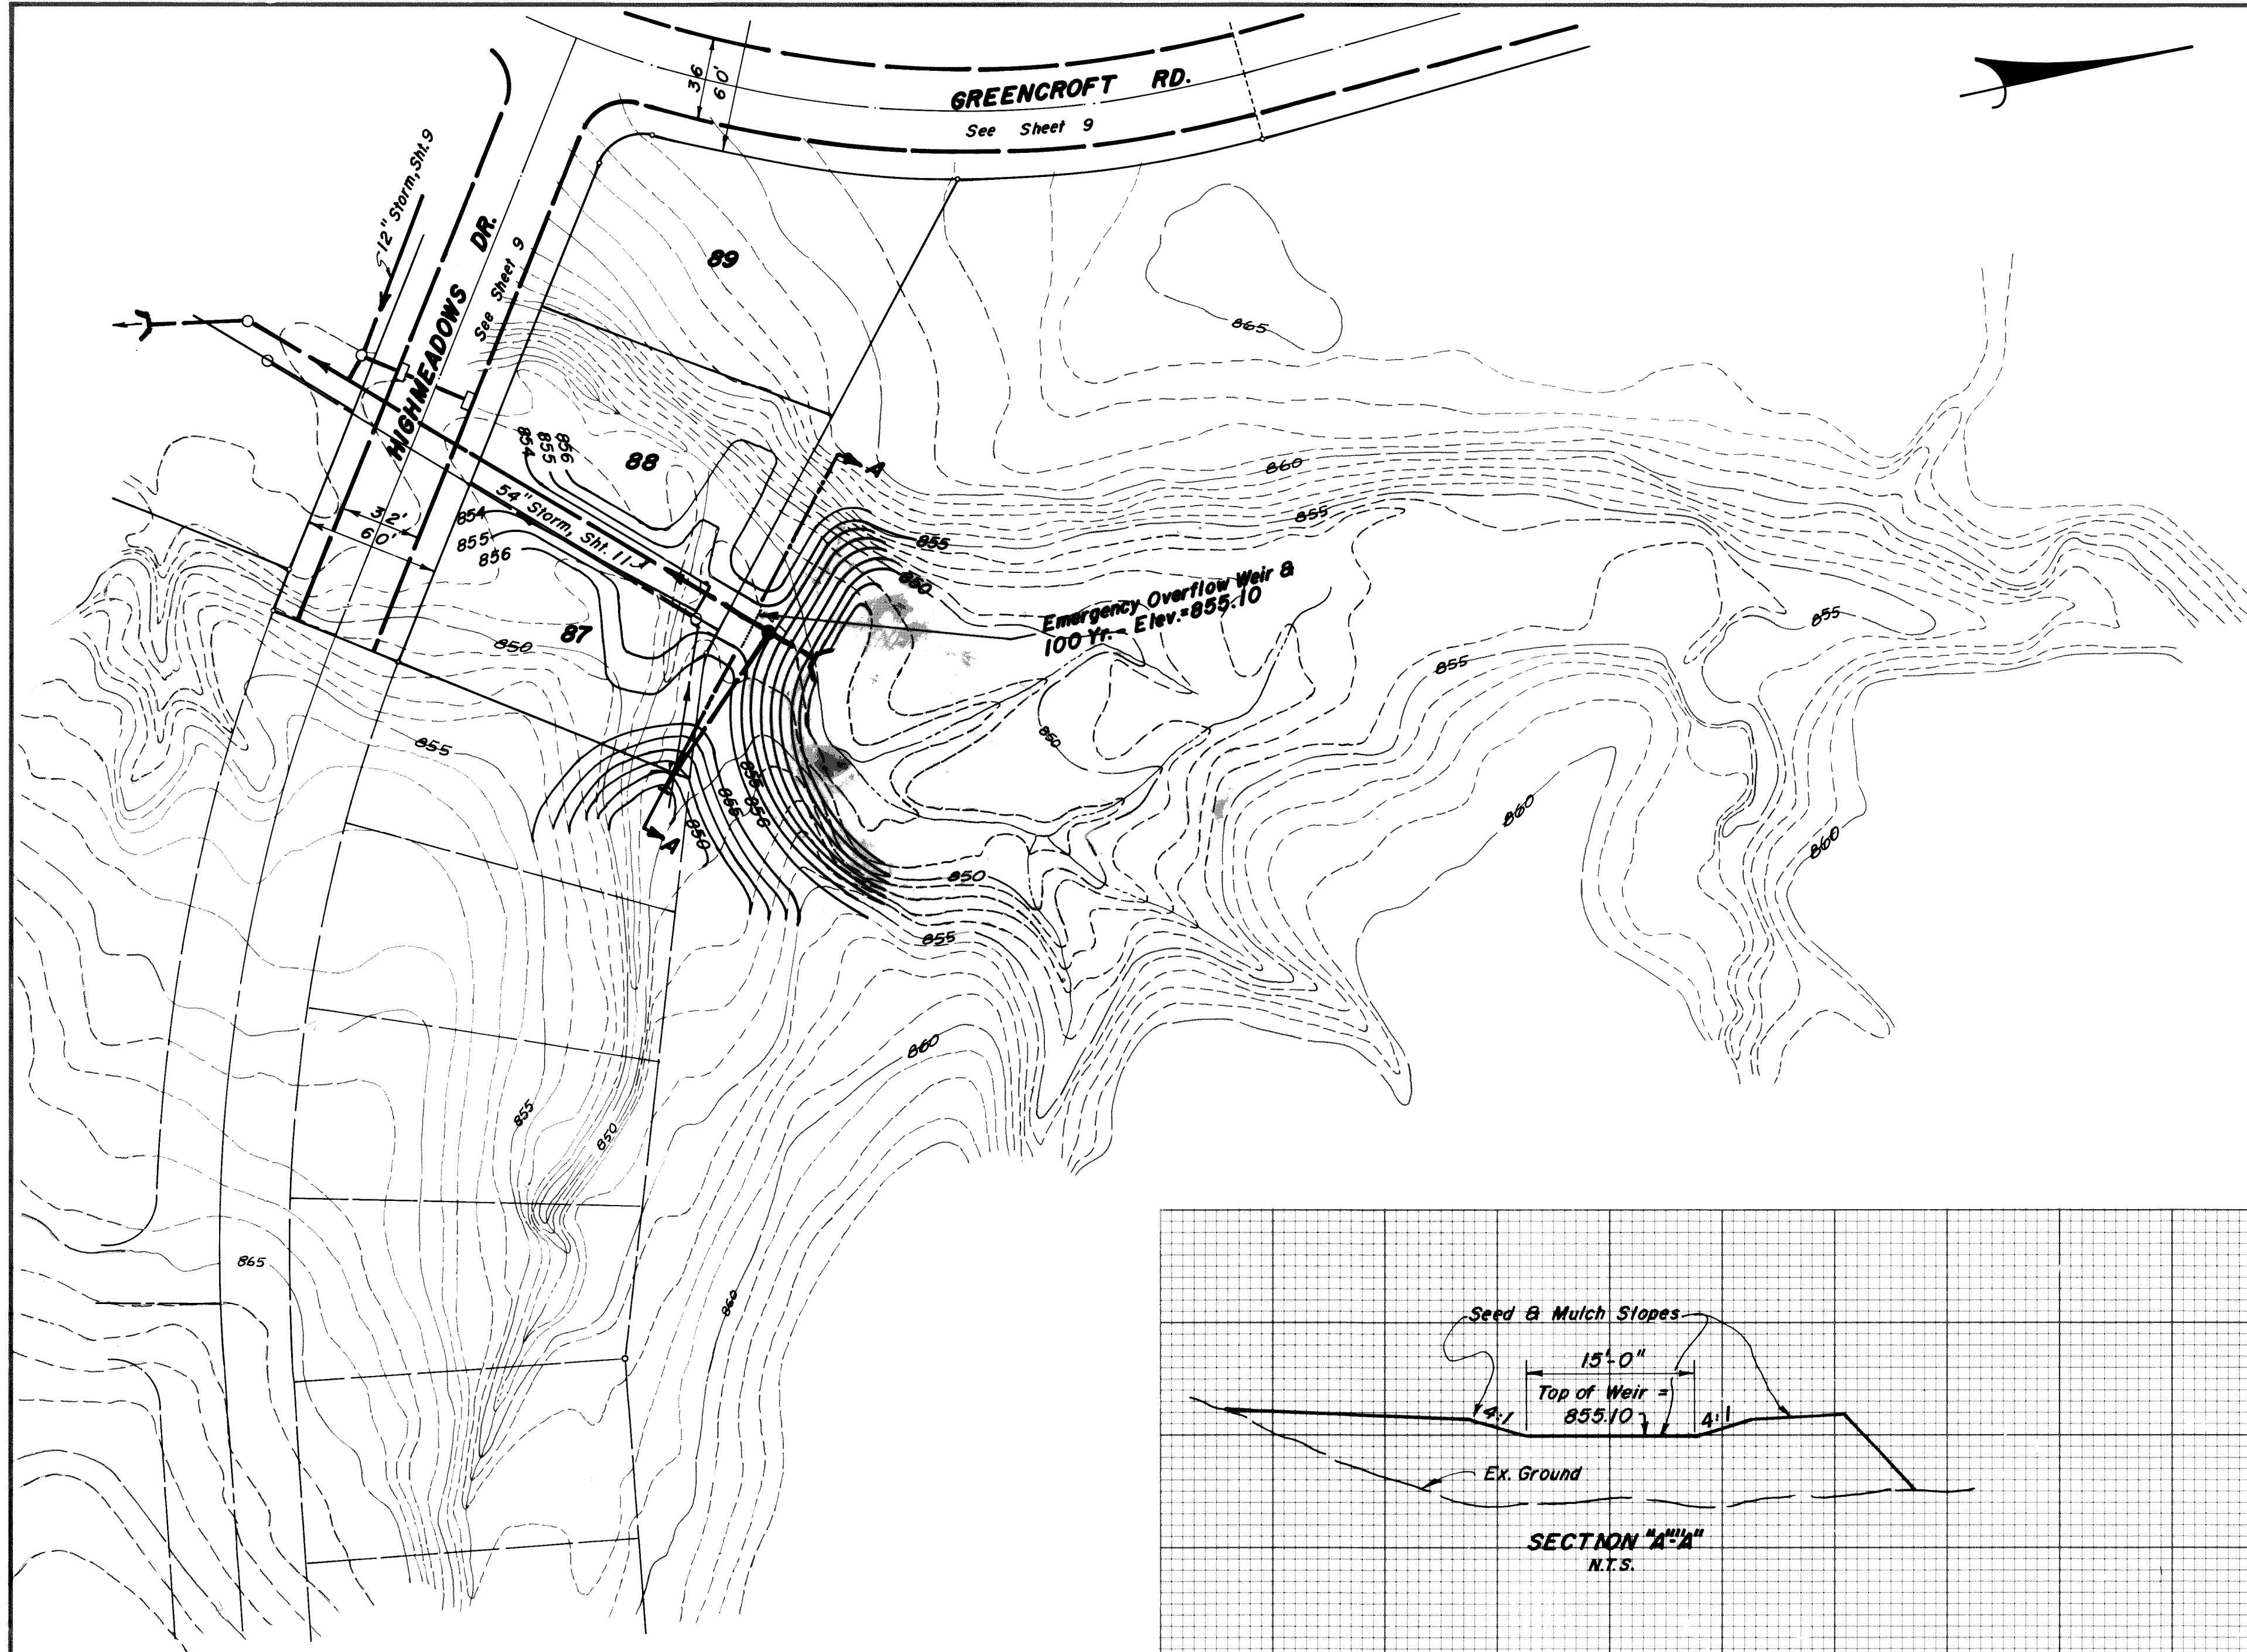

CITY OF GAHANNA, OHIO
PRIVATE STREET, STORM, WATER AND
STREET LIGHTING IMPROVEMENT #366
CHERRY BOTTOM GLADE

SCALE Horiz 1" = 50'
Vert 1" = 5'

EVANS, MECHWART, HAMBLETON & TILTON, INC.
CONSULTING ENGINEERS & SURVEYORS



Rev. 2/27/87

STREET, STORM, WATER AND
LIGHTING IMPROVEMENT NO. 382
HIGH MEADOWS OF GAHANNA
SECTION 2

CITY OF GAHANNA, OHIO

1987

GENERAL NOTES

SPECIFICATION: The requirements of the City of Gahanna, together with the Standard Specifications of the State of Ohio, Department of Transportation, including all supplements thereto in force on date of contract shall govern all materials and workmanship involved in the improvements shown on these plans except as such specifications are modified by the following specifications or by the construction details set forth herein.

STANDARD CONSTRUCTION DRAWINGS: All pertinent Standard Construction Drawings are available upon request at the office of the City Engineer.

PERMITS: The Contractor shall obtain all necessary permits.

SAFETY REQUIREMENTS: The Contractor and Sub-Contractor shall be solely responsible for all federal, state and local safety requirements, together with exercising precautions at all times for the protection of persons (including employees) and property. It is also the sole responsibility of the Contractor and Sub-Contractor to initiate, maintain and supervise all safety requirements, precautions and programs in connection with this work.

MISCELLANEOUS WORK: All items of work called for on the plans for which no specific method of payment is provided shall be performed by the Contractor and the cost of same shall be included in the price for the various related items.

FIELD TILE: All field tile broken during excavation shall be replaced to its original condition or connected to either the curb subdrain or to the storm sewer system as directed by the Engineer.

SURPLUS EXCAVATION: The Contractor shall dispose of all surplus street excavation on the project site where and as directed by the Owner.

UNAUTHORIZED STREET EXCAVATION: In the event excavation for the street is from 0" to 6" below that called for on the plans, the Contractor shall replace this excess excavated material with compacted 46D crushed aggregate as directed and at no extra cost to the owner.

STORM SEWERS: Unless otherwise noted on the plans all Storm Sewers shall be as hereafter specified; (1) All sizes of storm sewer located within or across proposed or existing pavement areas shall be Type B Conduit, 706.02, with Class B Bedding; (2) Storm Sewer located outside pavement areas shall be Type E Conduit, 706.01, Class C Bedding, for 15 inch and smaller, and shall be Type E Conduit, 706.02, Class C Bedding, for 18 inch and larger. The following modifications to Ohio Department of Transportation Specifications shall apply: (1) Type E Conduits shall have sealed joints; (2) Granular backfill material shall be compacted granular material, Item 310-A placed within limits shown on the plan including around all inlet structures. Granular backfill shall extend from the bottom of the trench to a plane 6 inches below the subgrade.

CURB INLETS: All curb inlets shall be channeled as directed.

ROOF DRAIN OPENINGS: The Contractor shall provide two roof drain openings in the curb for each lot, each opening located not more than 4 feet in from each lot line.

STREET LIGHTING: Standard Electrical Specifications and Standard Construction Drawings, covering Street Lighting for the City of Gahanna, Ohio, shall apply.

EXPANSION JOINTS: It shall be the responsibility of the Contractor to adequately barricade the street in the vicinity of all expansion joints, until such time as the street is open to traffic.

WATER MAINS: All water mains shall be either Ductile Iron Class 53 (4" through 10"), Class 54 (12" and larger), or Polyvinyl Chloride, Class 150. All bends, joint deflections and fittings shall be backed with concrete where and as directed. Where water mains or services cross proposed or existing streets, backfill shall be compacted granular material, Item 310-A, within limits 5 feet outside the edge of pavement or curb extended from the bottom of the trench to a plane 6 inches below the subgrade. The services may be jacked across the street in lieu of open cut and the use of granular backfill.

CURB BOXES: Curb boxes shall be located one-half foot from the property line unless otherwise shown on the plans or ordered by the Engineer.

CHLORINATION OF WATER MAINS: The Contractor shall make arrangements to have the water mains chlorinated by the City of Columbus. The cost of chlorination shall be included in the price bid for the various water main items.

EXISTING UTILITIES: The identity and location of the existing underground utility facilities known to be located in the construction area have been shown on the plans as accurately as provided by the Owner of the underground utility. The City of Gahanna and/or Engineer assumes no responsibility as to the accuracy or the depths of the underground facilities shown on the plans.

Support, protection and restoration of all existing utilities and appurtenances shall be the responsibility of the Contractor. The cost of this work shall be included in the price bid for the various items.

The Contractor shall cause notice to be given to the Ohio Utilities Protection Service (telephone 800-362-2764 - toll free) and to the Owners of underground utility facilities shown on the plans who are not members of a registered underground protection service in accordance with Section 153.64 of the Revised Code. The above mentioned notice shall be given at least 48 hours prior to start of construction.

The Owner/Developer shall provide a Soils Engineer, registered in the State of Ohio, for the purpose of inspecting and certifying to the City of Gahanna, acceptable soil bearing conditions prior to placement of improvements within the right-of-way and easements in accordance with the appropriate O.D.O.T. specifications.

All site clearing (tree removal) shall be performed by the Owner at his expense prior to construction of this project.

BENCH MARKS


Franklin County BM#A-24 South End of Headwall on East Side Stygler Rd. 300'± North of McCutcheon Rd. Elev. = 822.52

North Bolt Fire Hydrant East Side Stygler Rd. at Res. #960 100'± South of Ridenour Road Elev. = 841.18


Spk. West Side 36" Oak East Side of Stygler Rd. 300'± North of Ridenour Road. Elev. = 837.50

PHASE I	PHASE II		ESTIMATE OF QUANTITIES	
ITEM	QUAN.	UNIT	DESCRIPTION	
2,100	203	1,980	Cu. Yds.	Excavation, Including Embankment Construction
5,255	305	3,005	Sq. Yds.	7" Portland Cement Concrete Base
185	402	105	Cu. Yds.	Asphalt Concrete
190	404	110	Cu. Yds.	Asphalt Concrete
530	407	300	Gals.	Bituminous Tack Coat
3,570	605	2,305	Lin. Ft.	4" Shallow Pipe Underdrain
1,030	609	1,395	Lin. Ft.	Concrete Combination Curb & Gutter *
2,440	609	910	Lin. Ft.	Concrete Mountable Curb *
800	603	685	Lin. Ft.	12" Conduit, Type E, 706.02
65	603	75	Lin. Ft.	12" Conduit, Type B, 706.02 Class 4
310	603	175	Lin. Ft.	15" Conduit, Type E, 706.01
40	603	25	Lin. Ft.	15" Conduit, Type B, 706.02
40	603		Lin. Ft.	18" Conduit, Type E, 706.02
375	603		Lin. Ft.	21" Conduit, Type E, 706.02
295	603		Lin. Ft.	24" Conduit, Type E, 706.02
30	603		Lin. Ft.	27" Conduit, Type B, 706.02
95	603		Lin. Ft.	27" Conduit, Type E, 706.02
2	604		Each	Manhole Type A
5	604	5	Each	2 - 2 - B Catch Basin
3	604	3	Each	Curb and Gutter Inlet (Std. Curb) Cols. AA-S125, Top AA-S128
3	604	2	Each	Curb and Gutter Inlet (Mountable Curb) Cols. AA-S125, Top AA-S129

* Wheel Chair Curb drops to be included in the unit price bid for the above items (at intersection)
Concrete for Ramps shall be constructed at the time of sidewalk construction (by builders)

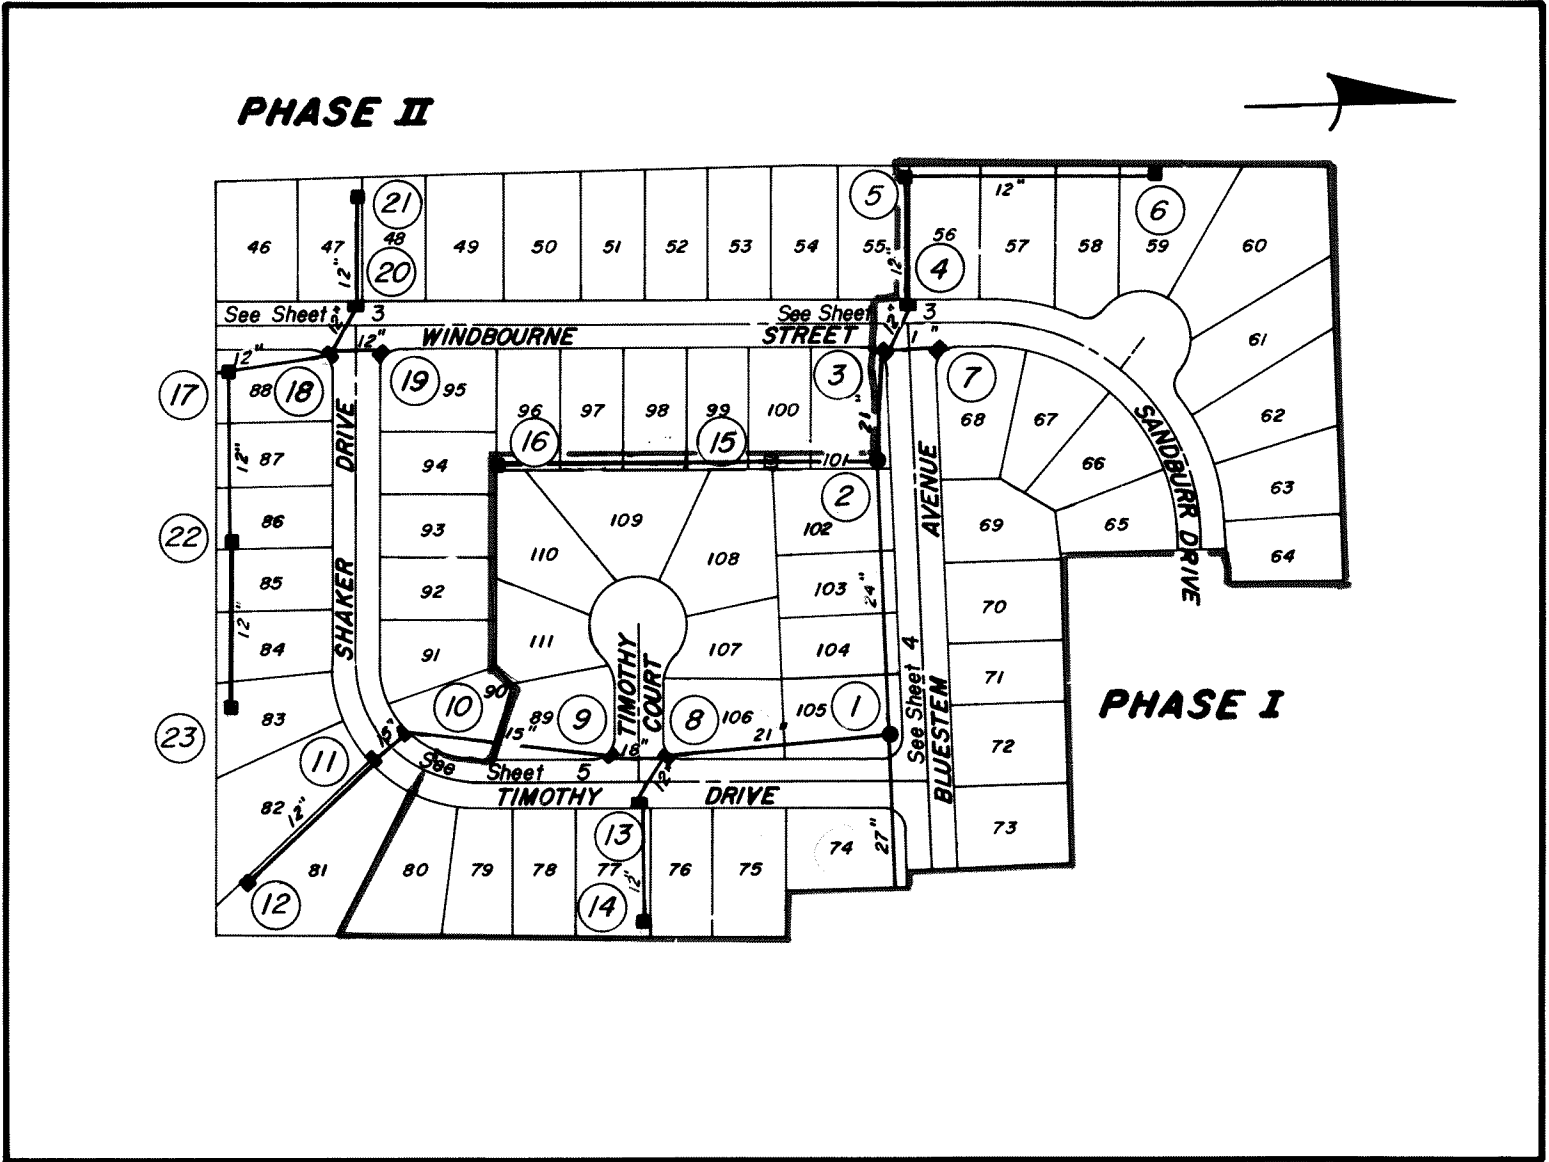

INDEX MAP
Scale : 1"= 200'

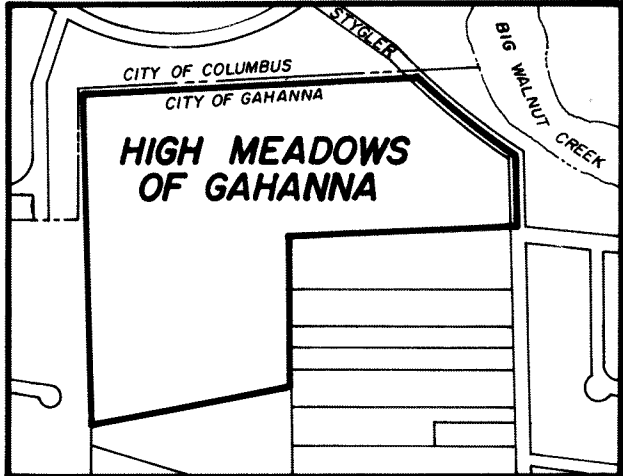

LOCATION MAP & BACKGROUND DRAWING

PREPARED BY
EVANS, MECHWART, HAMBLETON & TILTON, INC.

CONSULTING ENGINEERS & SURVEYORS

GAHANNA, OHIO

By David A. Hussey 8-21-87
Registered Engineer Date

Signatures below signify only concurrence with the general purpose of this project. All technical details are the responsibility of Evans, Mechwart, Hambleton & Tilton, Inc., Consulting Engineers and Surveyors.

David A. Hussey 8-21-87
City Engineer, City of Gahanna, Ohio Date

Robert J. Hambleton 9-10-87
Superintendent, Division of Water & Sewer, City of Gahanna, Ohio Date

Robert J. Hambleton 9-15-87
Superintendent, Division of Streets, City of Gahanna, Ohio Date


John F. Schuchman 9-11-87
Director of Public Service, City of Gahanna, Ohio Date

David A. Hussey 9-14-87
Director of Finance, City of Gahanna, Ohio Date


James F. McLean 9-15-87
Mayor, City of Gahanna, Ohio Date

BLUESTEM AVENUE
TIMOTHY DRIVE
TIMOTHY COURT
SHAKER DRIVE

TYPICAL 26' SECTION (50' R/W)



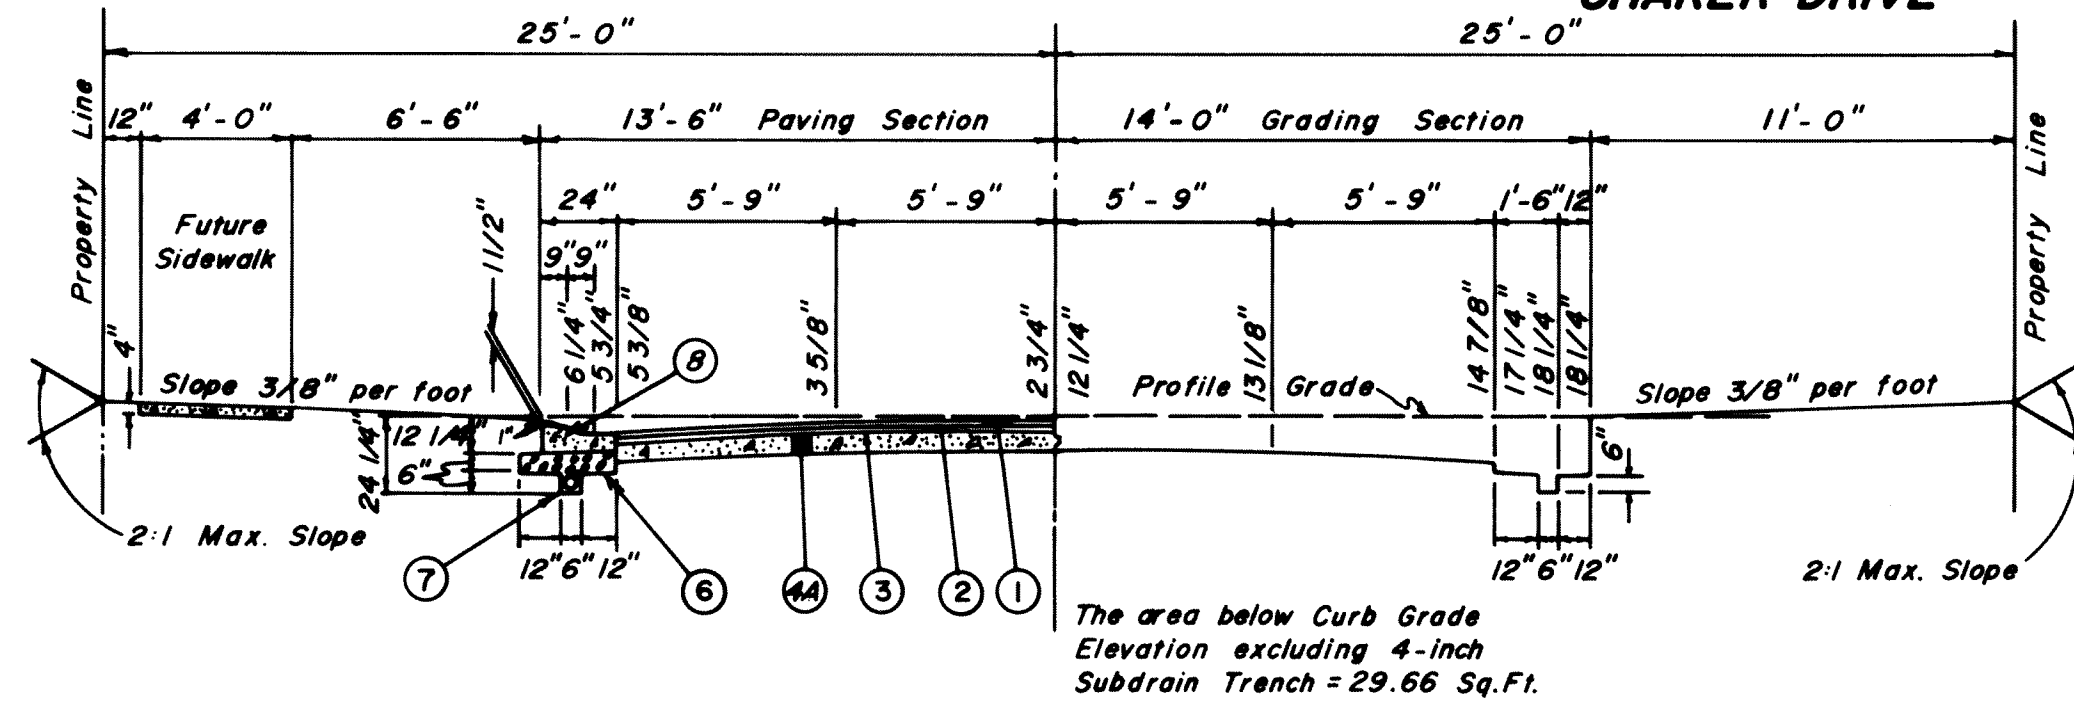


TYPICAL 36' SECTION (60' R/W)

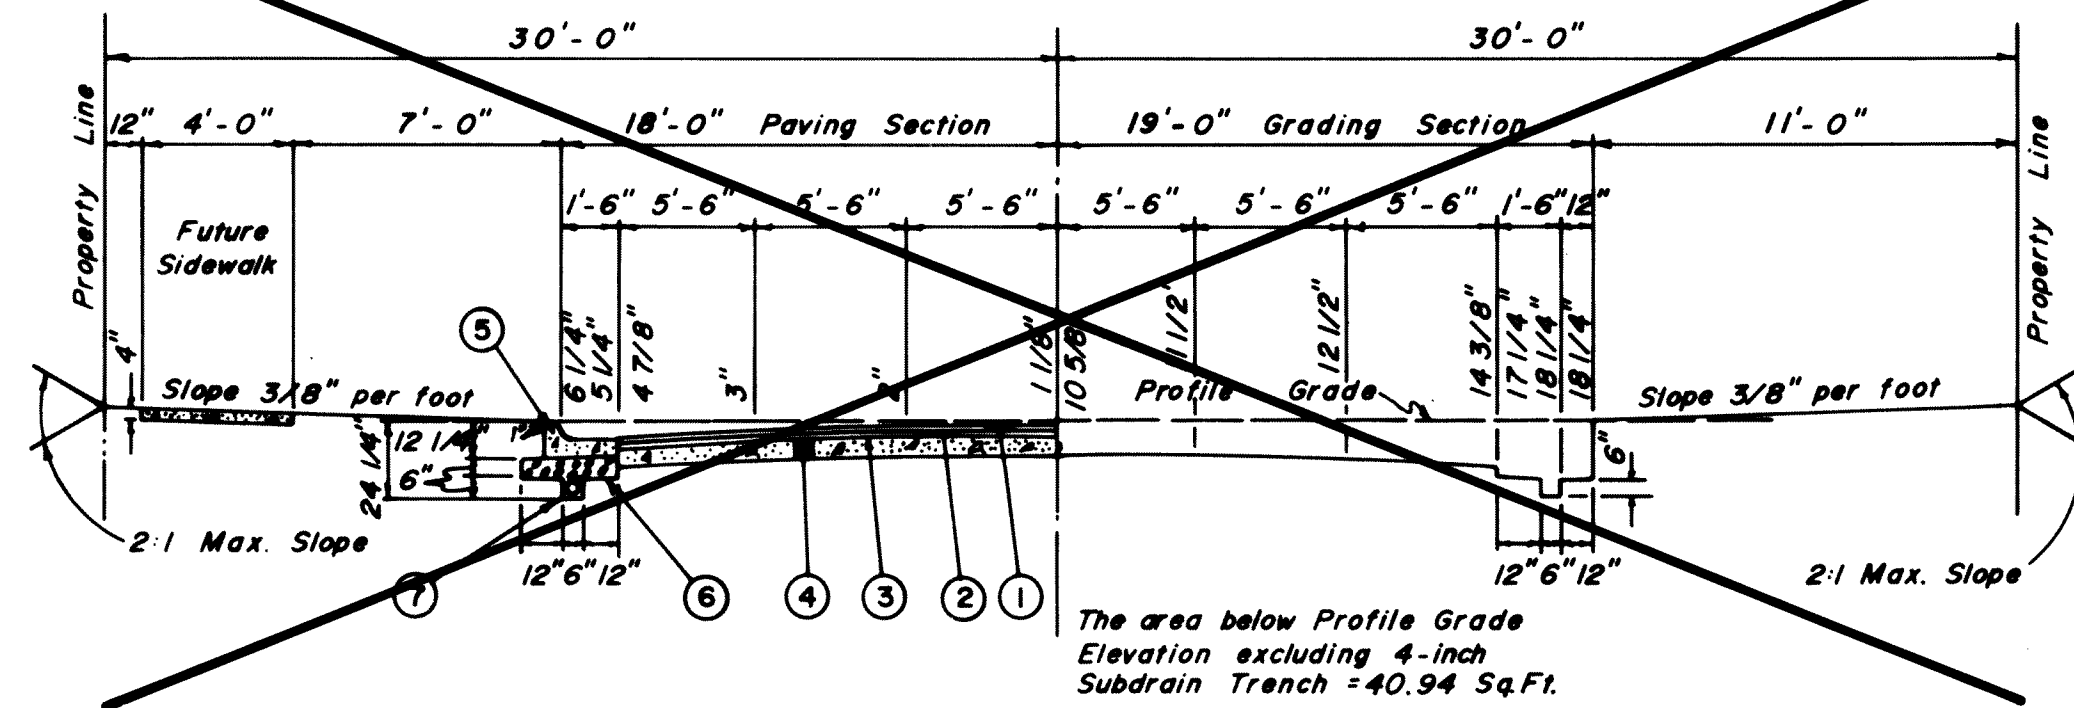


TYPICAL 26' SECTION (50' R/W)

SANDBURR DRIVE
WINDBOURNE STREET

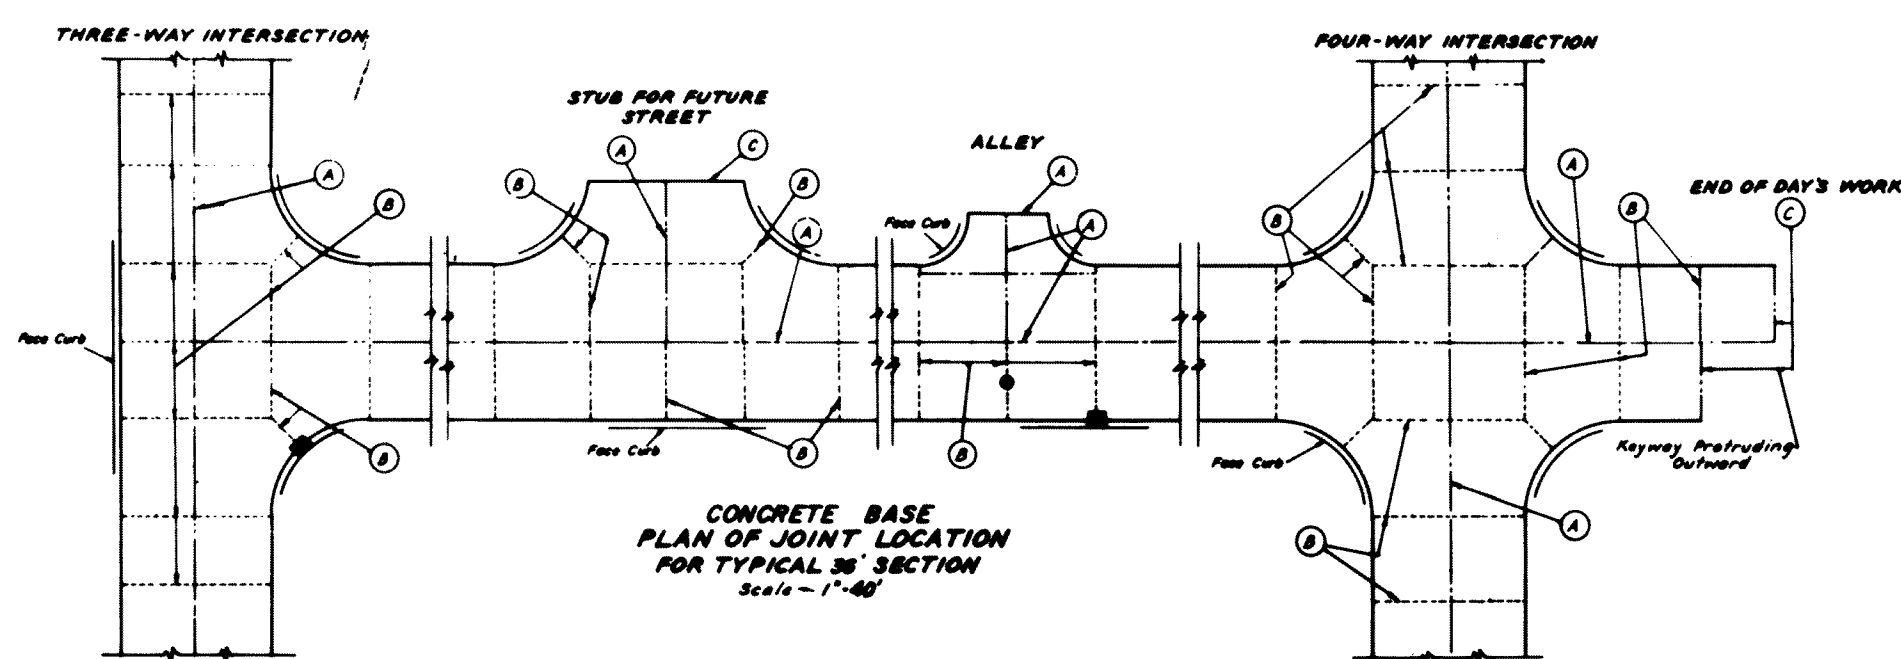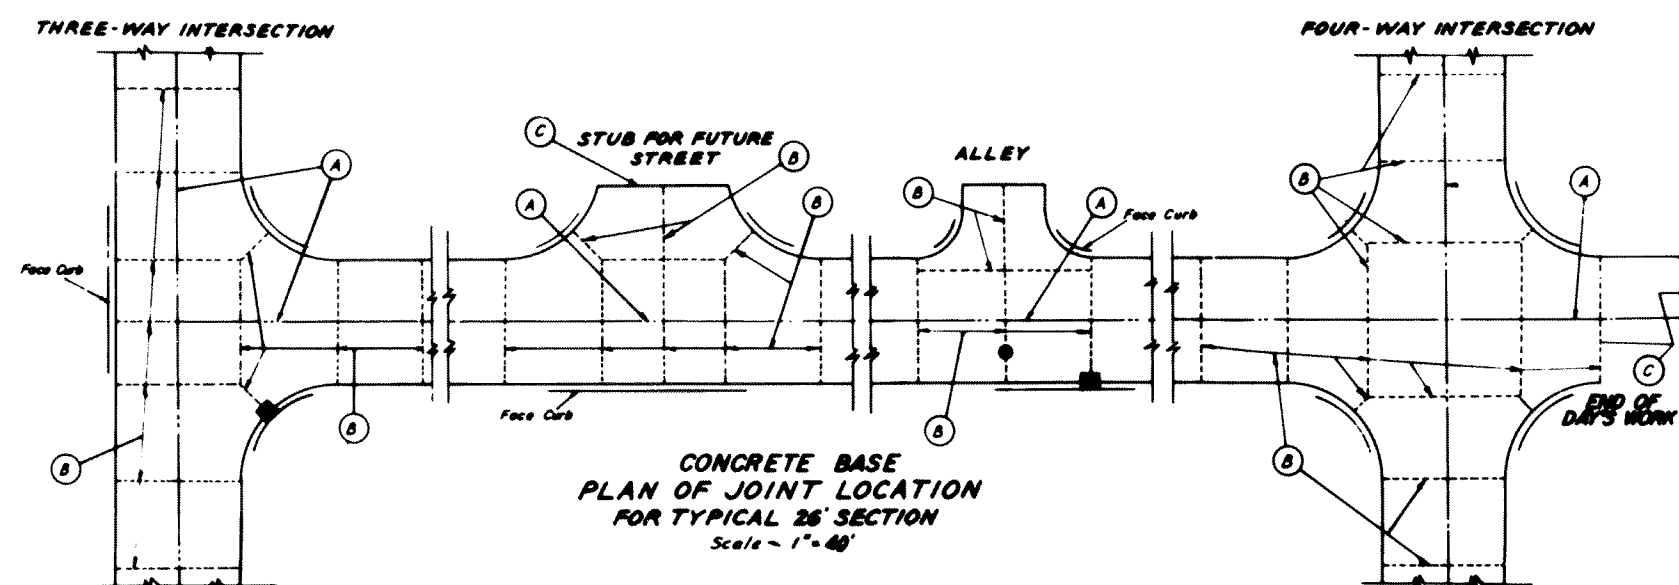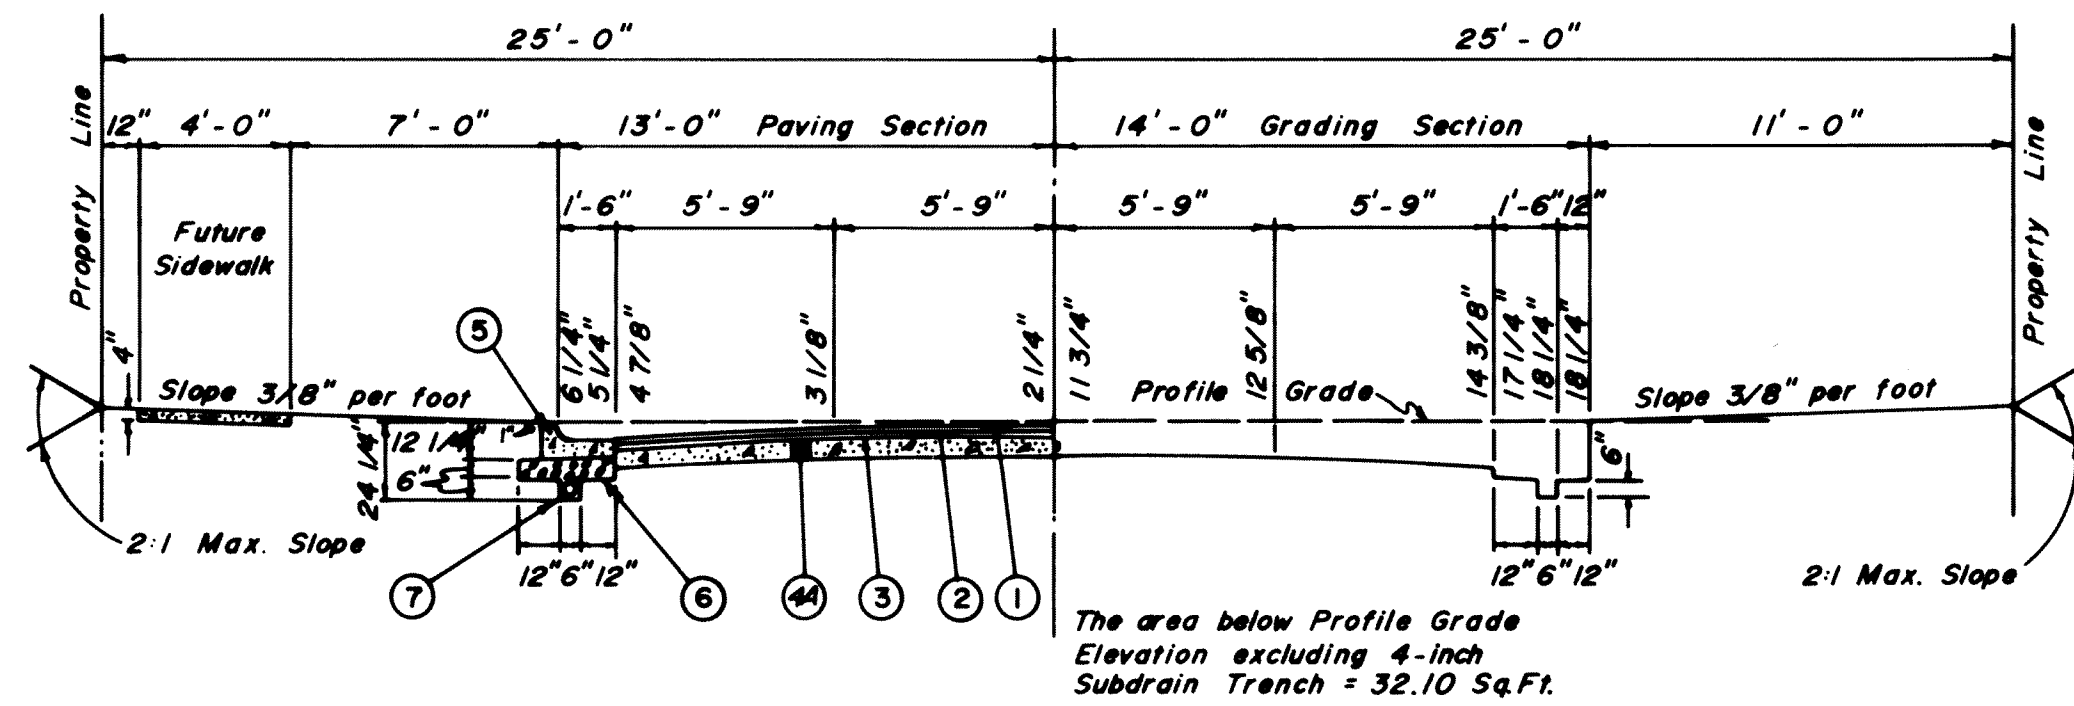

TYPICAL 32' SECTION (60' R/W)

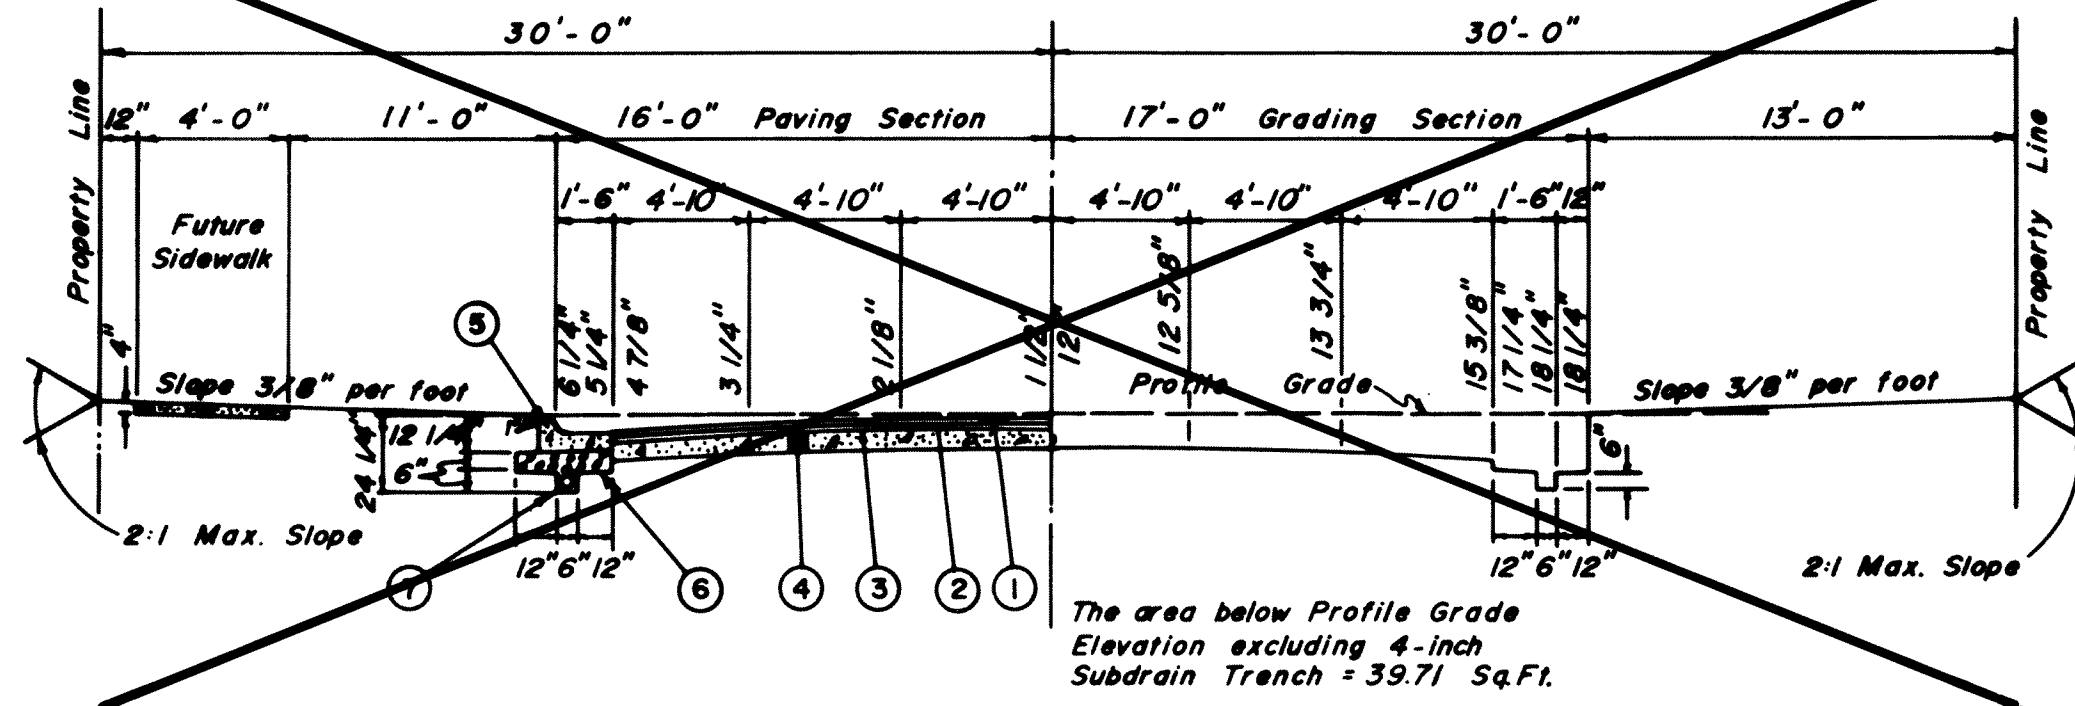

The Specifications of the State of Ohio, Department of Transportation, including all supplements thereto, in force on date of contract, together with the requirements of the City of Gahanna shall govern all materials and workmanship involved in construction.

All item numbers are in accordance with the Ohio Department of Transportation, modified as noted.

- ① 1 1/4" Hot-Mixed, Hot-Laid Asphalt Concrete, Item 404 (85-100) with Modification to State Highway Specifications Asphalt Concrete shall contain all crushed Aggregate. Joints for Asphalt Concrete shall be staggered.
- ② 1 1/4" Hot-Mixed, Hot-Laid Asphalt Concrete, Item 402 (85-100).
- ③ Bituminous Tack Coat, Item 407. Bituminous Material 702.02, RS-1 or an approved equal applied 0.1 Gal. per Sq. Yd. and cover aggregate consisting of crushed gravel or limestone Size No. 9.
- ④ 8" Portland Cement Concrete Base, Item 305 modified as follows, City of Gahanna, Class E Concrete, 510 lbs. Portland Cement per cubic yard, 3% to 6% Air Entrainment and 3" max. slump. (This item also conforms to City of Columbus Construction & Material Specification Item 305.) The use of an approved single beam vibrating screen will be required and Transverse Contraction Joints shall be sawed as per this plan.
- ④A 7" Portland Cement Concrete Base, Item 305 modified as follows, City of Gahanna, Class B Concrete, 380 lbs. Portland Cement per cubic yard, 3% to 5% Air Entrainment and 4.5" max. slump. (This item also conforms to City of Columbus Construction & Material Specification Item 306.) The use of an approved single beam vibrating screen will be required and Transverse Contraction Joints shall be sawed as per this plan.
- Centerline Joint for concrete pavement base shall be sawed if pavement base is constructed full width.
- A subgrade planer or an automatic subgrader will not be required.
- ⑤ Concrete Combined Curb & Gutter, Item 609, modified as follows, City of Gahanna, Class F Concrete, 560 lbs. Portland Cement per cubic Yard, 4% to 8% Air Entrainment and 3" max. slump.
- ⑥ No. 46 Aggregate.
- ⑦ 4" Pipe Underdrain, Item 605.
- ⑧ Mountable Curb, Item 609, Concrete, Item 499, modified as follows, City of Gahanna, Class F Concrete, 560 lbs. Portland Cement per cubic yard, 4% to 8% Air Entrainment and 4" max. slump.

Sidewalks and Drive Ramps, Item 608, Concrete, Item 499, modified as follows, City of Gahanna, Class F, 560 lbs. Portland Cement per cubic yard, 4% to 8% Air Entrainment and 4" max. slump.

Curing Material shall conform to 705.07, Type 2, and shall be applied with a motor driven pump sprayer.


Sidewalk location shall be determined by the City Engineer.

When the pavement design shown on the typical sections is not adequate for contemplated heavier load requirements, the proposed street sections shall be designed in accordance and agreement with the City Engineer.


In the event excavation for the street is from 0" to 6" below that called for on the plans, the Contractor shall replace this excess excavation material with compacted 46D crushed aggregate as directed, and at no extra cost to the Owner.

Mountable Curb may be used on 26' Residential Streets, subject to approval by the City Engineer. All other streets shall be built using combined curb and gutter.


Two or more curb openings for each lot shall be provided for downspout drains at the time of the permanent construction. Cost to be included in the price bid for Item 609. All curb openings provided after curb construction shall be drilled or sawed for downspout drain placement. (Saw Cut Width 1'-0")

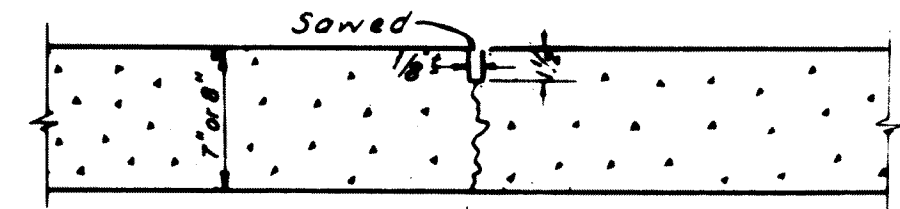


CONTRACTION JOINT (B)
Maximum spacing of Sawed Joints shall be 20'
Maximum spacing of Sawed Joints for Service Road shall be 15'

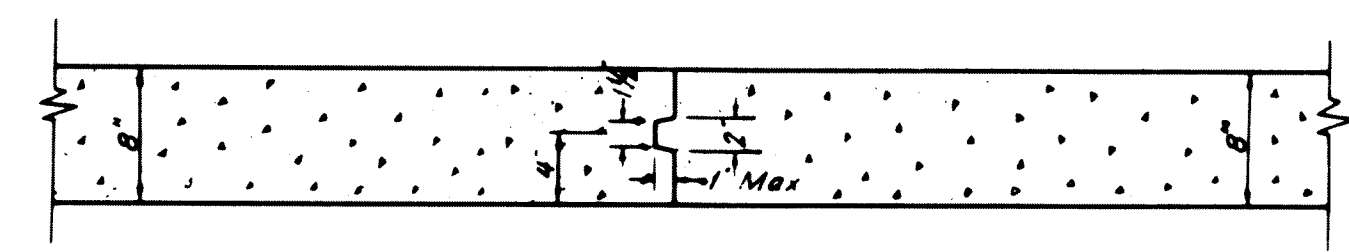


JOINT A & C

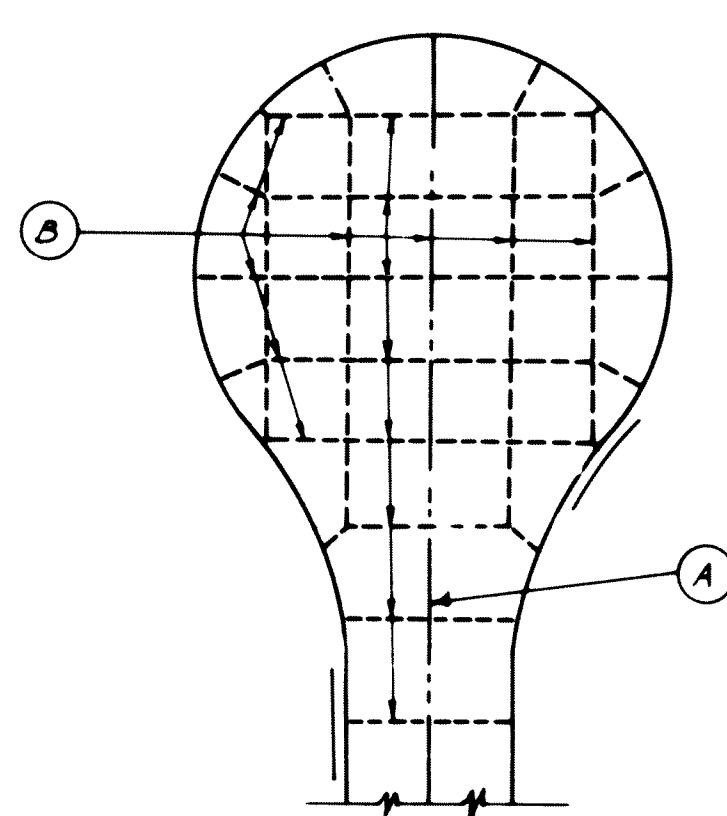

CUL-DE-SAC
FULLY PAVED
Scale - 1" = 30'

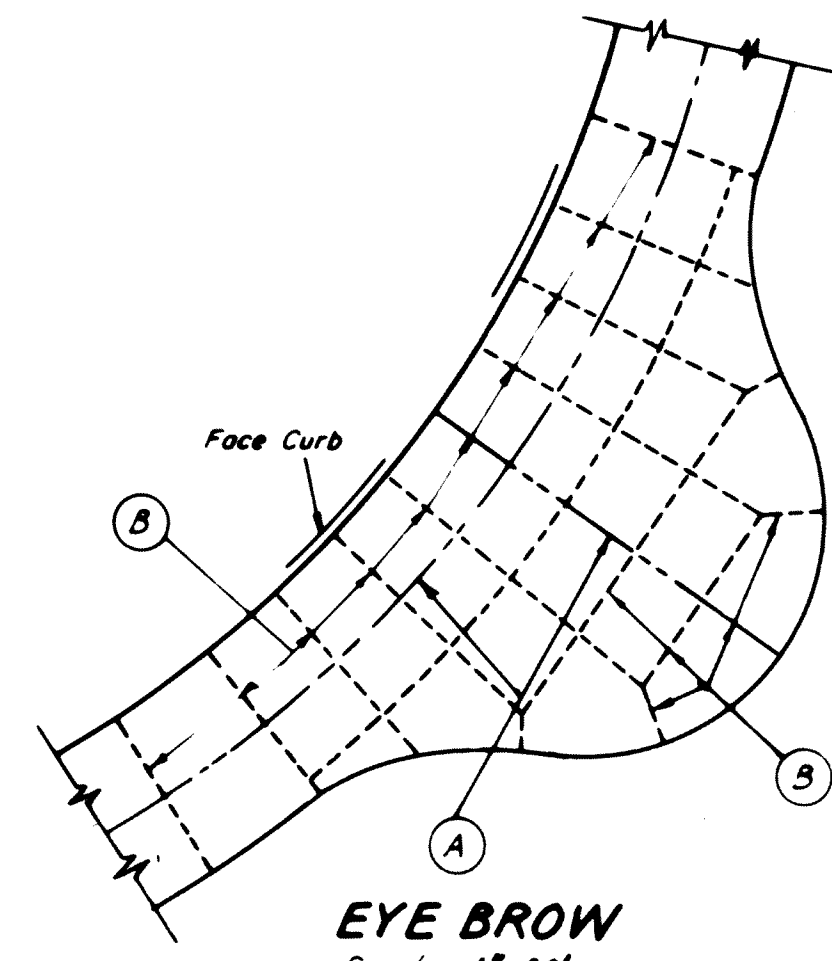


EYE BROW
Scale 1" = 30'

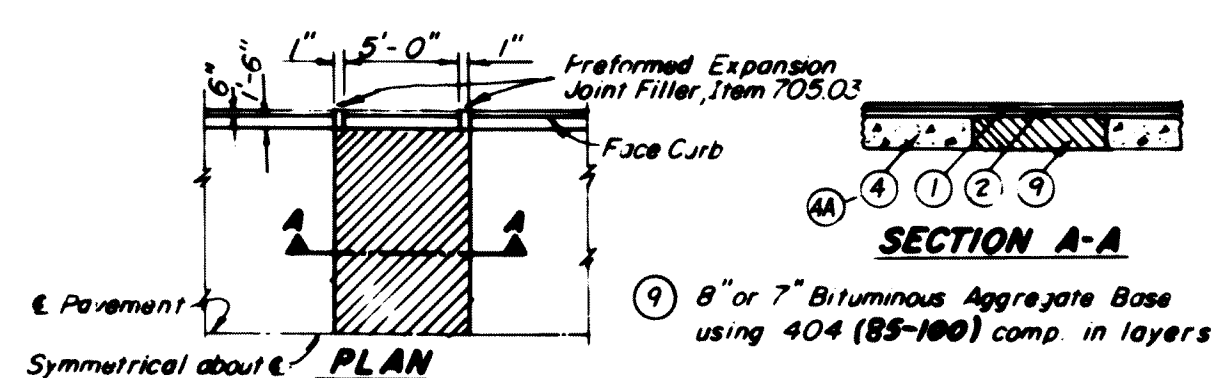


DETAIL OF EXPANSION JOINT


Expansion Joints shall be constructed where shown on the plans. The Bituminous Aggr. Base shall be paid for at the price bid per Cu Yd. for Item 404 Asph. Concrete.

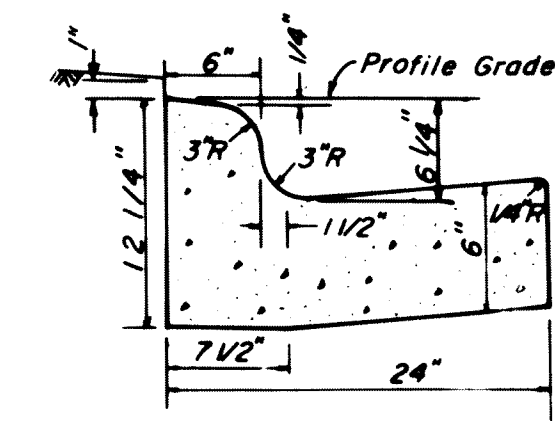

COMBINATION CURB & GUTTER


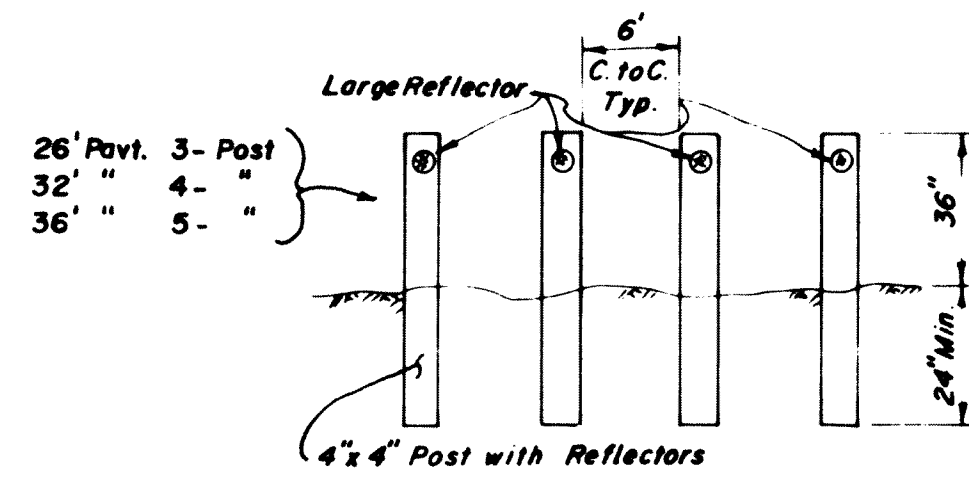



DETAIL OF TEMPORARY BARRICADE

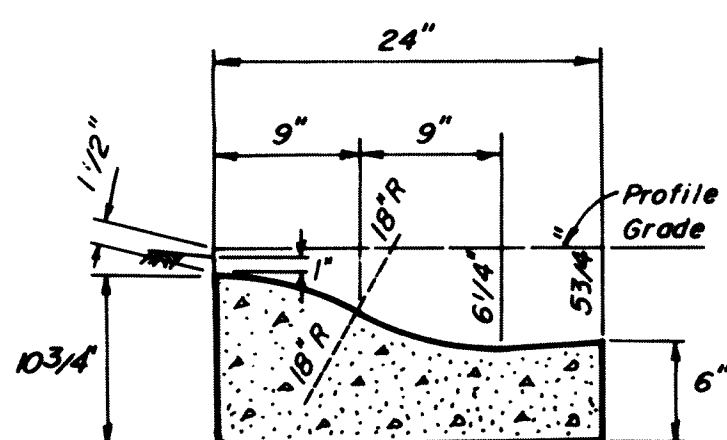


MOUNTABLE CURB

CITY OF GAHANNA , OHIO	
STANDARD CONSTRUCTION DRAWING	
CONSTRUCTION DETAILS FOR ASPHALT CONCRETE ON P.C. CONCRETE BASE	
Approved: <i>William B. Parker</i> CITY ENGINEER, GAHANNA OHIO <i>Richard V. Warren</i> DIRECTOR OF PUBLIC SERVICE, GAHANNA OHIO	DATE 2/5

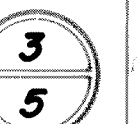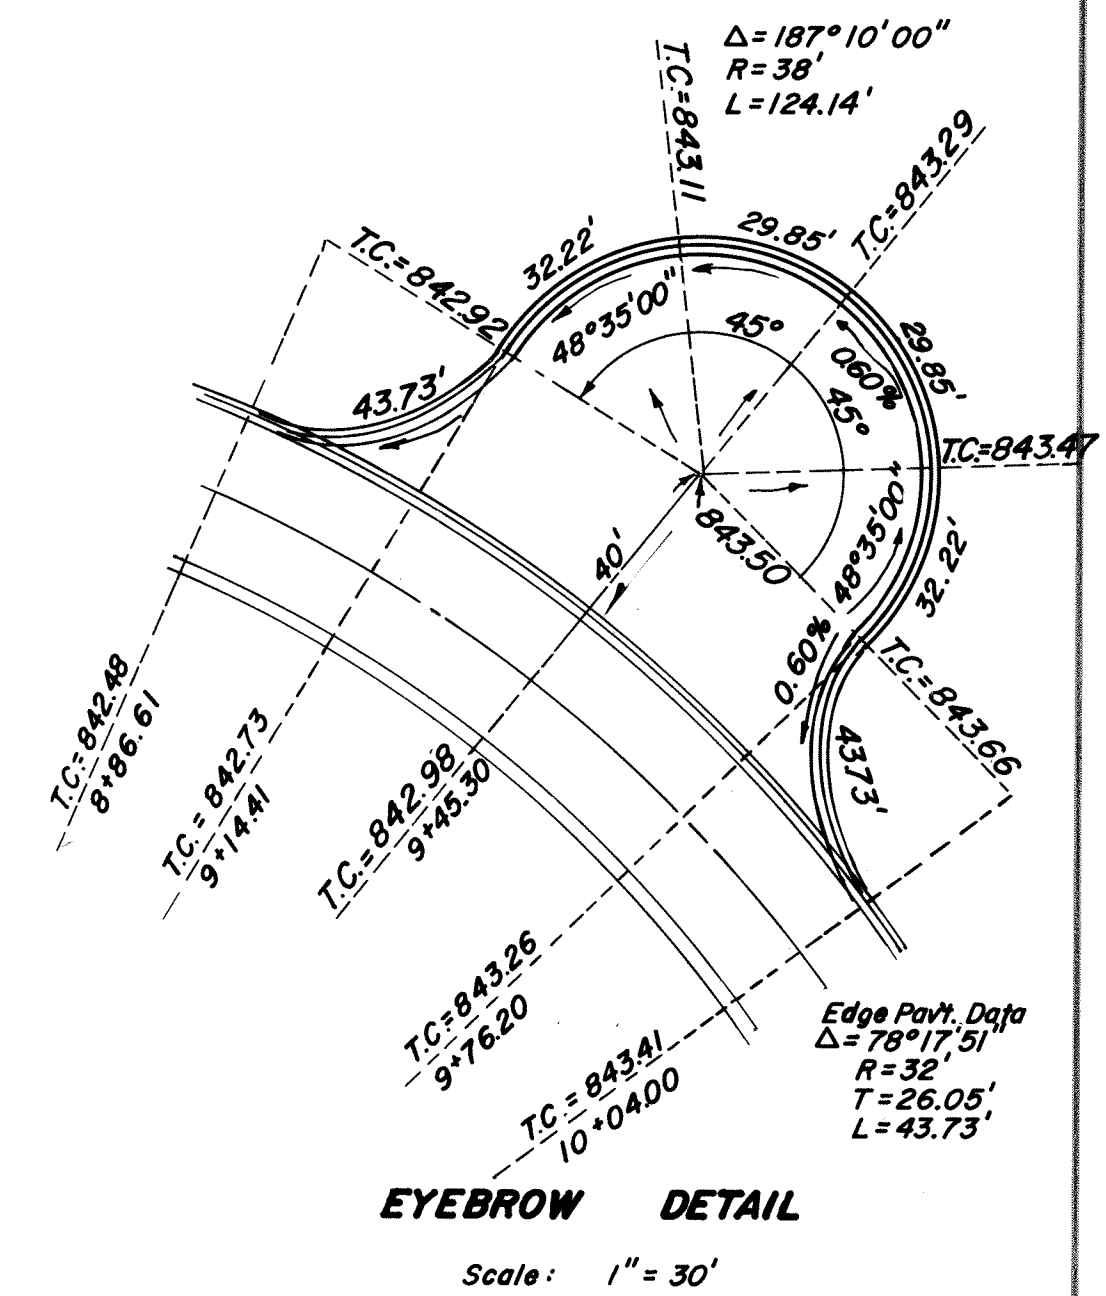


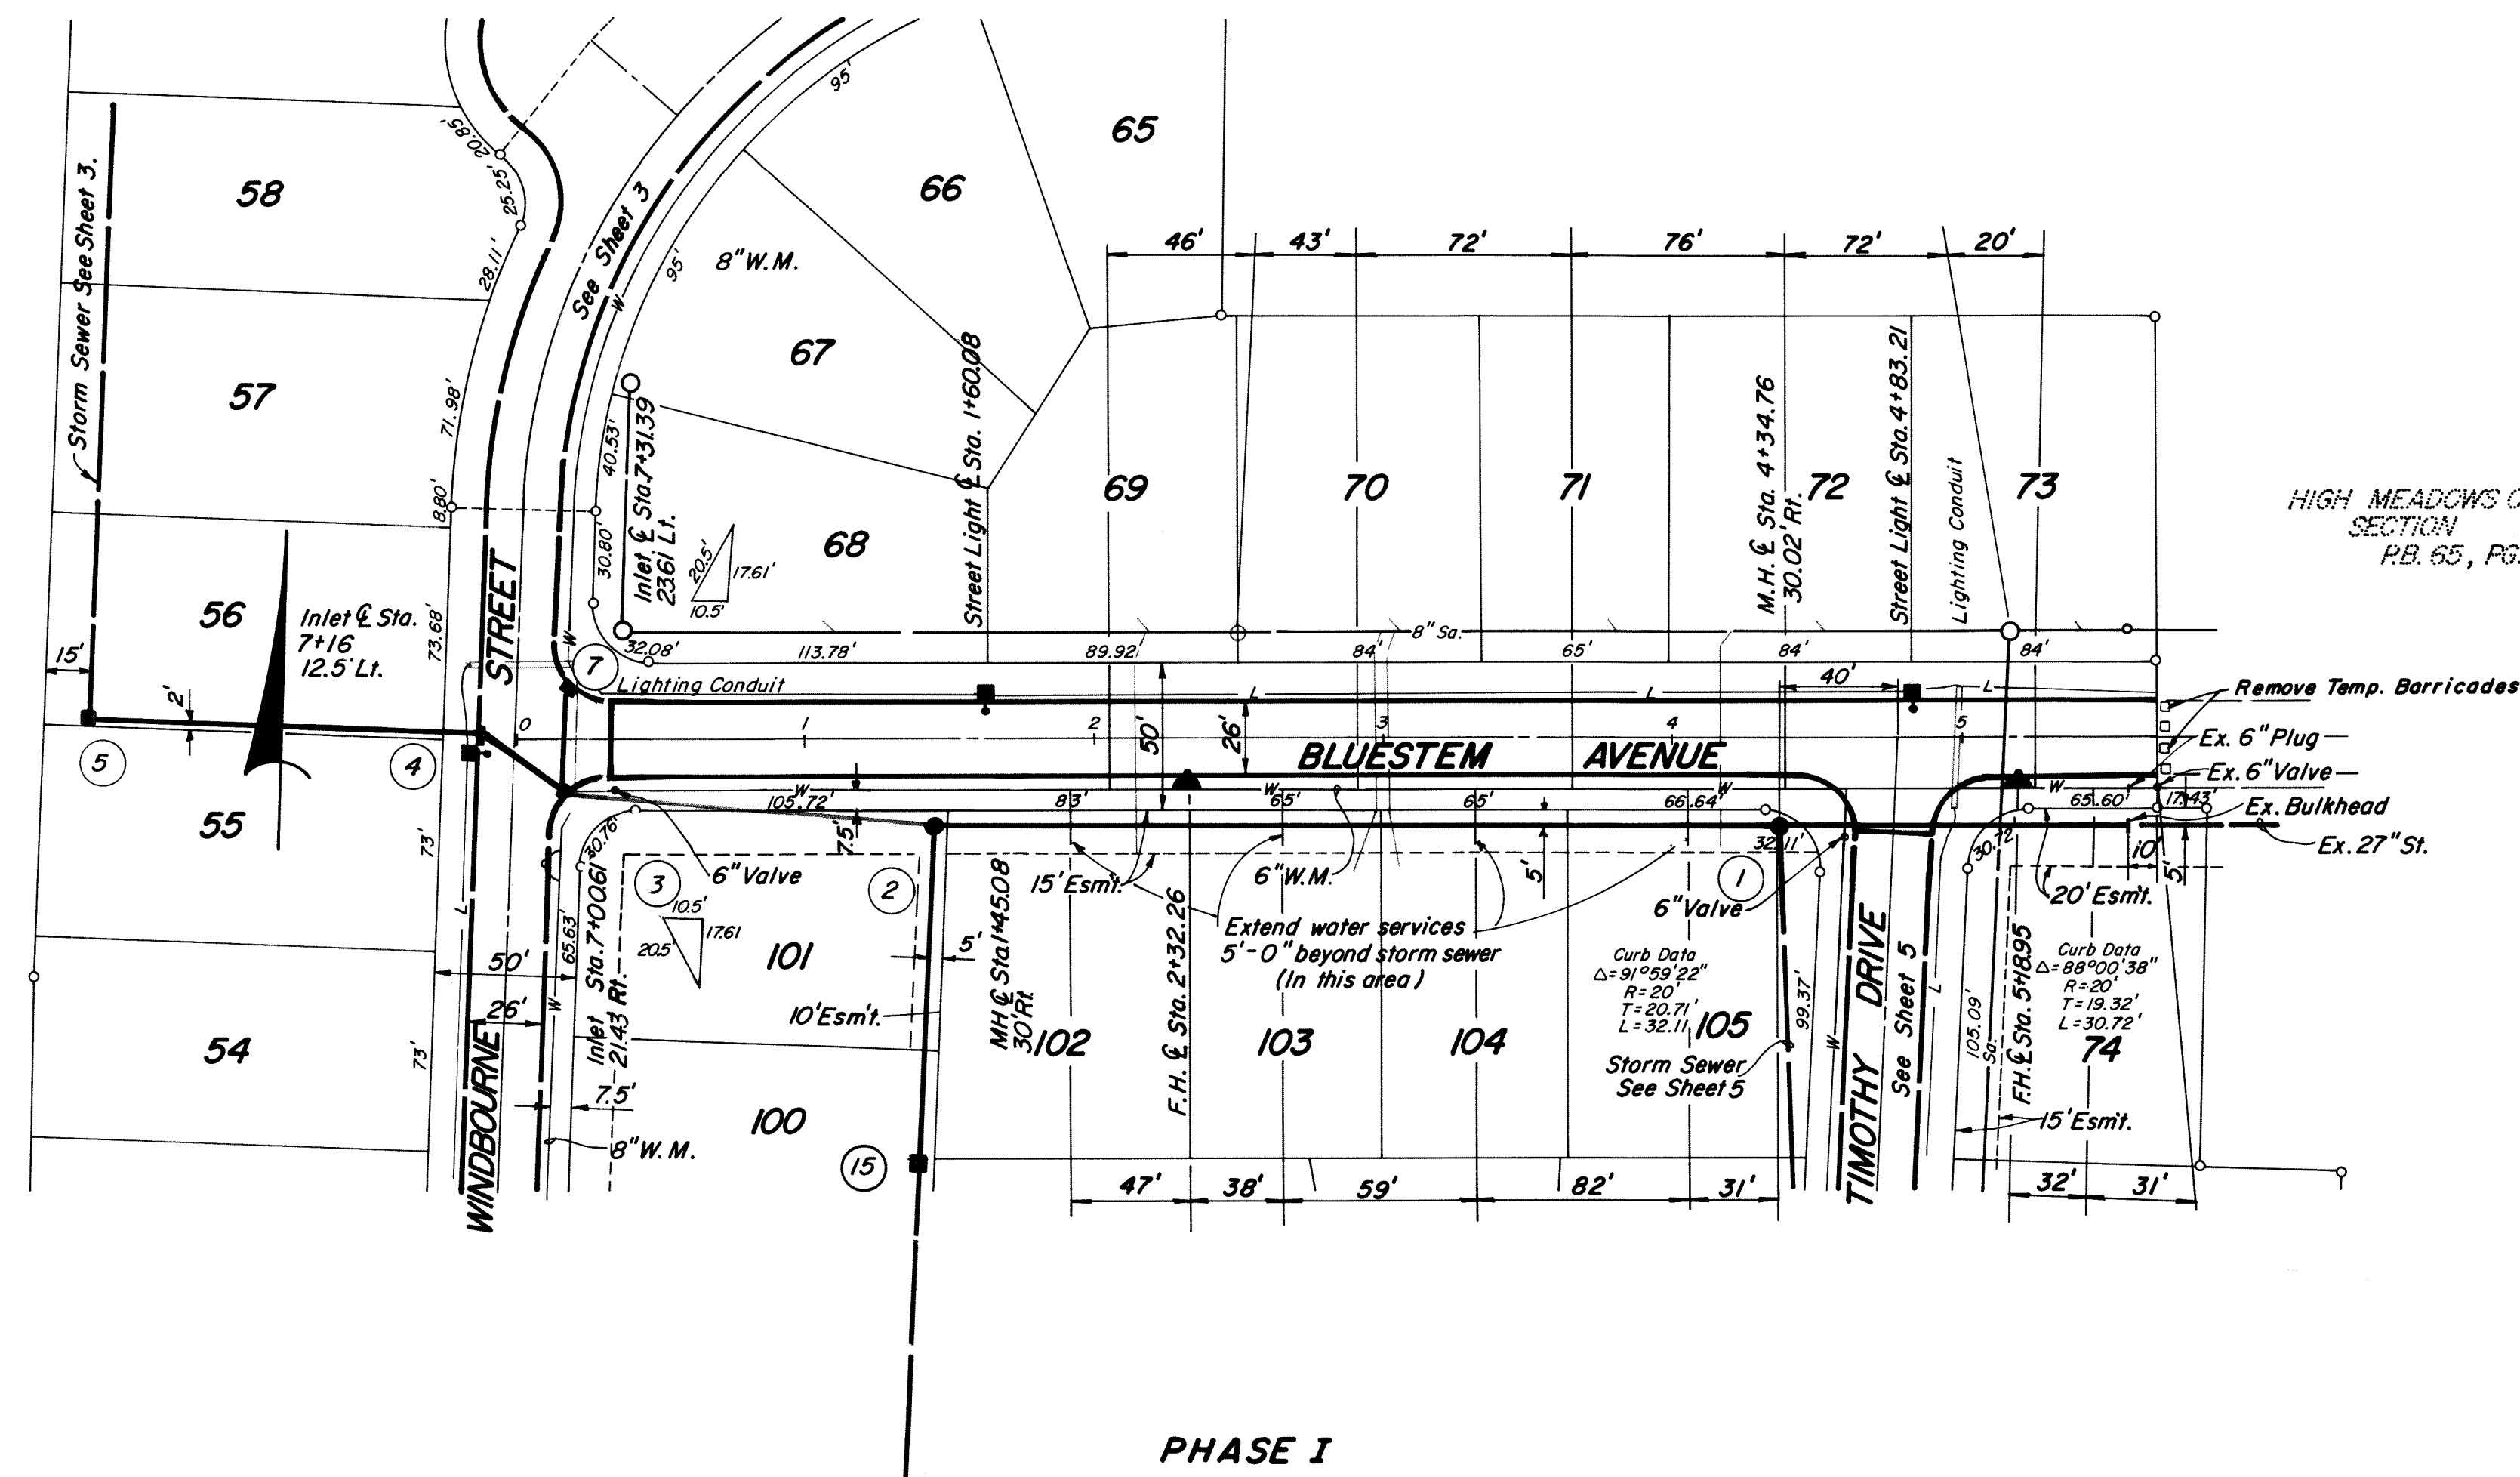


HIGH MEADOWS OF GAHANNA
SECTION No. 1
P.B. 65, PG. 94

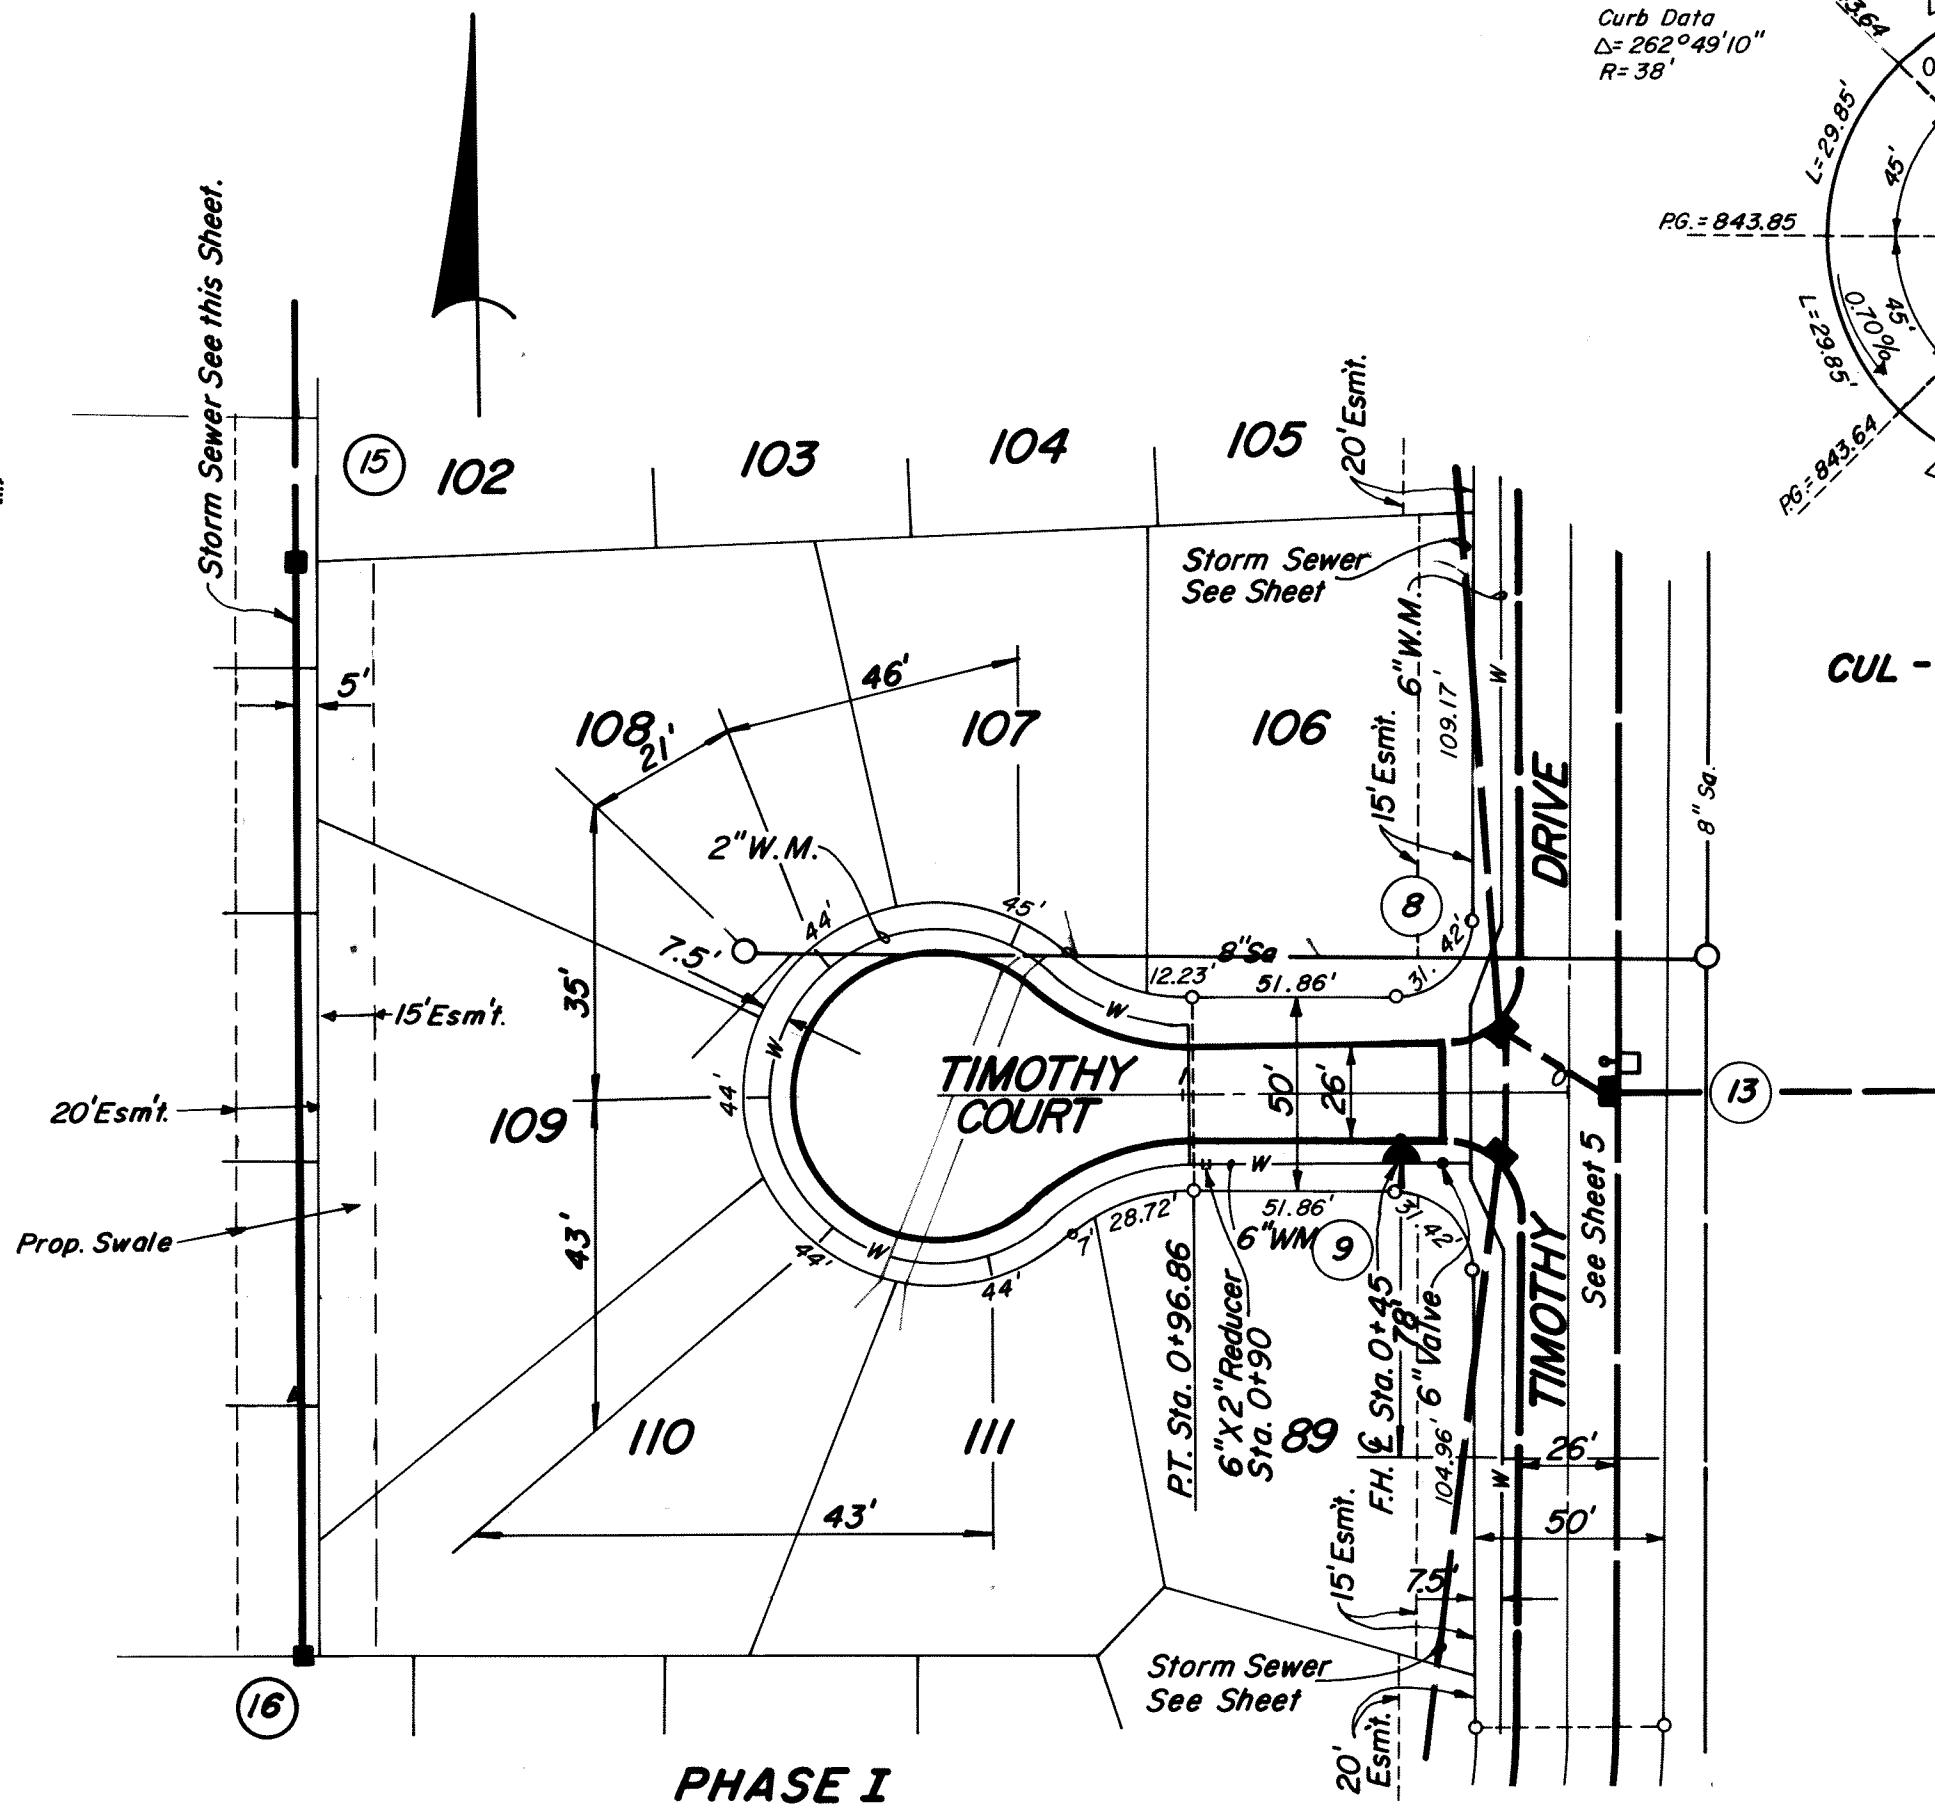

PHASE I

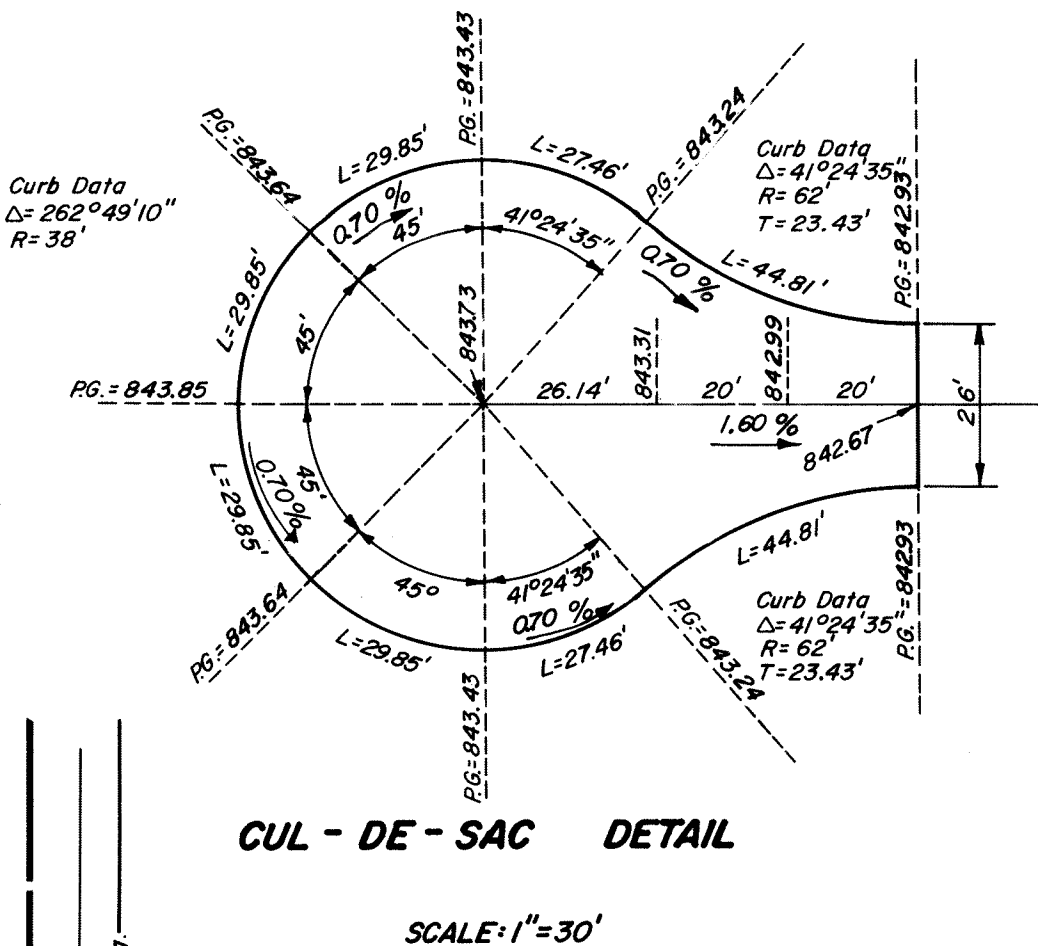

CUL-DE-SAC DETAIL
SCALE: 1"=30'

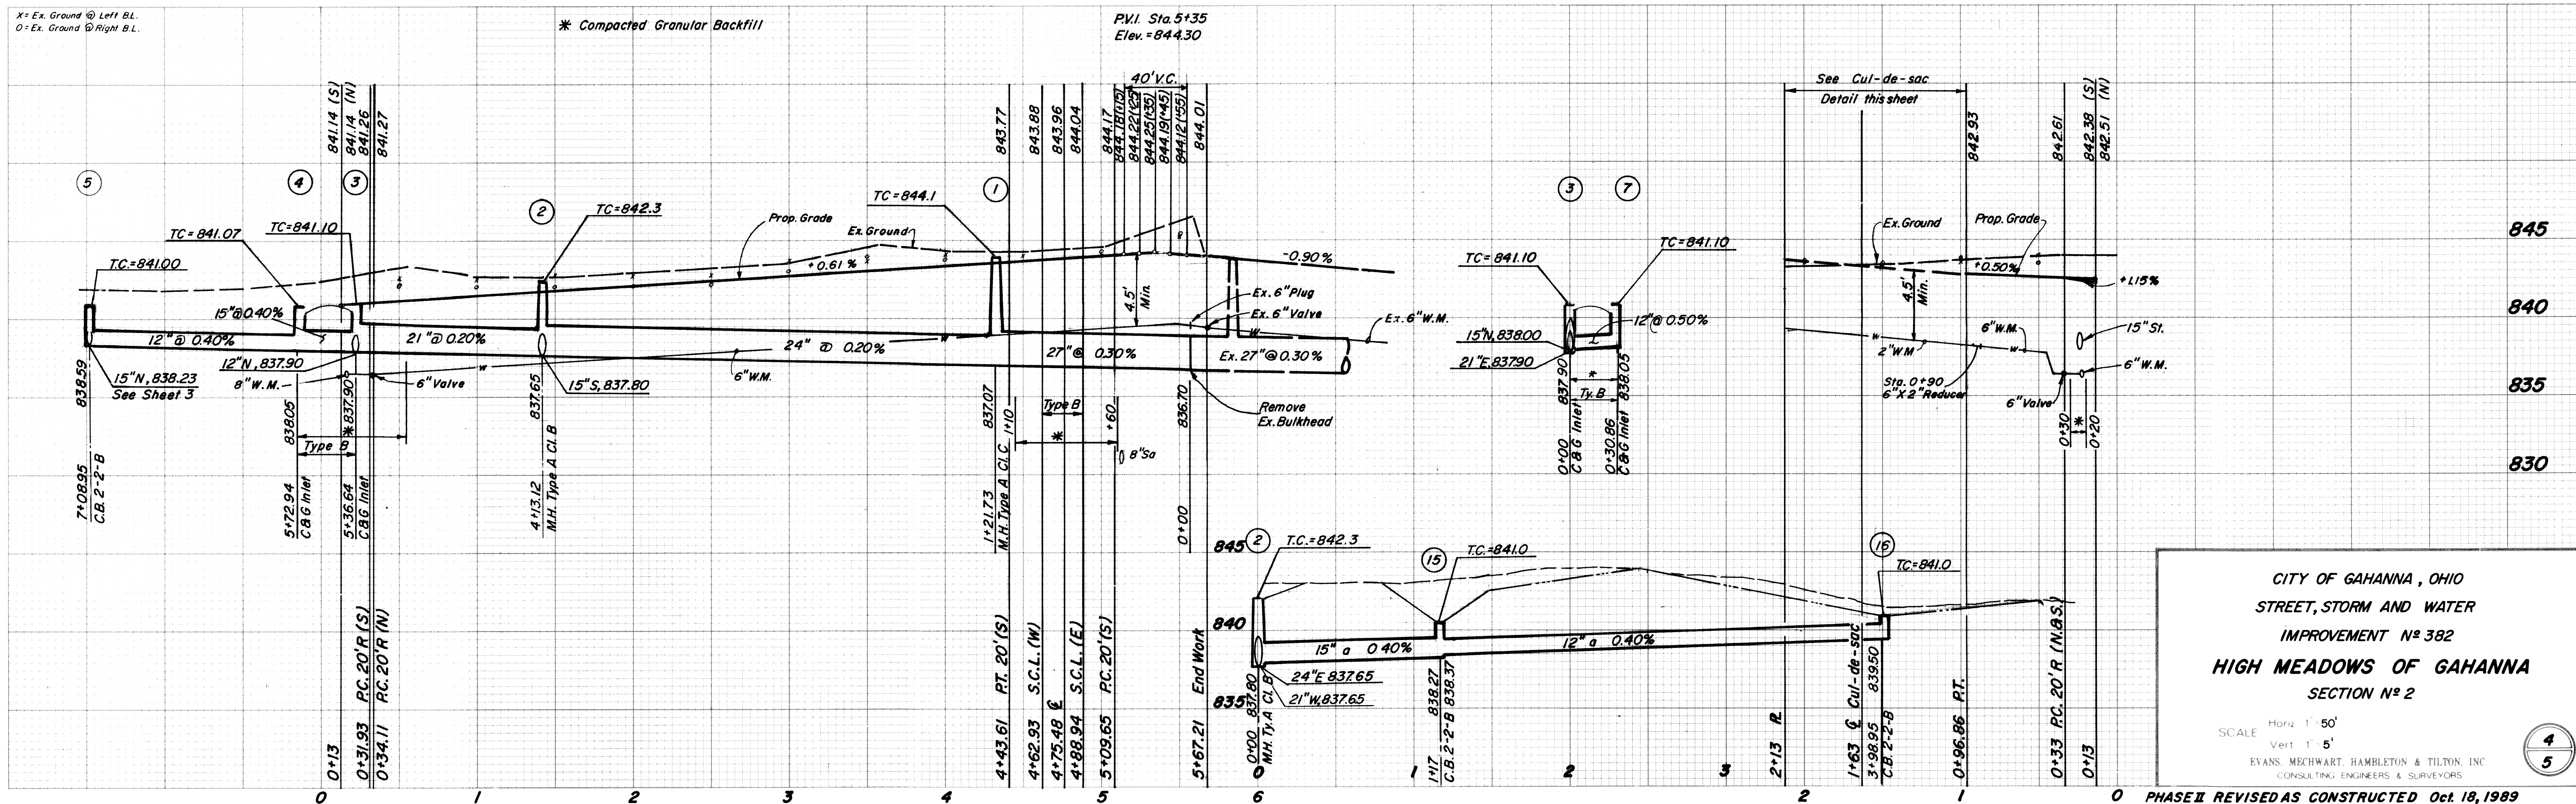

CITY OF GAHANNA, OHIO
STREET, STORM AND WATER
IMPROVEMENT No. 382
HIGH MEADOWS OF GAHANNA
SECTION No. 2


SCALE: Horiz. 1"=50'
Vert. 1"=5'

EVANS, MECHWART, HAMBLETON & TILTON, INC.
CONSULTING ENGINEERS & SURVEYORS


PHASE II REVISED AS CONSTRUCTED Oct. 18, 1989

PHASE I REVISED AS CONSTRUCTED Nov. 11, 1987

AMBASSADOR COMMONS
P.B. 48
PG. 33

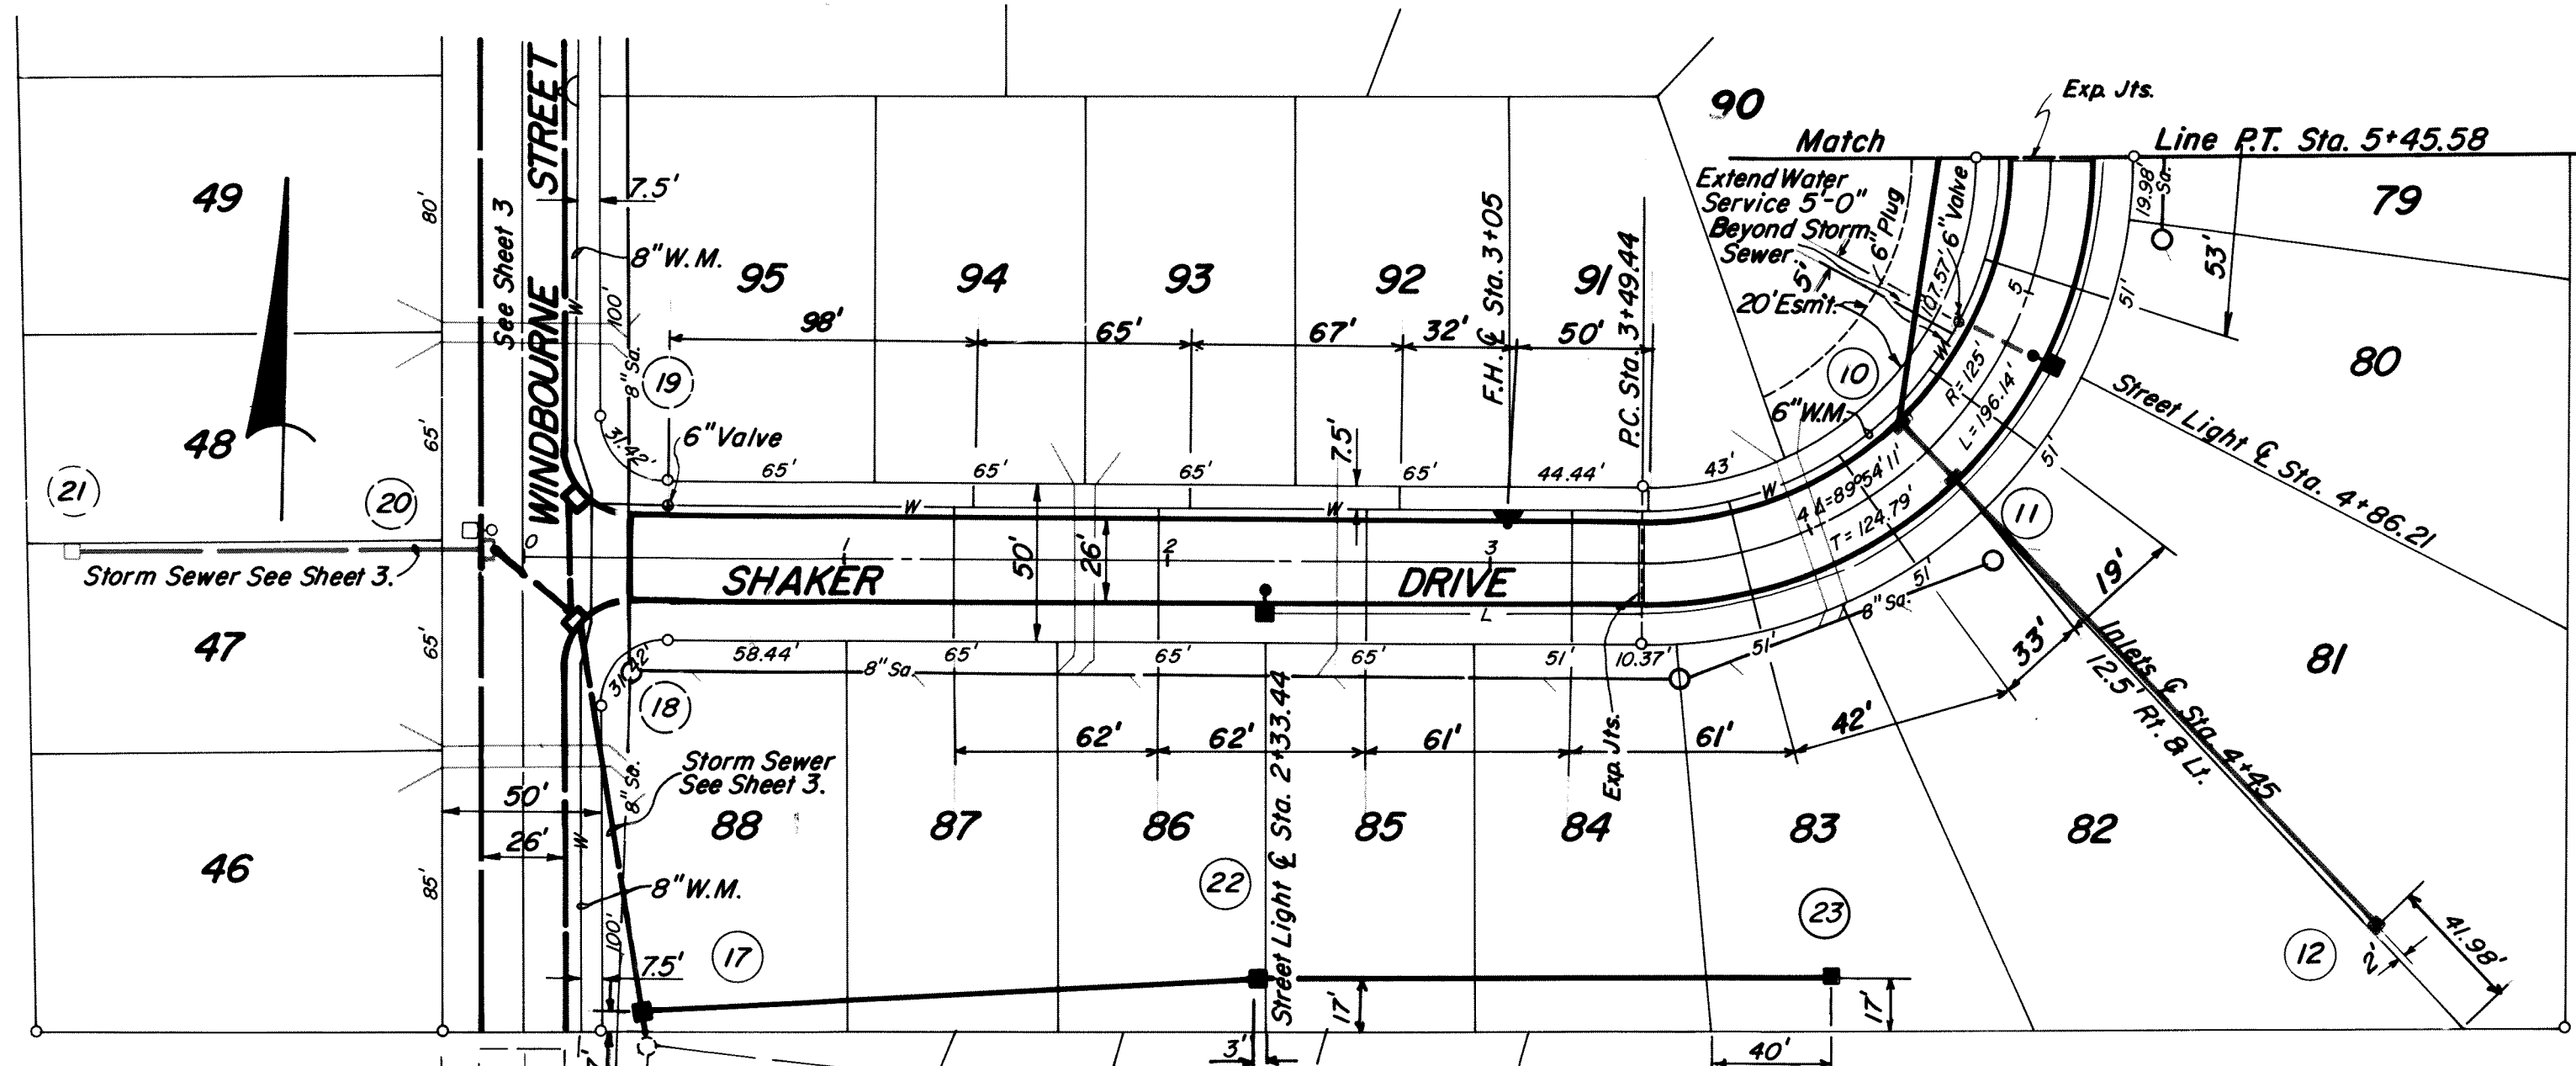

ANNABELL JAMES
D.B. 1355 PG. 269
D.B. 2039 PG. 480

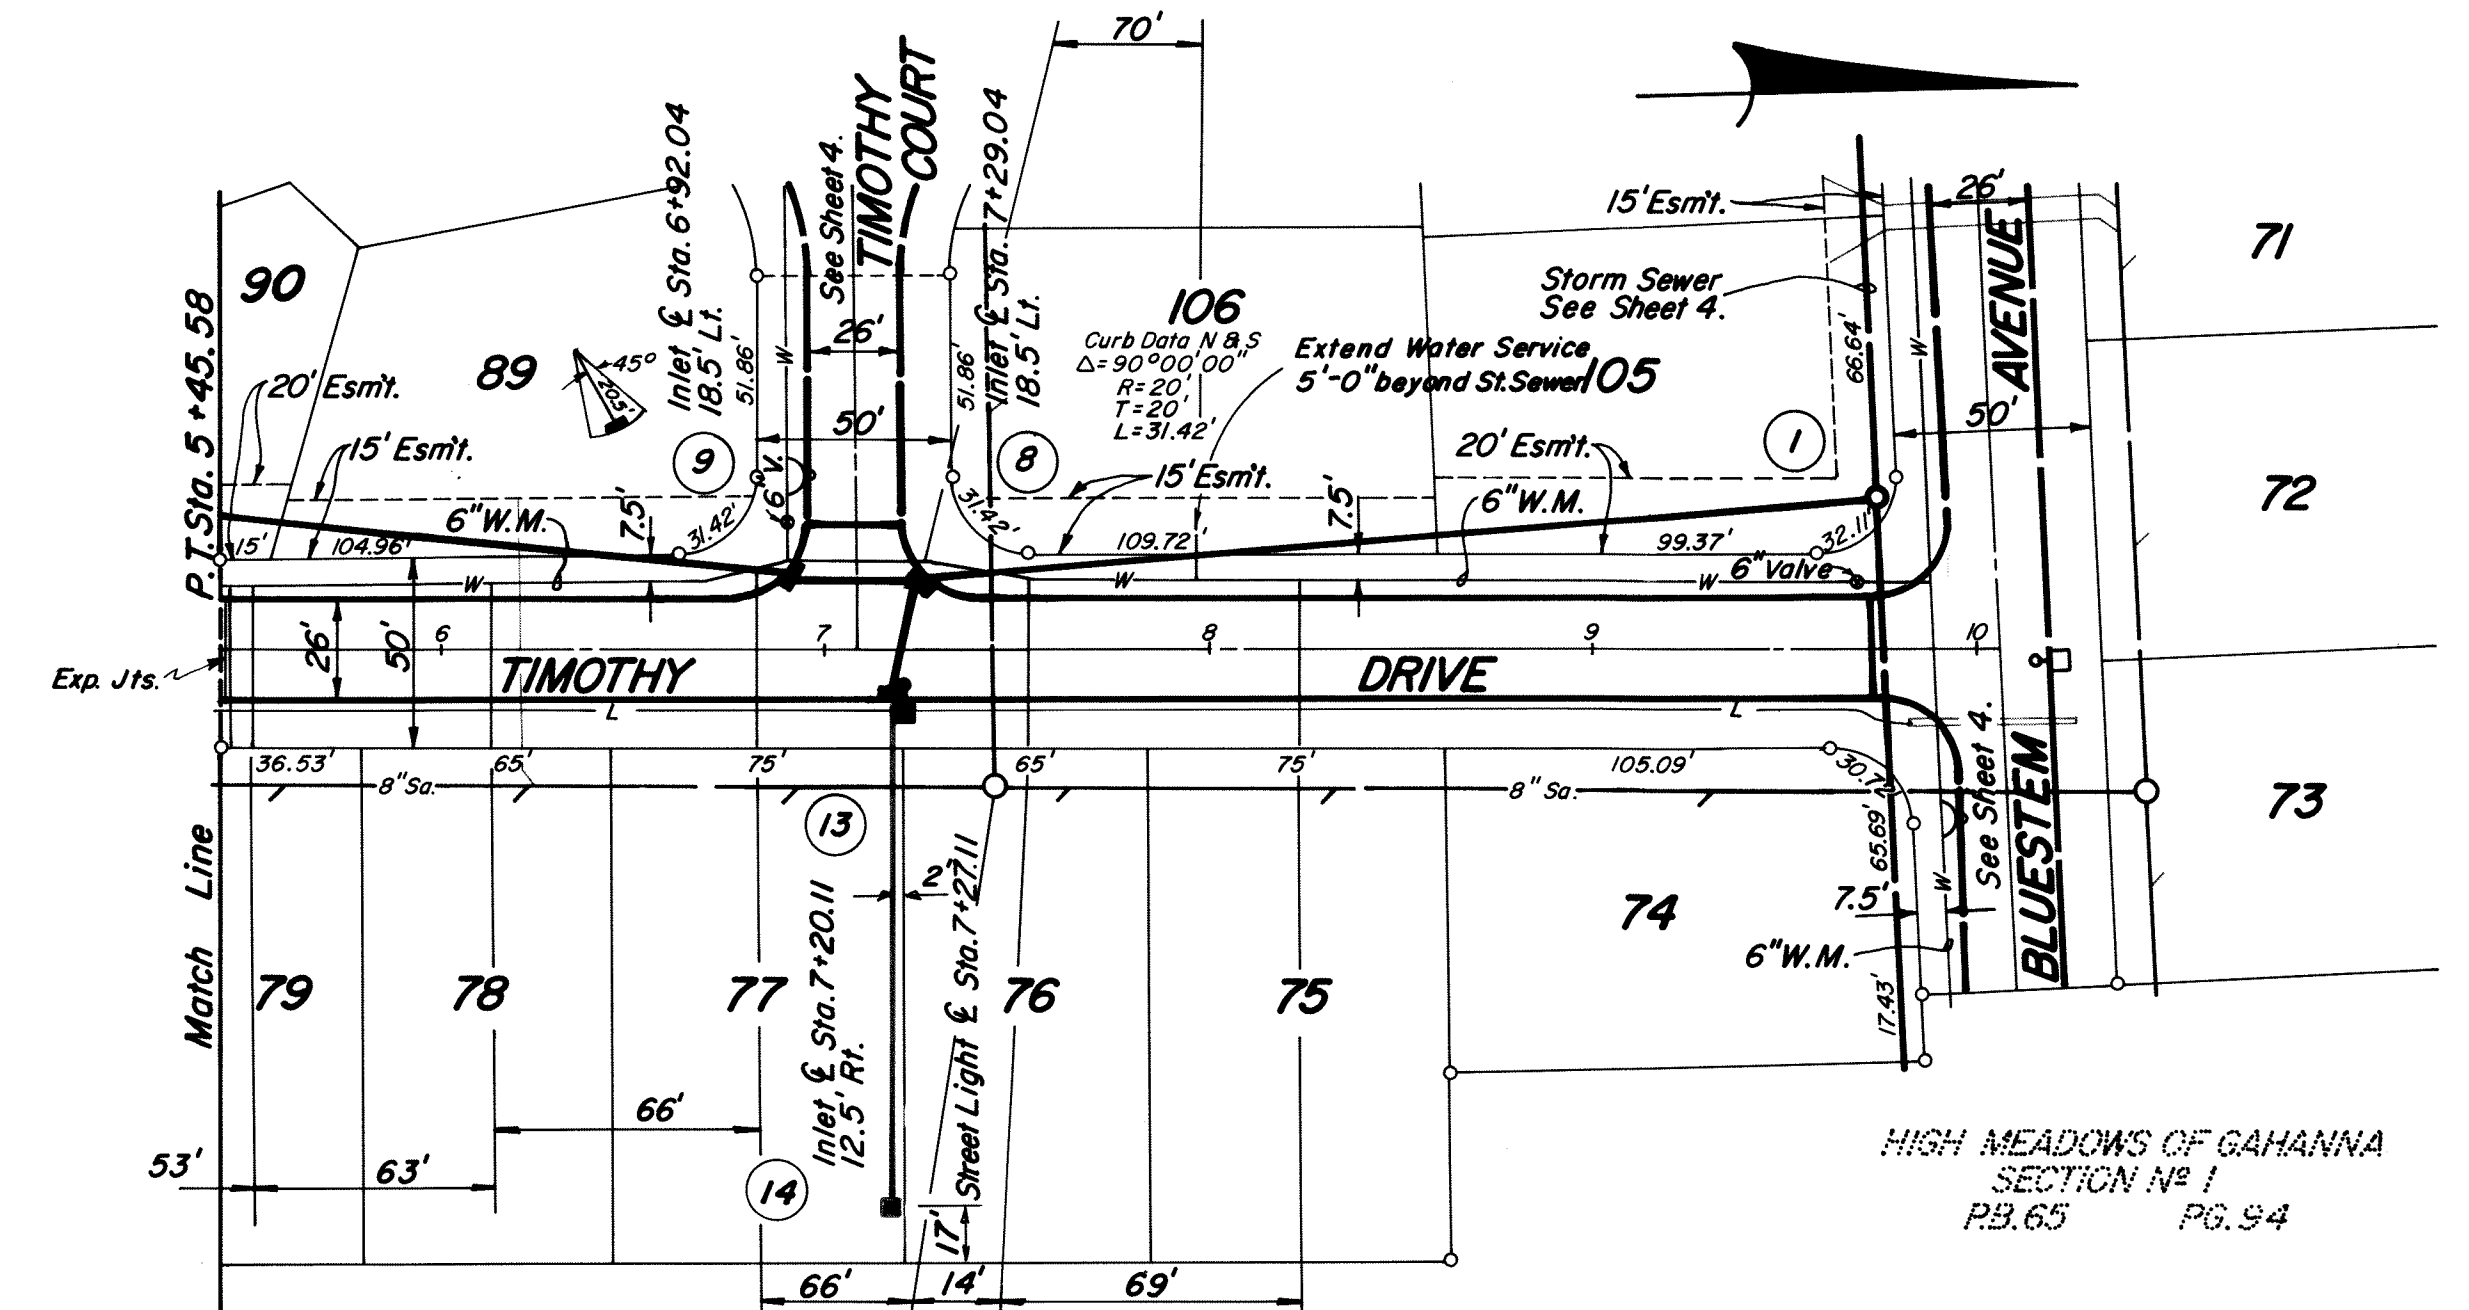

ANNABELL JAMES
D.B. 1355 PG. 269
D.B. 2039 PG. 480


HIGH MEADOWS OF GAHANNA
SECTION No. 1
PG. 65 PG. 94

PHASE II PHASE I

PHASE I

X = Ex. Ground @ Left B.L.
O = Ex. Ground @ Right B.L.

* Compacted Granular Backfill

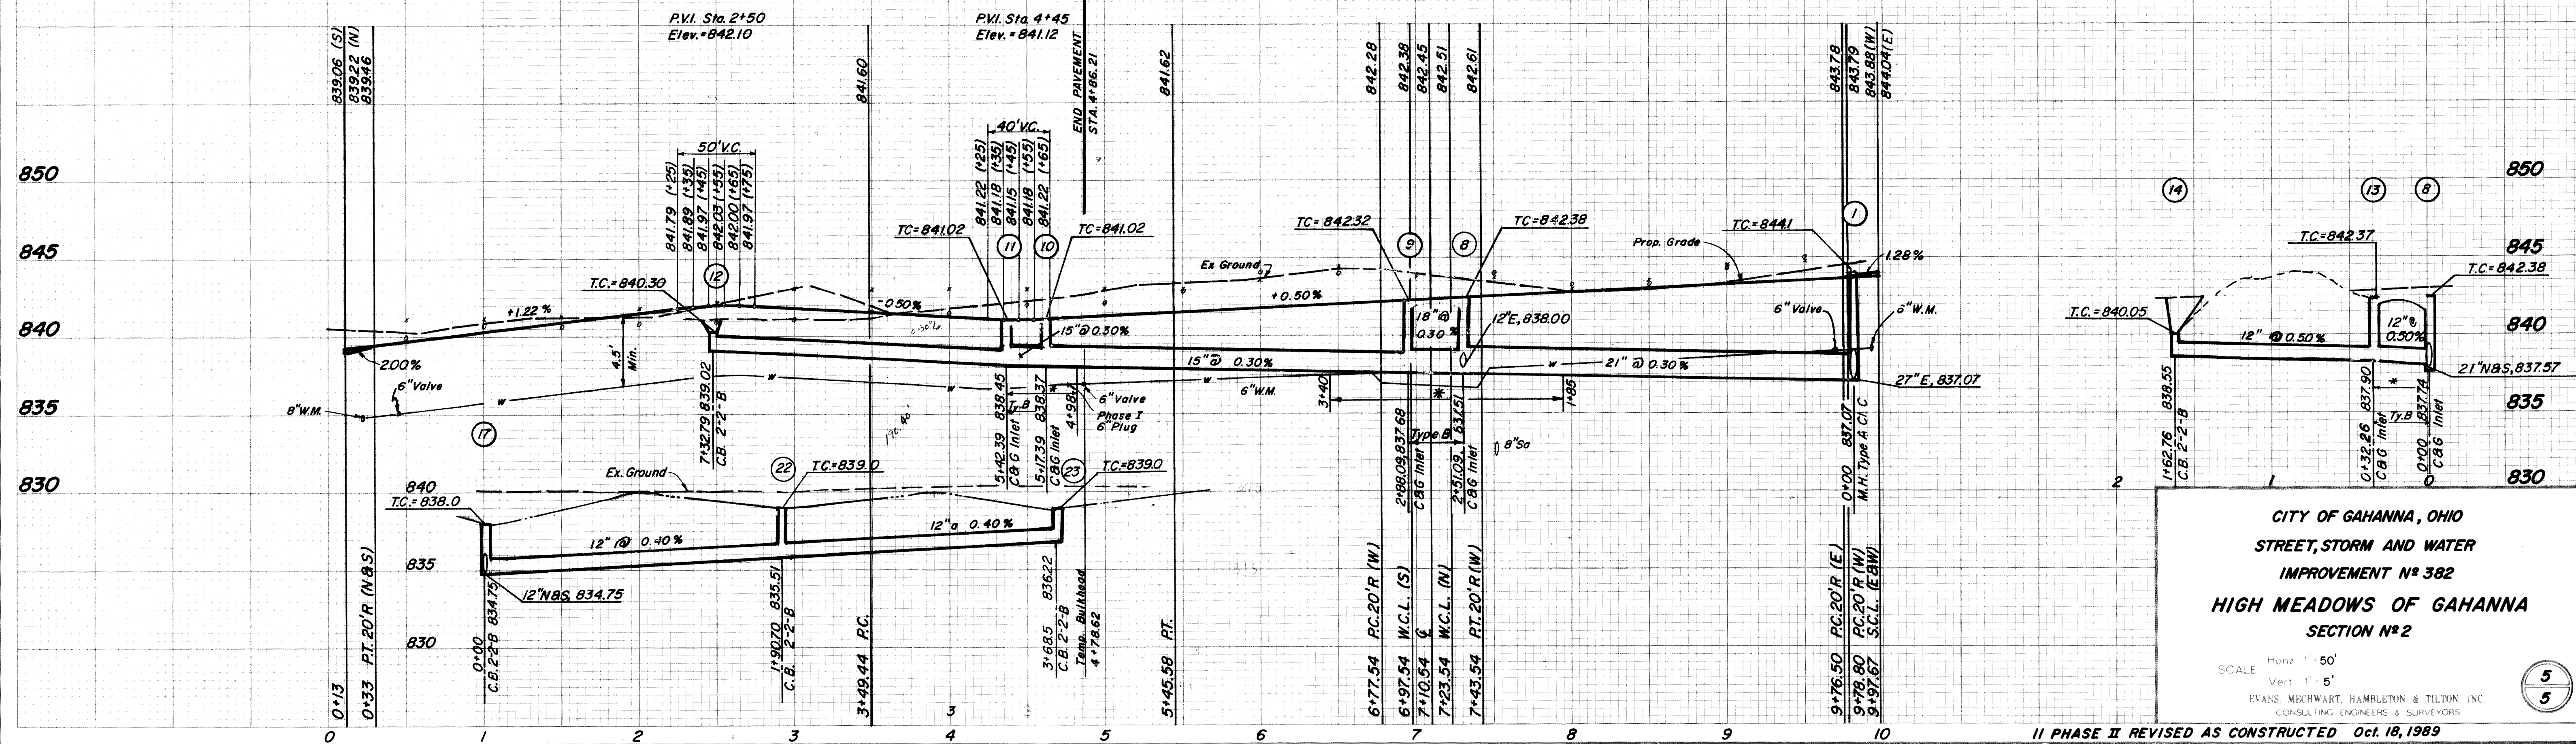

CITY OF GAHANNA, OHIO
STREET, STORM AND WATER
IMPROVEMENT No. 382
HIGH MEADOWS OF GAHANNA
SECTION No. 2

SCALE
HORIZ 1" = 50'
VERT 1" = 5'
EVANS, MECHWART, HAMBLETON & TILTON, INC.
CONSULTING ENGINEERS & SURVEYORS

PHASE II REVISED AS CONSTRUCTED Oct. 18, 1989

PHASE I REVISED AS CONSTRUCTED Nov. 11, 1987

High Meadows Section 2

P-1170 No. 382

CITY OF GAHANNA, OHIO
STREET, STORM, WATER AND STREET LIGHTING
IMPROVEMENT NO. 406
BRYN MAWR
SECTION 2, PHASE 1
1988

GENERAL NOTES

SPECIFICATION: The requirements of the City of Gahanna, together with the Standard Specifications of the State of Ohio, Department of Transportation, including all supplements thereto in force on date of contract shall govern all materials and workmanship involved in the improvements shown on these plans except as such specifications are modified by the following specifications or by the construction details set forth herein.

STANDARD CONSTRUCTION DRAWINGS: All pertinent Standard Construction Drawings are available upon request at the office of the City Engineer.

PERMITS: The Contractor shall obtain all necessary permits.

SAFETY REQUIREMENTS: The Contractor and Sub-Contractor shall be solely responsible for all federal, state and local safety requirements, together with exercising precautions at all times for the protection of persons (including employees) and property. It is also the sole responsibility of the Contractor and Sub-Contractor to initiate, maintain and supervise all safety requirements, precautions and programs in connection with this work.

MISCELLANEOUS WORK: All items of work called for on the plans for which no specific method of payment is provided shall be performed by the Contractor and the cost of same shall be included in the price for the various related items.

FIELD TILE: All field tile broken during excavation shall be replaced to its original condition or connected to either the curb subdrain or to the storm sewer system as directed by the Engineer.

SURPLUS EXCAVATION: The Contractor shall dispose of all surplus street excavation on the project site where and as directed by the Owner.

UNAUTHORIZED STREET EXCAVATION: In the event excavation for the street is from 0" to 6" below that called for on the plans, the Contractor shall replace this excess excavated material with compacted 46D crushed aggregate as directed and at no extra cost to the owner.

STORM SEWERS: Unless otherwise noted on the plans all Storm Sewers shall be as hereafter specified: (1) All sizes of storm sewer located within or across proposed or existing pavement areas shall be Type B Conduit, 706.02, with Class B Bedding, (2) Storm Sewer located outside pavement areas shall be Type E Conduit, 706.01, Class C Bedding, for 15 inch and smaller, and shall be Type E Conduit, 706.02, Class C Bedding, for 18 inch and larger. The following modifications to Ohio Department of Transportation Specifications shall apply: (1) Type E Conduits shall have sealed joints; (2) Granular backfill material shall be compacted granular material, Item 310-A placed within limits shown on the plan including around all inlet structures. Granular backfill shall extend from the bottom of the trench to a plane 6 inches below the subgrade.

CURB INLETS: All curb inlets shall be channeled as directed.

ROOF DRAIN OPENINGS: All curb drain openings to be drilled by builder at time of construction of each house, including mountable curb.

STREET LIGHTING: Standard Electrical Specifications and Standard Construction Drawings, covering Street Lighting for the City of Gahanna, Ohio, shall apply.

EXPANSION JOINTS: It shall be the responsibility of the Contractor to adequately barricade the street in the vicinity of all expansion joints, until such time as the street is open to traffic.

WATER MAINS: All water mains shall be either Ductile Iron Class 53 (4" through 10"), Class 54 (12" and larger), or P.V.C. C-900, Class 150. All bends, joint deflections and fittings shall be backed with concrete where and as directed. Where water mains or services cross proposed or existing streets, backfill shall be compacted granular material, Item 310-A, within limits 5 feet outside the edge of pavement or curb extended from the bottom of the trench to a plane 6 inches below the subgrade. The services may be jacked across the street in lieu of open cut and the use of granular backfill. 2" water mains shall be P.V.C. SR 21-CL-200, service saddles for 2" pipe shall be a Ford S-70 or equal.

CURB BOXES: Curb boxes shall be located six inches inside the R/W line and that any extension of water services underneath the proposed storm sewer shall be coupled to the proposed water box installation and properly protected at the end of the service, marked and protected.

CHLORINATION OF WATER MAINS: The Contractor shall make arrangements to have the water mains chlorinated by the City of Columbus. The cost of chlorination shall be included in the price bid for the various water main items.

EXISTING UTILITIES: The identity and location of the existing underground utility facilities known to be located in the construction area have been shown on the plans as accurately as provided by the Owner of the underground utility. The City of Gahanna and/or Engineer assumes no responsibility as to the accuracy or the depths of the underground facilities shown on the plans.


Support, protection and restoration of all existing utilities and appurtenances shall be the responsibility of the Contractor. The cost of this work shall be included in the price bid for the various items.

The Contractor shall cause notice to be given to the Ohio Utilities Protection Service (telephone 800-362-2764 - toll free) and to the Owners of underground utility facilities shown on the plans who are not members of a registered underground protection service in accordance with Section 153.64 of the Revised Code. The above mentioned notice shall be given at least 48 hours prior to start of construction.


The Owner/Developer shall provide a Soils Engineer, registered in the State of Ohio, for the purpose of inspecting and certifying to the City of Gahanna, acceptable soil bearing conditions prior to placement of improvements within the right-of-way and easements in accordance with the appropriate O.D.O.T. specifications.

All site clearing (tree removal) shall be performed by the Owner at his expense prior to construction of this project.

The Contractor shall ensure that ducts for underground crossings of streets by Columbus Southern Power Company, Ohio Bell Telephone and Cable Television facilities and Street Light Wires where applicable are installed prior to commencement of construction of curb and pavement.

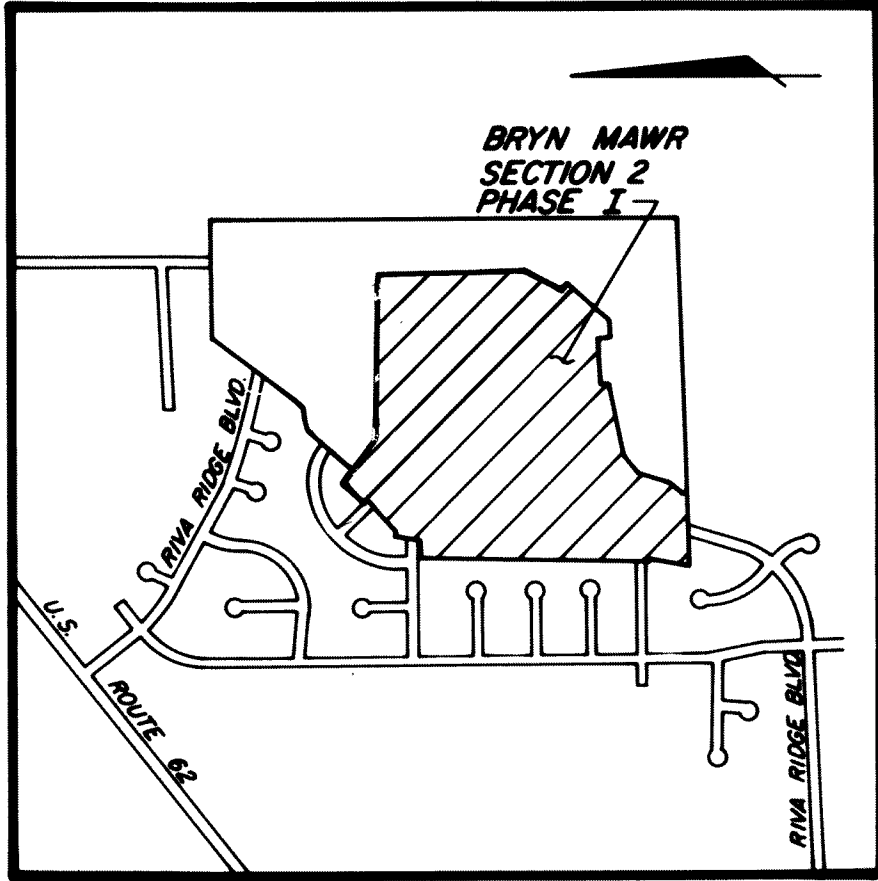

LOCATION MAP
SCALE: 1"=1200'

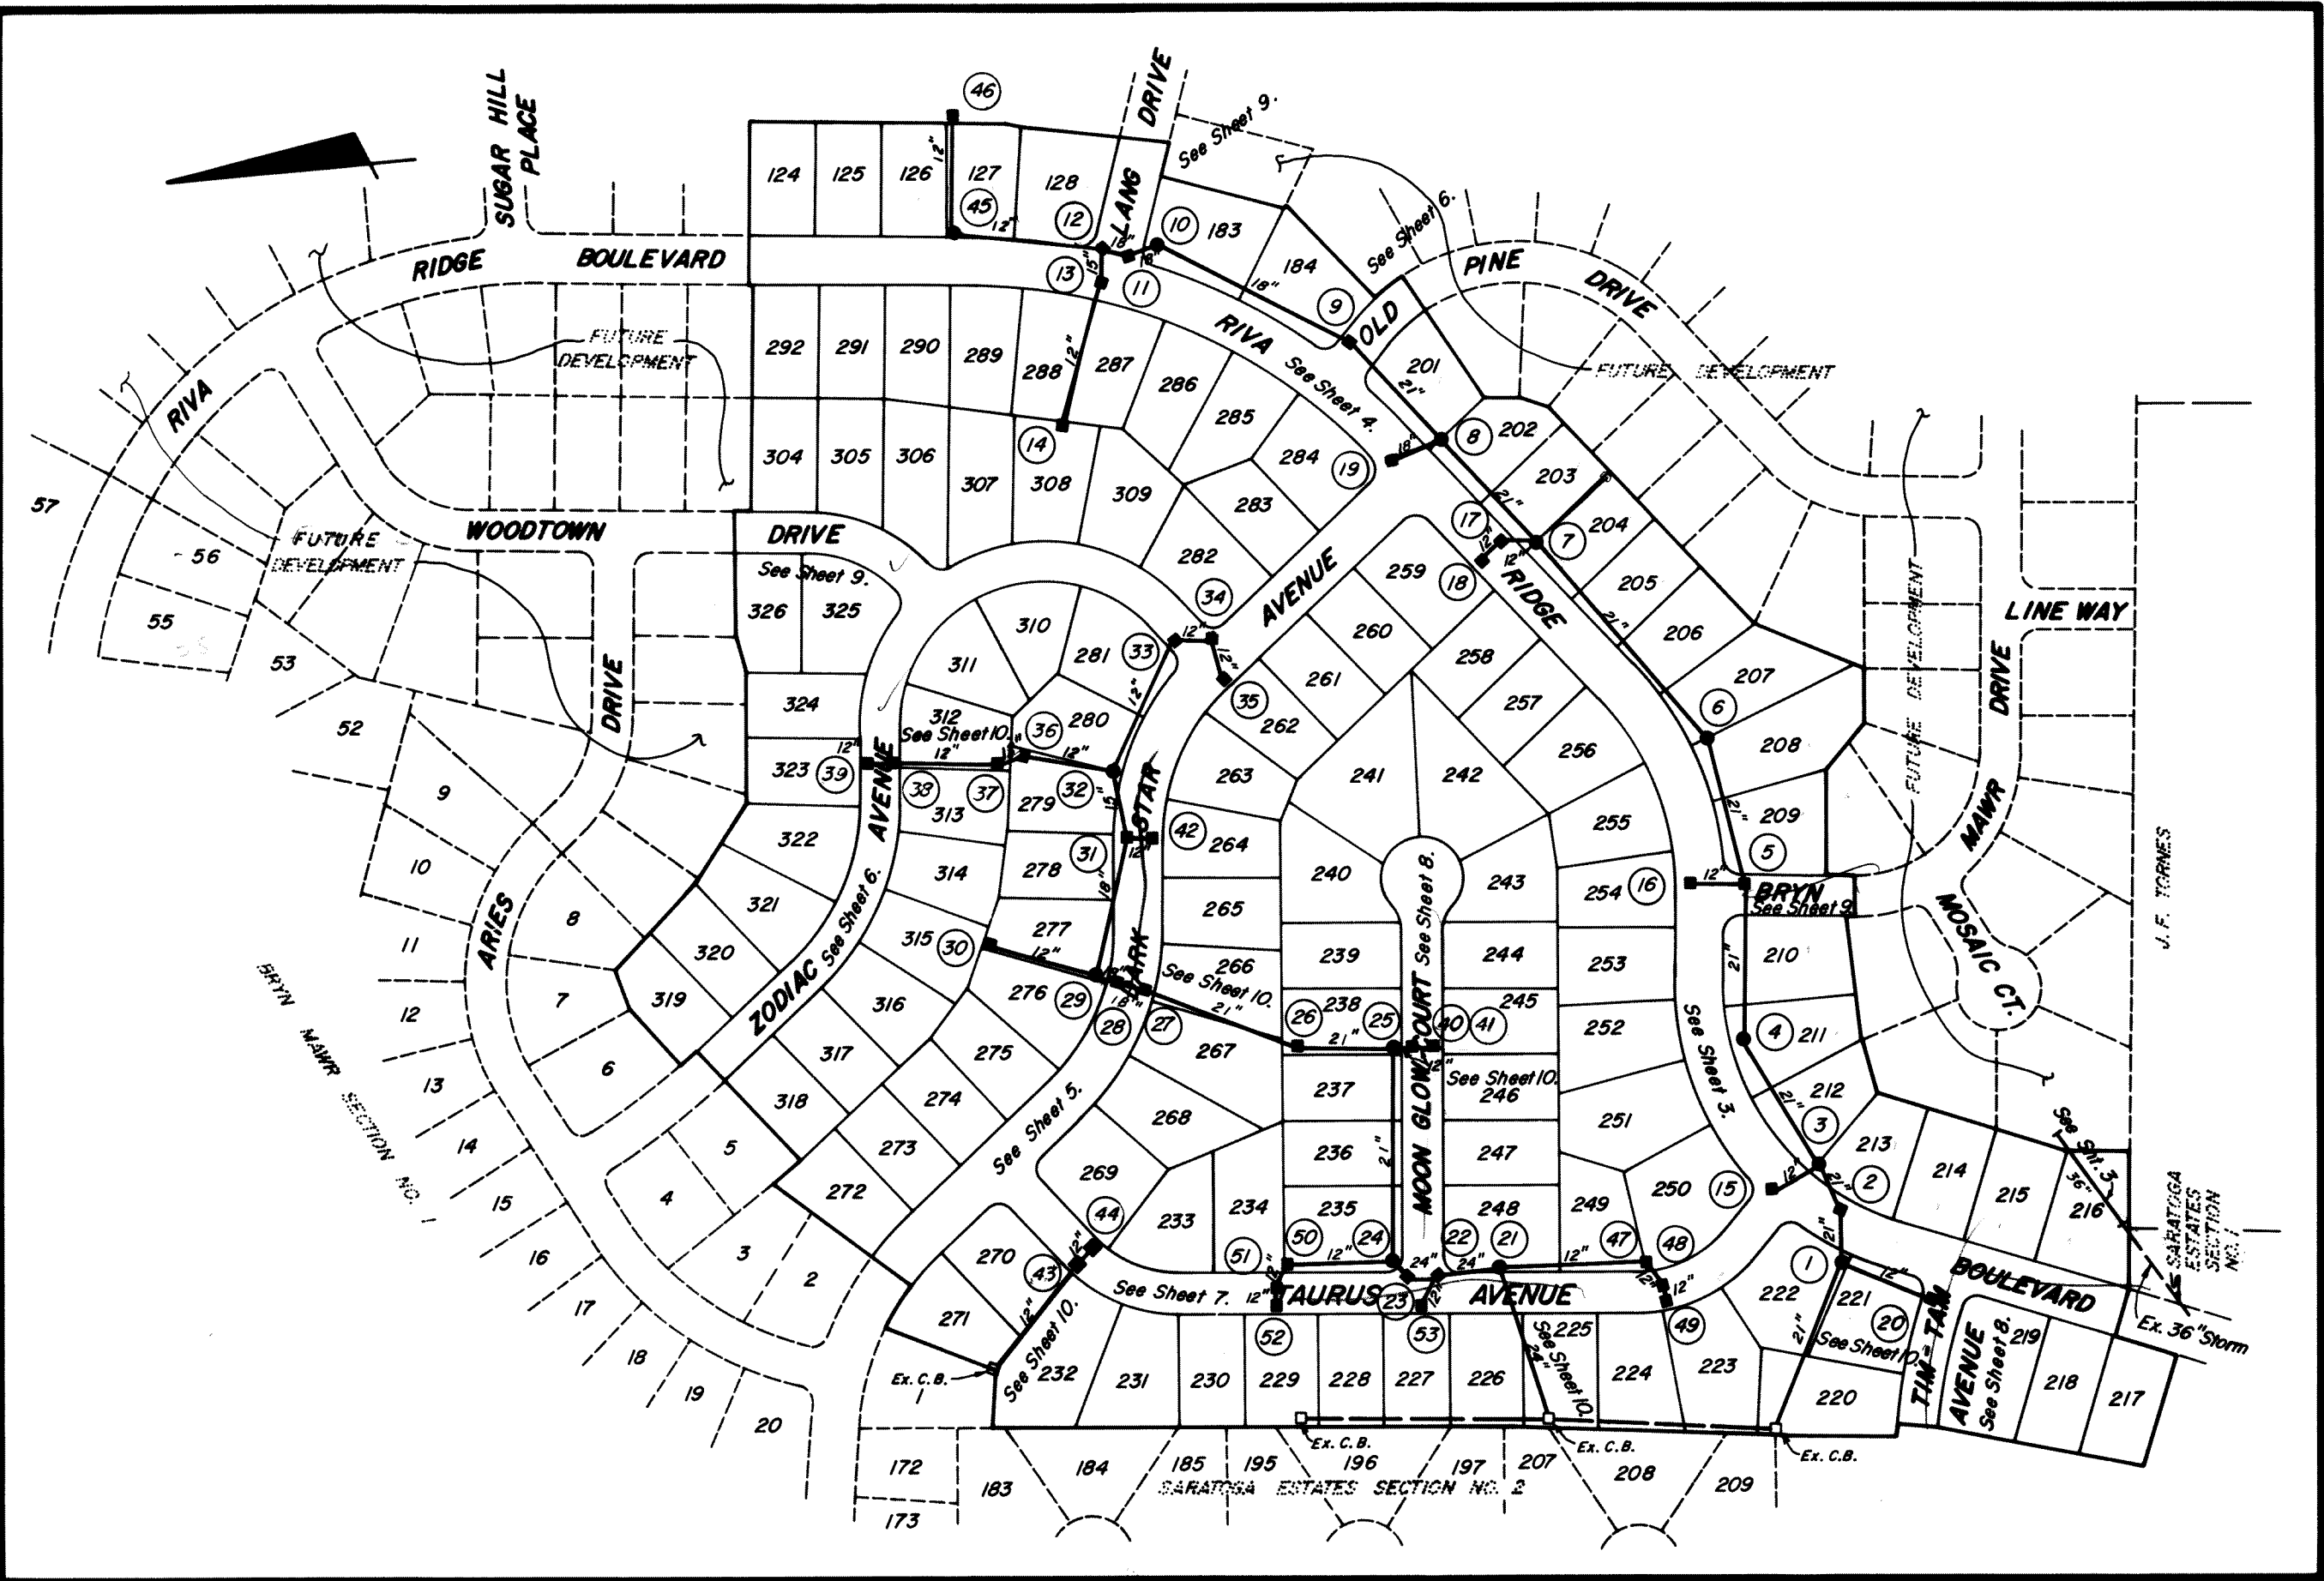

INDEX MAP

SCALE: 1"=200'

BENCH MARKS

N.E. corner of concrete base of street light at N.W. corner of Intersection of Tim-Tam and Venetian Way.
Elev. = 911.34

Spike on north side of 30" Beech Tree about 70' south of E of Riva Ridge station 17+95.
Elev. = 946.44

P.K. Nail in east side of twin 6" maple about 50' west of E of Riva Ridge station 31+90.
Elev. = 954.32

PREPARED BY

EVANS, MECHWART, HAMBLETON & TILTON, INC.

CONSULTING ENGINEERS & SURVEYORS

GAHANNA, OHIO

By *David L. Hussey* 1-20-88
Registered Engineer Date

Revised 5/11/88 Water Main along Riva Ridge Boulevard & Tim-Tam Avenue.

APPROVED BY: *William H. Lechman* 5/14/88
City Engineer Supt. Div. of Water & Sewer

Revised 1/10/89 Relocated Control Site; See Shts. 3 & 4.

ESTIMATE OF QUANTITIES			
ITEM	QUAN.	UNIT	DESCRIPTION
203	17,230	Cu. Yds.	Excavation, including Embankment Construction
305	8,575	Sq. Yds.	7" Portland Cement Concrete Base
305	13,445	Sq. Yds.	8" Portland Cement Concrete Base
402	770	Cu. Yds.	Asphalt Concrete
404	770	Cu. Yds.	Asphalt Concrete
407	2,210	Gals.	Bituminous Tack Coat
605	13,780	Lin. Ft.	4" Shallow Pipe Underdrain
609	7,660	Lin. Ft.	Concrete Combination Curb and Gutter
609	6,120	Lin. Ft.	Concrete Mountable Curb
Special	4	Each	Temporary Barricades
603	455	Lin. Ft.	12" Conduit, Type B, 706.02
603	1,640	Lin. Ft.	12" Conduit Type E, 706.01
603	40	Lin. Ft.	15" Conduit Type B, 706.02
603	75	Lin. Ft.	15" Conduit Type E, 706.01
603	75	Lin. Ft.	18" Conduit Type B, 706.02
603	490	Lin. Ft.	18" Conduit Type E, 706.02
603	90	Lin. Ft.	21" Conduit Type B, 706.02
603	2,040	Lin. Ft.	21" Conduit Type E, 706.02
603	65	Lin. Ft.	24" Conduit Type B, 706.02
603	270	Lin. Ft.	24" Conduit Type E, 706.02
603	145	Lin. Ft.	36" Conduit Type E, 706.02
602	.70	Cu. Yds.	Headwall 4-B (36")
604	13	Each	Manhole, Type A
604	16	Each	Curb and Gutter Inlet (Std. Curb) Cols. AA-S125, Top AA-S128 *
604	16	Each	Curb and Gutter Inlet (Mountable Curb) Cols. AA-S125, Top AA-S129 *
604	7	Each	2'-2" B Catch Basin
604	1	Each	42" Catch Basin (Cols.)
WATER MAIN ITEMS			
3,775	Lin. Ft.	8" Water Main	
3,125	Lin. Ft.	6" Water Main	
340	Lin. Ft.	2" Water Main	
1	Each	2" Valve and Box	
5	Each	8" Valve and Box	
24	Each	6" Valve and Box	
67	Each	3/4" Water Services (Short)	
50	Each	3/4" Water Services (Long)	
16	Each	Fire Hydrant	
4	Each	3/4" Water Services Tapped into Existing Water Main (Short)	
2	Each	3/4" Water Services Tapped into Existing Water Main (Long)	
Lump	Lump Sum	21 Street Lighting System & 1 Control Site	

Signatures below signify only concurrence with the general purpose of this project. All technical details are the responsibility of Evans, Mechwart, Hambleton & Tilton, Inc., Consulting Engineers and Surveyors.

Spencer M. Bots 7-26-88
City Engineer, City of Gahanna, Ohio Date












James B. ... 2/8/88
Superintendent, Division of Water & Sewer, City of Gahanna, Ohio Date

Robert ... 2-9-88
Superintendent, Division of Streets, City of Gahanna, Ohio Date

William H. Lechman 2-9-88
Director of Public Service, City of Gahanna, Ohio Date

John ... 2-9-88
Director of Finance, City of Gahanna, Ohio Date

James F. ... 2-25-88
Mayor, City of Gahanna, Ohio Date

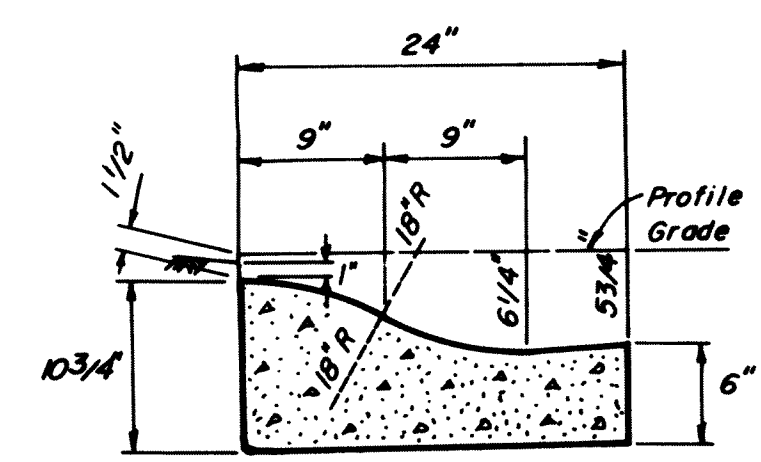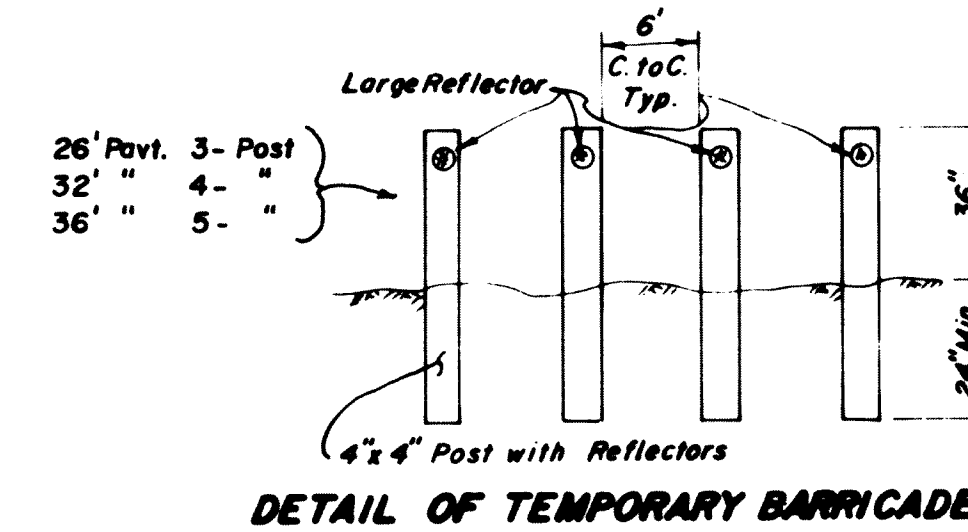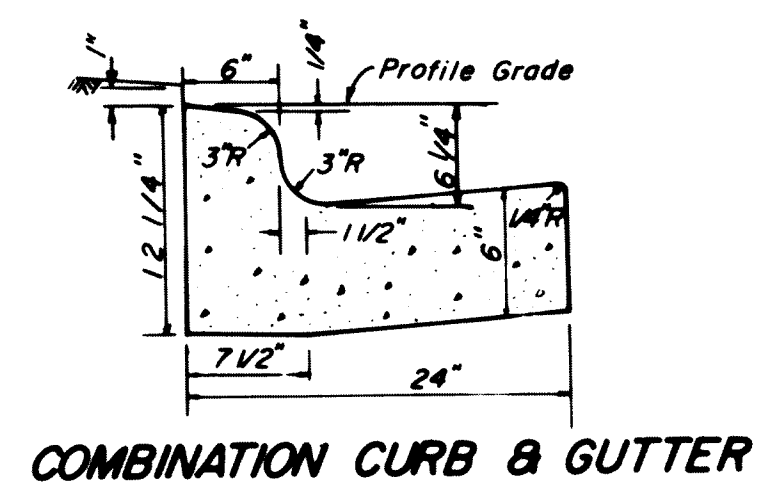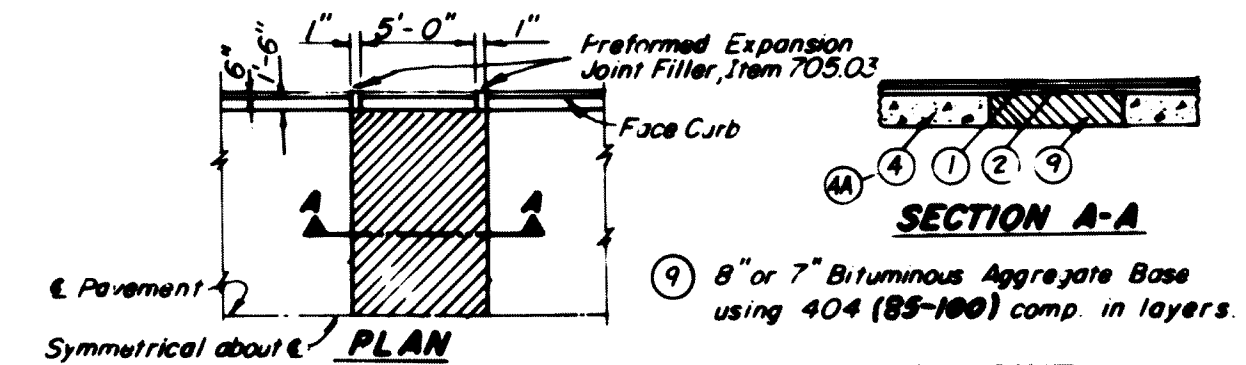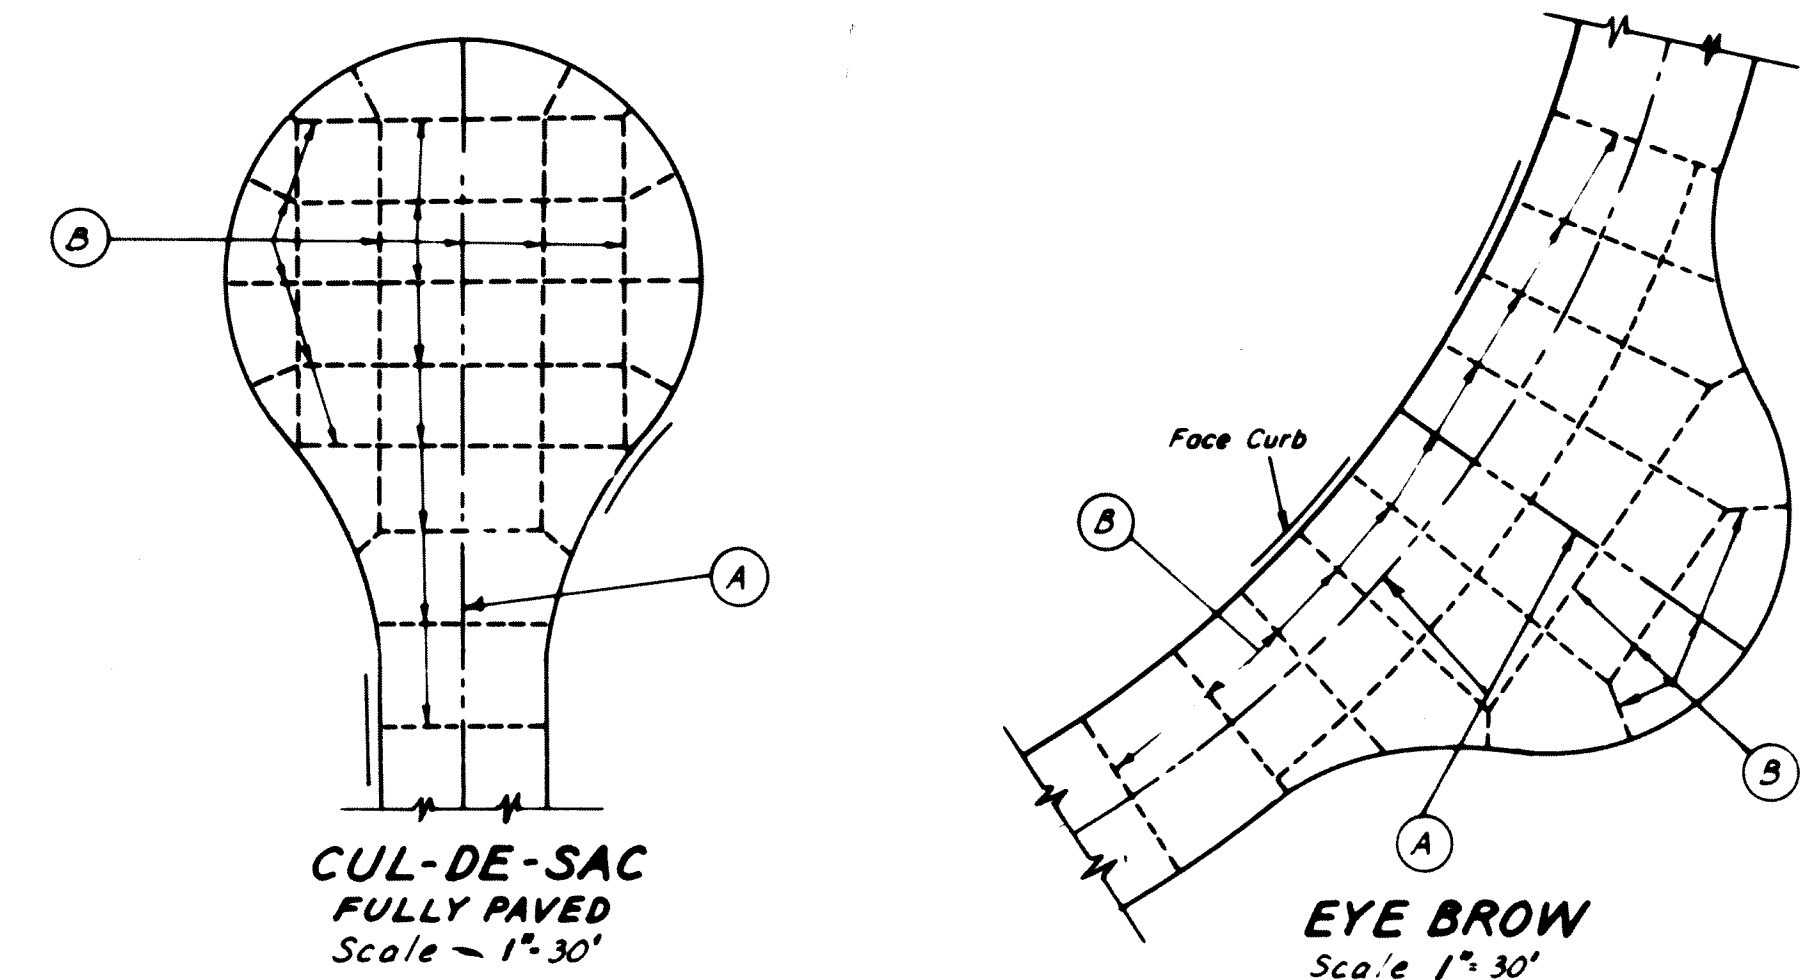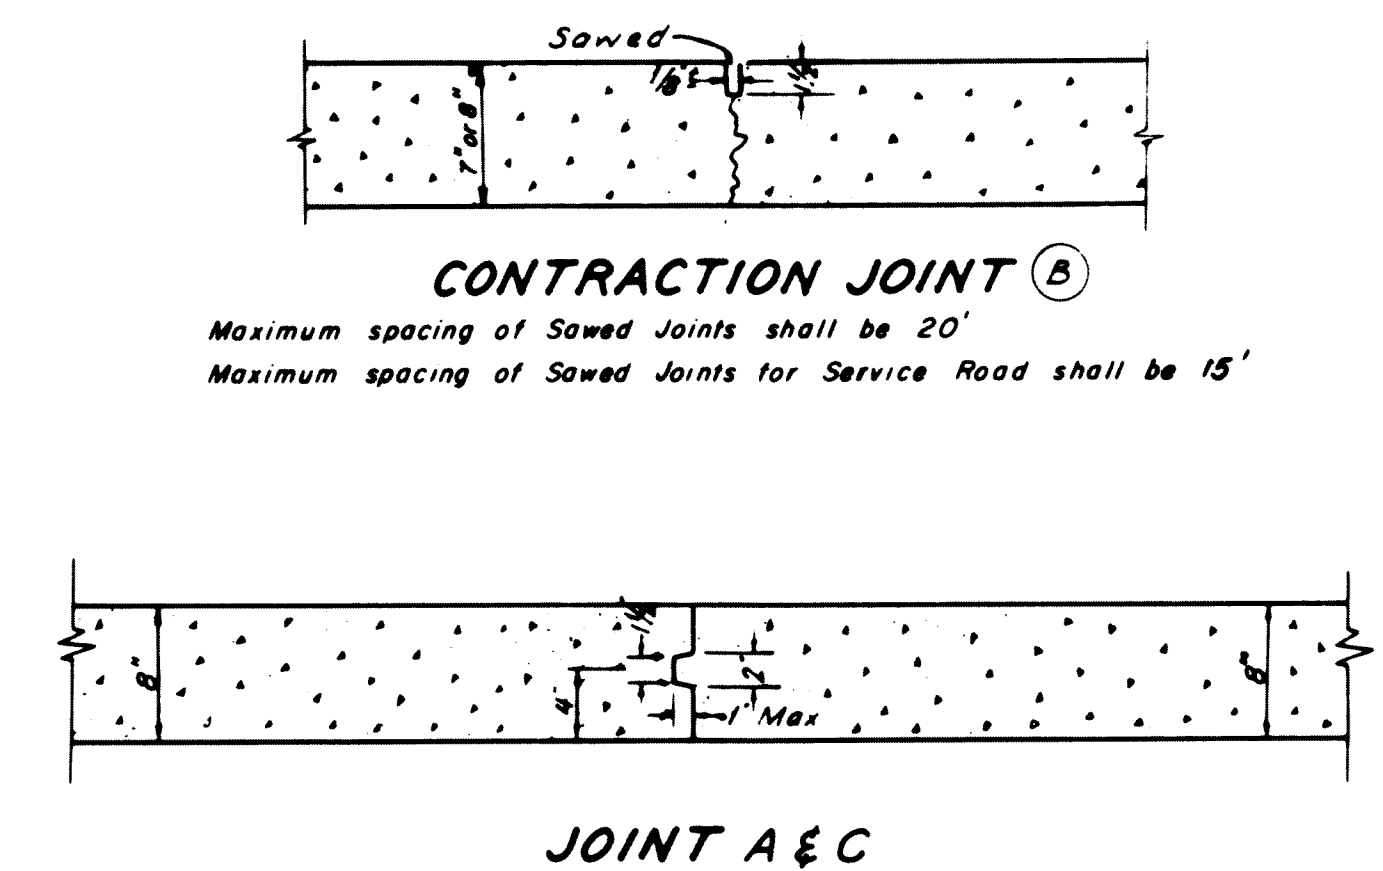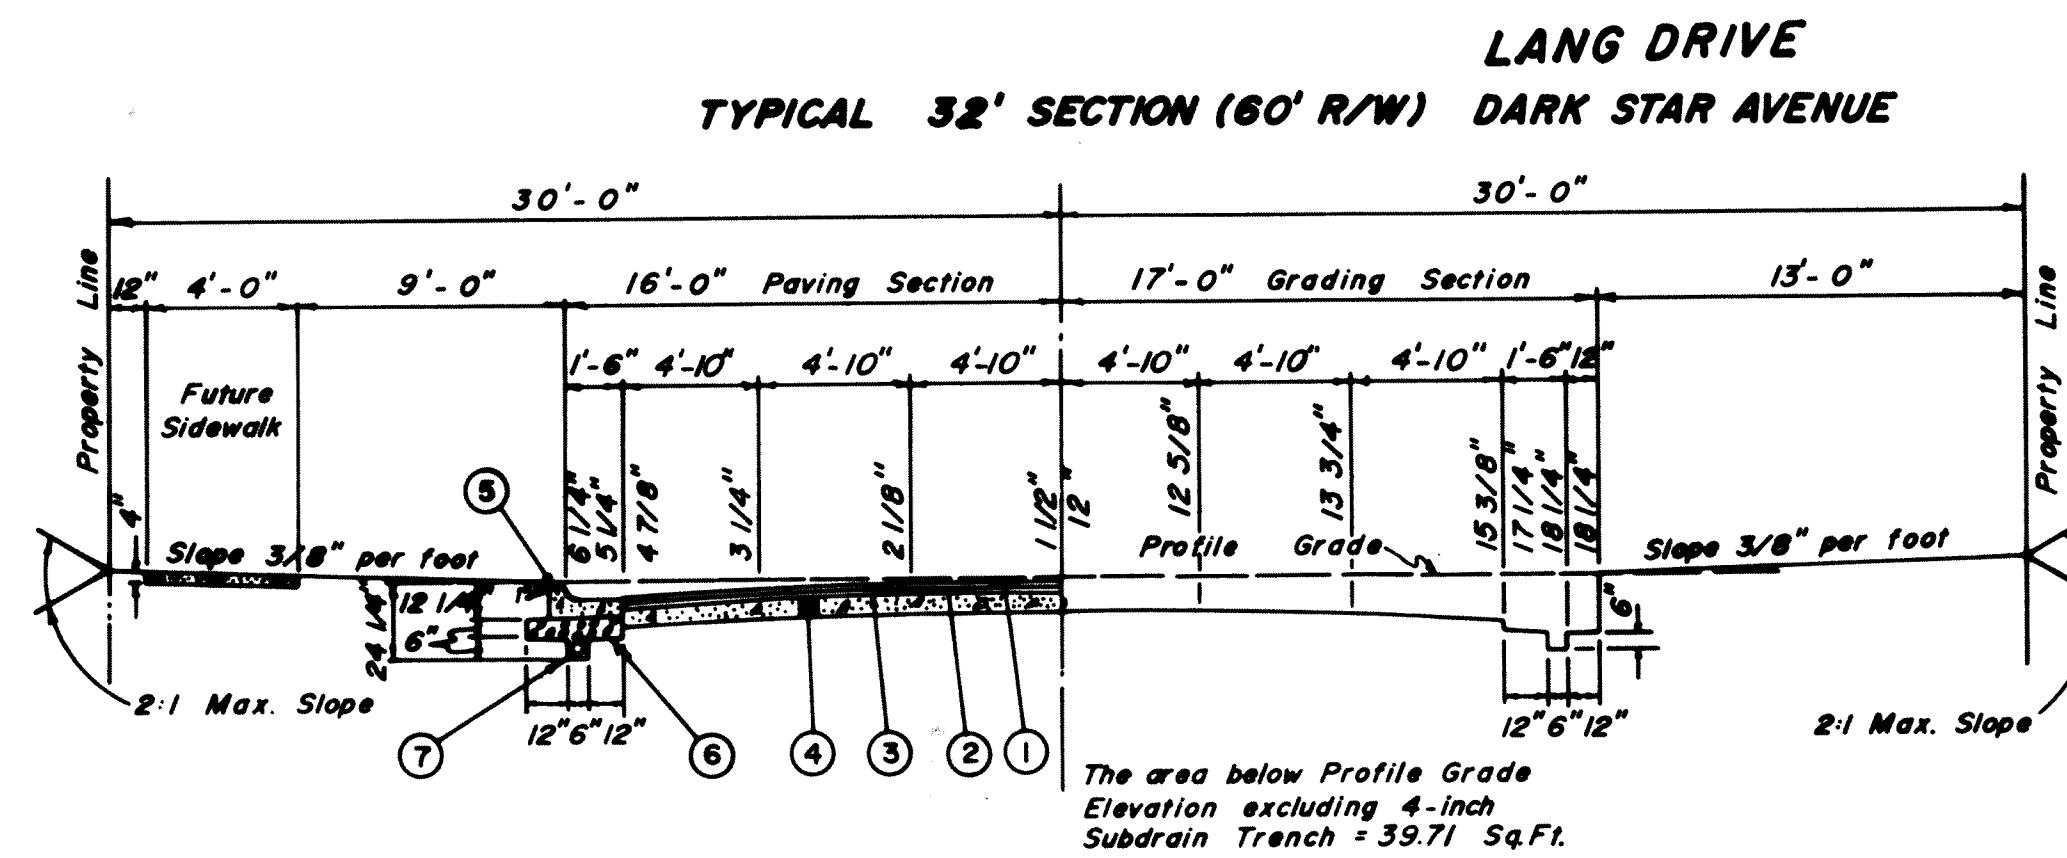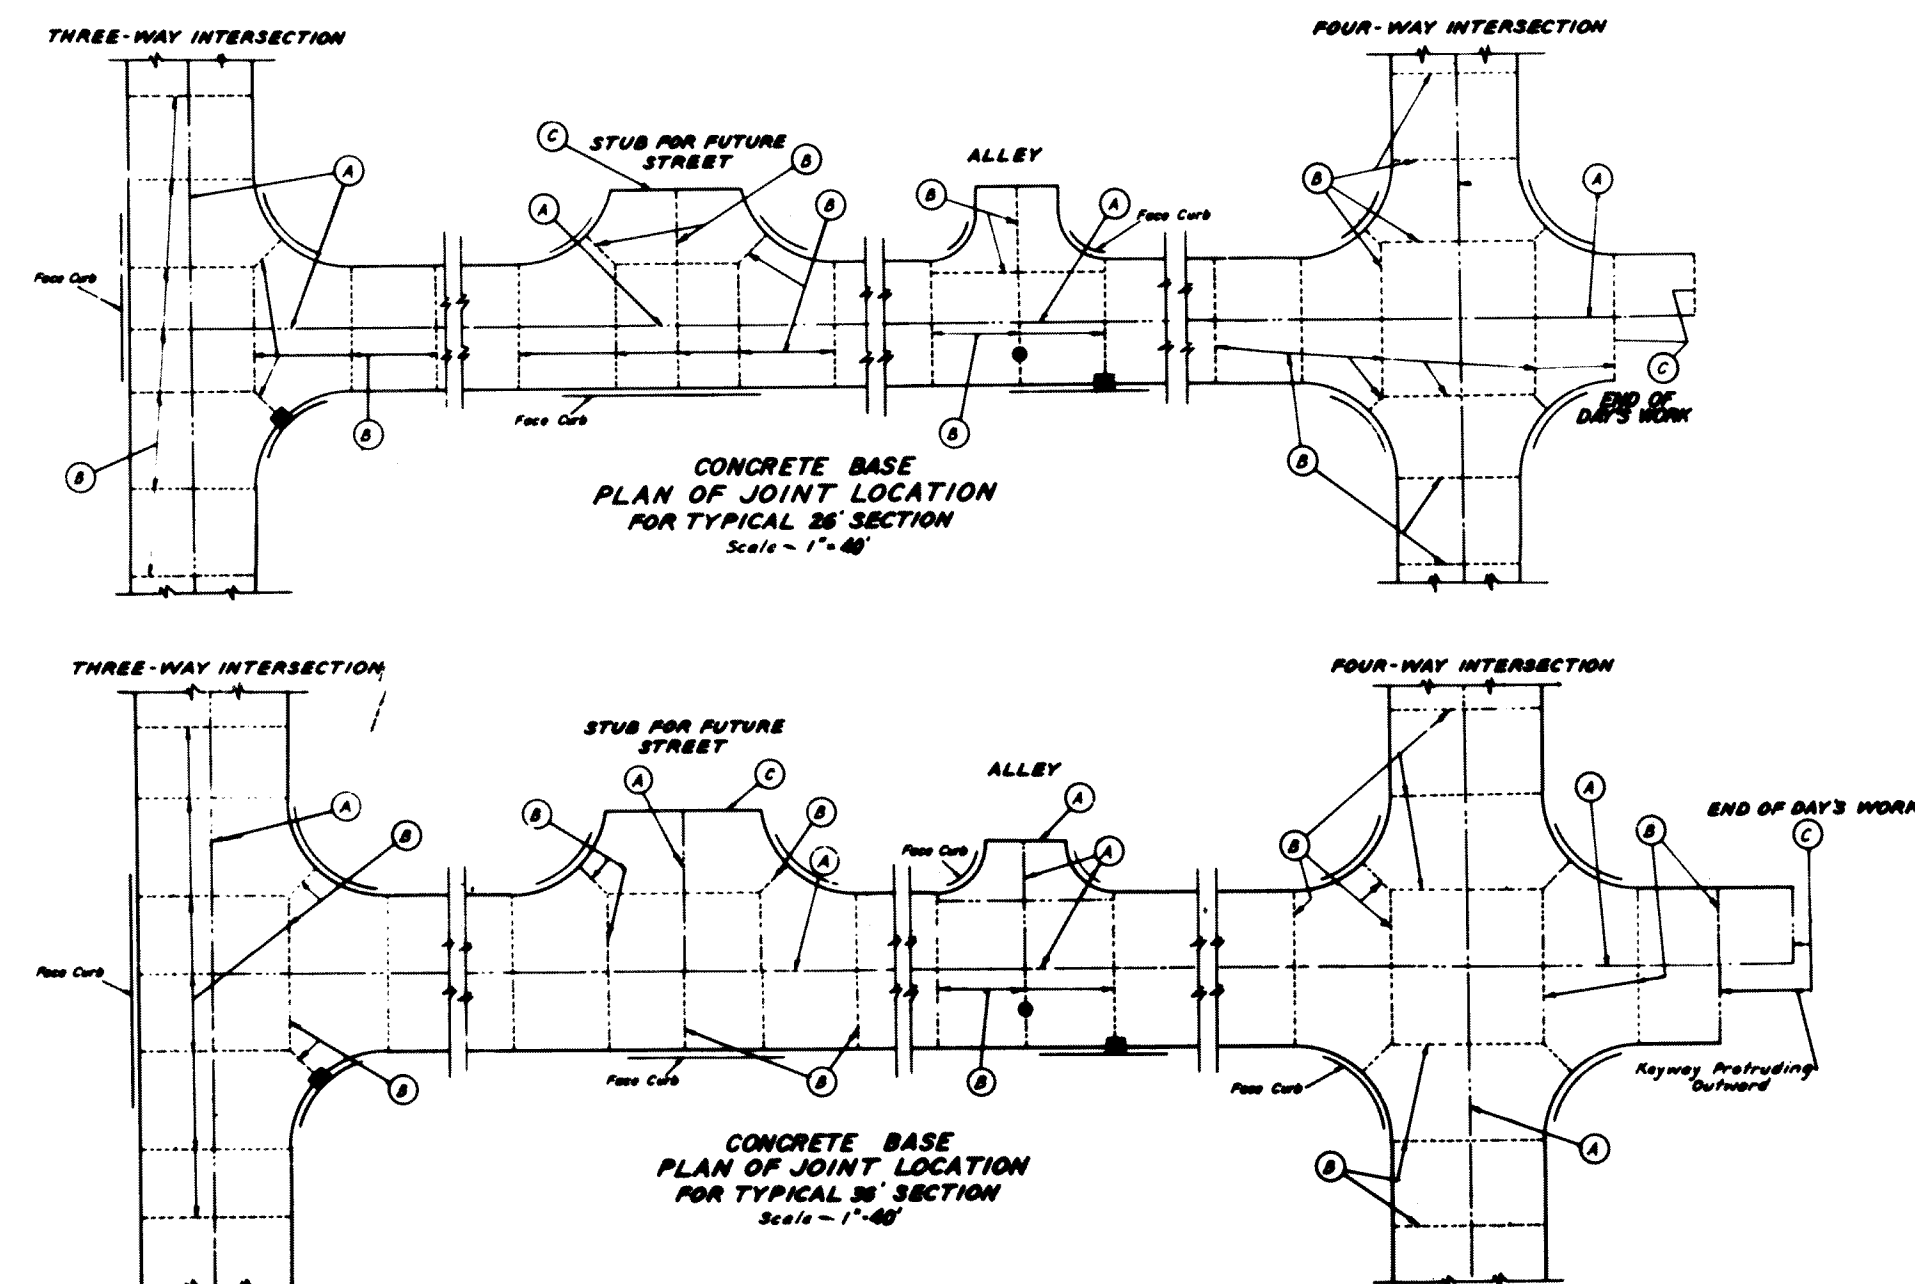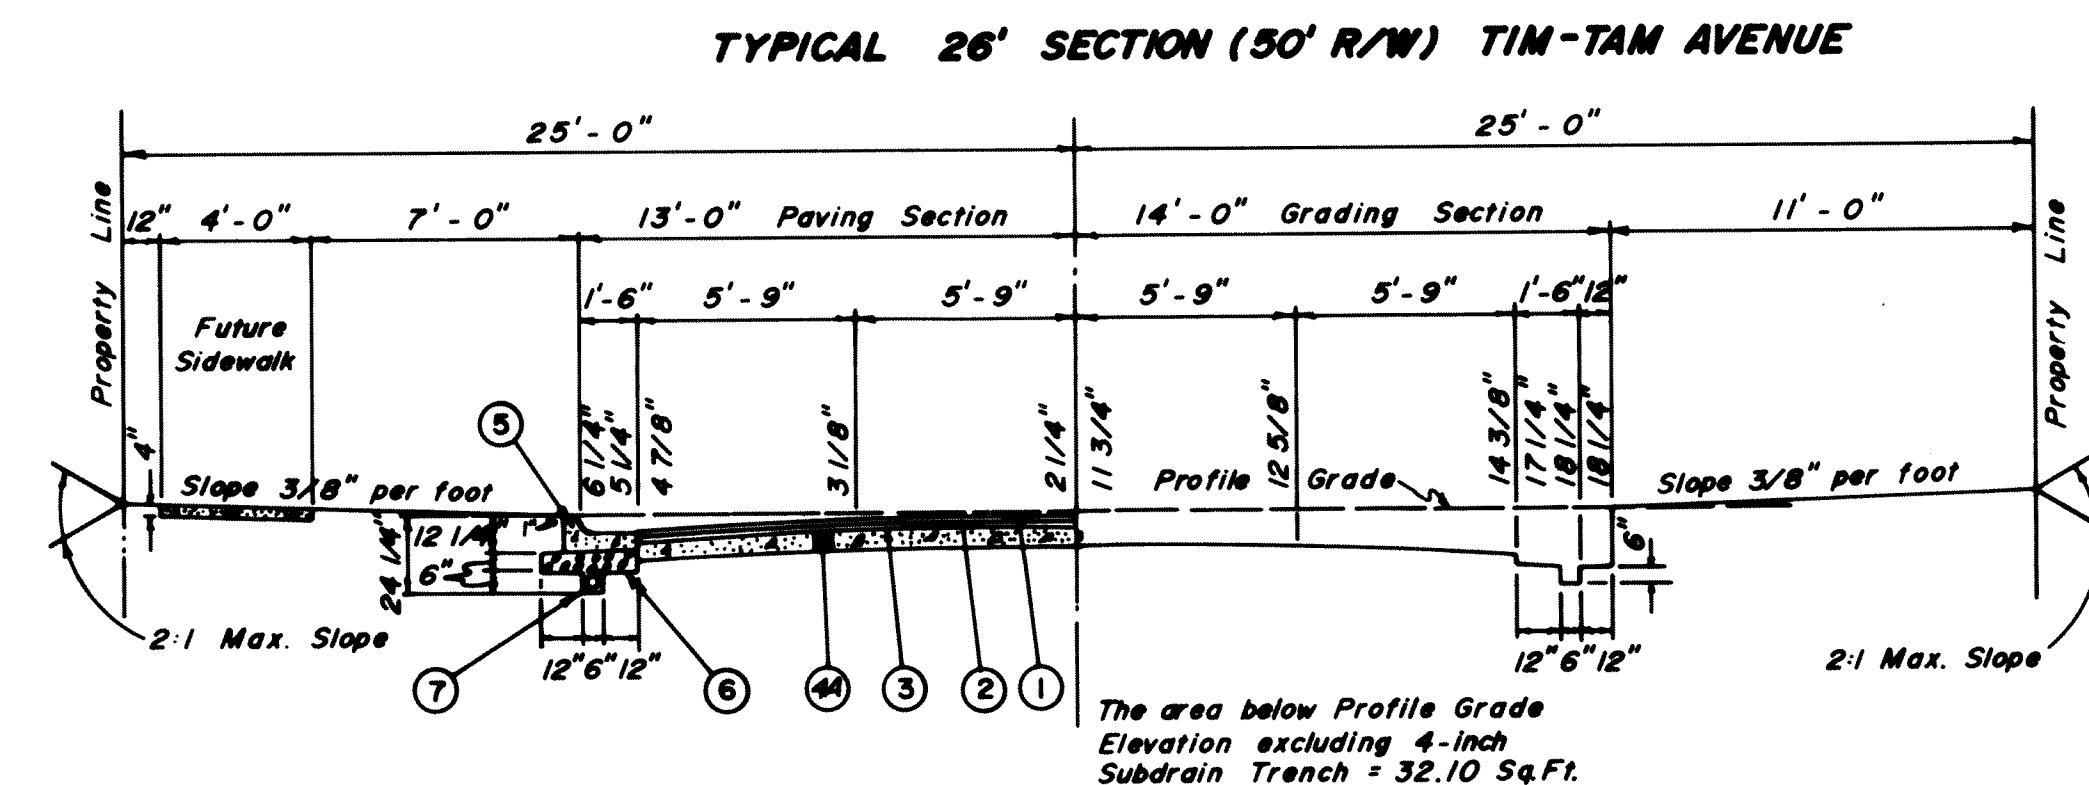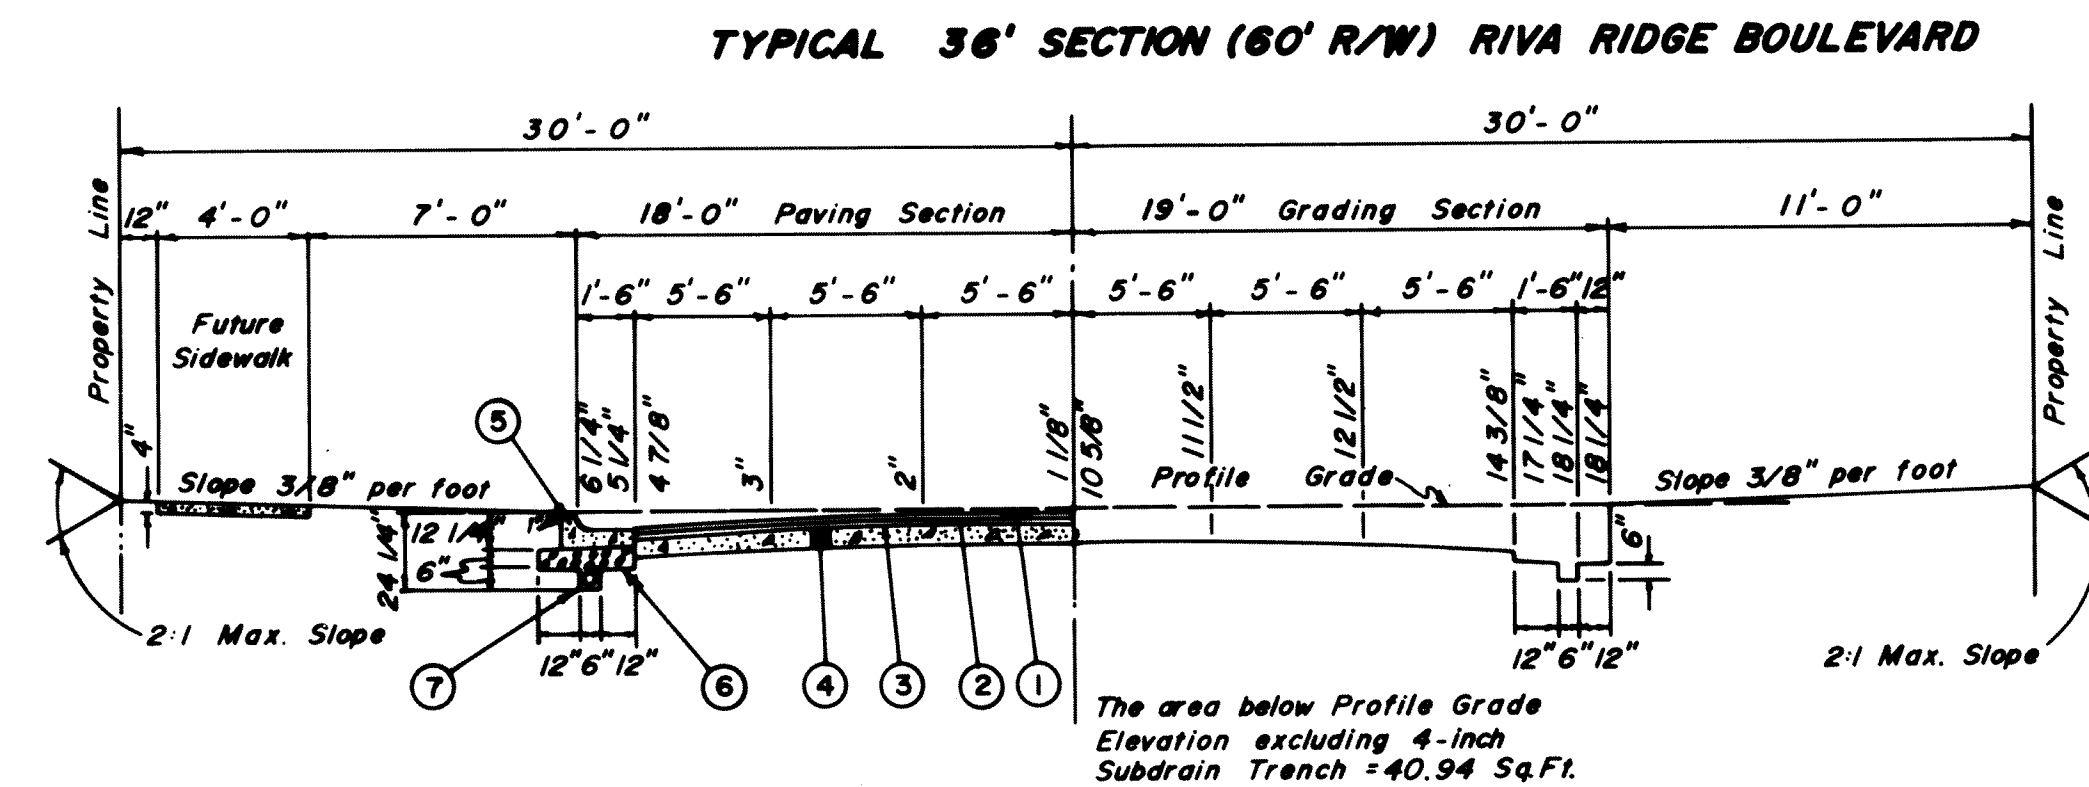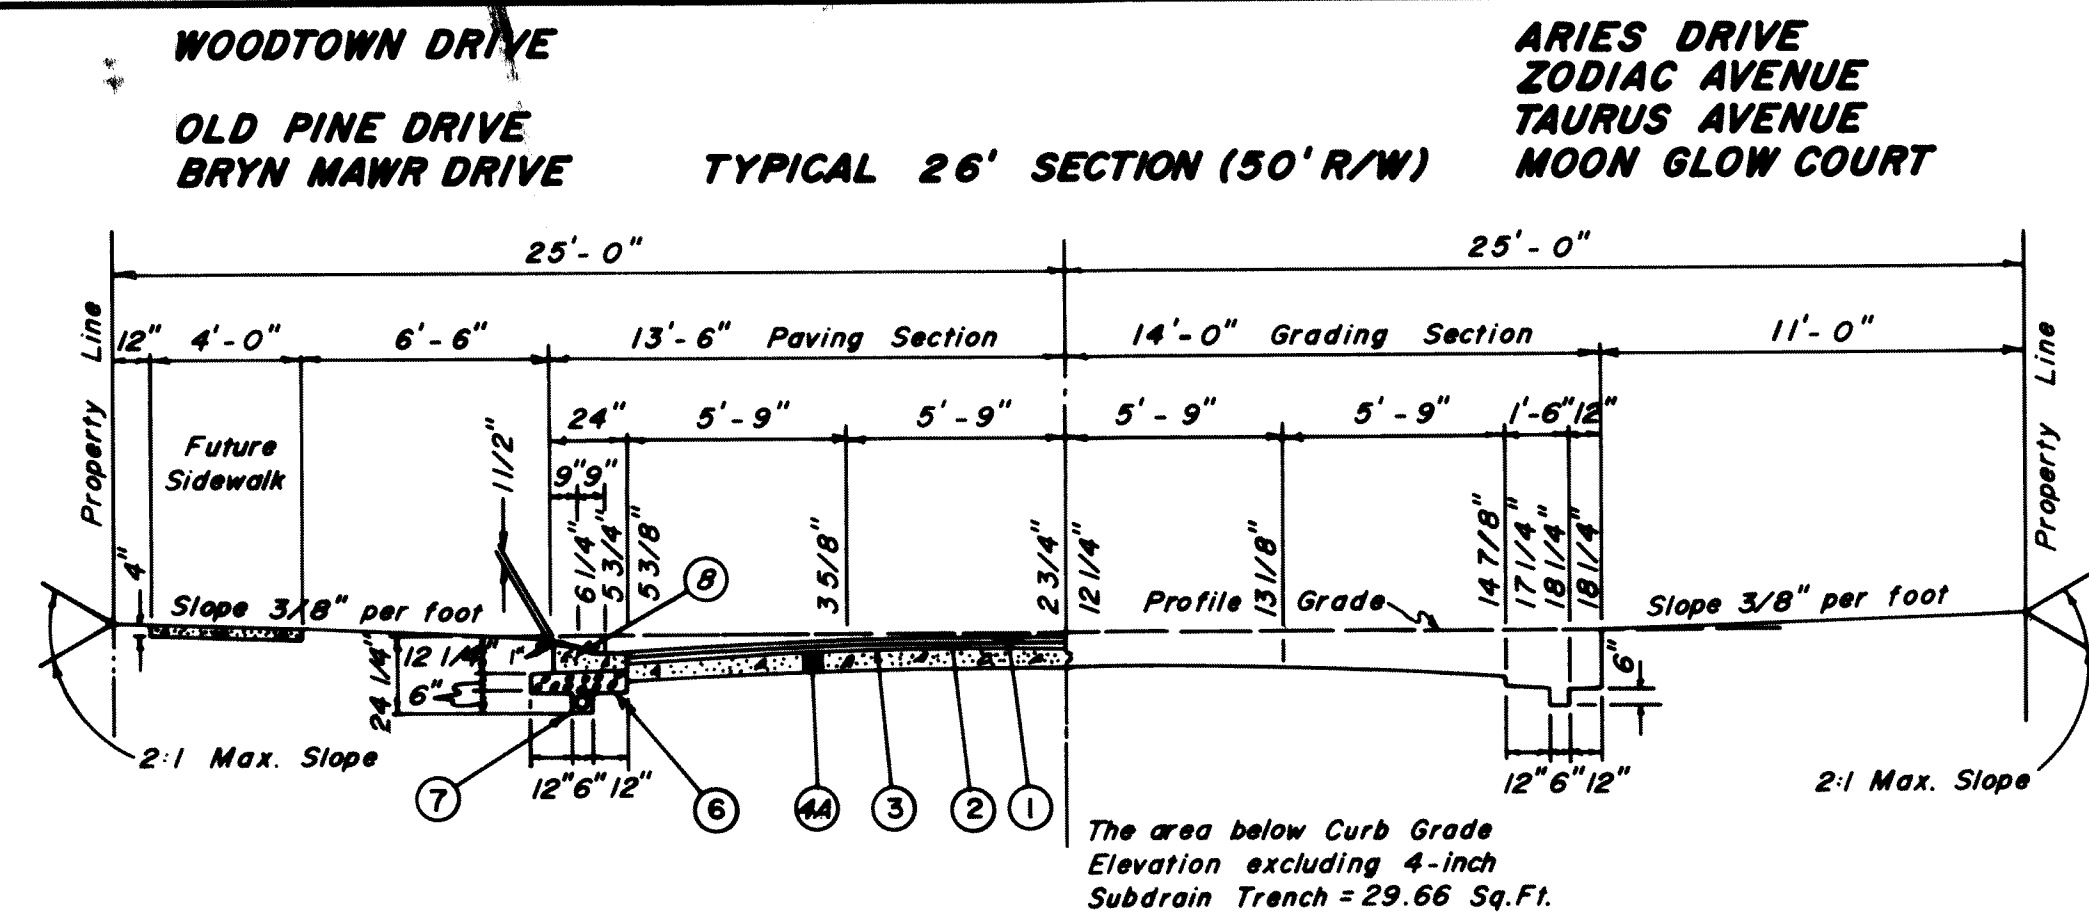

The Specifications of the State of Ohio, Department of Transportation, including all supplements thereto, in force on date of contract, together with the requirements of the City of Gahanna shall govern all materials and workmanship involved in construction.

All item numbers are in accordance with the Ohio Department of Transportation, modified as noted.

1 1/4" Hot-Mixed, Hot-Laid Asphalt Concrete, Item 404 (85-100) with Modification to State Highway Specifications Asphalt Concrete shall contain all crushed Aggregate. Joints for Asphalt Concrete shall be staggered.

1 1/4" Hot-Mixed, Hot-Laid Asphalt Concrete, Item 402 (85-100).

8" Portland Cement Concrete Base, Item 305 modified as follows, City of Gahanna, Class E Concrete, 510 lbs. Portland Cement per cubic yard, 3% to 5% Air Entrainment and 3" max. slump. (This item also conforms to City of Columbus Construction & Material Specification Item 305.) The use of an approved single beam vibrating screen will be required and Transverse Contraction Joints shall be sawed as per this plan.

7" Portland Cement Concrete Base, Item 305 modified as follows, City of Gahanna, Class B Concrete, 380 lbs. Portland Cement per cubic yard, 3% to 5% Air Entrainment and 4.5" max. slump. (This item also conforms to City of Columbus Construction & Material Specification, Item 306.) The use of an approved single beam vibrating screen will be required and Transverse Contraction Joints shall be sawed as per this plan.

Centerline Joint for concrete pavement base shall be sawed if pavement base is constructed full width.

A subgrade planer or an automatic subgrader will not be required.

Concrete Combined Curb & Gutter, Item 609, modified as follows, City of Gahanna, Class F Concrete, 560 lbs. Portland Cement per cubic Yard, 4% to 8% Air Entrainment and 3" max. slump.

No. 46 Aggregate.

4" Pipe Underdrain, Item 605.

4" Pipe Underdrain, Item 605.

Mountable Curb, Item 609, Concrete, Item 499, modified as follows, City of Gahanna, Class F Concrete, 560 lbs. Portland Cement per cubic yard, 4% to 8% Air Entrainment and 3" max. slump.

Sidewalks and Drive Ramps, Item 608, Concrete, Item 499, modified as follows, City of Gahanna, Class F, 560 lbs. Portland Cement per cubic yard, 4% to 8% Air Entrainment and 4" max. slump.

Curing Material shall conform to 705.07, Type 2, and shall be applied with a motor driven pump sprayer.

Sidewalk location shall be determined by the City Engineer.

When the pavement design shown on the typical sections is not adequate for contemplated heavier load requirements, the proposed street sections shall be designed in accordance and agreement with the City Engineer.

In the event excavation for the street is from 0" to 6" below that called for on the plans, the Contractor shall replace this excess excavation material with compacted 46D crushed aggregate as directed, and at no extra cost to the Owner.

Mountable Curb may be used on 26' Residential Streets, subject to approval by the City Engineer. All other streets shall be built using combined curb and gutter.

All curb drain openings to be drilled by builder at time of construction of each house, including mountable curb.

CITY OF GAHANNA, OHIO

STANDARD CONSTRUCTION DRAWING


CONSTRUCTION DETAILS FOR ASPHALT CONCRETE ON P.C. CONCRETE BASE

Approved: *William B. Parker*
 CITY ENGINEER, GAHANNA OHIO


Richard V. Warren
 DIRECTOR OF PUBLIC SERVICE, GAHANNA OHIO

DATE: *2/10*

Revised as Constructed 8-8-88

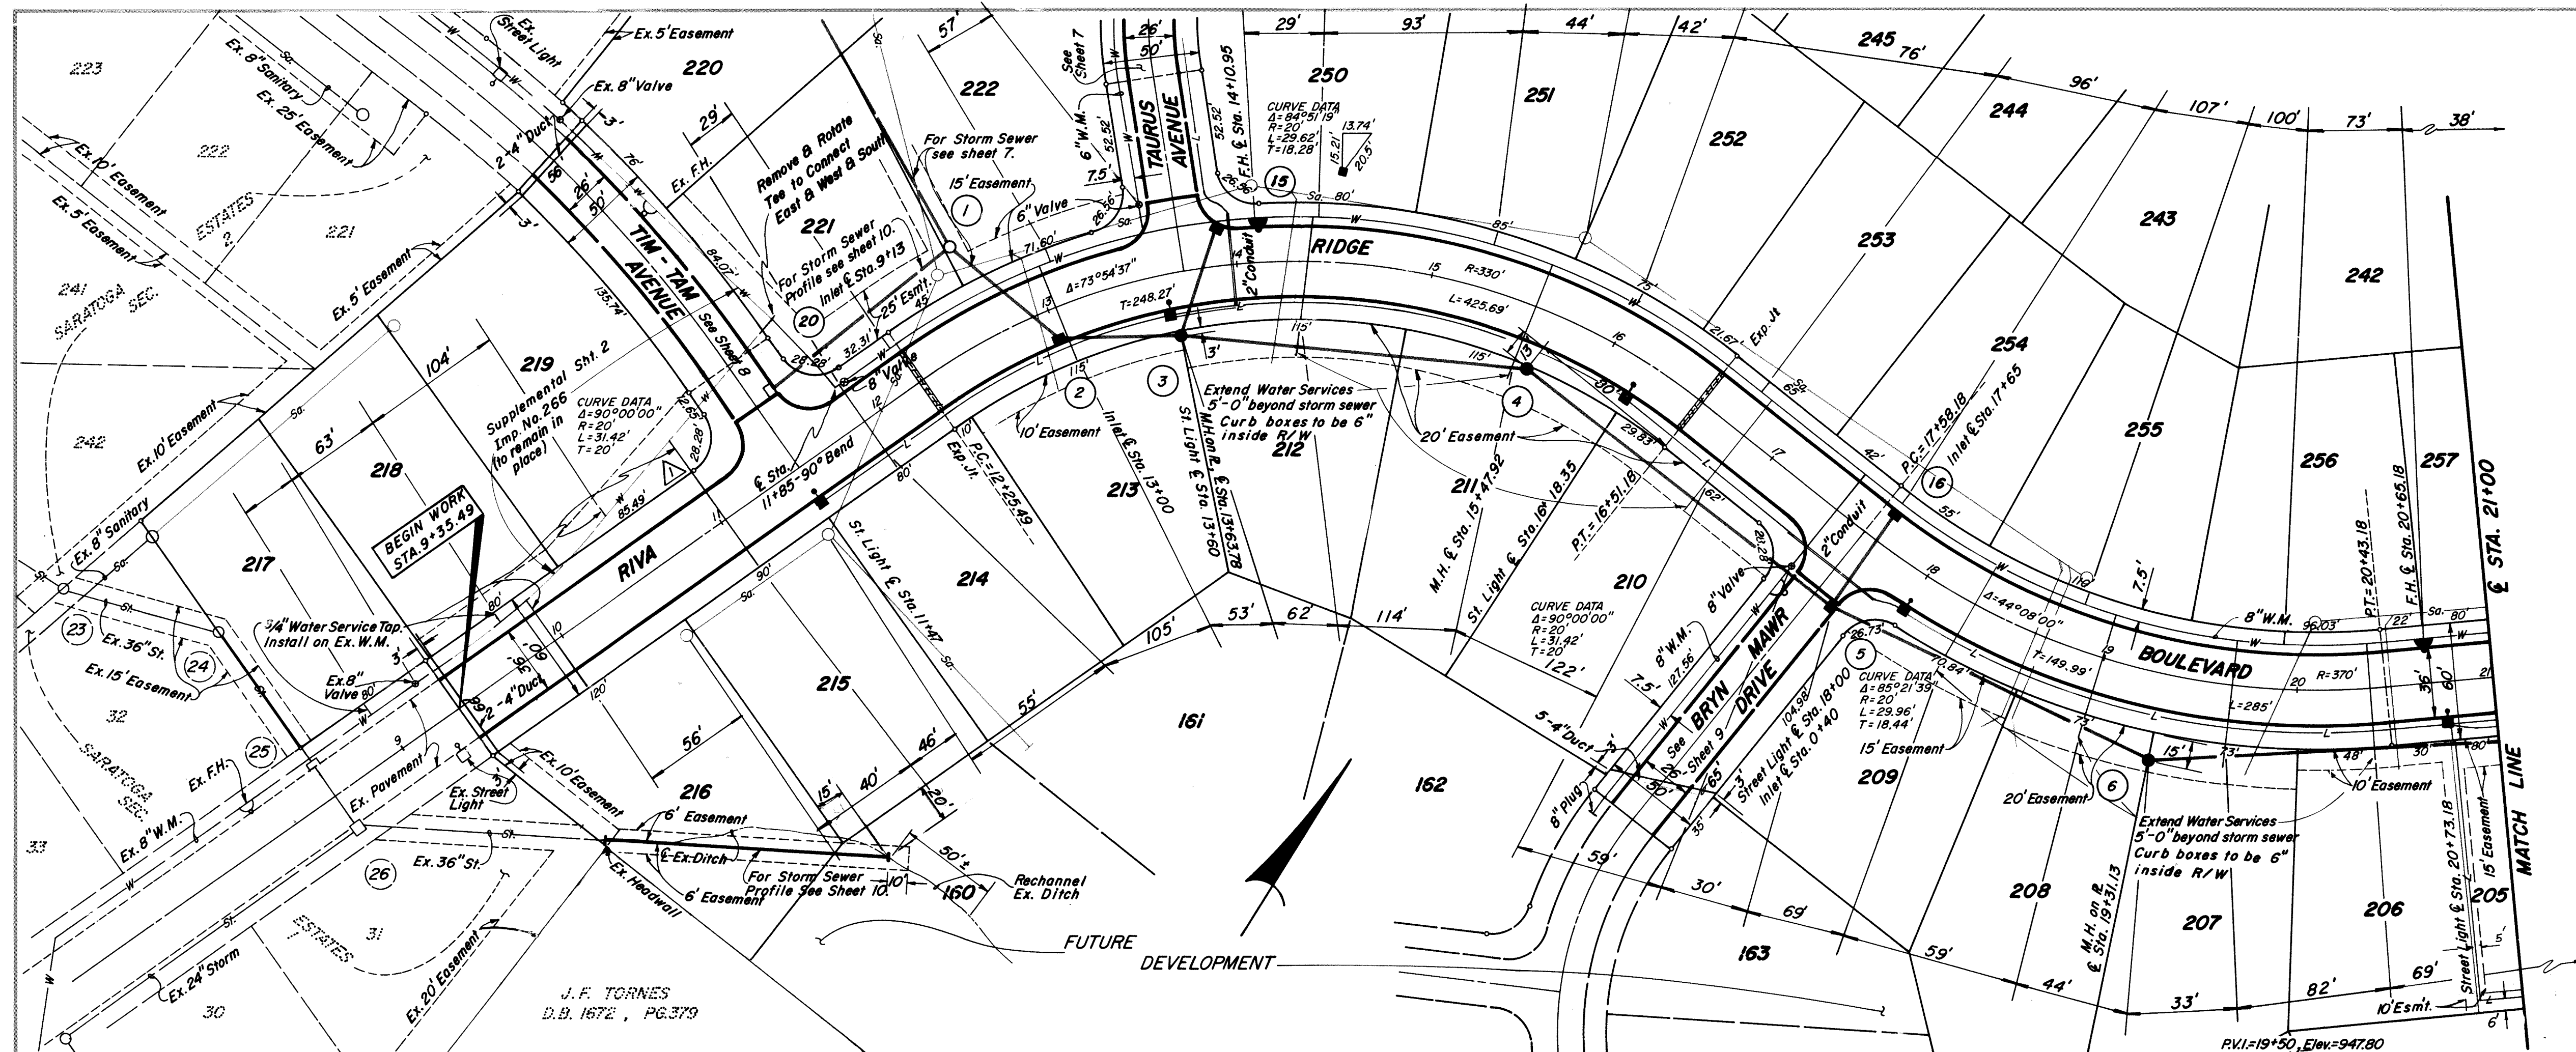

x = Ex. Ground @ Left B/L
o = Ex. Ground @ Right B/L

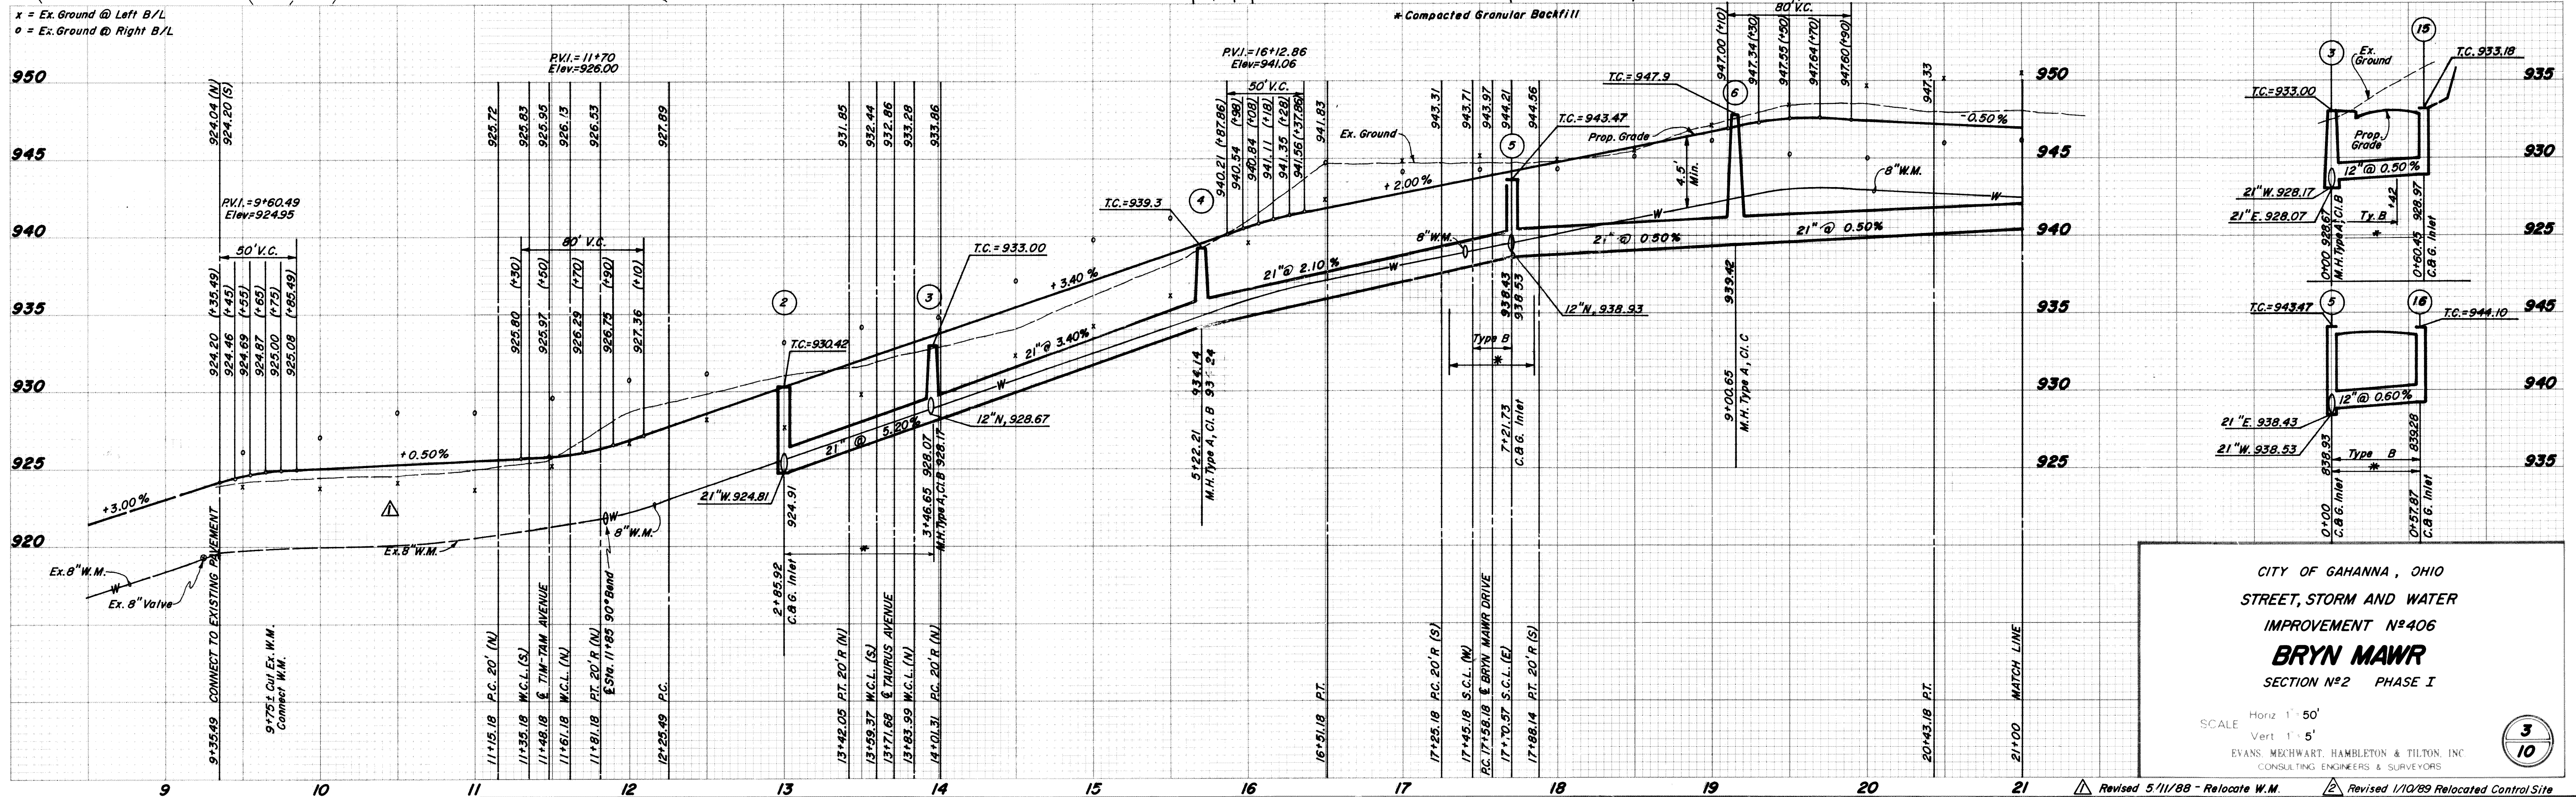



CITY OF GAHANNA, OHIO
STREET, STORM AND WATER
IMPROVEMENT N°406
BRYN MAWR
SECTION N°2 PHASE I

SCALE Horiz 1" = 50'
Vert 1" = 5'
EVANS MECHWART, HAMBLETON & TILTON, INC.
CONSULTING ENGINEERS & SURVEYORS

Revised As Constructed 8-8-88

Revised 5/11/88 - Relocate W.M.
Revised 1/10/89 Relocated Control Site

3
10

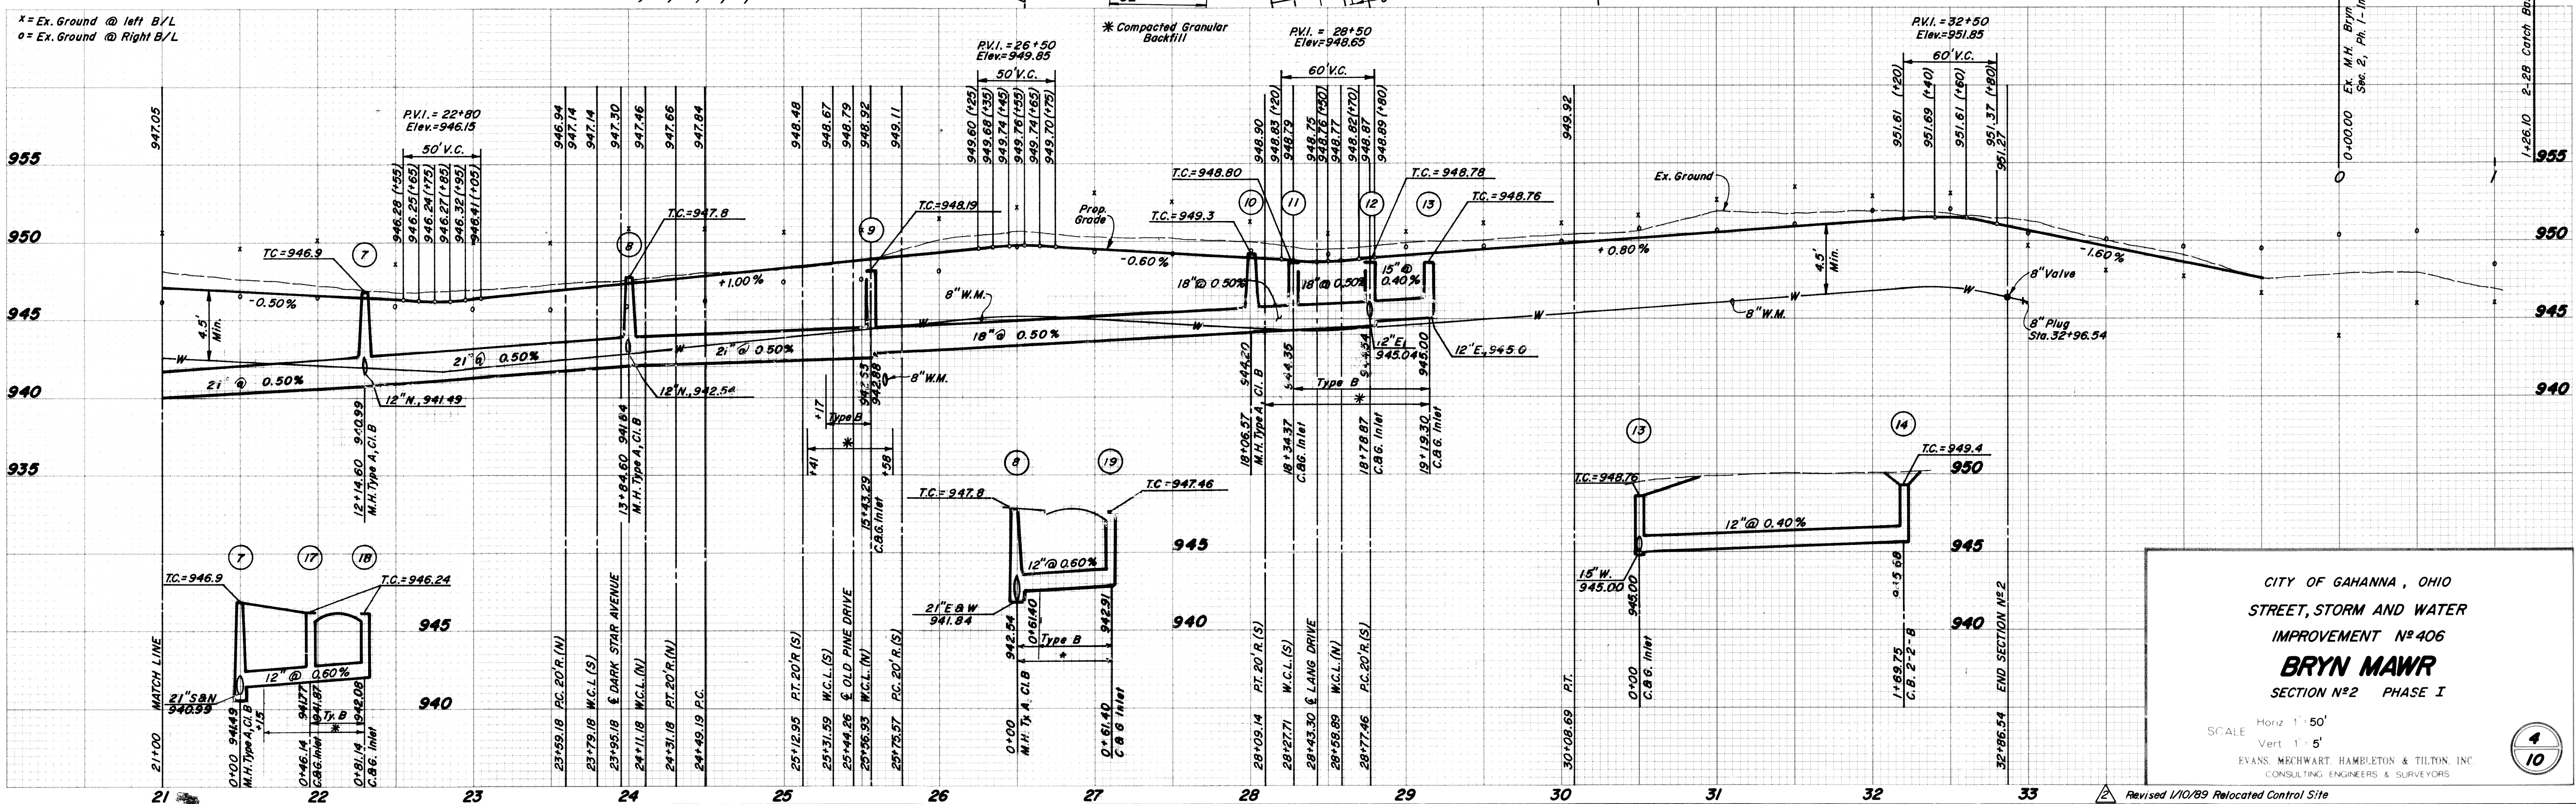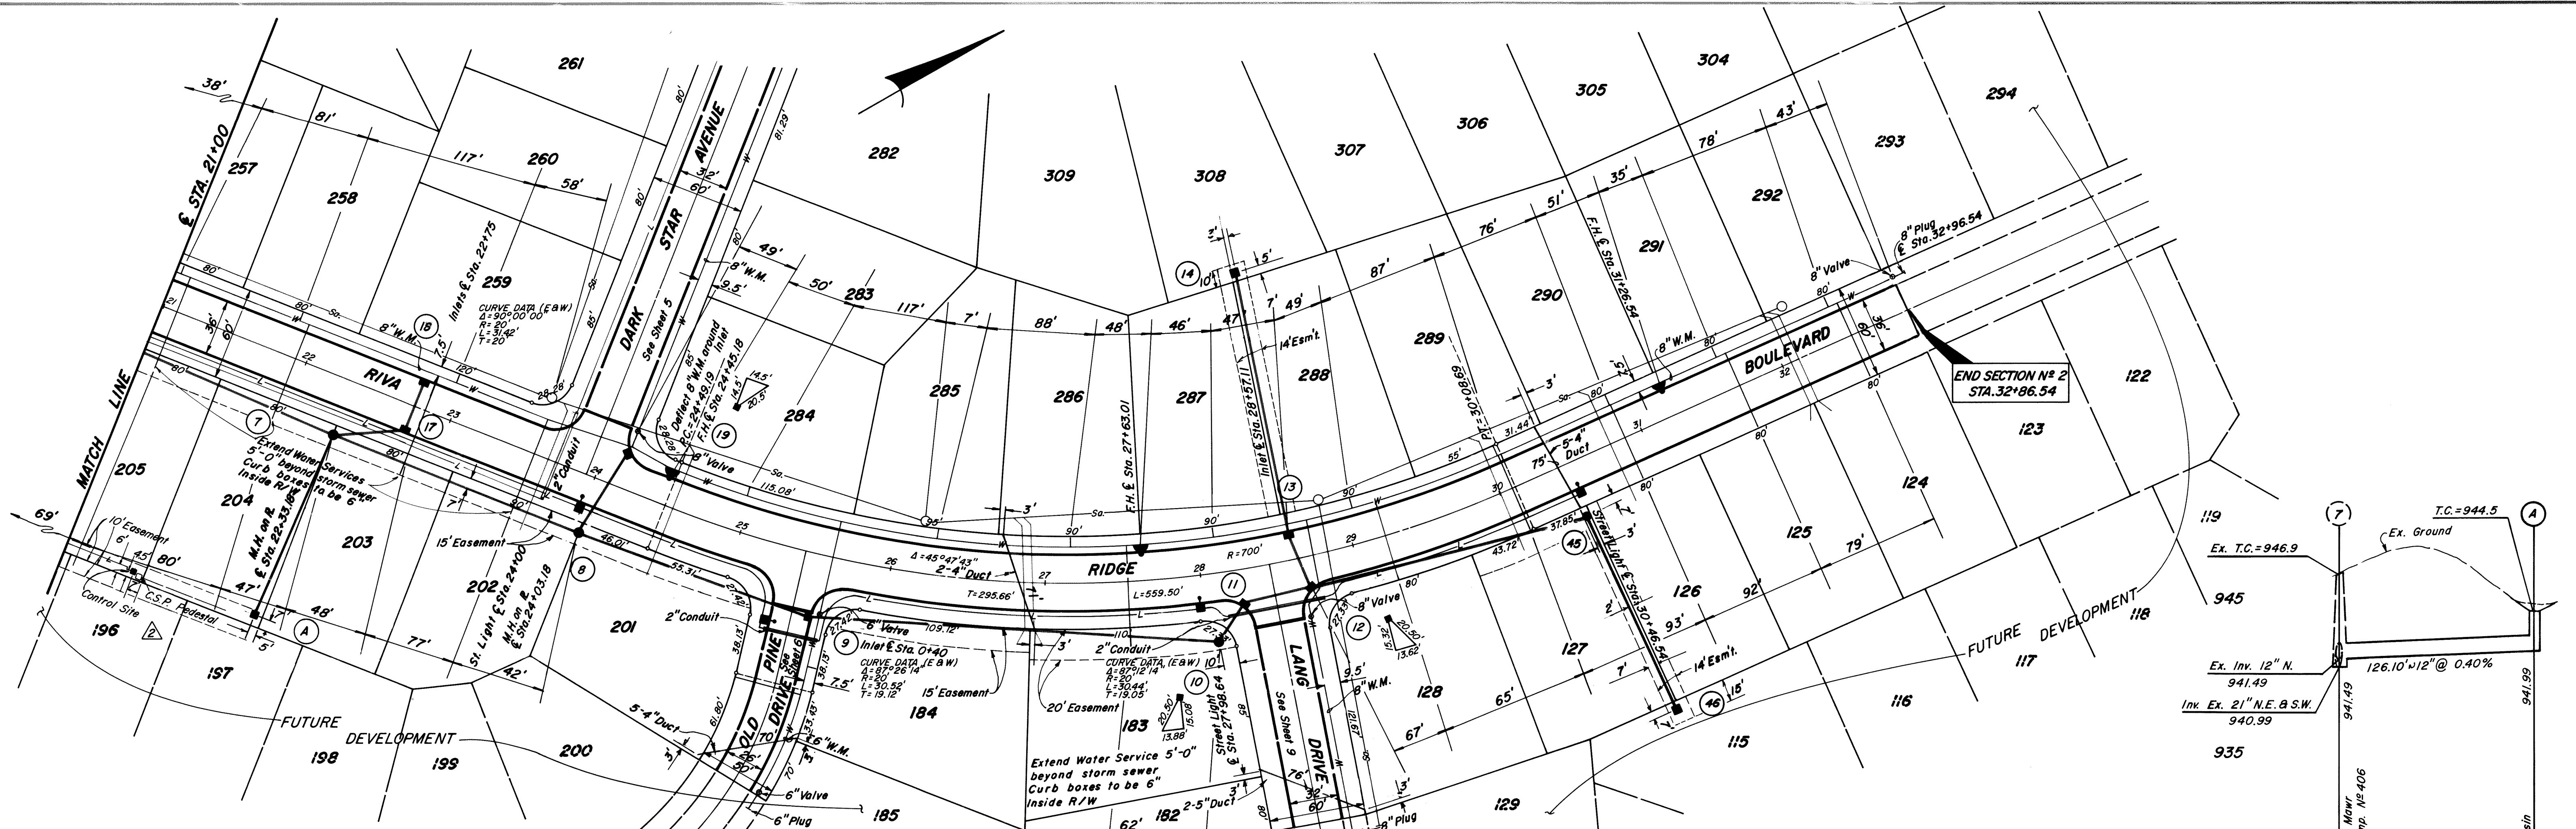

CITY OF GAHANNA, OHIO
 STREET, STORM AND WATER
 IMPROVEMENT N° 406
BRYN MAWR
 SECTION N° 2 PHASE I



SCALE Horiz 1" = 50'
 Vert 1" = 5'

EVANS, MECHWART, HAMBLETON & TILTON, INC.
 CONSULTING ENGINEERS & SURVEYORS


Revised 1/10/89 Relocated Control Site

Revised as Constructed 8-8-88


1
10

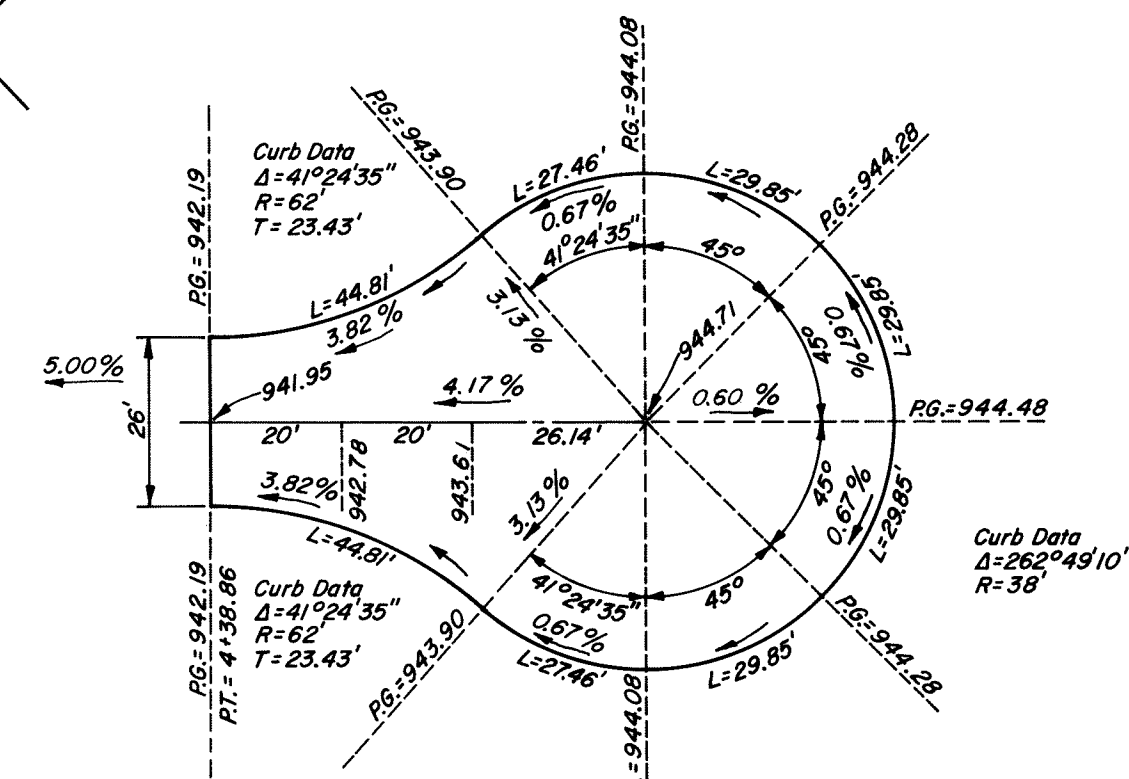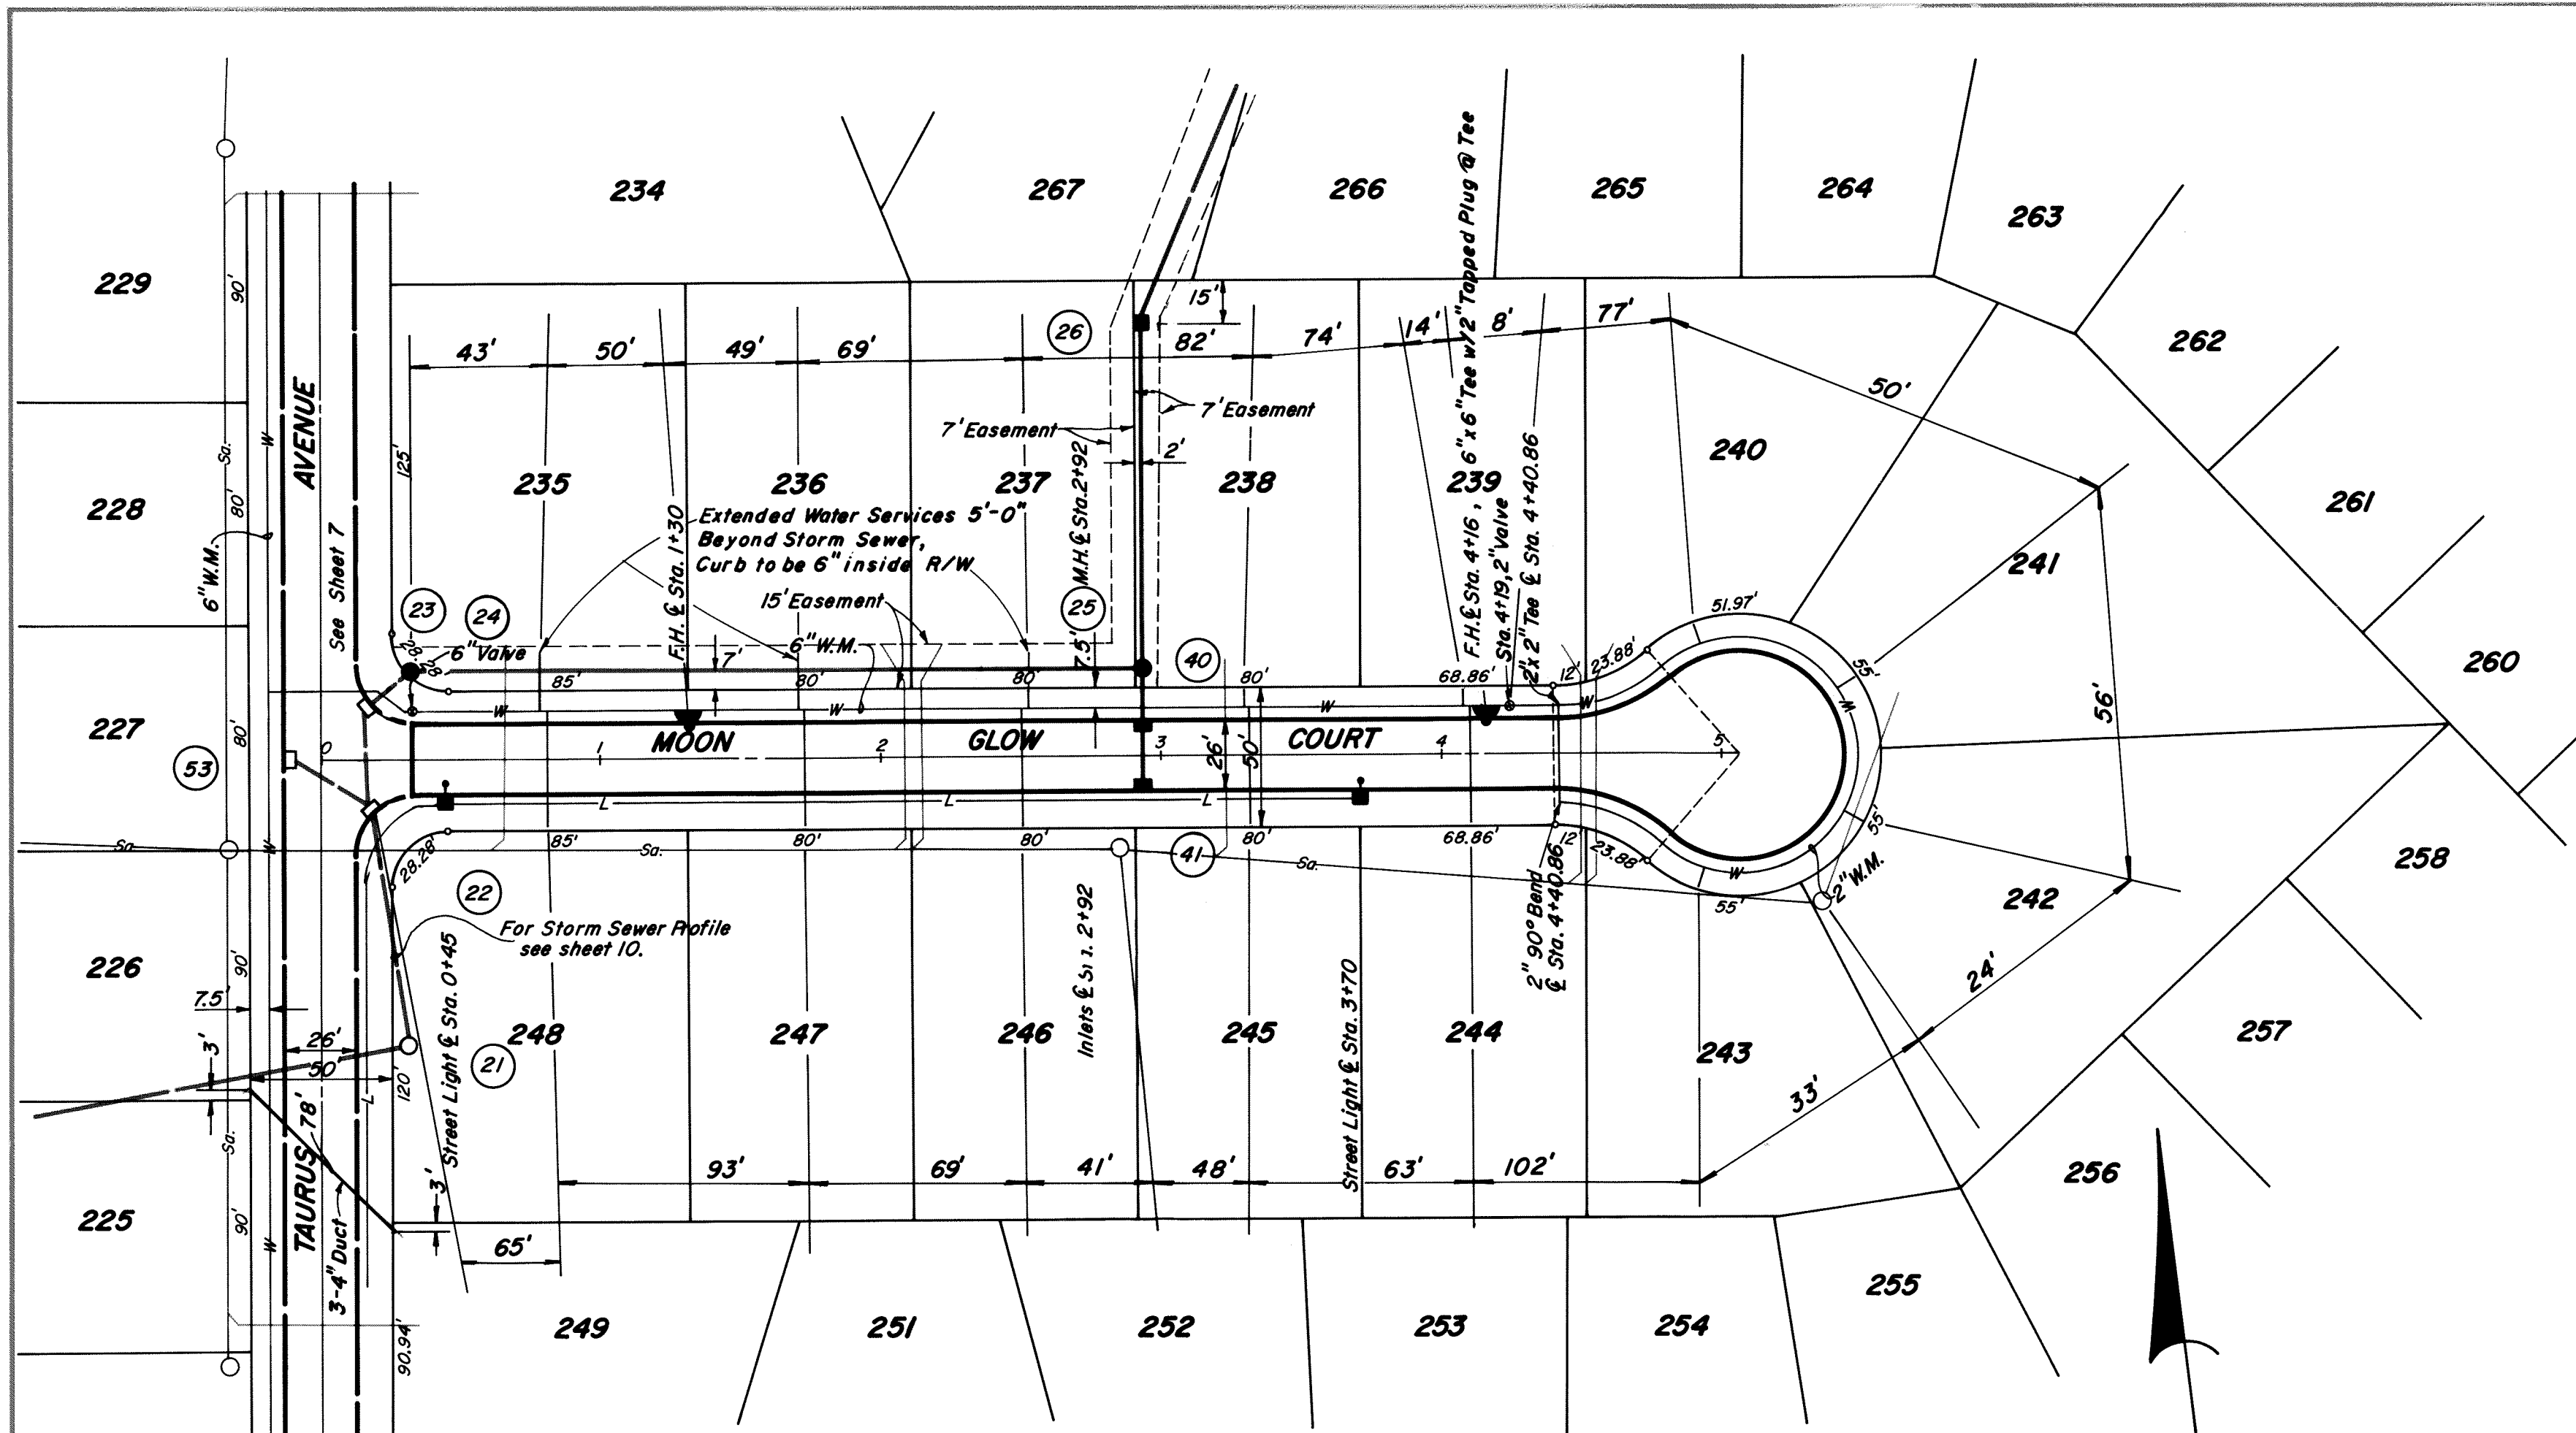

CUL-DE-SAC DETAIL
MOON GLOW COURT
SCALE: 1"=30'

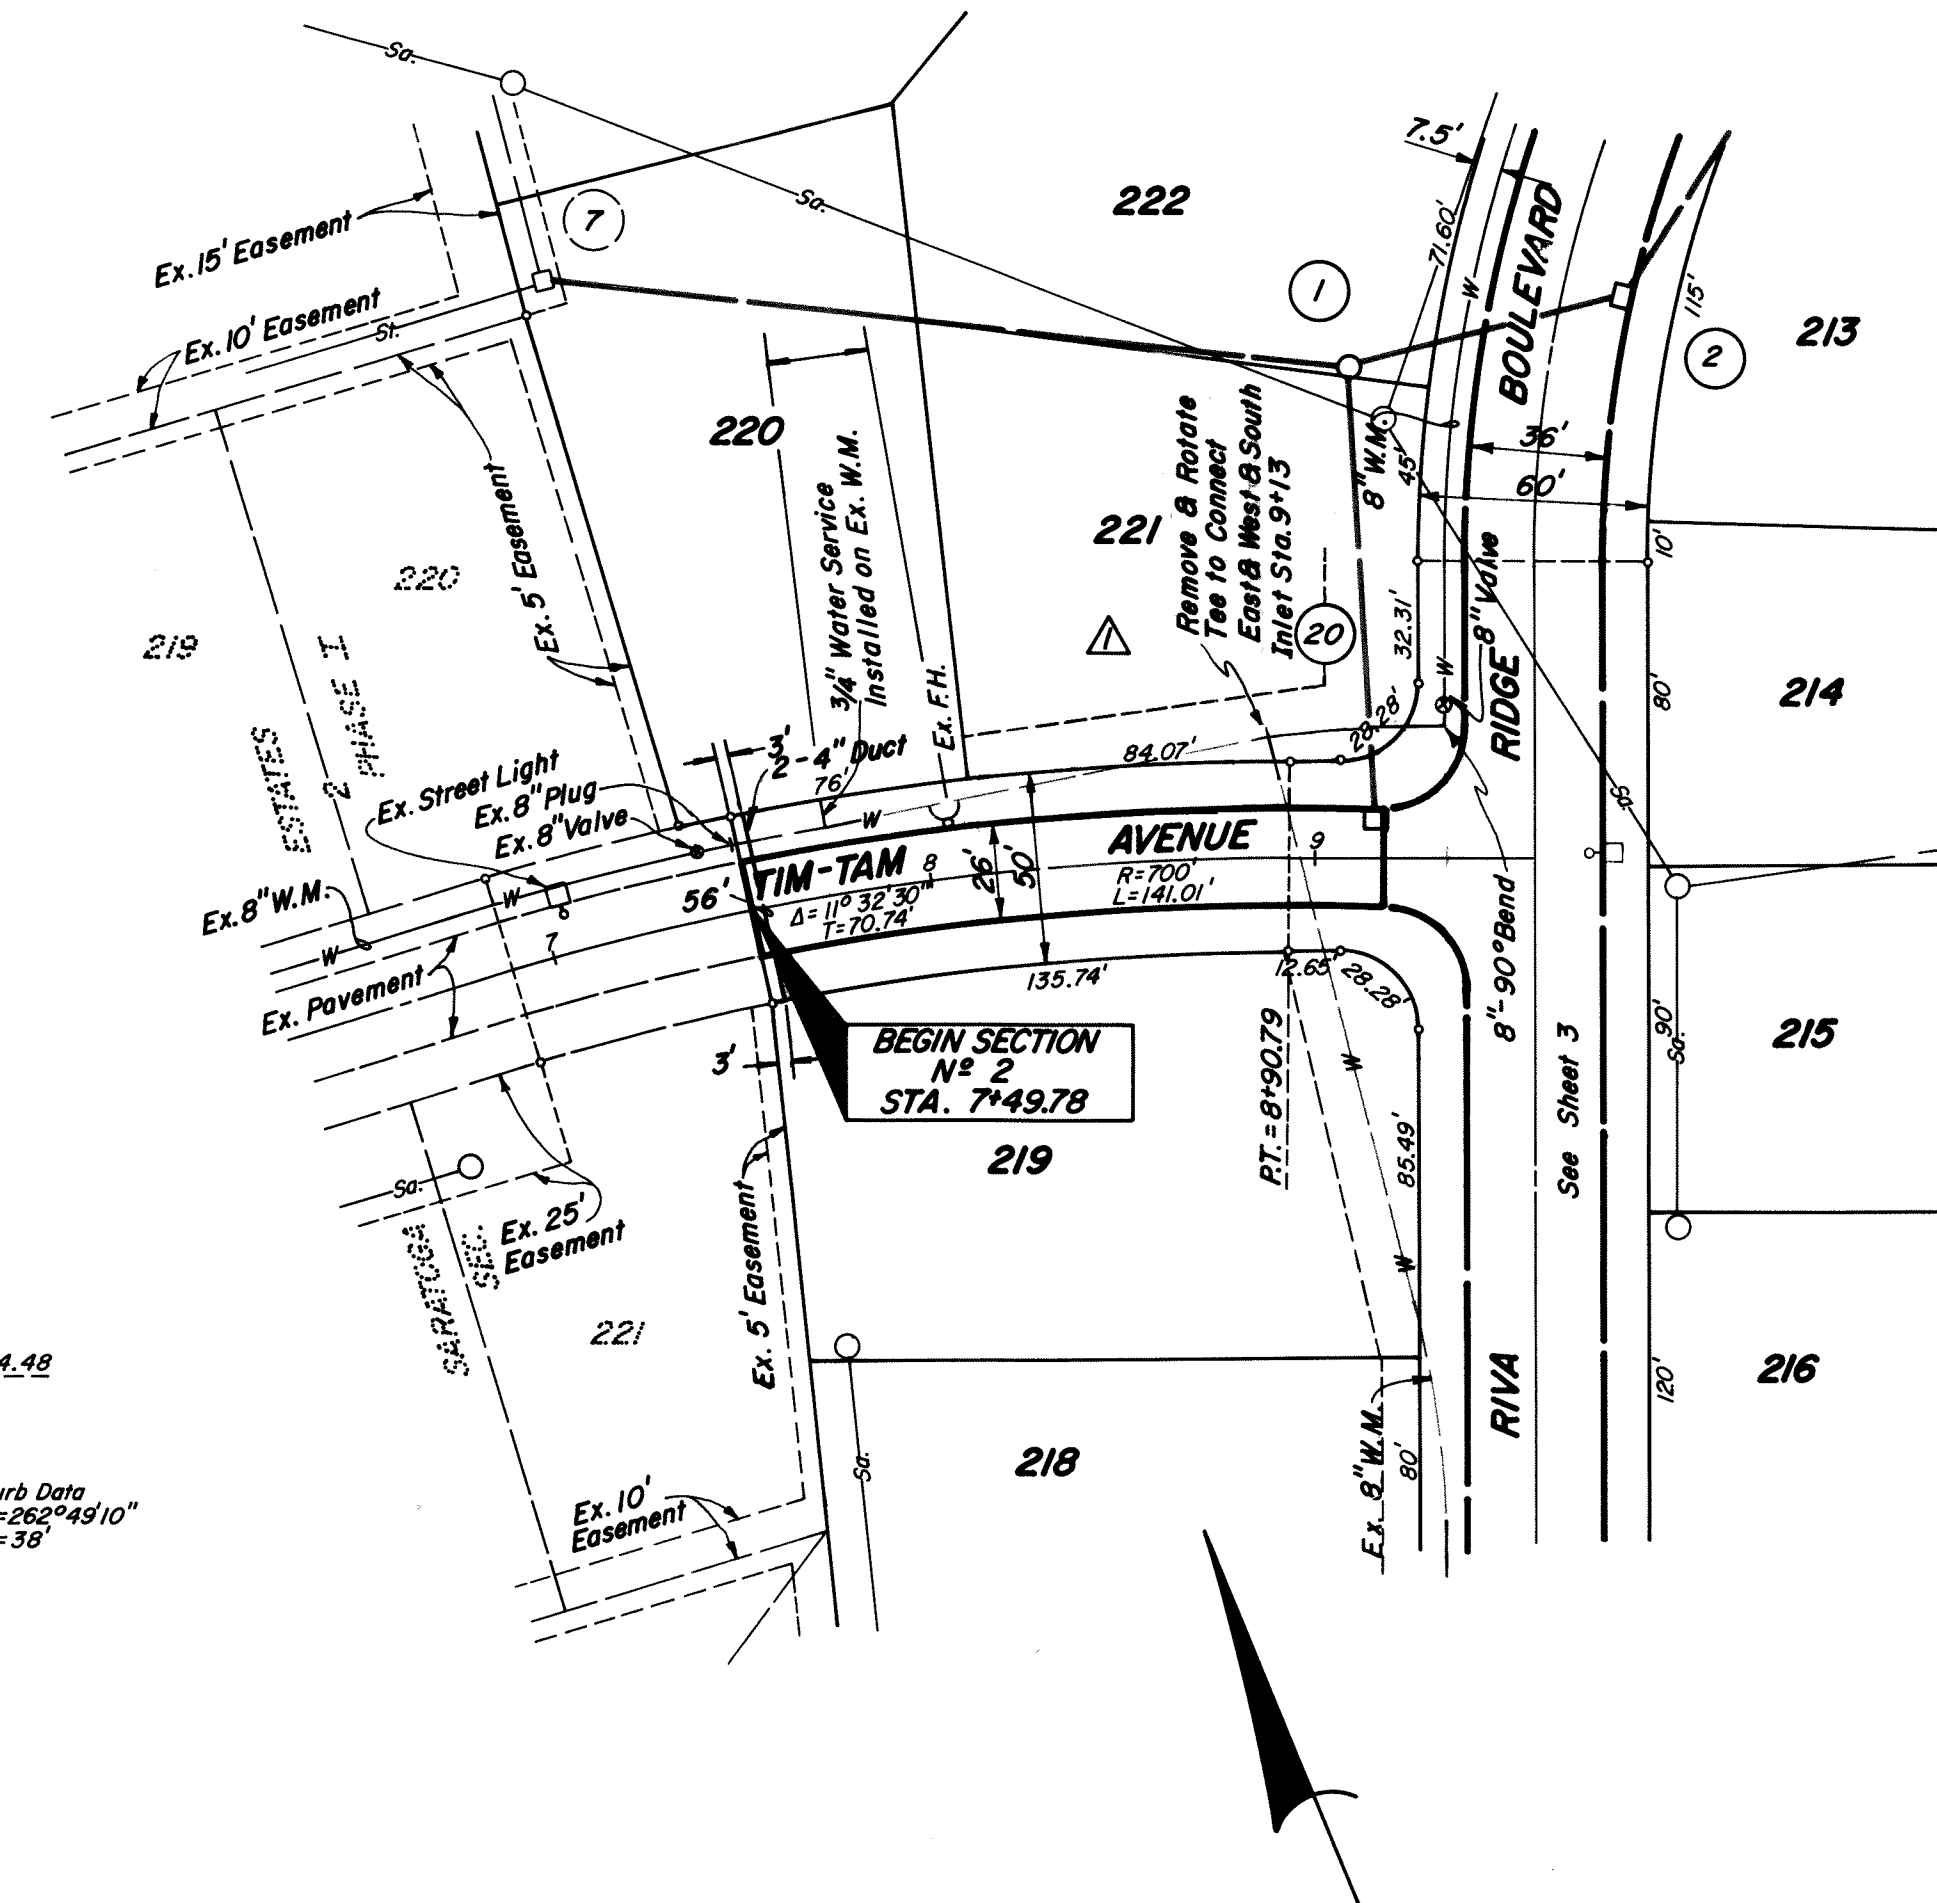

x = Ex. Ground a Left B/L
o = Ex. Ground a Right B/L

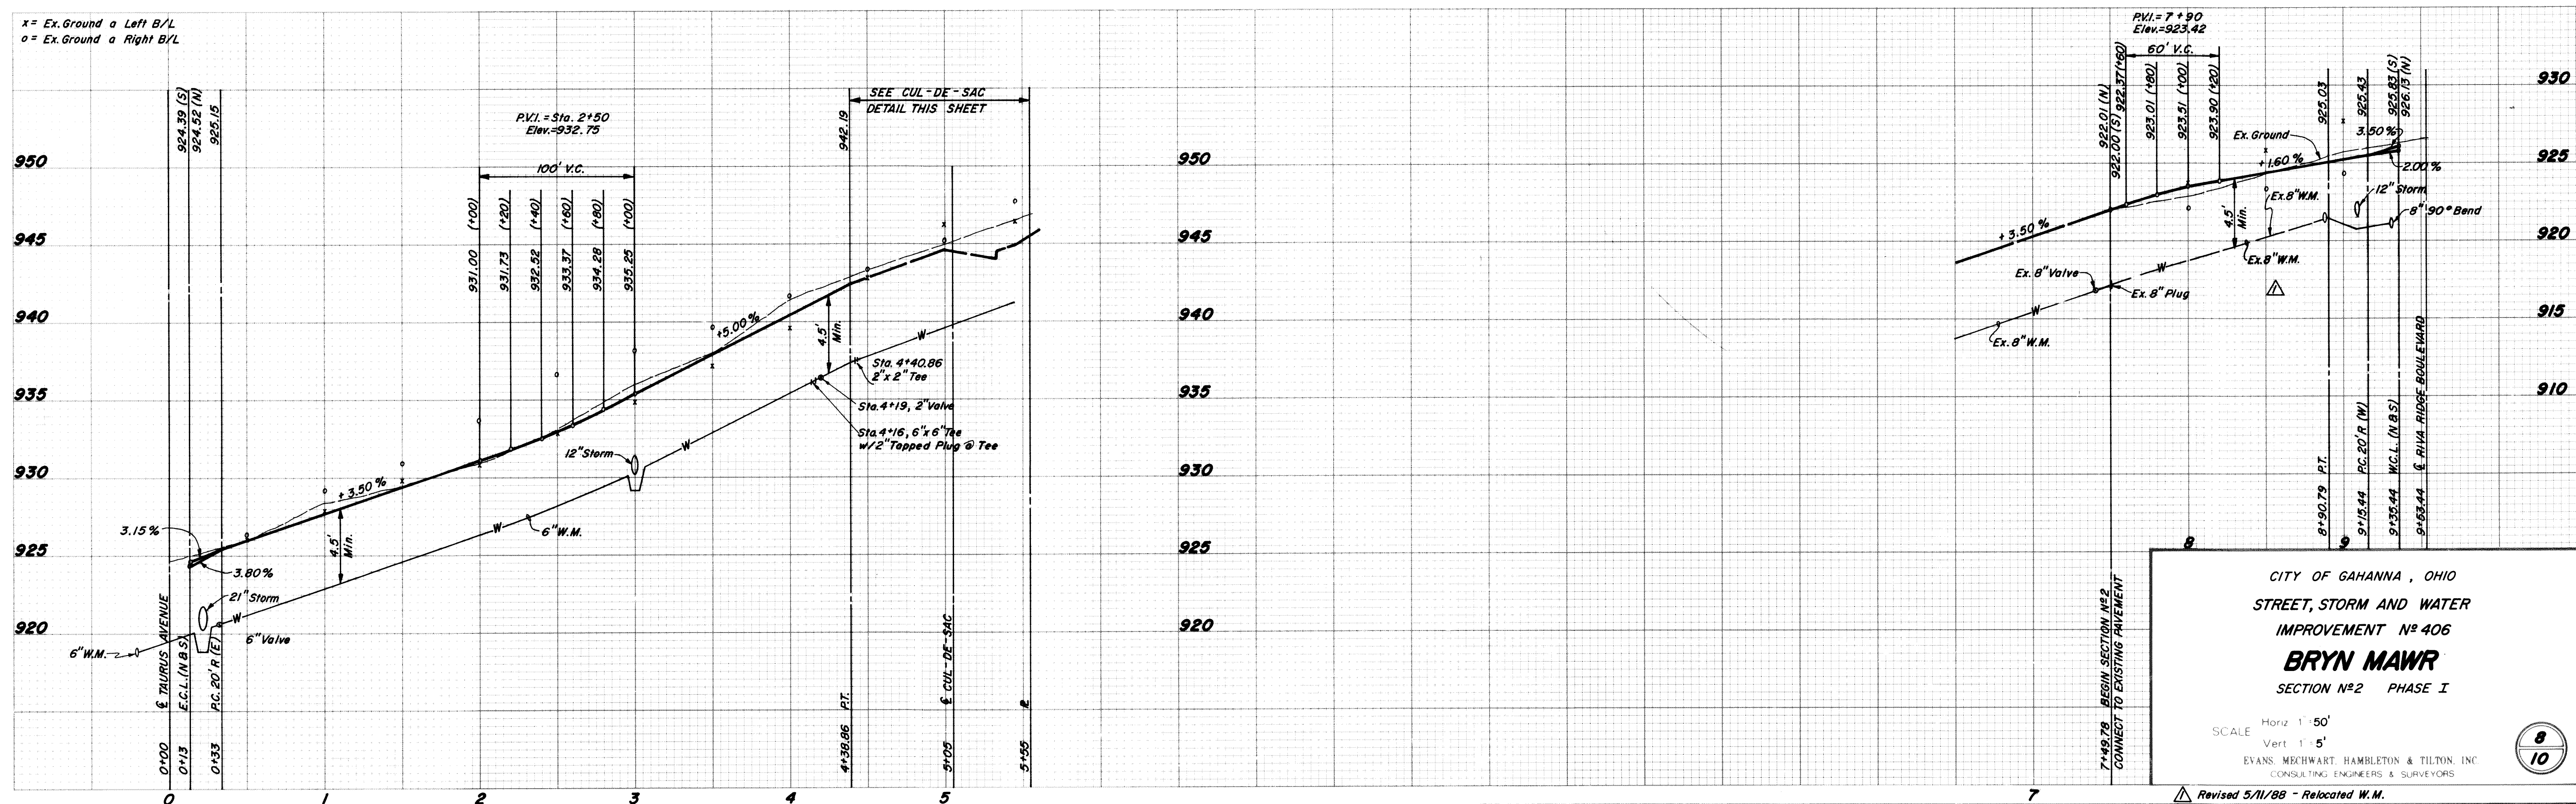







CITY OF GAHANNA, OHIO
STREET, STORM AND WATER
IMPROVEMENT N° 406
BRYN MAWR
SECTION N° 2 PHASE I

SCALE Horiz 1"=50'
Vert 1"=5'

EVANS, MECHWART, HAMBLETON & TILTON, INC.
CONSULTING ENGINEERS & SURVEYORS

Revised 5/11/88 - Relocated W.M.

Revised as Constructed 8-8-88

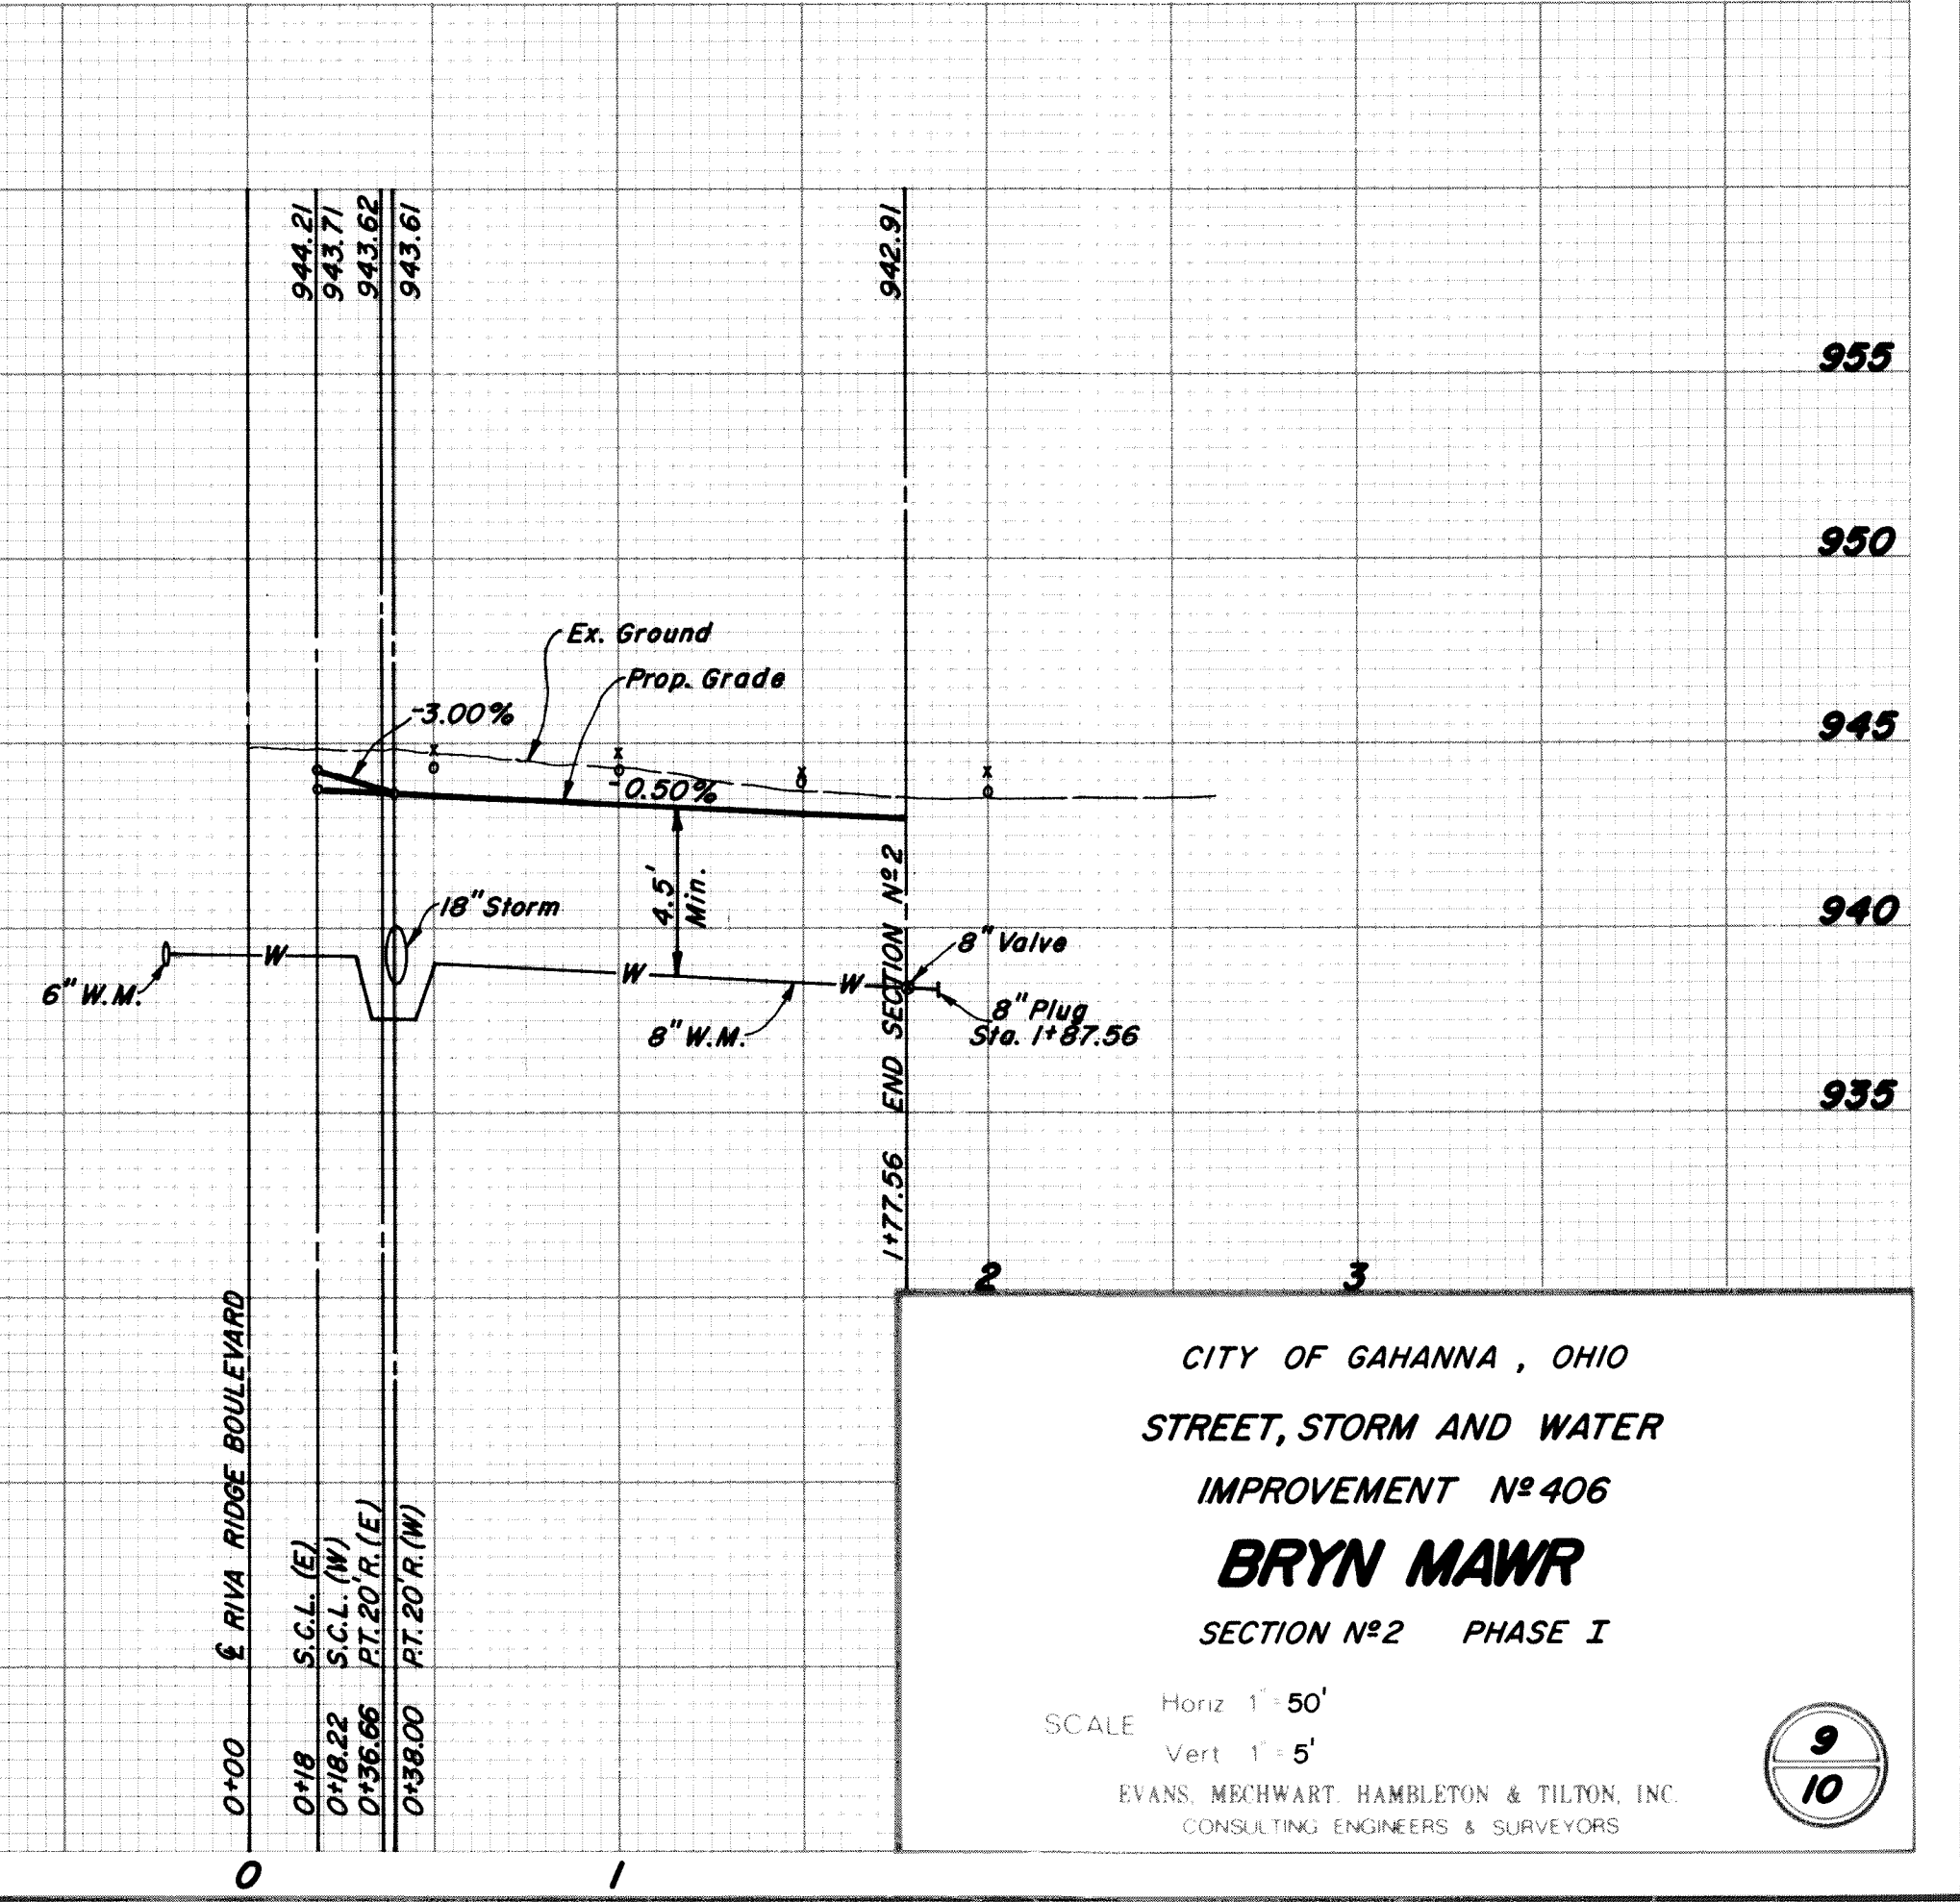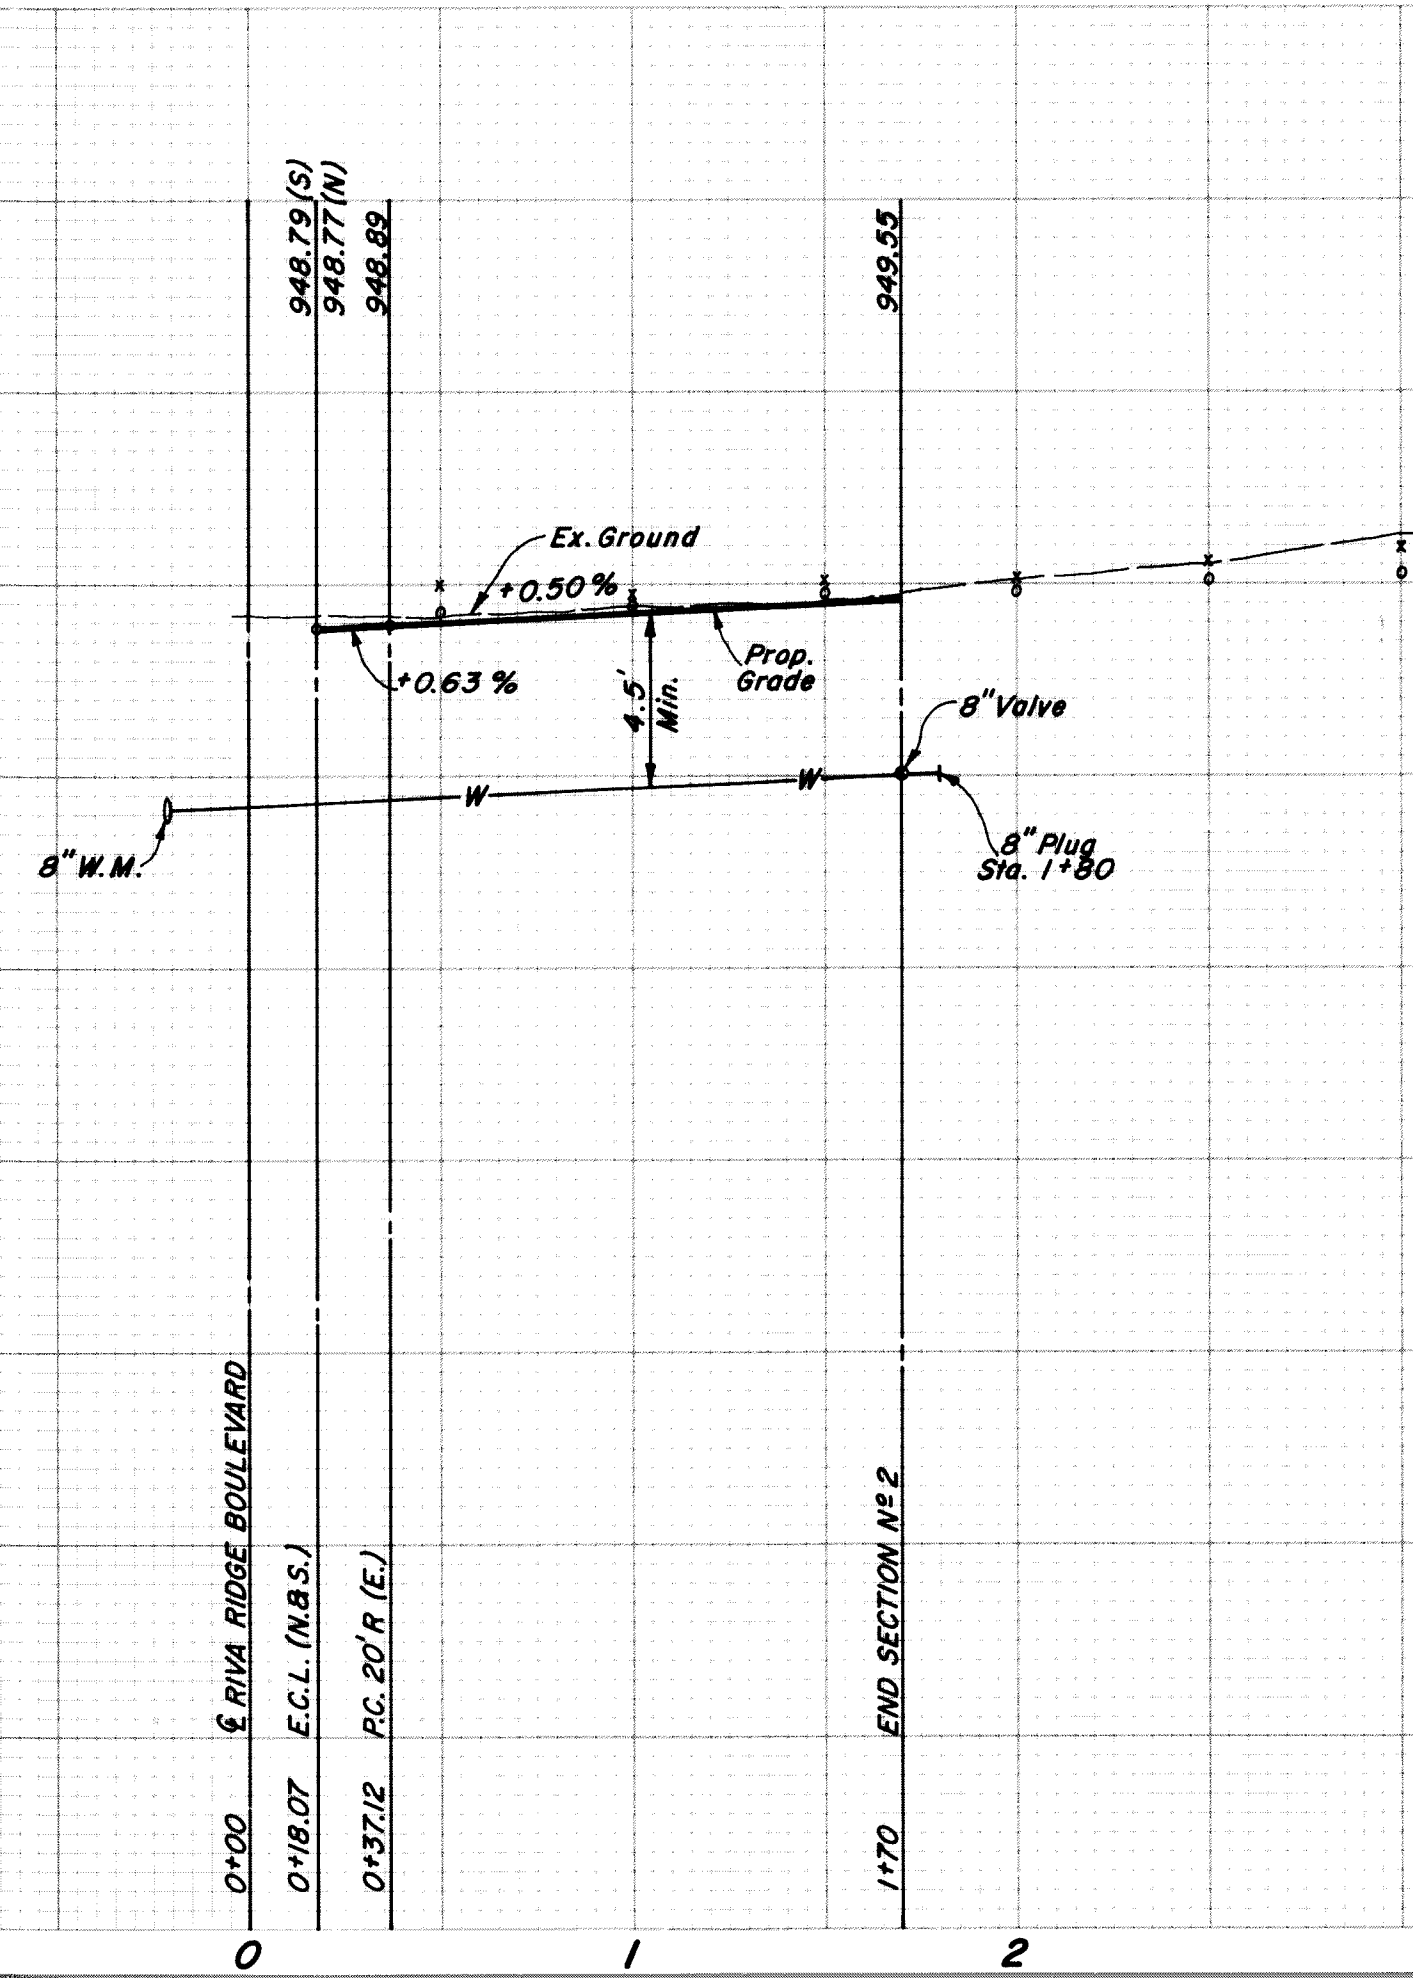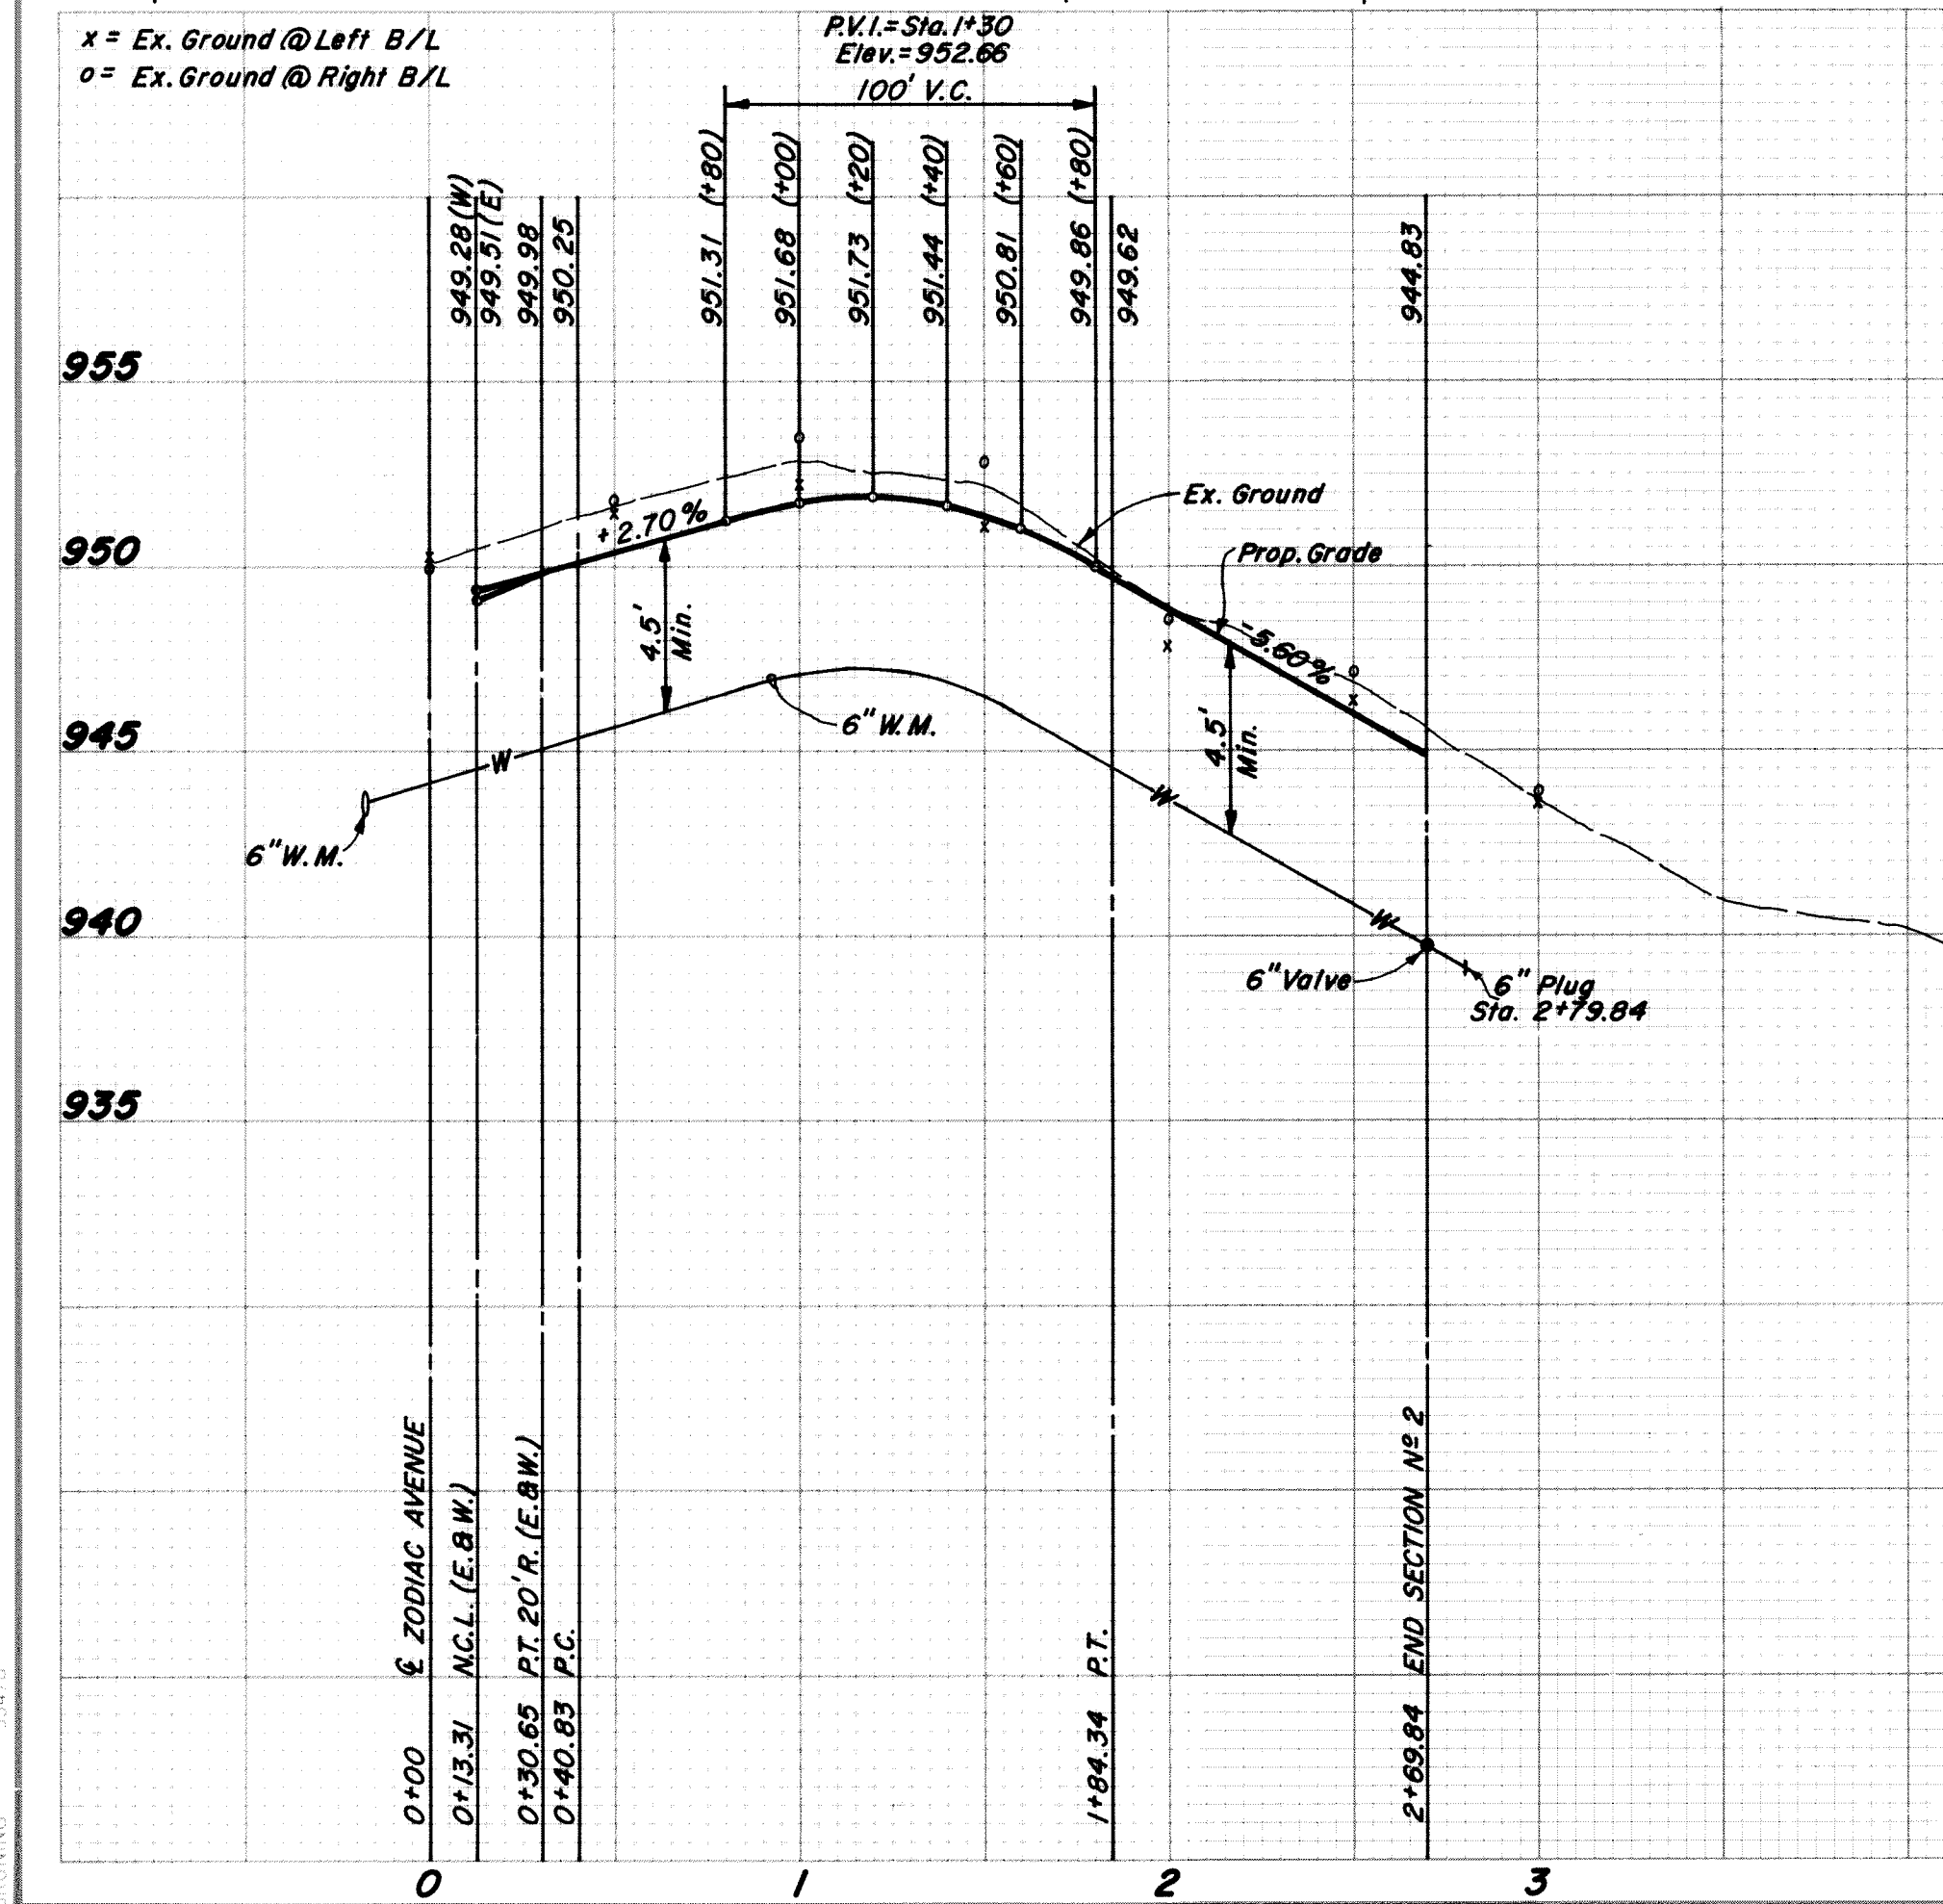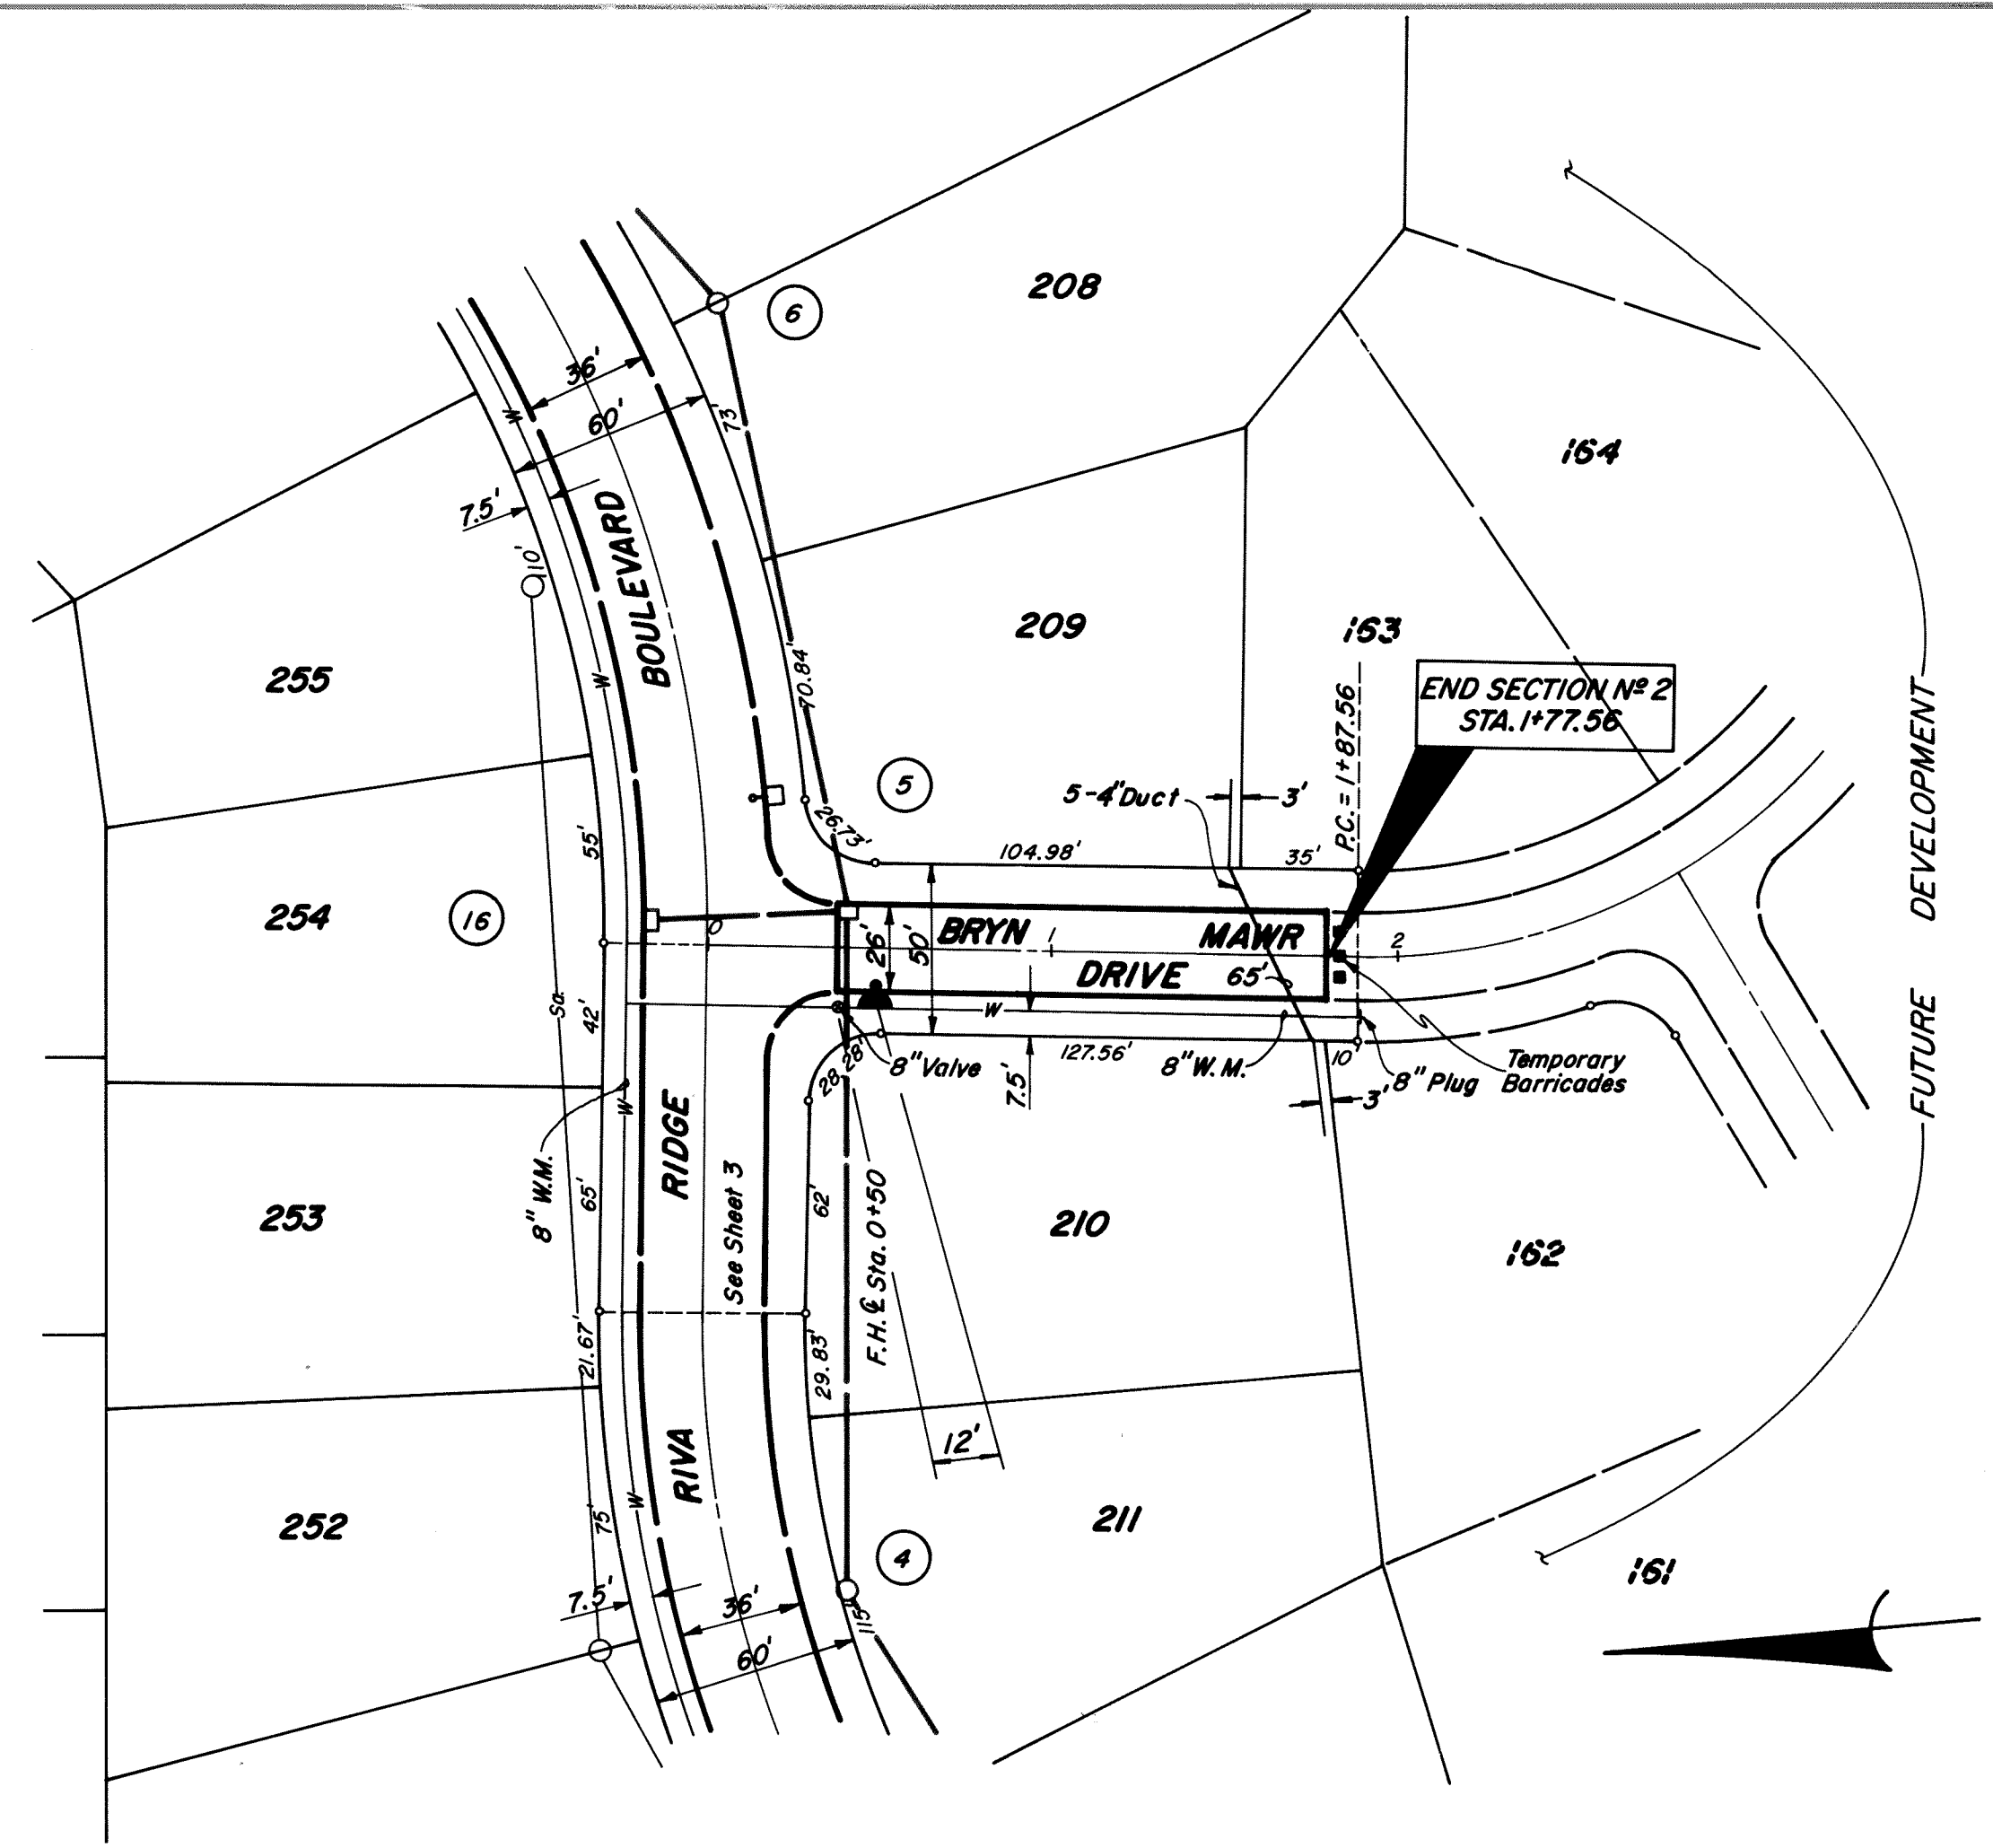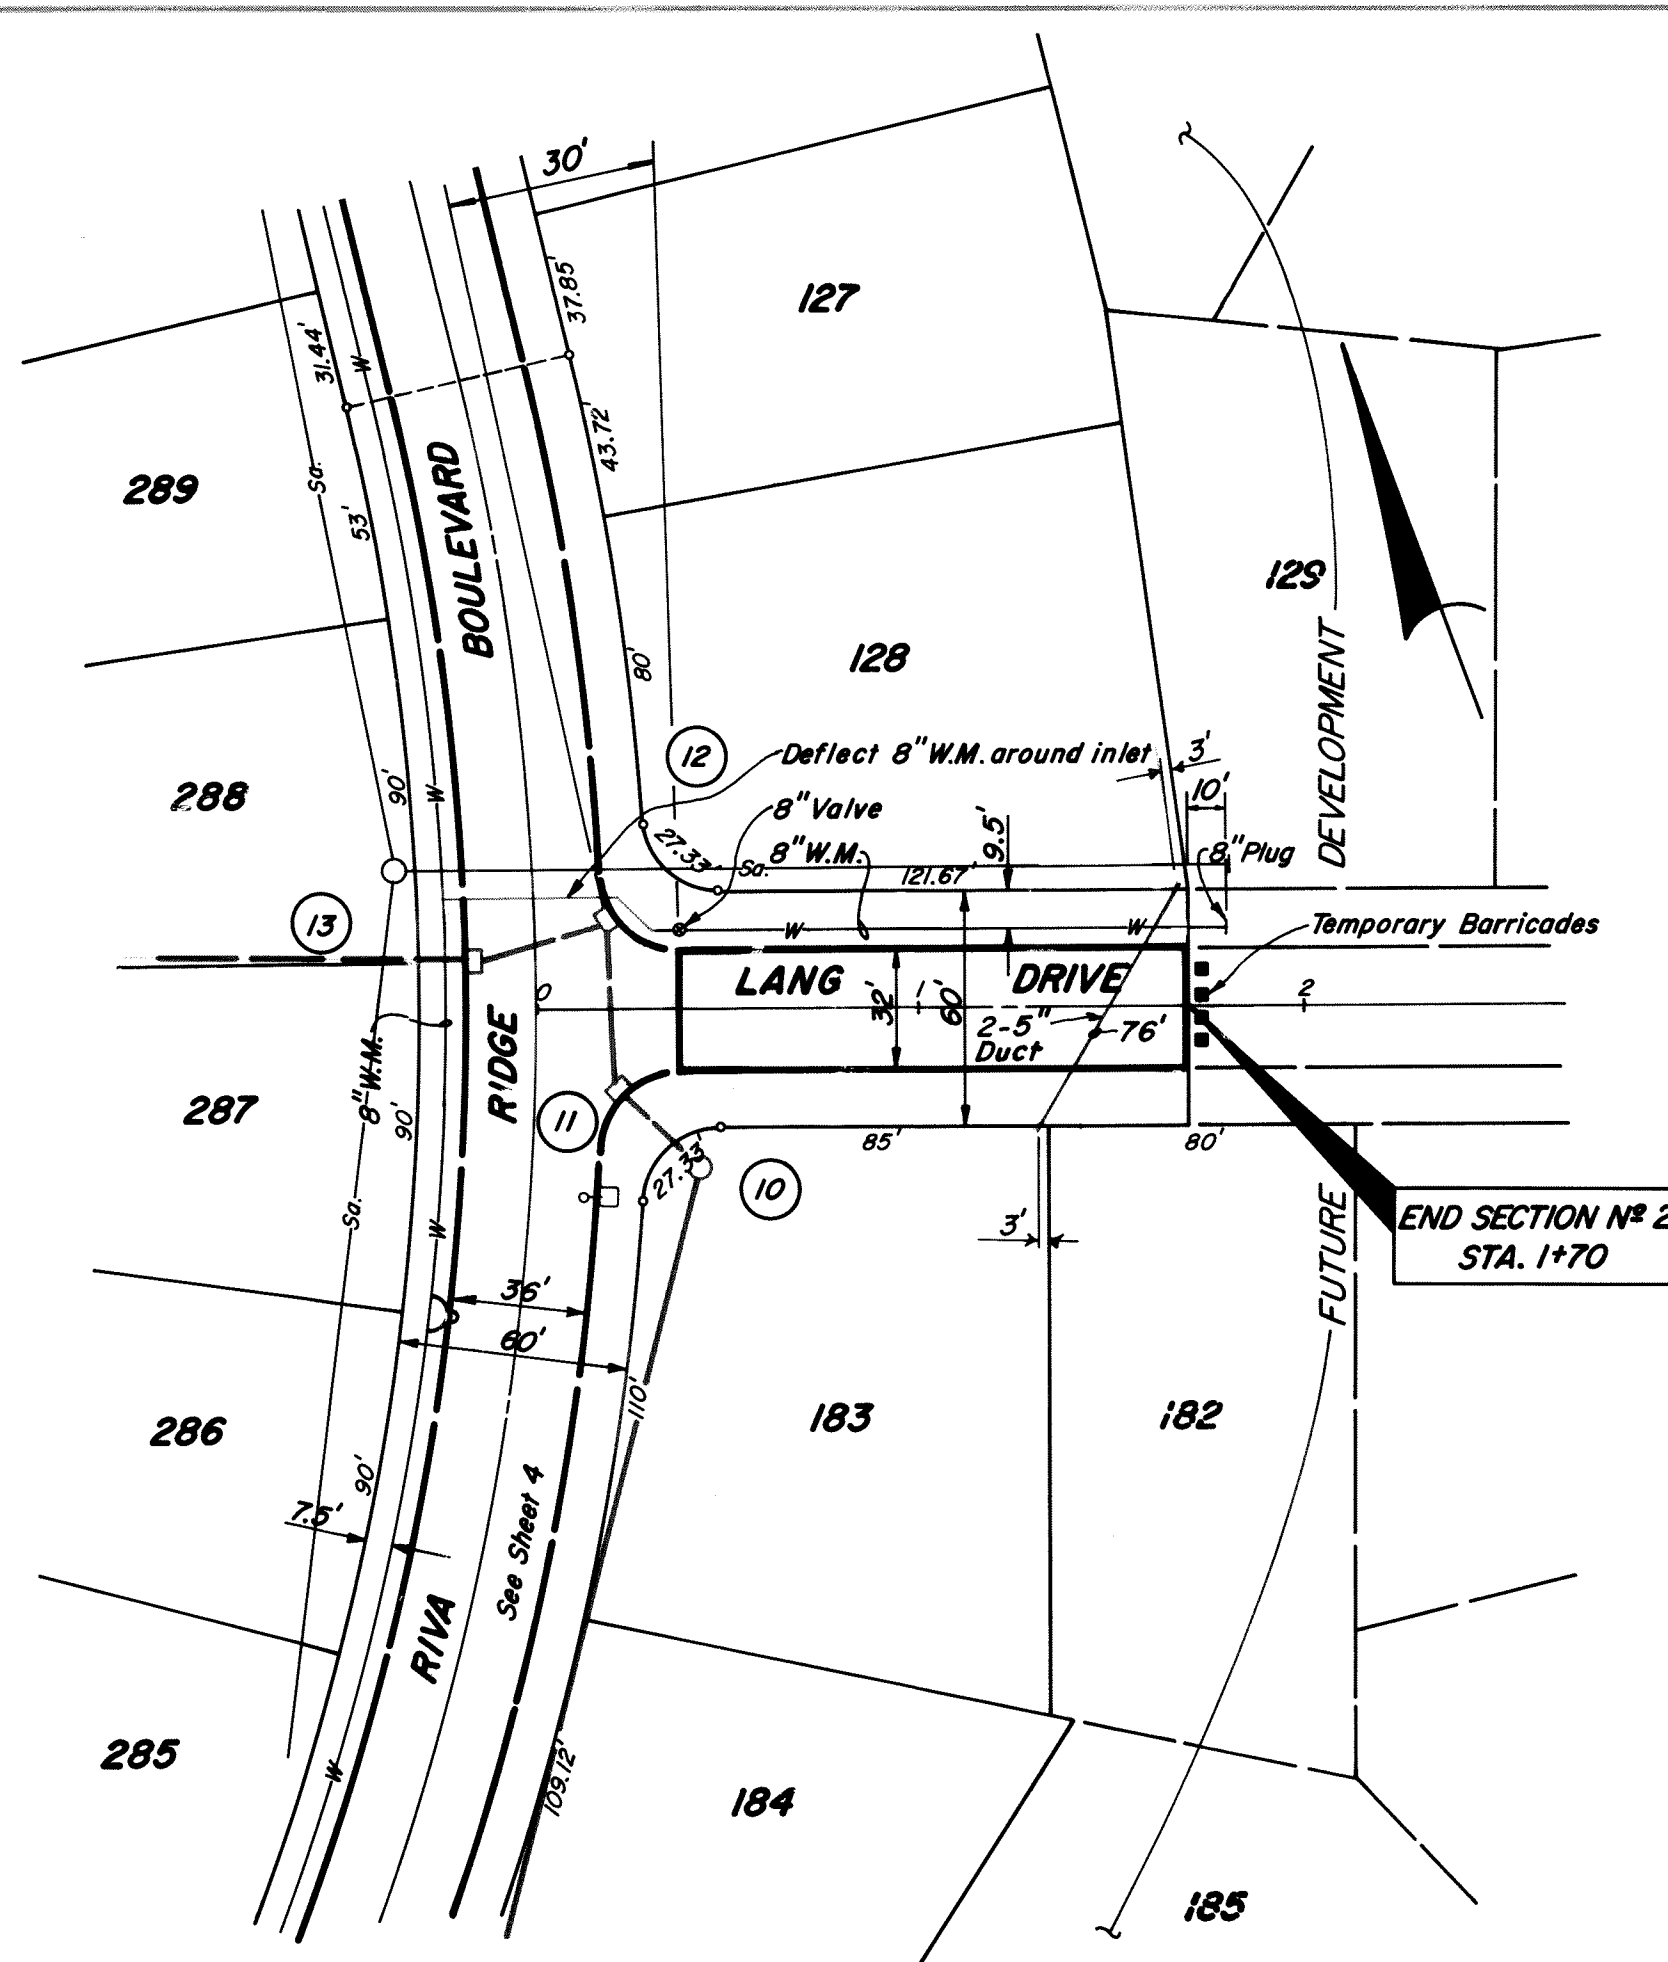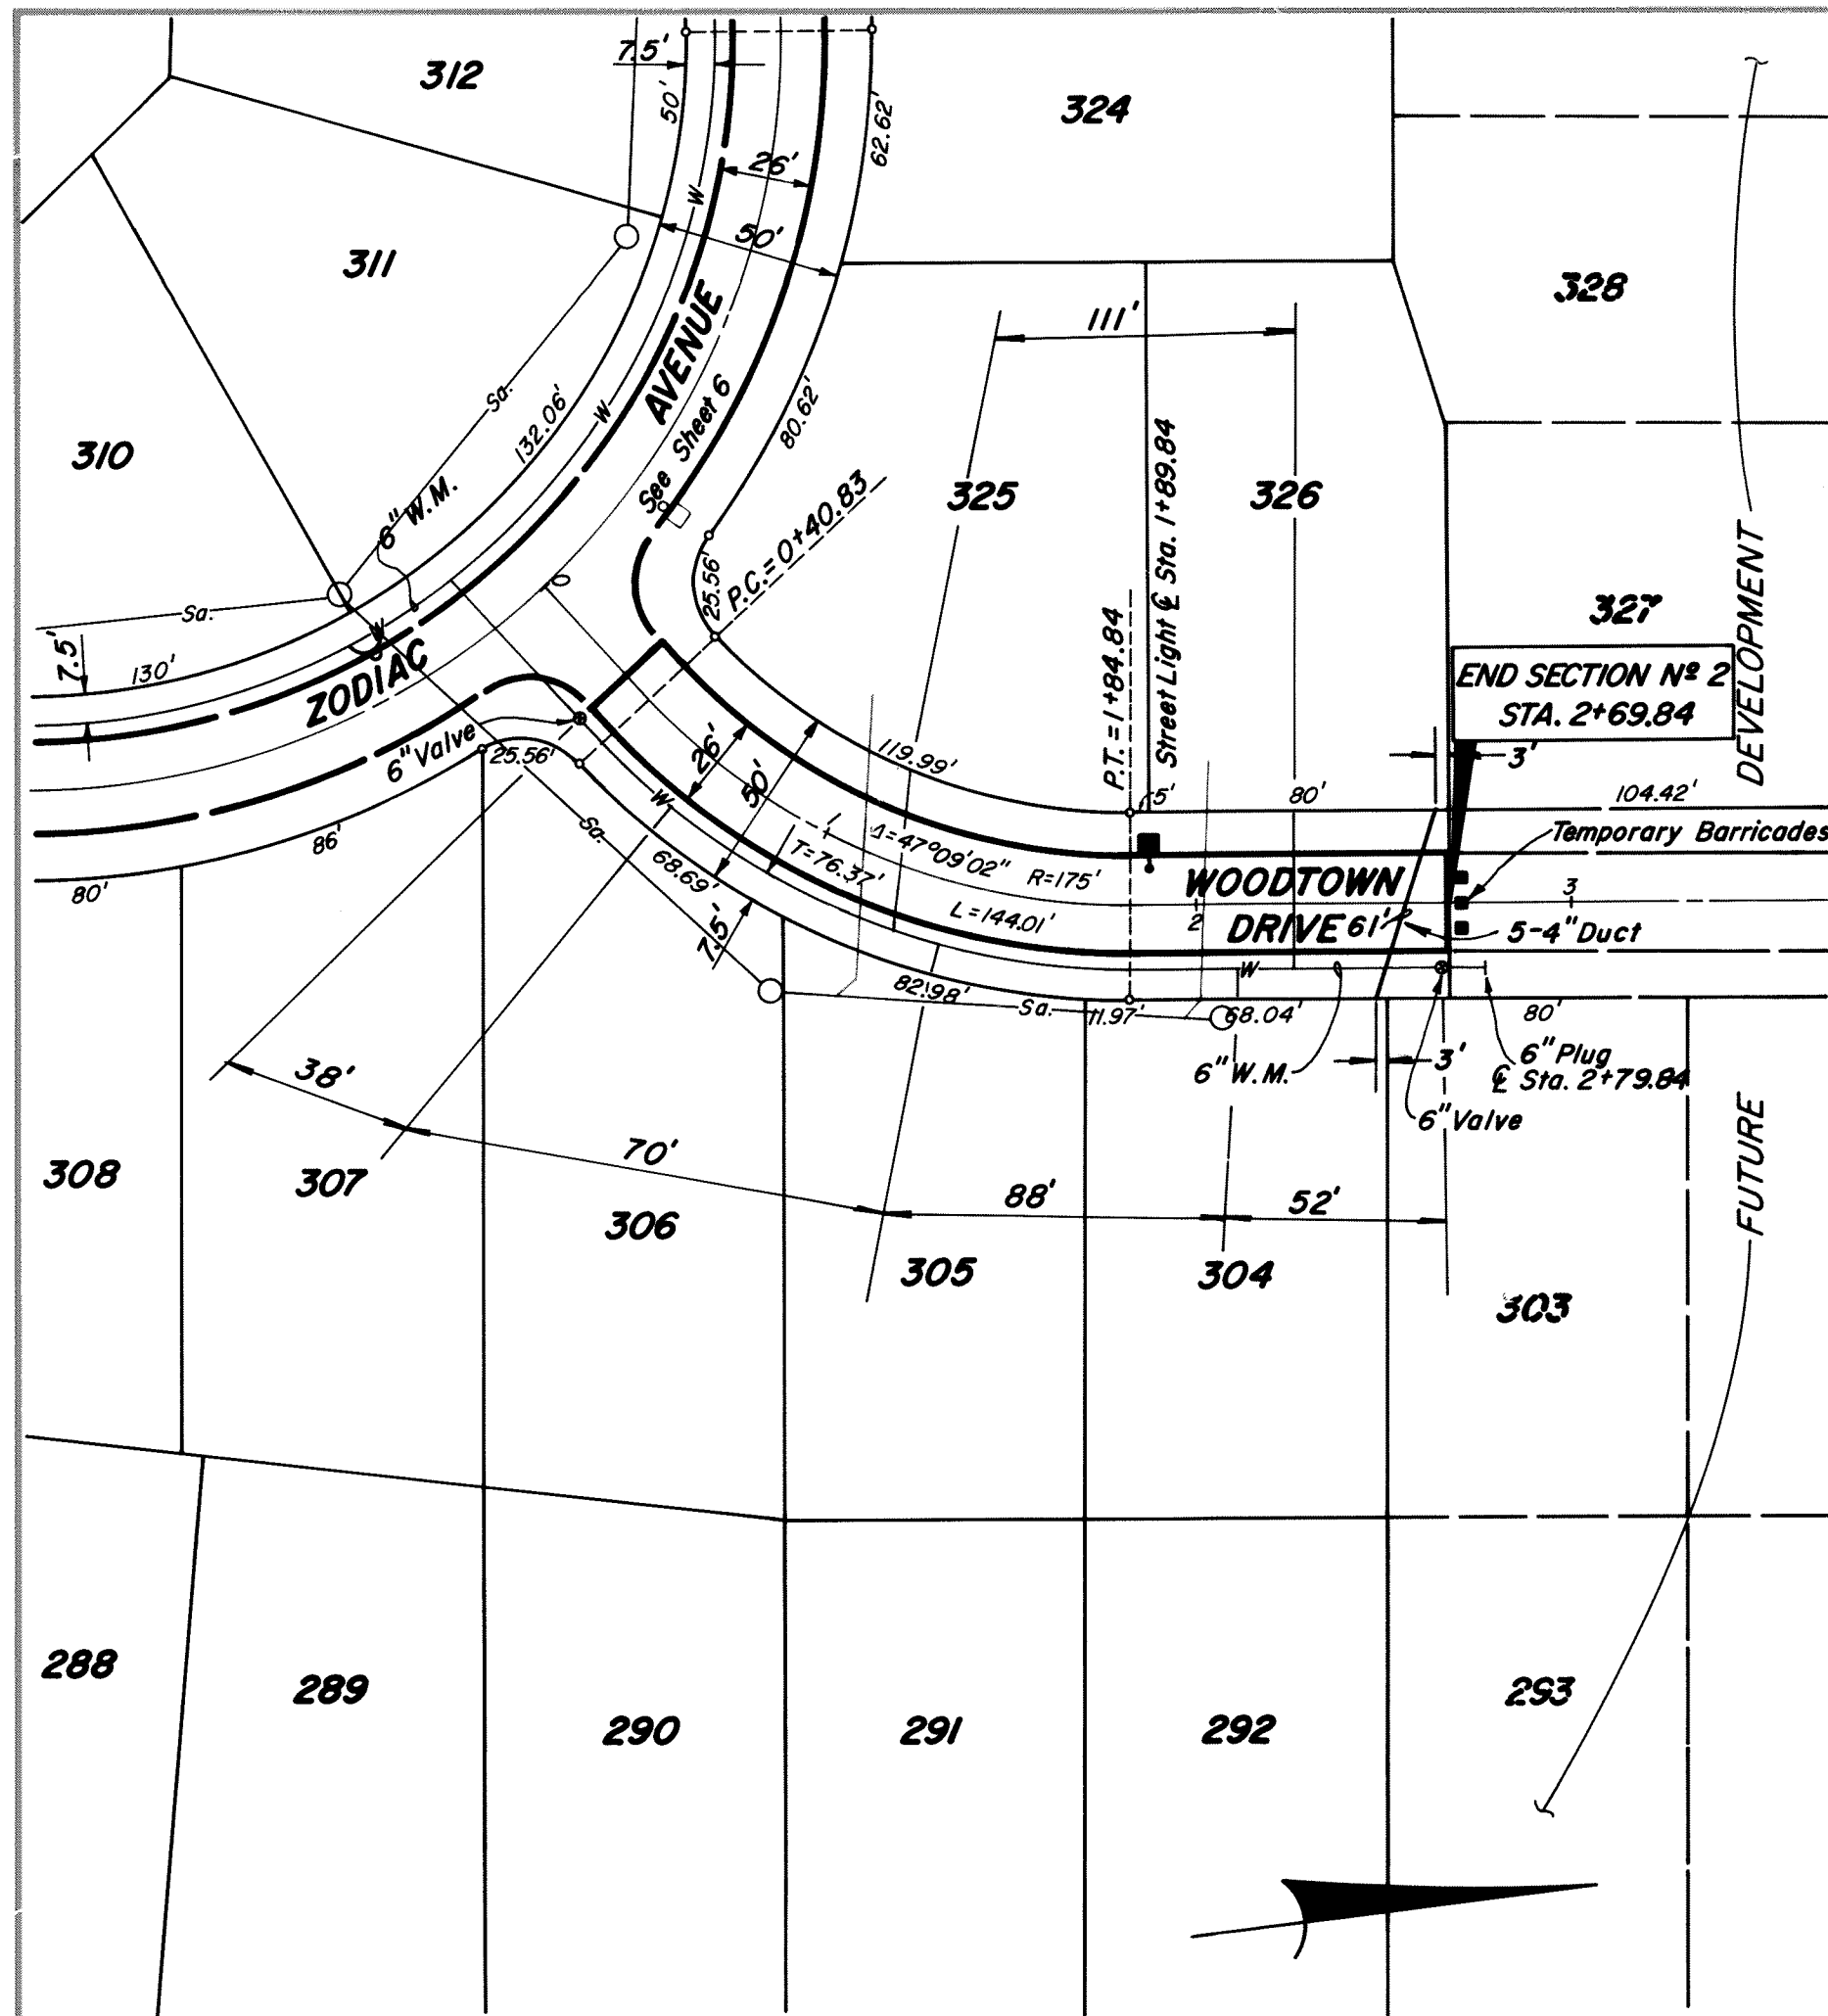

CITY OF GAHANNA, OHIO
STREET, STORM AND WATER
IMPROVEMENT No 406
BRYN MAWR
SECTION No 2 PHASE I


SCALE Horiz 1" = 50'
Vert 1" = 5'

EVANS, MECHWART, HAMBLETON & TILTON, INC.
CONSULTING ENGINEERS & SURVEYORS

Revised as Constructed 8-8-88

9
10

* COMPACTED GRANULAR BACKFILL

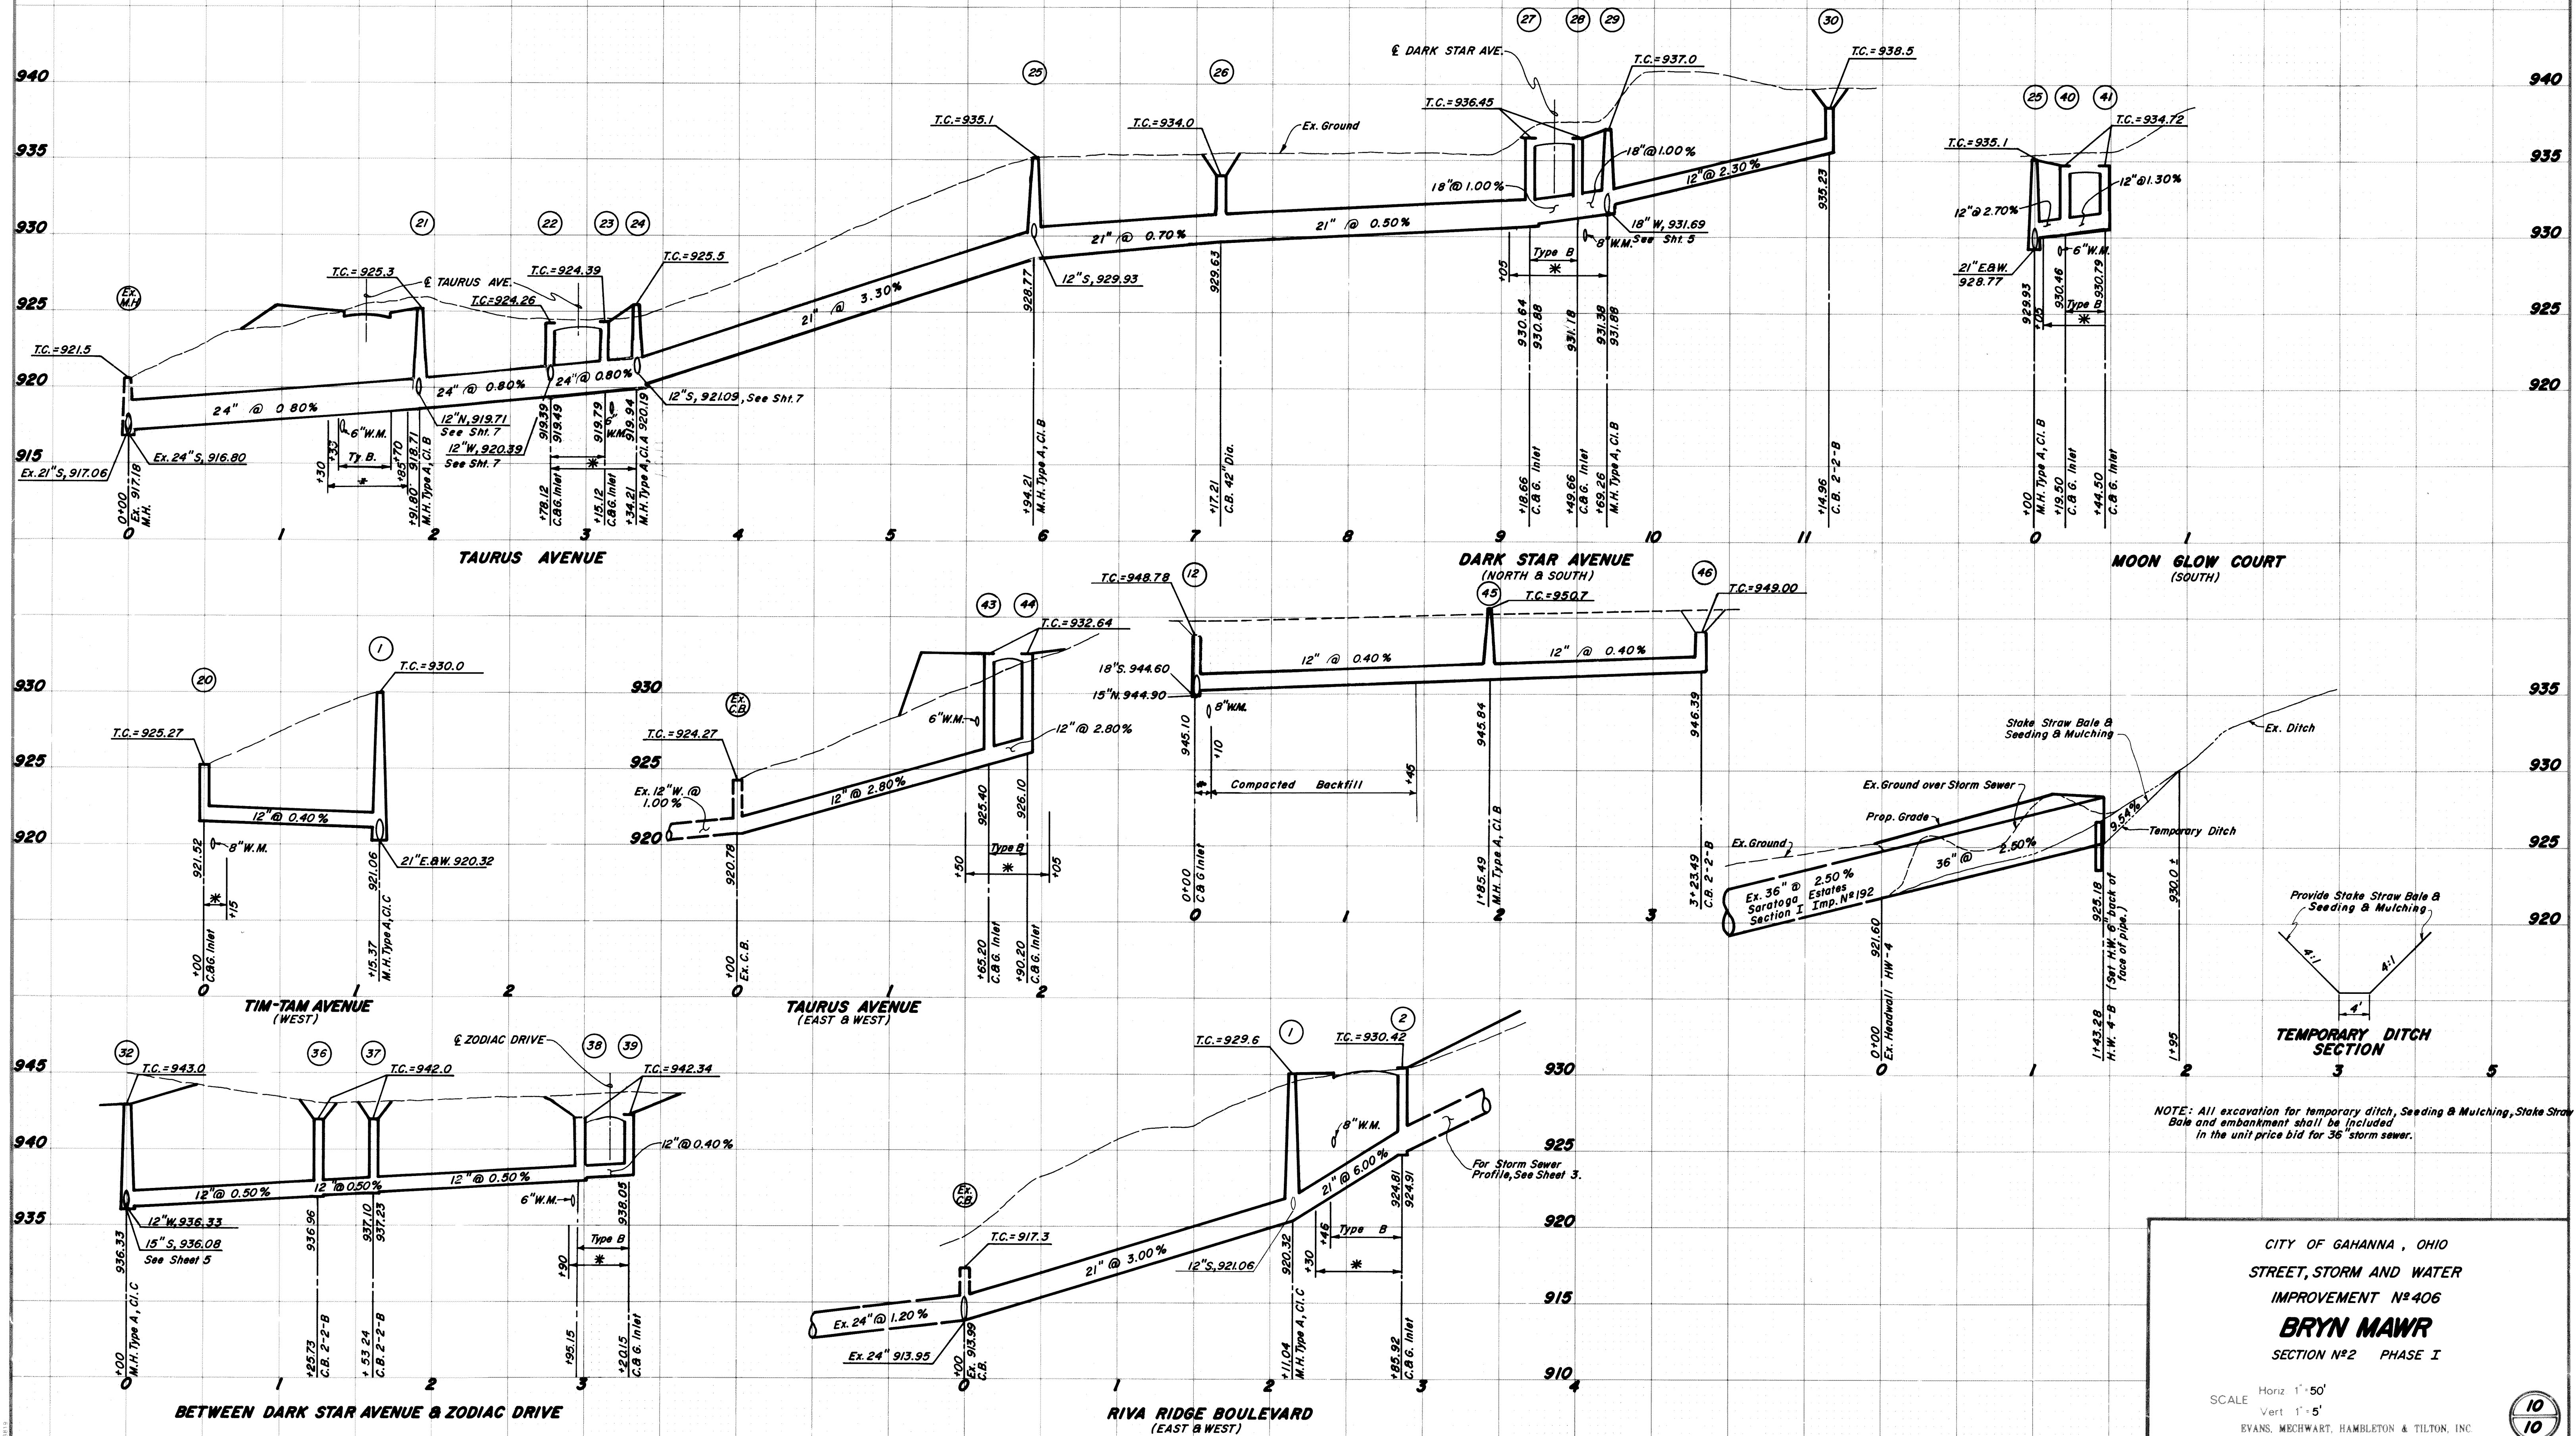

NOTE: All excavation for temporary ditch, Seeding & Mulching, Stake Straw Bale and embankment shall be included in the unit price bid for 36" storm sewer.

CITY OF GAHANNA, OHIO
STREET, STORM AND WATER
IMPROVEMENT No. 406
BRYN MAWR
SECTION No. 2 PHASE I

SCALE Horiz 1"=50'
Vert 1"=5'

EVANS, MECHWART, HAMBLETON & TILTON, INC.
CONSULTING ENGINEERS & SURVEYORS

Revised as Constructed 8-8-88



ST-406

STREET, STORM WATER AND LIGHTING
IMPROVEMENT NO. 450
ROSE RUN
SECTION 3
CITY OF GAHANNA, OHIO
1989

GENERAL NOTES

SPECIFICATION: The requirements of the City of Gahanna, together with the Standard Specifications of the State of Ohio, Department of Transportation, including all supplements thereto in force on date of contract shall govern all materials and workmanship involved in the improvements shown on these plans except as such specifications are modified by the following specifications or by the construction details set forth herein.

STANDARD CONSTRUCTION DRAWINGS: All pertinent Standard Construction Drawings are available upon request at the office of the City Engineer.

PERMITS: The Contractor shall obtain all necessary permits.

SAFETY REQUIREMENTS: The Contractor and Sub-Contractor shall be solely responsible for all federal, state and local safety requirements, together with exercising precautions at all times for the protection of persons (including employees) and property. It is also the sole responsibility of the Contractor and Sub-Contractor to initiate, maintain and supervise all safety requirements, precautions and programs in connection with this work.

MISCELLANEOUS WORK: All items of work called for on the plans for which no specific method of payment is provided shall be performed by the Contractor and the cost of same shall be included in the price for the various related items.

FIELD TILE: All field tile broken during excavation shall be replaced to its original condition or connected to either the curb subdrain or to the storm sewer system as directed by the Engineer.

SURPLUS EXCAVATION: The Contractor shall dispose of all surplus street excavation on the project site where and as directed by the Owner.

UNAUTHORIZED STREET EXCAVATION: In the event excavation for the street is from 0" to 6" below that called for on the plans, the Contractor shall replace this excess excavated material with compacted 46D crushed aggregate as directed and at no extra cost to the owner.

STORM SEWERS: Unless otherwise noted on the plans all Storm Sewers shall be as hereafter specified; (1) All sizes of storm sewer located within or across proposed or existing pavement areas shall be Type B Conduit, 706.02, with Class B Bedding, (2) Storm Sewer located outside pavement areas shall be Type E Conduit, 706.01, Class C Bedding, for 15 inch and smaller, and shall be Type E Conduit, 706.02, Class C Bedding, for 18 inch and larger. The following modifications to Ohio Department of Transportation Specifications shall apply; (1) Type E Conduits shall have sealed joints; (2) Granular backfill material shall be compacted granular material, Item 310-A placed within limits shown on the plan including around all inlet structures. Granular backfill shall extend from the bottom of the trench to a plane 6 inches below the subgrade.

CURB INLETS: All curb inlets shall be channeled as directed.

ROOF DRAIN OPENINGS: The Contractor shall provide two roof drain openings in the curb for each lot, each opening located not more than 4 feet in from each lot line.

STREET LIGHTING: Standard Electrical Specifications and Standard Construction Drawings, covering Street Lighting for the City of Gahanna, Ohio, shall apply.

EXPANSION JOINTS: It shall be the responsibility of the Contractor to adequately barricade the street in the vicinity of all expansion joints, until such time as the street is open to traffic.

WATER MAINS: All water mains shall be either Ductile Iron Class 53 (4" through 10"), Class 54 (12" and larger), or P.V.C. C-900, Class 150. All bends, joint deflections and fittings shall be backed with concrete where and as directed. Where water mains or services cross proposed or existing streets, backfill shall be compacted granular material, Item 310-A, within limits 5 feet outside the edge of pavement or curb extended from the bottom of the trench to a plane 6 inches below the subgrade. The services may be jacked across the street in lieu of open cut and the use of granular backfill. 2" water mains shall be P.V.C. SR 21-CL-200, service saddles for all P.V.C. pipe shall be a Ford S-70 or equal.

CURB BOXES: Curb boxes shall be located one-half foot from the property line unless otherwise shown on the plans or ordered by the Engineer.

CHLORINATION OF WATER MAINS: The Contractor shall make arrangements to have the water mains chlorinated by the City of Columbus. The cost of chlorination shall be included in the price bid for the various water main items.

EXISTING UTILITIES: The identity and location of the existing underground utility facilities known to be located in the construction area have been shown on the plans as accurately as provided by the Owner of the underground utility. The City of Gahanna and/or Engineer assumes no responsibility as to the accuracy or the depths of the underground facilities shown on the plans.

Support, protection and restoration of all existing utilities and appurtenances shall be the responsibility of the Contractor. The cost of this work shall be included in the price bid for the various items.

The Contractor shall cause notice to be given to the Ohio Utilities Protection Service (telephone 800-362-2764 - toll free) and to the Owners of underground utility facilities shown on the plans who are not members of a registered underground protection service in accordance with Section 153.64 of the Revised Code. The above mentioned notice shall be given at least 48 hours prior to start of construction.

The Owner/Developer shall provide a Soils Engineer, registered in the State of Ohio, for the purpose of inspecting and certifying to the City of Gahanna, acceptable soil bearing conditions prior to placement of improvements within the right-of-way and easements in accordance with the appropriate O.D.O.T. specifications.

All site clearing (tree removal) shall be performed by the Owner at his expense prior to construction of this project.

BENCH MARKS

B.M. - R.R. Spike in South Side of Power Pole 245'±
South of North Property Line along U.S. Rte. 62.
Elevation = 924.31

B.M. - R.R. Spike in South Side of Power Pole 130'±
North of South Property Line along U.S. Rte. 62.
Elevation = 916.44

B.M. - P.K. Nail in South Side 8" Tree near N.E. Corner
Conroy Tract.
Elevation = 893.85

PREPARED BY
EVANS, MECHWART, HAMBLETON & TILTON, INC.
CONSULTING ENGINEERS & SURVEYORS
GAHANNA, OHIO


By David A. Finney 4-26-89
Registered Engineer Date

Revised Sheet 3
Add 8" Valve & Plug at Sta. 14+29.1, TIM-TAM AVE. &
Reloc. Water Service (Lot 158)
Michael J. Smith 9/25/89

STANDARD CONSTRUCTION DRAWINGS

The Std. Const. Dwgs. listed on these plans shall be considered a part thereof.

G-1
G-8
G-12
G-38
G-39

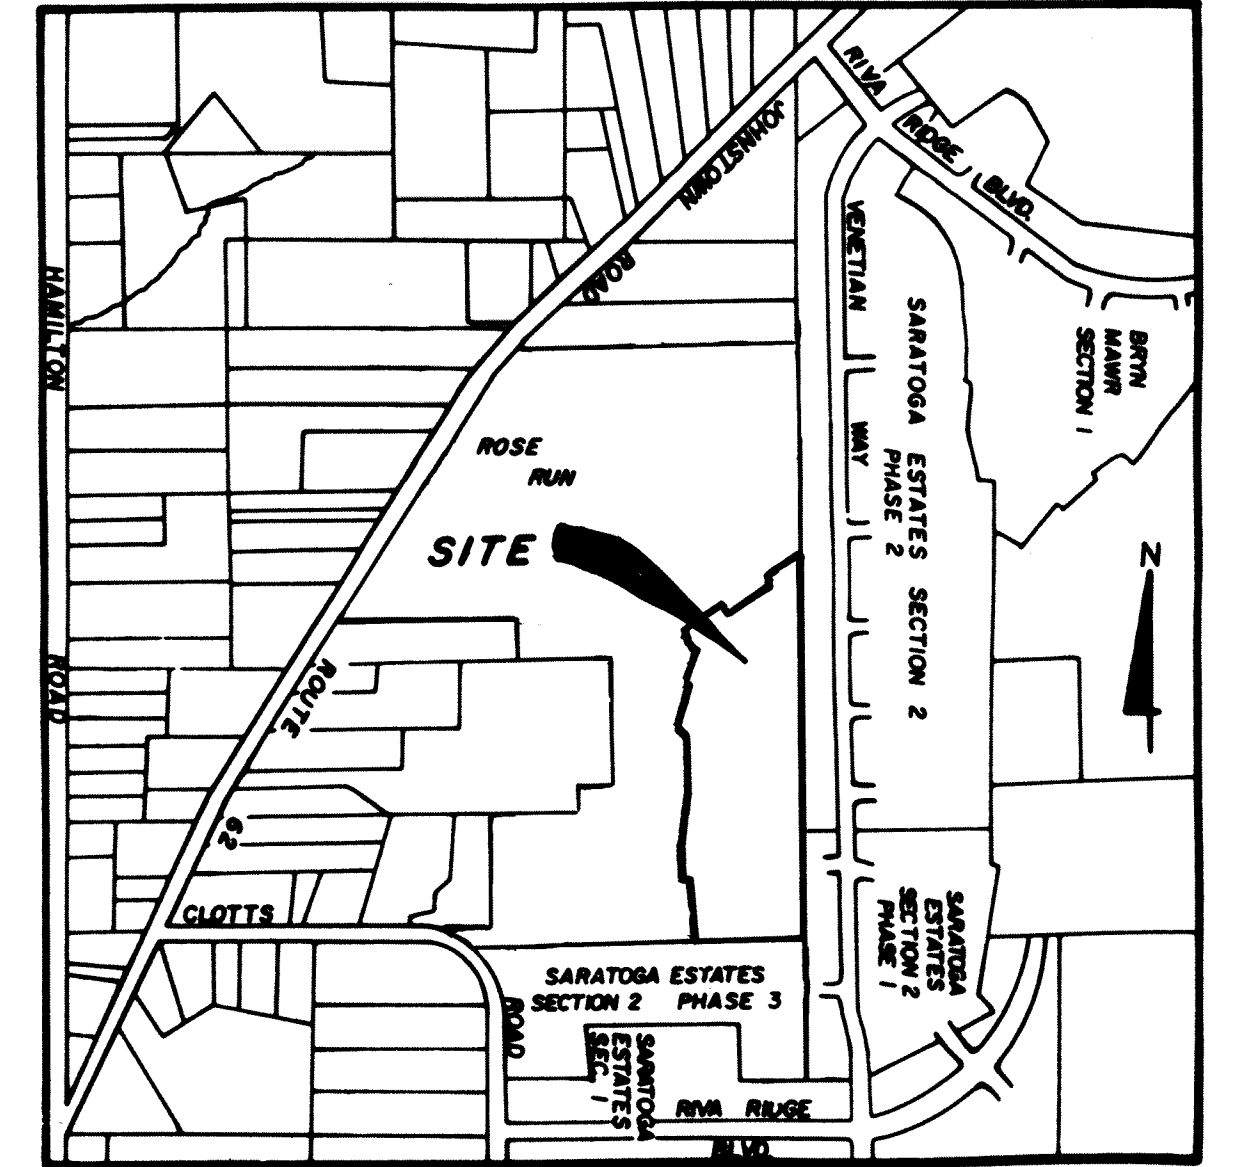

LOCATION MAP & BACKGROUND DRAWING
SCALE: 1" = 800'

ESTIMATE OF QUANTITIES			
ITEM	QUAN.	UNIT	DESCRIPTION
203	6,550	Cu. Yds.	Excavation Including Embankment Construction
305	7,730	Sq. Yds.	7" Portland Cement Concrete Base
402	275	Cu. Yds.	Asphalt Concrete
404	275	Cu. Yds.	Asphalt Concrete
407	782	Gals.	Bituminous Tack Coat
605	5,275	Lin. Ft.	4" Underdrain
608	240	Sq. Ft.	Concrete Curb Ramps
609	2,085	Lin. Ft.	Concrete Combination Curb & Gutter
609	3,200	Lin. Ft.	Mountable Curb
Spec.	161	Lin. Ft.	Expansion Joint
202	Lump	L.S.	61'± - Ex. 15" Pipe & Ex. C.B. Removed & Dispose of (See Sht. 5)
603	190	Lin. Ft.	12" Conduit, Type B, 706.02, CL II
603	980	Lin. Ft.	12" Conduit, Type E, 706.01, CL II
603	25	Lin. Ft.	15" Conduit, Type E, 706.02, Concrete Encasement
603	26	Lin. Ft.	15" Conduit, Type E, 706.01, CL II
603	40	Lin. Ft.	15" Conduit, Type B, 706.02, CL II
603	290	Lin. Ft.	18" Conduit, Type E, 706.02, CL II
603	100	Lin. Ft.	21" Conduit, Type B, 706.02, CL II
603	315	Lin. Ft.	21" Conduit, Type E, 706.02, CL II
603	255	Lin. Ft.	24" Conduit, Type E, 706.02, CL II
603	30	Lin. Ft.	27" Conduit, Type B, 706.02, CL II
603	90	Lin. Ft.	27" Conduit, Type E, 706.02, CL II
604	10	Each	Manhole, Type A
604	5	Each	Curb & Gutter Inlet (Mountable)
604	8	Each	Curb & Gutter Inlet (Std. Curb) Cols. AA-S125, Top AA-S128
604	3	Each	2'-2"-B Catch Basin
Lump	L.S.		Street Lighting (11 Decorative Standard - 3 Control Site) HADC0 Series 72, Model vs. with P-1740 Post
WATER MAIN ITEMS			
1,040	Lin. Ft.	8" Water Main	
1,160	Lin. Ft.	6" Water Main	
1,195	Lin. Ft.	2" Water Main	
10	Each	6" Valve & Box (Includes Hyd. Valves)	
1	Each	2" Valve & Box	
31	Each	3/4" Water Services (Short)	
14	Each	3/4" Water Services (Long)	
6	Each	Fire Hydrant - Mueller Centurion (4 1/2")	


Signatures below signify only concurrence with the general purpose of this project. All technical details are the responsibility of Evans, Mechwart, Hambleton & Tilton, Inc., Consulting Engineers and Surveyors.

Michael J. Smith 9/25/89
City Engineer, City of Gahanna, Ohio
Richard Lyon 6/16/89
Superintendent, Division of Streets, City of Gahanna, Ohio
Wayne Murphy 6/16/89
Director of Public Services, City of Gahanna, Ohio
W. James John 6/16/89
Director of Finance, City of Gahanna, Ohio
James P. McLeary 6/7/89
Mayor, City of Gahanna, Ohio


**CORDERO LANE
TURCOTTE DRIVE**

TYPICAL 26' SECTION (50' R/W)

**AFFIRMED COURT
BOREL COURT
TURCOTTE COURT**


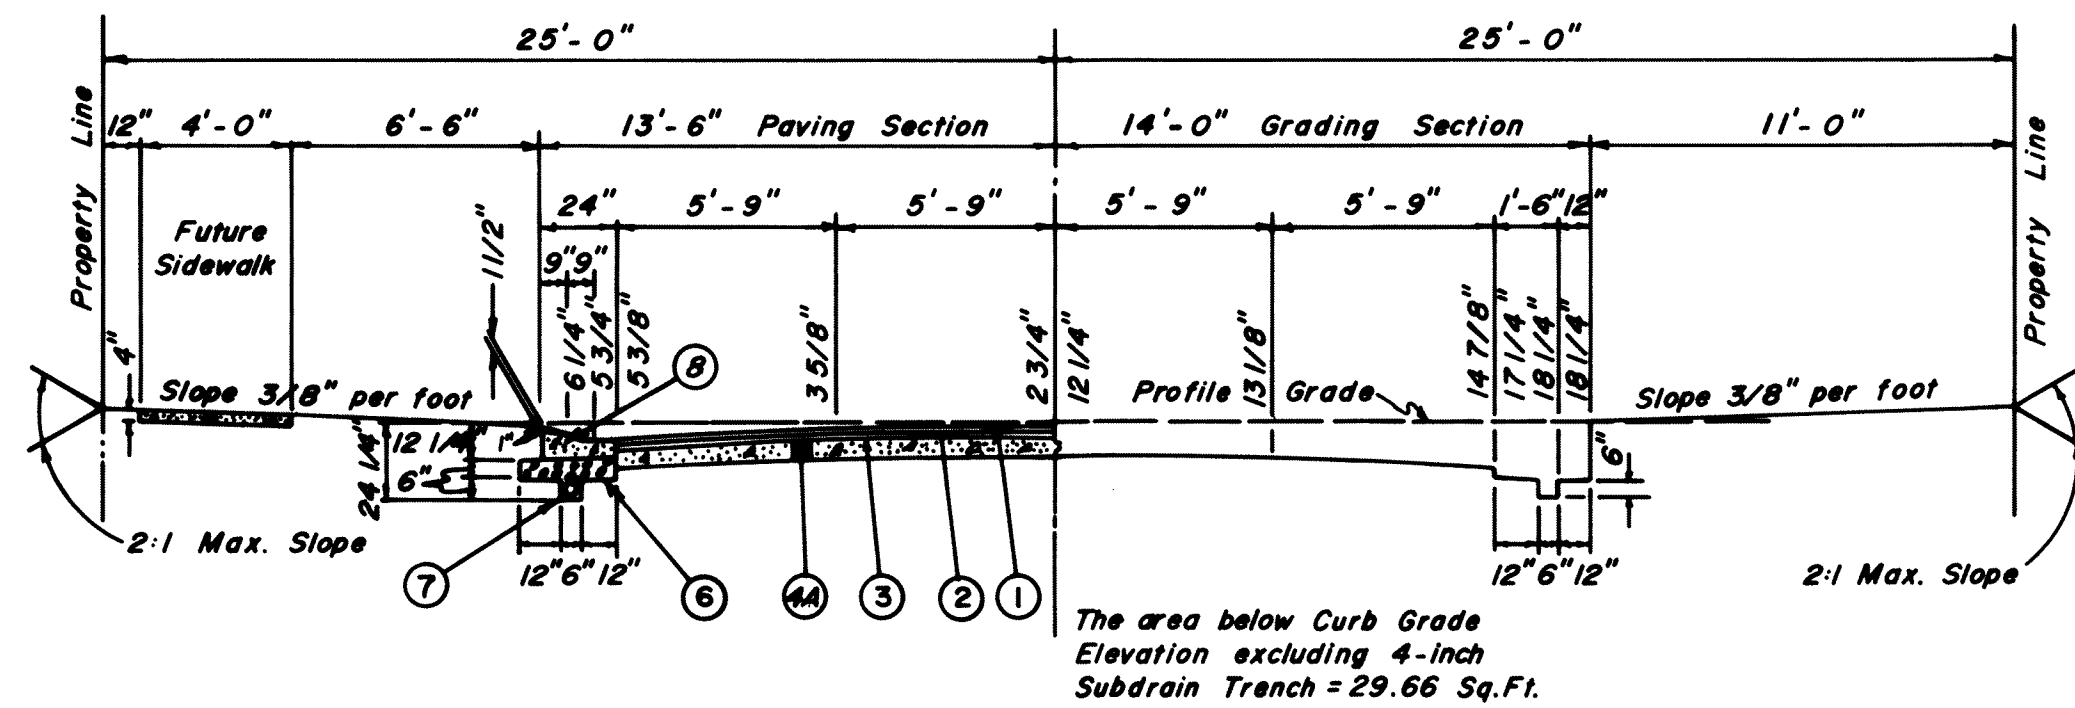


TYPICAL 30' SECTION (60' R/W)


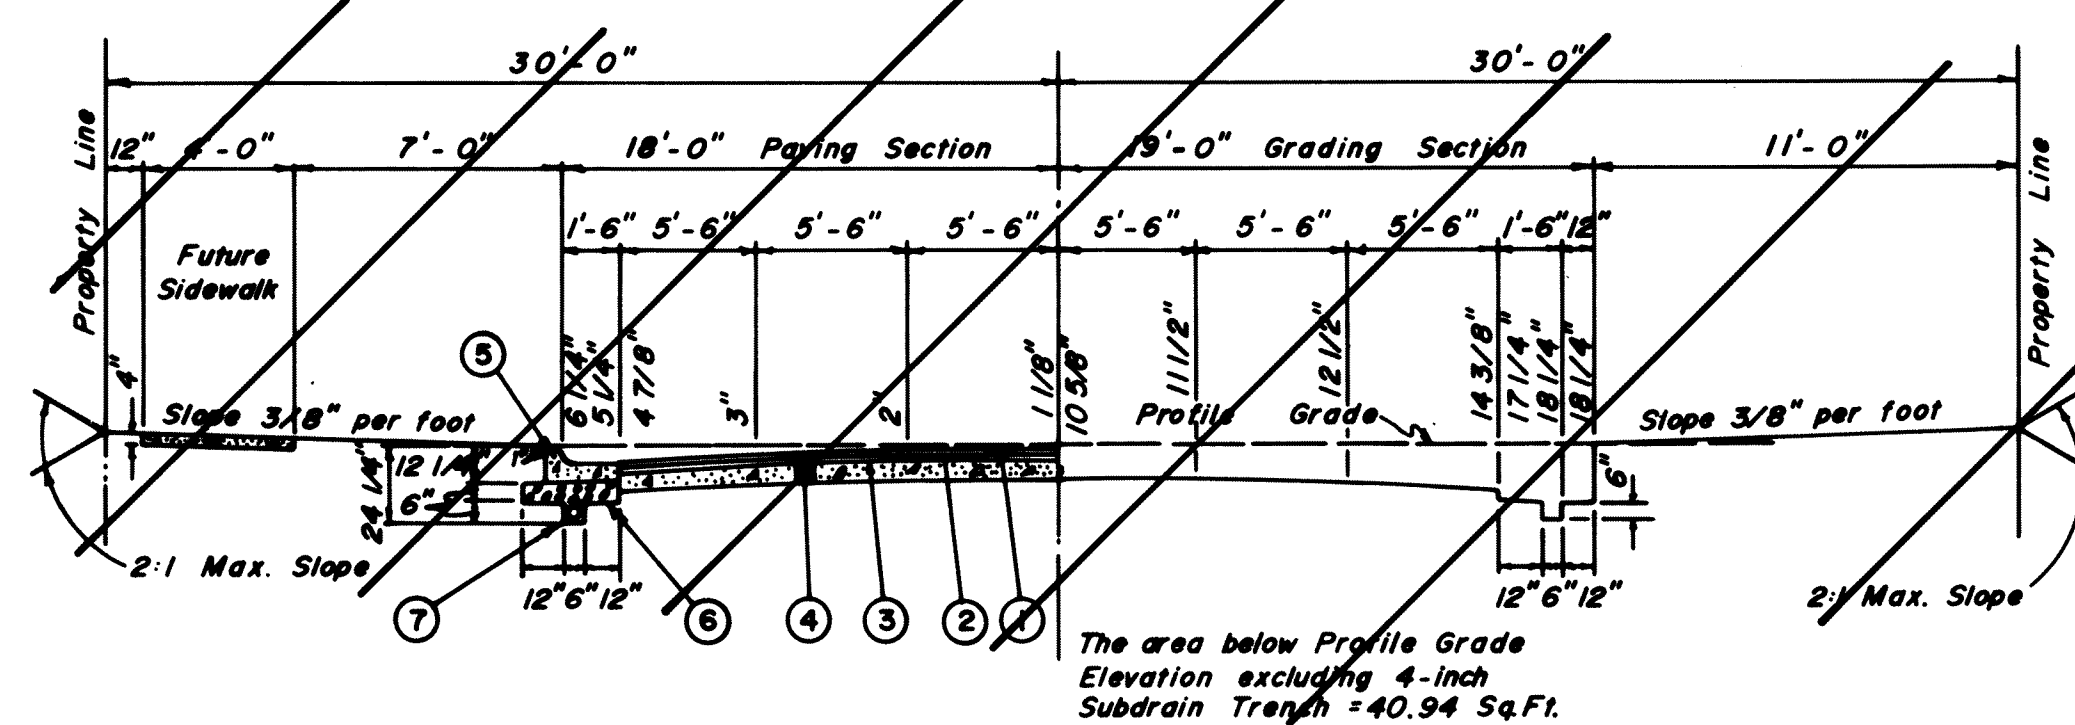


TYPICAL 26' SECTION (50' R/W)


TIM - TAM AVENUE

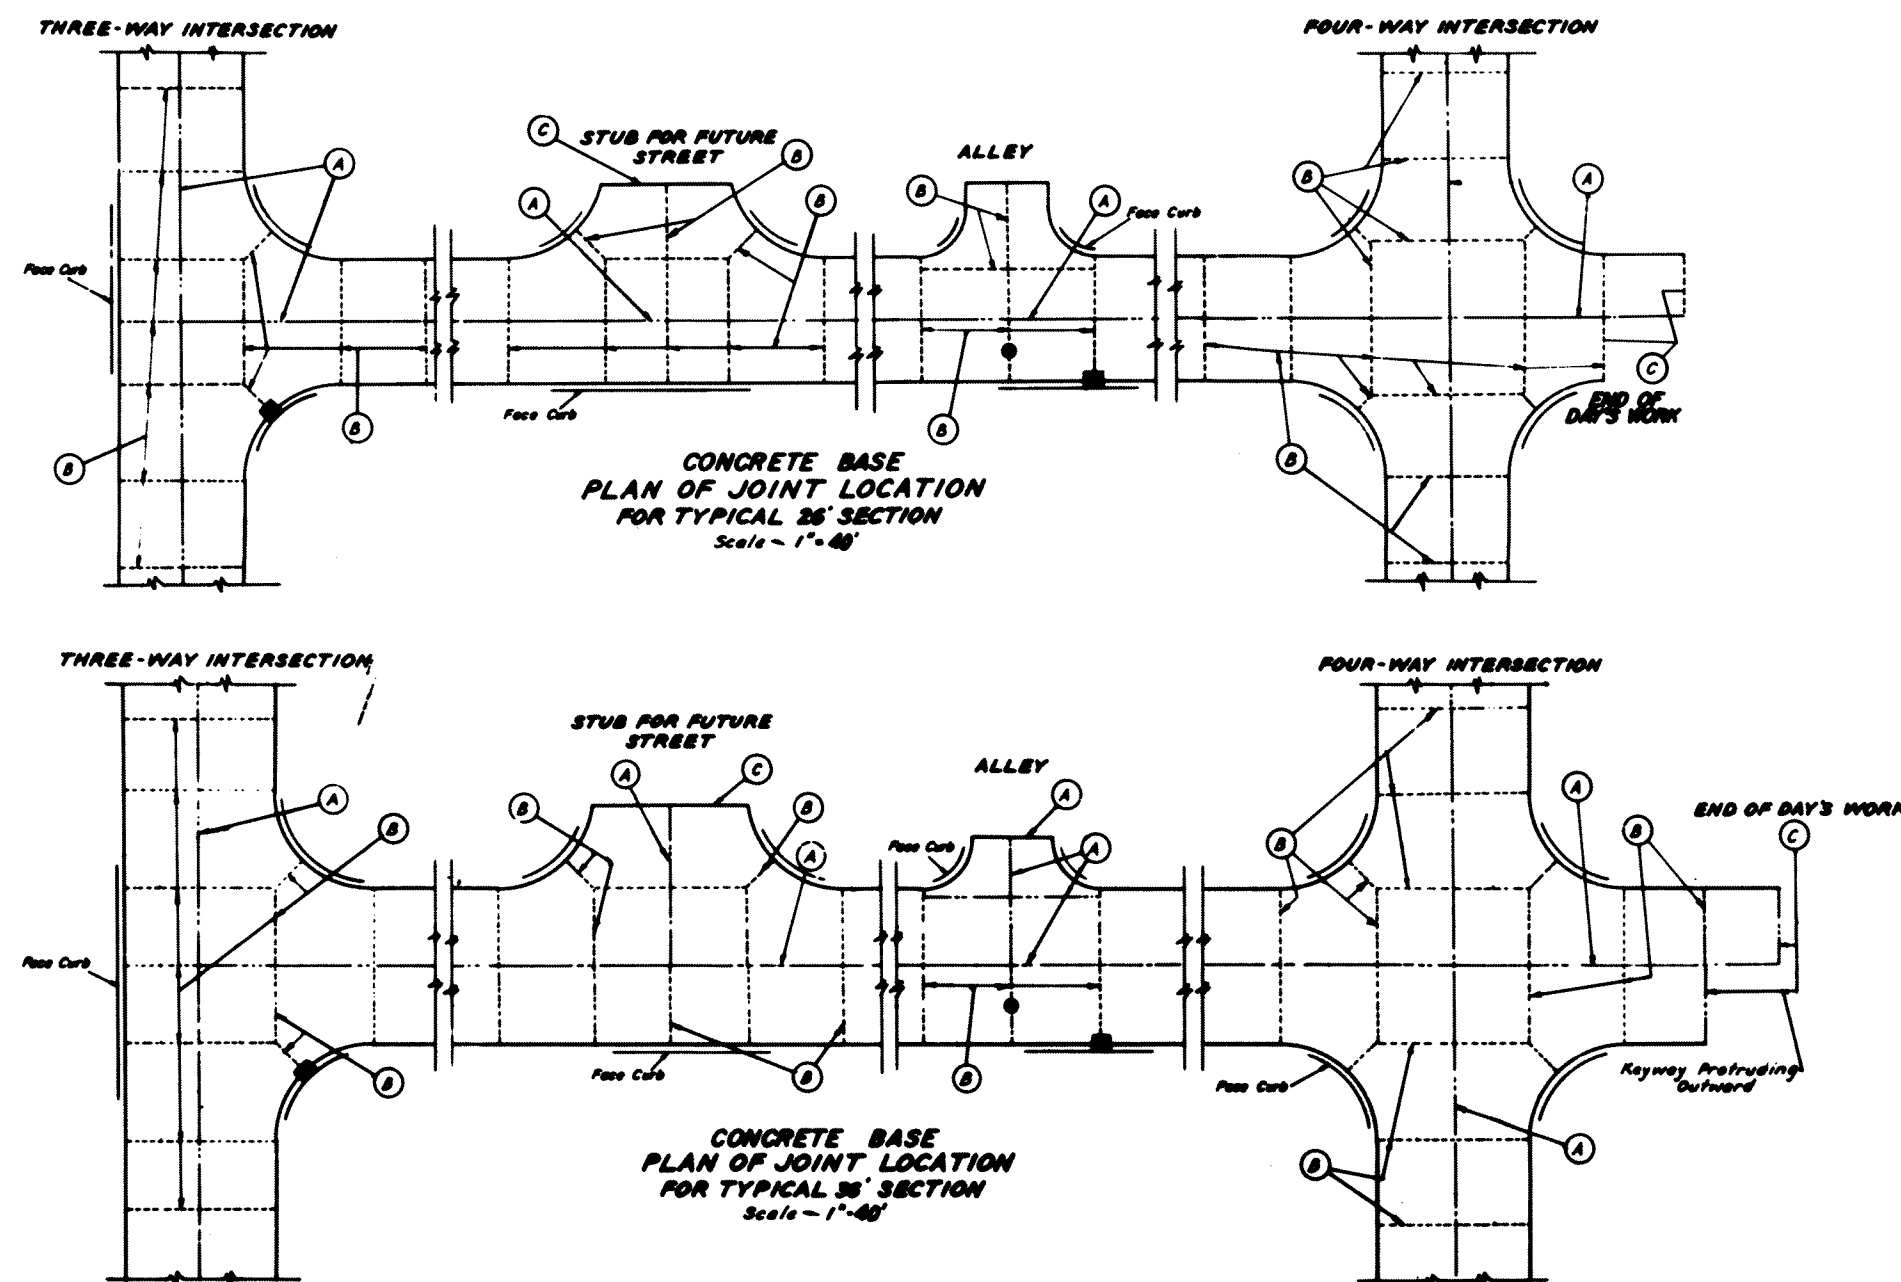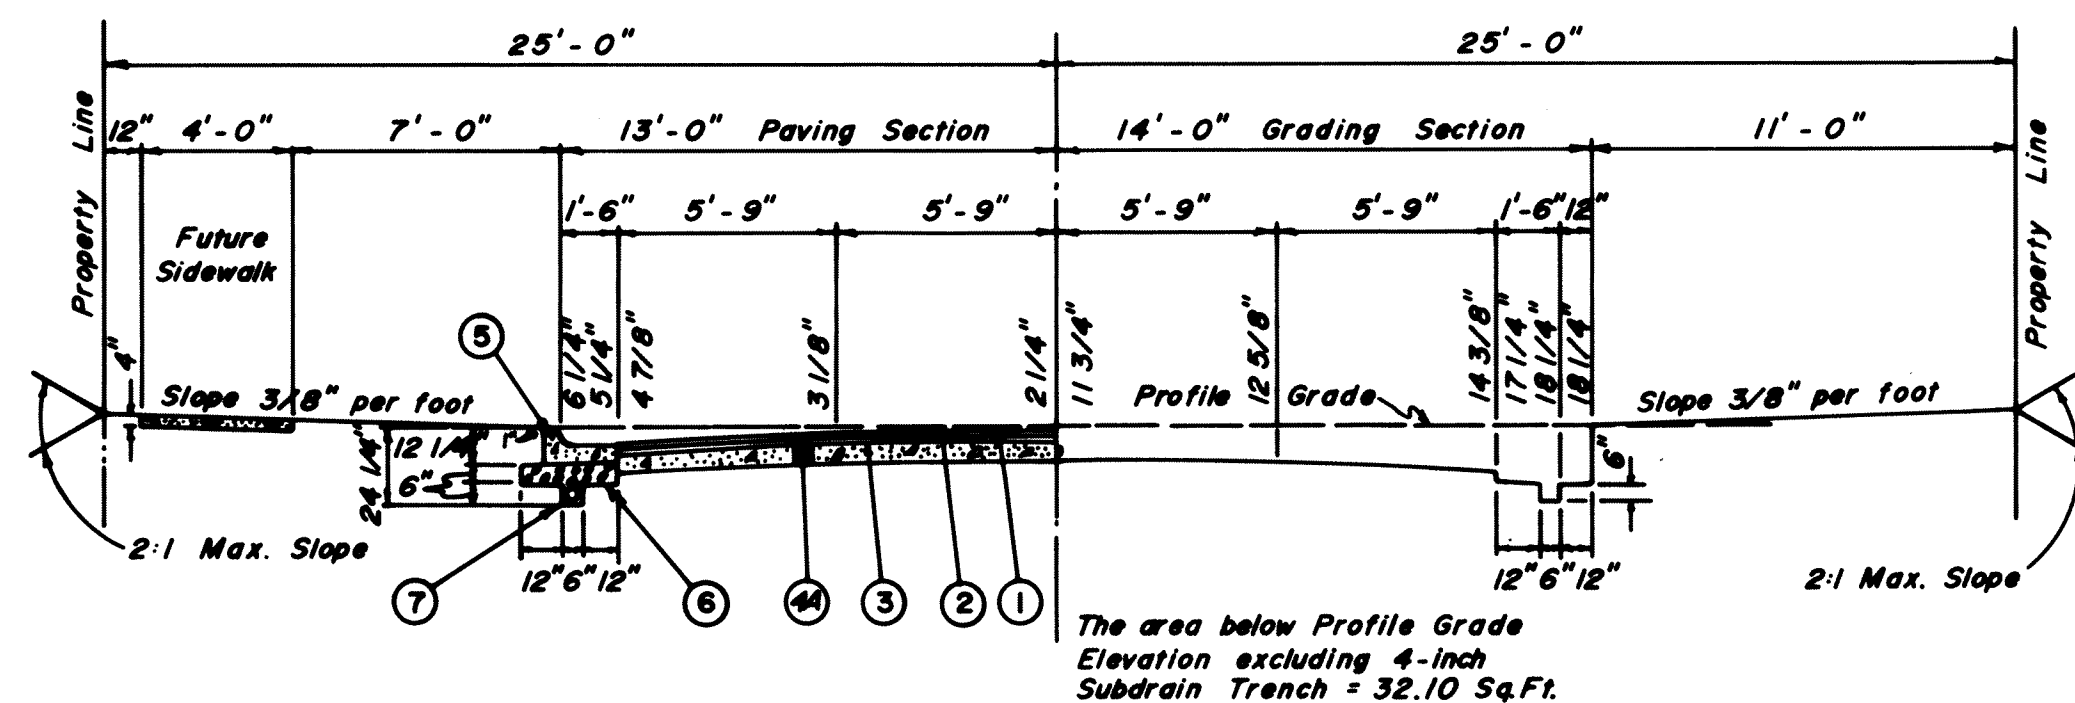


TYPICAL 32' SECTION (60' R/W)

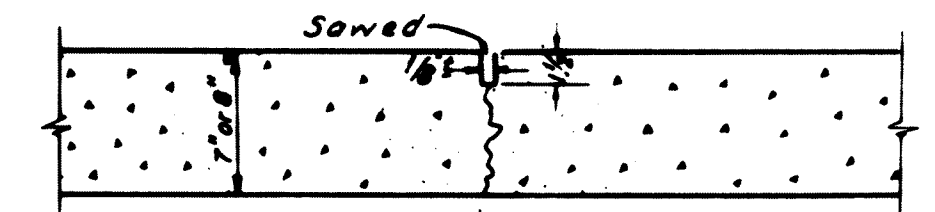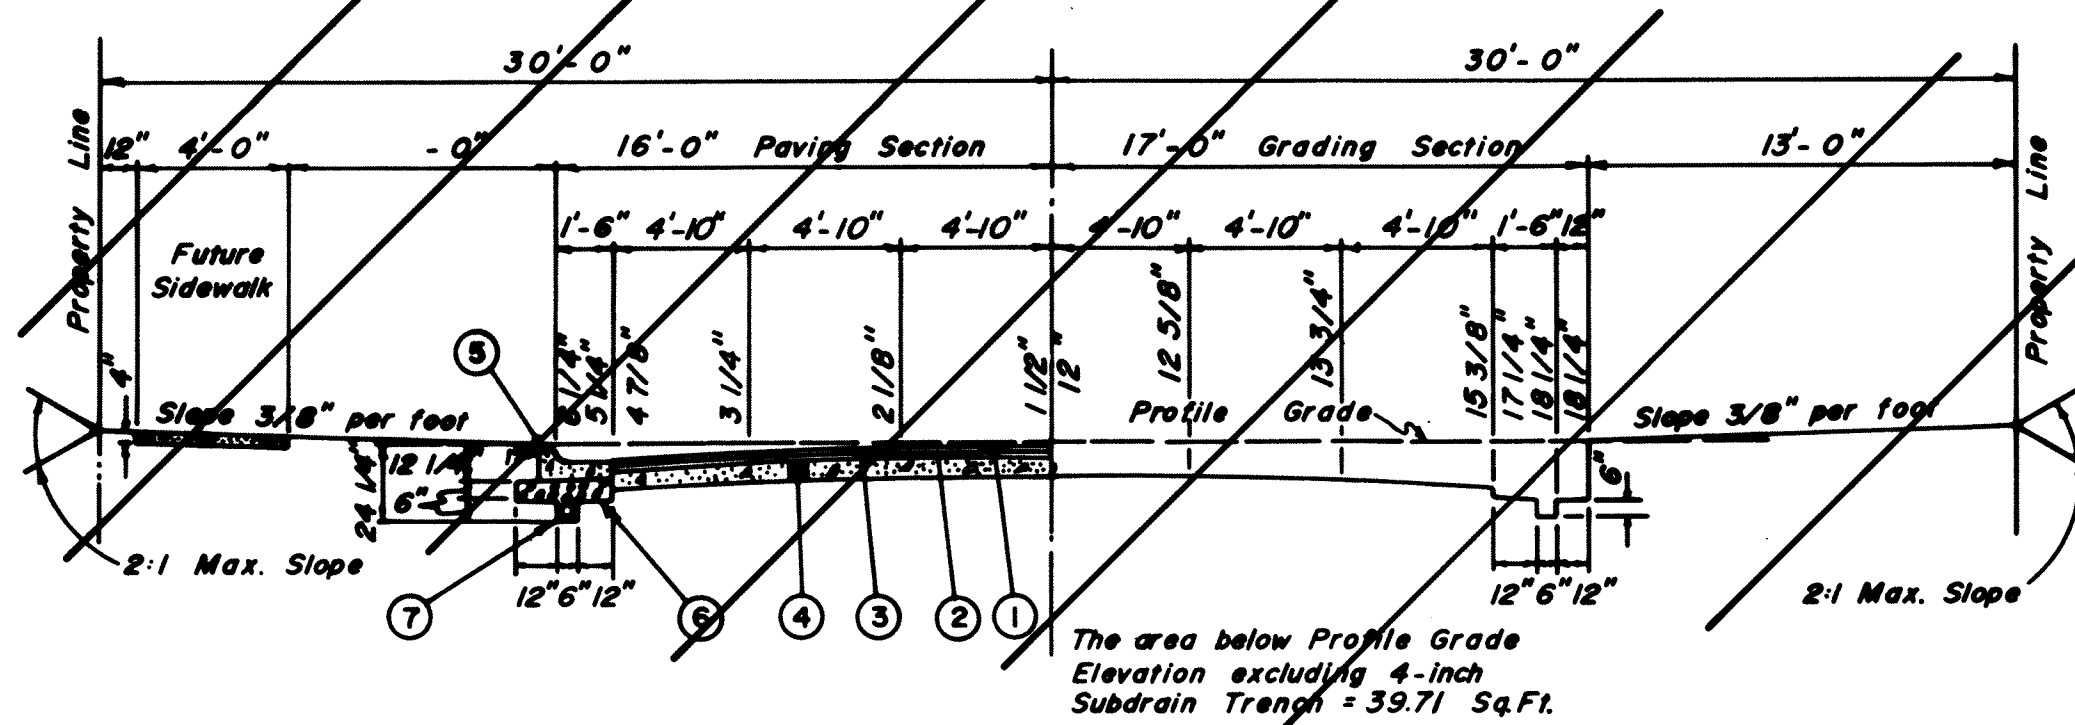


CONTRACTION JOINT (B)
Maximum spacing of Sawed Joints shall be 20'
Maximum spacing of Sawed Joints for Service Road shall be 15'

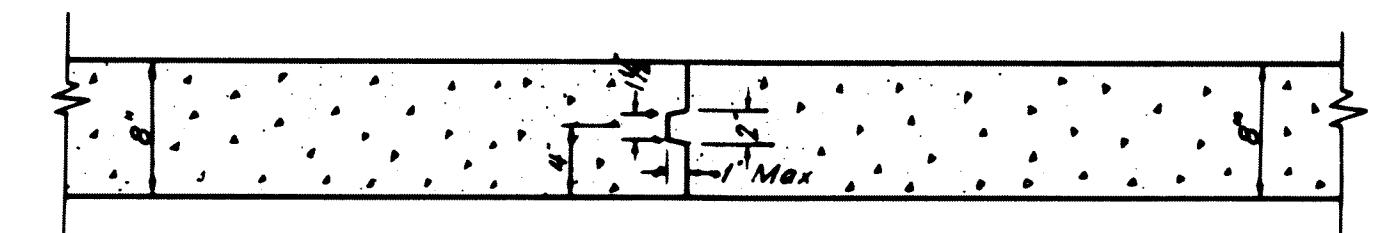


JOINT A & C

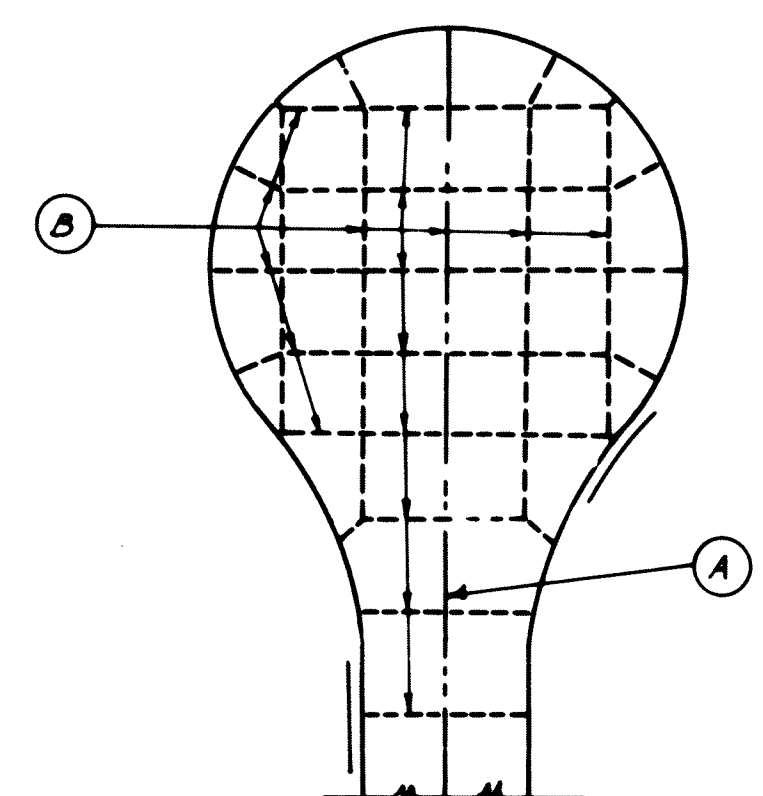


**CUL-DE-SAC
FULLY PAVED**
Scale - 1" = 30'

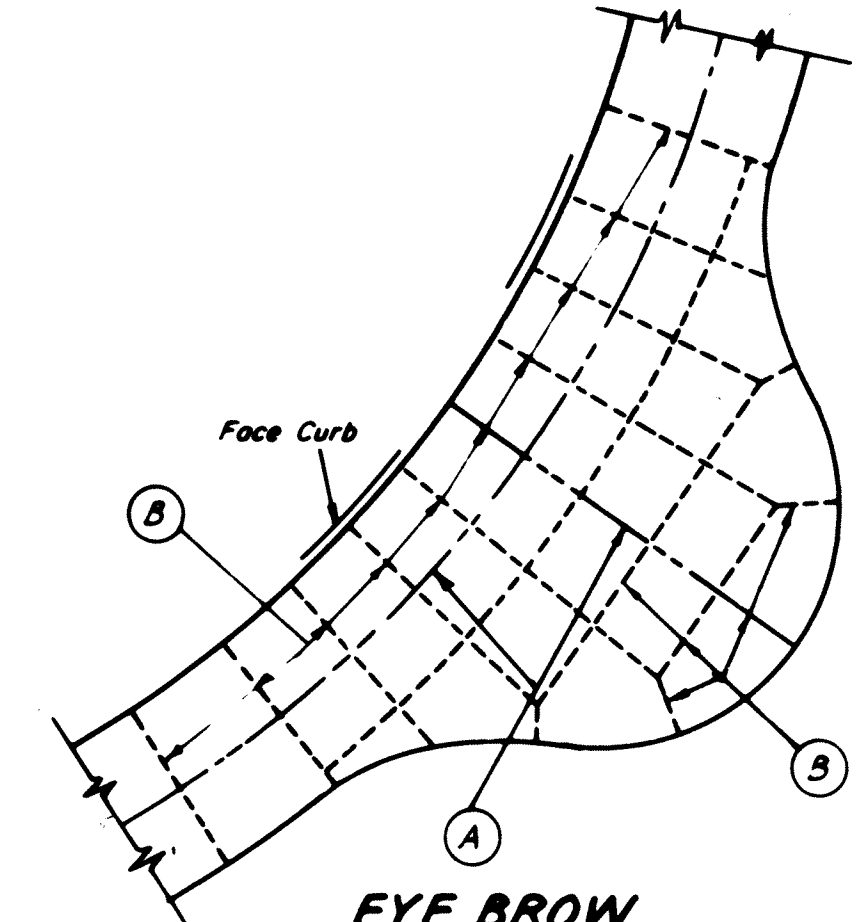


EYE BROW
Scale 1" = 30'

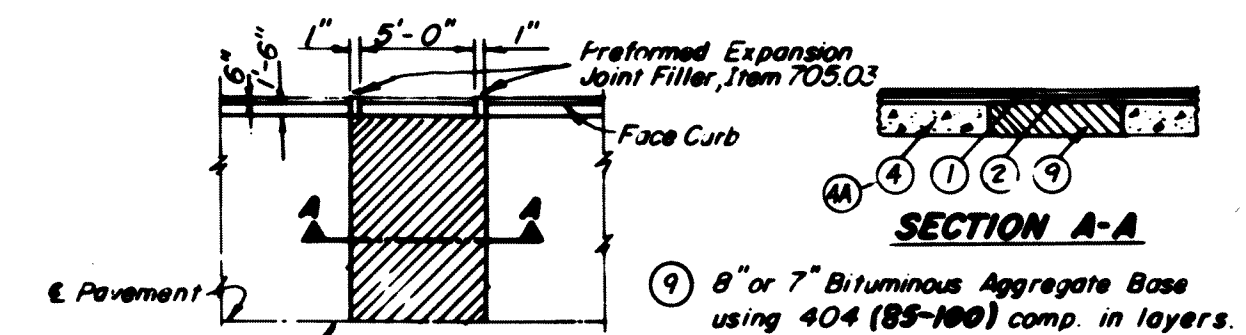


DETAIL OF EXPANSION JOINT
No Scale
Expansion Joints shall be constructed where shown on the plans. The Bituminous Aggr. Base shall be paid for at the price bid per Cu Yd. for Item 404 Asph. Concrete.

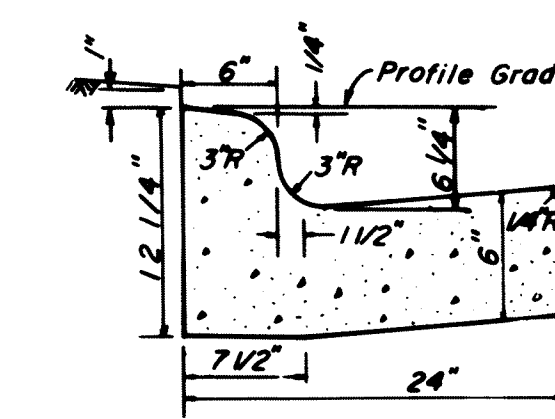

COMBINATION CURB & GUTTER

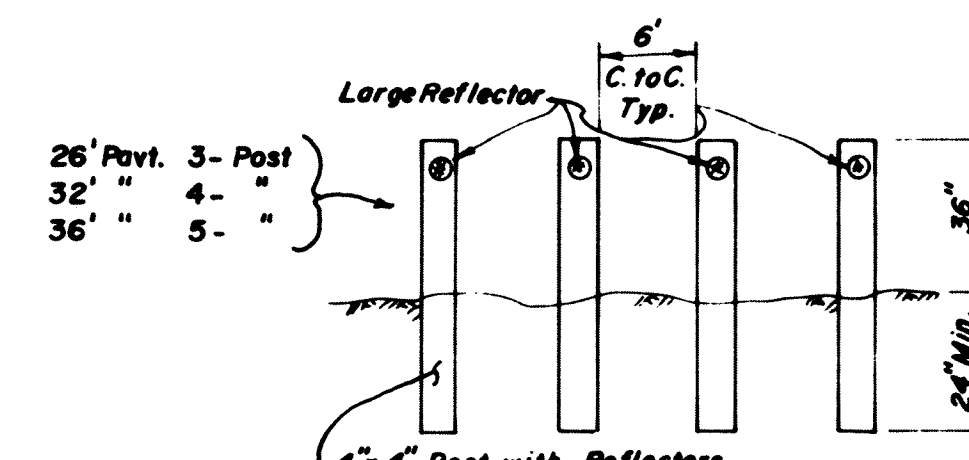

DETAIL OF TEMPORARY BARRICADE

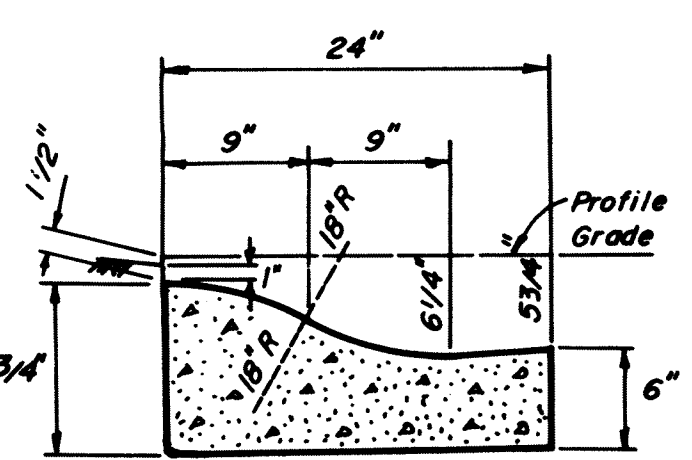

MOUNTABLE CURB

The Specifications of the State of Ohio, Department of Transportation, including all supplements thereto, in force on date of contract, together with the requirements of the City of Gahanna shall govern all materials and workmanship involved in construction.

All item numbers are in accordance with the Ohio Department of Transportation, modified as noted.

- ① 1 1/4" Hot-Mixed, Hot-Laid Asphalt Concrete, Item 404 (85-100) with Modification to State Highway Specifications Asphalt Concrete shall contain all crushed Aggregate. Joints for Asphalt Concrete shall be staggered.
- ② 1 1/4" Hot-Mixed, Hot-Laid Asphalt Concrete, Item 402 (85-100).
- ③ Bituminous Tack Coat, Item 407. Bituminous Material 702.02, RS-1 or an approved equal applied 0.1 Gal. per Sq. Yd. and cover aggregate consisting of crushed gravel or limestone Size No. 9.
- ④ 8" Portland Cement Concrete Base, Item 305 modified as follows, City of Gahanna, Class E Concrete, 510 lbs. Portland Cement per cubic yard, 3% to 6% Air Entrainment and 3" max. slump. (This item also conforms to City of Columbus Construction & Material Specification Item 305.) The use of an approved single beam vibrating screen will be required and Transverse Contraction Joints shall be sawed as per this plan.
- ④A 7" Portland Cement Concrete Base, Item 305 modified as follows, City of Gahanna, Class B Concrete, 380 lbs. Portland Cement per cubic yard, 3% to 5% Air Entrainment and 4.5" max. slump. (This item also conforms to City of Columbus Construction & Material Specification, Item 306.) The use of an approved single beam vibrating screen will be required and Transverse Contraction Joints shall be sawed as per this plan.
- Centerline Joint for concrete pavement base shall be sawed if pavement base is constructed full width.
- A subgrade planer or an automatic subgrader will not be required.
- ⑤ Concrete Combined Curb & Gutter, Item 609, modified as follows, City of Gahanna, Class F Concrete, 560 lbs. Portland Cement per cubic Yard, 4% to 8% Air Entrainment and 3" max. slump.
- No. 46 Aggregate.
- ⑦ 4" Pipe Underdrain, Item 605.
- ⑧ Mountable Curb, Item 609, Concrete, Item 499, modified as follows, City of Gahanna, Class F Concrete, 560 lbs. Portland Cement per cubic yard, 4% to 8% Air Entrainment and 3" max. slump.

Sidewalks and Drive Ramps, Item 608, Concrete, Item 499, modified as follows, City of Gahanna, Class F, 560 lbs. Portland Cement per cubic yard, 4% to 8% Air Entrainment and 4" max. slump.

Curing Material shall conform to 705.07, Type 2, and shall be applied with a motor driven pump sprayer.

Sidewalk location shall be determined by the City Engineer.

When the pavement design shown on the typical sections is not adequate for contemplated heavier load requirements, the proposed street sections shall be designed in accordance and agreement with the City Engineer.

In the event excavation for the street is from 0" to 6" below that called for on the plans, the Contractor shall replace this excess excavation material with compacted 46D crushed aggregate as directed, and at no extra cost to the Owner.


Mountable Curb may be used on 26' Residential Streets, subject to approval by the City Engineer. All other streets shall be built using combined curb and gutter.

Two or more curb openings for each lot shall be provided for downspout drains at the time of the permanent construction. Cost to be included in the price bid for Item 609. All curb openings provided after curb construction shall be drilled or sawed for downspout drain placement. (Saw Cut Width 1'-0")

ROSE RUN SECTION 3

CITY OF GAHANNA, OHIO
STANDARD CONSTRUCTION DRAWING
CONSTRUCTION DETAILS FOR
ASPHALT CONCRETE ON P.C. CONCRETE BASE

Approved:
William B. Bosh
CITY ENGINEER, GAHANNA OHIO
Richard V. W. Aron
DIRECTOR OF PUBLIC SERVICE, GAHANNA OHIO
DATE: **2/6**

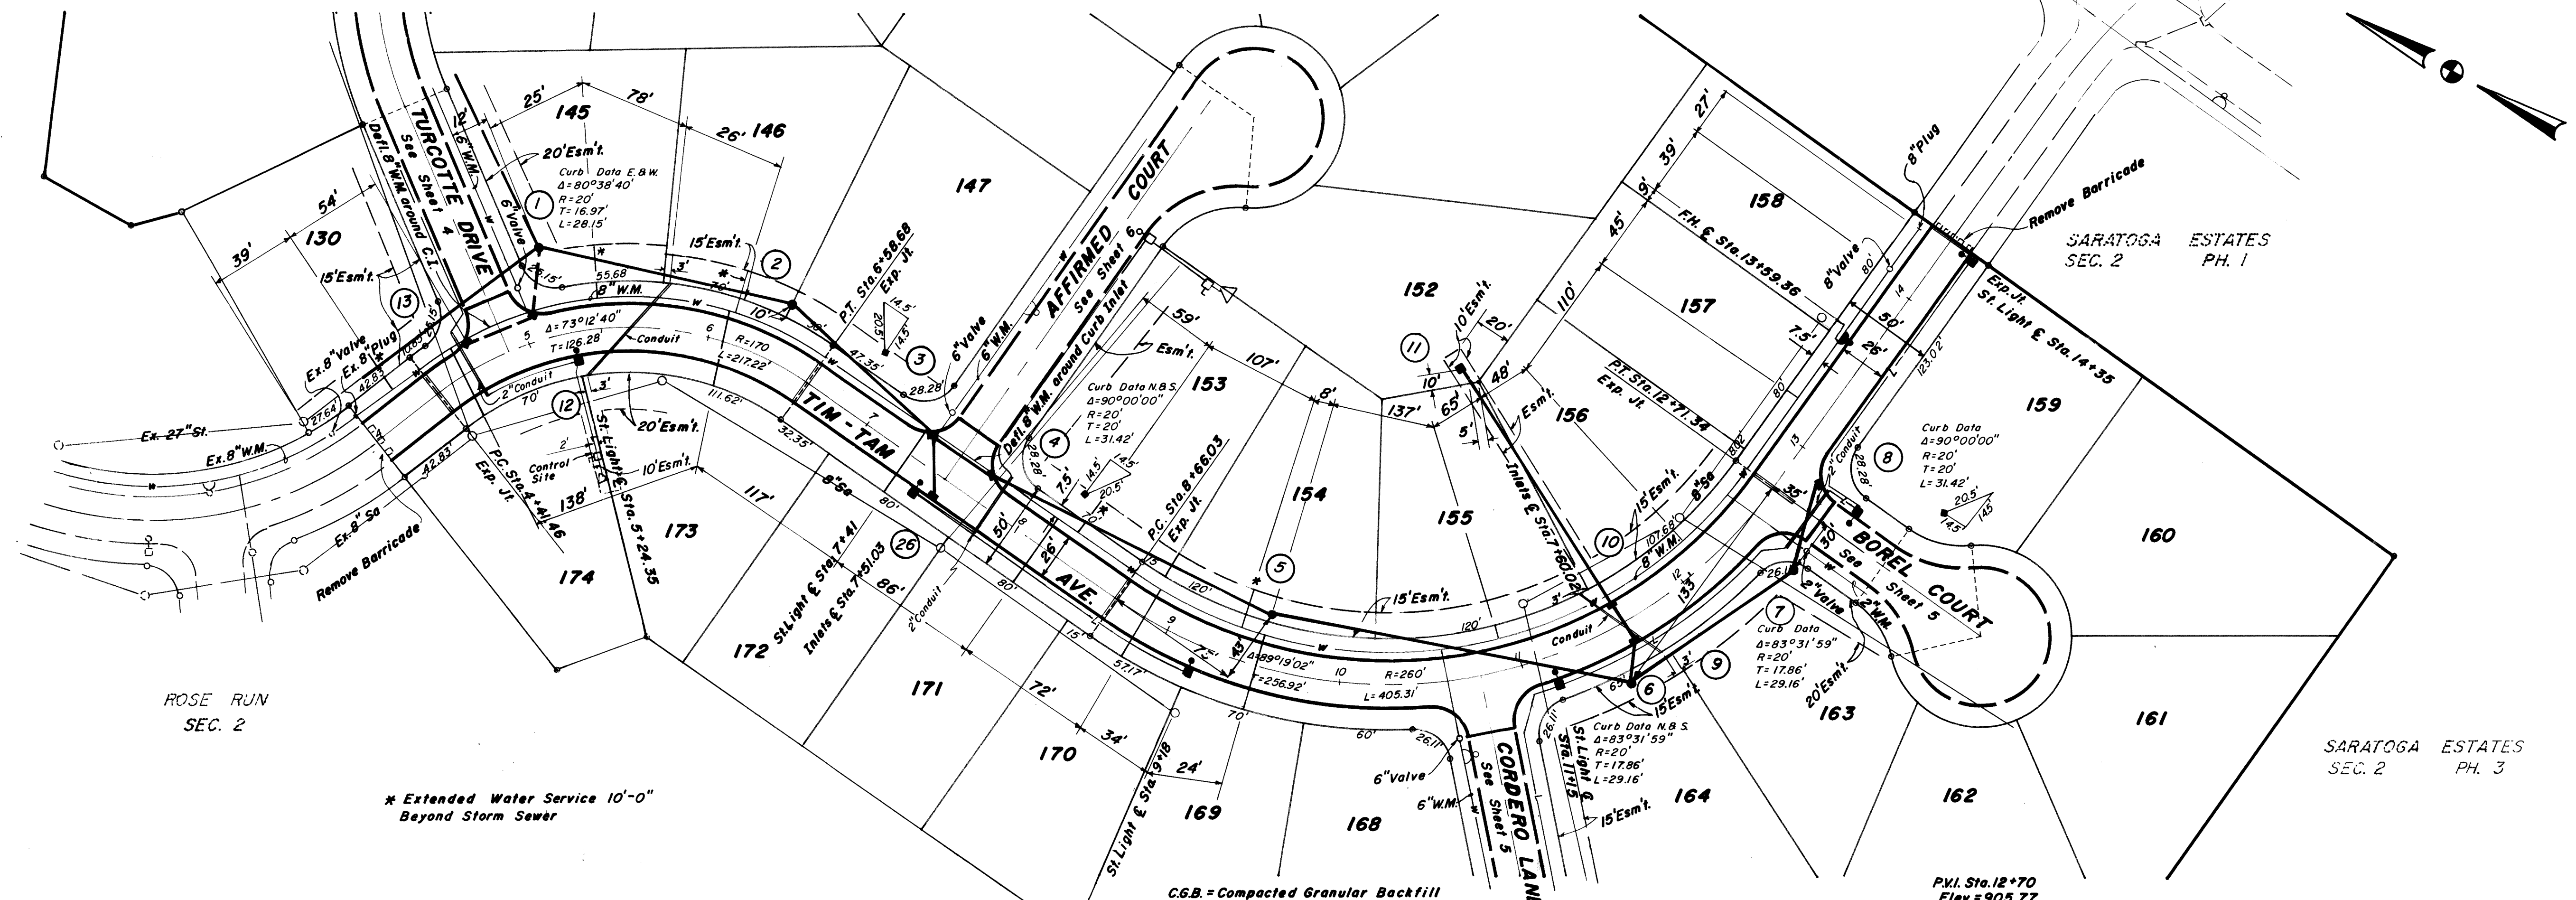

ROSE RUN
SEC. 2


* Extended Water Service 10'-0"
Beyond Storm Sewer

C.G.B. = Compacted Granular Backfill
C.B. = Compacted Backfill

PVI Sta. 12+70
Elev. = 905.77

SARATOGA ESTATES
SEC. 2 PH. 3

X = Ex. Ground @ Left B/L
O = Ex. Ground @ Right B/L

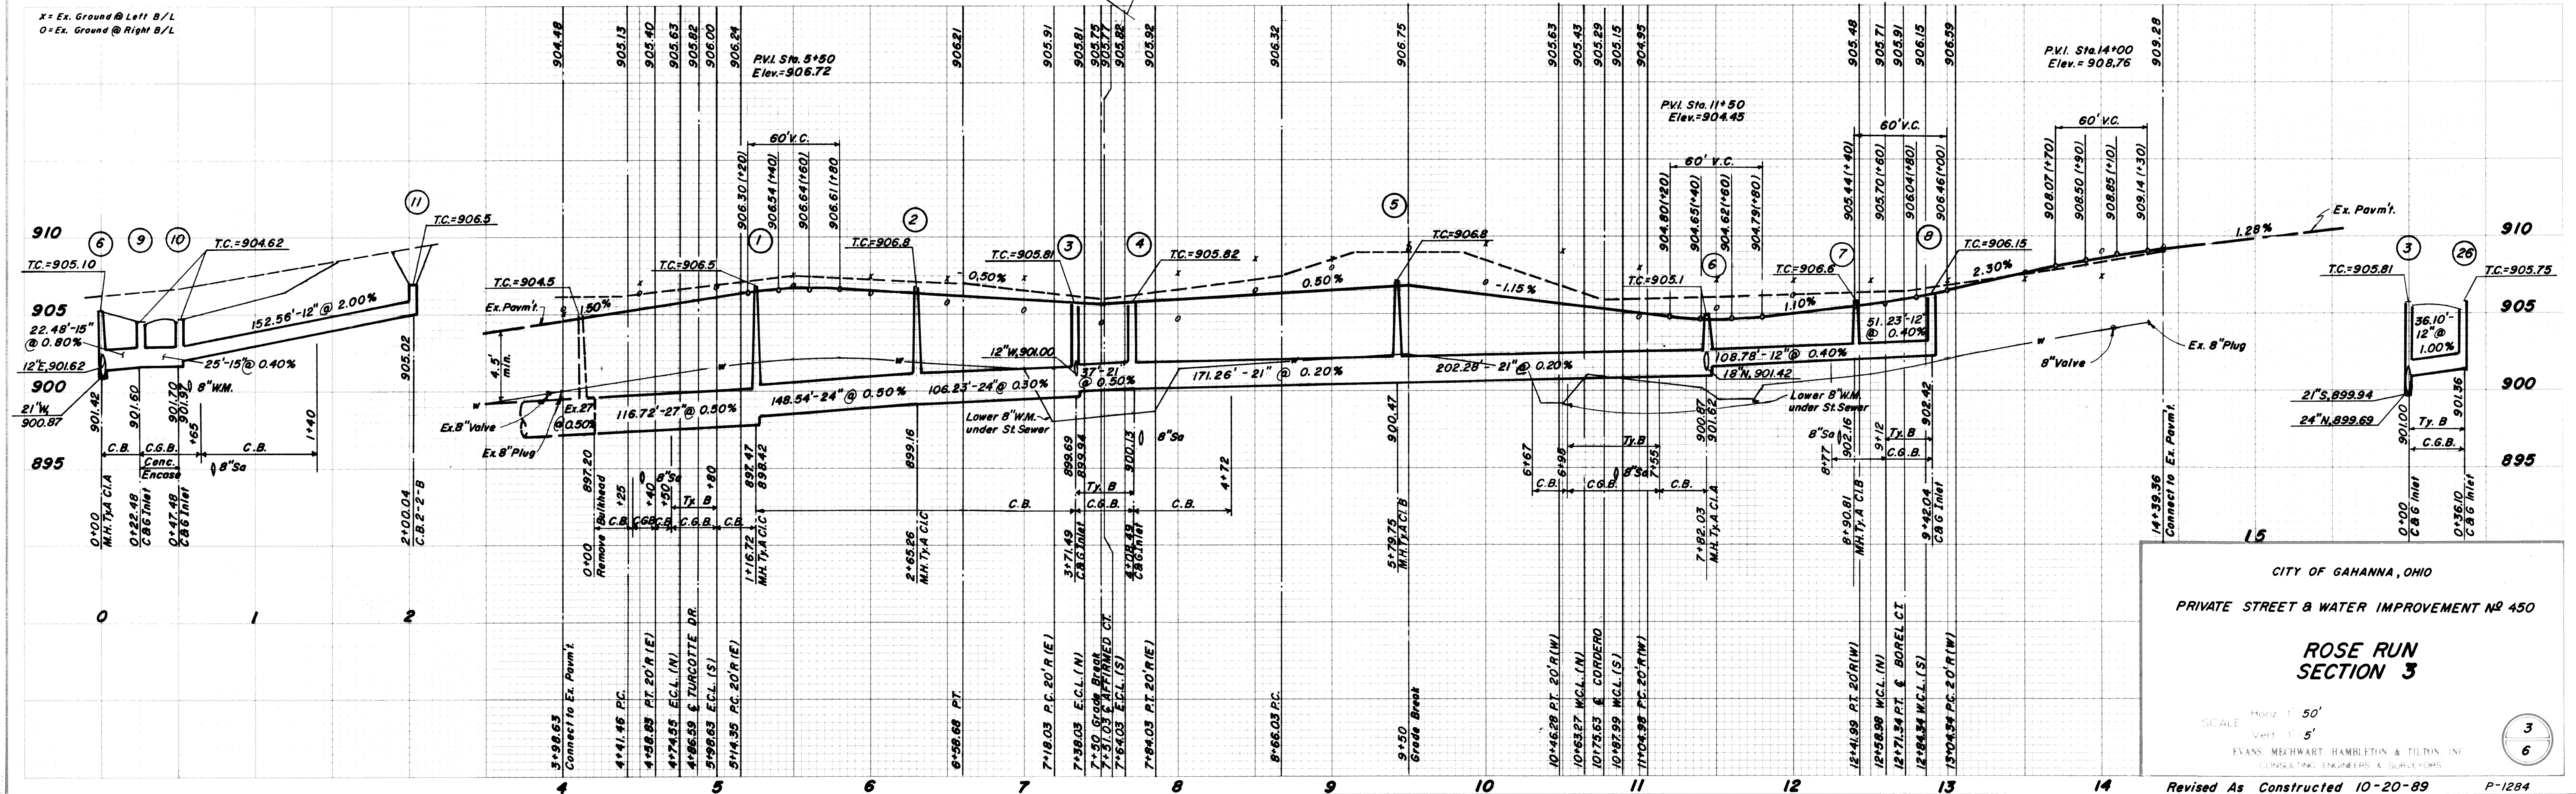

CITY OF GAHANNA, OHIO
PRIVATE STREET & WATER IMPROVEMENT NO. 450

**ROSE RUN
SECTION 3**



SCALE: Horiz. 1" = 50'
Vert. 1" = 5'

EVANS, MECHWART, HAMBLET & TILTON, INC.
CONSULTING ENGINEERS & SURVEYORS




Revised As Constructed 10-20-89 P-1284

Rose Run Section 3


No. 450

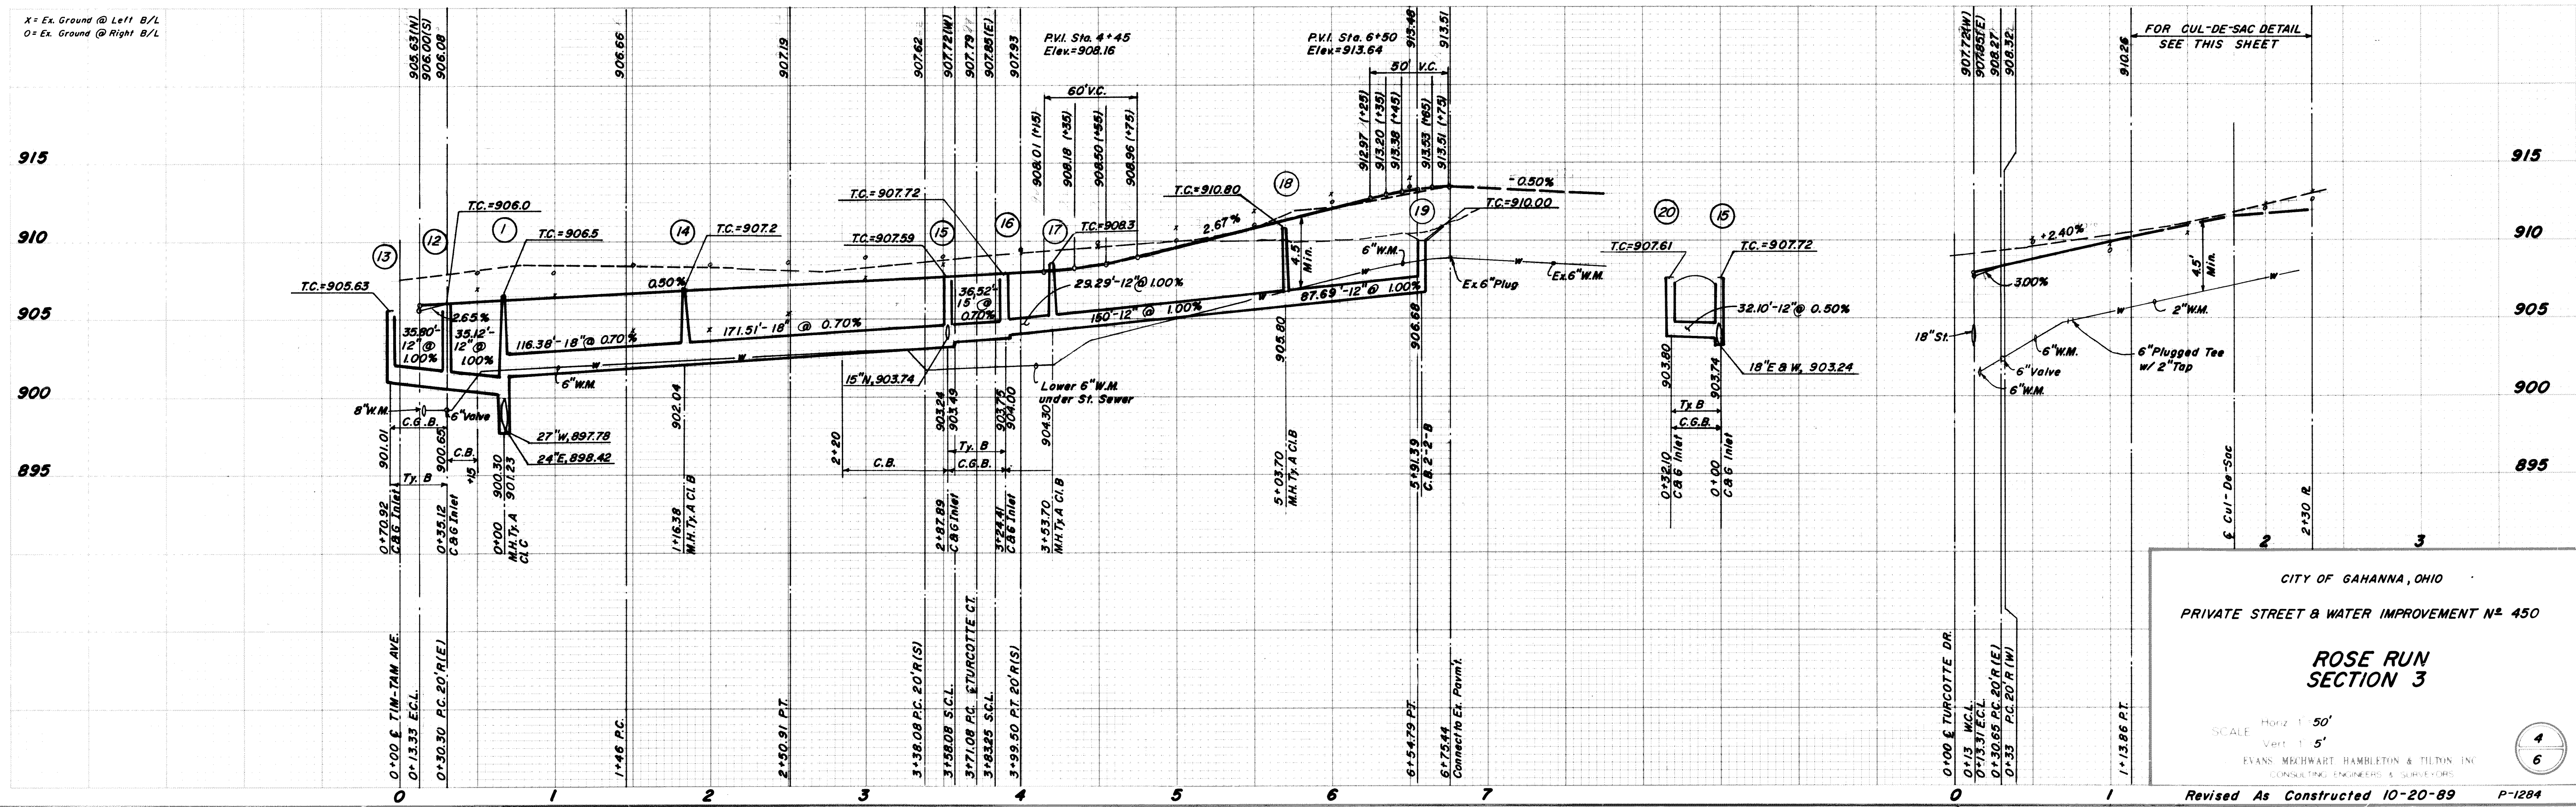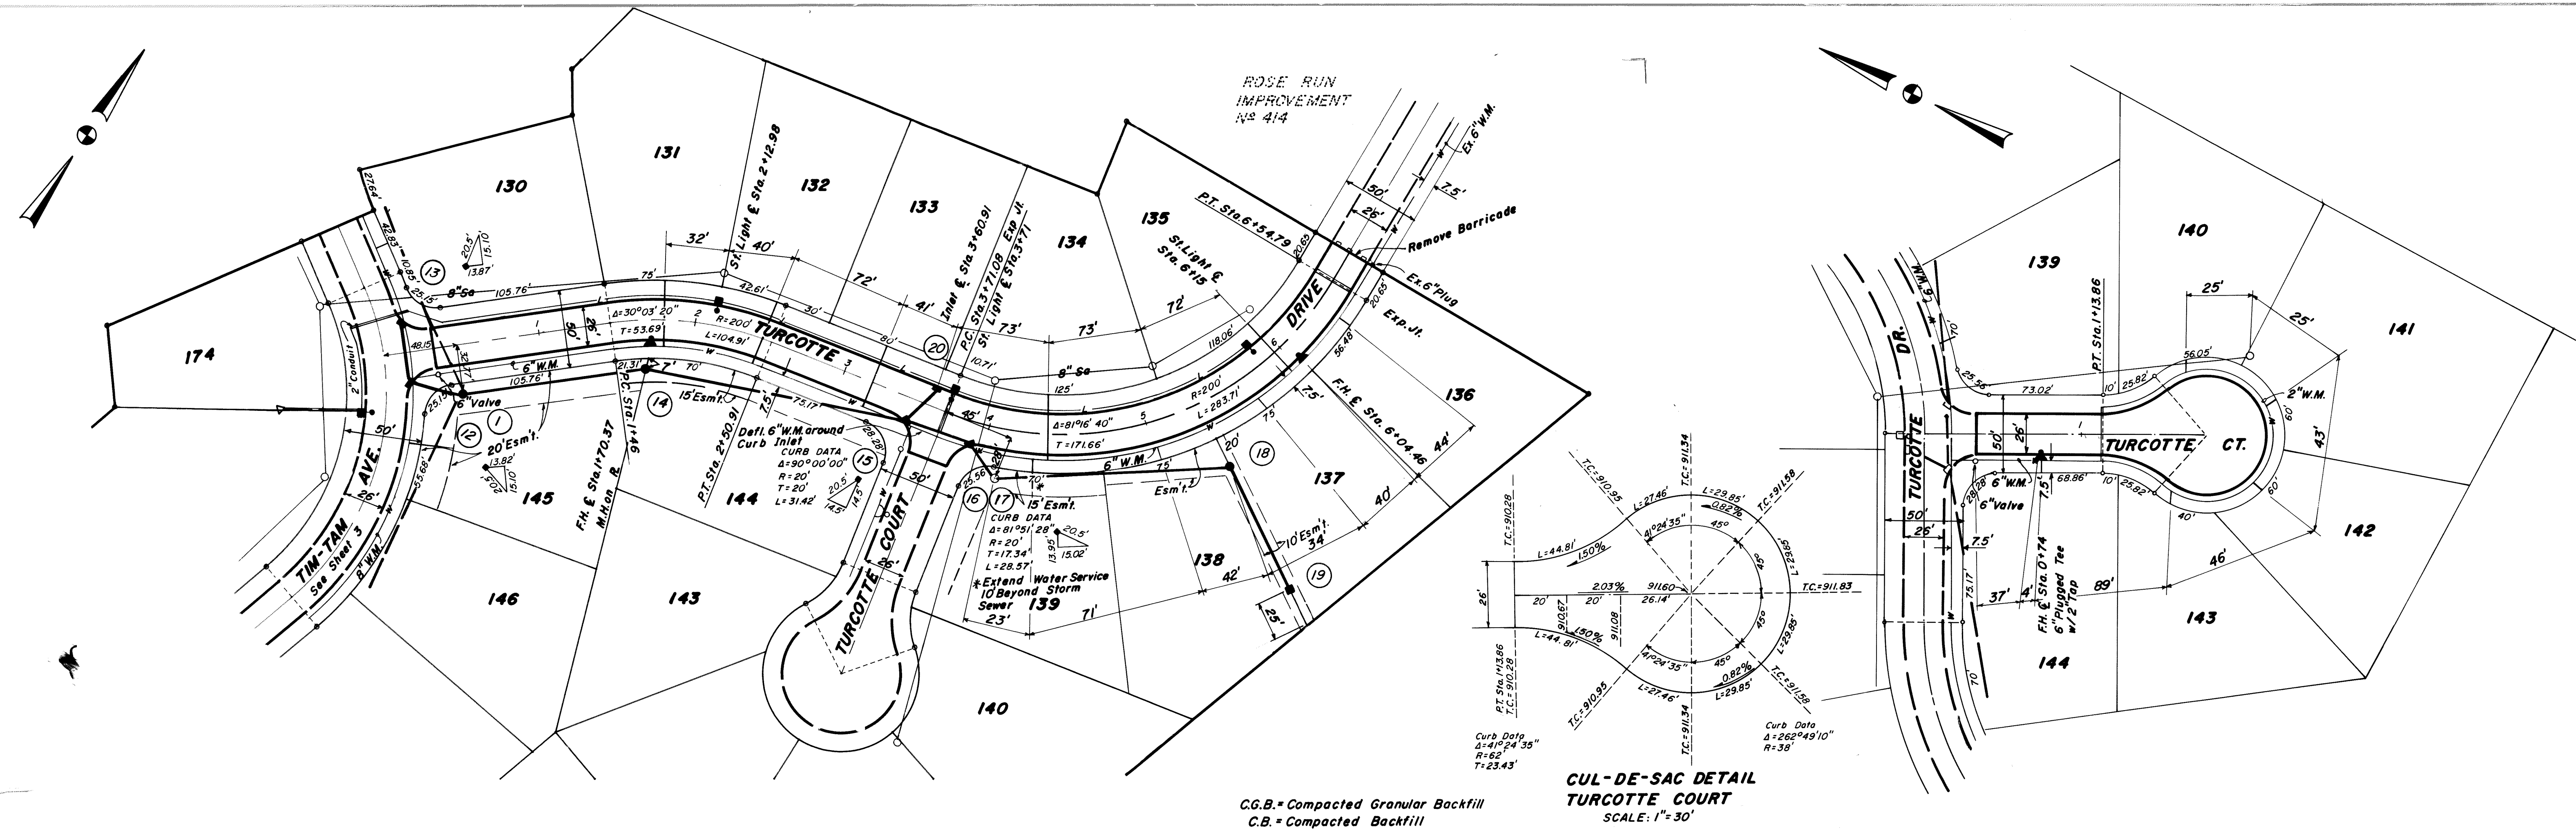



ROSE RUN
IMR N^o 422

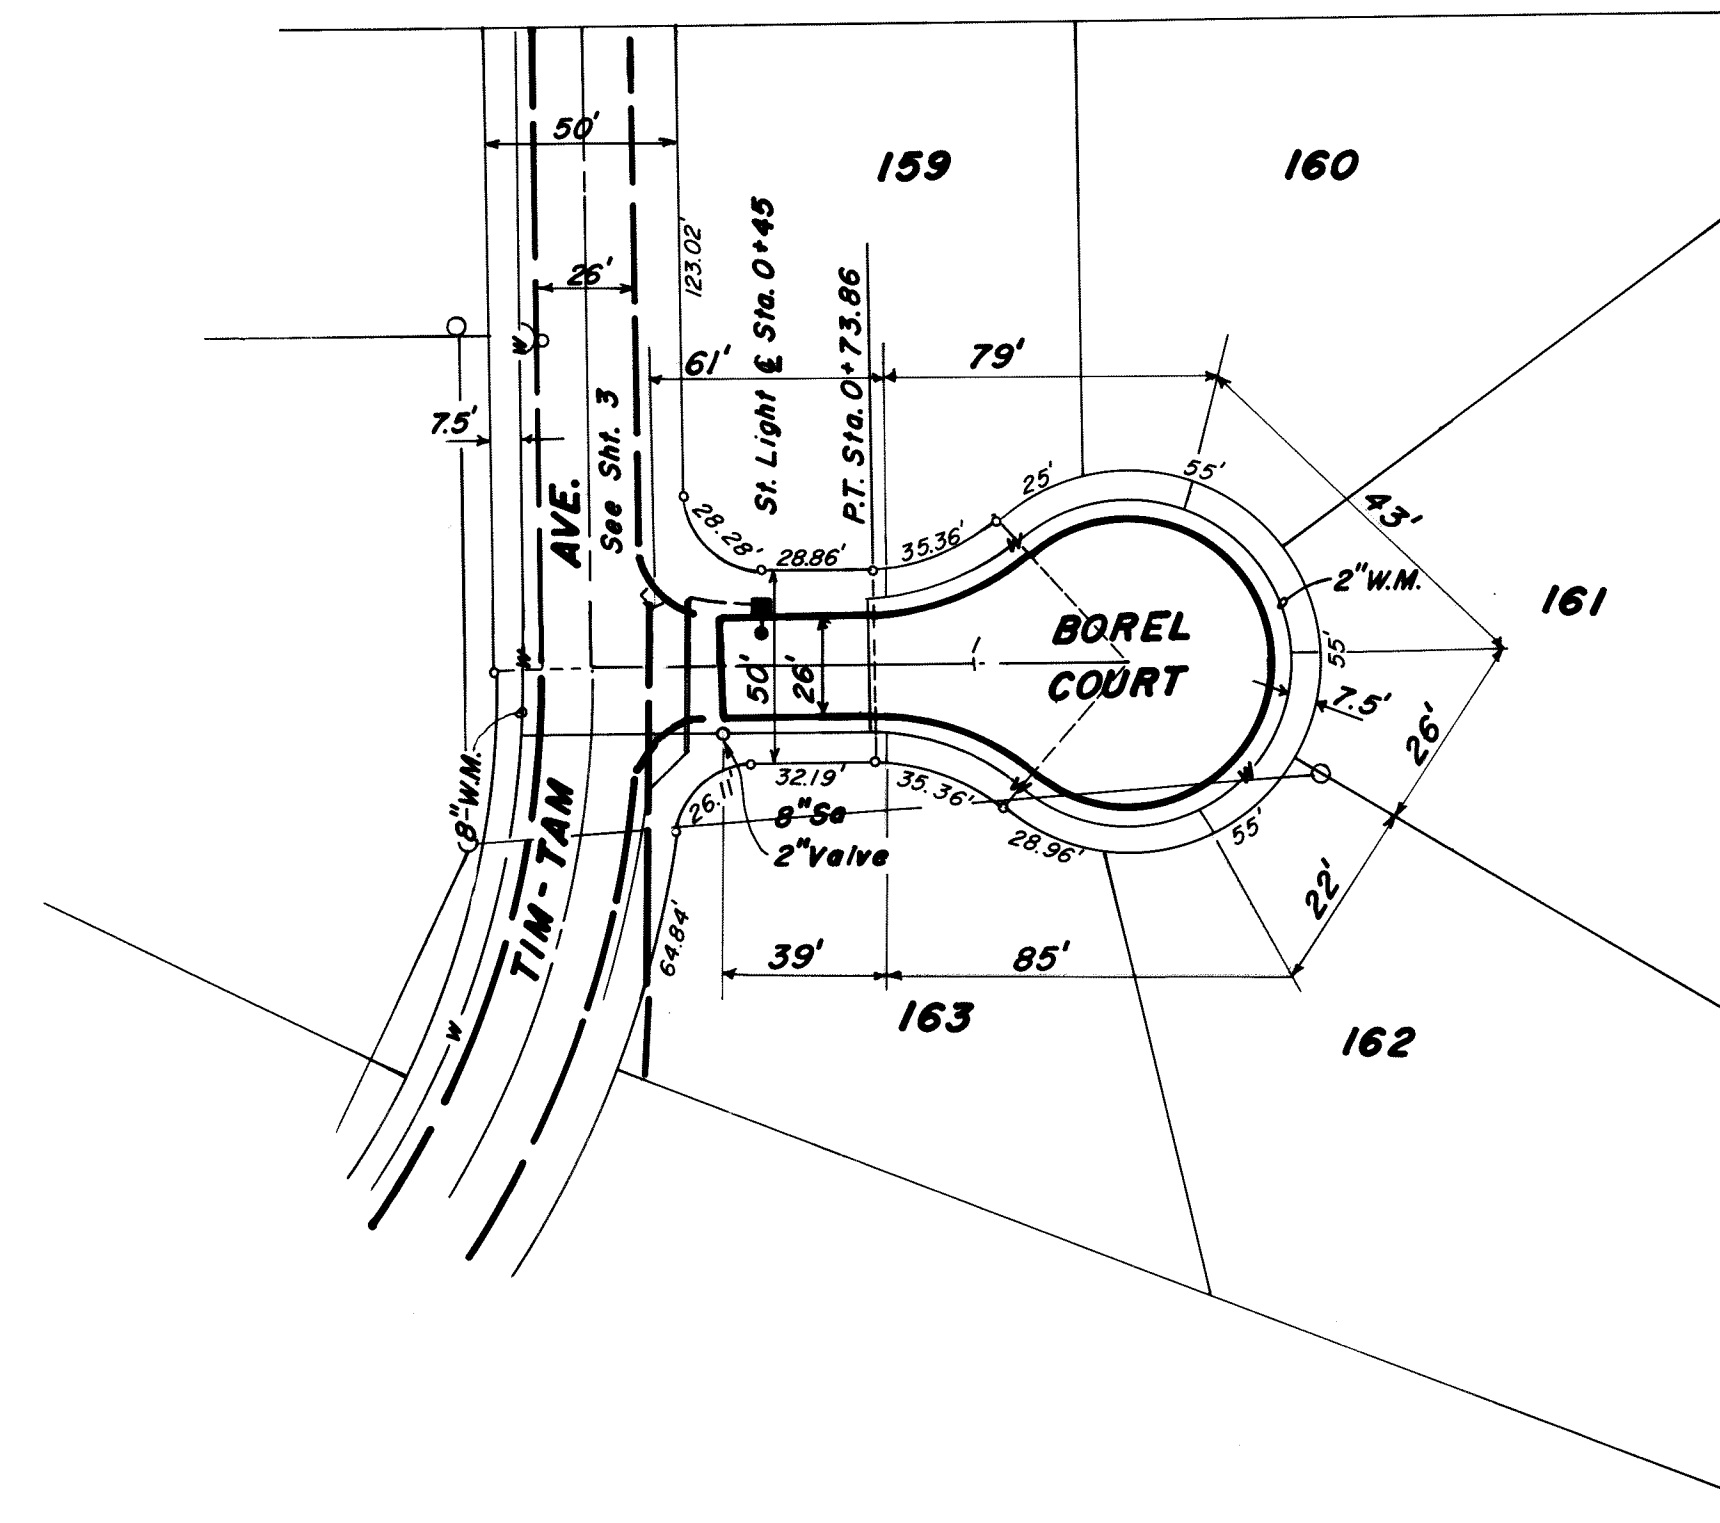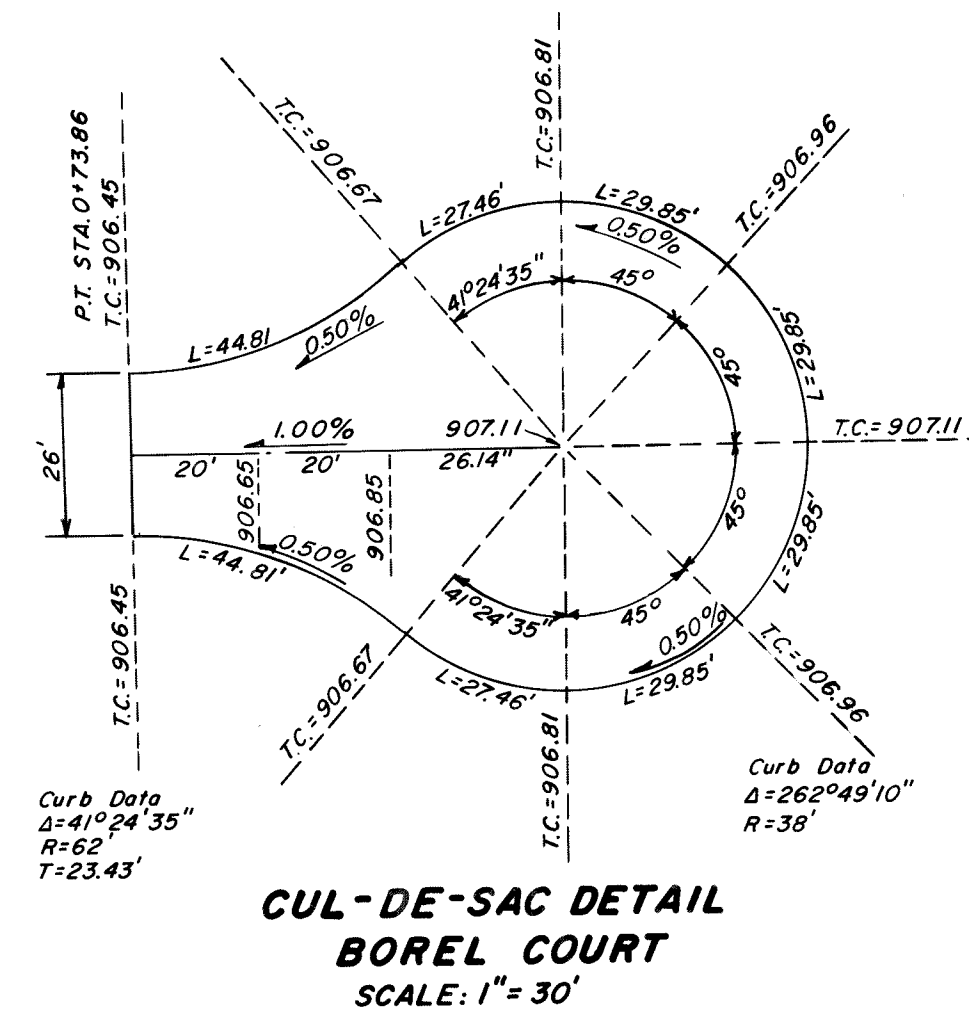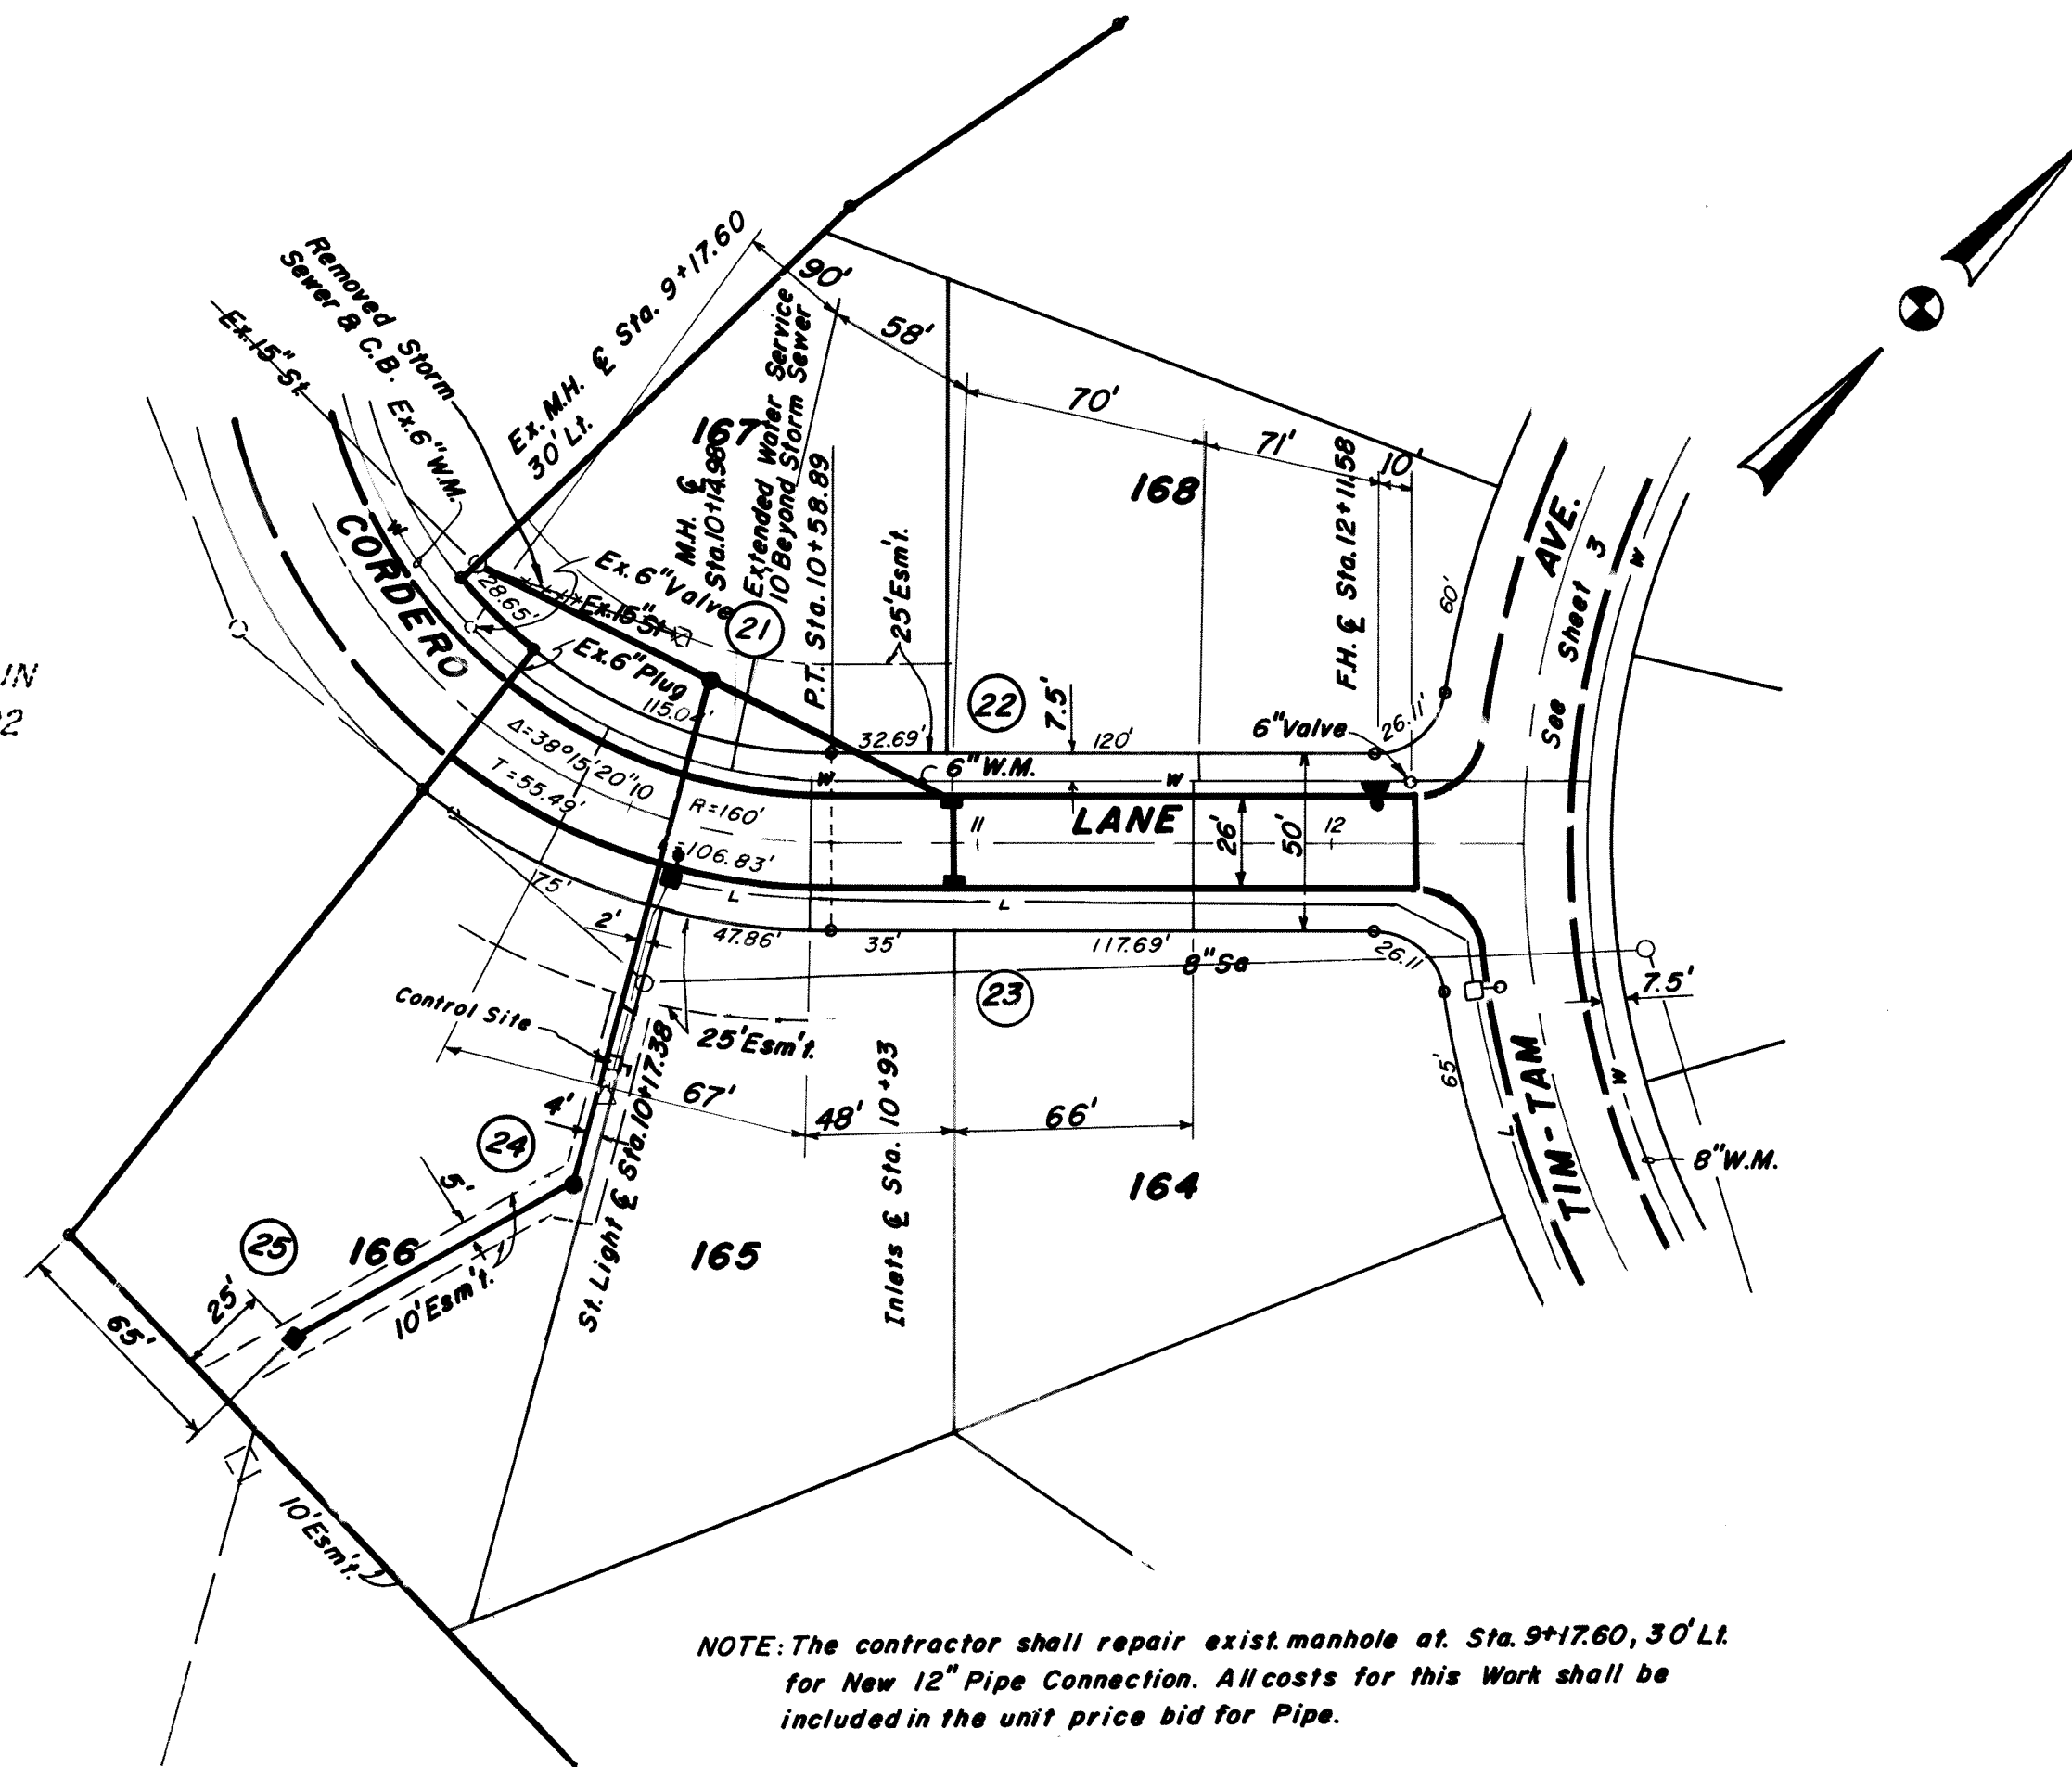

X = Ex. Ground @ Left B/L
O = Ex. Ground @ Right B/L

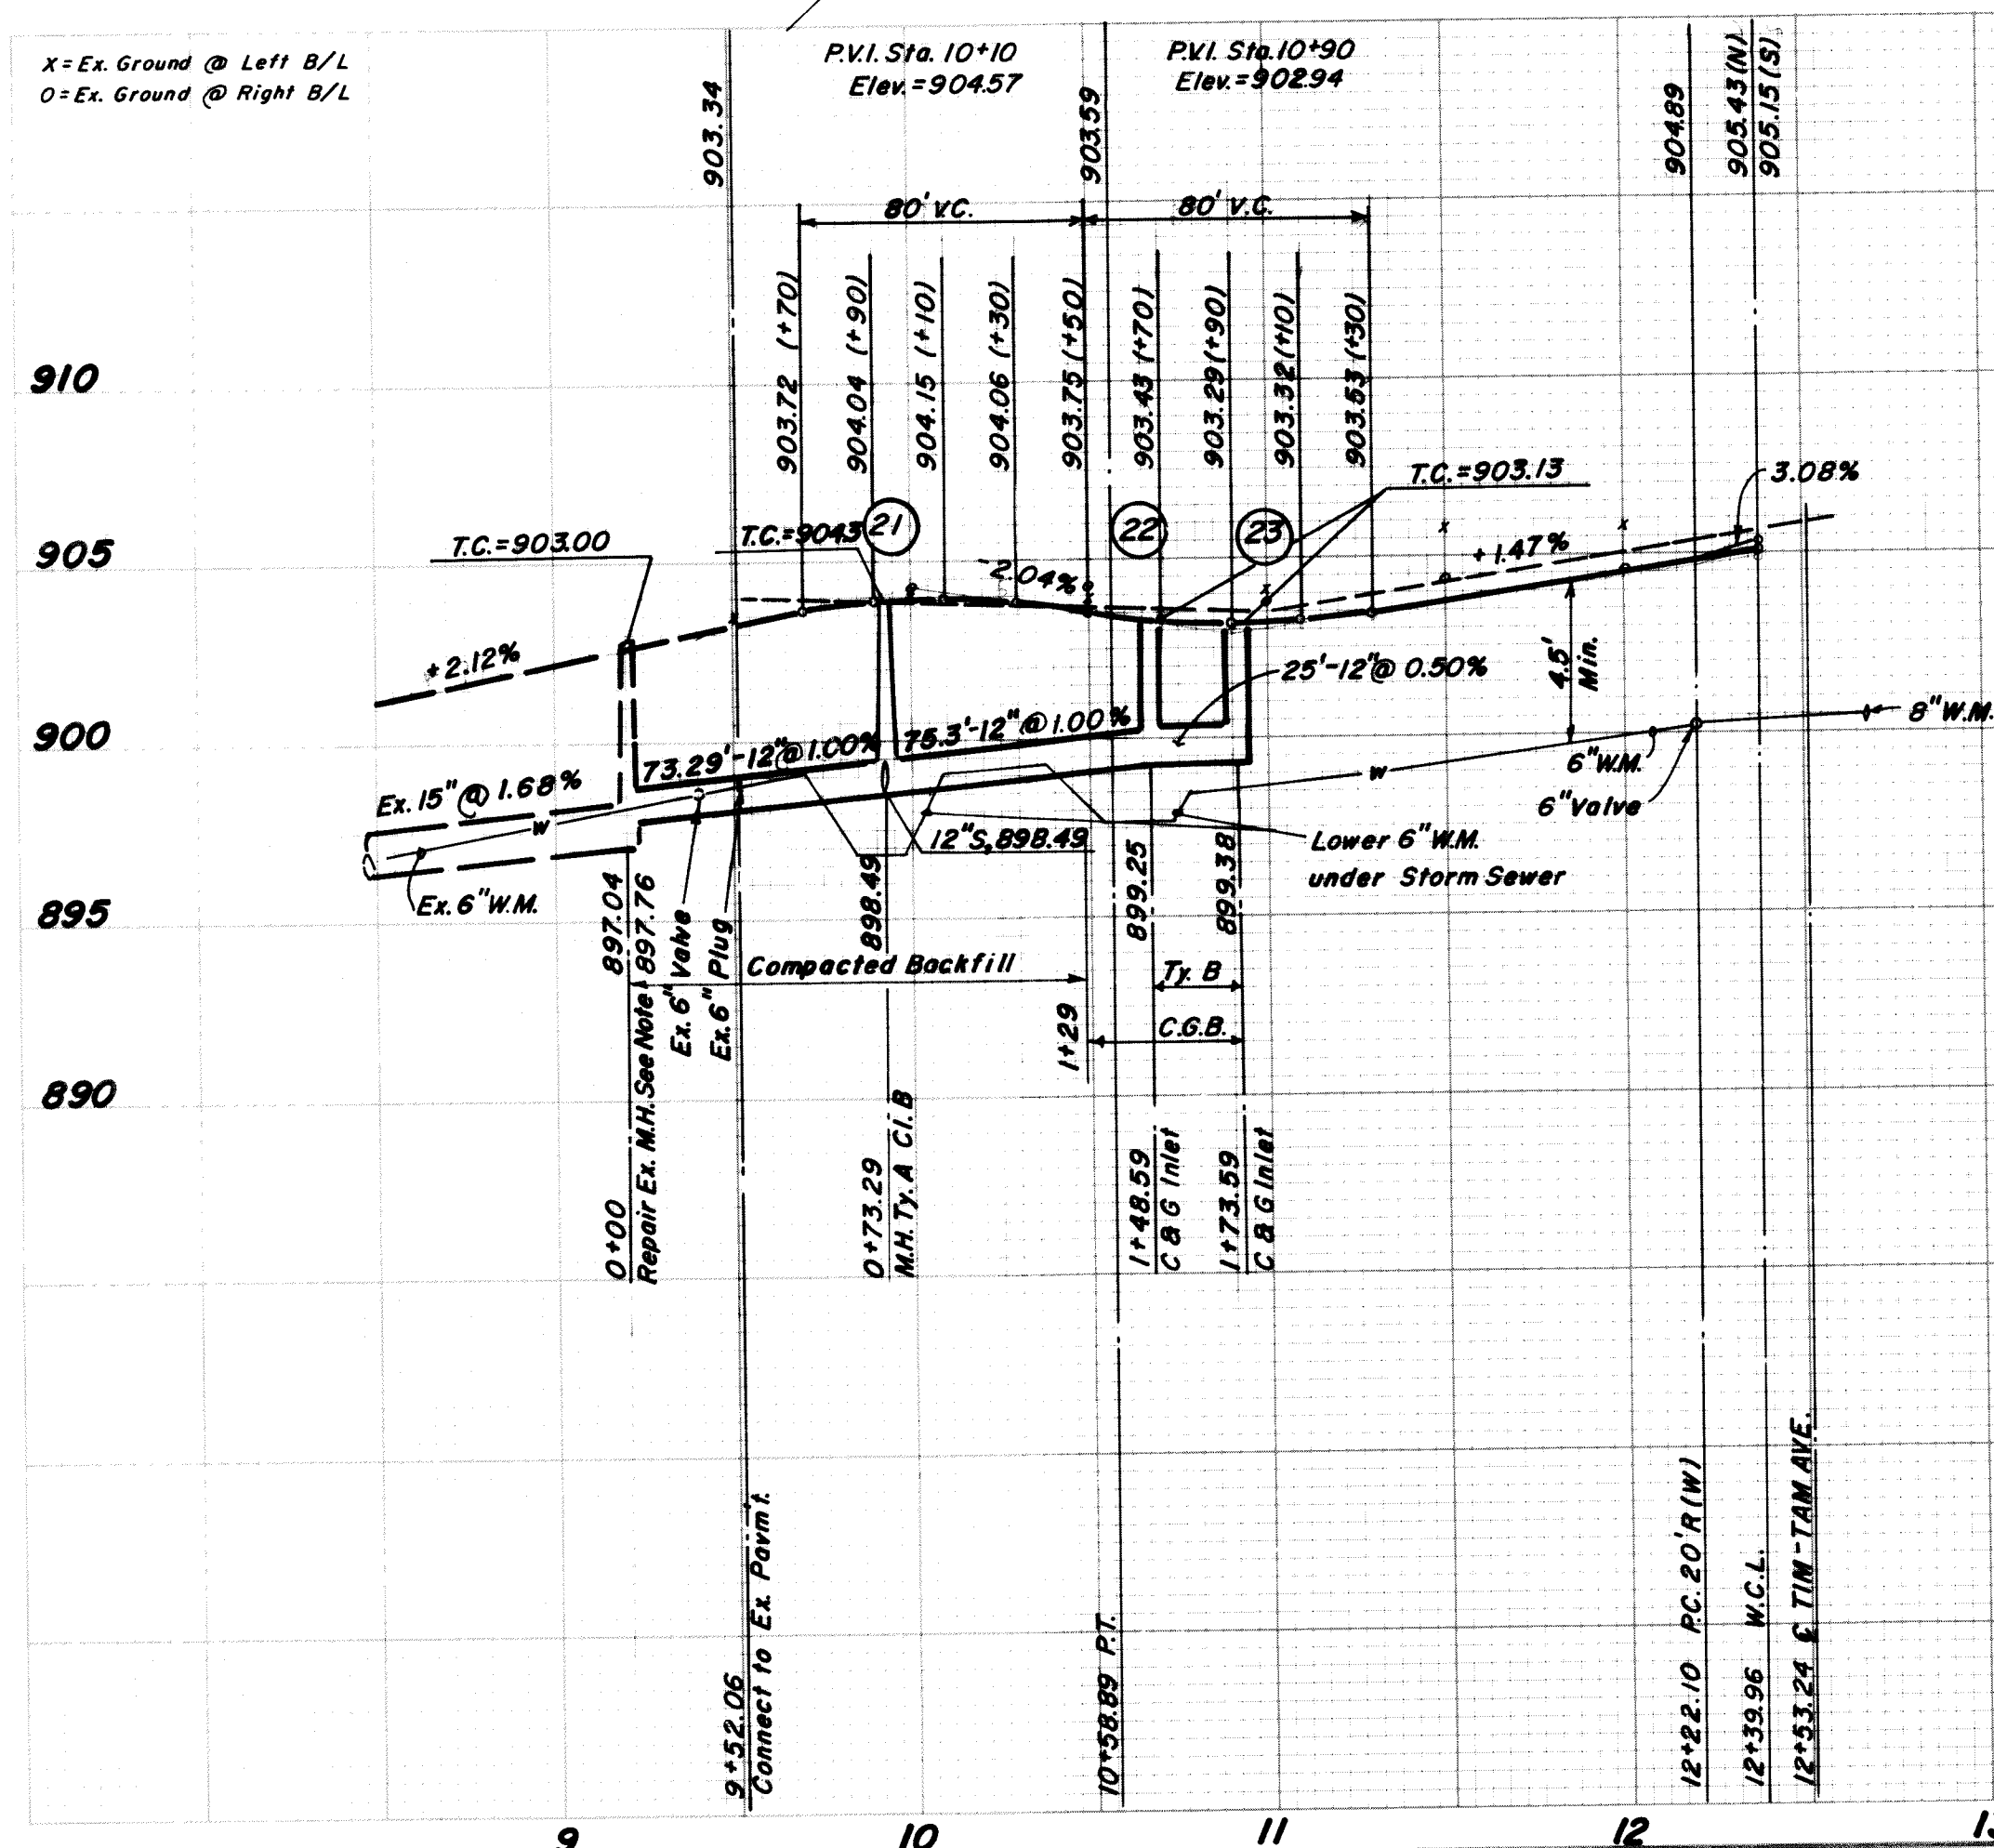

C.G.B. = Compacted Granular Backfill
C.B. = Compacted Backfill

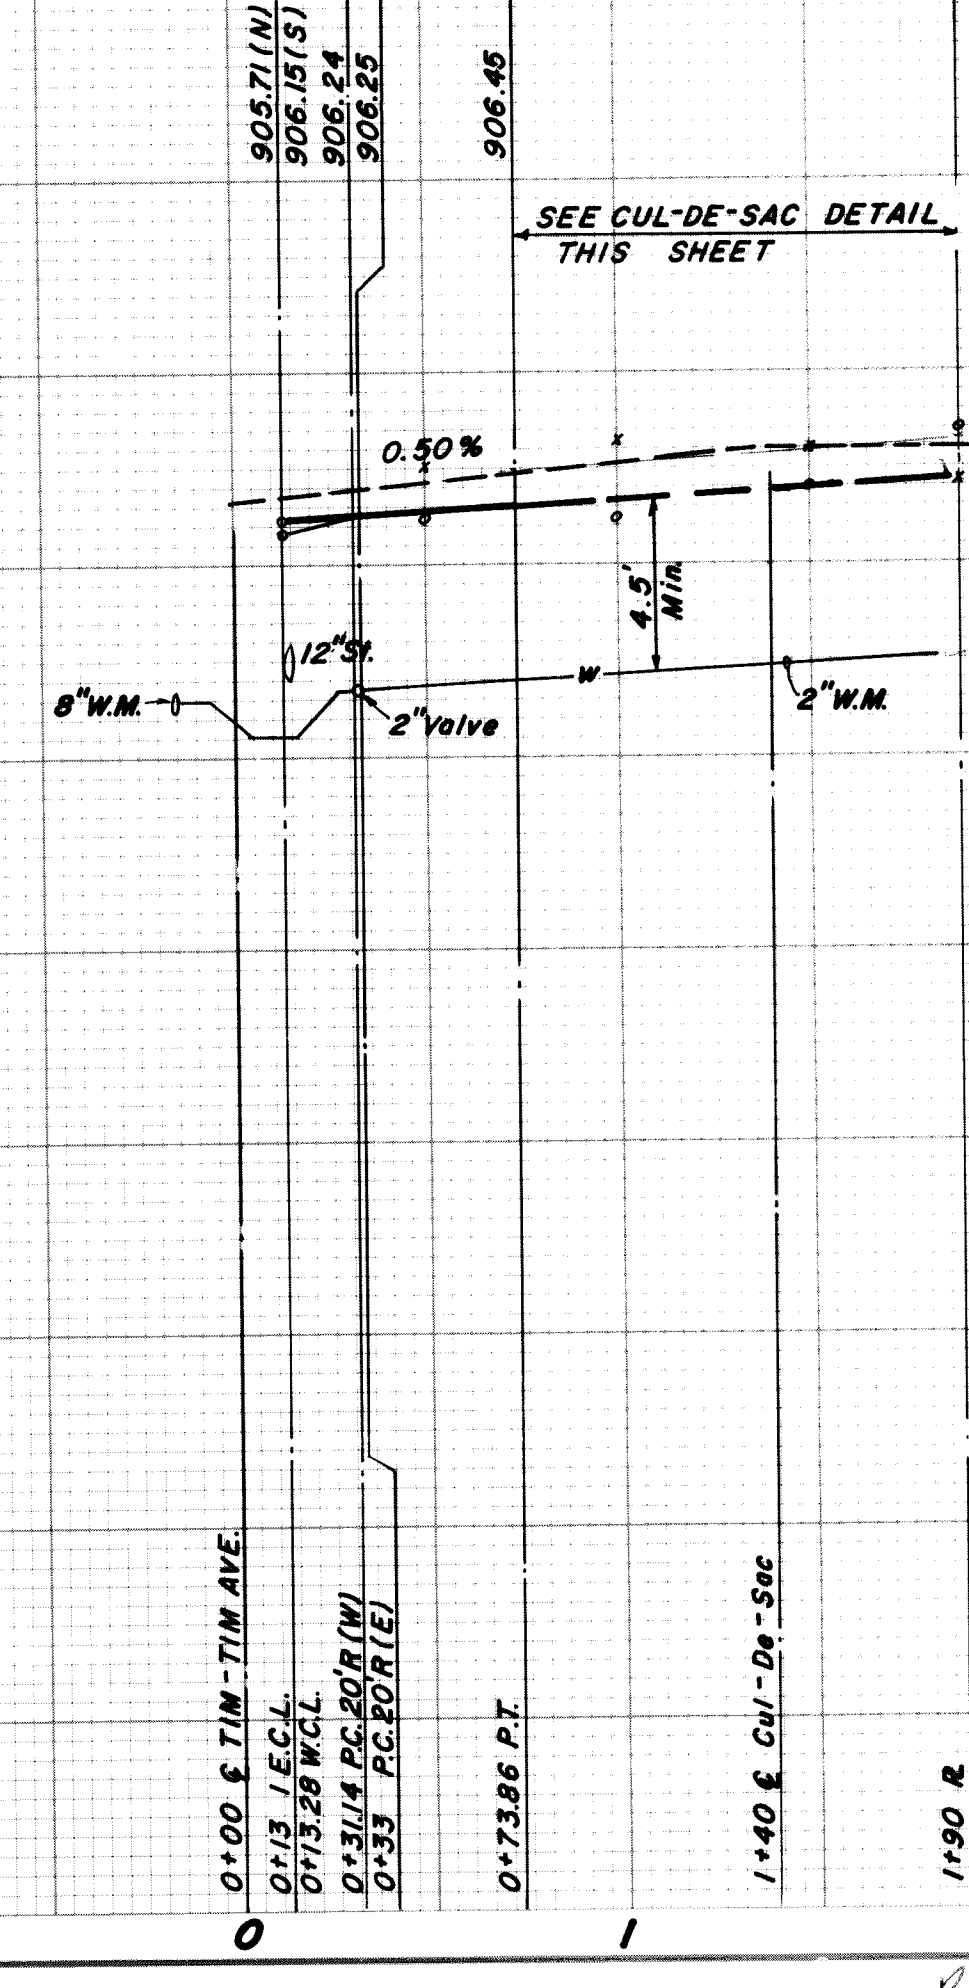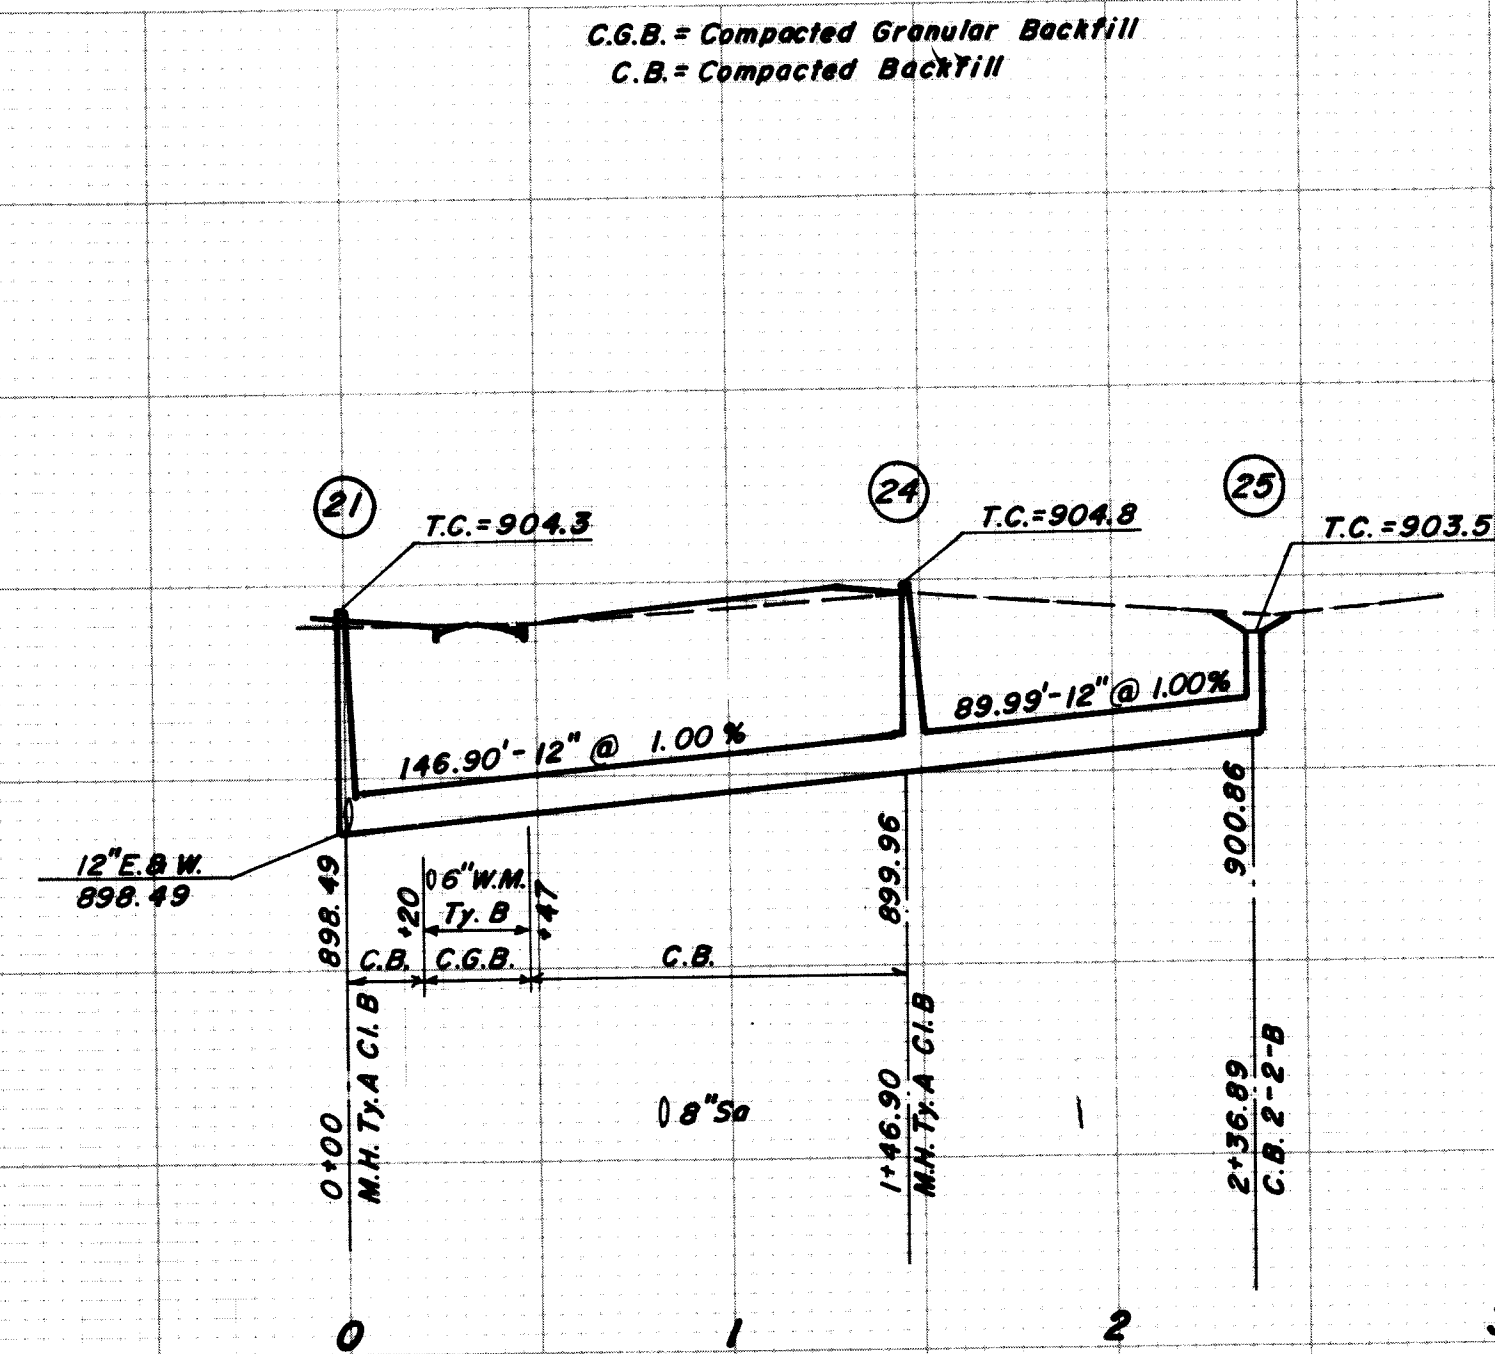

CITY OF GAHANNA, OHIO
PRIVATE STREET & WATER IMPROVEMENT N^o 450

**ROSE RUN
SECTION 3**

SCALE: Horiz. 1" = 50'
Vert. 1" = 5'



EVANS, MECHWART, HAMBLETON & TILTON, INC.
CONSULTING ENGINEERS & SURVEYORS

Revised As Constructed 10-20-89

5
6


Rose Run Section 3

No. 450

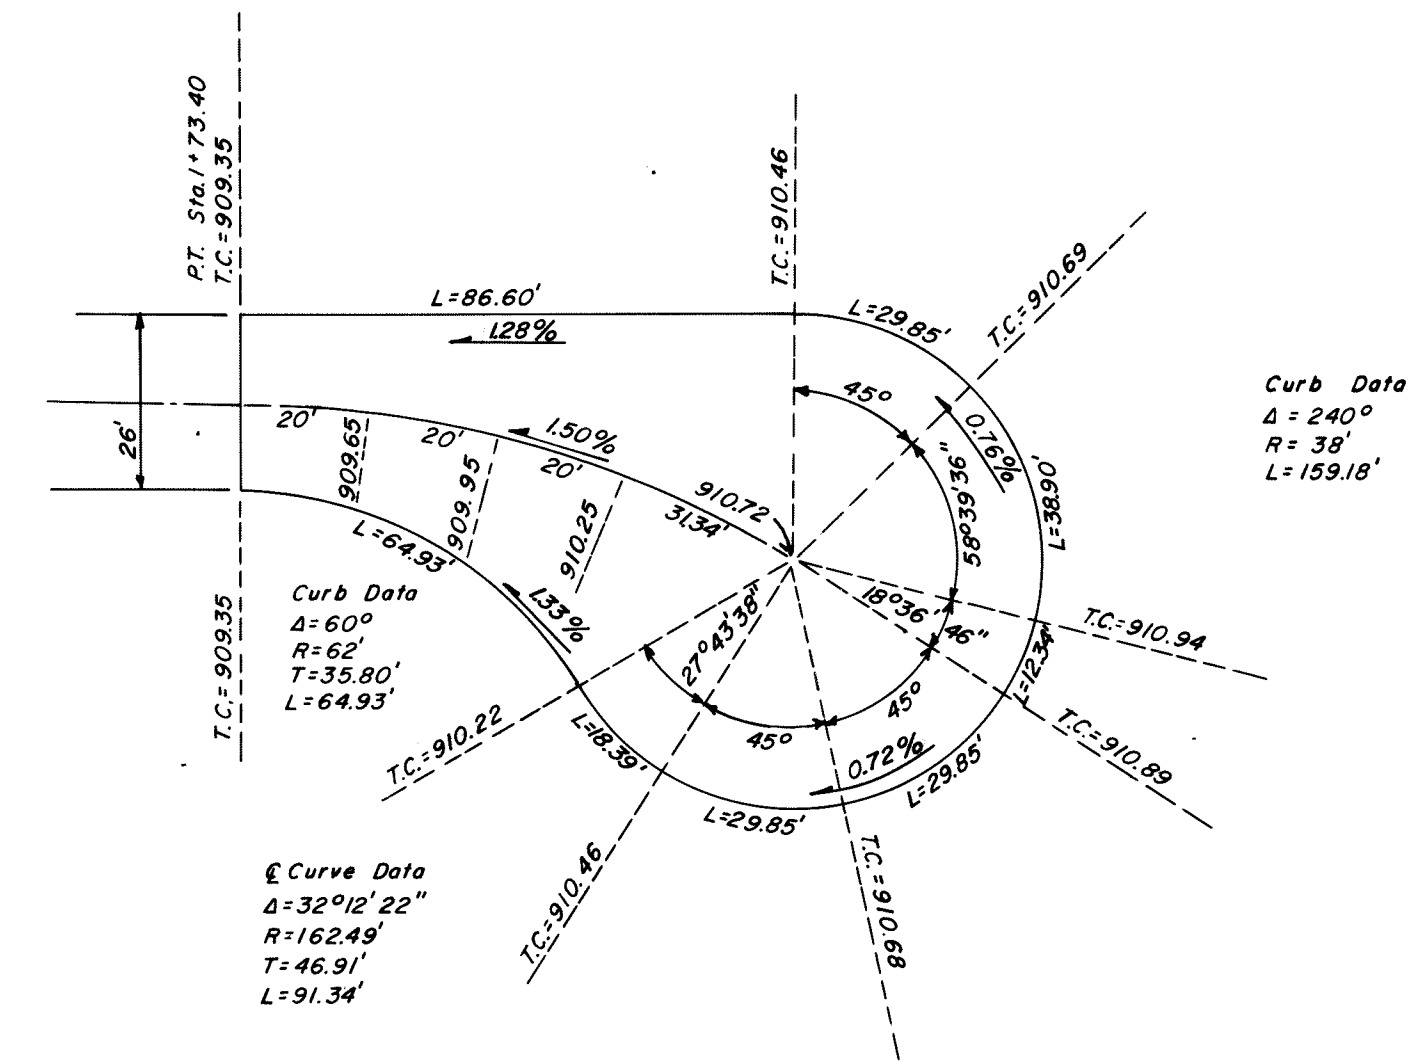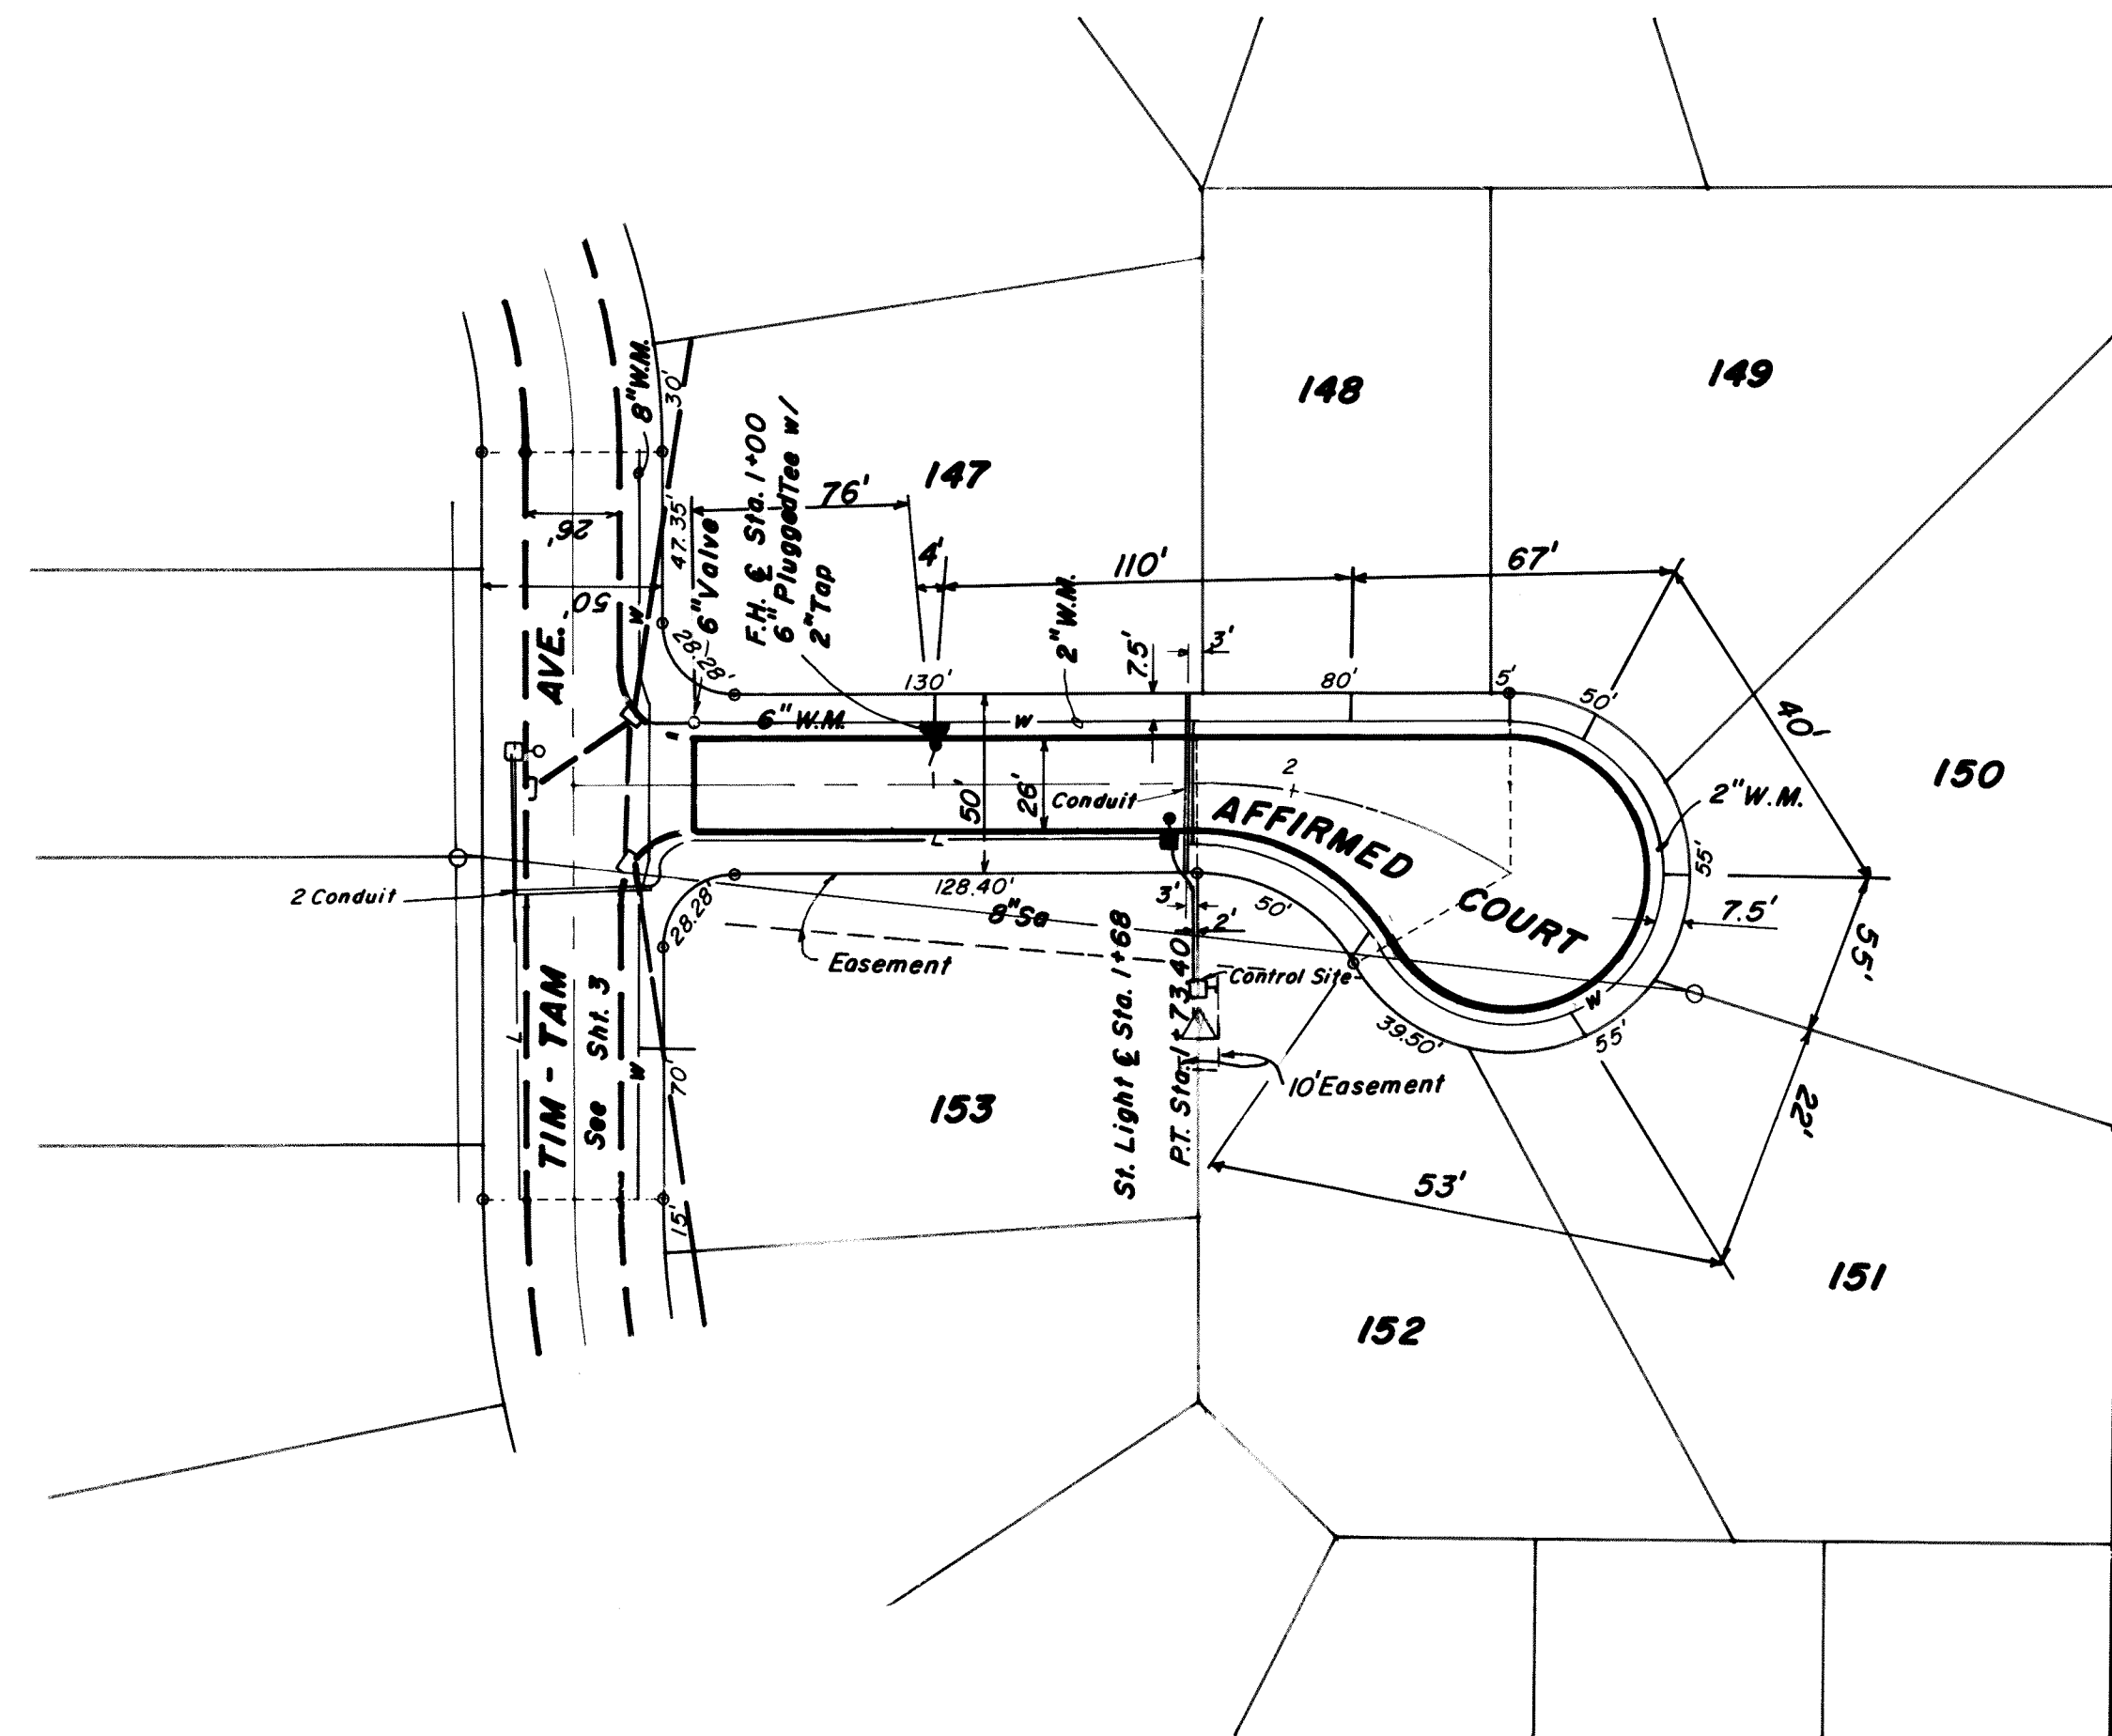

CUL-DE-SAC DETAIL
AFFIRMED COURT
SCALE: 1"=30'

X= Ex. Ground @ Left B/L
O= Ex. Ground @ Left B/L

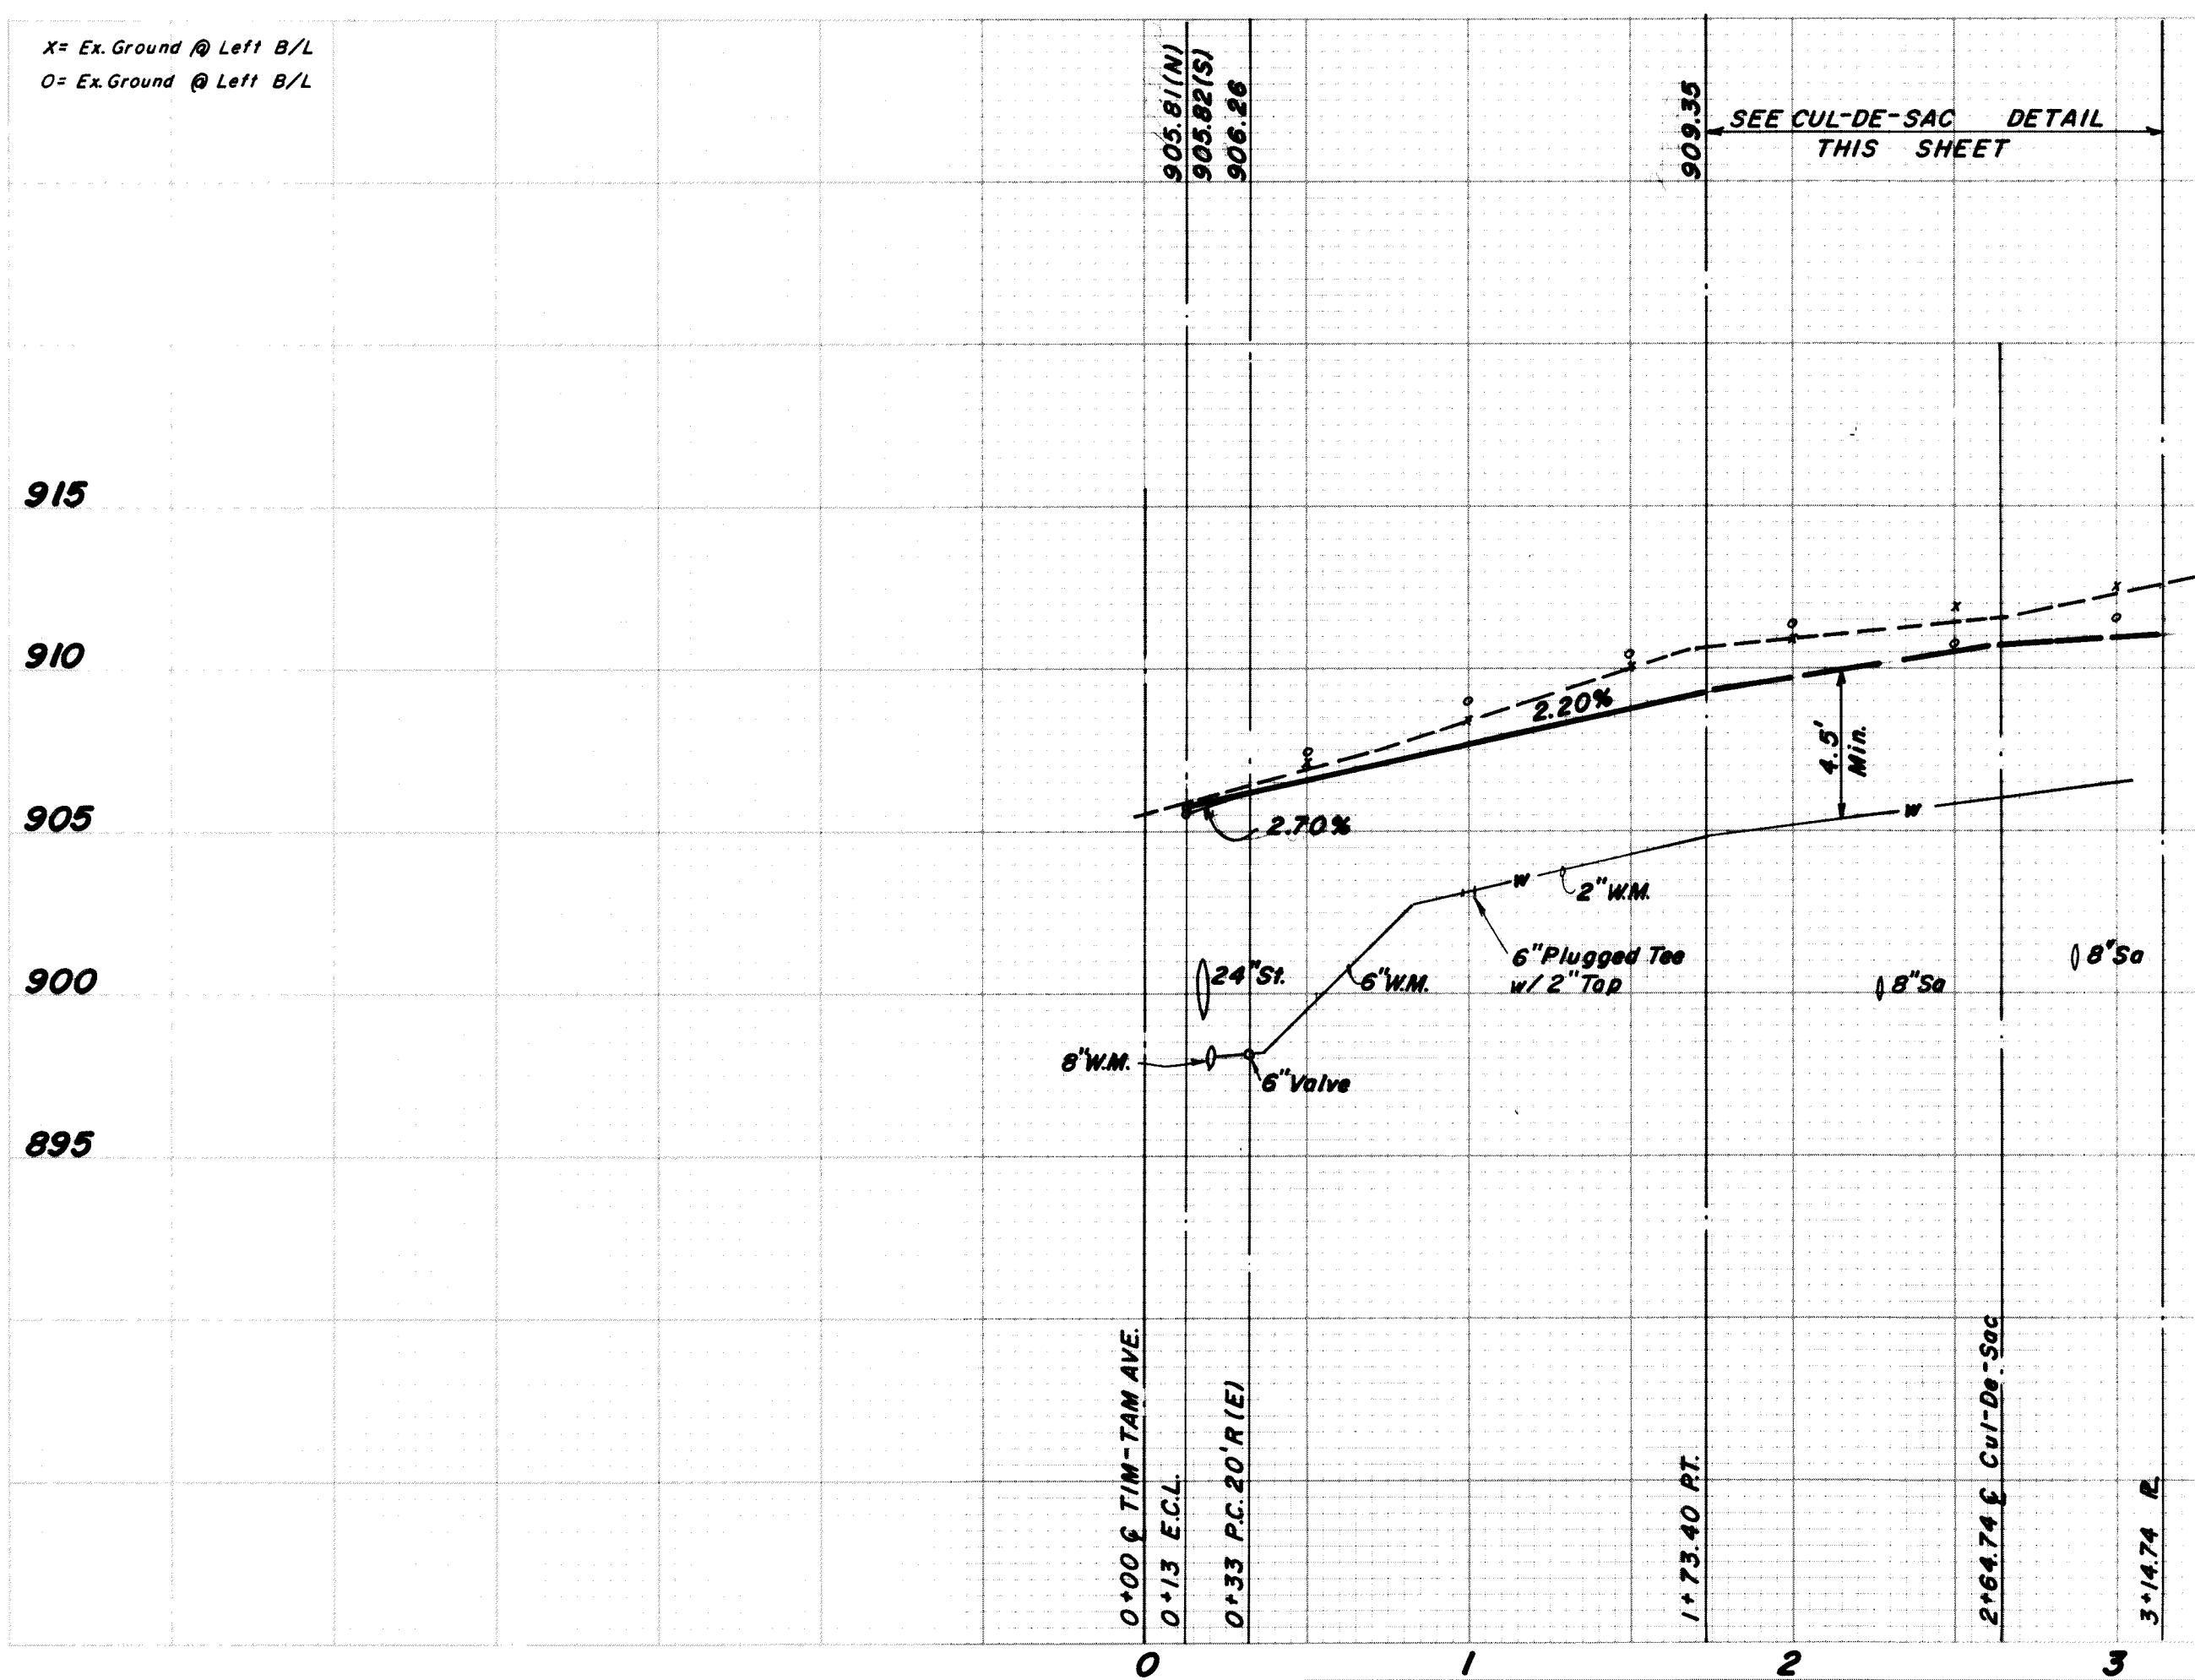


CITY OF GAHANNA, OHIO
PRIVATE STREET & WATER IMPROVEMENT No. 450
ROSE RUN
SECTION 3
SCALE: Horiz. 1"=50'
Vert. 1"=5'
EVANS MECHWART HAMBURTON & TILTON, INC.
CONSULTING ENGINEERS & SURVEYORS

Revised As Constructed 10-20-89

P-1284


Rose Run Section 3

No. 450

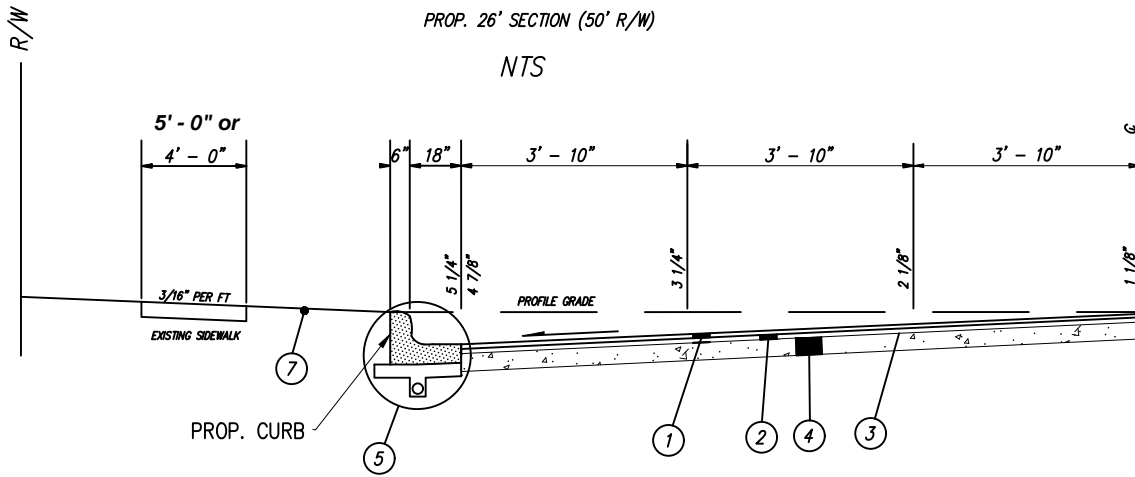

LEGEND

- ① 1-1/2" ASPHALT SURFACE COURSE, ITEM 448
- ② 1-1/2" ASPHALT INTERMEDIATE COURSE, ITEM 448
- ③ TACK COAT, ITEM 407 (APPLIED AT A RATE OF 0.1 GAL/SY)
- ④ 7" ROLLER COMPACTED CONCRETE PAVEMENT, SPEC
- ⑤ CONCRETE COMBINED CURB AND GUTTER INC. 4" UNDERDRAIN, ITEM 609 (SEE DETAIL)
- ⑥ 7" BITUMINOUS AGGREGATE BASE, ITEM 301 (APPLIED IN TWO 3-1/2" LIFTS)
- ⑦ TOPSOIL, SEEDING AND MULCHING, ITEM 653 & 659
- ⑧ 12" CEMENT BASE STABILIZATION, SPEC

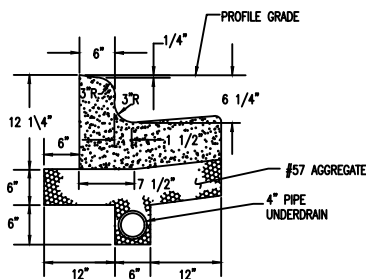

COMBINATION CURB & GUTTER INC. 4" UNDERDRAIN
NTS

CITY OF GAHANNA/FRANKLIN COUNTY, OHIO
RECONSTRUCTION TYPICAL SECTION

Project No.: **ST-1090**

Date: **MARCH 1, 2022**

Scale: **NONE**

Drawn By: **JAC**

Checked By: **JTM**

1

2024 Street Program ST-1110

STREET REBUILDS & SIDEWALK REPLACEMENTS


- CAM CT (CHERRYSTONE DR N to END OF COURT)
- COLDWELL CT (MILLSIDE DR to END OF COURT)
- HAYBROOK DR (GREENBANK to BROOKHILL DR)
- TIMOTHY CT (TIMOTHY DR to End of Court)
- TIM TAM AVE (RIVA RIDGE BLVD to VENETIAN WAY)
- TIM TAM AVE (BOREL CT to CORDERO LN NW)
- WINDBOURNE ST (SANDBURR to BLUESTEM)
- WINDROW CT (MIDHURST RD to END OF COURT)

OVERLAY & SIDEWALK MAINTENANCE

- BEAVERBROOK DR (BARDEN CT TO HUNTERS RUN W)
- CHALLIS SPRINGS DR (HARRISON POND DR to CLARK STATE RD)
- CHERRYSTONE DR N & S (TRAPP DR to TRAPP DR)
- EASTGATE PKWY (BLATT BLVD to EASTGATE PARKWAY)
- LANG DR (RIVA RIDGE BLVD to END OF STREET)
- MISTLE TOE ST (MOSS OAK AVE TO THISTLE AVE)
- SANDBURR (STYGLER to WINDBOURNE)
- SPIREA AVE (MISTLETOE ST TO END OF STREET)

CRACK SEAL

- AROYA CT (CHALLIS SPRINGS DR TO END OF COURT)
- AVIR CT (BRYN MAWR TO END OF COURT)
- BARDEN CT (BEAVERBROOK DR TO END OF COURT)
- CODET RD (LINCOLNSHIRE RD TO PENNY LN)
- DEBRA LN (GOSHEN LN TO SHARA PARK PL)
- FARMCREEK DR (HAVEN CORNERS RD TO CAROWAY BLVD)
- HOWLAND DR (RICE AVE TO DEAD END)
- LINCOLNSHIRE RD (KENILWORTH CT TO PALACE LN)
- LINE WAY (AYLESBURY DR TO LINE WAY)
- OLD PIN DR (BYRN MAWR DR TO RIVA RIDGE BLVD)
- SPRUCE HILL DR (RICE AVE TO CAROWAY BLVD)

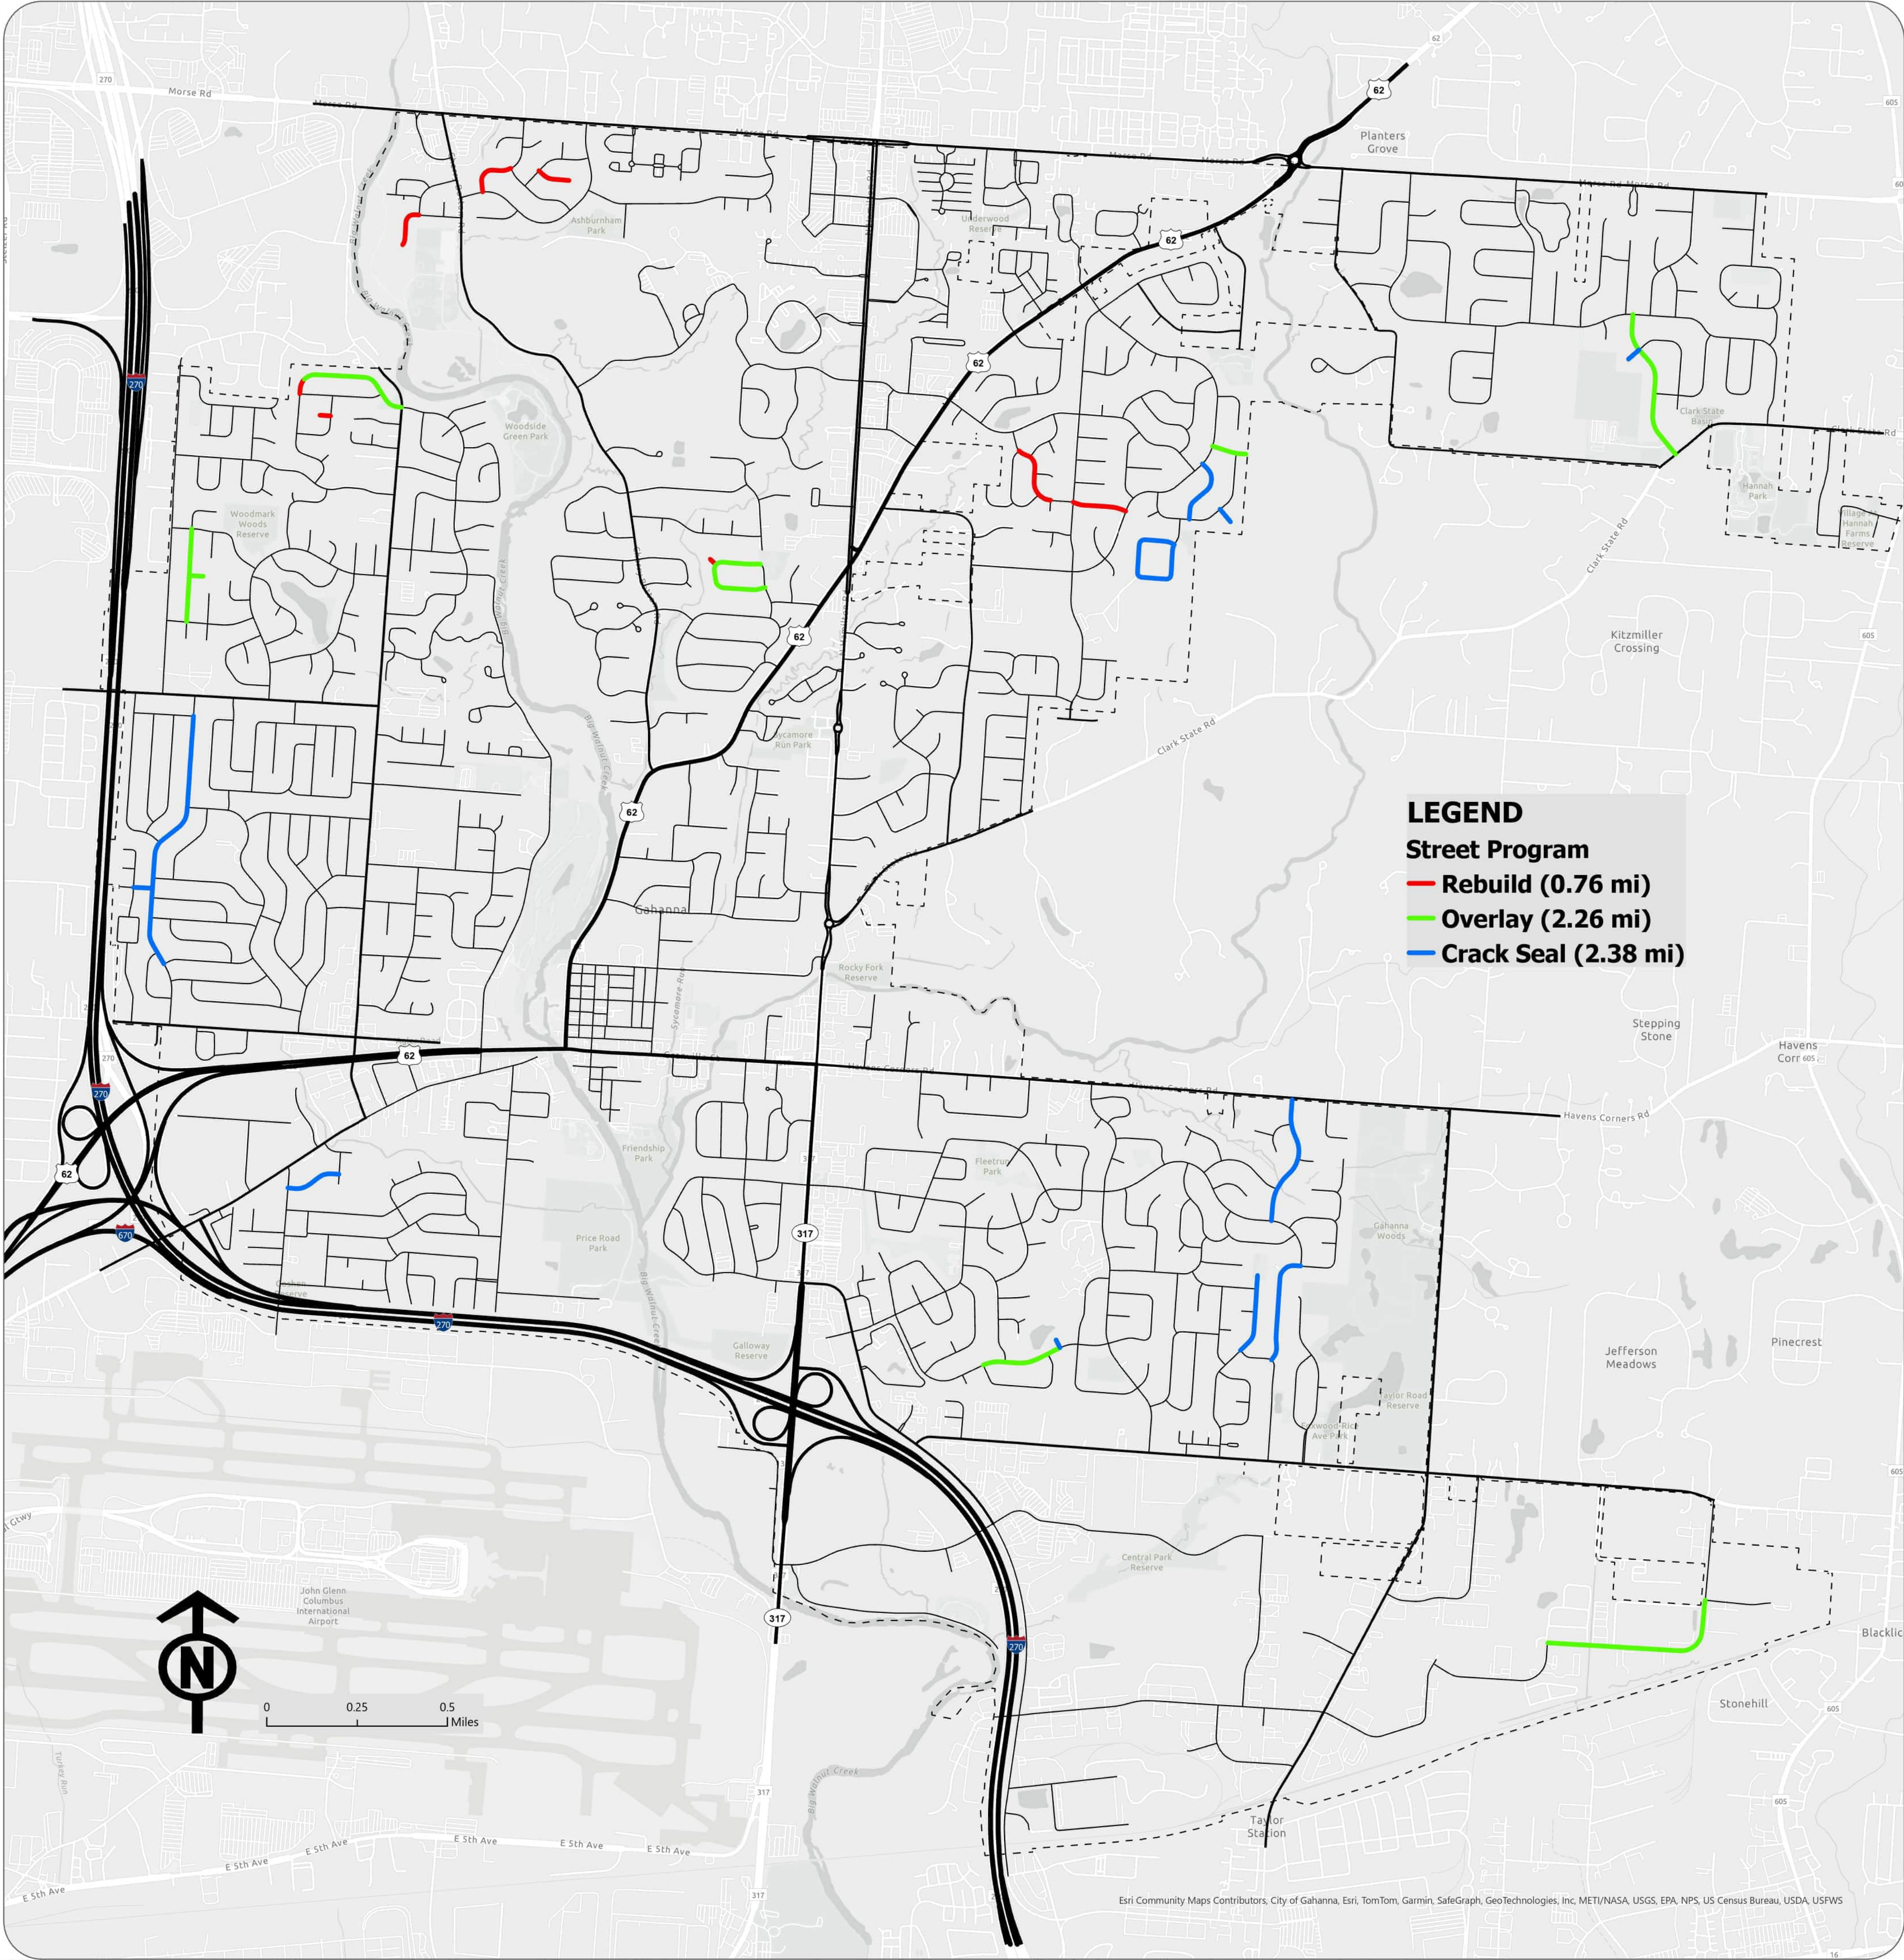


NOTE: This map is a resource to be used for general information purposes only. The City of Gahanna shall assume no liability for any errors, omissions, or inaccuracies in the information provided. All GIS data layers are referenced in the Ohio State Plane Coordinate System, Horizontal - North American Datum (NAD) 83 (95) Vertical - North American Datum Vertical Datum (NAVD) 88, Units - Surveyors Feet. All data has been developed from public records that are constantly undergoing change and is not warranted for content, completeness, or accuracy. The City of Gahanna does not warrant, guarantee or represent the data to be fit for a particular use or purpose.
Path: G:\GIS Pro Projects (New)\Engineering\Street

2024 Sidewalk Program ST-1110

SIDEWALK MAINTENANCE

- BEAVERBROOK DR (BARDEN CT TO HUNTERS RUN (WEST)
- BEAVERBROOK DR (BARDEN CT TO HELMBRIGHT DR)
- BARDEN CT (BEAVERBROOK DR TO END OF COURT
- CHALLIS SPRINGS DR (HARRISON POND DR to CLARK STATE RD)
- AROYA CT (CHALLIS SPRINGS DR TO END OF COURT)
- CHERRYSTONE DR N & S (TRAPP DR to TRAPP DR)
- TRAPP DR (CHERRYSTONE DR N TO CROSSING CREEK N)
- LANG DR (RIVA RIDGE BLVD to END OF STREET)
- LANG DR (BRYN MAWR DR to END OF COURT)
- MISTLE TOE ST (MOSS OAK AVE TO THISTLE AVE)
- SANDBURR (STYGLER to WINDBOURNE)
- SPIREA AVE (MISTLETOE TO END OF STREET)

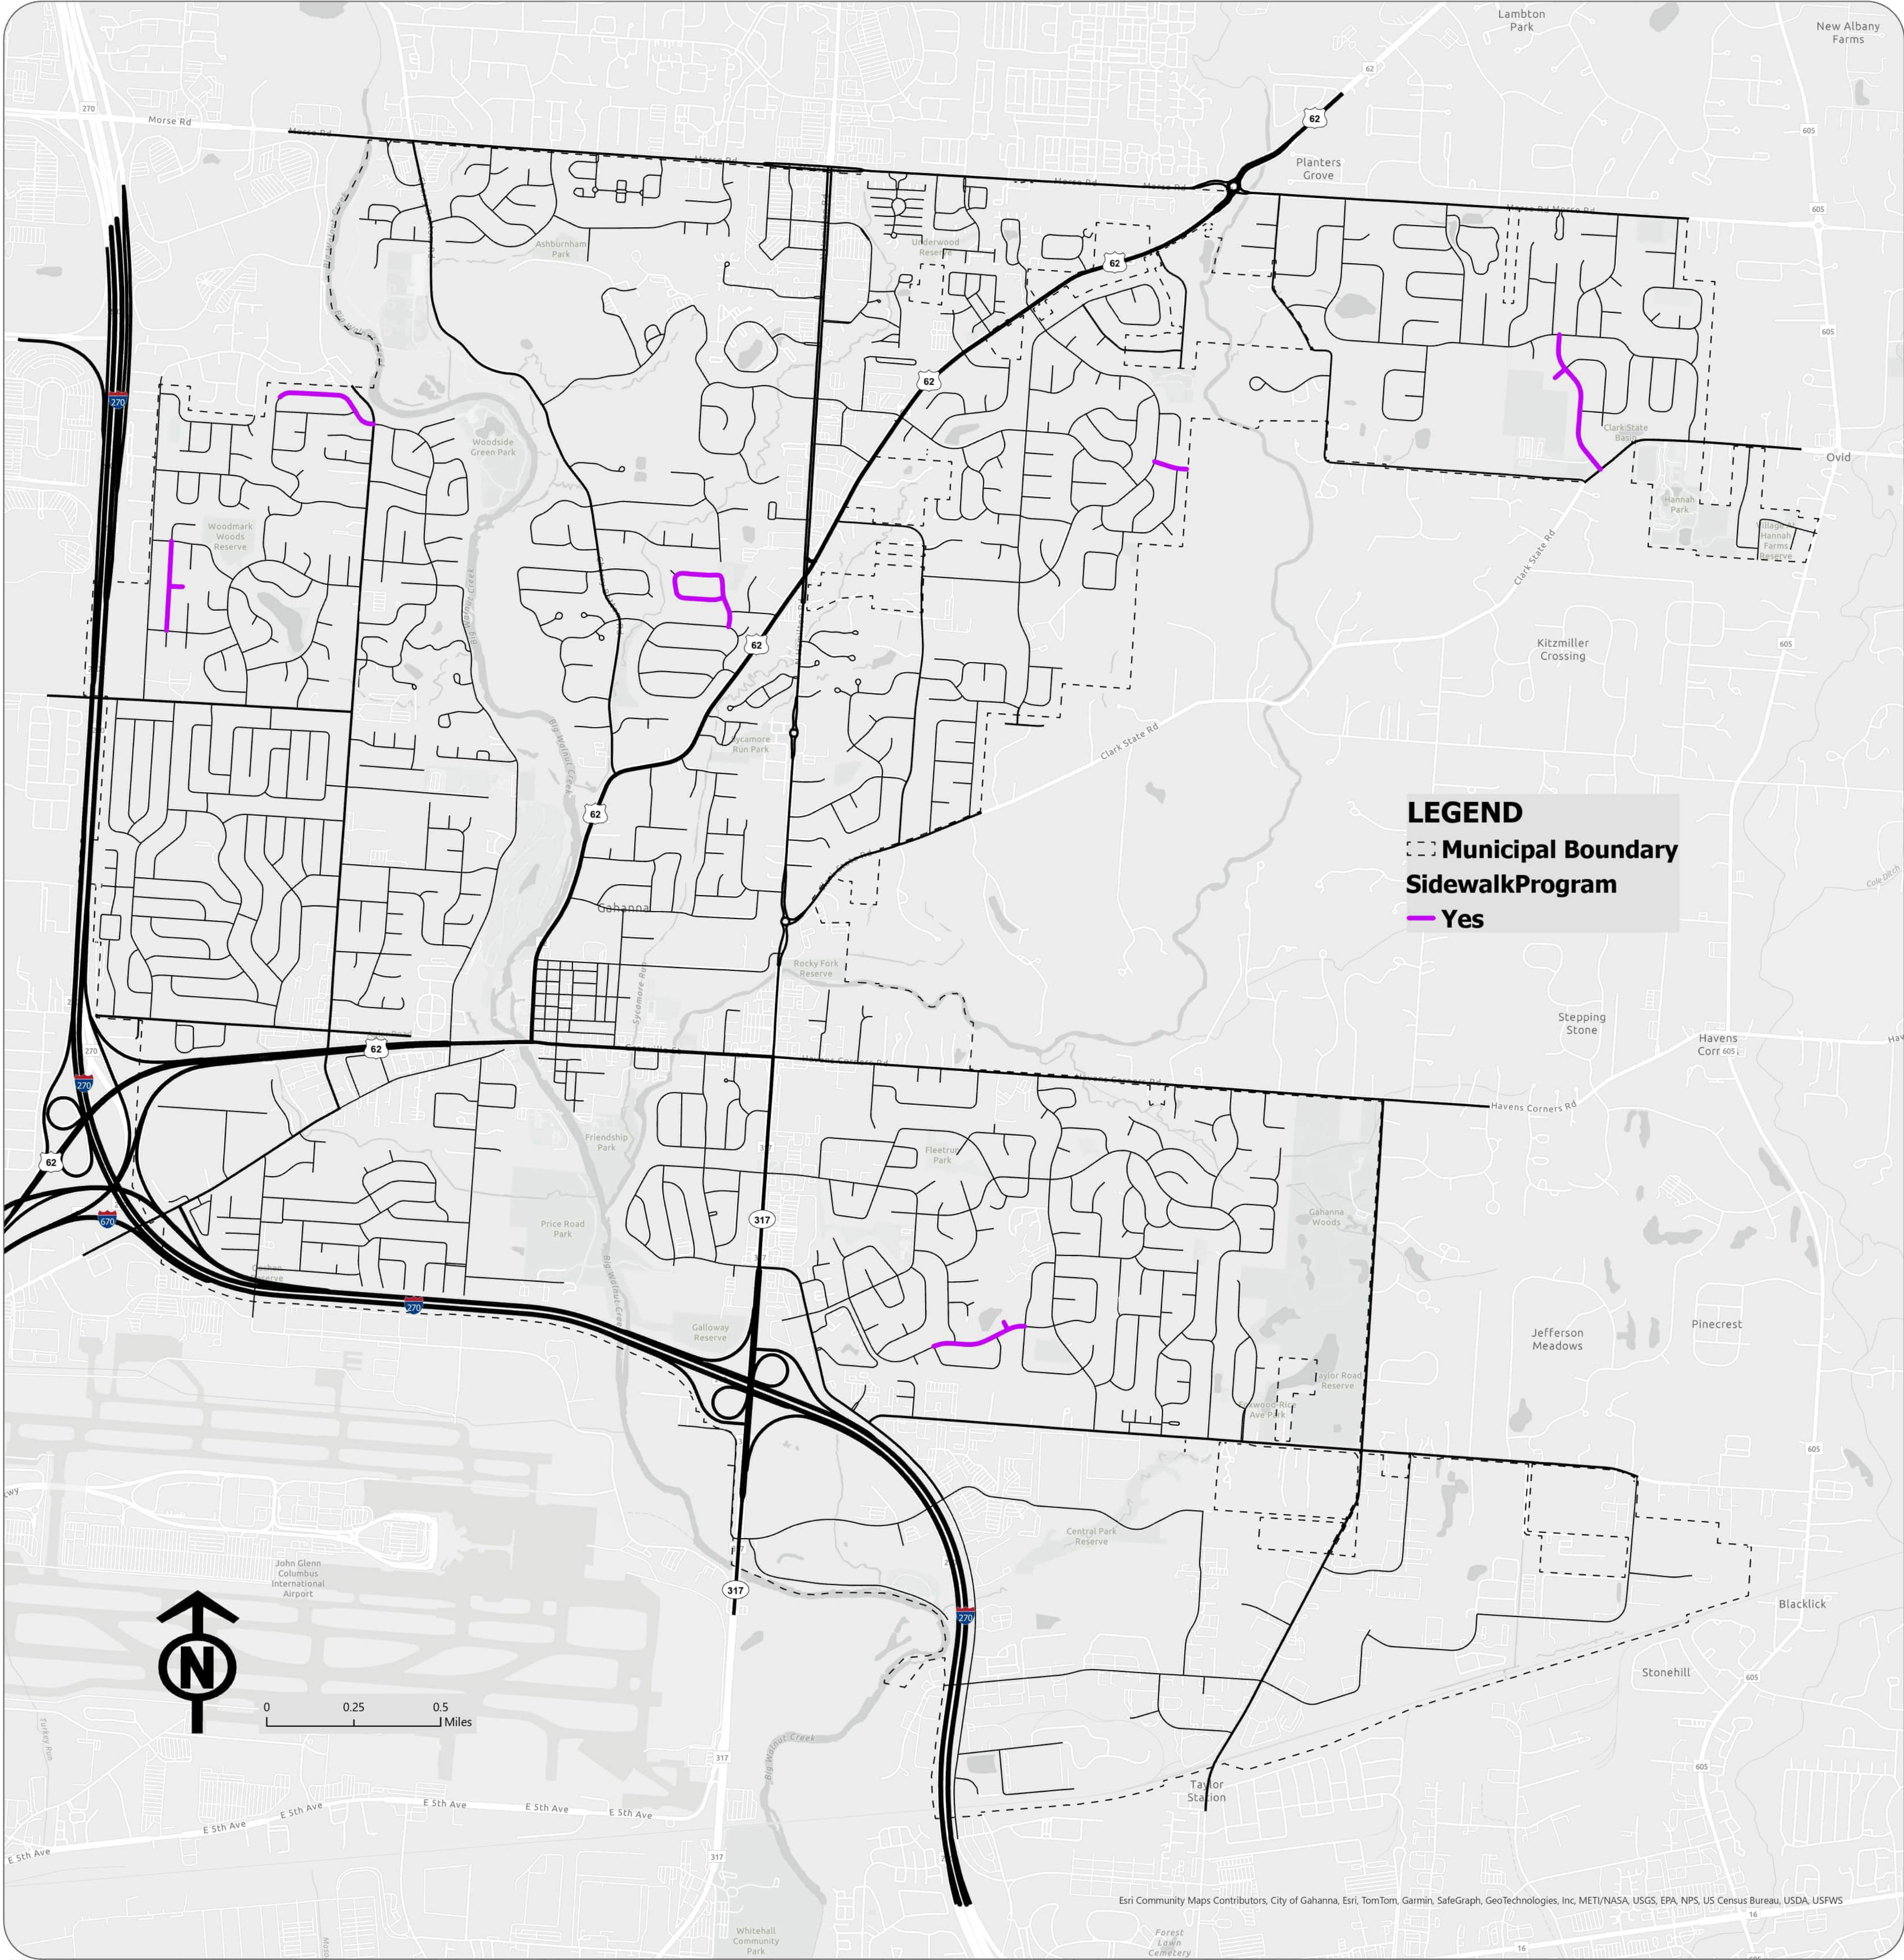


SHEET INDEX

- 1 - TITLE SHEET
2 - GENERAL NOTES
3 - OVERALL SITE PLAN
4-7 - SITE PLAN
8 - SITE PLAN DETAILS

CONSTRUCTION DOCUMENTS
FOR

GAHANNA MUNICIPAL GOLF COURSE

220 OLDE RIDENOUR ROAD
GAHANNA, OHIO 43230

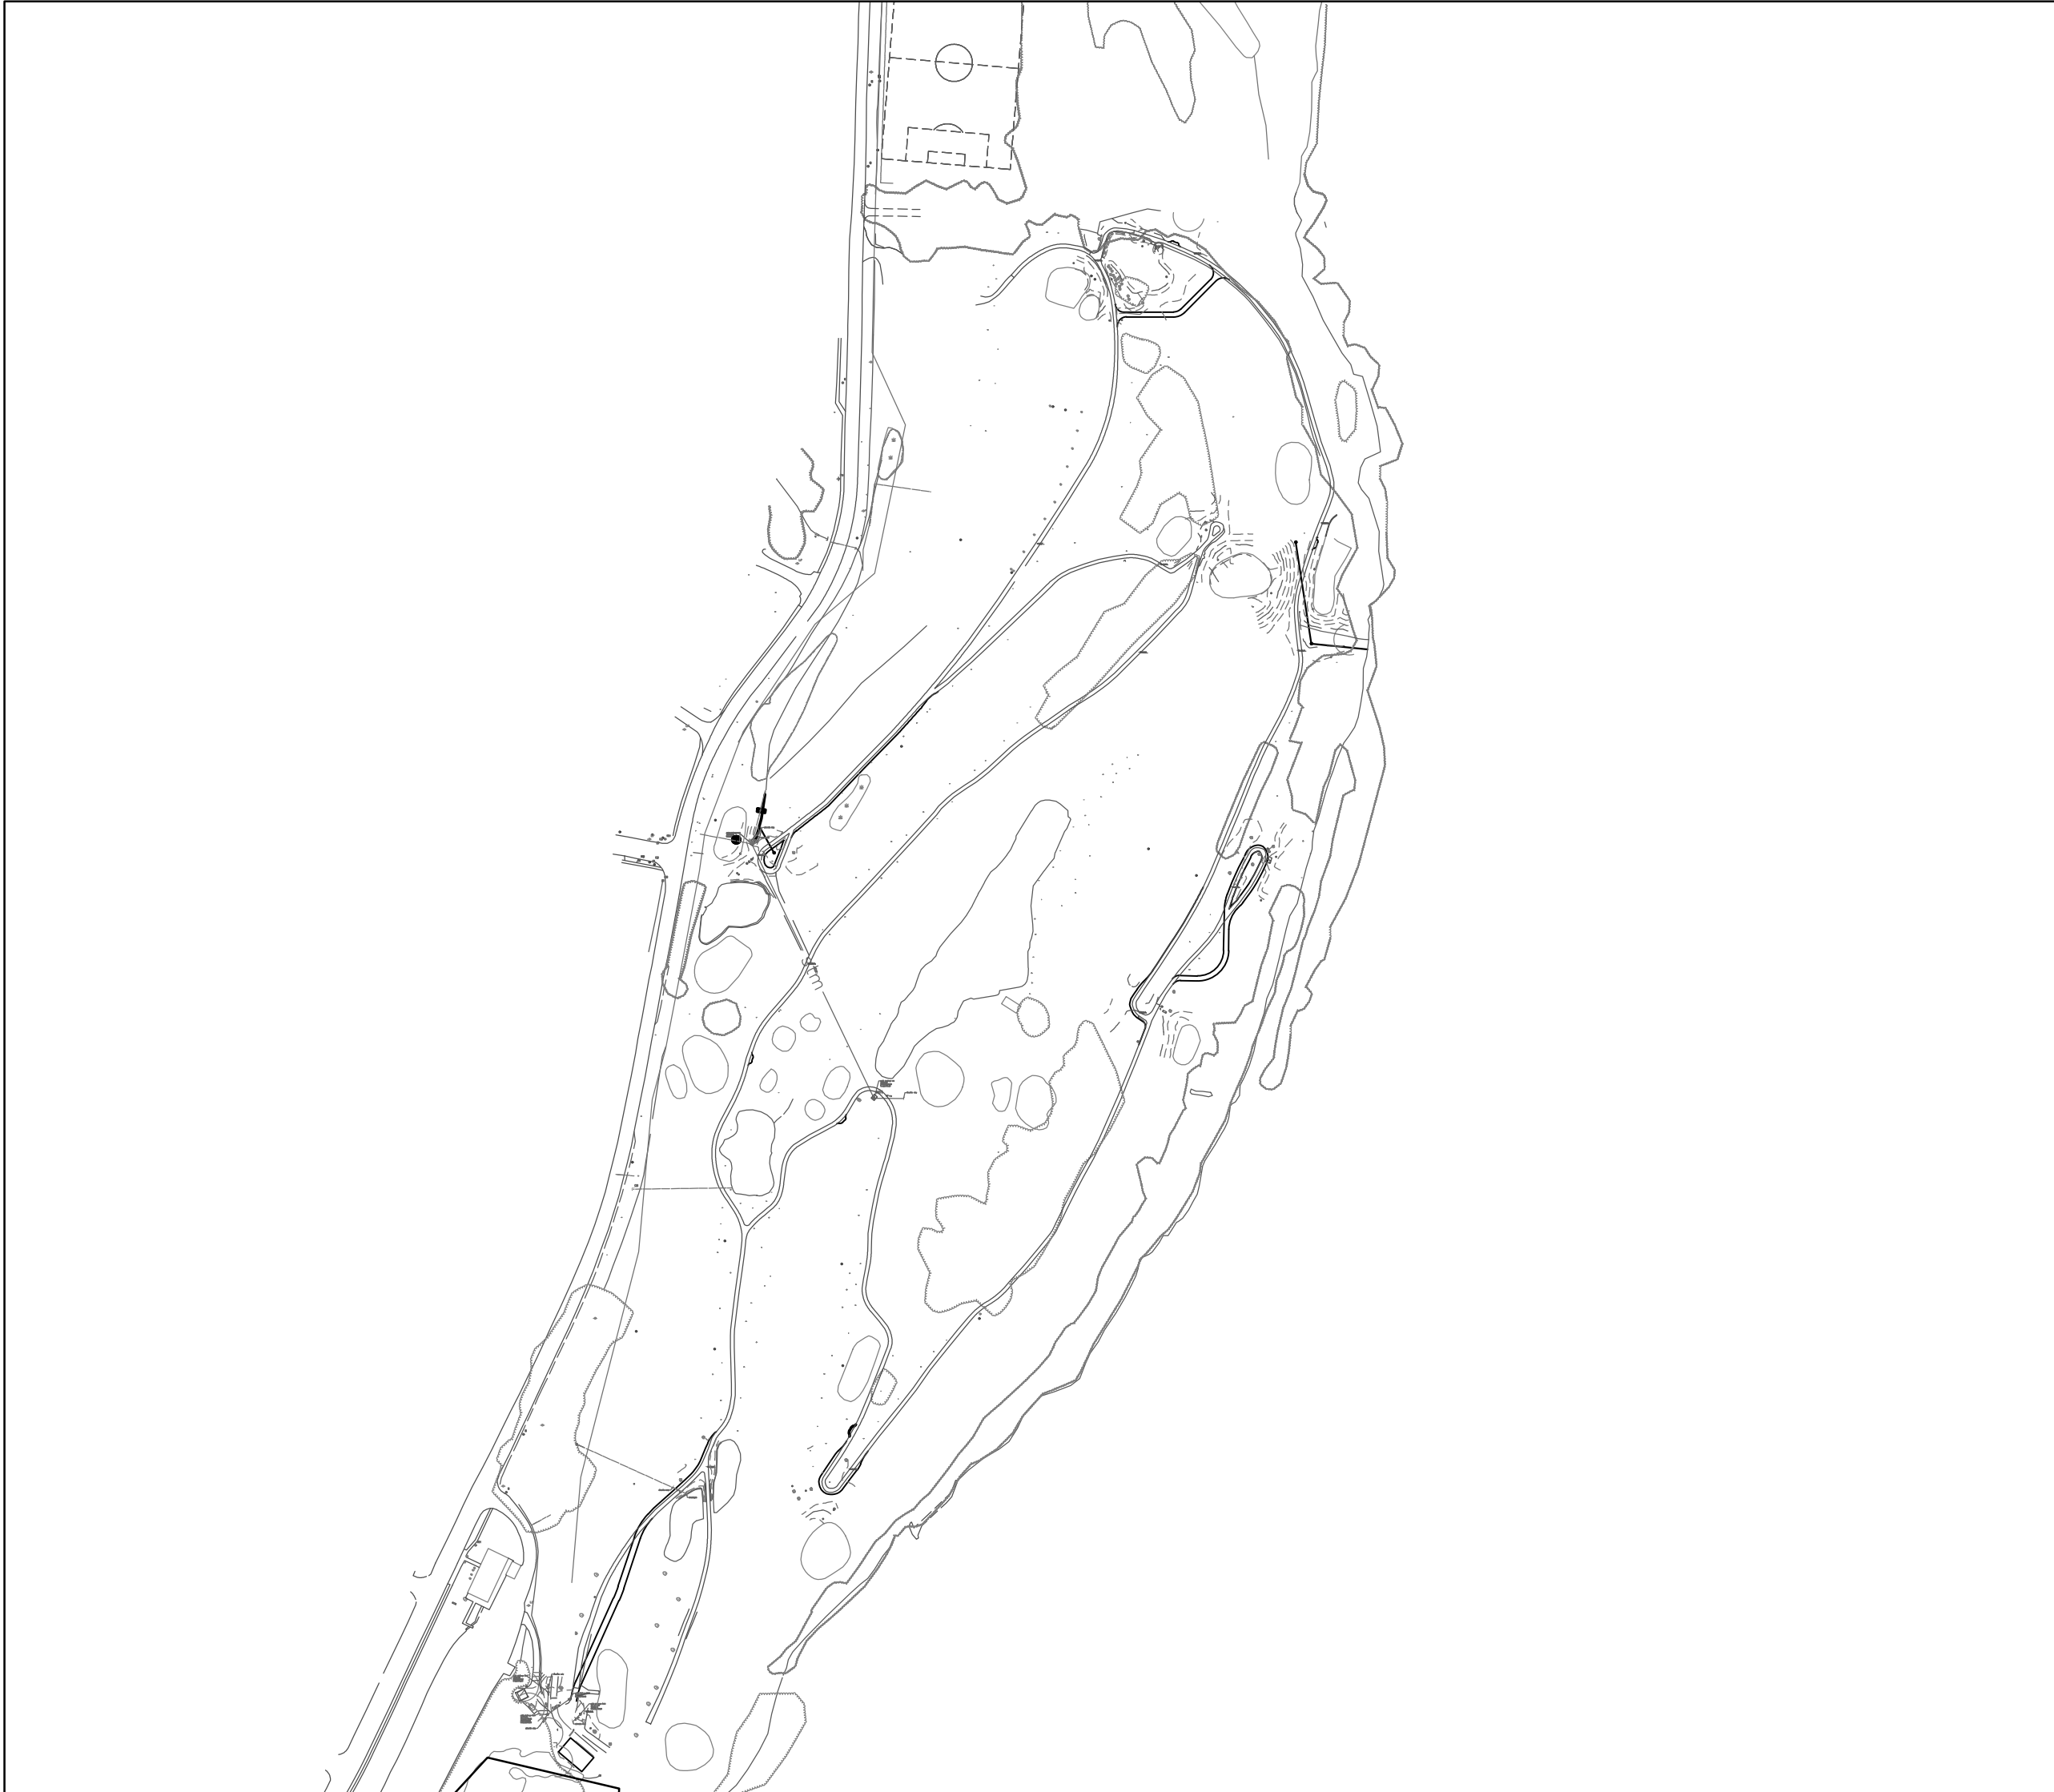

INDEX MAP
1" = 250'



OLDE RIDENOUR
DRIVE
SITE
MILL STEET



VICINITY MAP
NTS



STANDARD DRAWINGS

MUNICIPALITY
THE STANDARD CONSTRUCTION DRAWINGS LISTED ON
THESE PLANS SHALL BE CONSIDERED A PART THEREOF.

CITY OF GAHANNA

CITY OF GAHANNA APPROVAL

THE SIGNATURES BELOW SIGNIFY ONLY CONCURRENCE WITH THE PURPOSE AND
GENERAL LOCATION OF THE PROJECT. ALL TECHNICAL DETAILS REMAIN THE
RESPONSIBILITY OF THE ENGINEER PREPARING THE PLANS.

CITY ENGINEER _____ DATE _____
CITY OF GAHANNA, OHIO

PARKS AND RECREATION PROJECTS MANAGER _____ DATE _____
CITY OF GAHANNA, OHIO

DIRECTOR OF PARKS AND RECREATION _____ DATE _____
CITY OF GAHANNA, OHIO

ENGINEER

AMERICAN STRUCTUREPOINT
2550 CORPORATE EXCHANGE DRIVE, SUITE 300
COLUMBUS, OHIO 43230
CONTACT: BEN MILLER
PHONE: 614-901-2235
EMAIL: BMILLER@STRUCTUREPOINT.COM

OWNER

CITY OF GAHANNA
200 S. HAMILTON ROAD
GAHANNA, OHIO 43230
CONTACT: ALAN LITTLE
CELL: 614-302-0291
OFFICE: 614-342-4254
EMAIL: ALAN.LITTLE@GAHANNA.GOV

	1/15/2024
REGISTERED ENGINEER BEN MILLER, E-76866 P.E.	DATE

Ohio Utilities Protection Service



AMERICAN
STRUCTUREPOINT
INC.



2550 Corporate Exchange Dr., Ste 300 | Columbus, Ohio 43231
TEL: 614-901-2235 FAX: 614-901-2236
www.structurepoint.com

CONSTRUCTION DOCUMENTS
FOR
GAHANNA MUNICIPAL GOLF
COURSE
GAHANNA, FRANKLIN COUNTY, OHIO
TITLE SHEET

REVISIONS	DATE	SHEET NO.	DESCRIPTION

APPROVAL PENDING NOT FOR
CONSTRUCTION
IN SUBMITTING BIDS IN RELIANCE ON
THESE PLANS THE CONTRACTOR
ASSUMES ALL RISKS OF ADDITIONAL
COSTS OF REVISIONS DUE TO
REQUIREMENTS OF THE OWNER OR
GOVERNMENTAL AUTHORITIES AND
MATERIAL REVISIONS IN THE COURSE
OF COMPLETING THE FINAL DESIGN.

DATE:	1/15/2024
DRAWN BY:	MNA
CHECKED BY:	BJM
JOB NUMBER:	2019.01727

GENERAL NOTES

1. THE CONTRACTOR SHALL VISIT THE SITE, REVIEW ALL CONSTRUCTION DOCUMENTS, AND FIELD VERIFY THE EXISTING CONDITIONS PRIOR TO BIDDING. NO ADDITIONAL COMPENSATION WILL BE GIVEN FOR WORK THAT COULD HAVE BEEN IDENTIFIED BY A SITE VISIT OR CONSTRUCTION DOCUMENT REVIEW.
2. SPECIFICATIONS - PERFORM ALL WORK IN ACCORDANCE WITH CITY OF GAHANNA, CITY OF COLUMBUS, AND OHIO DEPARTMENT OF TRANSPORTATION (ODOT) MATERIAL SPECIFICATIONS AND STANDARD CONSTRUCTION DRAWINGS, INCLUDING ALL SUPPLEMENTS THERETO. IN CASE OF DISCREPANCY BETWEEN CITY AND ODOT REQUIREMENTS AND PROJECT SPECIFICATIONS, THE MORE STRICT SPECIFICATION SHALL APPLY. WHEREVER THE WORDS "STATE," "DEPARTMENT," OR "DEPUTY DIRECTOR" OCCUR, IT IS TO MEAN THE OWNER. WHEREVER THE WORD "ENGINEER" OCCURS, IT IS TO MEAN AMERICAN STRUCTUREPOINT, INC.

THIS PROJECT IS TO BE BID AND ADMINISTERED AS A LUMP SUM PROJECT. ALL REFERENCES TO UNIT PRICES AND METHODS OF MEASUREMENT FOR THE PURPOSE OF PAYMENT SHALL BE DISREGARDED.
3. IT IS THE CONTRACTORS RESPONSIBILITY TO ASCERTAIN THE LOCATION OF ALL EXISTING UTILITIES. THE CONTRACTOR SHALL VERIFY THE LOCATION, ELEVATION AND MARK ALL EXISTING UTILITIES 48 HOURS BEFORE CONSTRUCTION STARTS. CONTACT OUPS UTILITY LOCATING SERVICE TO FIELD LOCATE EXISTING UTILITIES. CONTACT UTILITY OWNER IF DAMAGE OCCURS DUE TO CONSTRUCTION.
4. PROTECT ALL EXISTING STRUCTURES AND UTILITIES WHICH ARE NOT SCHEDULED FOR REMOVAL.
5. BENCHMARKS - THE CONTRACTOR SHALL CAREFULLY PRESERVE BENCHMARKS, SURVEY MONUMENTS, PROPERTY CORNERS, REFERENCE POINTS, AND STAKES. ANY BENCHMARK, PROPERTY CORNER, OR SURVEY MARKER DAMAGED OR DISTURBED BY THE CONTRACTOR SHALL BE RESET BY AN OHIO REGISTERED SURVEYOR AT THE CONTRACTOR'S EXPENSE.
6. THE CONTRACTOR SHALL BE SOLELY RESPONSIBLE FOR COMPLYING WITH ALL FEDERAL AND LOCAL SAFETY REQUIREMENTS INCLUDING THE OCCUPATIONAL SAFETY AND HEALTH ACT (OSHA) OF 1970. THE CONTRACTOR SHALL EXERCISE PRECAUTION ALWAYS FOR THE PROTECTION OF PERSONS (INCLUDING EMPLOYEES) AND PROPERTY. IT SHALL ALSO BE THE SOLE RESPONSIBILITY OF THE CONTRACTOR TO INITIATE, MAINTAIN AND SUPERVISE ALL SAFETY REQUIREMENTS, PRECAUTIONS AND PROGRAMS IN CONNECTION WITH THE WORK, INCLUDING THE REQUIREMENTS FOR CONFINED SPACES PER 29 CFR 1910.146.
7. PERMITS & LICENSES - THE CONTRACTOR SHALL OBTAIN AND PAY FOR ALL NECESSARY PERMITS AND LICENSES NEEDED FOR THE CONSTRUCTION OF THIS PROJECT.
8. EXISTING SEWERS & STRUCTURES - THE CONTRACTOR SHALL REPLACE, TO THE SATISFACTION OF THE ENGINEER, ALL EXISTING MANHOLES, CATCH BASINS, DRAINS, SEWERS, AND APPURTENANCES REMOVED OR DAMAGED DURING CONSTRUCTION. THE CONTRACTOR SHALL REMOVE DEBRIS, SILT, ETC. FROM THE EXISTING MANHOLES AND CATCH BASINS WHICH HAVE BEEN AFFECTED BY CONSTRUCTION OPERATIONS. THE CONTRACTOR SHALL MAINTAIN SERVICE IN EXISTING SEWERS DURING CONSTRUCTION.
9. SAW-CUT - ALL EXISTING PAVEMENTS, WALKWAYS, CURBS, ETC. SHALL BE SAW-CUT BEFORE REMOVAL. IF DURING CONSTRUCTION, THE PAVEMENT, WALKWAY, CURB, ETC. IS DAMAGED BEYOND THE ORIGINAL SAW-CUT, THE DAMAGED AREA SHALL BE RE-CUT TO NEAT LINES, AS DIRECTED BY THE ENGINEER. SAW-CUT SHALL BE PERFORMED ALONG EXISTING JOINTS WHERE POSSIBLE. WHENEVER PORTIONS OF EXISTING PAVEMENT OR CURB ARE TO BE REMOVED ALLOWING PORTIONS OF THE PAVEMENT TO REMAIN, THE CONTRACTOR SHALL SAW-CUT THE ASPHALT OR CONCRETE PRIOR TO REMOVAL.
10. NON-RUBBER TIRED VEHICLES - NO NON-RUBBER TIRED VEHICLES SHALL BE MOVED ON EXISTING PAVEMENT TO REMAIN. EXCEPTIONS MAY BE GRANTED BY THE OWNER WHERE SHORT DISTANCES AND SPECIAL CIRCUMSTANCES ARE INVOLVED. GRANTING OF EXCEPTIONS MUST BE IN WRITING AND ANY RESULTING DAMAGE MUST BE REPAIRED TO THE SATISFACTION OF THE OWNER.
11. CLEAN-UP - IT IS THE INTENT OF THE OWNER TO KEEP INCONVENIENCE TO THE SURROUNDING PROPERTIES TO AN ABSOLUTE MINIMUM. ALL WORK PRESCRIBED AND DESCRIBED IN THESE PLANS AND SPECIFICATIONS IS SITUATED IN IMPROVEMENT AREAS. ALL WORK IS TO CONTINUE ON A UNIFORM BASIS AND ON SCHEDULE, PARTICULARLY THE RESTORATION AND CLEANUP OF DISTURBED AREAS AFTER CONSTRUCTION. ALL DEBRIS, RUBBLE, UNSUITABLE MATERIALS, AND ITEMS NOT SALVAGED BY THE OWNER SHALL BECOME THE PROPERTY OF THE CONTRACTOR AND SHALL BE REMOVED FROM THE SITE BY THE CONTRACTOR AND DISPOSED OF PROPERLY ACCORDING TO LOCAL CODES. THE CONTRACTOR SHALL RESTORE DISTURBED AREAS TO THEIR ORIGINAL CONDITION AND ELEVATION. ANY DIRT, SEDIMENT OR MUD DEPOSITED ON CITY STREETS ON OR OFF THE PROJECT SITE SHALL IMMEDIATELY BE CLEANED BY THE CONTRACTOR. THE CONTRACTOR IS REQUIRED TO PERFORM WEEKLY STREET CLEANING THROUGHOUT THE DURATION OF THE PROJECT. THIS MAY INCLUDE REMOVAL BY SWEEPING, POWER CLEANING, OR MANUAL METHODS. THE CONTRACTOR SHALL RESTORE ALL DISTURBED AREAS TO EQUAL OR BETTER CONDITION THAN EXISTED BEFORE CONSTRUCTION. DRAINAGE DITCHES OR WATERCOURSES THAT ARE DISTURBED BY CONSTRUCTION SHALL BE RESTORED TO THE GRADES AND CROSS-SECTIONS THAT EXISTED BEFORE CONSTRUCTION.
12. ADDITIONAL COMPENSATION - THE CONTRACTOR SHALL FURNISH ALL LABOR, MATERIALS, TOOLS, EQUIPMENT, SERVICES, AND RELATED ACCESSORIES FOR A COMPLETE PROJECT AS SHOWN AND DESCRIBED IN THE PLANS AND SPECIFICATIONS. SUBMISSIONS OF A BID SHALL BE CONSIDERED EVIDENCE THAT THE BIDDER IS SATISFIED WITH THE PLANS AND CONDITIONS AS SHOWN. NO ADDITIONAL COMPENSATION WILL BE PAID TO THE CONTRACTOR FOR COMPLIANCE WITH THE PLANS, SPECIFICATIONS, OR SPECIAL PROVISIONS.
13. SANITARY FACILITIES - THE CONTRACTOR SHALL FURNISH AND MAINTAIN SANITARY CONVENIENCE FACILITIES FOR THE WORKERS AND INSPECTORS FOR THE DURATION OF THE WORK.
14. STORAGE OF EQUIPMENT AND MATERIALS - ALL MATERIALS, INCLUDING PIPE, SHALL BE STORED IN AREAS TO MINIMIZE INCONVENIENCE AND LOSS OF USE TO OWNER PROPERTY. STORAGE EQUIPMENT, DURING NON-WORKING HOURS, SHALL ALSO COMPLY WITH THIS REQUIREMENT. COMPLIANCE WITH THIS REQUIREMENT ALONG WITH ADDITIONAL PROVISIONS OF THE CONTRACT SPECIFICATIONS SHALL NOT IN ANY WAY RELIEVE THE CONTRACTOR OF THIS LEGAL RESPONSIBILITIES OR LIABILITIES FOR THE SAFETY OF THE PUBLIC. THE CONTRACTOR SHALL RECEIVE OWNER APPROVAL OF STORAGE AREAS PRIOR TO CONSTRUCTION.
15. CONTRACTOR LAYDOWN AREAS - CONTRACTOR STAGING, LAYDOWN, AND TRAILER AREAS WILL BE PROVIDED AT THE PROJECT SITE. COORDINATE EXACT LOCATION WITH THE OWNER. PROTECTION OF LAYDOWN AREAS AND STAGING AREAS ARE AS DEEMED NECESSARY BY THE CONTRACTOR. PROVIDE ORANGE CONSTRUCTION FENCE AROUND ALL LAYDOWN AREAS. ALL LAYDOWN AREAS AND STAGING AREAS SHALL BE RESTORED TO ORIGINAL CONDITION PRIOR TO ACCEPTANCE BY THE OWNER.
16. CONSTRUCTION PRACTICES - BEST CONSTRUCTION PRACTICES ARE TO BE IMPLEMENTED TO MINIMIZE WATER QUALITY IMPACTS. A SPILL CONTAINMENT KIT IS TO BE MAINTAINED ON-SITE THROUGHOUT CONSTRUCTION ACTIVITIES. SPILLS OF FUELS, OILS, CHEMICALS, OR OTHER MATERIALS WHICH COULD POSE A THREAT TO GROUNDWATER SHALL BE CLEANED UP IMMEDIATELY. IF THE SPILL IS A REPORTABLE AMOUNT (25 GALLONS OR MORE) THE LOCAL FIRE DEPARTMENT IS TO BE CONTACTED. PROVIDE SECONDARY CONTAINMENT OF ANY TEMPORARY FUEL STORAGE TANK AND/OR EQUIPMENT THAT HAS POTENTIAL FOR CAUSING A SPILL.
17. TESTING - REFER TO PROJECT MANUAL FOR TESTING AND INSPECTION REQUIREMENTS.

- UTILITY PROTECTION - THE LOCATIONS OF THE UNDERGROUND UTILITIES SHOWN ON THE PLAN ARE OBTAINED FROM A TOPOGRAPHIC SURVEY. THE CONTRACTOR IS RESPONSIBLE FOR THE INVESTIGATION, LOCATION, SUPPORT, PROTECTION AND RESTORATION OF ALL EXISTING UTILITIES AND APPURTENANCES SHOWN. THE CONTRACTOR SHALL EXPOSE UTILITIES AND STRUCTURES PRIOR TO THE CONSTRUCTION TO VERIFY THE VERTICAL AND HORIZONTAL EFFECT ON THE PROPOSED CONSTRUCTION. ANY DEVIATIONS FROM THE PLANS SHALL BE REPORTED TO THE ENGINEER IMMEDIATELY. SUCH THAT, ANY MODIFICATIONS TO THE PROPOSED DESIGN CAN BE MADE. POTHOLES AND/OR EXCAVATIONS SHALL BE USED WHERE NECESSARY AND AS APPROVED BY THE OWNER. ITEMS SHALL BE EXPOSED SUFFICIENTLY IN ADVANCE TO MAINTAIN THE PROJECT SCHEDULE.
- THE CONTRACTOR SHALL CALL, TOLL FREE, THE OHIO UTILITIES PROTECTION SERVICE (1-800-362-2764) 72 HOURS PRIOR TO CONSTRUCTION AND SHALL NOTIFY ALL UTILITY COMPANIES AT LEAST 48 HOURS PRIOR TO WORK IN THE VICINITY OF THEIR UNDERGROUND LINES.
- MECHANICAL DIGGING EQUIPMENT SHALL NOT BE USED FOR EXPOSING ANY UNDERGROUND UTILITY. ONLY HAND TOOLS MAY BE USED TO UNCOVER THE UTILITY AND THE UTILITY COMPANY SHALL BE NOTIFIED AND HAVE A REPRESENTATIVE PRESENT WHEN THE UTILITY IS EXPOSED.
- LOCATE EXISTING UNDERGROUND UTILITIES IN THE AREAS OF THE WORK. IF UTILITIES ARE TO REMAIN IN PLACE, PROVIDE ADEQUATE MEANS OF PROTECTING DURING EXCAVATION OPERATIONS. SHOULD UNCHARTED OR INCORRECTLY CHARTED PIPING OR OTHER UTILITIES BE ENCOUNTERED DURING EXCAVATION, CONSULT THE ENGINEER IMMEDIATELY FOR DIRECTIONS.
- CONTRACTOR SHALL SUPPORT ALL EXISTING UTILITIES TRAVERSING THROUGH THE EXCAVATION. DO NOT INTERRUPT EXISTING UTILITIES SERVING FACILITIES OCCUPIED AND USED OUTSIDE OF THE PROJECT AREA, EXCEPT WHEN PERMITTED IN WRITING BY THE AFFECTED PARTY AND THEN ONLY AFTER ACCEPTABLE TEMPORARY UTILITY SERVICES HAVE BEEN PROVIDED.
- COOPERATE WITH THE OWNER AND THE PUBLIC UTILITY COMPANIES IN KEEPING THEIR RESPECTIVE SERVICES AND FACILITIES IN OPERATION. REPAIR DAMAGED UTILITIES TO THE SATISFACTION OF THE UTILITY OWNER.
19. CONTRACTOR SHALL INSTALL A CONSTRUCTION FENCE, AS NECESSARY, TO KEEP ALL PEDESTRIANS SAFELY AWAY FROM WORK. FENCE SHALL BE 6' HIGH CHAIN LINK FENCE WITH GROUND MOUNTED POSTS OR TEMPORARY POSTS SECURELY ANCHORED.
20. ALL EXCAVATION, CONSTRUCTION, AND BACKFILL TO BE CONSTRUCTED UNDER THIS CONTRACT SHALL BE CONSTRUCTED UNDER DRY CONDITIONS. THE CONTRACTOR SHALL MAINTAIN ALL EXCAVATIONS IN A DE-WATERED, WORKABLE CONDITION, AND PROPER DE-WATERING MEASURES SHALL BE TAKEN AS DICTATED BY FIELD CONDITIONS. THE DISCHARGE OF SEDIMENT LADEN WATERS INTO ANY PUBLIC WATERCOURSE IS STRICTLY PROHIBITED. ALL SEDIMENTS MUST BE REMOVED PRIOR TO DISCHARGE.
21. HAZARDOUS MATERIALS - THE CONTRACTOR SHALL BRING TO THE ATTENTION OF THE ENGINEER AND THE OWNER'S REPRESENTATIVE, ANY MATERIAL ENCOUNTERED DURING EXCAVATION OF THE WORK THAT THE CONTRACTOR SUSPECTS IS HAZARDOUS.
22. REPLACEMENT OF DRAIN TILE AND STORM SEWER - ALL DRAIN TILE AND STORM SEWERS DAMAGED, DISTURBED, OR REMOVED AS A RESULT OF THE CONTRACTOR'S OPERATIONS SHALL BE REPLACED WITH THE SAME QUALITY PIPE OR BETTER, MAINTAINING THE SAME GRADIENT AS THE EXISTING. THE DRAIN TILE AND/OR STORM SEWER SHALL BE CONNECTED TO THE CURB SUB-DRAIN, STORM SEWER SYSTEM, OR PROVIDED WITH AN OUTLET INTO THE ROADWAY DITCH AS APPLICABLE. REPLACEMENT DRAIN TILE/STORM SEWER SHALL BE LAID ON COMPACTED BEDDING EQUAL IN DENSITY TO SURROUNDING STRUTUM. REPLACEMENT WORK SHALL BE DONE AT THE TIME OF THE BACKFILL OPERATION.
23. SUBGRADE - REFER TO PROJECT GEOTECHNICAL REPORT REGARDING SUBGRADE RECOMMENDATIONS FOR THE PROJECT SITE.
24. OPEN TRENCH EXCAVATION - SLOUGHING AND CAVING OF EXCAVATIONS SHOULD BE ANTICIPATED WHERE SATURATED WEAK SOILS ARE ENCOUNTERED OR WHERE GRANULAR SEAMS AND LAYERS ARE PRESENT. ALL EXCAVATIONS MUST BE PERFORMED WITHOUT ENDANGERING THE CONSTRUCTION WORKERS. THEREFORE, IN ACCORDANCE WITH THE OSHA TRENCH/EXCAVATION REGULATIONS (OSHA 29 CFR PART 1926), FOR ANY EXCAVATIONS EXCEEDING A DEPTH OF 5 FEET IN WHICH WORKERS WILL BE ENTERING THE EXCAVATION/TRENCH, THE EXCAVATION SIDES MUST BE BRACED OR SLOPED TO THE REQUIRED MAXIMUM INCLINATION OR FLATTER (BASED ON THE SOIL TYPE AND STRENGTH).
- ANY EXCAVATION INSTALLED USING AN OPEN TRENCH CONSTRUCTION METHOD COULD POTENTIALLY CAUSE DAMAGE TO EXISTING UNDERGROUND UTILITIES, STRUCTURES, OR PAVEMENT CURRENTLY LOCATED IN THE VICINITY OF THE PROPOSED UTILITY ALIGNMENT AND POSITIONED AT HIGHER ELEVATIONS THAN THE PLANNED EXCAVATION DEPTH. THIS WOULD APPLY TO EITHER THE TYPICAL OPEN CUT TRENCH THAT HAS NEAR VERTICAL SIDES OR A TRENCH BOX. THEREFORE, THE LATERAL DISTANCE, DEPTH OF THE EXISTING UTILITY, AND THE PLANNED EXCAVATION DEPTH MUST BE KNOWN TO DETERMINE WHETHER ADJACENT UNDERGROUND UTILITIES COULD BE AFFECTED BY THE EXCAVATION. THE RISK OF LATERAL MOVEMENT WITHIN THE INFLUENCE ZONE INCREASES WITH BOTH THE LENGTH OF THE EXCAVATION AND THE TIME THE TRENCH REMAINS OPEN.
- WHERE BRACED EXCAVATIONS ARE REQUIRED, TRENCH EXCAVATIONS SHALL BE DIRECTLY BRACED AT THE TIME OF THE EXCAVATION. THE BRACING MUST BE DESIGNED AS A RIGID SYSTEM WITHOUT DEFLECTION ALONG ITS ENTIRETY, CONSTRUCTED "TIGHT" AGAINST THE RETAINED SOIL. THE BRACING SYSTEM CANNOT BE INSTALLED AFTER THE EXCAVATION IS MADE.
25. TRENCH BACKFILL - TRENCH COMPACTED BACKFILL SHALL BE PER ODOT ITEM 611 & 638.08. COMPACTED GRANULAR MATERIAL IS REQUIRED IN ALL TRENCHES UNDER PAVEMENT AREAS (DRIVEWAYS, STREETS, SIDEWALKS, ETC.) OR WHERE THE FRONT FACE OF TRENCHES PARALLELING THE PAVEMENT, ARE WITHIN 36" OF THE FACE OF CURB OR EDGE OF PAVEMENT. UNLESS SHOWN OTHERWISE ON THE PLANS, THE MATERIAL WILL EXTEND Laterally 36" BEYOND THE FACE OF CURB OR EDGE OF PAVEMENT FROM TRENCHES WHICH CROSS THE PAVEMENT. AT ALL POINTS OF CROSSING WATER MAINS OR OTHER SEWERS, THE BACKFILL SHALL BE OF GRANULAR MATERIAL BETWEEN THE DEEPER AND SHALLOWER PIPES.
26. PLAN CHANGES - GRADES AND ELEVATIONS SHOWN ON THE PLANS SHALL NOT BE REVISED UNDER ANY CIRCUMSTANCES WITHOUT FIRST OBTAINING WRITTEN APPROVAL FROM THE ENGINEER. INVERT ELEVATIONS SHALL NOT DEVIATE FROM PLAN ELEVATION BY MORE THAN 0.05 FOOT. FAILING TO MEET THE ABOVE REQUIREMENTS ARE CAUSE FOR REJECTION OF THE AFFECTED SECTION OF SEWER.
- DEMOLITION NOTES:
1. CONFIRM EXISTING CONDITIONS PRIOR TO BEGINNING WORK.
2. ALL CLEARING, GRUBBING, AND RELATED ACTIVITIES SHALL CONFORM TO ODOT ITEM 201. DISPOSE OF TREES OFF SITE.
3. ALL TREES, SAPLINGS, CROPS, GRASS, OR MONUMENTS LOCATED WITHIN THE WORK AREA WHETHER SHOWN OR NOT SHOWN ON THE DRAWINGS ARE TO BE PRESERVED, UNLESS NOTED TO BE REMOVED OR UNLESS APPROVAL TO REMOVE IS GIVEN IN WRITING BY THE ENGINEER. THE CONTRACTOR WILL BE RESPONSIBLE FOR ANY CLAIM FROM DAMAGE TO TREES, SAPLINGS, CROPS, OR GRASSES WHICH MAY OCCUR AS THE RESULT OF THE CONSTRUCTION OPERATIONS, DAMAGE TO SIGNS, FENCES, LAWN AREAS, HEDGES, FLOWERS, SHRUBBERY, ETC. AS A RESULT OF THE CONSTRUCTION SHALL BE RESTORED IN LIKE KIND AND CHARACTER TO THE SATISFACTION OF THE ENGINEER.

4. REMOVE ALL ON-GRADE SITE FEATURES WITHIN THE AREA OF WORK INCLUDING: SIDEWALKS, CURBS, CONCRETE FOUNDATIONS, CONCRETE AND ASPHALT PAVEMENT.
 5. SAW-CUT, FULL DEPTH, EXISTING ASPHALT PAVEMENT AND CONCRETE CURB WHERE NEW WORK ABUTS EXISTING CONSTRUCTION. USE CARE TO SAW-CUT NEAT STRAIGHT LINES. WHEN SAW-CUTTING EXISTING CONCRETE, CUT ALONG EXISTING JOINT LINES WHEREVER POSSIBLE.
 6. CONTRACTOR SHALL USE CAUTION TO PROTECT EXISTING SITE FEATURES TO REMAIN. REPLACE ANY DAMAGE AT NO COST TO THE OWNER.
 7. LEGALLY DISPOSE OF ALL CONSTRUCTION DEBRIS OFF-SITE IN ACCORDANCE WITH LOCAL CODES. NO ON-SITE BURNING.
 8. USE ALL MEANS NECESSARY TO CONTROL DUST ON-SITE AND PREVENT TRACKING SOIL OFF-SITE.
 9. REFER TO ARCHITECTURAL DRAWINGS AND SPECIFICATIONS FOR EXISTING BUILDING AND/OR STRUCTURES DEMOLITION AND PROTECTION.
- A. GRAVEL, AND PAVEMENT MILLINGS OFF-SITE PER LOCAL CODES.



ESTIMATE OF QUANTITIES			
ITEM	DESCRIPTION	QUANTITY	UNIT
CART PATH			
202	PAVEMENT REMOVED	305	SY
204	SUBGRADE COMPACTION	987	SY
254	PAVEMENT PLANING	5,977	
304	6" GRAVEL AGGREGATE BASE	165	CY
407	NON-TRACKING TACK COAT	418	GAL
659	SEEDING AND MULCHING	1,000	SY
659	WATER	1	MGAL
1530	ASPHALT CONCRETE SURFACE COURSE, TYPE 1 (448) PG 64-22 (1.25")	242	CY
1531	ASPHALT CONCRETE INTERMEDIATE COURSE, TYPE 2 (448) PG 64-22 (1.75")	339	CY
STORM SEWER			
SPEC	10" ADS N-12 PIPE	308	LF
SPEC	10" ADS NYLOPLAST DRAIN BASIN	3	EA
SPEC	CONSTRUCTION STAKING	1	LS
SPEC	MOBILIZATION	1	LS
CALCULATED BY: MNA DATE: 12/18/2023 CHECKED BY: BJM			

[illegible]

APPROVAL PENDING NOT FOR CONSTRUCTION
IN SUBMITTING BIDS IN RELIANCE ON THESE PLANS THE CONTRACTOR ASSUMES ALL RISKS OF ADDITIONAL COSTS OF REVISIONS DUE TO REQUIREMENTS OF THE OWNER OR GOVERNMENTAL AUTHORITIES AND MATERIAL REVISIONS IN THE COURSE OF COMPLETING THE FINAL DESIGN.

DATE:	1/15/2024
DRAWN BY:	MNA
CHECKED BY:	BJM
JOB NUMBER:	2019.01727

PLOT SCALE: 1"=150' DATE: 12/18/23 - 2:45 PM EDITED BY: MAHMOUD DRAIVING FILE: 01201901727.D DRAWINGS\CIVIL\CONSTRUCTION\DOCUMENTS\CONSTRUCTION\DOCUMENTS\2019.01727.OSP.DWG

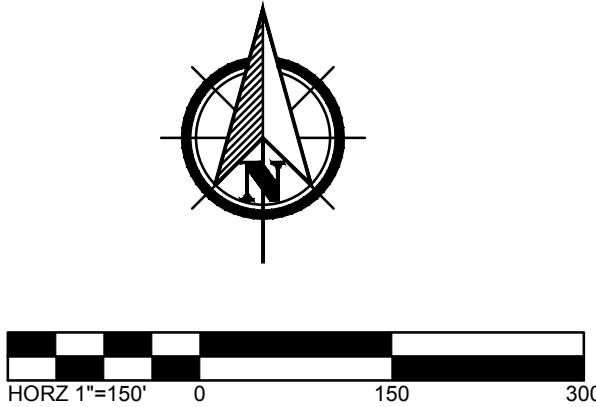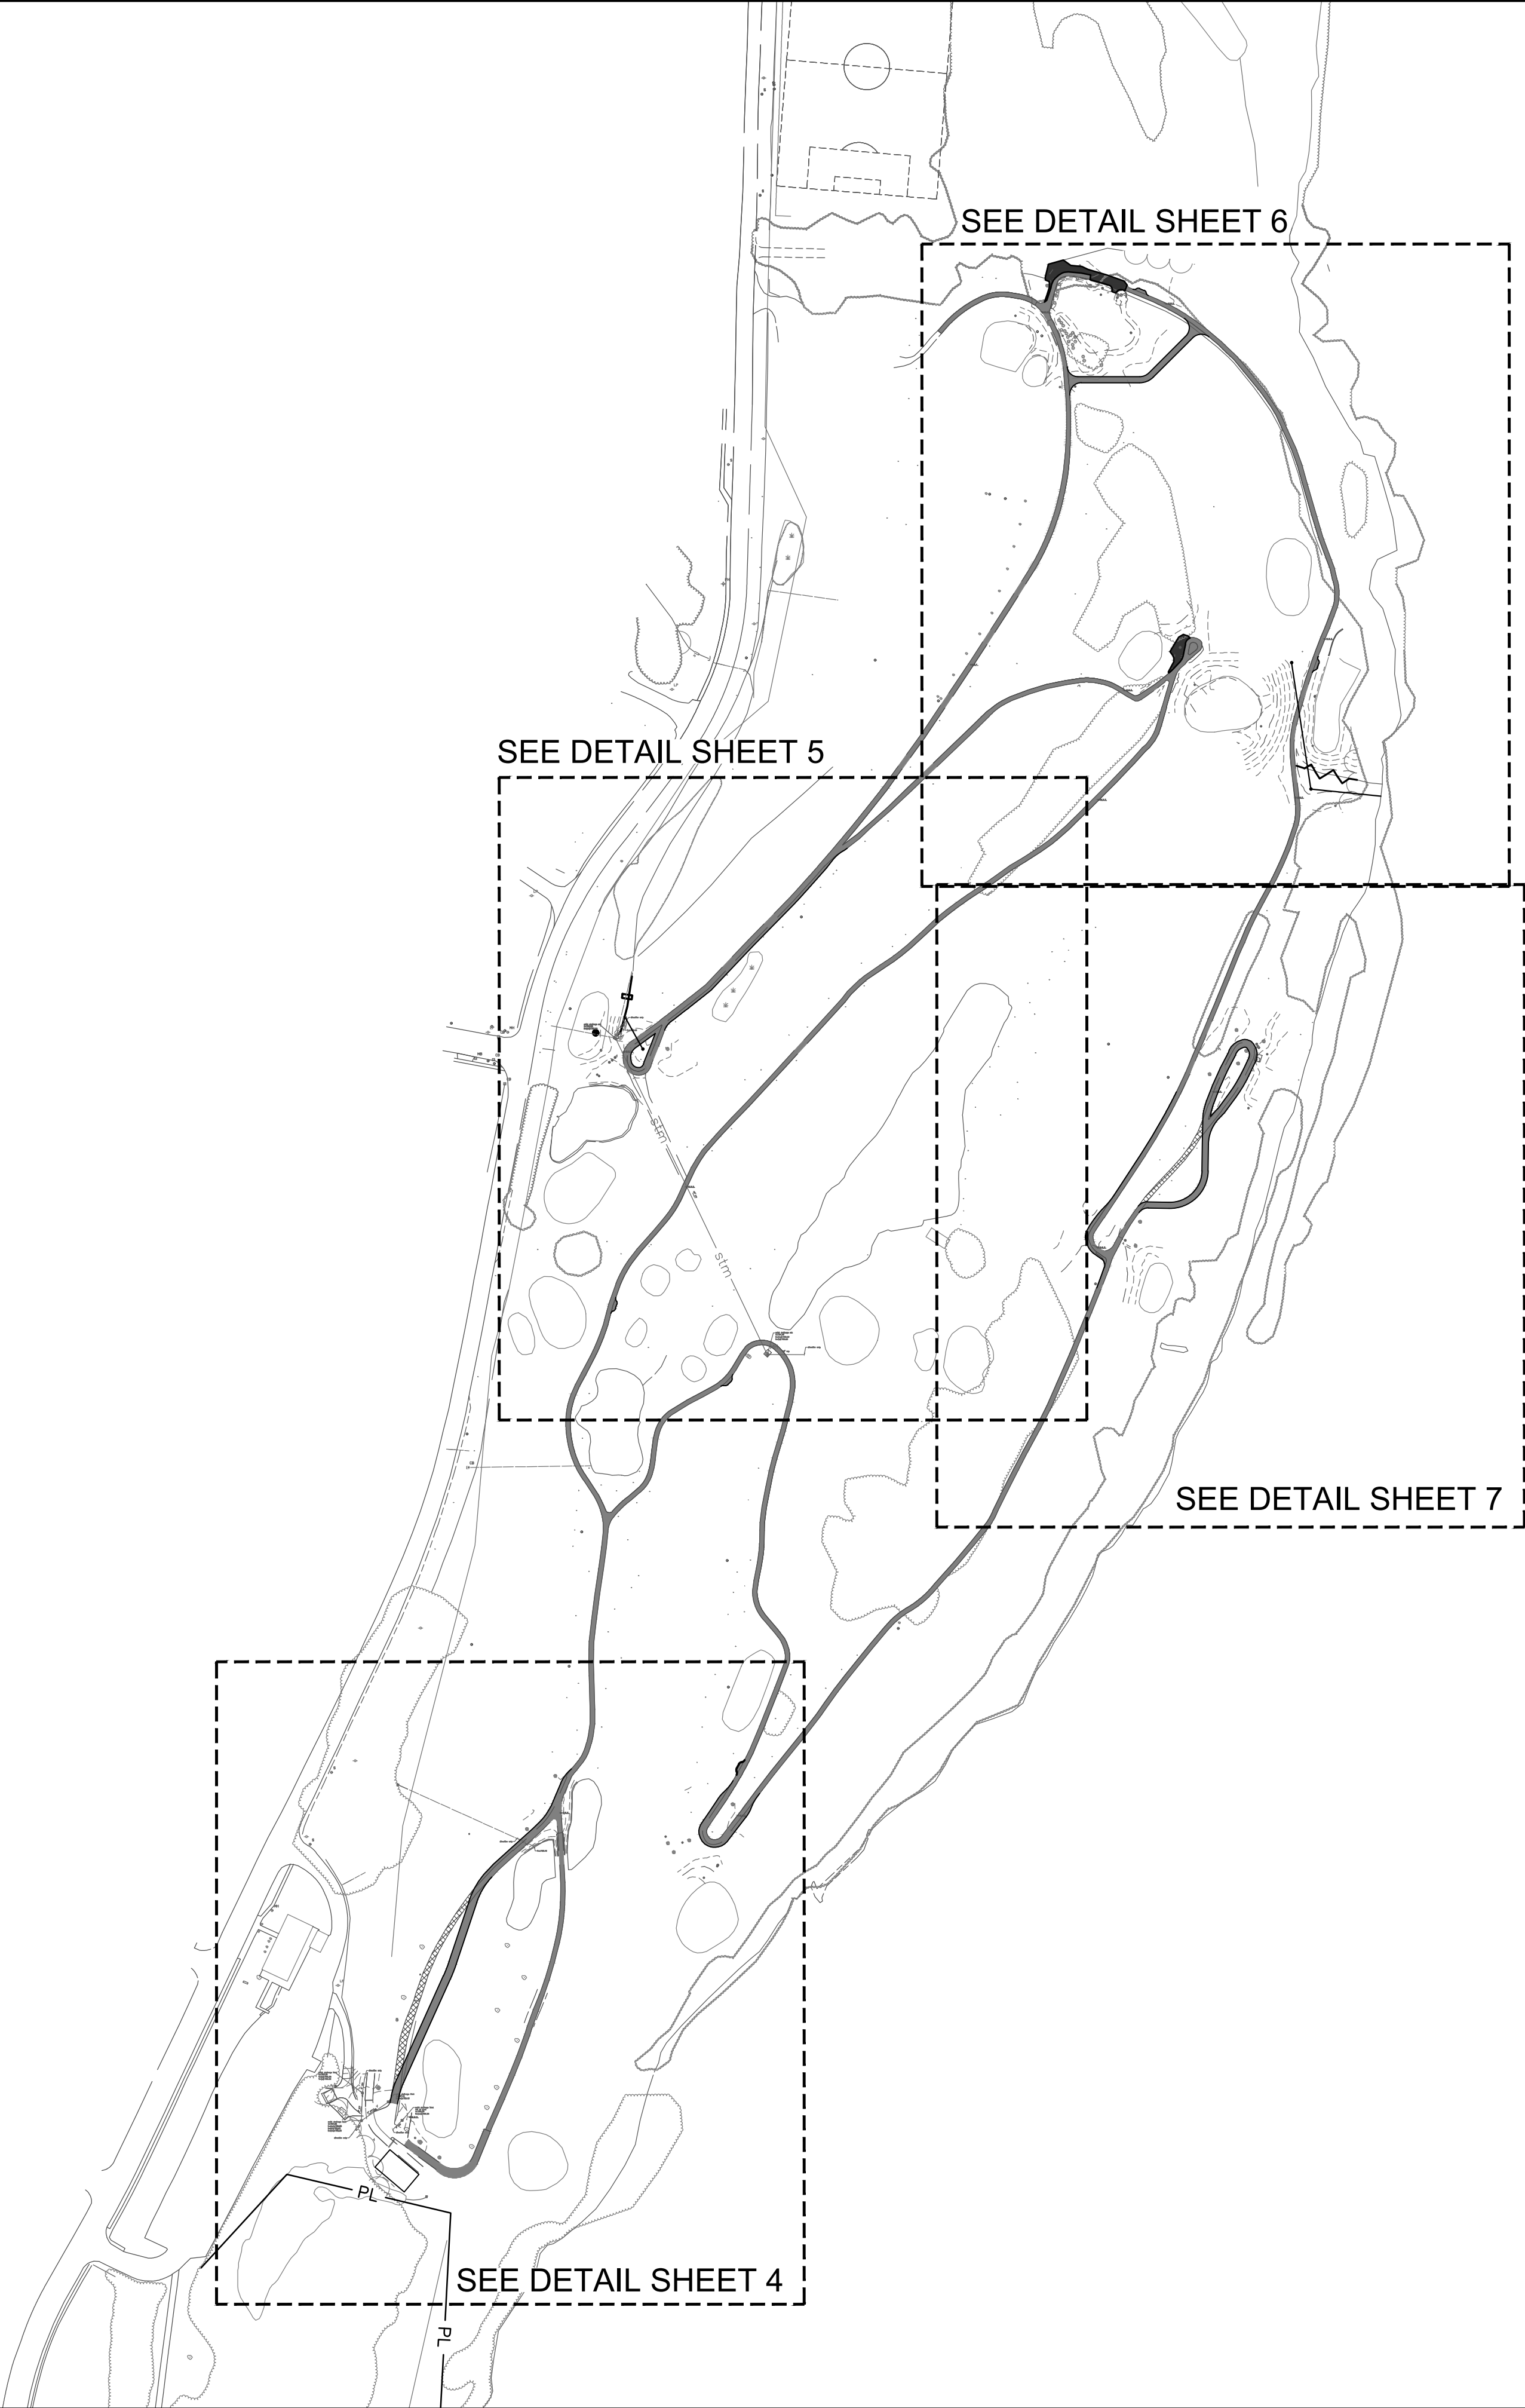

REVISIONS	DATE	SHEET NO.	DESCRIPTION

APPROVAL PENDING NOT FOR CONSTRUCTION
IN SUBMITTING BIDS IN RELIANCE ON THESE PLANS THE CONTRACTOR ASSUMES ALL RISKS OF ADDITIONAL COSTS OF REVISIONS DUE TO REQUIREMENTS OF THE OWNER OR GOVERNMENTAL AUTHORITIES AND MATERIAL REVISIONS IN THE COURSE OF COMPLETING THE FINAL DESIGN.


DATE:	1/15/2024
DRAWN BY:	MNA
CHECKED BY:	BJM
JOB NUMBER:	2019.01727

CONSTRUCTION DOCUMENTS
FOR
GAHANNA MUNICIPAL GOLF COURSE
GAHANNA, FRANKLIN COUNTY, OHIO
OVERALL SITE PLAN

**AMERICAN
STRUCTUREPOINT
INC.**

2550 Corporate Exchange Dr., Ste 300 | Columbus, Ohio 43221
TEL: 614.422.1226 FAX: 614.422.1226
www.structurepoint.com


PLOT SCALE: 1"=100' DATE: 12/18/23 - 2:15 PM EDITED BY: MAHMOUD DRAWING FILE: 01201901727.D DRAWINGSS/CIVIL/CONSTRUCTION DOCUMENTS/CONSTRUCTION DOCUMENTS/2019.01727 OSP.DWG

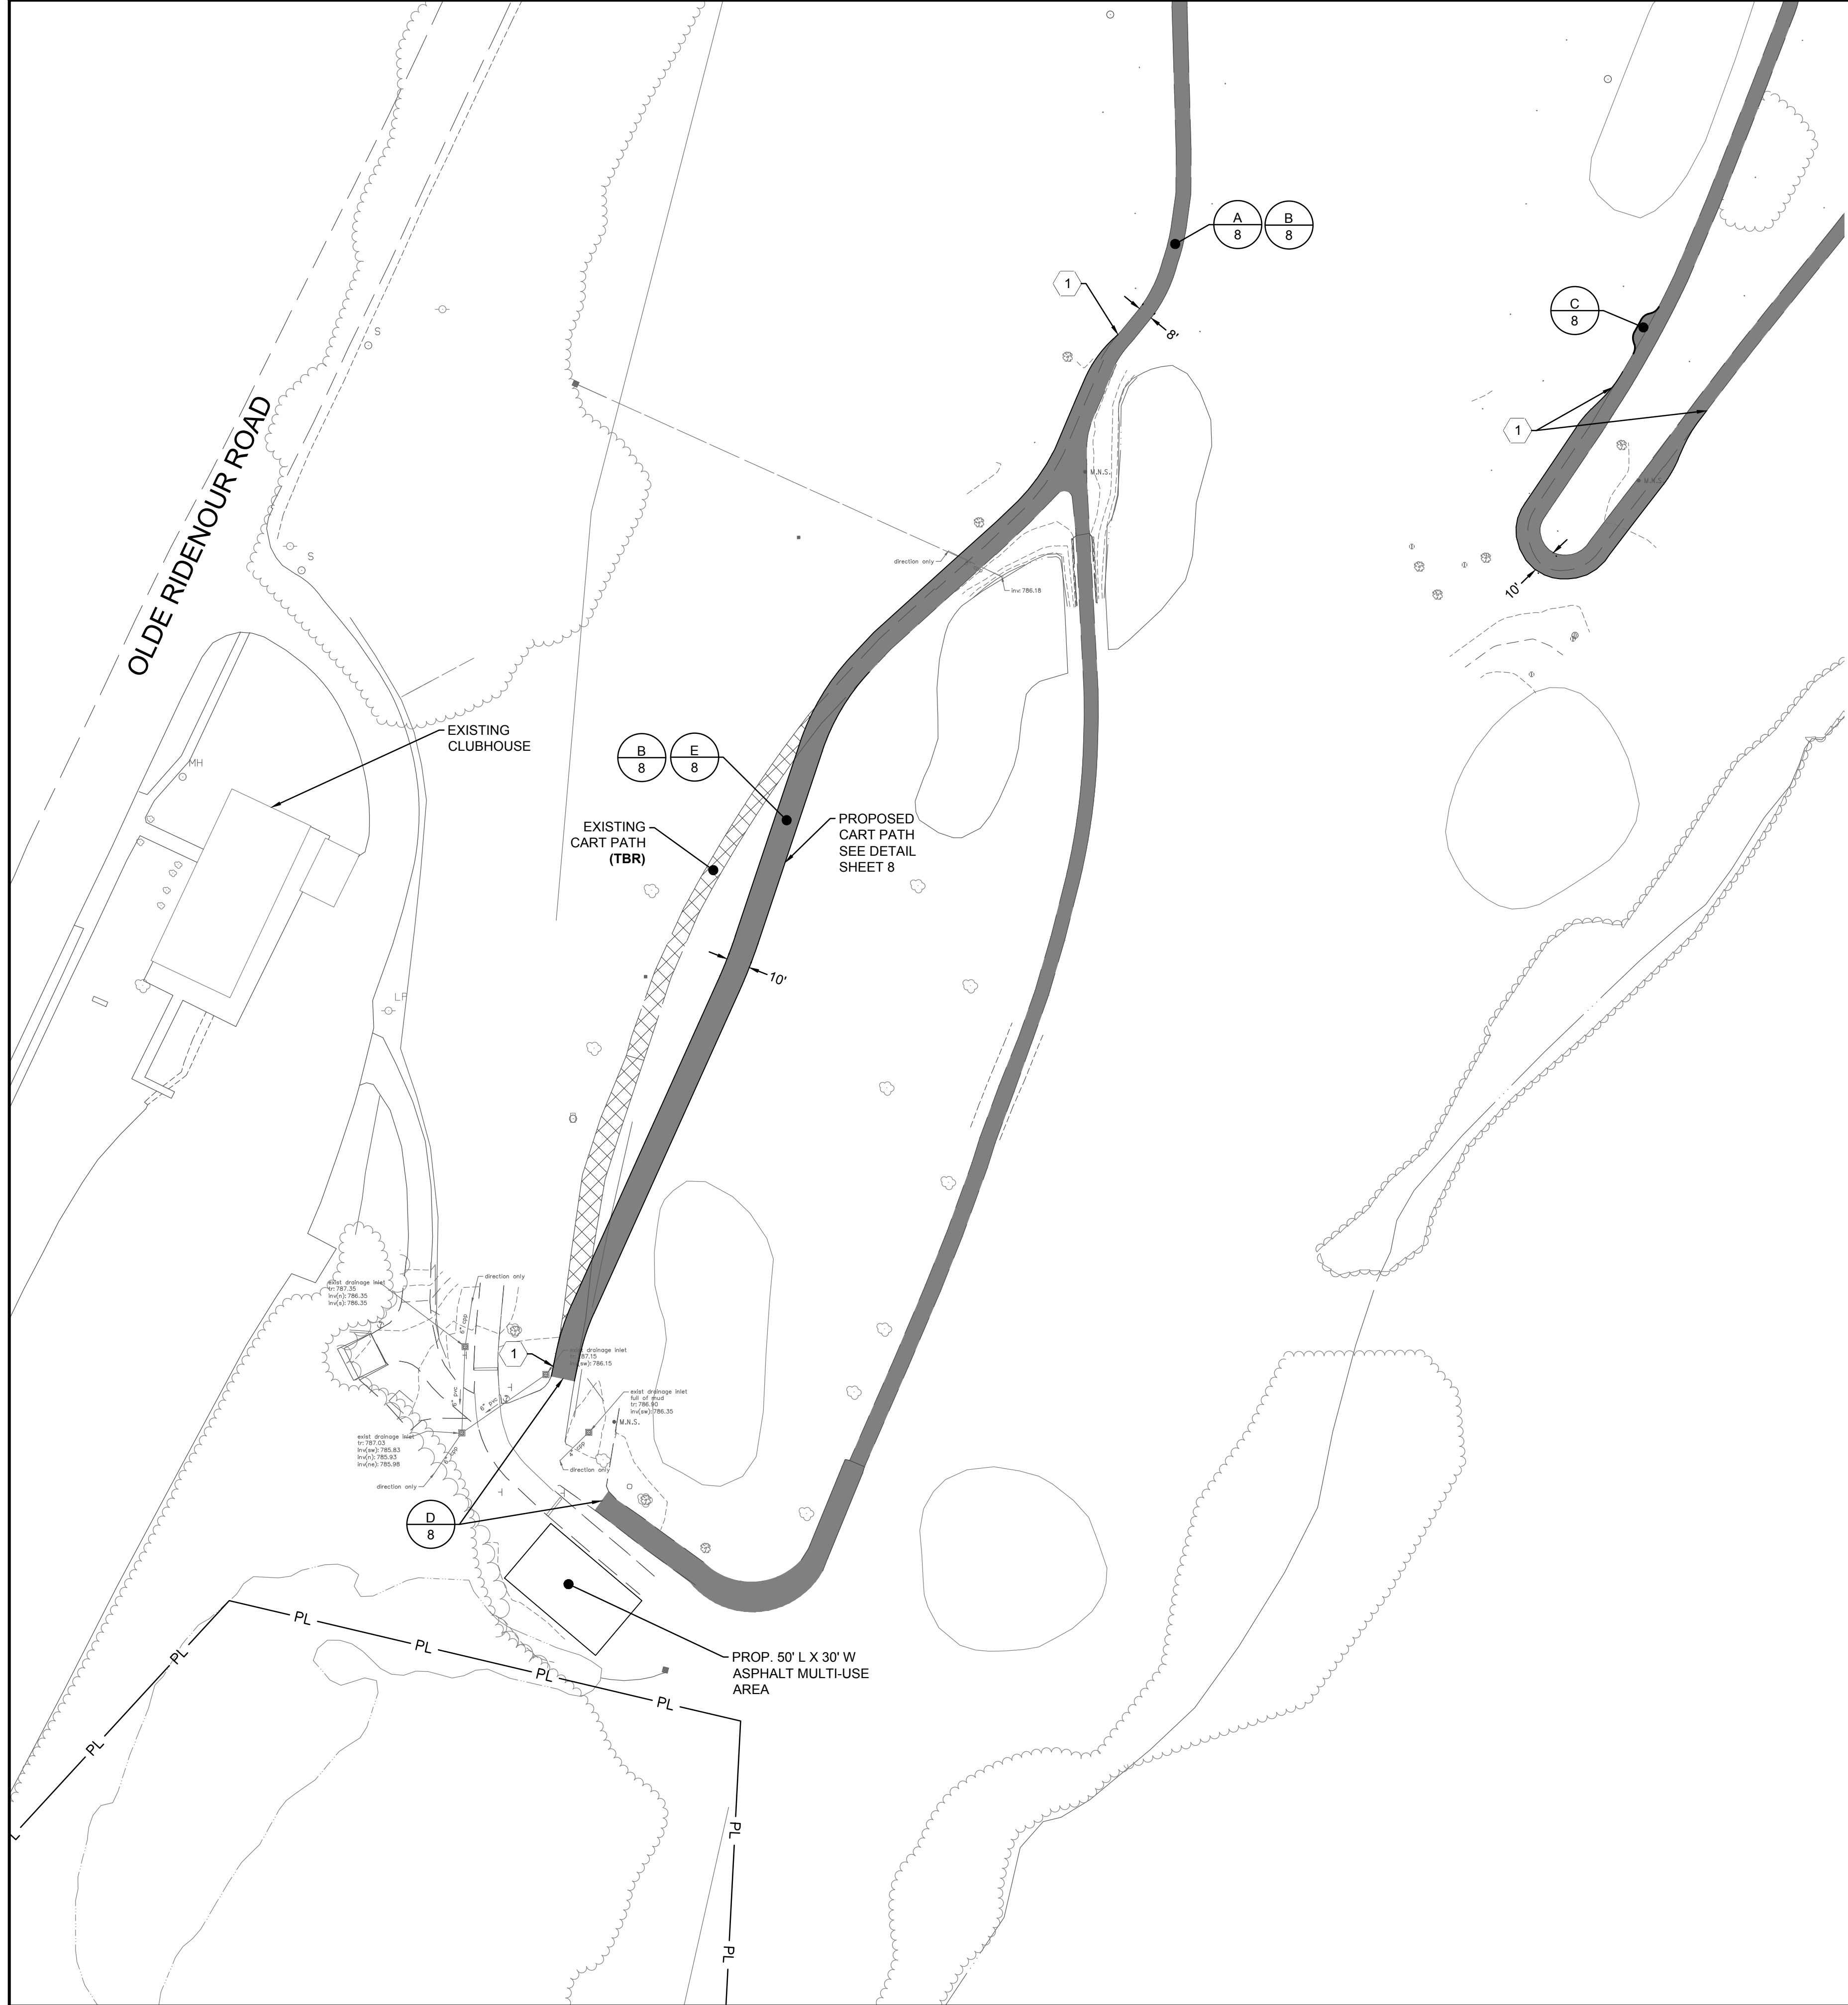

CODED NOTES	
1	PATH WIDENED TO 10'
2	GRAVEL SECTION TO BE REPLACED WITH ASPHALT

LEGEND	
TBR	TO BE REMOVED
TBRR	TO BE REMOVED & REPLACED
	ASPHALT PAVEMENT TO BE REMOVED
	CART PATH ASPHALT PAVEMENT
	ITEM TO BE REMOVED

NOTES:
THE ENTIRETY OF THE CART PATH WILL BE WIDENED TO 8-FEET UNLESS OTHERWISE SHOWN ON THESE PLANS.
NO TREES SHALL BE REMOVED WITH OUT GAHANNA GOLF COURSE APPROVAL.

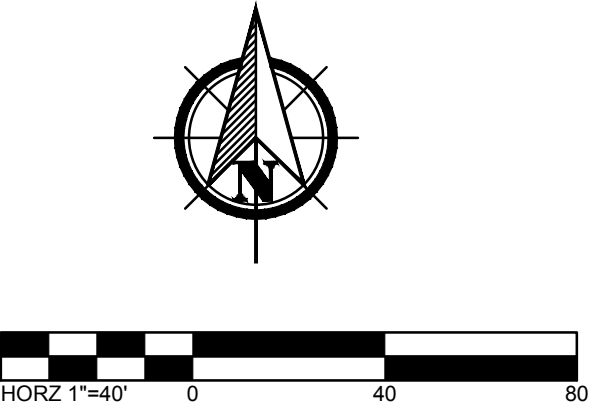

AMERICAN
STRUCTUREPOINT
INC.

2550 Corporate Exchange Dr., Ste 300 | Columbus, Ohio 43221
TEL: 614.425.1225 FAX: 614.425.1226
www.structurepoint.com


CONSTRUCTION DOCUMENTS
FOR
**GAHANNA MUNICIPAL GOLF
COURSE**
GAHANNA, FRANKLIN COUNTY, OHIO
SITE PLAN

REVISIONS	DATE	SHEET NO.	DESCRIPTION

APPROVAL PENDING NOT FOR CONSTRUCTION
IN SUBMITTING BIDS IN RELIANCE ON THESE PLANS THE CONTRACTOR ASSUMES ALL RISKS OF ADDITIONAL COSTS OF REVISIONS DUE TO REQUIREMENTS OF THE OWNER OR GOVERNMENTAL AUTHORITIES AND MATERIAL REVISIONS IN THE COURSE OF COMPLETING THE FINAL DESIGN.

DATE:	1/15/2024
DRAWN BY:	MNA
CHECKED BY:	BJM
JOB NUMBER:	2019.01727

PLOT SCALE: 1"=40' DATE: 12/18/23 - 2:15 PM EDITED BY: MAHMOUD DRAWING FILE: 01201901727.D DRAWINGSS/CIVIL/CONSTRUCTION DOCUMENTS/CONSTRUCTION DOCUMENTS/2019.01727 OSP.DWG

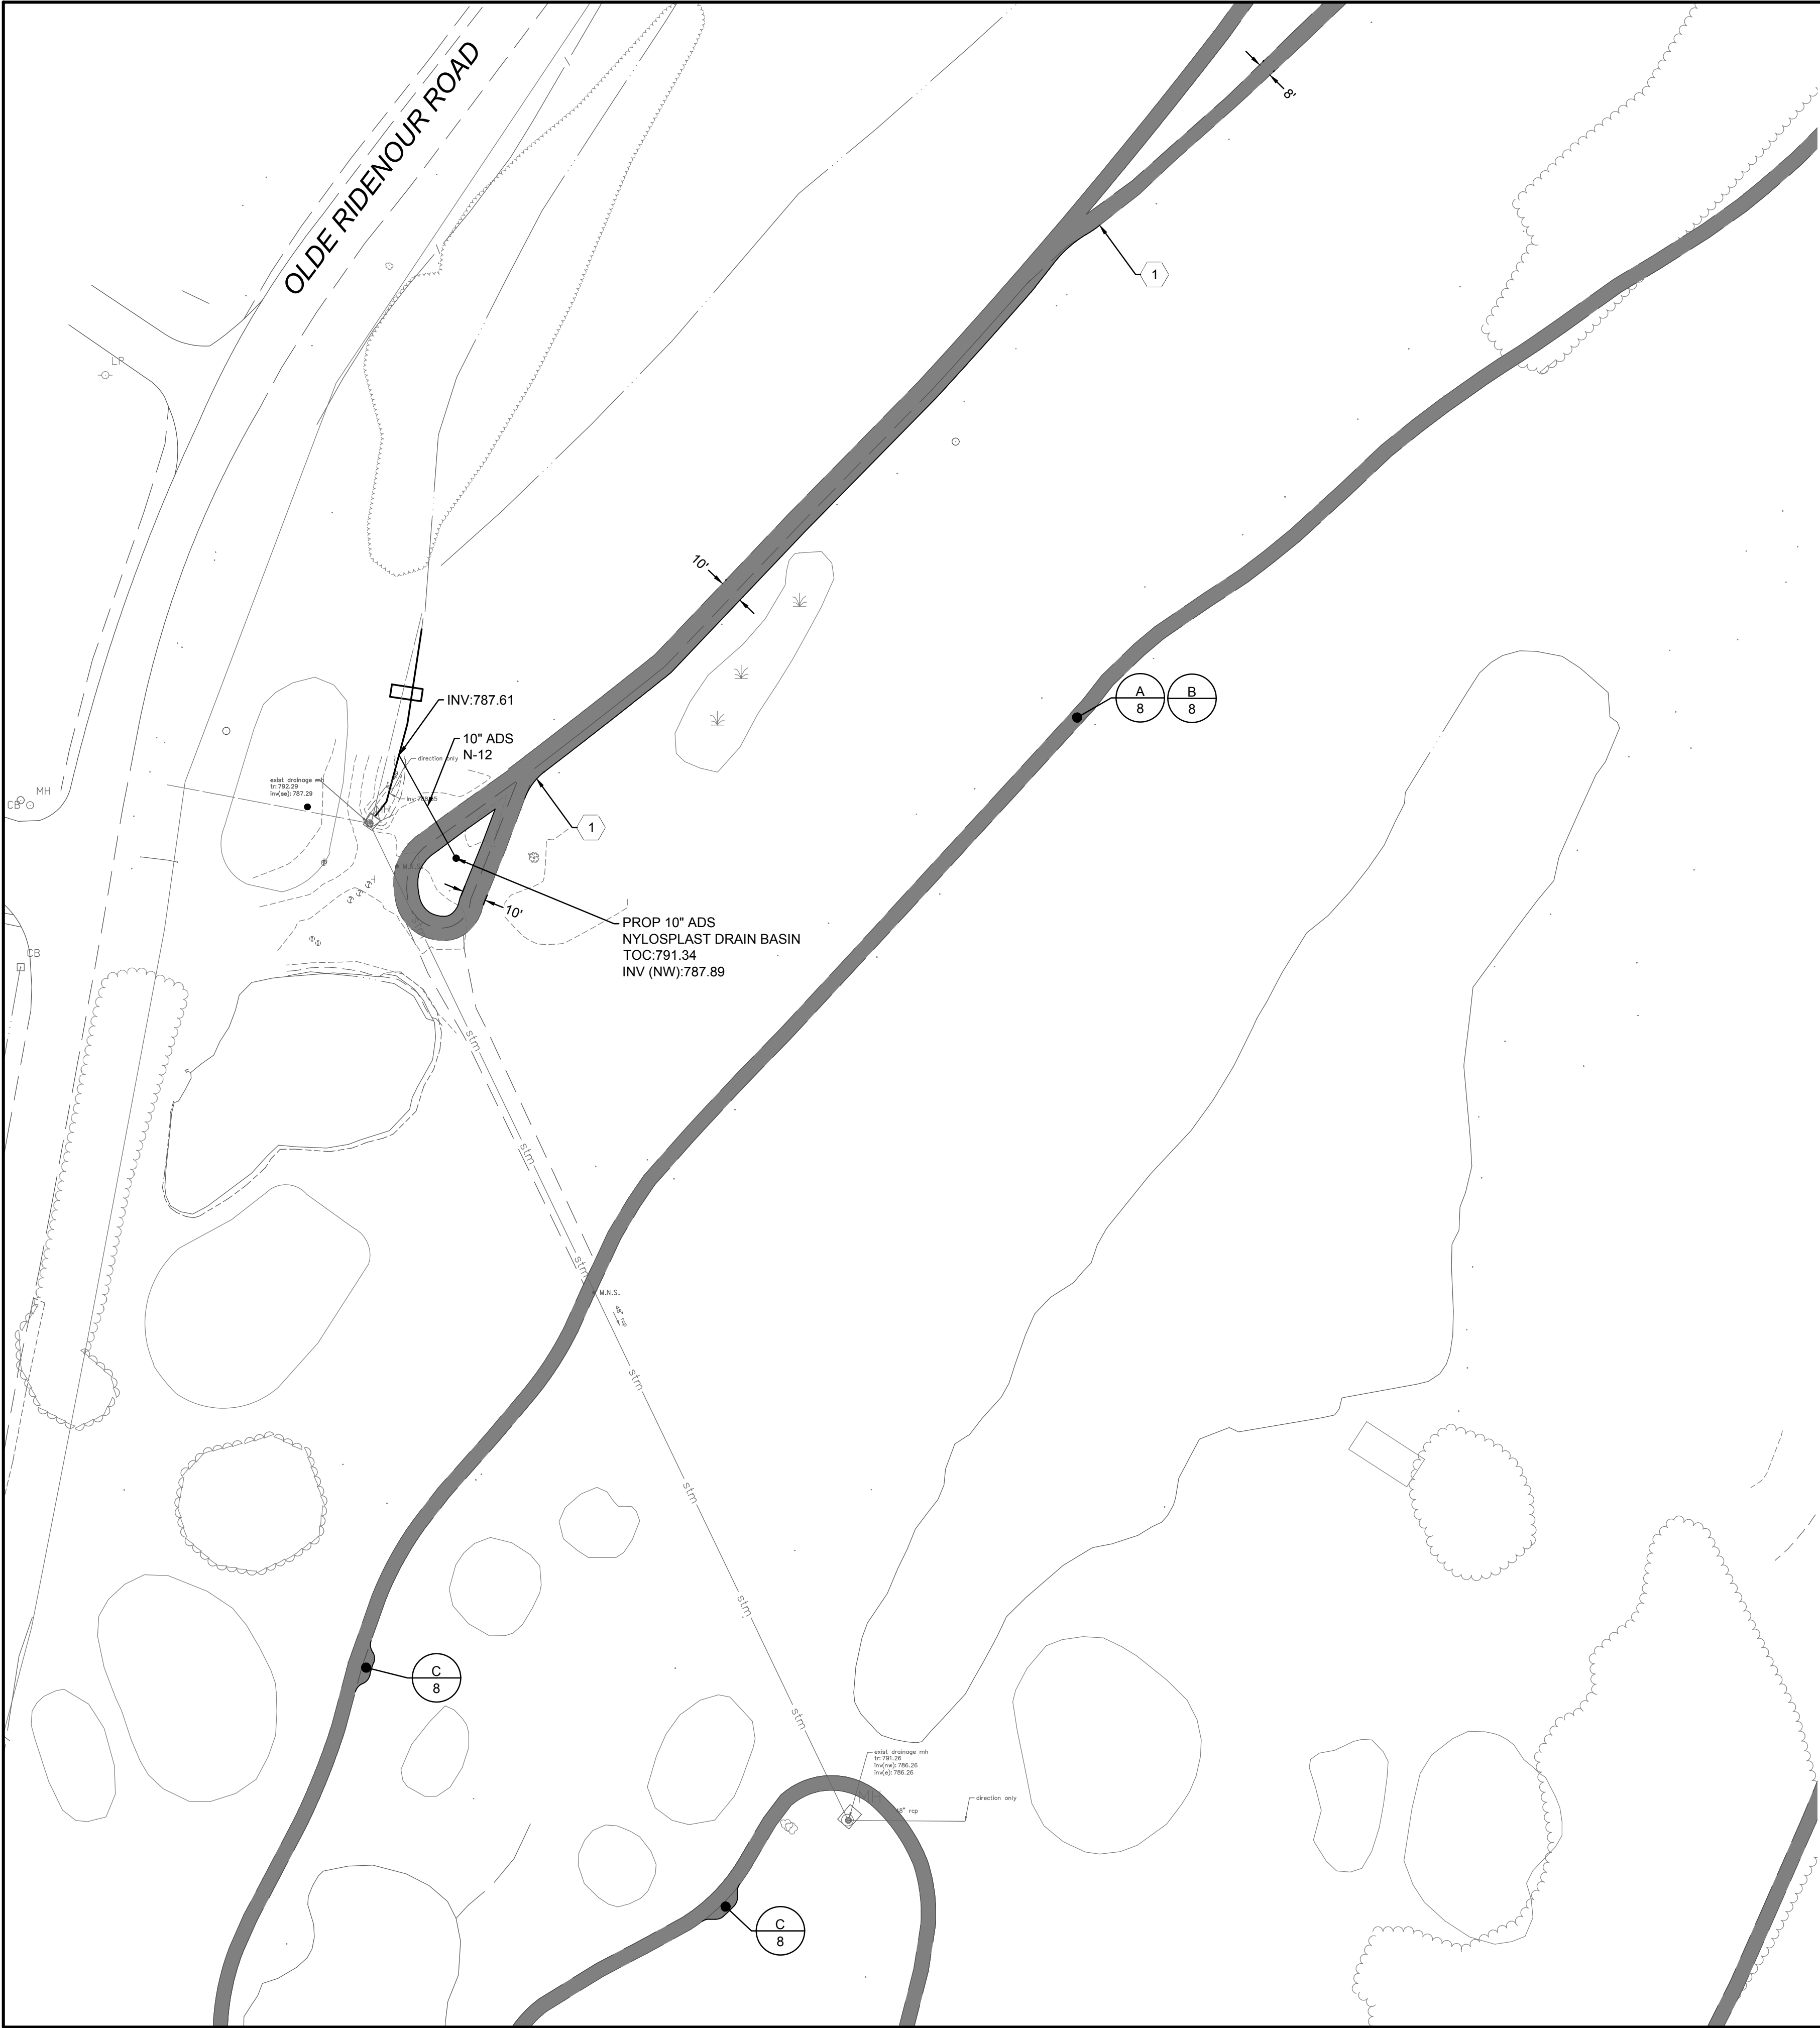


CODED NOTES	
1	PATH WIDENED TO 10'
2	GRAVEL SECTION TO BE REPLACED WITH ASPHALT

LEGEND	
TBR	TO BE REMOVED
TBRR	TO BE REMOVED & REPLACED
	ASPHALT PAVEMENT TO BE REMOVED
	CART PATH ASPHALT PAVEMENT
	ITEM TO BE REMOVED

NOTES:

THE ENTIRETY OF THE CART PATH WILL BE WIDENED TO 8-FEET UNLESS OTHERWISE SHOWN ON THESE PLANS.

NO TREES SHALL BE REMOVED WITH OUT GAHANNA GOLF COURSE APPROVAL.

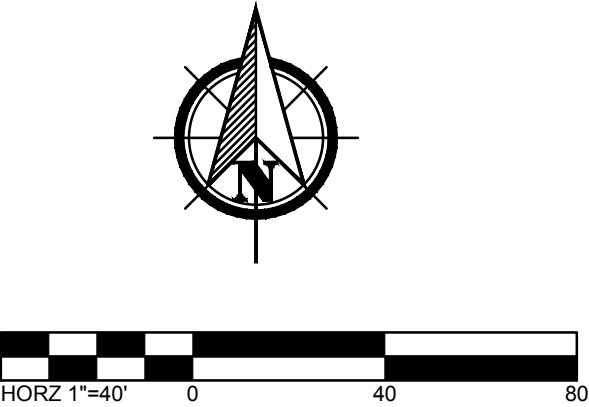

AMERICAN
STRUCTUREPOINT
INC.

2550 Corporate Exchange Dr., Ste 300 | Columbus, Ohio 43231
TEL: 614.425.1226 FAX: 614.425.1226
www.structurepoint.com

CONSTRUCTION DOCUMENTS
FOR
**GAHANNA MUNICIPAL GOLF
COURSE**
GAHANNA, FRANKLIN COUNTY, OHIO

SITE PLAN

REVISIONS	DATE	SHEET NO.	DESCRIPTION


APPROVAL PENDING NOT FOR CONSTRUCTION

IN SUBMITTING BIDS IN RELIANCE ON THESE PLANS THE CONTRACTOR ASSUMES ALL RISKS OF ADDITIONAL COSTS OF REVISIONS DUE TO REQUIREMENTS OF THE OWNER OR GOVERNMENTAL AUTHORITIES AND MATERIAL REVISIONS IN THE COURSE OF COMPLETING THE FINAL DESIGN.

DATE:	1/15/2024
DRAWN BY:	MNA
CHECKED BY:	BJM
JOB NUMBER:	2019.01727

5/8

PLOT SCALE: 1"=40' DATE: 12/18/23 2:45 PM EDITED BY: MAHMOUD DRAWING FILE: 01201901727.D DRAWINGSS/CIVIL/CONSTRUCTION DOCUMENTS/CONSTRUCTION DOCUMENTS/2019.01727 OSP.DWG

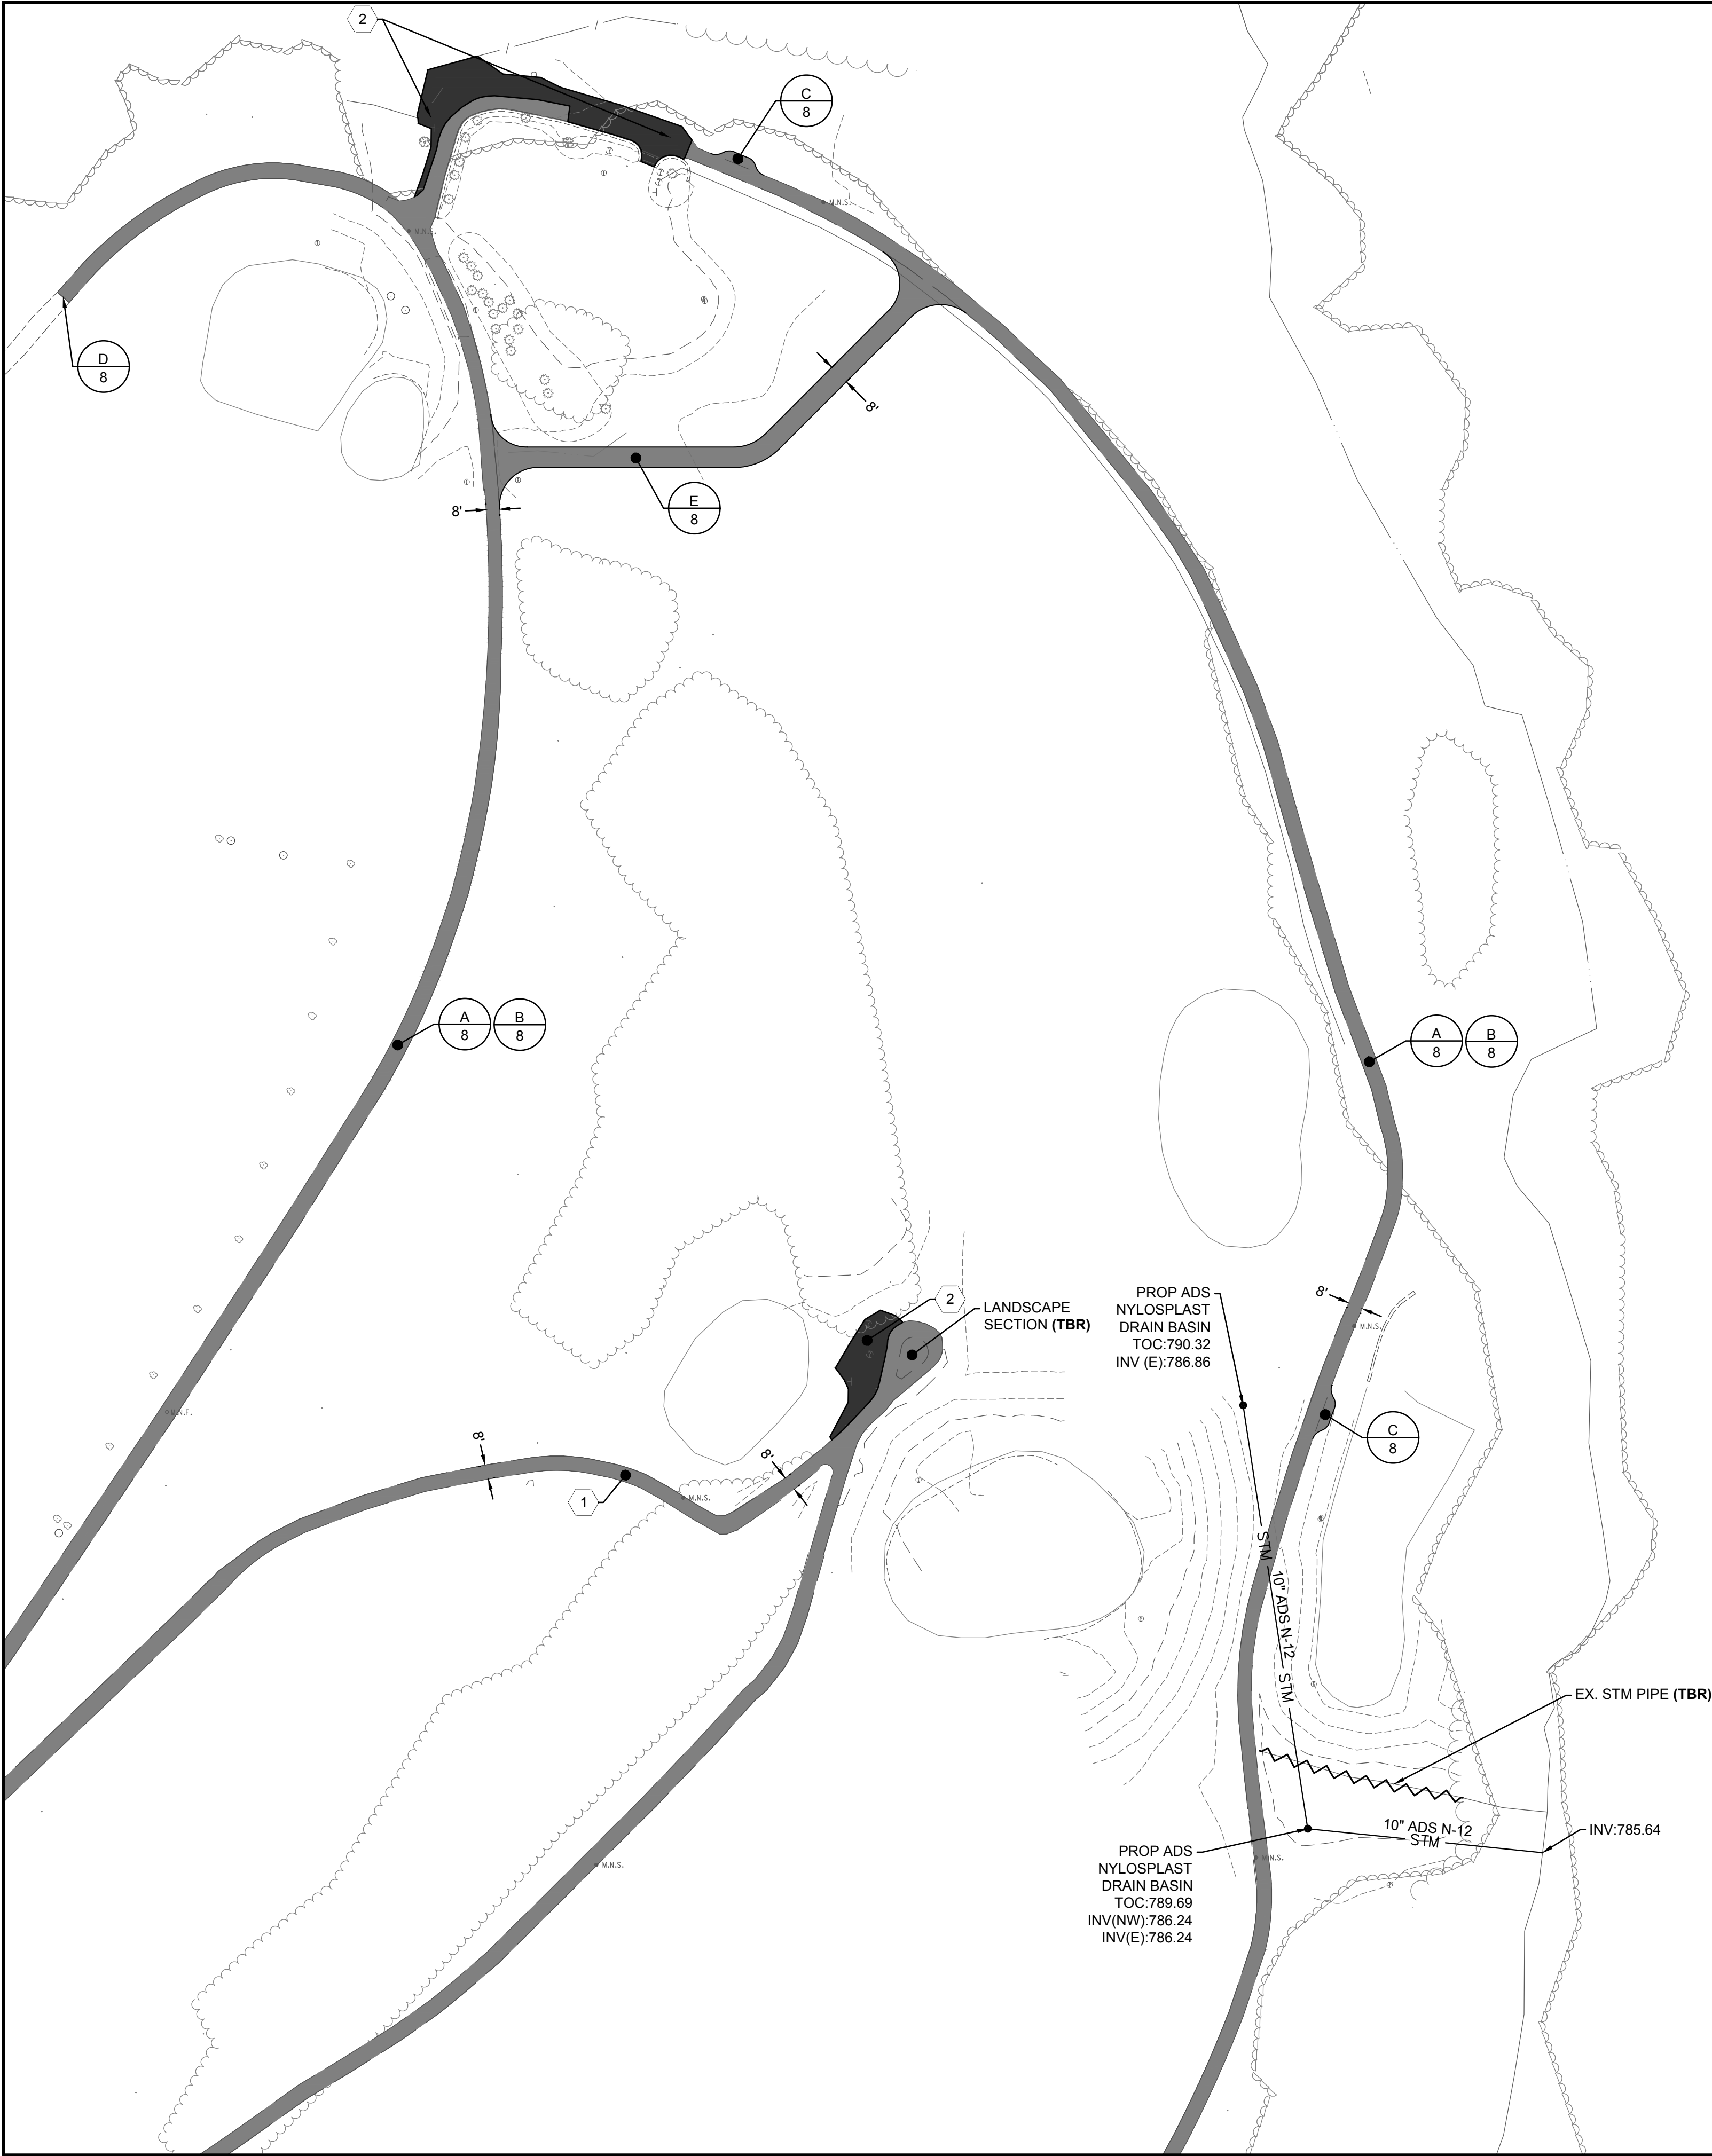


CODED NOTES	
1	PATH WIDENED TO 10'
2	GRAVEL SECTION TO BE REPLACED WITH ASPHALT

LEGEND	
TBR	TO BE REMOVED
TBRR	TO BE REMOVED & REPLACED
	ASPHALT PAVEMENT TO BE REMOVED
	CART PATH ASPHALT PAVEMENT
	ITEM TO BE REMOVED

NOTES:

THE ENTIRETY OF THE CART PATH WILL BE WIDENED TO 8-FEET UNLESS OTHERWISE SHOWN ON THESE PLANS.

NO TREES SHALL BE REMOVED WITH OUT GAHANNA GOLF COURSE APPROVAL.

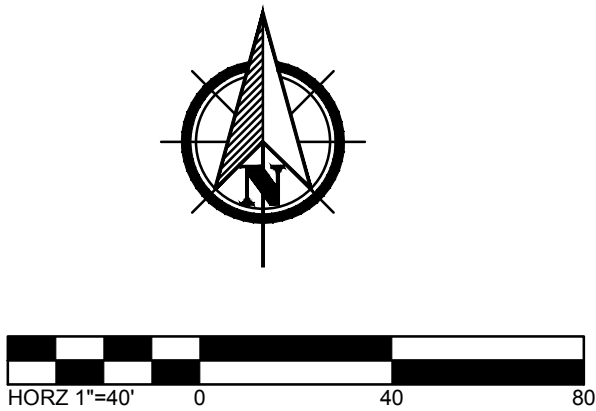

2550 Corporate Exchange Dr., Ste 300 | Columbus, Ohio 43221
TEL: 614.425.1226 FAX: 614.425.1226
www.structurepoint.com

CONSTRUCTION DOCUMENTS
FOR
GAHANNA MUNICIPAL GOLF COURSE
GAHANNA, FRANKLIN COUNTY, OHIO
SITE PLAN


REVISIONS	DATE	SHEET NO.	DESCRIPTION

APPROVAL PENDING NOT FOR CONSTRUCTION

IN SUBMITTING BIDS IN RELIANCE ON THESE PLANS THE CONTRACTOR ASSUMES ALL RISKS OF ADDITIONAL COSTS OF REVISIONS DUE TO REQUIREMENTS OF THE OWNER OR GOVERNMENTAL AUTHORITIES AND MATERIAL REVISIONS IN THE COURSE OF COMPLETING THE FINAL DESIGN.

DATE:	1/15/2024
DRAWN BY:	MNA
CHECKED BY:	BJM
JOB NUMBER:	2019.01727

PLOT SCALE: 1"=100' DATE: 12/18/23 - 2:15 PM EDITED BY: MAHMOUD DRAWING FILE: 01201901727.D DRAWINGSS/CIVIL/CONSTRUCTION DOCUMENTS/CONSTRUCTION DOCUMENTS/2019.01727.OSP.DWG

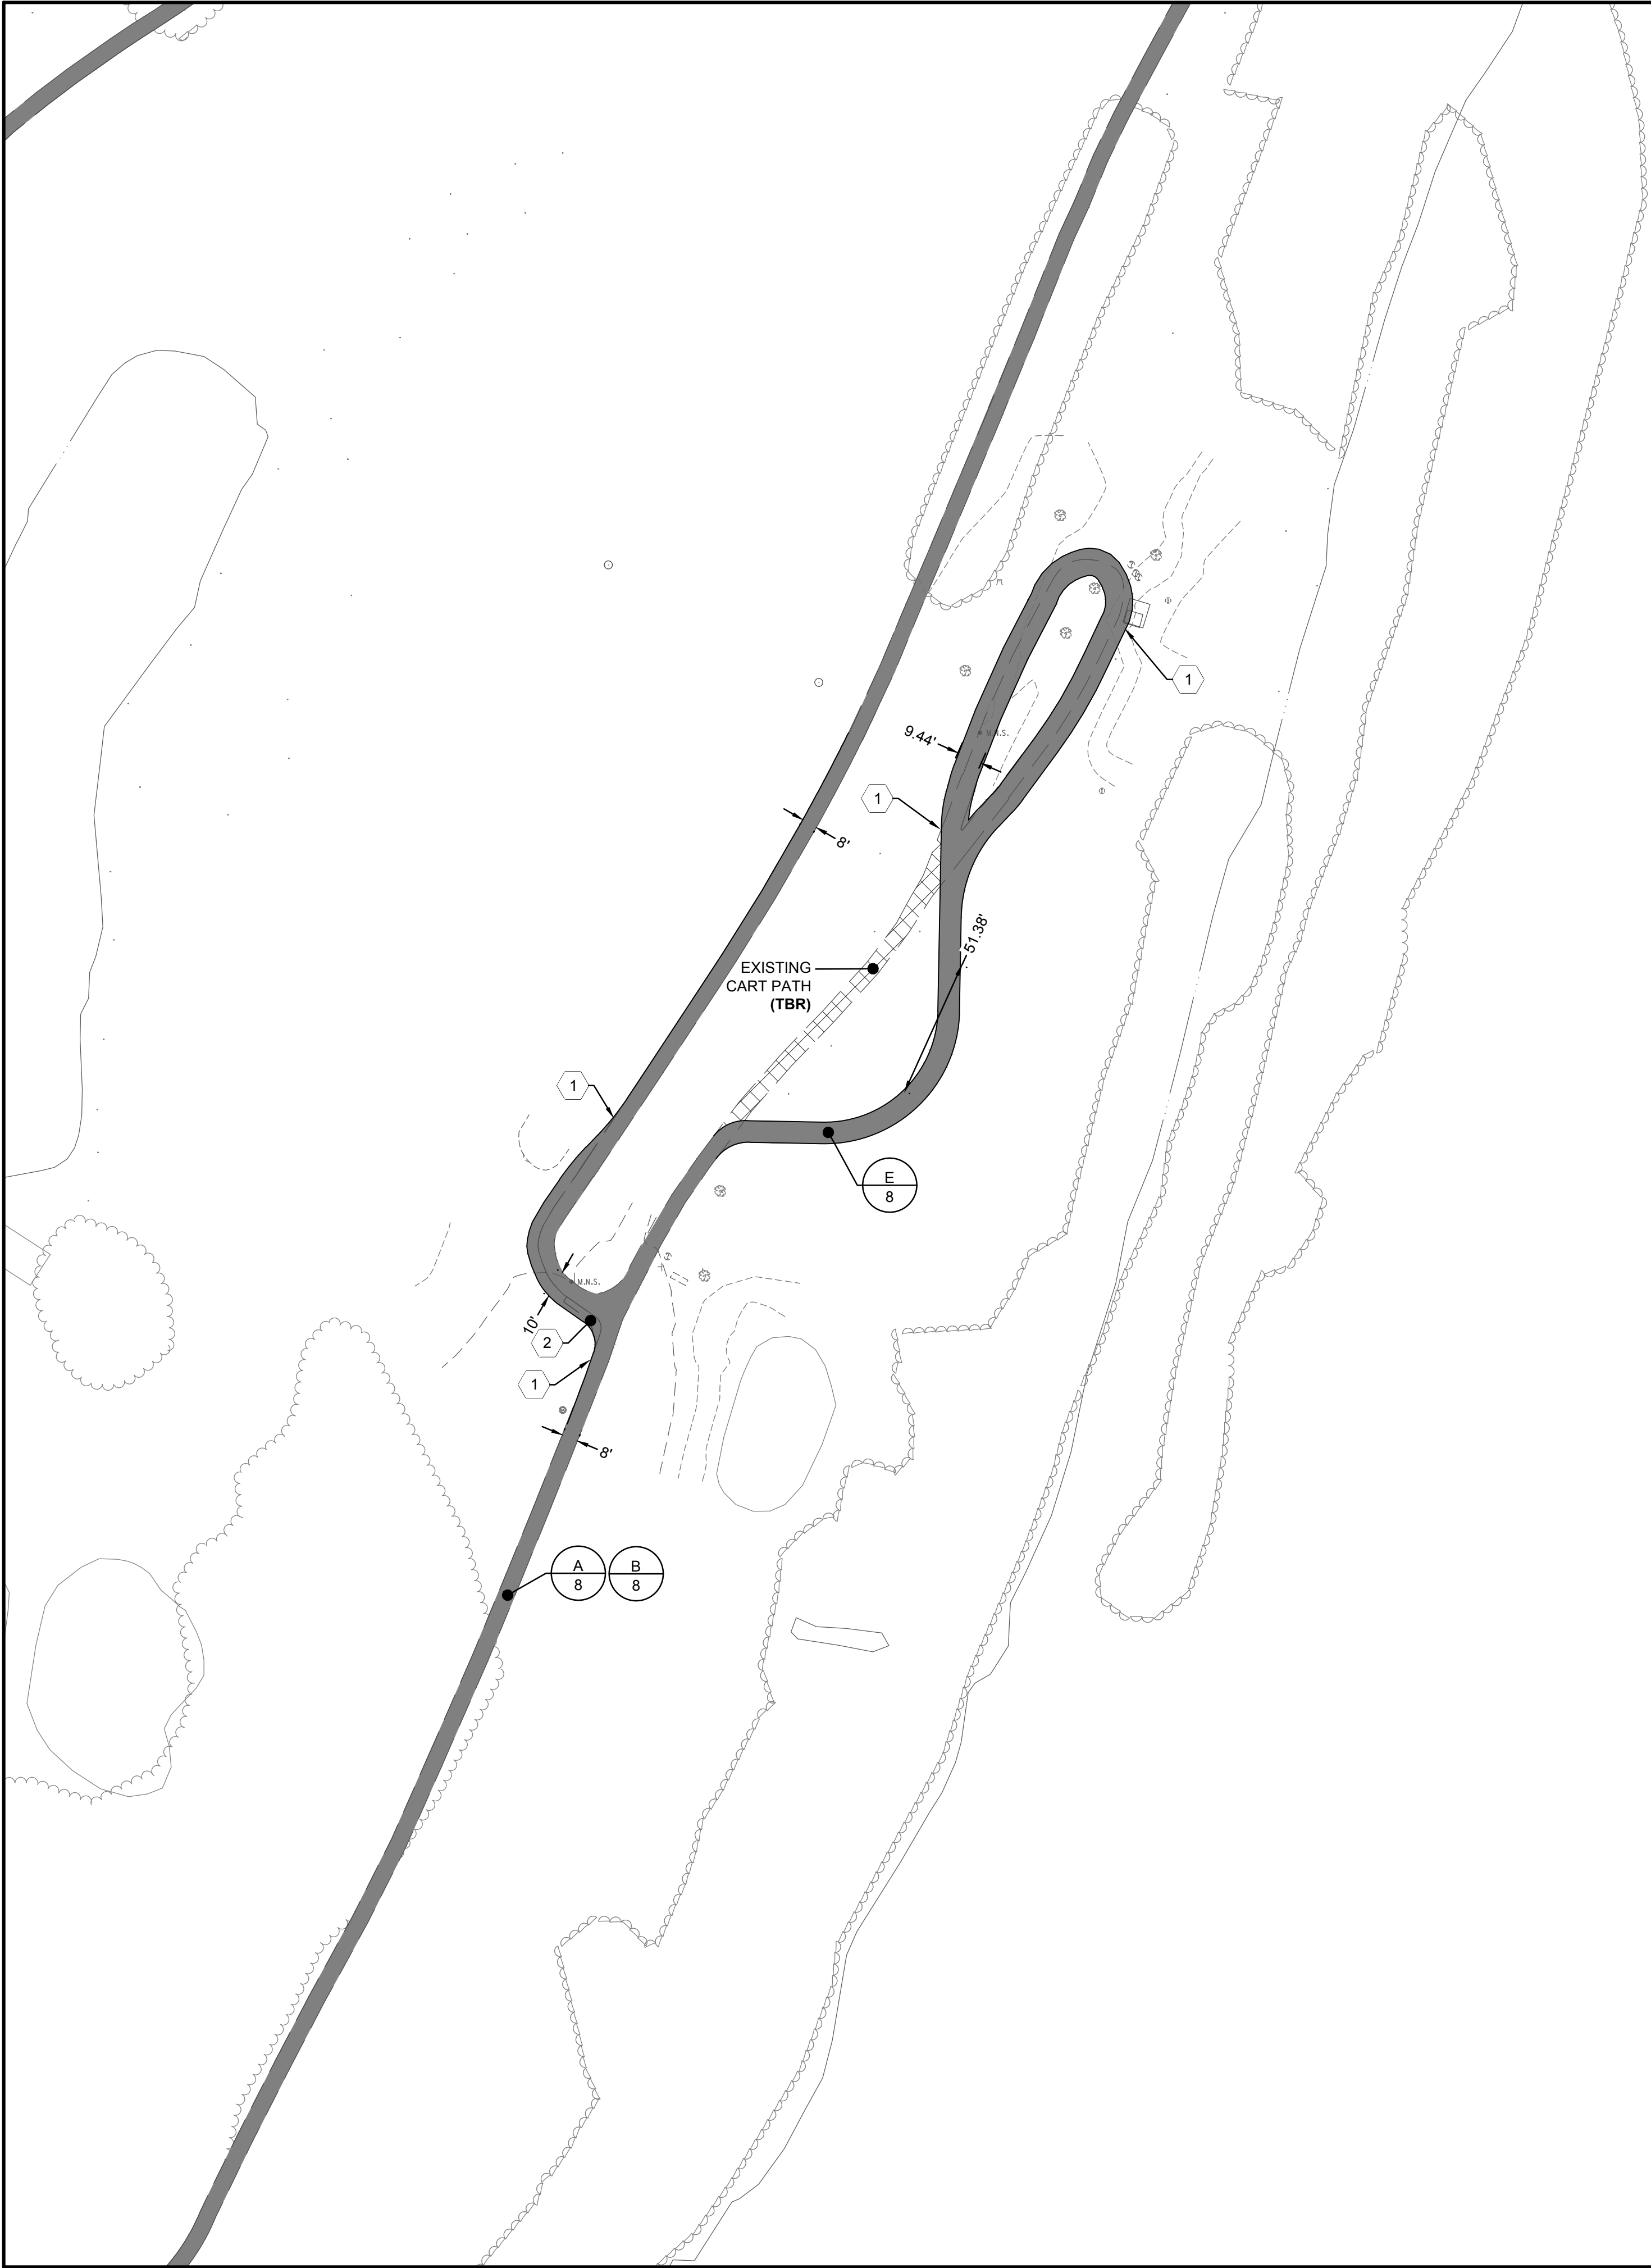


CODED NOTES	
1	PATH WIDENED TO 10'
2	GRAVEL SECTION TO BE REPLACED WITH ASPHALT

LEGEND

TBR	TO BE REMOVED
TBRR	TO BE REMOVED & REPLACED
	ASPHALT PAVEMENT TO BE REMOVED
	CART PATH ASPHALT PAVEMENT
	ITEM TO BE REMOVED

NOTES:

THE ENTIRETY OF THE CART PATH WILL BE WIDENED TO 8-FEET UNLESS OTHERWISE SHOWN ON THESE PLANS.
NO TREES SHALL BE REMOVED WITH OUT GAHANNA GOLF COURSE APPROVAL.

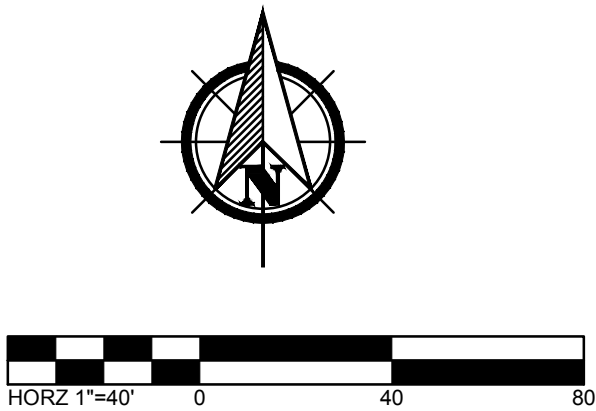


CONSTRUCTION DOCUMENTS
FOR
GAHANNA MUNICIPAL GOLF
COURSE
GAHANNA, FRANKLIN COUNTY, OHIO
SITE PLAN

REVISIONS	DATE	SHEET NO.	DESCRIPTION

APPROVAL PENDING NOT FOR CONSTRUCTION
IN SUBMITTING BIDS IN RELIANCE ON THESE PLANS THE CONTRACTOR ASSUMES ALL RISKS OF ADDITIONAL COSTS OF REVISIONS DUE TO REQUIREMENTS OF THE OWNER OR GOVERNMENTAL AUTHORITIES AND MATERIAL REVISIONS IN THE COURSE OF COMPLETING THE FINAL DESIGN.

DATE:	1/15/2024
DRAWN BY:	MNA
CHECKED BY:	BJM
JOB NUMBER:	2019.01727


PLOT SCALE: 1"=1' EDIT DATE: 12/18/23 - 2:45 PM EDITED BY: MAHMOUD DRAWING FILE: 01201901727.D DRAWINGSS/CIVIL/CONSTRUCTION DOCUMENTS/CONSTRUCTION DOCUMENTS/2019.01727.0SP.DWG

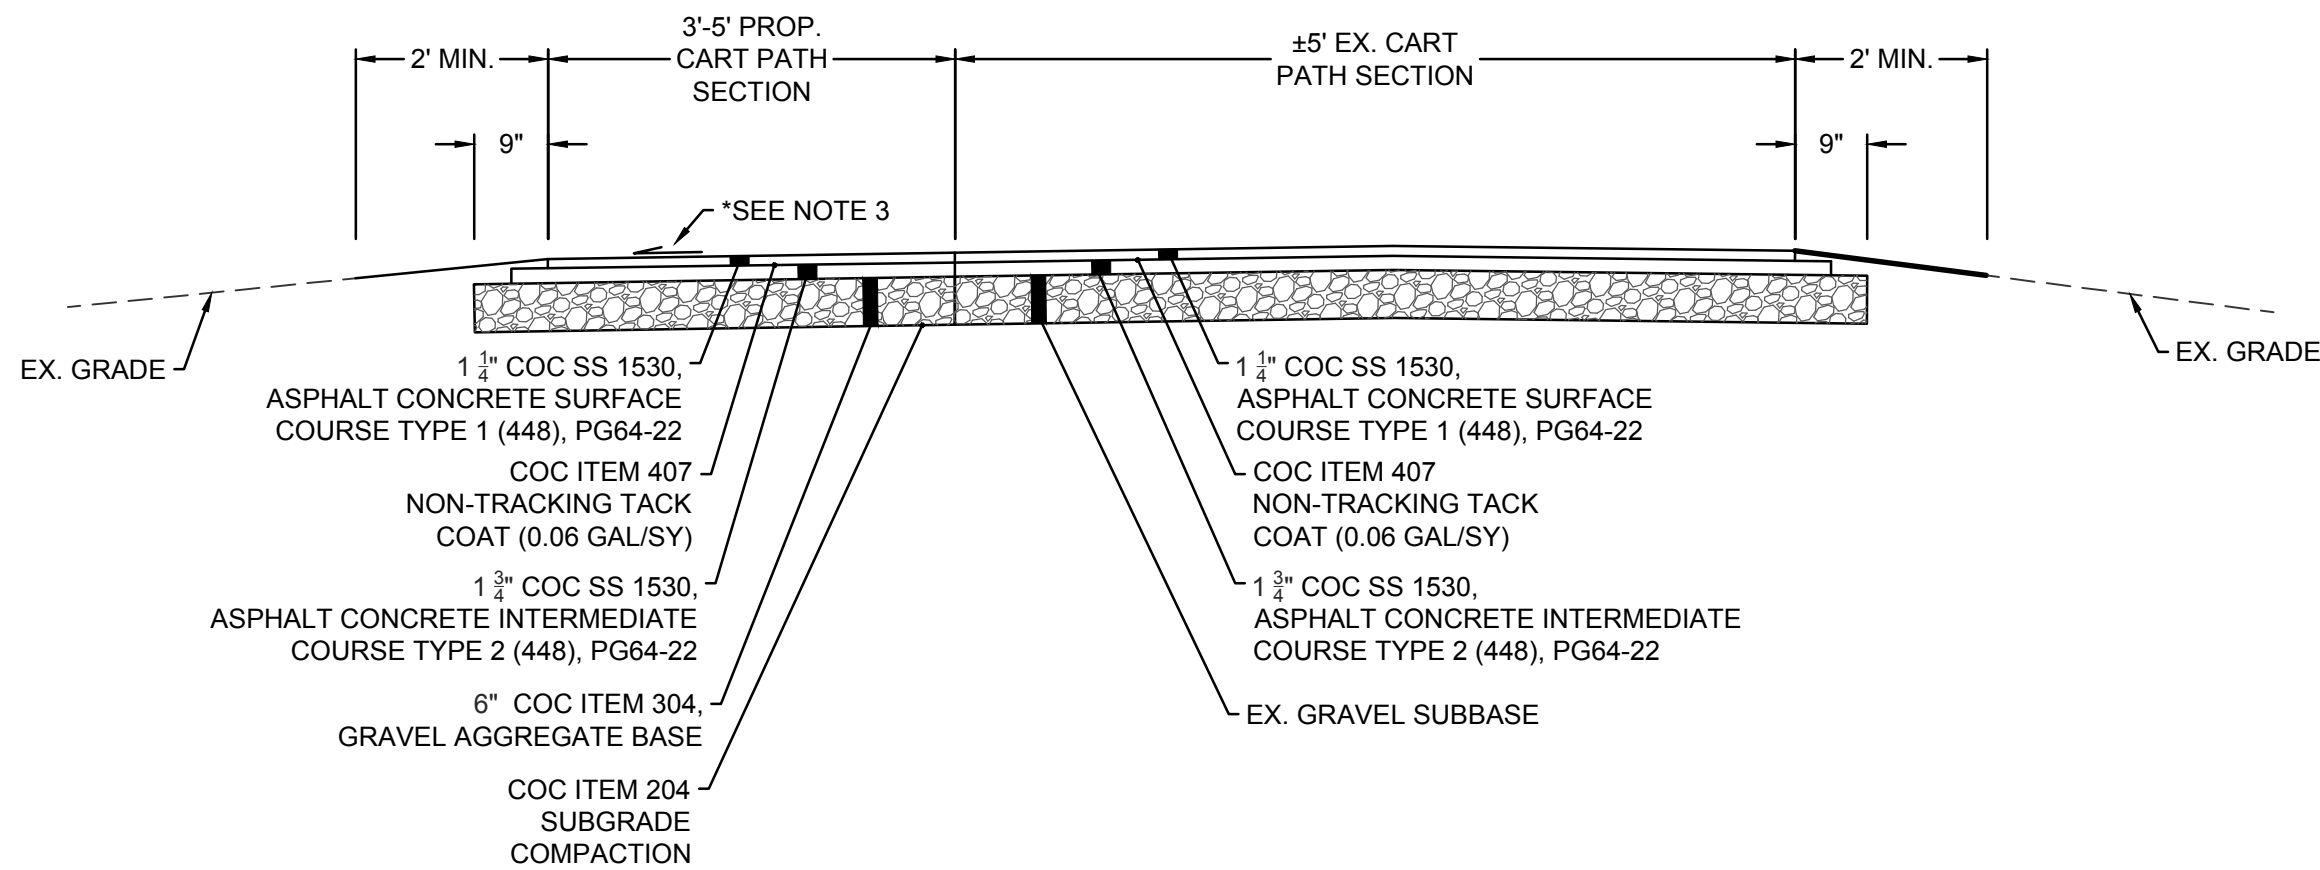

NOTES:

- THE EXISTING ASPHALT PAVEMENT SHALL BE REMOVED AND REPLACED PER THE PROPOSED ASPHALT SECTION.
- ONCE THE EXISTING ASPHALT IS REMOVED, THE CONTRACTOR SHALL VERIFY THE EXISTING GRAVEL SUBBASE THICKNESS. A MINIMUM THICKNESS OF 4" SHALL BE MAINTAINED.
- CONTRACTOR TO MATCH EXISTING SLOPE TO PROVIDE POSITIVE DRAINAGE ALONG CART PATH


A CART PATH WIDENING DETAIL
NOT TO SCALE

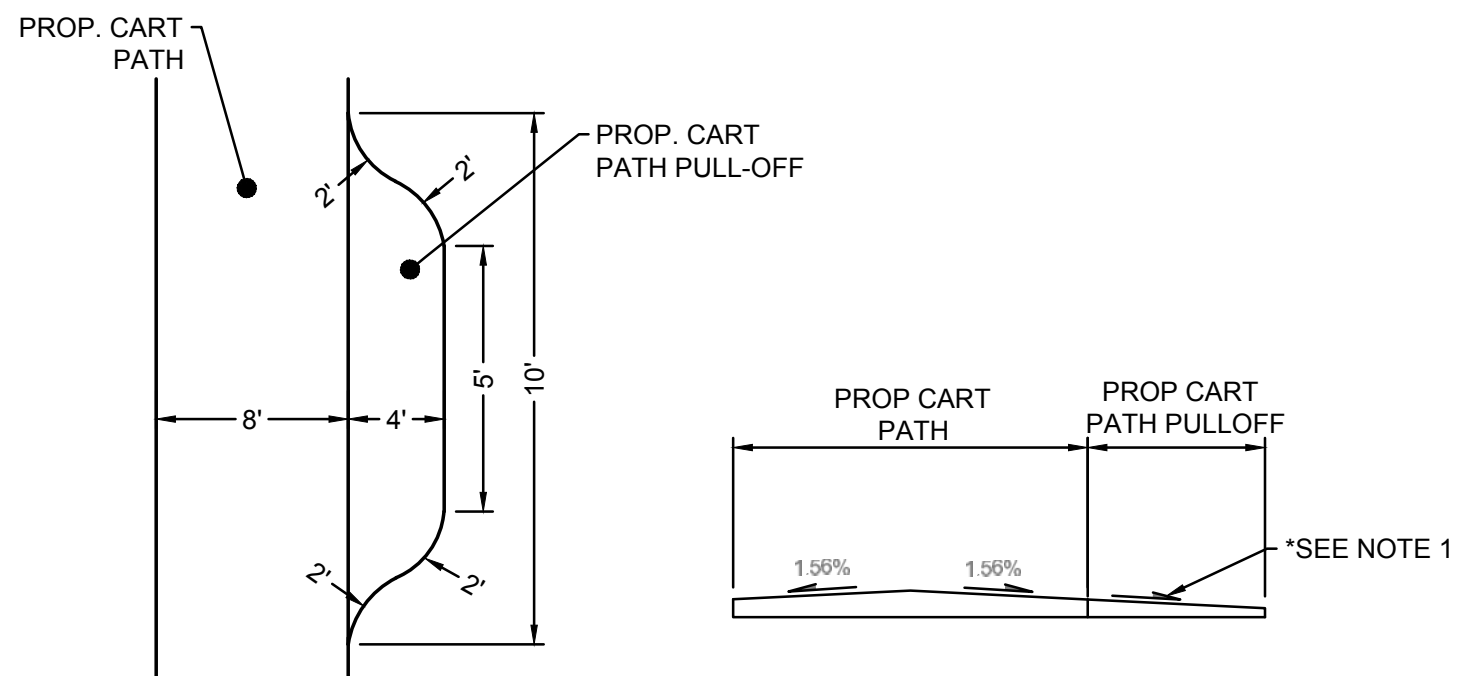

NOTES:

- CONTRACTOR TO MATCH SLOPE OF 1.56% FOR PROPOSED CART PULL OFF SECTIONS


C CART PATH PULL-OFF
NOT TO SCALE

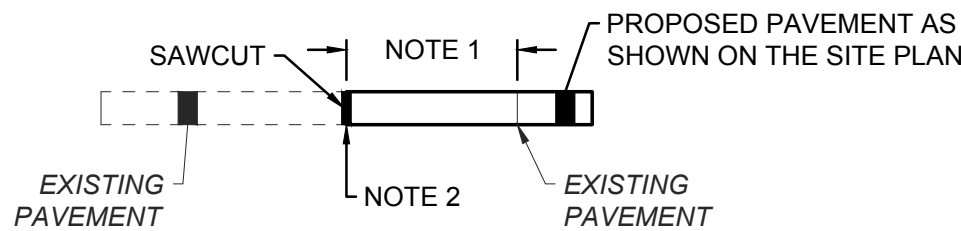

NOTES:

- PROPOSED ASPHALT PAVEMENT REPLACEMENT SHALL BE A MINIMUM OF 2'-0" IN WIDTH FROM THE EXISTING EDGE OF PAVEMENT.
- PROVIDE CRACK SEALING PER ODOT ITEM 423 BETWEEN EXISTING AND PROPOSED PAVEMENT.

D PAVEMENT MATCHING
NOT TO SCALE

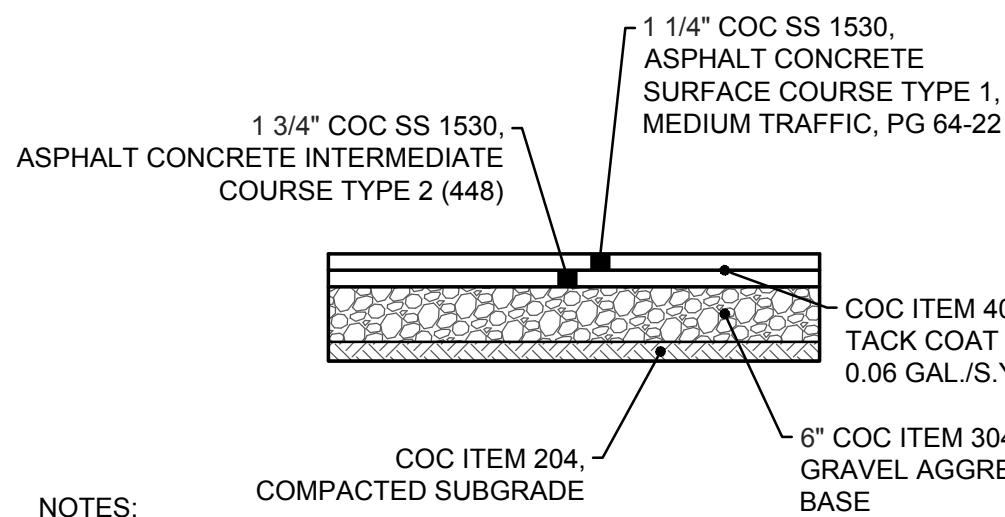


NOTE:

PAVEMENT DESIGN IS NOT BASED ON A GEOTECHNICAL ENGINEERS RECOMMENDATION. AMERICAN STRUCTUREPOINT IS NOT RESPONSIBLE FOR PAVEMENT DESIGN.

NOTES:

- COMPOSE HOT MIX ASPHALT MIXTURE WITH AGGREGATE AND ASPHALT BINDER MEETING COC 401 REQUIREMENTS.
- SUBMIT AN APPROVED JOB MIX FORMULA INCLUDING MIX TYPE PROPOSED FOR USE, AGGREGATE SOURCE, TYPE, AND GRADATION, PERCENT OF ASPHALT BINDER, AND UNIT WEIGHT OF THE MIXTURE.
- OBTAIN JOB MIX FORMULA APPROVAL BY PROVIDING A PREVIOUSLY COC APPROVED FORMULA OR CONTRACT AN INDEPENDENT TESTING AGENCY TO PROVIDE TESTING AND WRITTEN APPROVAL OF THE FORMULA. THE AGENCY PERFORMING THE TESTING MUST BE LEVEL III BITUMINOUS CONCRETE APPROVED BY COC.

B ASPHALT PAVEMENT DETAIL
NOT TO SCALE

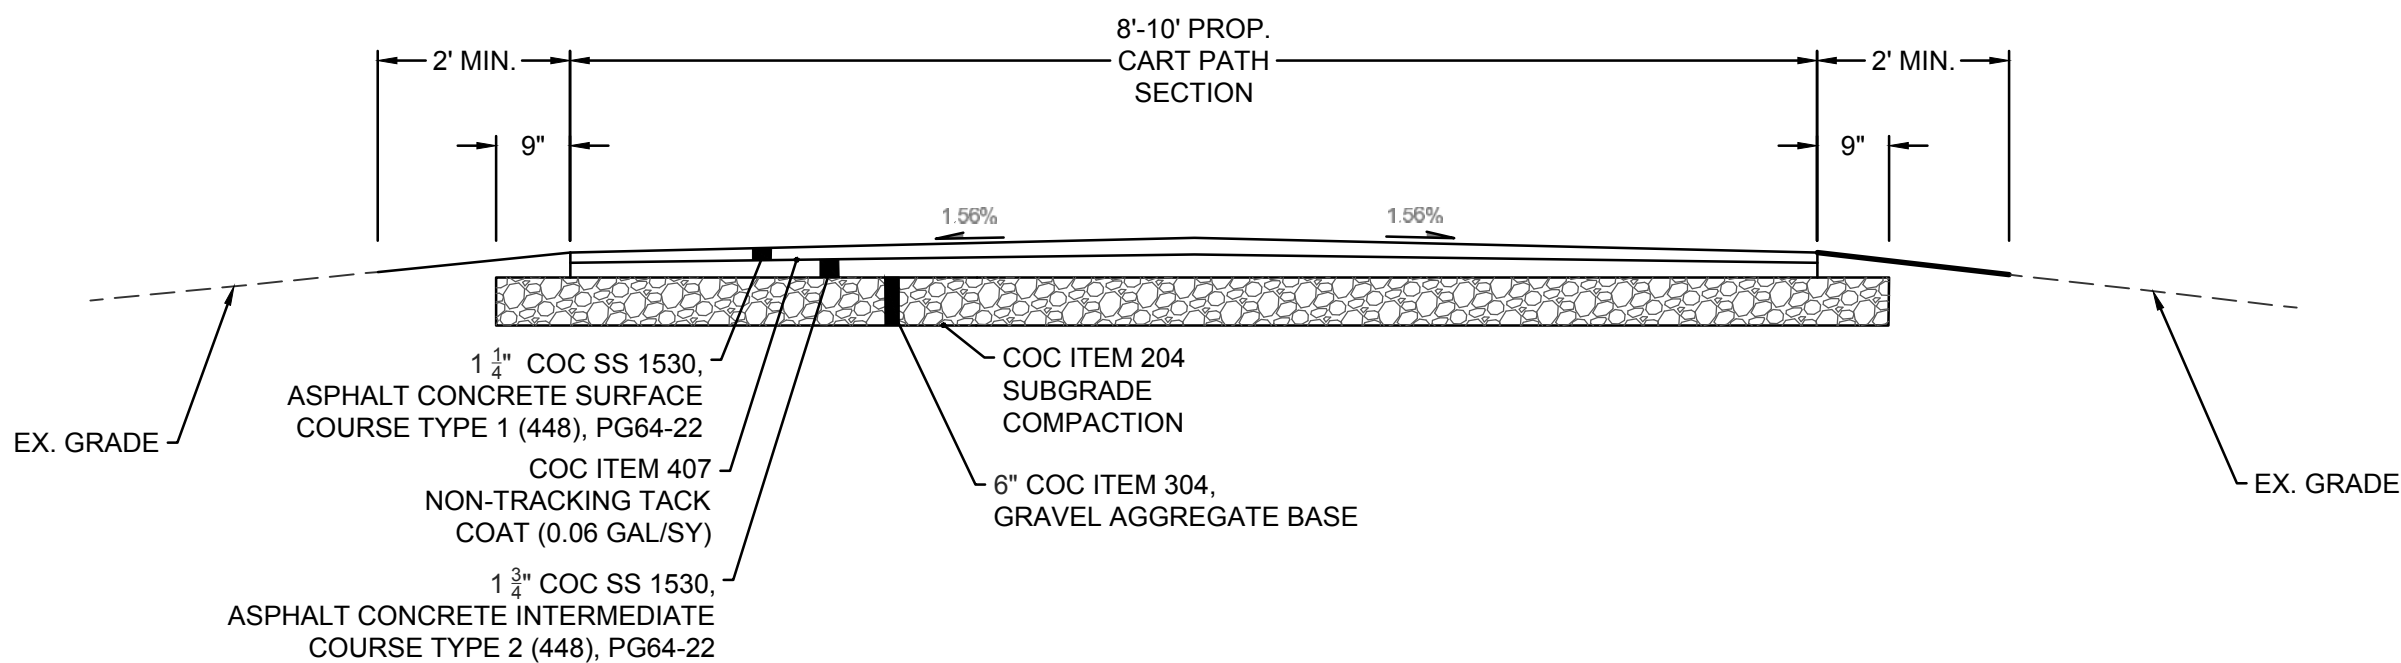

NOTES:

- THE EXISTING ASPHALT PAVEMENT SHALL BE REMOVED AND REPLACED PER THE PROPOSED ASPHALT SECTION.
- ONCE THE EXISTING ASPHALT IS REMOVED, THE CONTRACTOR SHALL VERIFY THE EXISTING GRAVEL SUBBASE THICKNESS. A MINIMUM THICKNESS OF 4" SHALL BE MAINTAINED.

E CART PATH DETAIL
NOT TO SCALE



2550 Corporate Exchange Dr., Ste 300 | Columbus, Ohio 43231
TEL: 614.425.1226
www.structurepoint.com

CONSTRUCTION DOCUMENTS
FOR
GAHANNA MUNICIPAL GOLF COURSE
GAHANNA, FRANKLIN COUNTY, OHIO
SITE PLAN DETAILS

REVISIONS	DATE	SHEET NO.	DESCRIPTION

APPROVAL PENDING NOT FOR CONSTRUCTION
IN SUBMITTING BIDS IN RELIANCE ON THESE PLANS THE CONTRACTOR ASSUMES ALL RISKS OF ADDITIONAL COSTS OF REVISIONS DUE TO REQUIREMENTS OF THE OWNER OR GOVERNMENTAL AUTHORITIES AND MATERIAL REVISIONS IN THE COURSE OF COMPLETING THE FINAL DESIGN.

DRAWN BY:	MNA
CHECKED BY:	BJM
JOB NUMBER:	2019.01727

APPENDIX E

Owner-Contractor Agreement
EJCDC Standard General Conditions

OWNER-CONTRACTOR AGREEMENT

Contract Terms Sheet

Owner: City of Gahanna 200 South Hamilton Road Gahanna, Ohio 43230 Phone: (614) 342-4005 Owner's Representative: Tom Komlanc	Contractor: Strawser Paving Company 1595 Frank Rd Columbus OH 43223 Phone: (614) 276-5273 Contractor Representative: Kyle Strawser
Project Name: Street and Sidewalk Program (2024), ST-1110	
Contract Effective Date: April 2, 2024 (Street Program) & October 1, 2024 (Golf Course Paths)	
<u> </u> When this item is checked by the Owner, e.g., with an "X" or other mark, the State of Ohio Department of Transportation, Construction Specifications Manual, in the current version through January 23, 2024, will be a Contract Document, but only as modified by the document titled <i>ODOT Manual Supplement</i> , prepared by Owner.	
<u> X </u> When this item is checked by the Owner, e.g., with an "X" or other mark, the City of Columbus Construction and Material Specifications Supplement, in the current edition through January 23, 2024, will be a Contract Document, but only as modified by the document titled <i>City of Columbus Construction and Material Specifications Supplement</i> .	
Non-Contract Documents. The following are the reports and tests of subsurface conditions at or contiguous to the Site, if any, that the Design Professional has used in preparing the Contract Documents. (None, if none are listed).	
Non-Contract Documents. The following are those reports and drawings related to any Hazardous Conditions at the Site, if any. (None, if none are listed). _____ _____	
The Design Professional (also called the "Consulting Engineer") is: _____ _____ _____ Phone: _____ Fax: _____	
If no other individual is named, then the City Engineer shall be considered to be the Project Design Professional.	
The Design Professional's Representative is: Tom Komlanc, tom.komlanc@gahanna.gov	
The Date for Substantial Completion is the following date or the following Contract Time (in calendar days)	
The Coordinating Contractor shall be the _____ Contractor. (If this blank is not completed, then the Coordinating Contractor shall be the General Trades Contractor or, if there is only one contractor, the Contractor).	

The Contract Sum (also called Contract Price) is: Four Million, Eight Hundred Ninety Nine Thousand, five hundred and Eighty Dollars and Sixty Nine Cents. The Contract Sum includes the following:

Base Bid Amount: \$4,899,580.69

Accepted Alternates, if any (none if none are listed):

Alternate No.	Description	Amount
1	Additional Crack Seal & Micro Surface	\$29,143.08
2	Golf Course Paths	\$288,287.40
3	Additional Striping	\$48,395.69

This document is an agreement between the Owner and the Contractor for the Work described in the Contract Documents related to the Contract identified above for the Project defined above and is effective as of the date set forth above ("Effective Date of this Agreement"), which if no date is entered shall be the date the Agreement was signed by the Owner.

The Owner and the Contractor agree as set forth in the following sections:

1. CONTRACT DOCUMENTS. The Contract Documents consist of the following documents:

1. NOTICE TO BIDDERS;
2. INFORMATION AND REQUIREMENTS FOR BIDDERS;
3. REQUEST FOR INFORMATION (PRE-BID);
4. SUPPLEMENTARY SPECIFICATIONS;
5. PREVAILING WAGE RATES (as applicable);
6. BID FORM;
7. NONCOLLUSION AFFIDAVIT;
8. CORPORATE AFFIDAVIT;
9. CONTRACTOR'S PERSONAL PROPERTY TAX AFFIDAVIT (O.R.C. § 5719.042);
10. CERTIFICATE OF INSURANCE;
11. STATE OF OHIO DEPARTMENT OF TAXATION, SALES AND USE TAX CONSTRUCTION CONTRACT EXEMPTION CERTIFICATE;
12. CONTRACTOR'S QUALIFICATION STATEMENT;
13. SUB CONTRACTORS LIST;
14. OWNER-CONTRACTOR AGREEMENT;
15. FISCAL OFFICER'S STATEMENT OF AVAILABILITY;
16. MODIFIED STANDARD GENERAL CONDITIONS;
17. STATE OF OHIO BUREAU OF WORKER'S COMPENSATION INSURANCE CERTIFICATE;
18. NOTICE OF COMMENCEMENT OF PUBLIC IMPROVEMENT;
19. NOTICE OF AWARD TO CONTRACTOR;
20. NOTICE OF AWARD TO SURETY AND SURETY'S AGENT;
21. NOTICE TO PROCEED;
22. CHANGE ORDER;
23. PAYROLL INFORMATION;
24. FINAL PAYROLL AFFIDAVIT;
25. CONTRACTOR'S PAYMENT APPLICATION CHECKLIST;
26. CONTRACTOR'S AFFIDAVIT WITH LIST OF SUBCONTRACTORS AND SUPPLIERS WITH ANY AMOUNTS WITHHELD;
27. CONTRACTOR'S WAIVER & RELEASE AGREEMENT;
28. SUBCONTRACTOR'S – SUPPLIER'S WAIVER & RELEASE AGREEMENT;
29. STATEMENT OF CLAIM FORM;
30. STATEMENT OF CLAIM FORM INSTRUCTIONS;
31. DESIGN PROFESSIONAL'S CERTIFICATE OF SUBSTANTIAL COMPLETION;

32. MODIFICATIONS ISSUED AFTER THE EXECUTION OF THE CONTRACT, INCLUDING:
 - i. A written amendment to the Agreement signed by both parties;
 - ii. A Change Order;
 - iii. A Work Change Directive; or,
 - iv. A written order for a minor change of the Work issued by the Design Professional in accordance with the General Conditions; and
33. If selected as a Contract Document in the Contract Terms Sheet, the State of Ohio Department of Transportation, Construction Specifications Manual, in the current version through January 23, 2024, will be a Contract Document, but only as modified by the document titled *ODOT Manual Supplement*, prepared by Owner;
34. If selected as a Contract Document in the Contract Terms Sheet, the City of Columbus Construction and Material Specifications Supplement, in the current edition through January 23, 2024, will be a Contract Document, but only as modified by the document titled *City of Columbus Construction and Material Specifications Supplement*; and
35. THE PROJECT PLANS, DRAWINGS, AND EXHIBITS.

Note: NON-CONTRACT DOCUMENTS. The reports and tests of subsurface conditions at or contiguous to the Site, if any, that the Design Professional has used in preparing the Contract Documents, identified in the Contract Terms Sheet, are not Contract Documents. The General Conditions, as modified, contain additional terms related to these reports and tests.

Note: NON-CONTRACT DOCUMENTS. The reports and drawings related to any Hazardous Conditions at the Site, if any, identified in the Contract Terms Sheet, are not Contract Documents. The General Conditions, as modified, contain additional terms related to these reports and drawings. (None if none are listed).

2. **DESIGN PROFESSIONAL RELATIONSHIP.** The Contract Documents shall not be construed to create a contractual relationship of any kind between the Design Professional and the Contractor or any Subcontractor or Material Supplier to the Project. The Design Professional, however, shall be entitled to performance of the obligations of the Contractor intended for its benefit and to enforcement of such obligations, but nothing contained herein shall be deemed to give the Contractor or any third party any claim or right of action against the Design Professional that does not otherwise exist without regard to this Contract. The Contractor and its Subcontractors shall not be deemed to be beneficiaries of any of the acts or services of the Design Professional that are performed for the sole benefit of the Owner. The Contractor shall forward all communications to the Owner through the Design Professional and hereby acknowledges and agrees that any instructions, reviews, advice, approvals, orders, or directives that are rendered to it by the Design Professional are specifically authorized and directed by the Owner to the Contractor through the Design Professional acting on behalf of the Owner.

2.1 The Design Professional (also called the "Consulting Engineer"), if any, is identified in the Contract Terms Sheet.

3. TIME FOR COMPLETION AND PROJECT COORDINATION.

3.1 DATE FOR COMMENCEMENT. The date for commencement of the Work shall be the date established in a written Notice to Proceed issued by the Owner, through the Design Professional, to the Contractor. If no Notice to Proceed is issued, then the date for commencement shall be the Effective Date of this Agreement. The date for commencement of the Work shall be within sixty (60) days from the bid opening date, unless the Owner and the Contractor agree to a later date. If there is any other date for commencement of the Work in the bid documents, Contract Documents or elsewhere, it is agreed that such other date is a tentative date and may not be relied upon by the Contractor. If the date for commencement of the Work is later than sixty (60) days from the bid opening date or, if applicable, the later date agreed to by the Owner and the Contractor, the Contractor may submit a Claim in accordance with the Contract Documents.

3.2 DATE FOR SUBSTANTIAL COMPLETION. The Contractor shall have its Work on the Project Substantially Complete by the following date or within the following Contract Time (in calendar days) set forth in the Contract Terms Sheet. The Date for Substantial Completion is the foregoing date or date calculated using the Contract Time. The Date for Substantial Completion shall only be changed or modified by Change Order, other Modification, or a Claim that is Finally Resolved regardless of any dates in any schedule created by any person, including the Coordinating Contractor. The Contract Time shall run from the date of the Notice to Proceed or if there is no Notice to Proceed from the Effective Date of this Agreement.

3.2.1 Substantial Completion is the time at which the Work has progressed to the point where the Work is sufficiently complete, in accordance with the Contract Documents, so that the Work can be utilized for the purposes for which it is intended. Final Completion shall mean that the Work is complete in accordance with the Contract Documents and the Contractor has submitted to the Design Professional all documents required to be submitted to the Design Professional for final payment. A Claim is "Finally Resolved" when the claim process is complete and not subject to further proceedings.

3.2.2 SHUTDOWN DATES. Due to events scheduled by the Owner and/or other Owner considerations, Contractor must only perform Work on the days and at the times allowed by the Ordinances of the City of Gahanna. Additionally, Contractor will not be able to perform Work on the Project on the dates and times delineated in the Supplementary Specifications to these Contract Documents.

Contractor's Construction Schedule for performing the Work shall account for Contractor not being able to perform Work on these dates and the contractual dates for Substantial Completion and Final Completion will not be changed due to Contractor not being able to perform Work on these dates.

3.3 CONSTRUCTION SCHEDULE. The Construction Schedule (also referred to as the "Progress Schedule") shall be developed by the Coordinating Contractor as provided in the Contract Documents.

3.4 COORDINATING CONTRACTOR. The Coordinating Contractor shall be the contractor identified in the Contract Terms Sheet (if none is identified, then the Coordinating Contractor shall be the General Trades Contractor or, if there is only one contractor, the

Contractor). The Coordinating Contractor shall be responsible for coordinating the work of all contractors on the Project.

3.5 **LIQUIDATED DAMAGES**. If the Contractor does not have its Work on the Project Substantially Complete by its Date for Substantial Completion or Finally Complete within forty-five (45) days of achieving Substantial Completion, the Contractor shall pay the Owner (and the Owner may set off from sums coming due the Contractor) Liquidated Damages in the per diem amounts as set forth in the following tables, whichever may be applicable:

LIQUIDATED DAMAGES – DATE FOR SUBSTANTIAL COMPLETION

<u>Contract Amount</u>	<u>Dollars Per Day</u>
\$1.00 to \$50,000.00	\$ 250.00
\$50,000.01 to \$150,000.00	\$ 500.00
\$150,000.01 to \$500,000.00	\$1,000.00
\$500,000.01 to \$2,000,000.00	\$1,500.00
\$2,000,000.01 to \$5,000,000.00	\$2,500.00
\$5,000,000.01 to \$10,000,000.00	\$3,000.00

LIQUIDATED DAMAGES – FINAL COMPLETION

<u>Contract Amount</u>	<u>Dollars Per Day</u>
\$1.00 to \$50,000.00	\$ 50.00
\$50,000.01 to \$150,000.00	\$ 100.00
\$150,000.01 to \$500,000.00	\$ 200.00
\$500,000.01 to \$2,000,000.00	\$ 300.00
\$2,000,000.01 to \$5,000,000.00	\$ 500.00
\$5,000,000.01 to \$10,000,000.00	\$ 600.00

In addition to such Liquidated Damages, the Contractor shall indemnify, defend and hold the Owner and its employees and agents harmless from any and all claims, whether or not such claims are proven, and from all costs and expenses incurred, as a result of or related to such claims, including but not limited to attorneys' and consultants' fees and expenses, provided that such claims arise out of or are related to the Contractor's failure to Substantially Complete its Work by its Date for Substantial Completion or its failure to Finally Complete its Work within forty-five (45) days of its Date for Substantial Completion. The Contractor's obligation to indemnify, defend and hold the Owner harmless under this Section 3.5 shall be joint and several. These Liquidated Damages are in addition to any other remedies available to the Owner under the Contract Documents.

The Contractor acknowledges that such amounts of Liquidated Damages represent a reasonable estimate of the actual damages for loss of or interference with the intended use of the Project that the Owner would incur if the Contractor's Work is not Substantially Complete by its Date for Substantial Completion or Finally Complete by the required date for Final Completion.

4. CONTRACT SUM (also called Contract Price). The lump sum Contract Sum to be paid by the Owner to the Contractor, as provided herein, for the satisfactory performance and completion of the Work and all of the duties, obligations, and responsibilities of the Contractor under this Agreement and the other Contract Documents is as set forth in the Contract Terms Sheet. The Contract Sum includes all federal, state, county, municipal, and other taxes imposed by law, including but not limited to any sales, use, commercial activity, and personal property taxes payable by or levied against the Contractor on account of the Work or the materials incorporated into the Work. The Contractor will pay any such taxes. The Contract Sum includes the Base Bid and Alternates, if any, identified in the Contract Terms Sheet.

If after Substantial Completion of its Work, the Contractor fails to submit its final payment application with all the documents required to be submitted with such application within ninety (90) days after written notice to do so from the Owner and without prejudice to any other rights and remedies the Owner may have available to it, the balance of the Contract Sum shall become the Owner's sole and exclusive property, and the Contractor shall have no further interest in or right to such balance.

5. RETAINAGE. Retainage applicable to the Contract by Ohio Revised Code Sections 153.12, .13, and .14 will be withheld as defined in the General Conditions. The Contractor agrees that the Retainage will not be held in escrow or in any interest bearing account, and that no interest will be paid on such retained funds.

6. LIMITATION ON LIABILITY. The Owner's total liability under this Agreement will be limited to the amount set forth in the Fiscal Officer's certificate accompanying this Agreement. Under no circumstances will the elected officials, officers, employees, board or council members, or agents of the Owner be personally liable for any obligations or claims arising out of or related to this Agreement.

7. GENERAL.

7.1 MODIFICATION. Unless otherwise specifically set forth in this Agreement, no modification or waiver of any of the terms of this Agreement, or of any other Contract Documents, will be effective against a party unless set forth in writing and signed by or on behalf of a party. In the case of the Owner, the person executing the modification or waiver must have express authority to execute the Modification on behalf of the Owner pursuant to a resolution that is duly adopted by the Owner. Under no circumstances will forbearance, including the failure or repeated failure to insist upon compliance with the terms of the Contract Documents, constitute the waiver or modification of any such terms by the Owner. The parties acknowledge that no person has authority to modify this Agreement or the other Contract Documents or to waive any of its or their terms, except as expressly provided in this section.

7.2 ASSIGNMENT. The Contractor may not assign this Agreement without the written consent of the Owner, which the Owner may withhold in its sole discretion.

7.3 LAW AND JURISDICTION. All questions regarding the validity, intention, or meaning of this Agreement or any modifications of it relating to the rights and obligation of the parties will be construed and resolved under the laws of the State of Ohio. Any suit, which may be brought to enforce any provision of this Agreement or any remedy with respect hereto, shall be brought in the state court of competent jurisdiction in the county in Ohio in which the Owner's principal office is located, and each party hereby expressly consents to the exclusive

jurisdiction of such court. The parties expressly waive the right to remove any litigation arising out of this Agreement to federal court.

7.4 CONSTRUCTION. The parties acknowledge that each party has reviewed this Agreement and the other Contract Documents and entered into this Agreement as a free and voluntary act. Accordingly, the normal rule of construction to the effect that any ambiguities are to be resolved against the drafting party will not be employed in the interpretation of this Agreement, the other Contract Documents, or any amendments or exhibits to it or them.

7.5 APPROVALS. Except as expressly provided herein, the approvals and determinations of the Owner and Design Professional will be subject to the sole discretion of the respective party and be valid and binding on the Contractor, provided only that they be made in good faith, i.e., honestly. If the Contractor challenges any such approval or determination, the Contractor has the burden of proving that it was not made in good faith by clear and convincing evidence.

7.6 PARTIAL INVALIDITY. If any term or provision of this Agreement is found to be illegal, unenforceable, or in violation of any laws, statutes, ordinances, or regulations of any public authority having jurisdiction, then, notwithstanding such term or provision, this Agreement will remain in full force and effect and such term will be deemed stricken; provided this Agreement will be interpreted, when possible, so as to reflect the intentions of the parties as indicated by any such stricken term or provision.

7.7 COMPLIANCE WITH LAWS AND REGULATIONS. The Contractor, at its expense, will comply with all applicable federal, state, and local laws, rules, and regulations applicable to the Work, including but not limited to Chapter 4115 of the Ohio Revised Code and Sections 153.59 and 153.60 of the Ohio Revised Code, which prohibit discrimination in the hiring and treatment of employees, with respect to which the Contractor agrees to comply and to require its subcontractors to comply.

7.7.1 NON-DISCRIMINATION. Contractor agrees:


1. That in the hiring of employees for the performance of Work under this Agreement or in any subcontract, neither the Contractor, subcontractor, or any person acting on behalf of either of them, shall by reason of race, creed, sex, disability as defined in Section 4112.01 of the Ohio Revised Code, or color discriminate against any citizen of the state in the employment of labor or workers who are qualified and available to perform the Work to which the employment relates.
2. That neither the Contractor, subcontractor, nor any person acting on behalf of either of them shall, in any manner, discriminate against or intimidate any employee hired for the performance of Work under this Agreement on account of race, creed, sex, disability as defined in Section 4112.01 of the Ohio Revised Code, or color.
3. That there shall be deducted from the amount payable to the Contractor by the Owner under this Agreement a forfeiture of twenty-five dollars (\$25.00) as required by Ohio Revised Code Section 153.60 for each person who is discriminated against or intimidated in violation of this Agreement.
4. That this Agreement may be canceled or terminated by the Owner and all money to become due hereunder may be forfeited for a second or subsequent violation of the terms of this section of this Agreement.

- 7.7.2 PREVAILING WAGE RATES. The Contractor and its subcontractors, regardless of tier, shall strictly comply with their obligation to pay their employees working on the Project site at the applicable prevailing wage rates for the type of work, including any changes thereto, without increase in the Contract Sum.
- 7.7.3 ETHICS. By signing and entering into this agreement with the Owner, the Contractor represents that it is familiar with all applicable ethics law requirements, including without limitation Sections 102.04 and 3517.13 of the Ohio Revised Code, and certifies that it is in compliance with such requirements. The Contractor understands that failure to comply with the ethics laws is, in itself, grounds for termination of this contract and may result in the loss of other contracts with the Owner.
- 7.8 JOB MEETINGS. The Contractor or one of its representatives with authority to bind the Contractor will attend all job meetings. The Owner anticipates that job meetings will be scheduled on a weekly basis during construction or as needed. The Contractor will ensure that its Subcontractors also hold regular job meetings at which safety issues and job matters are discussed as these relate to the Work being performed. Job meetings include, but are not limited to, pre-construction meetings, weekly job meetings, weekly safety tool box meetings, and monthly safety meetings.
- 7.9 PROPERTY TAX AFFIDAVIT. The Contractor's affidavit given under Section 5719.024, Ohio Revised Code, is incorporated herein.
- 7.10 PARTNERING. Contractor agrees that it will participate, as part of the Contract Sum, in any partnering sessions scheduled by Owner.
- 7.11 ENTIRE AGREEMENT. This Agreement and the other Contract Documents constitute the entire agreement among the parties with respect to their subject matter and will supersede all prior and contemporaneous, oral or written, agreements, negotiations, communications, representations, and understandings with respect to such subject matter, and no person is justified in relying on such agreements, negotiations, communications, representations, or understandings.
- 7.12 COUNTERPARTS. This Agreement may be executed in any number of counterparts each of which when so executed and delivered will be an original hereof, and it will not be necessary in making proof of this Agreement to produce or account for more than one counterpart hereof. This Agreement may be executed and delivered by facsimile or via electronic mail.

IN WITNESS WHEREOF, the parties have caused this Agreement to be executed by their properly authorized representatives and agree that this Agreement is effective as of the date first set forth above.

Owner: The City of Gahanna

Contractor (as identified on the Contract Terms Sheet)

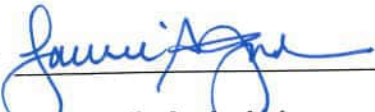By: 

Name: Laurie A. Jadwin

Title: Mayor

Date: 4.10.24

By: Strawser Paving Co., Inc.

Name: Cory Strawser

Title: Secretary-Treasurer

Date: 5-28-2027

By: 

Name: Tom Komlanc

Title: Director of Engineering

Date: 4-10-2024

Approved as to form of Contract and Contract Bond:

By: 

Name: Priya D. Tamilarasan

Title: City Attorney

Date: 4/11/24

FISCAL OFFICER'S STATEMENT OF AVAILABILITY

(Section 5705.41, R.C.)

I Joann Bury, hereby certify that I am the Director of Finance for the City of Gahanna, Ohio and that the amount of money to wit \$5,265,406.86 required to meet the cost of the attached Contract between the City of Gahanna, Ohio and Strawser Paving Company, has been or will be, prior to the ordering of any materials, lawfully appropriated for the purpose of said Contract and the money so appropriated is on deposit or in process of collection to the credit of the appropriate fund free from any previous encumbrances. Moneys due in excess of the Contract Sum and any Contingency amount assigned thereto shall require an additional and separate Fiscal Officer's Statement of Availability which shall not be given unless the Contract adjustment is directly attributable to one of the express methods for increasing the Contract Sum under the Contract Documents; and, such process is completed in the manner required by the Contract Documents.

Date: 4/10/2024

Signed: 

By: Joann Bury

Title: Director of Finance

This document has important legal consequences; consultation with an attorney is encouraged with respect to its use or modification. This document should be adapted to the particular circumstances of the contemplated Project and the controlling Laws and Regulations.

THIS DOCUMENT HAS BEEN MODIFIED FROM ITS ORIGINAL VERSION

MODIFIED STANDARD GENERAL CONDITIONS OF THE CONSTRUCTION CONTRACT

Prepared by



Issued and Published Jointly by



These General Conditions have been prepared for use with the Agreement Between Owner and Contractor for Construction Contract (EJCDC® C-520, Stipulated Sum, or C-525, Cost-Plus, 2013 Editions). Their provisions are interrelated and a change in one may necessitate a change in the other.

To prepare supplementary conditions that are coordinated with the General Conditions, use EJCDC's Guide to the Preparation of Supplementary Conditions (EJCDC® C-800, 2013 Edition). The full EJCDC Construction series of documents is discussed in the Commentary on the 2013 EJCDC Construction Documents (EJCDC® C-001, 2013 Edition).

Copyright © 2013:

National Society of Professional Engineers
1420 King Street, Alexandria, VA 22314-2794
(703) 684-2882
www.nspe.org

American Council of Engineering Companies
1015 15th Street N.W., Washington, DC 20005
(202) 347-7474
www.acec.org

American Society of Civil Engineers
1801 Alexander Bell Drive, Reston, VA 20191-4400
(800) 548-2723
www.asce.org

The copyright for this document is owned jointly by the three sponsoring organizations listed above. The National Society of Professional Engineers is the Copyright Administrator for the EJCDC documents; please direct all inquiries regarding EJCDC copyrights to NSPE.

NOTE: EJCDC publications may be purchased at www.ejcdc.org, or from any of the sponsoring organizations above.

STANDARD GENERAL CONDITIONS OF THE CONSTRUCTION CONTRACT

TABLE OF CONTENTS

ARTICLE 1 – Definitions and Terminology

1.01 Defined Terms

1.02 Terminology

ARTICLE 2 – Preliminary Matters

2.01 Delivery of Bonds and Evidence of Insurance

2.02 Copies of Documents

2.03 Before Starting Construction

2.04 Preconstruction Conference; Designation of Authorized Representatives

2.05 Initial Acceptance of Schedules

2.06 Electronic Transmittals

ARTICLE 3 – Documents: Intent, Requirements, Reuse

3.01 Intent

3.02 Reference Standards

3.03 Reporting and Resolving Discrepancies

3.04 Requirements of the Contract Documents

3.05 Reuse of Documents

ARTICLE 4 – Commencement and Progress of the Work

4.01 Commencement of Contract Times; Notice to Proceed

4.02 Starting the Work

4.03 Reference Points

4.04 Progress Schedule

4.05 Delays in Contractor's Progress

ARTICLE 5 – Availability of Lands; Subsurface and Physical Conditions; Hazardous Environmental Conditions

5.01 Availability of Lands

5.02 Use of Site and Other Areas

- 5.03 Subsurface and Physical Conditions
- 5.04 Differing Subsurface or Physical Conditions
- 5.05 Underground Facilities
- 5.06 Hazardous Environmental Conditions at Site

ARTICLE 6 – Bonds and Insurance

- 6.01 Performance, Payment, and Other Bonds
- 6.02 Insurance—General Provisions
- 6.03 Contractor's Insurance
- 6.04 Owner's Liability Insurance
- 6.05 Property Insurance
- 6.06 Waiver of Rights
- 6.07 Receipt and Application of Property Insurance Proceeds

ARTICLE 7 – Contractor's Responsibilities

- 7.01 Supervision and Superintendence
- 7.02 Labor; Working Hours
- 7.03 Services, Materials, and Equipment
- 7.04 "Or Equals"
- 7.05 Substitutes
- 7.06 Concerning Subcontractors, Suppliers, and Others
- 7.07 Patent Fees and Royalties
- 7.08 Permits
- 7.09 Taxes
- 7.10 Laws and Regulations
- 7.11 Record Documents
- 7.12 Safety and Protection
- 7.13 Safety Representative
- 7.14 Hazard Communication Programs
- 7.15 Emergencies
- 7.16 Shop Drawings, Samples, and Other Submittals

7.17 Contractor's General Warranty and Guarantee

7.18 Indemnification

7.19 Delegation of Professional Design Services

ARTICLE 8 – Other Work at the Site

8.01 Other Work

8.02 Coordination

8.03 Legal Relationships

ARTICLE 9 – Owner's Responsibilities

9.01 Communications to Contractor

9.02 Replacement of Engineer

9.03 Furnish Data

9.04 Pay When Due

9.05 Lands and Easements; Reports, Tests, and Drawings

9.06 Insurance

9.07 Change Orders

9.08 Inspections, Tests, and Approvals

9.09 Limitations on Owner's Responsibilities

9.10 Undisclosed Hazardous Environmental Condition

9.11 Evidence of Financial Arrangements

9.12 Safety Programs

ARTICLE 10 – Engineer's Status During Construction

10.01 Owner's Representative

10.02 Visits to Site

10.03 Project Representative

10.04 Rejecting Defective Work

10.05 Shop Drawings, Change Orders and Payments

10.06 Determinations for Unit Price Work

10.07 Decisions on Requirements of Contract Documents and Acceptability of Work

10.08 Limitations on Engineer's Authority and Responsibilities

10.09 Compliance with Safety Program

ARTICLE 11 – Amending the Contract Documents; Changes in the Work

11.01 Amending and Supplementing Contract Documents

11.02 Owner-Authorized Changes in the Work

11.03 Unauthorized Changes in the Work

11.04 Change of Contract Price

11.05 Change of Contract Times

11.06 Change Proposals

11.07 Execution of Change Orders

11.08 Notification to Surety

ARTICLE 12 – Claims

12.01 Claims

ARTICLE 13 – Cost of the Work; Allowances; Unit Price Work

13.01 Cost of the Work

13.02 Allowances

13.03 Unit Price Work

ARTICLE 14 – Tests and Inspections; Correction, Removal or Acceptance of Defective Work

14.01 Access to Work

14.02 Tests, Inspections, and Approvals

14.03 Defective Work

14.04 Acceptance of Defective Work

14.05 Uncovering Work

14.06 Owner May Stop the Work

14.07 Owner May Correct Defective Work

ARTICLE 15 – Payments to Contractor; Set-Offs; Completion; Correction Period

15.01 Progress Payments

15.02 Contractor's Warranty of Title

15.03 Substantial Completion

15.04 Partial Use or Occupancy

15.05 Final Inspection

15.06 Final Payment

15.07 Waiver of Claims

15.08 Correction Period

ARTICLE 16 – Suspension of Work and Termination

16.01 Owner May Suspend Work

16.02 Owner May Terminate for Cause

16.03 Owner May Terminate For Convenience

16.04 Contractor May Stop Work or Terminate

ARTICLE 17 – Final Resolution of Disputes

17.01 Methods and Procedures

ARTICLE 18 – Miscellaneous

18.01 Giving Notice

18.02 Computation of Times

18.03 Cumulative Remedies

18.04 Limitation of Damages

18.05 No Waiver

18.06 Survival of Obligations

18.07 Controlling Law

18.08 Headings

ARTICLE 1 – DEFINITIONS AND TERMINOLOGY

1.01 *Defined Terms*

- A. Wherever used in the Bidding Requirements or Contract Documents, a term printed with initial capital letters or with all capital letters, including the term's singular and plural forms, will have the meaning indicated in the definitions below. In addition to terms specifically defined, terms with initial capital letters in the Contract Documents include references to identified articles and paragraphs, and the titles of other documents or forms.
1. *Addenda*—Written or graphic instruments issued prior to the opening of Bids which clarify, correct, or change the Bidding Requirements or the proposed Contract Documents.
 2. *Agreement or Owner-Contractor Agreement*—The written instrument, executed by Owner and Contractor, that sets forth the Contract Price and Contract Times, identifies the parties and the Engineer, and designates the specific items that are Contract Documents.
 3. *Application for Payment*—The form acceptable to Engineer which is to be used by Contractor during the course of the Work in requesting progress or final payments and which is to be accompanied by such supporting documentation as is required by the Contract Documents.
 4. *Bid*—The offer of a Bidder submitted on the prescribed form setting forth the prices for the Work to be performed.
 5. *Bidder*—An individual or entity that submits a Bid to Owner.
 6. *Bidding Documents*—The Bidding Requirements, the proposed Contract Documents, and all Addenda.
 7. *Bidding Requirements*—The advertisement or invitation to bid, Information and Requirements for Bidders, Bid Bond or other Bid security, if any, the Bid Form, and legal notice.
 8. *Change Order*—A document which is signed by Contractor and Owner and authorizes an addition, deletion, or revision in the Work or an adjustment in the Contract Price or the Contract Times, or other revision to the Contract, issued on or after the Effective Date of the Contract.
 9. *Change Proposal*—A written request by Contractor, duly submitted in compliance with the procedural requirements set forth herein, seeking an adjustment in Contract Price or Contract Times, or both; contesting an initial decision by Engineer concerning the requirements of the Contract Documents or the acceptability of Work under the Contract Documents; challenging a set-off against payments due; or seeking other relief with respect to the terms of the Contract.
 10. *Claim*—(a) A demand or assertion by Owner directly to Contractor, duly submitted in compliance with the procedural requirements set forth herein: seeking an adjustment of Contract Price or Contract Times, or both; contesting an initial decision by Engineer concerning the requirements of the Contract Documents or the acceptability of Work under the Contract Documents; contesting Engineer's decision regarding a Change Proposal; seeking resolution

of a contractual issue that Engineer has declined to address; or seeking other relief with respect to the terms of the Contract; or (b) a demand or assertion by Contractor directly to Owner, duly submitted in compliance with the procedural requirements set forth herein, contesting Engineer's decision regarding a Change Proposal; or seeking resolution of a contractual issue that Engineer has declined to address. A demand for money or services by a third party is not a Claim.

11. *Constituent of Concern*—Asbestos, petroleum, radioactive materials, polychlorinated biphenyls (PCBs), hazardous waste, and any substance, product, waste, or other material of any nature whatsoever that is or becomes listed, regulated, or addressed pursuant to (a) the Comprehensive Environmental Response, Compensation and Liability Act, 42 U.S.C. §§9601 et seq. ("CERCLA"); (b) the Hazardous Materials Transportation Act, 49 U.S.C. §§5501 et seq.; (c) the Resource Conservation and Recovery Act, 42 U.S.C. §§6901 et seq. ("RCRA"); (d) the Toxic Substances Control Act, 15 U.S.C. §§2601 et seq.; (e) the Clean Water Act, 33 U.S.C. §§1251 et seq.; (f) the Clean Air Act, 42 U.S.C. §§7401 et seq.; or (g) any other federal, state, or local statute, law, rule, regulation, ordinance, resolution, code, order, or decree regulating, relating to, or imposing liability or standards of conduct concerning, any hazardous, toxic, or dangerous waste, substance, or material.
12. *Contract*—The entire and integrated written contract between the Owner and Contractor concerning the Work.
13. *Contract Documents*— The Contract Documents are the Contract Documents identified in the Owner-Contractor Agreement ("Agreement")
14. *Contract Price*—The money that Owner has agreed to pay Contractor for completion of the Work in accordance with the Contract Documents. .
15. *Contract Times*—The number of days or the dates by which Contractor shall: (a) achieve Milestones, if any; (b) achieve Substantial Completion; and (c) complete the Work.
16. *Contractor*—The individual or entity with which Owner has contracted for performance of the Work.
17. *Cost of the Work*—See Paragraph 13.01 for definition.
18. *Drawings*—The part of the Contract that graphically shows the scope, extent, and character of the Work to be performed by Contractor.
19. *Effective Date of the Contract*—The date, indicated in the Agreement, on which the Contract becomes effective, but if no such date is indicated, it means the date on which the Agreement is signed by the Owner.
20. *Engineer*—Either the individual or entity named as the Consulting Engineer in the Agreement or the City Engineer, as appropriate to the Project.
21. *Field Order*—A written order issued by Engineer which requires minor changes in the Work but does not change the Contract Price or the Contract Times.
22. *Hazardous Environmental Condition*—The presence at the Site of Constituents of Concern in such quantities or circumstances that may present a danger to persons or property exposed thereto. The presence at the Site of materials that are necessary for the execution of the Work, or that are to be incorporated in the Work, and that are controlled and contained pursuant to industry practices, Laws

and Regulations, and the requirements of the Contract, does not establish a Hazardous Environmental Condition.

23. *Laws and Regulations; Laws or Regulations*—Any and all applicable laws, statutes, rules, regulations, ordinances, codes, and orders of any and all governmental bodies, agencies, authorities, and courts having jurisdiction.
24. *Liens*—Charges, security interests, or encumbrances upon Contract-related funds, real property, or personal property.
25. *Milestone*—A principal event in the performance of the Work that the Contract requires Contractor to achieve by an intermediate completion date or by a time prior to Substantial Completion of all the Work.
26. *Notice of Award*—The written notice by Owner to a Bidder of Owner's acceptance of the Bid.
27. *Notice to Proceed*—A written notice by Owner to Contractor fixing the date on which the Contract Times will commence to run and on which Contractor shall start to perform the Work.
28. *Owner*—The individual or entity with which Contractor has contracted regarding the Work, and which has agreed to pay Contractor for the performance of the Work, pursuant to the terms of the Contract.
29. *Progress Schedule*—A schedule, prepared and maintained by Contractor, describing the sequence and duration of the activities comprising the Contractor's plan to accomplish the Work within the Contract Times.
30. *Project*—The total undertaking to be accomplished for Owner by engineers, contractors, and others, including planning, study, design, construction, testing, commissioning, and start-up, and of which the Work to be performed under the Contract Documents is a part.
31. *Project Manual*—The written documents prepared for, or made available for, procuring and constructing the Work, including but not limited to the Bidding Documents or other construction procurement documents, geotechnical and existing conditions information, the Agreement, bond forms, General Conditions, Supplementary Conditions, and Specifications. The contents of the Project Manual may be bound in one or more volumes.
32. *Resident Project Representative*—The authorized representative of Engineer assigned to assist Engineer at the Site. As used herein, the term Resident Project Representative or "RPR" includes any assistants or field staff of Resident Project Representative.
33. *Samples*—Physical examples of materials, equipment, or workmanship that are representative of some portion of the Work and that establish the standards by which such portion of the Work will be judged.
34. *Schedule of Submittals*—A schedule, prepared and maintained by Contractor, of required submittals and the time requirements for Engineer's review of the submittals and the performance of related construction activities.
35. *Schedule of Values*—A schedule, prepared and maintained by Contractor, allocating portions of the Contract Price to various portions of the Work and used as the basis for reviewing Contractor's Applications for Payment. If the Owner or Engineer prepares a Bid Schedule breaking the Work down into estimated

quantities (pay items) for the purpose of bidding the Work, the Schedule of Values shall be the Bid Schedule. If there is any part of the Work that is not identified in the Bid Schedule, such part shall be deemed incidental to Work identified in the Bid Schedule.

36. *Shop Drawings*—All drawings, diagrams, illustrations, schedules, and other data or information that are specifically prepared or assembled by or for Contractor and submitted by Contractor to illustrate some portion of the Work. Shop Drawings, whether approved or not, are not Drawings and are not Contract Documents.
37. *Site*—Lands or areas indicated in the Contract Documents as being furnished by Owner upon which the Work is to be performed, including rights-of-way and easements, and such other lands furnished by Owner which are designated for the use of Contractor.
38. *Specifications*—The part of the Contract that consists of written requirements for materials, equipment, systems, standards, and workmanship as applied to the Work, and certain administrative requirements and procedural matters applicable to the Work.
39. *Subcontractor*—An individual or entity having a direct contract with Contractor or with any other Subcontractor for the performance of a part of the Work.
40. *Substantial Completion*—The time at which the Work (or a specified part thereof) has progressed to the point where, in the opinion of Engineer, the Work (or a specified part thereof) is sufficiently complete, in accordance with the Contract Documents, so that the Work (or a specified part thereof) can be utilized for the purposes for which it is intended. The terms “substantially complete” and “substantially completed” as applied to all or part of the Work refer to Substantial Completion thereof.
41. *Successful Bidder*—The Bidder whose Bid the Owner accepts, and to which the Owner makes an award of contract, subject to stated conditions.
42. *Supplementary Conditions*—The part of the Contract that amends or supplements these General Conditions. If additional supplements are included in the Contract Documents, they may be in the form of Supplementary or Special Conditions.
43. *Supplier*—A manufacturer, fabricator, supplier, distributor, materialman, or vendor having a direct contract with Contractor or with any Subcontractor to furnish materials or equipment to be incorporated in the Work by Contractor or a Subcontractor.
44. *Technical Data*—Those items expressly identified as Technical Data in the Supplementary Conditions, with respect to either (a) subsurface conditions at the Site, or physical conditions relating to existing surface or subsurface structures at the Site (except Underground Facilities) or (b) Hazardous Environmental Conditions at the Site. If no such express identifications of Technical Data have been made with respect to conditions at the Site, then the data contained in boring logs, recorded measurements of subsurface water levels, laboratory test results, and other factual, objective information regarding conditions at the Site that are set forth in any geotechnical or environmental report prepared for the Project and made available to Contractor are hereby defined as Technical Data with respect to conditions at the Site under Paragraphs 5.03, 5.04, and 5.06.

45. *Underground Facilities*—All underground pipelines, conduits, ducts, cables, wires, manholes, vaults, tanks, tunnels, or other such facilities or attachments, and any encasements containing such facilities, including but not limited to those that convey electricity, gases, steam, liquid petroleum products, telephone or other communications, fiber optic transmissions, cable television, water, wastewater, storm water, other liquids or chemicals, or traffic or other control systems.
46. *Unit Price Work*—Work to be paid for on the basis of unit prices.
47. *Work*—The entire construction or the various separately identifiable parts thereof required to be provided under the Contract Documents. Work includes and is the result of performing or providing all labor, services, and documentation necessary to produce such construction; furnishing, installing, and incorporating all materials and equipment into such construction; and may include related services such as testing, start-up, and commissioning, all as required by the Contract Documents.
48. *Work Change Directive*—A written directive to Contractor issued on or after the Effective Date of the Contract, signed by Owner and recommended by Engineer, ordering an addition, deletion, or revision in the Work.

1.02 Terminology

- A. The words and terms discussed in the following paragraphs are not defined but, when used in the Bidding Requirements or Contract Documents, have the indicated meaning.
- B. *Intent of Certain Terms or Adjectives:*
 1. The Contract Documents include the terms “as allowed,” “as approved,” “as ordered,” “as directed” or terms of like effect or import to authorize an exercise of professional judgment by Engineer. In addition, the adjectives “reasonable,” “suitable,” “acceptable,” “proper,” “satisfactory,” or adjectives of like effect or import are used to describe an action or determination of Engineer as to the Work. It is intended that such exercise of professional judgment, action, or determination will be solely to evaluate, in general, the Work for compliance with the information in the Contract Documents and with the design concept of the Project as a functioning whole as shown or indicated in the Contract Documents (unless there is a specific statement indicating otherwise). The use of any such term or adjective is not intended to and shall not be effective to assign to Engineer any duty or authority to supervise or direct the performance of the Work, or any duty or authority to undertake responsibility contrary to the provisions of Article 10 or any other provision of the Contract Documents.
- C. *Day:*
 1. The word “day” means a calendar day of 24 hours measured from midnight to the next midnight.
- D. *Defective:*
 1. The word “defective,” when modifying the word “Work,” refers to Work that is unsatisfactory, faulty, or deficient in that it:
 - a. does not conform to the Contract Documents; or

- b. does not meet the requirements of any applicable inspection, reference standard, test, or approval referred to in the Contract Documents; or
 - c. has been damaged prior to Engineer's recommendation of final payment (unless responsibility for the protection thereof has been assumed by Owner at Substantial Completion in accordance with Paragraph 15.03 or 15.04).
- E. *Furnish, Install, Perform, Provide:*
 - 1. The word "furnish," when used in connection with services, materials, or equipment, shall mean to supply and deliver said services, materials, or equipment to the Site (or some other specified location) ready for use or installation and in usable or operable condition.
 - 2. The word "install," when used in connection with services, materials, or equipment, shall mean to put into use or place in final position said services, materials, or equipment complete and ready for intended use.
 - 3. The words "perform" or "provide," when used in connection with services, materials, or equipment, shall mean to furnish and install said services, materials, or equipment complete and ready for intended use.
 - 4. If the Contract Documents establish an obligation of Contractor with respect to specific services, materials, or equipment, but do not expressly use any of the four words "furnish," "install," "perform," or "provide," then Contractor shall furnish and install said services, materials, or equipment complete and ready for intended use.
- F. Unless stated otherwise in the Contract Documents, words or phrases that have a well-known technical or construction industry or trade meaning are used in the Contract Documents in accordance with such recognized meaning.

ARTICLE 2 – PRELIMINARY MATTERS

2.01 *Delivery of Bonds and Evidence of Insurance*

- A. *Bonds:* When Contractor delivers the executed counterparts of the Agreement to Owner, Contractor shall also deliver to Owner such bonds, insurance certificates, insurance endorsements, and other documents as Contractor may be required to furnish under the Contract Documents.
- B. *Evidence of Contractor's Insurance:* When Contractor delivers the executed counterparts of the Agreement to Owner, Contractor shall also deliver to Owner, with copies to each named insured and additional insured (as identified in the Supplementary Conditions or elsewhere in the Contract), the certificates and other evidence of insurance required to be provided by Contractor in accordance with Article 6.
- C. *Evidence of Owner's Insurance:* After receipt of the executed counterparts of the Agreement and all required bonds and insurance documentation, Owner shall, upon the Contractor's request, promptly deliver to Contractor, with copies to each named insured and additional insured (as identified in the Supplementary Conditions or otherwise), the certificates and other evidence of insurance required to be provided by Owner under Article 6.

2.02 *Copies of Documents*

- A. Owner shall furnish to Contractor up to four printed copies of the Contract (including one fully executed counterpart of the Agreement), and one copy in electronic portable document format (PDF). Additional printed copies will be furnished upon request at the cost of reproduction.

B.

2.03 *Before Starting Construction*

- A. *Preliminary Schedules:* Within 10 days after the Notice to Proceed (or as otherwise specifically required by the Contract Documents), Contractor shall submit to Engineer for timely review:
 - 1. a preliminary Progress Schedule indicating the times (numbers of days or dates) for starting and completing the various stages of the Work, including any Milestones specified in the Contract;
 - 2. a preliminary Schedule of Submittals; and
 - 3. a preliminary Schedule of Values for all of the Work which includes quantities and prices of items which when added together equal the Contract Price and subdivides the Work into component parts in sufficient detail to serve as the basis for progress payments during performance of the Work. Such prices will include an appropriate amount of overhead and profit applicable to each item of Work. The total of the schedule of values prepared for the Work, as required by the General Conditions, shall not exceed the Bid submitted for the Work, unless such amount is adjusted as provided in the Contract Documents.
- B. The Contractor shall prepare the Progress Schedule within ten (10) days of the date of the Notice to Proceed. The Progress Schedule shall include and be consistent with any applicable Milestone Dates in the Construction Documents. The Contractor shall prepare all Progress Schedules in CPM format unless provided otherwise in the Contract Document or otherwise agreed in writing by the Owner. The Progress Schedule is for coordinating the timing, phasing, and sequence of the Work of the contractors and shall not change or modify the date for Substantial Completion. The date for Substantial Completion shall only be changed or modified by Change Order, other Modification, or a Claim that is finally resolved, regardless of the date in the Proposed Schedule.
 - 1. The Contractor shall update the Progress Schedule each month. In preparing and updating the Progress Schedule, the Contractor shall take into consideration but not be bound by the scheduling and other information submitted by the other contractors and subcontractors.
 - 2. The Progress Schedule shall be manpower loaded and shall include a schedule of the submission of Shop Drawings, Product Data, and Samples.
 - 3. The Contractor shall, on a weekly basis, prepare and submit to the Engineer a written report describing the activities begun or finished during the preceding week, Work in progress, expected completion of the Work, a look-ahead projection of all activities to be started or finished in the upcoming two (2) weeks, including without limitation the Contractor's workforce crew size and total resource hours associated with such Work and any other information requested by the Engineer.

4. The float in the Progress Schedule and any updates to it shall belong to the Owner. Float shall mean the amount of time by which activities may be delayed without affecting the Contract date for Substantial Completion.
- C. The Contractor's obligation to furnish requested scheduling information is a material term of its Contract. If the Contractor fails to furnish requested scheduling information in writing within five (5) days of a request for such information from the Design Professional or Owner, the Contractor shall pay and the Owner may withhold from the Contractor Liquidated Damages at the rate of Fifty Dollars (\$50.00) a day for each calendar day thereafter that the Contractor fails to furnish the requested information.
- D. THE PERIODS OF TIME IN THE PROJECT CONSTRUCTION SCHEDULE ARE OF THE ESSENCE TO THIS CONTRACT. THE CONTRACTOR SHALL PROSECUTE ITS WORK IN ACCORDANCE WITH THE CURRENT PROJECT CONSTRUCTION SCHEDULE.

2.04 *Preconstruction Conference; Designation of Authorized Representatives*

- A. Before any Work at the Site is started, a conference attended by Owner, Contractor, Engineer, and others as appropriate will be held to establish a working understanding among the parties as to the Work and to discuss the schedules referred to in Paragraph 2.03.A, procedures for handling Shop Drawings, Samples, and other submittals, processing Applications for Payment, electronic or digital transmittals, and maintaining required records.
- B. At this conference the Contractor shall designate, in writing, a specific individual to act as its authorized representative with respect to the services and responsibilities under the Contract. Such individuals shall have the authority to transmit and receive information, render decisions relative to the Contract, and otherwise act on behalf of each respective party.

2.05 *Initial Acceptance of Schedules*

- A. At least 10 days before submission of the first Application for Payment a conference, attended by Contractor, Engineer, and others as appropriate, will be held to review for acceptability to Engineer as provided below the schedules submitted in accordance with Paragraph 2.03.A. Contractor shall have an additional 10 days to make corrections and adjustments and to complete and resubmit the schedules. No progress payment shall be made to Contractor until acceptable schedules are submitted to Engineer.
 1. The Progress Schedule will be acceptable to Engineer if it provides an orderly progression of the Work to completion within the Contract Times. Such acceptance will not impose on Engineer responsibility for the Progress Schedule, for sequencing, scheduling, or progress of the Work, nor interfere with or relieve Contractor from Contractor's full responsibility therefor.
 2. Contractor's Schedule of Submittals will be acceptable to Engineer if it provides a workable arrangement for reviewing and processing the required submittals.
 3. Contractor's Schedule of Values will be acceptable to Engineer as to form and substance if it provides a reasonable allocation of the Contract Price to the component parts of the Work. Once approved by the Engineer, the Contractor will not change the allocation of the Contract Price to the component parts of the Work without the Engineer's written approval. The Engineer thereafter may from time to time require the Contractor to adjust such schedule if the Engineer determines it to be in any way unreasonable or inaccurate. The Contractor then

shall adjust the schedule of values as required by the Engineer within ten (10) days.

2.06 *Electronic Transmittals*

- A. Except as otherwise stated elsewhere in the Contract, the Owner, Engineer, and Contractor may transmit, and shall accept, Project-related correspondence, text, data, documents, drawings, information, and graphics, including but not limited to Shop Drawings and other submittals, in electronic media or digital format, either directly, or through access to a secure Project website.
- B. If the Contract does not establish protocols for electronic or digital transmittals, then Owner, Engineer, and Contractor may jointly develop such protocols.
- C. When transmitting items in electronic media or digital format, the transmitting party makes no representations as to long term compatibility, usability, or readability of the items resulting from the recipient's use of software application packages, operating systems, or computer hardware differing from those used in the drafting or transmittal of the items, or from those established in applicable transmittal protocols.

ARTICLE 3 – DOCUMENTS: INTENT, REQUIREMENTS, REUSE

3.01 *Intent*

- A. The Contract Documents are complementary; what is required by one is as binding as if required by all.
- B. It is the intent of the Contract Documents to describe a functionally complete project (or part thereof) to be constructed in accordance with the Contract Documents. Any labor, documentation, services, materials, or equipment that may reasonably be inferred from the Contract Documents or from prevailing custom or trade usage as being required to produce the intended result will be provided whether or not specifically called for at no additional cost to Owner.
- C. Unless otherwise stated in the Contract Documents, if there is a discrepancy between the electronic or digital versions of the Contract Documents (including any printed copies derived from such electronic or digital versions) and the printed record version, the printed record version shall govern.
- D. The Contract supersedes prior negotiations, representations, and agreements, whether written or oral.
- E. Engineer will issue clarifications and interpretations of the Contract Documents as provided herein.

3.02 *Reference Standards*

- A. Standards Specifications, Codes, Laws and Regulations
 - 1. Reference in the Contract Documents to standard specifications, manuals, reference standards, or codes of any technical society, organization, or association, or to Laws or Regulations, whether such reference be specific or by implication, shall mean the standard specification, manual, reference standard, code, or Laws or Regulations in effect at the time of opening of Bids (or on the Effective Date of the Contract if there were no Bids), except as may be otherwise specifically stated in the Contract Documents.

2. No provision of any such standard specification, manual, reference standard, or code, or any instruction of a Supplier, shall be effective to change the duties or responsibilities of Owner, Contractor, or Engineer, or any of their subcontractors, consultants, agents, or employees, from those set forth in the part of the Contract Documents prepared by or for Engineer. No such provision or instruction shall be effective to assign to Owner, Engineer, or any of their officers, directors, members, partners, employees, agents, consultants, or subcontractors, any duty or authority to supervise or direct the performance of the Work or any duty or authority to undertake responsibility inconsistent with the provisions of the part of the Contract Documents prepared by or for Engineer.

3.03 *Reporting and Resolving Discrepancies*

A. *Reporting Discrepancies:*

1. *Contractor's Verification of Figures and Field Measurements:* In addition to its obligations under the Information and Requirements for Bidders, before undertaking each part of the Work, Contractor shall carefully study the Contract Documents, and check and verify pertinent figures and dimensions therein, particularly with respect to applicable field measurements. Contractor shall promptly report in writing to Engineer any conflict, error, ambiguity, or discrepancy that Contractor discovers, or has actual knowledge of, and shall not proceed with any Work affected thereby until the conflict, error, ambiguity, or discrepancy is resolved, by a clarification or interpretation by Engineer, or by an amendment or supplement to the Contract Documents issued pursuant to Paragraph 11.01.
2. *Contractor's Review of Contract Documents:* If, before or during the performance of the Work, Contractor discovers any conflict, error, ambiguity, or discrepancy within the Contract Documents, or between the Contract Documents and (a) any applicable Law or Regulation, (b) actual field conditions, (c) any standard specification, manual, reference standard, or code, or (d) any instruction of any Supplier, then Contractor shall promptly report it to Engineer in writing. Contractor shall not proceed with the Work affected thereby (except in an emergency as required by Paragraph 7.15) until the conflict, error, ambiguity, or discrepancy is resolved, by a clarification or interpretation by Engineer, or by an amendment or supplement to the Contract Documents issued pursuant to Paragraph 11.01.
3. Contractor shall not be liable to Owner or Engineer for failure to report any conflict, error, ambiguity, or discrepancy in the Contract Documents unless Contractor knew or reasonably should have known thereof or Contractor failed to perform its obligations under the Information and Requirements for Bidders.
4. In addition to its obligations under the Information and Requirements for Bidders, if Contractor proceeds with work that Contractor had actual knowledge or should have known that a conflict, error, ambiguity, or discrepancy existed as indicated above, correction of work constructed without such notification to Engineer shall be at Contractor's expense, (except in an emergency as authorized pursuant to the terms of the contract).

B. *Resolving Discrepancies:*

1. Except as may be otherwise specifically stated in the Contract Documents, the provisions of the part of the Contract Documents prepared by or for Engineer shall take precedence in resolving any conflict, error, ambiguity, or discrepancy between such provisions of the Contract Documents and:

- a. the provisions of any standard specification, manual, reference standard, or code, or the instruction of any Supplier (whether or not specifically incorporated by reference as a Contract Document); or
 - b. the provisions of any Laws or Regulations applicable to the performance of the Work (unless such an interpretation of the provisions of the Contract Documents would result in violation of such Law or Regulation).
2. Within the Contract Documents, requirements of the Agreement shall take precedence over the Modified General Conditions, which shall take precedence over the Specifications, which shall take precedence over the Drawings.
 3. Within a particular Contract Document, figure dimensions on Drawings shall take precedence over general Drawings. Specific instructions or specifications shall take precedence over general instructions or specifications.

3.04 *Requirements of the Contract Documents*

- A. During the performance of the Work and until final payment, Contractor and Owner shall submit to the Engineer all matters in question concerning the requirements of the Contract Documents (sometimes referred to as requests for information or interpretation—RFIs), or relating to the acceptability of the Work under the Contract Documents, as soon as possible after such matters arise. Engineer will be the initial interpreter of the requirements of the Contract Documents, and judge of the acceptability of the Work thereunder.
- B. Engineer will, with reasonable promptness, render a written clarification, interpretation, or decision on the issue submitted, or initiate an amendment or supplement to the Contract Documents. Engineer's written clarification, interpretation, or decision will be final and binding on Contractor, unless it appeals by submitting a Change Proposal, and on Owner, unless it appeals by filing a Claim.
- C. If a submitted matter in question concerns terms and conditions of the Contract Documents that do not involve (1) the performance or acceptability of the Work under the Contract Documents, (2) the design (as set forth in the Drawings, Specifications, or otherwise), or (3) other engineering or technical matters, then Engineer will promptly give written notice to Owner and Contractor that Engineer is unable to provide a decision or interpretation. If Owner and Contractor are unable to agree on resolution of such a matter in question, either party may pursue resolution as provided in Article 12.

3.05 *Reuse of Documents*

- A. Contractor and its Subcontractors and Suppliers shall not:
 1. have or acquire any title to or ownership rights in any of the Drawings, Specifications, or other documents (or copies of any thereof) prepared by or bearing the seal of Engineer or its consultants, including electronic media editions, or reuse any such Drawings, Specifications, other documents, or copies thereof on extensions of the Project or any other project without written consent of Owner and Engineer and specific written verification or adaptation by Engineer; or
 2. have or acquire any title or ownership rights in any other Contract Documents, reuse any such Contract Documents for any purpose without Owner's express written consent, or violate any copyrights pertaining to such Contract Documents.

- B. The prohibitions of this Paragraph 3.05 will survive final payment, or termination of the Contract. Nothing herein shall preclude Contractor from retaining copies of the Contract Documents for record purposes.

ARTICLE 4 – COMMENCEMENT AND PROGRESS OF THE WORK

4.01 *Commencement of Contract Times; Notice to Proceed*

- A. The Contract Times will commence to run on the Effective Date of the Contract or, if a Notice to Proceed is given, on the day indicated in the Notice to Proceed. A Notice to Proceed may be given at any time within 60 days after the date bids are received for the Project. In no event will the Contract Times commence to run later than the sixtieth day after the day of Bid opening unless mutually agreed to by the Owner and Contractor.

4.02 *Starting the Work*

- A. Contractor shall start to perform the Work on the date when the Contract Times commence to run. No Work shall be done at the Site prior to such date.

4.03 *Reference Points*

- A. Owner shall provide engineering surveys to establish reference points for construction which in Engineer's judgment are necessary to enable Contractor to proceed with the Work. Contractor shall be responsible for laying out the Work, shall protect and preserve the established reference points and property monuments, and shall make no changes or relocations without the prior written approval of Owner. Contractor shall report to Engineer whenever any reference point or property monument is lost or destroyed or requires relocation because of necessary changes in grades or locations, and shall be responsible for the accurate replacement or relocation of such reference points or property monuments by professionally qualified personnel.

4.04 *Progress Schedule*

- A. Contractor shall adhere to the Progress Schedule established in accordance with Paragraph 2.05 as it may be adjusted from time to time as provided below.
 - 1. Contractor shall submit to Engineer for acceptance (to the extent indicated in Paragraph 2.05) proposed adjustments in the Progress Schedule that will not result in changing the Contract Times.
 - 2. Proposed adjustments in the Progress Schedule that will change the Contract Times shall be submitted in accordance with the requirements of Article 11.
- B. Contractor shall carry on the Work and adhere to the Progress Schedule during all disputes or disagreements with Owner. No Work shall be delayed or postponed pending resolution of any disputes or disagreements, or during any appeal process, except as permitted by Paragraph 16.04, or as Owner and Contractor may otherwise agree in writing.
- C. The float in the Progress Schedule and any updates to it shall belong to Owner. Float shall mean the amount of time by which activities may be delayed without affecting the Contract Date for Substantial Completion.

4.05 *Delays in Contractor's Progress*

- A. If Owner, Engineer, or anyone for whom Owner is responsible, delays, disrupts, or interferes with the performance or progress of the Work, then Contractor shall be

entitled to an equitable adjustment in the Contract Times and Contract Price provided the Contractor timely submits a Change Proposal as required by the Contract. Contractor's entitlement to an adjustment of the Contract Times is conditioned on such adjustment being essential to Contractor's ability to complete the Work within the Contract Times.

- B. Contractor shall not be entitled to an adjustment in Contract Price or Contract Times for delay, disruption, or interference caused by or within the control of Contractor. Delay, disruption, and interference attributable to and within the control of a Subcontractor or Supplier, of any tier, shall be deemed to be within the control of Contractor.
- C. If Contractor's performance or progress is delayed, disrupted, or interfered with by unanticipated causes not the fault of and beyond the control of Owner, Contractor, and those for which they are responsible, then Contractor shall be entitled to an equitable adjustment in Contract Times provided the Contractor timely submits a Change Proposal as required by the Contract. Contractor's entitlement to an adjustment of the Contract Times is conditioned on such adjustment being essential to Contractor's ability to complete the Work within the Contract Times. Such an adjustment shall be Contractor's sole and exclusive remedy for the delays, disruption, and interference described in this paragraph. Causes of delay, disruption, or interference that may give rise to an adjustment in Contract Times under this paragraph include but are not limited to the following:
 - 1. severe and unavoidable natural catastrophes such as fires, floods, epidemics, and earthquakes;
 - 2. abnormal weather conditions;
 - 3. acts or failures to act of utility owners (other than those performing other work at or adjacent to the Site by arrangement with the Owner, as contemplated in Article 8); and
 - 4. acts of war or terrorism.
- D. Delays, disruption, and interference to the performance or progress of the Work resulting from the existence of a differing subsurface or physical condition, an Underground Facility that was not shown or indicated by the Contract Documents, or not shown or indicated with reasonable accuracy, and those resulting from Hazardous Environmental Conditions, are governed by Article 5.
- E. Paragraph 8.03 governs delays, disruption, and interference to the performance or progress of the Work resulting from the performance of certain other work at or adjacent to the Site.
- F. Contractor shall not be entitled to an adjustment in Contract Price or Contract Times for any delay, disruption, or interference if such delay is concurrent with a delay, disruption, or interference caused by or within the control of Contractor.
- G. Contractor must submit any Change Proposal seeking an adjustment in Contract Price or Contract Times under this paragraph within 30 days of the commencement of the delaying, disrupting, or interfering event. Contractor's failure to timely submit a Change Proposal within this 30-day time period shall constitute an irrevocable waiver of Contractor's right to an adjustment of the Contract Times or Contract Price.
- H. **Weather Delays.** When the Contractor is prevented from completing any part of the Work on the critical path within the Contract Time due to weather conditions, if a

Change Proposal is made therefor as provided in the Contract, the Contract Times will be extended by one (1) day for each work day lost due to weather that delays Work on the critical path in excess of those in the following table:

Month	Workdays Lost Due To Weather
January	8
February	8
March	7
April	6
May	5
June	5
July	4
August	4
September	5
October	5
November	5
December	6

- I. The Contractor acknowledges and agrees that the Owner and/or parties in privity of contract with the Owner may delay, interfere with and/or disrupt the Contractor's Work, and such actions shall not constitute a breach of contract by the Owner, since the Contractor is entitled to additional compensation by properly pursuing a Change Proposal and Claim as permitted by these Modified General Conditions. Pending the final resolution of a Claim, the Contractor shall continue performance of the Work.
- J. If the Owner determines that the performance of the Work has not progressed such that it is likely that the Contractor will not substantially complete its Work by its Date for Substantial Completion based upon the Contractor's failure to achieve specific milestone dates contained within the Progress Schedule, the Owner shall have the right to order the Contractor to take corrective measures necessary to expedite the Work, including, without limitation: (i) working additional shifts or overtime; (ii) supplying additional manpower, equipment, and facilities; and (iii) other similar measures (collectively referred to as "Corrective Measures"). If the Owner orders the Contractor to take such corrective measures, and regardless of any claims, disputes or objections, the Contractor shall take and continue such Corrective Measures until the Owner is satisfied that the Contractor is likely to substantially complete its Work by its Date for Substantial Completion.
 1. The Contractor shall not be entitled to adjustment in the Contract Sum in connection with the Corrective Measures required by the Owner pursuant to Paragraph 4.05(J), unless the Contractor is able to establish that it is entitled to additional compensation under other terms of the Contract Documents.

ARTICLE 5 – AVAILABILITY OF LANDS; SUBSURFACE AND PHYSICAL CONDITIONS; HAZARDOUS ENVIRONMENTAL CONDITIONS

5.01 *Availability of Lands*

- A. Owner shall furnish the Site. Owner shall notify Contractor of any encumbrances or restrictions not of general application but specifically related to use of the Site with which Contractor must comply in performing the Work.
- B. Upon reasonable request, Owner shall furnish Contractor with a Notice of Commencement prepared for the Project, conforming to the provisions of Ohio Revised Code Section 1311.252.
- C. Contractor shall provide for all additional lands and access thereto that may be required for temporary construction facilities or storage of materials and equipment.

5.02 *Use of Site and Other Areas*

- A. *Limitation on Use of Site and Other Areas:*
 - 1. Contractor shall confine construction equipment, temporary construction facilities, the storage of materials and equipment, and the operations of workers to the Site, adjacent areas that Contractor has arranged to use through construction easements or otherwise, and other adjacent areas permitted by Laws and Regulations, and shall not unreasonably encumber the Site and such other adjacent areas with construction equipment or other materials or equipment. Contractor shall assume full responsibility for (a) damage to the Site; (b) damage to any such other adjacent areas used for Contractor's operations; (c) damage to any other adjacent land or areas; and (d) for injuries and losses sustained by the owners or occupants of any such land or areas; provided that such damage or injuries result from the performance of the Work or from other actions or conduct of the Contractor or those for which Contractor is responsible.
 - 2. If a damage or injury claim is made by the owner or occupant of any such land or area because of the performance of the Work, or because of other actions or conduct of the Contractor or those for which Contractor is responsible, Contractor shall (a) take immediate corrective or remedial action as required by Paragraph 7.12, or otherwise; (b) promptly attempt to settle the claim as to all parties through negotiations with such owner or occupant, or otherwise resolve the claim by arbitration or other dispute resolution proceeding, or at law; and (c) to the fullest extent permitted by Laws and Regulations, indemnify and hold harmless Owner and Engineer, and the officers, directors, members, partners, employees, agents, consultants and subcontractors of each and any of them from and against any such claim, and against all costs, losses, and damages (including but not limited to all fees and charges of engineers, architects, attorneys, and other professionals and all court or arbitration or other dispute resolution costs) arising out of or relating to any claim or action, legal or equitable, brought by any such owner or occupant against Owner, Engineer, or any other party indemnified hereunder to the extent caused directly or indirectly, in whole or in part by, or based upon, Contractor's performance of the Work, or because of other actions or conduct of the Contractor or those for which Contractor is responsible.
- B. *Removal of Debris During Performance of the Work:* During the progress of the Work the Contractor shall keep the Site and other adjacent areas free from accumulations of waste materials, rubbish, and other debris. Removal and disposal of such waste

materials, rubbish, and other debris shall conform to applicable Laws and Regulations.

- C. *Cleaning:* Prior to Substantial Completion of the Work Contractor shall clean the Site and the Work and make it ready for utilization by Owner. At the completion of the Work Contractor shall remove from the Site and adjacent areas all tools, appliances, construction equipment and machinery, and surplus materials and shall restore to original condition all property not designated for alteration by the Contract Documents.
- D. *Loading of Structures:* Contractor shall not load nor permit any part of any structure to be loaded in any manner that will endanger the structure, nor shall Contractor subject any part of the Work or adjacent structures or land to stresses or pressures that will endanger them.

5.03 *Subsurface and Physical Conditions*

- A. *Reports and Drawings:* The Contract identifies:
 - 1. those reports known to Owner of explorations and tests of subsurface conditions at or adjacent to the Site;
 - 2. those drawings known to Owner of physical conditions relating to existing surface or subsurface structures at the Site (except Underground Facilities); and
 - 3. Technical Data contained in such reports and drawings.
- B. *Reliance by Contractor on Technical Data Authorized:* Contractor may rely upon the general accuracy of the Technical Data expressly identified in the Supplementary Conditions with respect to such reports and drawings, but such reports and drawings are not Contract Documents. If no such express identification has been made, then Contractor may rely upon the accuracy of the Technical Data (as defined in Article 1) contained in any geotechnical or environmental report prepared for the Project and made available to Contractor. Except for such reliance on Technical Data, Contractor may not rely upon or make any claim against Owner or Engineer, or any of their officers, directors, members, partners, employees, agents, consultants, or subcontractors, with respect to:
 - 1. the completeness of such reports and drawings for Contractor's purposes, including, but not limited to, any aspects of the means, methods, techniques, sequences, and procedures of construction to be employed by Contractor, and safety precautions and programs incident thereto; or
 - 2. other data, interpretations, opinions, and information contained in such reports or shown or indicated in such drawings; or
 - 3. any Contractor interpretation of or conclusion drawn from any Technical Data or any such other data, interpretations, opinions, or information.
- C. It is possible that there may be other reports and/or tests of subsurface conditions at or contiguous to the Site. The Owner makes no representation about such reports and/or tests, assuming they exist. For example, all interpolations and extrapolations of data performed by Contractor to estimate locations or quantities of subsurface strata are independent factual assumptions, which Owner does not warrant.

5.04 *Differing Subsurface or Physical Conditions*

- A. *Notice by Contractor.* If Contractor believes that any subsurface or physical condition that is uncovered or revealed at the Site either:
1. is of such a nature as to establish that any Technical Data on which Contractor is entitled to rely as provided in Paragraph 5.03 is materially inaccurate; or
 2. is of such a nature as to require a change in the Drawings or Specifications; or
 3. differs materially from that shown or indicated in the Contract Documents; or
 4. is of an unusual nature, and differs materially from conditions ordinarily encountered and generally recognized as inherent in work of the character provided for in the Contract Documents;

then Contractor shall, as a condition precedent to any increase in the Contract Price and/or an extension of the Contract Times, promptly and within no more than 48 hours after becoming aware thereof, and before further disturbing the subsurface or physical conditions or performing any Work in connection therewith (except in an emergency as required by Paragraph 7.15), notify Owner and Engineer in writing about such condition. Contractor shall not further disturb such condition or perform any Work in connection therewith (except with respect to an emergency) until receipt of a written statement permitting Contractor to do so. If Contractor fails to notify Owner and Engineer within the time required by this Paragraph 5.04.A, Contractor irrevocable waives any right to a Contract Price and Contract Time Adjustment under Paragraph 5.04.C.

- B. *Engineer's Review.* After receipt of written notice as required by the preceding paragraph, Engineer will promptly review the subsurface or physical condition in question; determine the necessity of Owner's obtaining additional exploration or tests with respect to the condition; conclude whether the condition falls within any one or more of the differing site condition categories in Paragraph 5.04.A above; obtain any pertinent cost or schedule information from Contractor; prepare recommendations to Owner regarding the Contractor's resumption of Work in connection with the subsurface or physical condition in question and the need for any change in the Drawings or Specifications; and advise Owner in writing, with a copy to the Contractor, of Engineer's findings, conclusions, and recommendations.
- C. *Possible Price and Times Adjustments:*
1. Contractor shall be entitled to an equitable adjustment in Contract Price or Contract Times, or both, to the extent that the existence of a differing subsurface or physical condition, or any related delay, disruption, or interference, causes an increase or decrease in Contractor's cost of, or time required for, performance of the Work; subject, however, to the following:
 - a. such condition must fall within any one or more of the categories described in Paragraph 5.04.A;
 - b. with respect to Work that is paid for on a unit price basis, any adjustment in Contract Price will be subject to the provisions of Paragraph 13.03; and,
 - c. Contractor's entitlement to an adjustment of the Contract Times is conditioned on such adjustment being essential to Contractor's ability to complete the Work within the Contract Times.

2. Contractor shall not be entitled to any adjustment in the Contract Price or Contract Times with respect to a subsurface or physical condition if:
 - a. Contractor knew or should have known of the existence of such condition at the time Contractor made a commitment to Owner with respect to Contract Price and Contract Times by the submission of a Bid or becoming bound under a negotiated contract, or otherwise; or
 - b. the existence of such condition reasonably could have been discovered or revealed as a result of any examination, investigation, exploration, test, or study of the Site and contiguous areas expressly required by the Bidding Requirements or Contract Documents to be conducted by or for Contractor prior to Contractor's making such commitment; or
 - c. Contractor failed to give the written notice as required by Paragraph 5.04.A and failed to submit a Change Proposal within 30 days of issuance of the Engineer's review.
3. If Owner and Contractor agree regarding Contractor's entitlement to and the amount or extent of any adjustment in the Contract Price or Contract Times, or both, then any such adjustment shall be set forth in a Change Order.
4. Contractor shall submit a Change Proposal regarding its entitlement to or the amount or extent of any adjustment in the Contract Price or Contract Times, or both, no later than 30 days after issuance of the Engineer's review regarding the subsurface or physical condition in question.

5.05 *Underground Facilities*

- A. *Contractor's Responsibilities:* The information and data shown or indicated in the Contract Documents with respect to existing Underground Facilities at or adjacent to the Site is based on information and data furnished to Owner or Engineer by the owners of such Underground Facilities, including Owner, or by others. Unless it is otherwise expressly provided in the Modified General Conditions:
 1. Owner and Engineer do not warrant or guarantee the accuracy or completeness of any such information or data; and
 2. the cost of all of the following will be included in the Contract Price, and Contractor shall have full responsibility for:
 - a. reviewing and checking all information and data regarding existing Underground Facilities at the Site;
 - b. locating all Underground Facilities shown or indicated in the Contract Documents as being at the Site protecting all Underground Facilities in a manner at least as cautious and protective of safety and of underground facilities as those methods identified in Ohio Revised Code Sections 3781.25 and 3781.30;
 - c. coordination of the Work with the owners (including Owner) of such Underground Facilities, during construction; and
 - d. the safety and protection of all existing Underground Facilities at the Site, and repairing any damage thereto resulting from the Work.
- B. *Notice by Contractor:* If Contractor believes that an Underground Facility that is uncovered or revealed at the Site was not shown or indicated in the Contract Documents, or was not shown or indicated with reasonable accuracy, then Contractor

shall, promptly after becoming aware thereof and before further disturbing conditions affected thereby or performing any Work in connection therewith (except in an emergency as required by Paragraph 7.15), identify the owner of such Underground Facility and give written notice to that owner and to Owner and Engineer.

- C. *Engineer's Review:* Engineer will promptly review the Underground Facility and conclude whether such Underground Facility was not shown or indicated in the Contract Documents, or was not shown or indicated with reasonable accuracy; obtain any pertinent cost or schedule information from Contractor; prepare recommendations to Owner regarding the Contractor's resumption of Work in connection with the Underground Facility in question; determine the extent, if any, to which a change is required in the Drawings or Specifications to reflect and document the consequences of the existence or location of the Underground Facility; and advise Owner in writing, with a copy to the Contractor, of Engineer's findings, conclusions, and recommendations. During such time, Contractor shall be responsible for the safety and protection of such Underground Facility.
- D. *Possible Price and Times Adjustments:*
 - 1. Contractor shall be entitled to an equitable adjustment in the Contract Price or Contract Times, or both, to the extent that any existing Underground Facility at the Site that was not shown or indicated in the Contract Documents, or was not shown or indicated with reasonable accuracy, or any related delay, disruption, or interference, causes an increase or decrease in Contractor's cost of, or time required for, performance of the Work; subject, however, to the following:
 - a. Contractor did not know of and could not reasonably have been expected to be aware of or to have anticipated the existence or actual location of the Underground Facility in question;
 - b. With respect to Work that is paid for on a unit price basis, any adjustment in Contract Price will be subject to the provisions of Paragraph 13.03;
 - c. Contractor's entitlement to an adjustment of the Contract Times is conditioned on such adjustment being essential to Contractor's ability to complete the Work within the Contract Times; and
 - d. Contractor gave the notice required in Paragraph 5.05.B and submitted a Change Proposal no later than 30 days after issuance of the Engineer's review.
 - 2. If Owner and Contractor agree regarding Contractor's entitlement to and the amount or extent of any adjustment in the Contract Price or Contract Times, or both, then any such adjustment shall be set forth in a Change Order.
 - 3. Contractor shall submit a Change Proposal regarding its entitlement to or the amount or extent of any adjustment in the Contract Price or Contract Times, or both, no later than 30 days after Engineer's issuance of the Engineer's Review to Contractor regarding the Underground Facility in question.

5.06 *Hazardous Environmental Conditions at Site*

- A. *Reports and Drawings:* The Supplementary Conditions identify:
 - 1. those reports and drawings known to Owner relating to Hazardous Environmental Conditions that have been identified at or adjacent to the Site; and
 - 2. Technical Data contained in such reports and drawings.

- B. *Reliance by Contractor on Technical Data Authorized:* Contractor may rely upon the accuracy of the Technical Data expressly identified in the Supplementary Conditions with respect to such reports and drawings, but such reports and drawings are not Contract Documents. If no such express identification has been made, then Contractor may rely on the accuracy of the Technical Data (as defined in Article 1) contained in any geotechnical or environmental report prepared for the Project and made available to Contractor. Except for such reliance on Technical Data, Contractor may not rely upon or make any claim against Owner or Engineer, or any of their officers, directors, members, partners, employees, agents, consultants, or subcontractors with respect to:
1. the completeness of such reports and drawings for Contractor's purposes, including, but not limited to, any aspects of the means, methods, techniques, sequences and procedures of construction to be employed by Contractor and safety precautions and programs incident thereto; or
 2. other data, interpretations, opinions and information contained in such reports or shown or indicated in such drawings; or
 3. any Contractor interpretation of or conclusion drawn from any Technical Data or any such other data, interpretations, opinions or information.
- C. Contractor shall not be responsible for removing or remediating any Hazardous Environmental Condition encountered, uncovered, or revealed at the Site unless such removal or remediation is expressly identified in the Contract Documents to be within the scope of the Work.
- D. Contractor shall be responsible for controlling, containing, and duly removing all Constituents of Concern brought to the Site by Contractor, Subcontractors, Suppliers, or anyone else for whom Contractor is responsible, and for any associated costs; and for the costs of removing and remediating any Hazardous Environmental Condition created by the presence of any such Constituents of Concern.
- E. If Contractor encounters, uncovers, or reveals a Hazardous Environmental Condition whose removal or remediation is not expressly identified in the Contract Documents as being within the scope of the Work, or if Contractor or anyone for whom Contractor is responsible creates a Hazardous Environmental Condition, then Contractor shall immediately: (1) secure or otherwise isolate such condition; (2) stop all Work in connection with such condition and in any area affected thereby (except in an emergency as required by Paragraph 7.15); and (3) notify Owner and Engineer (and promptly thereafter confirm such notice in writing). Owner shall promptly consult with Engineer concerning the necessity for Owner to retain a qualified expert to evaluate such condition or take corrective action, if any. Promptly after consulting with Engineer, Owner shall take such actions as are necessary to permit Owner to timely obtain required permits and provide Contractor the written notice required by Paragraph 5.06.F. If Contractor or anyone for whom Contractor is responsible created the Hazardous Environmental Condition in question, then Owner may remove and remediate the Hazardous Environmental Condition, and impose a set-off against payments to account for the associated costs. If Contractor fails to notify Owner and Engineer within the time required by this Paragraph 5.06.E, Contractor waives any right to a Contract Price and Contract Time Adjustment.
- F. Contractor shall not resume Work in connection with such Hazardous Environmental Condition or in any affected area until after Owner has obtained any required permits related thereto, and delivered written notice to Contractor either (1) specifying that

such condition and any affected area is or has been rendered safe for the resumption of Work, or (2) specifying any special conditions under which such Work may be resumed safely.

- G. If Owner and Contractor cannot agree as to entitlement to or on the amount or extent, if any, of any adjustment in Contract Price or Contract Times, or both, as a result of such Work stoppage or such special conditions under which Work is agreed to be resumed by Contractor, then within 30 days of Owner's written notice regarding the resumption of Work, Contractor may submit a Change Proposal, or Owner may impose a set-off.
- H. If after receipt of such written notice Contractor does not agree to resume such Work based on a reasonable belief it is unsafe, or does not agree to resume such Work under such special conditions, then Owner may order the portion of the Work that is in the area affected by such condition to be deleted from the Work, following the contractual change procedures in Article 11. Owner may have such deleted portion of the Work performed by Owner's own forces or others in accordance with Article 8.
- I. To the extent permitted by Laws and Regulations, Owner shall indemnify and hold harmless Contractor, Subcontractors, and Engineer, and the officers, directors, members, partners, employees, agents, consultants, and subcontractors of each and any of them from and against all claims, costs, losses, and damages (including but not limited to all fees and charges of engineers, architects, attorneys, and other professionals and all court or arbitration or other dispute resolution costs) arising out of or relating to a Hazardous Environmental Condition, provided that such Hazardous Environmental Condition (1) was not shown or indicated in the Drawings, Specifications, or other Contract Documents, identified as Technical Data entitled to limited reliance pursuant to Paragraph 5.06.B, or identified in the Contract Documents to be included within the scope of the Work, and (2) was not created by Contractor or by anyone for whom Contractor is responsible. Nothing in this Paragraph 5.06.H shall obligate Owner to indemnify any individual or entity from and against the consequences of that individual's or entity's own negligence. Such obligation shall be limited to the limits of Owner's insurance coverage for such loss.
- J. To the fullest extent permitted by Laws and Regulations, Contractor shall indemnify and hold harmless Owner and Engineer, and the officers, directors, members, partners, employees, agents, consultants, and subcontractors of each and any of them from and against all claims, costs, losses, and damages (including but not limited to all fees and charges of engineers, architects, attorneys, and other professionals and all court or arbitration or other dispute resolution costs) arising out of or relating to the failure to control, contain, or remove a Constituent of Concern brought to the Site by Contractor or by anyone for whom Contractor is responsible, or to a Hazardous Environmental Condition created by Contractor or by anyone for whom Contractor is responsible. Nothing in this Paragraph 5.06.J shall obligate Contractor to indemnify any individual or entity from and against the consequences of that individual's or entity's own negligence.
- K. The provisions of Paragraphs 5.03, 5.04, and 5.05 do not apply to the presence of Constituents of Concern or to a Hazardous Environmental Condition uncovered or revealed at the Site.

ARTICLE 6 – BONDS AND INSURANCE

6.01 *Performance, Payment, and Other Bonds*

- A. Contractor shall furnish a performance bond and payment bond, in an amount equal to the Contract Price, as security for the faithful performance and payment of all of Contractor's obligations under the Contract. Such bond shall be in the form that meets the requirements of the Ohio Revised Code. If the Contractor submitted a combined Bid Guaranty and Contract Bond with its bid for the Work, that form of Bond shall satisfy the Contractor's requirement to provide a Contract Bond. Contractor shall also furnish any other bonds as are required by the Contract Documents.
- B. All bonds shall be in the form prescribed by the Ohio Revised Code and shall be executed by such sureties as are named in "Companies Holding Certificates of Authority as Acceptable Sureties on Federal Bonds and as Acceptable Reinsuring Companies" as published in Circular 570 (as amended and supplemented) by the Financial Management Service, Surety Bond Branch, U.S. Department of the Treasury. A bond signed by an agent or attorney-in-fact must be accompanied by a certified copy of that individual's authority to bind the surety. The evidence of authority shall show that it is effective on the date the agent or attorney-in-fact signed the accompanying bond.
- C. Contractor shall obtain the required bonds from surety companies that are duly licensed or authorized in the jurisdiction in which the Project is located to issue bonds in the required amounts.
- D. If the surety on a bond furnished by Contractor is declared bankrupt or becomes insolvent, or its right to do business is terminated in any state or jurisdiction where any part of the Project is located, or the surety ceases to meet the requirements above, then Contractor shall promptly notify Owner and Engineer and shall, within 20 days after the event giving rise to such notification, provide another bond and surety, both of which shall comply with the bond and surety requirements above.
- E. If Contractor has failed to obtain a required bond, Owner may exclude the Contractor from the Site and exercise Owner's termination rights under Article 16.
- F. Upon request, Owner shall provide a copy of the payment bond to any Subcontractor, Supplier, or other person or entity claiming to have furnished labor or materials used in the performance of the Work.
- G. *Material Default or Termination.* If the Owner notifies the Contractor's surety that the Contractor is in material default, the surety will complete its investigation of the claimed material default within 21 days. The surety is advised to start looking for a replacement contractor upon notice of material default. As part of its investigation, the surety shall promptly visit the offices of the Contractor, Engineer, and Owner to inspect and copy the available Project records. The Owner, Engineer, and Contractor, upon written request by the surety, shall make such records available during regular business hours for such inspection and copying. The Owner and Engineer's making such records available as provided herein shall satisfy the Owner's obligation to the surety to furnish documents for the investigation. The surety will provide the Owner with the results of its investigation, including any written report or documents.

If the Owner terminates the Contract and the surety proposes to takeover the Work, the surety shall do so no later than the later of the expiration of the 21-day investigation period or 10 days after the date the Owner terminates the Contract, whichever is later. If the Owner terminates the Contract, and the surety proposes to

provide a replacement contractor, the replacement contractor shall be fully capable of performing the Work in accordance with the Contract Documents. If the Contractor is terminated for cause, the replacement contractor shall not be the Contractor or its employees, unless the Owner agrees in writing. In the event the Surety takes over the Project, the surety's obligation shall not be limited to the penal sum of the Bond.

If the surety does not propose an acceptable contractor as required by this Paragraph, the Owner may complete the Work by such means as it deems appropriate. In the event the Owner agrees to accept a replacement contractor, the replacement contractor shall furnish its own bond for the replacement contractor's scope of work, and neither the Contractor nor the surety shall be relieved of their obligations under the Contract Documents.

This Paragraph is in addition to any other rights of the Owner under the Contract Documents and is not intended to create any rights of the surety, including but not limited to the right to take over the Contractor's obligations.

In the event of the Contractor's termination and if the surety does not takeover the Work as provided in this Paragraph, the Owner may take possession of and use all materials, facilities and equipment at the Project Site or stored off-site for which Owner has paid in whole or in part.

6.02 *Insurance—General Provisions*

- A. Owner and Contractor shall obtain and maintain insurance as required in this Article and in the Supplementary Conditions.
- B. All insurance required by the Contract to be purchased and maintained by Owner or Contractor shall be obtained from insurance companies that are duly licensed or authorized, in the state or jurisdiction in which the Project is located, to issue insurance policies for the required limits and coverages. Unless a different standard is indicated in the Supplementary Conditions, all companies that provide insurance policies required under this Contract shall have an A.M. Best rating of A-VII or better.
- C. Contractor shall deliver to Owner, with copies to each named insured and additional insured (as identified in this Article, in the Supplementary Conditions, or elsewhere in the Contract), certificates of insurance establishing that Contractor has obtained and is maintaining the policies, coverages, and endorsements required by the Contract. Upon request by Owner or any other insured, Contractor shall also furnish other evidence of such required insurance, including but not limited to copies of policies and endorsements, and documentation of applicable self-insured retentions and deductibles. Contractor may block out (redact) any confidential premium or pricing information contained in any policy or endorsement furnished under this provision. Failure of Owner to demand such certificates or other evidence of full compliance with these insurance requirements or failure of Owner to identify a deficiency from evidence provided shall not be construed as a waiver of Contractor's obligation to maintain such insurance.
- D. Owner shall, upon the Contractor's request, deliver to Contractor, with copies to each named insured and additional insured (as identified in this Article, the Supplementary Conditions, or elsewhere in the Contract), certificates of insurance establishing that Owner has obtained and is maintaining the policies, coverages, and endorsements required of Owner by the Contract (if any). Upon request by Contractor or any other insured, Owner shall also provide other evidence of such required insurance (if any), including but not limited to copies of policies and endorsements, and documentation of applicable self-insured retentions and deductibles. Owner may block out (redact)

any confidential premium or pricing information contained in any policy or endorsement furnished under this provision.

- E. Failure of Owner or Contractor to demand such certificates or other evidence of the other party's full compliance with these insurance requirements, or failure of Owner or Contractor to identify a deficiency in compliance from the evidence provided, shall not be construed as a waiver of the other party's obligation to obtain and maintain such insurance.
- F. If either party does not purchase or maintain all of the insurance required of such party by the Contract, such party shall notify the other party in writing of such failure to purchase prior to the start of the Work, or of such failure to maintain prior to any change in the required coverage.
- G. If Contractor has failed to obtain and maintain required insurance, Owner may exclude the Contractor from the Site, impose an appropriate set-off against payment, and exercise Owner's termination rights under Article 16.
- H. Without prejudice to any other right or remedy, if a party has failed to obtain required insurance, the other party may elect to obtain equivalent insurance to protect such other party's interests at the expense of the party who was required to provide such coverage, and the Contract Price shall be adjusted accordingly.
- I. Owner does not represent that insurance coverage and limits established in this Contract necessarily will be adequate to protect Contractor or Contractor's interests.
- J. The insurance and insurance limits required herein shall not be deemed as a limitation on Contractor's liability under the indemnities granted to Owner and other individuals and entities in the Contract.
- K. The minimum limits of liability for the required insurance policies listed in Paragraph 6.03 shall not be less than the following unless a greater amount is required by law:
 - 1. Commercial General Liability ("CGL"): Bodily injury (including death and personal injury) and property damage with limits of \$1,000,000 each occurrence and \$2,000,000 aggregate. CGL shall include (i) Premises-Operations, (ii) Explosion and Collapse Hazard, (iii) Underground Hazard, (iv) Independent Contractors' Protective, (v) Broad Form Property Damage, including Completed Operations, (vi) Contractual Liability, (vii) Products and Completed Operations, (viii) Personal/Advertising Injury with Employment Exclusion deleted, (ix) Stopgap liability endorsement for \$1,000,000 limit, and (x) per project aggregate endorsement.
 - 2. Automobile Liability, covering all owned, non-owned, and hired vehicles used in connection with the Work: Bodily injury (including death and personal injury) and property damage with a combined single limit of \$1,000,000 per person and \$1,000,000 each accident.
 - 3. Such policies shall be supplemented by an umbrella policy, also written on an occurrence basis, to provide additional protection to provide coverage in the total amount of \$1,000,000 for each occurrence and \$1,000,000 aggregate for contracts with a Contract Price of \$250,000 or less; \$2,000,000 each occurrence and \$2,000,000 aggregate for contracts with a Contract Price greater than \$250,000 but less than or equal to \$500,000; \$3,000,000 each occurrence and \$3,000,000 aggregate for contracts with a Contract Price greater than \$500,000 but less than or equal to \$1,000,000; and \$5,000,000 each occurrence and

\$5,000,000 aggregate for contracts with a Contract Price greater than \$1,000,000.

6.03 *Contractor's Insurance*

- A. *Workers' Compensation*: Contractor shall purchase and maintain workers' compensation and employer's liability insurance for:
 - 1. claims under workers' compensation, disability benefits, and other similar employee benefit acts.
 - 2. United States Longshoreman and Harbor Workers' Compensation Act and Jones Act coverage (if applicable).
 - 3. claims for damages because of bodily injury, occupational sickness or disease, or death of Contractor's employees (by stop-gap endorsement in monopolist worker's compensation states).
 - 4. Foreign voluntary worker compensation (if applicable).
- B. *Commercial General Liability—Claims Covered*: Contractor shall purchase and maintain commercial general liability insurance, covering all operations by or on behalf of Contractor, on an occurrence basis, against:
 - 1. claims for damages because of bodily injury, sickness or disease, or death of any person other than Contractor's employees.
 - 2. claims for damages insured by reasonably available personal injury liability coverage.
 - 3. claims for damages, other than to the Work itself, because of injury to or destruction of tangible property wherever located, including loss of use resulting therefrom.
- C. *Commercial General Liability—Form and Content*: Contractor's commercial liability policy shall be written on a 1996 (or later) ISO commercial general liability form (occurrence form) and include the following coverages and endorsements:
 - 1. Products and completed operations coverage:
 - a. Such insurance shall be maintained for three years after final payment.
 - b. Contractor shall furnish Owner and each other additional insured (as identified in the Supplementary Conditions or elsewhere in the Contract) evidence of continuation of such insurance at final payment and three years thereafter.
 - 2. Blanket contractual liability coverage, to the extent permitted by law, including but not limited to coverage of Contractor's contractual indemnity obligations in Paragraph 7.18.
 - 3. Broad form property damage coverage.
 - 4. Severability of interest.
 - 5. Underground, explosion, and collapse coverage.
 - 6. Personal injury coverage.
 - 7. Additional insured endorsements that include both ongoing operations and products and completed operations coverage through ISO Endorsements CG 20

10 10 01 and CG 20 37 10 01 (together); or CG 20 10 07 04 and CG 20 37 07 04 (together); or their equivalent.

8. For design professional additional insureds, ISO Endorsement CG 20 32 07 04, "Additional Insured—Engineers, Architects or Surveyors Not Engaged by the Named Insured" or its equivalent.
- D. *Automobile liability*: Contractor shall purchase and maintain automobile liability insurance against claims for damages because of bodily injury or death of any person or property damage arising out of the ownership, maintenance, or use of any motor vehicle. The automobile liability policy shall be written on an occurrence basis.
- E. *Umbrella or excess liability*: Contractor shall purchase and maintain umbrella or excess liability insurance written over the underlying employer's liability, commercial general liability, and automobile liability insurance described in the paragraphs above. Subject to industry-standard exclusions, the coverage afforded shall follow form as to each and every one of the underlying policies.
- F. *Contractor's pollution liability insurance*: Contractor shall purchase and maintain a policy covering third-party injury and property damage claims, including clean-up costs, as a result of pollution conditions arising from Contractor's operations and completed operations. This insurance shall be maintained for no less than three years after final completion.
- G. *Additional insureds*: The Contractor's commercial general liability, automobile liability, umbrella or excess, and pollution liability policies shall include and list as additional insureds Owner and Engineer, and any individuals or entities identified in the Supplementary Conditions; include coverage for the respective officers, directors, members, partners, employees, agents, consultants, and subcontractors of each and any of all such additional insureds; and the insurance afforded to these additional insureds shall provide primary coverage for all claims covered thereby (including as applicable those arising from both ongoing and completed operations) on a non-contributory basis. Contractor shall obtain all necessary endorsements to support these requirements.
- H. *Contractor's professional liability insurance*: If Contractor will provide or furnish professional services under this Contract, through a delegation of professional design services or otherwise, then Contractor shall be responsible for purchasing and maintaining applicable professional liability insurance. This insurance shall provide protection against claims arising out of performance of professional design or related services, and caused by a negligent error, omission, or act for which the insured party is legally liable. It shall be maintained throughout the duration of the Contract and for a minimum of two years after Substantial Completion. If such professional design services are performed by a Subcontractor, and not by Contractor itself, then the requirements of this paragraph may be satisfied through the purchasing and maintenance of such insurance by such Subcontractor.
- I. *General provisions*: The policies of insurance required by this Paragraph 6.03 shall:
 1. include at least the specific coverages provided in this Article.
 2. be written for not less than the limits of liability provided in this Article and in the Supplementary Conditions, or required by Laws or Regulations, whichever is greater.
 3. contain a provision or endorsement that the coverage afforded will not be canceled, materially changed, or renewal refused until at least 30 days prior

written notice has been given to Contractor, Owner, and Engineer and each other insured under the policy.

4. remain in effect at least until final payment (and longer if expressly required in this Article) and at all times thereafter when Contractor may be correcting, removing, or replacing defective Work as a warranty or correction obligation, or otherwise, or returning to the Site to conduct other tasks arising from the Contract Documents.
 5. be appropriate for the Work being performed and provide protection from claims that may arise out of or result from Contractor's performance of the Work and Contractor's other obligations under the Contract Documents, whether it is to be performed by Contractor, any Subcontractor or Supplier, or by anyone directly or indirectly employed by any of them to perform any of the Work, or by anyone for whose acts any of them may be liable.
- J. The coverage requirements for specific policies of insurance must be met by such policies, and not by reference to excess or umbrella insurance provided in other policies.
6. Contractor's insurance shall be primary and non-contributory.
 7. Insurance policies shall be written on an occurrence basis only.
 8. The Contractor shall require all Subcontractors to provide Workers' Compensation, CGL, and Automobile Liability Insurance with the same minimum limits specified herein, unless the Owner agrees to a lesser amount.

6.04 *Owner's Liability Insurance*

- A. In addition to the insurance required to be provided by Contractor under Paragraph 6.03, Owner, at Owner's option, may purchase and maintain at Owner's expense Owner's own liability insurance as will protect Owner against claims which may arise from operations under the Contract Documents.
- B. Owner's liability policies, if any, operate separately and independently from policies required to be provided by Contractor, and Contractor cannot rely upon Owner's liability policies for any of Contractor's obligations to the Owner, Engineer, or third parties.

6.05 *Property Insurance*

- A. ***Builder's Risk:*** Contractor shall purchase and maintain builder's risk insurance upon the Work on a completed value basis, in the amount of the full insurable replacement cost thereof. Insurance shall be completed value form. This insurance shall:
 1. include the Owner and Contractor as named insureds, and all Subcontractors, and any individuals or entities required by the Supplementary Conditions to be insured under such builder's risk policy, as insureds or named insureds. For purposes of the remainder of this Paragraph 6.05, Paragraphs 6.06 and 6.07, and any corresponding Supplementary Conditions, the parties required to be insured shall collectively be referred to as "insureds." Insurance certificates shall specifically indicate by name the additional insureds which are to include Owner and Engineer as well as other individuals or entities so identified.
 2. be written on a builder's risk "all risk" policy form that shall at least include insurance for physical loss or damage to the Work, temporary buildings, falsework, and materials and equipment in transit, and shall insure against at

least the following perils or causes of loss: fire; lightning; windstorm; riot; civil commotion; terrorism; vehicle impact; aircraft; smoke; theft; vandalism and malicious mischief; mechanical breakdown, boiler explosion, and artificially generated electric current; earthquake; volcanic activity, and other earth movement; flood; collapse; explosion; debris removal; demolition occasioned by enforcement of Laws and Regulations; water damage (other than that caused by flood); and such other perils or causes of loss as may be specifically required by the Supplementary Conditions. If insurance against mechanical breakdown, boiler explosion, and artificially generated electric current; earthquake; volcanic activity, and other earth movement; or flood, are not commercially available under builder's risk policies, by endorsement or otherwise, such insurance may be provided through other insurance policies acceptable to Owner.

3. cover, as insured property, at least the following: (a) the Work and all materials, supplies, machinery, apparatus, equipment, fixtures, and other property of a similar nature that are to be incorporated into or used in the preparation, fabrication, construction, erection, or completion of the Work, including Owner-furnished or assigned property; (b) spare parts inventory required within the scope of the Contract; and (c) temporary works which are not intended to form part of the permanent constructed Work but which are intended to provide working access to the Site, or to the Work under construction, or which are intended to provide temporary support for the Work under construction, including scaffolding, form work, fences, shoring, falsework, and temporary structures.
 4. cover expenses incurred in the repair or replacement of any insured property (including but not limited to fees and charges of engineers and architects).
 5. cover the total value of materials and equipment supplied under the Contract from the time Contractor takes possession of them until they are installed and tested by Contractor and the project is accepted as complete by Owner under an endorsement to this policy or in the form of Installation Floater Insurance of the "all risk" type.
 6. extend to cover damage or loss to insured property while in transit.
 7. allow for partial occupation or use of the Work by Owner, such that those portions of the Work that are not yet occupied or used by Owner shall remain covered by the builder's risk insurance.
 8. allow for the waiver of the insurer's subrogation rights, as set forth below.
 9. provide primary coverage for all losses and damages caused by the perils or causes of loss covered.
 10. not include a co-insurance clause.
 11. include an exception for ensuing losses from physical damage or loss with respect to any defective workmanship, design, or materials exclusions.
 12. include performance/hot testing and start-up.
 13. be maintained in effect, subject to the provisions herein regarding Substantial Completion and partial occupancy or use of the Work by Owner, until the Work is complete.
- B. *Notice of Cancellation or Change:* All the policies of insurance (and the certificates or other evidence thereof) required to be purchased and maintained in accordance with this Paragraph 6.05 will contain a provision or endorsement that the coverage

afforded will not be canceled or materially changed or renewal refused until at least 10 days prior written notice has been given to the purchasing policyholder. Within three days of receipt of any such written notice, the purchasing policyholder shall provide a copy of the notice to each other insured.

- C. *Deductibles*: Contractor shall be responsible for any deductible or self-insured retention.
- D. *Partial Occupancy or Use by Owner*: If Owner will occupy or use a portion or portions of the Work prior to Substantial Completion of all the Work as provided in Paragraph 15.04, then Owner (through Contractor) will provide notice of such occupancy or use to the builder's risk insurer. The builder's risk insurance shall not be canceled or permitted to lapse on account of any such partial use or occupancy; rather, those portions of the Work that are occupied or used by Owner may come off the builder's risk policy, while those portions of the Work not yet occupied or used by Owner shall remain covered by the builder's risk insurance.
- E. *Additional Insurance*: If Contractor elects to obtain other special insurance to be included in or supplement the builder's risk or property insurance policies provided under this Paragraph 6.05, it may do so at Contractor's expense.
- F. *Insurance of Other Property*: If the express insurance provisions of the Contract do not require or address the insurance of a property item or interest, such as tools, construction equipment, or other personal property owned by Contractor, a Subcontractor, or an employee of Contractor or a Subcontractor, then the entity or individual owning such property item will be responsible for deciding whether to insure it, and if so in what amount.
- G. *Payment of Deductible*: Contractor shall pay all deductible provisions applicable to claims related to the Project made under and paid by insurance. If more than one Contractor is responsible for the incident giving rise to the insurance coverage, the Contractors shall be responsible on a pro rata basis, according to their responsibility for the occurrence or accident giving rise to the claim, for payment of the deductible. The risk of loss within such identified deductible amount will be borne by Contractor, Subcontractors, or others suffering any such loss, and if any of them wishes property insurance coverage within the limits of such amounts, each may purchase and maintain it at the purchaser's own expense.

6.06 *Waiver of Rights*

- A. All policies purchased in accordance with Paragraph 6.05, expressly including the builder's risk policy, shall contain provisions to the effect that in the event of payment of any loss or damage the insurers will have no rights of recovery against any insureds thereunder, or against Engineer or its consultants, or their officers, directors, members, partners, employees, agents, consultants, or subcontractors. Owner and Contractor waive all rights against each other and the respective officers, directors, members, partners, employees, agents, consultants, and subcontractors of each and any of them, for all losses and damages caused by, arising out of, or resulting from any of the perils or causes of loss covered by such policies and any other property insurance applicable to the Work; and, in addition, waive all such rights against Engineer, its consultants, all Subcontractors, all individuals or entities identified in the Supplementary Conditions as insureds, and the officers, directors, members, partners, employees, agents, consultants, and subcontractors of each and any of them, under such policies for losses and damages so caused. None of the above waivers shall extend to the rights that any party making such waiver may have to the

proceeds of insurance held by Owner or Contractor as trustee or fiduciary, or otherwise payable under any policy so issued.

- B. Owner waives all rights against Contractor, Subcontractors, and Engineer, and the officers, directors, members, partners, employees, agents, consultants and subcontractors of each and any of them, for:
 - 1. loss due to business interruption, loss of use, or other consequential loss extending beyond direct physical loss or damage to Owner's property or the Work caused by, arising out of, or resulting from fire or other perils whether or not insured by Owner; and
 - 2. loss or damage to the completed Project or part thereof caused by, arising out of, or resulting from fire or other insured peril or cause of loss covered by any property insurance maintained on the completed Project or part thereof by Owner during partial occupancy or use pursuant to Paragraph 15.04, after Substantial Completion pursuant to Paragraph 15.03, or after final payment pursuant to Paragraph 15.06.
- C. Any insurance policy maintained by Owner covering any loss, damage or consequential loss referred to in Paragraph 6.06.B shall contain provisions to the effect that in the event of payment of any such loss, damage, or consequential loss, the insurers will have no rights of recovery against Contractor, Subcontractors, or Engineer, or the officers, directors, members, partners, employees, agents, consultants, or subcontractors of each and any of them.
- D. Contractor shall be responsible for assuring that the agreement under which a Subcontractor performs a portion of the Work contains provisions whereby the Subcontractor waives all rights against Owner, Contractor, all individuals or entities identified in the Supplementary Conditions as insureds, the Engineer and its consultants, and the officers, directors, members, partners, employees, agents, consultants, and subcontractors of each and any of them, for all losses and damages caused by, arising out of, relating to, or resulting from any of the perils or causes of loss covered by builder's risk insurance and any other property insurance applicable to the Work.

6.07 *Receipt and Application of Property Insurance Proceeds*

- A. Any insured loss under the builder's risk and other policies of insurance required by Paragraph 6.05 will be adjusted and settled with the named insured that purchased the policy. Such named insured shall act as fiduciary for the other insureds, and give notice to such other insureds that adjustment and settlement of a claim is in progress. Any other insured may state its position regarding a claim for insured loss in writing within 15 days after notice of such claim.
- B. Proceeds for such insured losses may be made payable by the insurer either jointly to multiple insureds, or to the named insured that purchased the policy in its own right and as fiduciary for other insureds, subject to the requirements of any applicable mortgage clause. A named insured receiving insurance proceeds under the builder's risk and other policies of insurance required by Paragraph 6.05 shall distribute such proceeds in accordance with such agreement as the parties in interest may reach, or as otherwise required under the dispute resolution provisions of this Contract or applicable Laws and Regulations.

- C. If no other special agreement is reached, the damaged Work shall be repaired or replaced, the money so received applied on account thereof, and the Work and the cost thereof covered by Change Order, if needed.

ARTICLE 7 – CONTRACTOR’S RESPONSIBILITIES

7.01 *Supervision and Superintendence*

- A. Contractor shall supervise, inspect, and direct the Work competently and efficiently, devoting such attention thereto and applying such skills and expertise as may be necessary to perform the Work in accordance with the Contract Documents. Contractor shall be solely responsible for the means, methods, techniques, sequences, and procedures of construction.
- B. At all times during the progress of the Work, Contractor shall assign a competent resident superintendent who shall have full authority to act on behalf of Contractor and who shall not be replaced without written notice to Owner and Engineer except under extraordinary circumstances.

7.02 *Labor; Working Hours*

- A. Contractor shall provide competent, suitably qualified personnel to survey and lay out the Work and perform construction as required by the Contract Documents. Contractor shall at all times maintain good discipline and order at the Site.
- B. Except as otherwise required for the safety or protection of persons or the Work or property at the Site or adjacent thereto, and except as otherwise stated in the Contract Documents, all Work at the Site shall be performed during regular working hours, Monday through Friday. Contractor will not perform Work on a Saturday, Sunday, or any legal holiday. Contractor may perform Work outside regular working hours or on Saturdays, Sundays, or legal holidays only with Owner’s written consent, which will not be unreasonably withheld.

7.03 *Services, Materials, and Equipment*

- A. Unless otherwise specified in the Contract Documents, Contractor shall provide and assume full responsibility for all services, materials, equipment, labor, transportation, construction equipment and machinery, tools, appliances, fuel, power, light, heat, telephone, water, sanitary facilities, temporary facilities, and all other facilities and incidentals necessary for the performance, testing, start up, and completion of the Work, whether or not such items are specifically called for in the Contract Documents. The foregoing items and services shall all be included in Contractor’s original bid and no additional payments shall be made for the provision of any of the foregoing items and services.
- B. All materials and equipment incorporated into the Work shall be of good quality and new, except as otherwise provided in the Contract Documents. All special warranties and guarantees required by the Specifications shall expressly run to the benefit of Owner. If required by Engineer, Contractor shall furnish satisfactory evidence (including reports of required tests) as to the source, kind, and quality of materials and equipment. Contractor warrants that all materials and equipment are suitable and fit for the intended use of such materials and equipment and are free from defects in material, workmanship, or design. The foregoing applies whether or not the materials or equipment are specified in the Contract Documents.

- C. All materials and equipment shall be stored, applied, installed, connected, erected, protected, used, cleaned, and conditioned in accordance with instructions of the applicable Supplier, except as otherwise may be provided in the Contract Documents.

7.04 "Or Equals"

- A. Substitutions prior to the receipt of bids shall be governed by the Instruction to Bidders. Substitutions after the entry into the Agreement shall be governed by these Modified General Conditions.
 - 1. If Engineer in its sole discretion determines that an item of material or equipment proposed by Contractor is functionally equal to that named and sufficiently similar so that no change in related Work will be required, Engineer shall deem it an "or equal" item. For the purposes of this paragraph, a proposed item of material or equipment will be considered functionally equal to an item so named if:
 - a. in the exercise of reasonable judgment Engineer determines that:
 - 1) it is at least equal in materials of construction, quality, durability, appearance, strength, and design characteristics;
 - 2) it will reliably perform at least equally well the function and achieve the results imposed by the design concept of the completed Project as a functioning whole;
 - 3) it has a proven record of performance and availability of responsive service; and
 - 4) it is not objectionable to Owner.
 - b. Contractor certifies that, if approved and incorporated into the Work:
 - 1) there will be no increase in cost to the Owner or increase in Contract Times; and
 - 2) it will conform substantially to the detailed requirements of the item named in the Contract Documents.
- B. *Contractor's Expense*: Contractor shall provide all data in support of any proposed "or equal" item at Contractor's expense.
- C. *Engineer's Evaluation and Determination*: Engineer will be allowed a reasonable time to evaluate each "or-equal" request. Engineer may require Contractor to furnish additional data about the proposed "or-equal" item. Engineer will be the sole judge of acceptability. No "or-equal" item will be ordered, furnished, installed, or utilized until Engineer's review is complete and Engineer determines that the proposed item is an "or-equal", which will be evidenced by an approved Shop Drawing or other written communication. Engineer will advise Contractor in writing of any negative determination.
- D. *Effect of Engineer's Determination*: Neither approval nor denial of an "or-equal" request shall result in any change in Contract Price. The Engineer's denial of an "or-equal" request shall be final and binding, and may not be reversed through an appeal under any provision of the Contract Documents.
- E. *Treatment as a Substitution Request*. If Engineer determines that an item of material or equipment proposed by Contractor does not qualify as an "or-equal" item, Contractor may request that Engineer consider the proposed item as a substitute pursuant to Paragraph 7.05.

7.05 Substitutes

- A. Unless the specification or description of an item of material or equipment required to be furnished under the Contract Documents contains or is followed by words reading that no substitution is permitted, Contractor may request that Engineer authorize the use of other items of material or equipment under the circumstances described below. To the extent possible such requests shall be made before commencement of related construction at the Site.
1. Contractor shall submit sufficient information as provided below to allow Engineer to determine if the item of material or equipment proposed is functionally equivalent to that named and an acceptable substitute therefor. Engineer will not accept requests for review of proposed substitute items of material or equipment from anyone other than Contractor.
 2. The requirements for review by Engineer will be as set forth in Paragraph 7.05.B, as supplemented by the Specifications, and as Engineer may decide is appropriate under the circumstances.
 3. Contractor shall make written application to Engineer for review of a proposed substitute item of material or equipment that Contractor seeks to furnish or use. The application:
 - a. shall certify that the proposed substitute item will:
 - 1) perform adequately the functions and achieve the results called for by the general design,
 - 2) be similar in substance to that specified, and
 - 3) be suited to the same use as that specified.
 - b. will state:
 - 1) the extent, if any, to which the use of the proposed substitute item will necessitate a change in Contract Times,
 - 2) whether use of the proposed substitute item in the Work will require a change in any of the Contract Documents (or in the provisions of any other direct contract with Owner for other work on the Project) to adapt the design to the proposed substitute item, and
 - 3) whether incorporation or use of the proposed substitute item in connection with the Work is subject to payment of any license fee or royalty.
 - c. will identify:
 - 1) all variations of the proposed substitute item from that specified, and
 - 2) available engineering, sales, maintenance, repair, and replacement services.
 - d. shall contain an itemized estimate of all costs or credits that will result directly or indirectly from use of such substitute item, including but not limited to changes in Contract Price, shared savings, costs of redesign, and claims of other contractors affected by any resulting change.
- B. *Engineer's Evaluation and Determination:* Engineer will be allowed a reasonable time to evaluate each substitute request, and to obtain comments and direction from

Owner. Engineer may require Contractor to furnish additional data about the proposed substitute item. Engineer will be the sole judge of acceptability. No substitute will be ordered, furnished, installed, or utilized until Engineer's review is complete and Engineer determines that the proposed item is an acceptable substitute. Engineer's determination will be evidenced by a Field Order or a proposed Change Order accounting for the substitution itself and all related impacts, including changes in Contract Price or Contract Times. Engineer will advise Contractor in writing of any negative determination.

- C. *Special Guarantee:* Owner may require Contractor to furnish at Contractor's expense a special performance guarantee or other surety with respect to any substitute.
- D. *Reimbursement of Engineer's Cost:* Engineer will record Engineer's costs in evaluating a substitute proposed or submitted by Contractor. Whether or not Engineer approves a substitute so proposed or submitted by Contractor, Contractor shall reimburse Owner for the reasonable charges of Engineer for evaluating each such proposed substitute. Contractor shall also reimburse Owner for the reasonable charges of Engineer for making changes in the Contract Documents (or in the provisions of any other direct contract with Owner) resulting from the acceptance of each proposed substitute. In the instance where the Engineer is the City of Gahanna Engineer, the foregoing work shall be charged at a rate of \$75.00 per hour for any City of Gahanna employee performing the tasks contemplated in this paragraph.
- E. *Contractor's Expense:* Contractor shall provide all data in support of any proposed substitute at Contractor's expense.
- F. *Effect of Engineer's Determination:* If Engineer approves the substitution request, Contractor shall execute the proposed Change Order and proceed with the substitution. The Engineer's denial of a substitution request shall be final and binding, and may not be reversed through an appeal under any provision of the Contract Documents. Contractor may challenge the scope of reimbursement costs imposed under Paragraph 7.05.D, by timely submittal of a Change Proposal.

7.06 *Concerning Subcontractors, Suppliers, and Others*

- A. Contractor may retain Subcontractors and Suppliers for the performance of parts of the Work. Such Subcontractors and Suppliers must be acceptable to Owner.
- B. Contractor shall retain specific Subcontractors, Suppliers, or other individuals or entities for the performance of designated parts of the Work if required by the Contract to do so.
- C. Subsequent to the submittal of Contractor's Bid or final negotiation of the terms of the Contract, Owner may not require Contractor to retain any Subcontractor, Supplier, or other individual or entity to furnish or perform any of the Work against which Contractor has reasonable objection. If Owner or Engineer, after due investigation, has reasonable objections to any proposed Subcontractor, Supplier, or other individual or entity, either may request Contractor submit an acceptable substitute without an increase in Contract Price, and the Contractor shall do so within ten (10) days.
- D. Prior to entry into any binding subcontract or purchase order, Contractor shall submit to Owner the identity of the proposed Subcontractor or Supplier (unless Owner has already deemed such proposed Subcontractor or Supplier acceptable, during the bidding process or otherwise). Such proposed Subcontractor or Supplier shall be deemed acceptable to Owner unless Owner raises a substantive, reasonable

objection within five days. The Owner's acceptance or failure to raise an objection shall not relieve the Contractor of its liability for the acts, omissions, or breaches of contract by its subcontractors or suppliers.

- E. Owner may require the replacement of any Subcontractor, Supplier, employee, or other individual or entity retained by Contractor to perform any part of the Work. Owner also may require Contractor to retain specific replacements; provided, however, that Owner may not require a replacement to which Contractor has a reasonable objection. If Contractor has submitted the identity of certain Subcontractors, Suppliers, or other individuals or entities for acceptance by Owner, and Owner has accepted it (either in writing or by failing to make written objection thereto), then Owner may subsequently revoke the acceptance of any such Subcontractor, Supplier, or other individual or entity so identified solely on the basis of substantive, reasonable objection after due investigation. Contractor shall submit an acceptable replacement for the rejected Subcontractor, Supplier, or other individual or entity. Cause for removal shall include but not be limited to incompetent, unfaithful, or disorderly behavior, refusal to carry out any provision of the Contract Documents, careless or unsatisfactory work, or disrespectful, threatening or abusive language to any supervisor of the work or to the public.
- F. If Owner requires the replacement of any Subcontractor, Supplier, employee, or other individual or entity retained by Contractor to perform any part of the Work, then Contractor shall not be entitled to an adjustment in Contract Price or Contract Times, or both, with respect to the replacement; and Contractor shall initiate a Change Proposal for such adjustment within 30 days of Owner's requirement of replacement.
- G. No acceptance by Owner of any such Subcontractor, Supplier, employee, or other individual or entity, whether initially or as a replacement, shall constitute a waiver of the right of Owner to the completion of the Work in accordance with the Contract Documents.
- H. On a monthly basis Contractor shall submit to Engineer a complete list of all Subcontractors and Suppliers having a direct contract with Contractor, and of all other Subcontractors and Suppliers known to Contractor at the time of submittal.
- I. Contractor shall be fully responsible to Owner and Engineer for all acts and omissions of the Subcontractors, Suppliers, and other individuals or entities performing or furnishing any of the Work just as Contractor is responsible for Contractor's own acts and omissions.
- J. Contractor shall be solely responsible for scheduling and coordinating the work of Subcontractors, Suppliers, and all other individuals or entities performing or furnishing any of the Work.
- K. Contractor shall restrict all Subcontractors, Suppliers, and such other individuals or entities performing or furnishing any of the Work from communicating with Engineer or Owner, except through Contractor or in case of an emergency, or as otherwise expressly allowed herein.
- L. The divisions and sections of the Specifications and the identifications of any Drawings shall not control Contractor in dividing the Work among Subcontractors or Suppliers or delineating the Work to be performed by any specific trade.
- M. All Work performed for Contractor by a Subcontractor or Supplier shall be pursuant to an appropriate contractual agreement that specifically binds the Subcontractor or

Supplier to the applicable terms and conditions of the Contract Documents for the benefit of Owner and Engineer.

- N. Owner may furnish to any Subcontractor or Supplier, to the extent practicable, information about amounts paid to Contractor on account of Work performed for Contractor by the particular Subcontractor or Supplier.
- O. Nothing in the Contract Documents:
 - 1. shall create for the benefit of any such Subcontractor, Supplier, or other individual or entity any contractual relationship between Owner or Engineer and any such Subcontractor, Supplier, or other individual or entity; nor
 - 2. shall create any obligation on the part of Owner or Engineer to pay or to see to the payment of any money due any such Subcontractor, Supplier, or other individual or entity except as may otherwise be required by Laws and Regulations.
- P. The Owner shall be an intended third-party beneficiary of Contractor's agreements with its consultants, subcontractors, and suppliers.

7.07 *Patent Fees and Royalties*

- A. Contractor shall pay all license fees and royalties and assume all costs incident to the use in the performance of the Work or the incorporation in the Work of any invention, design, process, product, or device which is the subject of patent rights or copyrights held by others. If a particular invention, design, process, product, or device is specified in the Contract Documents for use in the performance of the Work and if, to the actual knowledge of Owner or Engineer, its use is subject to patent rights or copyrights calling for the payment of any license fee or royalty to others, the existence of such rights shall be disclosed by Owner in the Contract Documents.
- B. To the fullest extent permitted by Laws and Regulations, Contractor shall indemnify and hold harmless Owner and Engineer, and the officers, directors, members, partners, employees, agents, consultants and subcontractors of each and any of them from and against all claims, costs, losses, and damages (including but not limited to all fees and charges of engineers, architects, attorneys, and other professionals and all court or arbitration or other dispute resolution costs) arising out of or relating to any infringement of patent rights or copyrights incident to the use in the performance of the Work or resulting from the incorporation in the Work of any invention, design, process, product, or device not specified in the Contract Documents.

7.08 *Permits*

- A. Unless otherwise provided in the Contract Documents, Contractor shall obtain and pay for all construction permits and licenses. Owner shall assist Contractor, when necessary, in obtaining such permits and licenses. Contractor shall pay all governmental charges and inspection fees necessary for the prosecution of the Work which are applicable at the time of the submission of Contractor's Bid (or when Contractor became bound under a negotiated contract). Owner shall pay all charges of utility owners for connections for providing permanent service to the Work and other agencies or entities as may be required by the nature of the Work.

7.09 *Taxes*

- A. Contractor shall pay all sales, consumer, use, and other similar taxes required to be paid by Contractor in accordance with the Laws and Regulations of the place of the Project which are applicable during the performance of the Work.

- B. Materials purchased for use or consumption in connection with the proposed Work will be exempt from the State of Ohio Sales Tax, as provided in Section 5739.02 of the Ohio Revised Code, and also from the State of Ohio Use Tax, as provided in Section 5741.01 of the Ohio Revised Code. The Owner will provide the Contractor with a Construction Tax Exempt Certificate upon request, made through the Engineer.
- C. Purchases by the Contractor of expendable items, such as form lumber, tools, oil, greases, fuel, or equipment rentals, are subject to the application of Ohio Sales or Use Taxes.
- D. In addition to any other taxes required to be withheld by the Contractor, the Contractor shall withhold any income taxes due to the Owner for wages, salaries and commissions paid to its employees for work done under this Agreement and further agrees that any of its subcontractors shall, by the terms of its subcontract, be required to withhold any such income taxes due for work performed under this Agreement.

7.10 *Laws and Regulations*

- A. Contractor shall give all notices required by and shall comply with all Laws and Regulations applicable to the performance of the Work. Except where otherwise expressly required by applicable Laws and Regulations, neither Owner nor Engineer shall be responsible for monitoring Contractor's compliance with any Laws or Regulations.
- B. If Contractor performs any Work or takes any other action knowing or having reason to know that it is contrary to Laws or Regulations, Contractor shall bear all resulting costs and losses, and shall indemnify and hold harmless Owner and Engineer, and the officers, directors, members, partners, employees, agents, consultants, and subcontractors of each and any of them from and against all claims, costs, losses, and damages (including but not limited to all fees and charges of engineers, architects, attorneys, and other professionals and all court or arbitration or other dispute resolution costs) arising out of or relating to such Work or other action. It shall not be Contractor's responsibility to make certain that the Work described in the Contract Documents is in accordance with Laws and Regulations, but this shall not relieve Contractor of Contractor's obligations under Paragraph 3.03.

7.11 *Record Documents*

- A. Contractor shall maintain in a safe place at the Site two record copies of all Drawings, Specifications, Addenda, Change Orders, Work Change Directives, Field Orders, written interpretations and clarifications, and approved Shop Drawings. Contractor shall keep such record documents in good order and annotate them to show changes made during construction. These record documents, together with all approved Samples, will be available to Engineer for reference. Upon completion of the Work, Contractor shall deliver these record documents, samples, and shop drawings to the Engineer no later than the date for Substantial Completion for the Engineer's review and transmitted to the Owner.

7.12 *Safety and Protection*

- A. Contractor shall be solely responsible for initiating, maintaining, and supervising all safety precautions and programs in connection with the Work. Such responsibility does not relieve Subcontractors of their responsibility for the safety of persons or property in the performance of their work, nor for compliance with applicable safety Laws and Regulations. Contractor shall take all necessary precautions for the safety of, and shall provide the necessary protection to prevent damage, injury, or loss to:

1. all persons on the Site or who may be affected by the Work;
 2. all the Work and materials and equipment to be incorporated therein, whether in storage on or off the Site; and
 3. other property at the Site or adjacent thereto, including trees, shrubs, lawns, walks, pavements, roadways, structures, other work in progress, utilities, and Underground Facilities not designated for removal, relocation, or replacement in the course of construction.
- B. Contractor shall comply with all applicable Laws and Regulations relating to the safety of persons or property, or to the protection of persons or property from damage, injury, or loss; and shall erect and maintain all necessary safeguards for such safety and protection. Contractor shall notify Owner; the owners of adjacent property, Underground Facilities, and other utilities; and other contractors and utility owners performing work at or adjacent to the Site, when prosecution of the Work may affect them, and shall cooperate with them in the protection, removal, relocation, and replacement of their property or work in progress.
- C. Contractor shall comply with the applicable requirements of Owner's safety programs, if any. The Supplementary Conditions identify any Owner's safety programs that are applicable to the Work.
- D. Contractor shall inform Owner and Engineer of the specific requirements of Contractor's safety program with which Owner's and Engineer's employees and representatives must comply while at the Site.
- E. All damage, injury, or loss to any property referred to in Paragraph 7.12.A.2 or 7.12.A.3 caused, directly or indirectly, in whole or in part, by Contractor, any Subcontractor, Supplier, or any other individual or entity directly or indirectly employed by any of them to perform any of the Work, or anyone for whose acts any of them may be liable, shall be remedied by Contractor at its expense (except damage or loss attributable to the fault of Drawings or Specifications or to the acts or omissions of Owner or Engineer or anyone employed by any of them, or anyone for whose acts any of them may be liable, and not attributable, directly or indirectly, in whole or in part, to the fault or negligence of Contractor or any Subcontractor, Supplier, or other individual or entity directly or indirectly employed by any of them).
- F. Contractor's duties and responsibilities for safety and protection shall continue until such time as all the Work is completed and Engineer has issued a notice to Owner and Contractor in accordance with Paragraph 15.06.B that the Work is acceptable (except as otherwise expressly provided in connection with Substantial Completion).
- G. Contractor's duties and responsibilities for safety and protection shall resume whenever Contractor or any Subcontractor or Supplier returns to the Site to fulfill warranty or correction obligations, or to conduct other tasks arising from the Contract Documents.

7.13 *Safety Representative*

- A. Contractor shall designate a qualified and experienced safety representative at the Site whose duties and responsibilities shall be the prevention of accidents and the maintaining and supervising of safety precautions and programs.
- B. Contractor shall keep at the Site at all times during the progress of the Work a competent person to comply with OSHA trenching and excavation requirements. The competent person shall be one who is capable of identifying existing and predictable

hazards in the surroundings, or working conditions that are unsanitary, hazardous, or dangerous to employees, and who has authorization to take prompt corrective measures to eliminate them.

7.14 *Hazard Communication Programs*

- A. Contractor shall be responsible for coordinating any exchange of material safety data sheets or other hazard communication information required to be made available to or exchanged between or among employers at the Site in accordance with Laws or Regulations.

7.15 *Emergencies*

- A. In emergencies affecting the safety or protection of persons or the Work or property at the Site or adjacent thereto, Contractor is obligated to act to prevent threatened damage, injury, or loss. Contractor shall give Engineer prompt written notice if Contractor believes that any significant changes in the Work or variations from the Contract Documents have been caused thereby or are required as a result thereof. If Engineer determines that a change in the Contract Documents is required because of the action taken by Contractor in response to such an emergency, a Work Change Directive or Change Order will be issued.

7.16 *Shop Drawings, Samples, and Other Submittals*

- A. *Shop Drawing and Sample Submittal Requirements:*
 - 1. Before submitting a Shop Drawing or Sample, Contractor shall have:
 - a. reviewed and coordinated the Shop Drawing or Sample with other Shop Drawings and Samples and with the requirements of the Work and the Contract Documents;
 - b. determined and verified all field measurements, quantities, dimensions, specified performance and design criteria, installation requirements, materials, catalog numbers, and similar information with respect thereto;
 - c. determined and verified the suitability of all materials and equipment offered with respect to the indicated application, fabrication, shipping, handling, storage, assembly, and installation pertaining to the performance of the Work; and
 - d. determined and verified all information relative to Contractor's responsibilities for means, methods, techniques, sequences, and procedures of construction, and safety precautions and programs incident thereto.
 - 2. Each submittal shall bear a stamp or specific written certification that Contractor has satisfied Contractor's obligations under the Contract Documents with respect to Contractor's review of that submittal, and that Contractor approves the submittal.
 - 3. With each submittal, Contractor shall give Engineer specific written notice of any variations that the Shop Drawing or Sample may have from the requirements of the Contract Documents. This notice shall be set forth in a written communication separate from the Shop Drawings or Sample submittal; and, in addition, in the case of Shop Drawings by a specific notation made on each Shop Drawing submitted to Engineer for review and approval of each such variation.

- B. *Submittal Procedures for Shop Drawings and Samples:* Contractor shall submit Shop Drawings and Samples to Engineer for review and approval in accordance with the accepted Schedule of Submittals. Each submittal will be identified as Engineer may require.
1. *Shop Drawings:*
 - a. Contractor shall submit the number of copies required in the Specifications.
 - b. Data shown on the Shop Drawings will be complete with respect to quantities, dimensions, specified performance and design criteria, materials, and similar data to show Engineer the services, materials, and equipment Contractor proposes to provide and to enable Engineer to review the information for the limited purposes required by Paragraph 7.16.D.
 2. *Samples:*
 - a. Contractor shall submit the number of Samples required in the Specifications.
 - b. Contractor shall clearly identify each Sample as to material, Supplier, pertinent data such as catalog numbers, the use for which intended and other data as Engineer may require to enable Engineer to review the submittal for the limited purposes required by Paragraph 7.16.D.
 3. Where a Shop Drawing or Sample is required by the Contract Documents or the Schedule of Submittals, any related Work performed prior to Engineer's review and approval of the pertinent submittal will be at the sole expense and responsibility of Contractor.
- C. *Other Submittals:* Contractor shall submit other submittals to Engineer in accordance with the accepted Schedule of Submittals, and pursuant to the applicable terms of the Specifications.
- D. *Engineer's Review:*
1. Engineer will provide timely review of Shop Drawings and Samples in accordance with the Schedule of Submittals acceptable to Engineer. Engineer's review and approval will be only to determine if the items covered by the submittals will, after installation or incorporation in the Work, conform to the information given in the Contract Documents and be compatible with the design concept of the completed Project as a functioning whole as indicated by the Contract Documents.
 2. Engineer's review and approval will not extend to means, methods, techniques, sequences, or procedures of construction or to safety precautions or programs incident thereto.
 3. Engineer's review and approval of a separate item as such will not indicate approval of the assembly in which the item functions.
 4. Engineer's review and approval of a Shop Drawing or Sample shall not relieve Contractor from responsibility for any variation from the requirements of the Contract Documents unless Contractor has complied with the requirements of Paragraph 7.16.A.3 and Engineer has given written approval of each such variation by specific written notation thereof incorporated in or accompanying the Shop Drawing or Sample. Engineer will document any such approved variation from the requirements of the Contract Documents in a Field Order.

5. Engineer's review and approval of a Shop Drawing or Sample shall not relieve Contractor from responsibility for complying with the requirements of Paragraph 7.16.A and B.
6. Engineer's review and approval of a Shop Drawing or Sample, or of a variation from the requirements of the Contract Documents, shall not, under any circumstances, change the Contract Times or Contract Price, unless such changes are included in a Change Order.
7. Neither Engineer's receipt, review, acceptance or approval of a Shop Drawing, Sample, or other submittal shall result in such item becoming a Contract Document.
8. Contractor shall perform the Work in compliance with the requirements and commitments set forth in approved Shop Drawings and Samples, subject to the provisions of Paragraph 7.16.D.4.

E. *Resubmittal Procedures:*

1. Contractor shall make corrections required by Engineer and shall return the required number of corrected copies of Shop Drawings and submit, as required, new Samples for review and approval. Contractor shall direct specific attention in writing to revisions other than the corrections called for by Engineer on previous submittals.
2. Contractor shall furnish required submittals with sufficient information and accuracy to obtain required approval of an item with no more than three submittals. Engineer will record Engineer's time for reviewing a fourth or subsequent submittal of a Shop Drawings, sample, or other item requiring approval, and Contractor shall be responsible for Engineer's charges to Owner for such time. Owner may impose a set-off against payments due to Contractor to secure reimbursement for such charges.
3. If Contractor requests a change of a previously approved submittal item, Contractor shall be responsible for Engineer's charges to Owner for its review time, and Owner may impose a set-off against payments due to Contractor to secure reimbursement for such charges, unless the need for such change is beyond the control of Contractor.

7.17 *Contractor's General Warranty and Guarantee*

- A. Contractor warrants and guarantees to Owner that all Work will be in accordance with the Contract Documents and will not be defective. Engineer and its officers, directors, members, partners, employees, agents, consultants, and subcontractors shall be entitled to rely on Contractor's warranty and guarantee.
- B. Contractor's warranty and guarantee hereunder excludes defects or damage caused by:
 1. abuse, modification, or improper maintenance or operation by persons other than Contractor, Subcontractors, Suppliers, or any other individual or entity for whom Contractor is responsible; or
 2. normal wear and tear under normal usage.
- C. Contractor's obligation to perform and complete the Work in accordance with the Contract Documents shall be absolute. None of the following will constitute an acceptance of Work that is not in accordance with the Contract Documents or a

release of Contractor's obligation to perform the Work in accordance with the Contract Documents:

1. observations by Engineer;
 2. recommendation by Engineer or payment by Owner of any progress or final payment;
 3. the issuance of a certificate of Substantial Completion by Engineer or any payment related thereto by Owner;
 4. use or occupancy of the Work or any part thereof by Owner;
 5. any review and approval of a Shop Drawing or Sample submittal;
 6. the issuance of a notice of acceptability by Engineer;
 7. any inspection, test, or approval by others; or
 8. any correction of defective Work by Owner.
- D. If the Contract requires the Contractor to accept the assignment of a contract entered into by Owner, then the specific warranties, guarantees, and correction obligations contained in the assigned contract shall govern with respect to Contractor's performance obligations to Owner for the Work described in the assigned contract.

7.18 *Indemnification*

- A. To the fullest extent permitted by Laws and Regulations, and in addition to any other obligations of Contractor under the Contract or otherwise, Contractor shall indemnify and hold harmless Owner and Engineer, and the officers, directors, members, partners, employees, agents, consultants and subcontractors of each and any of them from and against all claims, costs, losses, and damages (including but not limited to all fees and charges of engineers, architects, attorneys, and other professionals and all court or arbitration or other dispute resolution costs) arising out of or relating to the performance of the Work, but only to the extent caused by any breach of contract, negligent act or omission of Contractor, any Subcontractor, any Supplier, or any individual or entity directly or indirectly employed by any of them to perform any of the Work or anyone for whose acts any of them may be liable.
- B. In any and all claims against Owner or Engineer or any of their officers, directors, members, partners, employees, agents, consultants, or subcontractors by any employee (or the survivor or personal representative of such employee) of Contractor, any Subcontractor, any Supplier, or any individual or entity directly or indirectly employed by any of them to perform any of the Work, or anyone for whose acts any of them may be liable, the indemnification obligation under Paragraph 7.18.A shall not be limited in any way by any limitation on the amount or type of damages, compensation, or benefits payable by or for Contractor or any such Subcontractor, Supplier, or other individual or entity under workers' compensation acts, disability benefit acts, or other employee benefit acts.

7.19 *Delegation of Professional Design Services*

- A. Contractor will not be required to provide professional design services unless such services are specifically required by the Contract Documents for a portion of the Work or unless such services are required to carry out Contractor's responsibilities for construction means, methods, techniques, sequences and procedures. Contractor shall not be required to provide professional services in violation of applicable Laws and Regulations.

- B. If professional design services or certifications by a design professional related to systems, materials, or equipment are specifically required of Contractor by the Contract Documents, Owner and Engineer will specify all performance and design criteria that such services must satisfy. Contractor shall cause such services or certifications to be provided by a properly licensed professional, whose signature and seal shall appear on all drawings, calculations, specifications, certifications, and other submittals prepared by such professional. Shop Drawings and other submittals related to the Work designed or certified by such professional, if prepared by others, shall bear such professional's written approval when submitted to Engineer.
- C. Owner and Engineer shall be entitled to rely upon the adequacy, accuracy, and completeness of the services, certifications, or approvals performed by such design professionals, provided Owner and Engineer have specified to Contractor all performance and design criteria that such services must satisfy.
- D. Pursuant to this paragraph, Engineer's review and approval of design calculations and design drawings will be only for the limited purpose of checking for conformance with performance and design criteria given and the design concept expressed in the Contract Documents. Engineer's review and approval of Shop Drawings and other submittals (except design calculations and design drawings) will be only for the purpose stated in Paragraph 7.16.D.1.
- E. Contractor shall not be responsible for the adequacy of the performance or design criteria specified by Owner or Engineer.

ARTICLE 8 – OTHER WORK AT THE SITE

8.01 *Other Work*

- A. In addition to and apart from the Work under the Contract Documents, the Owner may perform other work at or adjacent to the Site. Such other work may be performed by Owner's employees, or through contracts between the Owner and third parties. Owner may also arrange to have third-party utility owners perform work on their utilities and facilities at or adjacent to the Site.
- B. If Owner performs other work at or adjacent to the Site with Owner's employees, or through contracts for such other work, then Owner shall give Contractor written notice thereof prior to starting any such other work. If Owner has advance information regarding the start of any utility work at or adjacent to the Site, Owner shall provide such information to Contractor.
- C. Contractor shall afford each other contractor that performs such other work, each utility owner performing other work, and Owner, if Owner is performing other work with Owner's employees, proper and safe access to the Site, and provide a reasonable opportunity for the introduction and storage of materials and equipment and the execution of such other work. Contractor shall do all cutting, fitting, and patching of the Work that may be required to properly connect or otherwise make its several parts come together and properly integrate with such other work. Contractor shall not endanger any work of others by cutting, excavating, or otherwise altering such work; provided, however, that Contractor may cut or alter others' work with the written consent of Engineer and the others whose work will be affected.
- D. If the proper execution or results of any part of Contractor's Work depends upon work performed by others under this Article 8, Contractor shall inspect such other work and promptly report to Engineer in writing any delays, defects, or deficiencies in such other

work that render it unavailable or unsuitable for the proper execution and results of Contractor's Work. Contractor's failure to so report will constitute an acceptance of such other work as fit and proper for integration with Contractor's Work except for latent defects and deficiencies in such other work.

8.02 *Coordination*

- A. If Owner intends to contract with others for the performance of other work at or adjacent to the Site, to perform other work at or adjacent to the Site with Owner's employees, or to arrange to have utility owners perform work at or adjacent to the Site, the following will be set forth in the Supplementary Conditions or provided to Contractor prior to the start of any such other work:
 - 1. the identity of the individual or entity that will have authority and responsibility for coordination of the activities among the various contractors;
 - 2. an itemization of the specific matters to be covered by such authority and responsibility; and
 - 3. the extent of such authority and responsibilities.
- B. Unless otherwise provided in the Supplementary Conditions, Owner shall have sole authority and responsibility for such coordination.

8.03 *Legal Relationships*

- A. If, in the course of performing other work at or adjacent to the Site for Owner, the Owner's employees, any other contractor working for Owner, or any utility owner causes damage to the Work or to the property of Contractor or its Subcontractors, or delays, disrupts, interferes with, or increases the scope or cost of the performance of the Work, through actions or inaction, then Contractor shall be entitled to an equitable adjustment in the Contract Price or the Contract Times, or both. Contractor must submit any Change Proposal seeking an equitable adjustment in the Contract Price or the Contract Times under this paragraph within 30 days of the damaging, delaying, disrupting, or interfering event. The entitlement to, and extent of, any such equitable adjustment shall take into account information (if any) regarding such other work that was provided to Contractor in the Contract Documents prior to the submittal of the Bid or the final negotiation of the terms of the Contract. When applicable, any such equitable adjustment in Contract Price shall be conditioned on Contractor assigning to Owner all Contractor's rights against such other contractor or utility owner with respect to the damage, delay, disruption, or interference that is the subject of the adjustment. Contractor's entitlement to an adjustment of the Contract Times is conditioned on such adjustment being essential to Contractor's ability to complete the Work within the Contract Times.
- B. Contractor shall take reasonable and customary measures to avoid damaging, delaying, disrupting, or interfering with the work of Owner, any other contractor, or any utility owner performing other work at or adjacent to the Site. If Contractor fails to take such measures and as a result damages, delays, disrupts, or interferes with the work of any such other contractor or utility owner, then Owner may impose a set-off against payments due to Contractor, and assign to such other contractor or utility owner the Owner's contractual rights against Contractor with respect to the breach of the obligations set forth in this paragraph.
- C. When Owner is performing other work at or adjacent to the Site with Owner's employees, Contractor shall be liable to Owner for damage to such other work, and for the reasonable direct delay, disruption, and interference costs incurred by Owner

as a result of Contractor's failure to take reasonable and customary measures with respect to Owner's other work. In response to such damage, delay, disruption, or interference, Owner may impose a set-off against payments due to Contractor.

- D. If Contractor damages, delays, disrupts, or interferes with the work of any other contractor, or any utility owner performing other work at or adjacent to the Site, through Contractor's failure to take reasonable and customary measures to avoid such impacts, or if any claim arising out of Contractor's actions, inactions, or negligence in performance of the Work at or adjacent to the Site is made by any such other contractor or utility owner against Contractor, Owner, or Engineer, then Contractor shall (1) promptly attempt to settle the claim as to all parties through negotiations with such other contractor or utility owner, or otherwise resolve the claim by arbitration or other dispute resolution proceeding or at law, and (2) indemnify and hold harmless Owner and Engineer, and the officers, directors, members, partners, employees, agents, consultants and subcontractors of each and any of them from and against any such claims, and against all costs, losses, and damages (including but not limited to all fees and charges of engineers, architects, attorneys, and other professionals and all court or arbitration or other dispute resolution costs) arising out of or relating to such damage, delay, disruption, or interference.

ARTICLE 9 – OWNER'S RESPONSIBILITIES

9.01 *Communications to Contractor*

- A. Except as otherwise provided in these General Conditions, Owner shall issue all communications to Contractor through Engineer.

9.02 *Replacement of Engineer*

- A. Owner may at its discretion appoint an engineer to replace Engineer. The replacement engineer's status under the Contract Documents shall be that of the former Engineer.

9.03 *Furnish Data*

- A. Owner shall promptly furnish the data required of Owner under the Contract Documents.

9.04 *Pay When Due*

- A. Owner shall make payments to Contractor when they are due as provided in the Agreement.

9.05 *Lands and Easements; Reports, Tests, and Drawings*

- A. Owner's duties with respect to providing lands and easements are set forth in Paragraph 5.01.
- B. Owner's duties with respect to providing engineering surveys to establish reference points are set forth in Paragraph 4.03.
- C. Article 5 refers to Owner's identifying and making available to Contractor copies of reports of explorations and tests of conditions at the Site, and drawings of physical conditions relating to existing surface or subsurface structures at the Site.

9.06 *Insurance*

- A. Owner's responsibilities, if any, with respect to purchasing and maintaining liability and property insurance are set forth in Article 6.

9.07 *Change Orders*

- A. Owner's responsibilities with respect to Change Orders are set forth in Article 11.

9.08 *Inspections, Tests, and Approvals*

- A. Owner's responsibility with respect to certain inspections, tests, and approvals is set forth in Paragraph 14.02.B.

9.09 *Limitations on Owner's Responsibilities*

- A. The Owner shall not supervise, direct, or have control or authority over, nor be responsible for, Contractor's means, methods, techniques, sequences, or procedures of construction, or the safety precautions and programs incident thereto, or for any failure of Contractor to comply with Laws and Regulations applicable to the performance of the Work. Owner will not be responsible for Contractor's failure to perform the Work in accordance with the Contract Documents. Contractor agrees that, without assuming any liability, Owner may bring to the Contractor's attention any hazardous or unsafe practice that the Owner may notice and Contractor shall immediately rectify the unsafe condition at its own expense.

9.10 *Undisclosed Hazardous Environmental Condition*

- A. Owner's responsibility in respect to an undisclosed Hazardous Environmental Condition is set forth in Paragraph 5.06.

9.11 *Evidence of Financial Arrangements*

- A. The Owner shall provide the Contractor with a certificate from its fiscal officer as to the availability of funds.

9.12 *Safety Programs*

- A. While at the Site, Owner's employees and representatives shall comply with the specific applicable requirements of Contractor's safety programs of which Owner has been informed.
- B. Owner shall furnish copies of any applicable Owner safety programs to Contractor.

ARTICLE 10 – ENGINEER'S STATUS DURING CONSTRUCTION

10.01 *Owner's Representative*

- A. Engineer will be Owner's representative during the construction period. The duties and responsibilities and the limitations of authority of Engineer as Owner's representative during construction are set forth in the Contract.

10.02 *Visits to Site*

- A. Engineer will make visits to the Site at intervals appropriate to the various stages of construction as Engineer deems necessary in order to observe as an experienced and qualified design professional the progress that has been made and the quality of the various aspects of Contractor's executed Work. Based on information obtained during such visits and observations, Engineer, for the benefit of Owner, will determine, in general, if the Work is proceeding in accordance with the Contract Documents. Engineer will not be required to make exhaustive or continuous inspections on the Site to check the quality or quantity of the Work. Engineer's efforts will be directed toward providing for Owner a greater degree of confidence that the completed Work will conform generally to the Contract Documents. On the basis of such visits and

observations, Engineer will keep Owner informed of the progress of the Work and will endeavor to guard Owner against defective Work.

- B. Engineer's visits and observations are subject to all the limitations on Engineer's authority and responsibility set forth in Paragraph 10.08. Particularly, but without limitation, during or as a result of Engineer's visits or observations of Contractor's Work, Engineer will not supervise, direct, control, or have authority over or be responsible for Contractor's means, methods, techniques, sequences, or procedures of construction, or the safety precautions and programs incident thereto, or for any failure of Contractor to comply with Laws and Regulations applicable to the performance of the Work.

10.03 *Project Representative*

- A. If Owner and Engineer have agreed that Engineer will furnish a Resident Project Representative to represent Engineer at the Site and assist Engineer in observing the progress and quality of the Work, then the authority and responsibilities of any such Resident Project Representative will be as provided in the Contract Documents, and limitations on the responsibilities thereof will be as provided in Paragraph 10.08. If Owner designates a representative or agent to represent Owner at the Site who is not Engineer's consultant, agent, or employee, the responsibilities and authority and limitations thereon of such other individual will be subject to the Contract Documents, specifically including the requirement in the Agreement that any Change Order or other Modification be authorized by the Owner.

10.04 *Rejecting Defective Work*

- A. Engineer has the authority to reject Work in accordance with Article 14.

10.05 *Shop Drawings, Change Orders and Payments*

- A. Engineer's authority, and limitations thereof, as to Shop Drawings and Samples, are set forth in Paragraph 7.16.
- B. Engineer's authority, and limitations thereof, as to design calculations and design drawings submitted in response to a delegation of professional design services, if any, are set forth in Paragraph 7.19.
- C. Engineer's authority as to Change Orders is set forth in Article 11.
- D. Engineer's authority as to Applications for Payment is set forth in Article 15.

10.06 *Determinations for Unit Price Work*

- A. Engineer will determine the actual quantities and classifications of Unit Price Work performed by Contractor as set forth in Paragraph 13.03.
- B. Unit Price Work for which a typical cross section or other detail from the Contract Documents applies shall be paid only up to the quantity determined by using the dimensions provided in the typical cross section or other detail. By way of example, this provision means that if a typical trench width detail in the Drawings shows a maximum width of 30-inches, all pay quantities associated with the actual work of constructing the detail shall be calculated using a trench width not greater than 30-inches. This means that the actual pay quantity could also be less than that based upon a 30-inch wide trench, if the actual trench width is smaller and otherwise in conformance with the Contract Documents, but the Contractor would not be paid more if the actual trench width exceeds 30 inches. Contractor is responsible for determining

what actual trench width may be required due to field conditions and applicable laws and regulations existing at the time of its bid.

10.07 *Decisions on Requirements of Contract Documents and Acceptability of Work*

- A. Engineer will render decisions regarding the requirements of the Contract Documents, and judge the acceptability of the Work, pursuant to the specific procedures set forth herein for initial interpretations, Change Proposals, and acceptance of the Work. In rendering such decisions and judgments, Engineer will not show partiality to Owner or Contractor, and will not be liable to Owner, Contractor, or others in connection with any proceedings, interpretations, decisions, or judgments conducted or rendered in good faith.

10.08 *Limitations on Engineer's Authority and Responsibilities*

- A. Neither Engineer's authority or responsibility under this Article 10 or under any other provision of the Contract, nor any decision made by Engineer in good faith either to exercise or not exercise such authority or responsibility or the undertaking, exercise, or performance of any authority or responsibility by Engineer, shall create, impose, or give rise to any duty in contract, tort, or otherwise owed by Engineer to Contractor, any Subcontractor, any Supplier, any other individual or entity, or to any surety for or employee or agent of any of them.
- B. Engineer will not supervise, direct, control, or have authority over or be responsible for Contractor's means, methods, techniques, sequences, or procedures of construction, or the safety precautions and programs incident thereto, or for any failure of Contractor to comply with Laws and Regulations applicable to the performance of the Work. Engineer will not be responsible for Contractor's failure to perform the Work in accordance with the Contract Documents.
- C. Engineer will not be responsible for the acts or omissions of Contractor or of any Subcontractor, any Supplier, or of any other individual or entity performing any of the Work.
- D. Engineer's review of the final Application for Payment and accompanying documentation and all maintenance and operating instructions, schedules, guarantees, bonds, certificates of inspection, tests and approvals, and other documentation required to be delivered by Paragraph 15.06.A will only be to determine generally that their content complies with the requirements of, and in the case of certificates of inspections, tests, and approvals, that the results certified indicate compliance with the Contract Documents.
- E. The limitations upon authority and responsibility set forth in this Paragraph 10.08 shall also apply to the Resident Project Representative, if any.

10.09 *Compliance with Safety Program*

- A. While at the Site, Engineer's employees and representatives will comply with the specific applicable requirements of Owner's and Contractor's safety programs (if any) of which Engineer has been informed.

ARTICLE 11 – AMENDING THE CONTRACT DOCUMENTS; CHANGES IN THE WORK

11.01 *Amending and Supplementing Contract Documents*

- A. The Contract Documents may be amended or supplemented by a Change Order, a Work Change Directive, or a Field Order.

1. *Change Orders:*

- a. If an amendment or supplement to the Contract Documents includes a change in the Contract Price or the Contract Times, such amendment or supplement must be set forth in a Change Order. A Change Order also may be used to establish amendments and supplements of the Contract Documents that do not affect the Contract Price or Contract Times.
 - b. Owner and Contractor may amend those terms and conditions of the Contract Documents that do not involve (1) the performance or acceptability of the Work, (2) the design (as set forth in the Drawings, Specifications, or otherwise), or (3) other engineering or technical matters, without the recommendation of the Engineer. Such an amendment shall be set forth in a Change Order.
 - c. Agreement on any Change Order shall constitute a final settlement of all matters relating to the change in the Work that is the subject of the Change Order, including, without limitation, all direct and indirect costs associated with such change and any and all adjustments to the Contract Price and Contract Times, unless the Contractor submits a Change Proposal and Claim in accordance with the Contract Documents.
2. *Work Change Directives:* A Work Change Directive will not change the Contract Price or the Contract Times but is evidence that the parties expect that the modification ordered or documented by a Work Change Directive will be incorporated in a subsequently issued Change Order, following negotiations by the parties as to the Work Change Directive's effect, if any, on the Contract Price and Contract Times; or, if negotiations are unsuccessful, by a determination under the terms of the Contract Documents governing adjustments, expressly including Paragraph 11.04 regarding change of Contract Price. Contractor must submit any Change Proposal seeking an adjustment of the Contract Price or the Contract Times, or both, no later than 30 days after the completion of the Work set out in the Work Change Directive.
3. *Field Orders:* Engineer may authorize minor changes in the Work if the changes do not involve an adjustment in the Contract Price or the Contract Times and are compatible with the design concept of the completed Project as a functioning whole as indicated by the Contract Documents. Such changes will be accomplished by a Field Order and will be binding on Owner and also on Contractor, which shall perform the Work involved promptly. If Contractor believes that a Field Order justifies an adjustment in the Contract Price or Contract Times, or both, then before proceeding with the Work at issue, Contractor shall submit a Change Proposal as provided herein.

11.02 *Owner-Authorized Changes in the Work*

- A. Without invalidating the Contract and without notice to any surety, Owner may, at any time or from time to time, order additions, deletions, or revisions in the Work. Such changes shall be supported by Engineer's recommendation, to the extent the change involves the design (as set forth in the Drawings, Specifications, or otherwise), or other engineering or technical matters. Such changes may be accomplished by a Change Order, if Owner and Contractor have agreed as to the effect, if any, of the changes on Contract Times or Contract Price; or by a Work Change Directive. Upon receipt of any such document, Contractor shall promptly proceed with the Work involved; or, in the case of a deletion in the Work, promptly cease construction

activities with respect to such deleted Work. Added or revised Work shall be performed under the applicable conditions of the Contract Documents. Nothing in this paragraph shall obligate Contractor to undertake work that Contractor reasonably concludes cannot be performed in a manner consistent with Contractor's safety obligations under the Contract Documents or Laws and Regulations.

- B. Should the Contractor conclude that an unsafe condition exists, Contractor shall, upon recognizing the condition, immediately stop Work in the affected area and report the condition to the Owner, and Engineer in writing. Upon receipt of the Contractor's written notice, the Owner shall obtain the services of a third-party to verify the presence or absence of the unsafe condition reported by the Contractor and, in the event such condition is found to be present, to cause it to be rendered harmless. If such third-party determines that a hazardous condition exists, the costs of such third-party along with the costs of rendering the condition harmless shall be at the Owner's expense. If such third-party determines that a hazardous or unsafe condition does not exist, the costs of the third-party shall be at the Contractor's expense, provided such unsafe condition was not caused by the Contractor or any of its consultants, subcontractors or suppliers, of any tier. Work in the affected area shall be resumed immediately following the occurrence of any one of the following events: (i) the Owner causes remedial work to be performed that results in the hazardous condition being rendered harmless; or (ii) the Owner and the Contractor, by written agreement, decide to resume performance of the Work; or (iii) the Work may safely and lawfully proceed using appropriate protective measures, as determined by a competent person employed by the Owner.

11.03 *Unauthorized Changes in the Work*

- A. Contractor shall not be entitled to an increase in the Contract Price or an extension of the Contract Times with respect to any work performed that is not required by the Contract Documents, as amended, modified, or supplemented, except in the case of an emergency as provided in Paragraph 7.15 or in the case of uncovering Work as provided in Paragraph 14.05.
- B. Contractor shall not proceed with any change in the Work without the appropriate written authorization. The Contractor's failure to obtain prior written authorization for a change in the Work shall constitute a waiver by the Contractor of an adjustment to the Contract Price or Contract Time for the related Work.

11.04 *Change of Contract Price*

- A. The Contract Price may only be changed by a Change Order. Any Change Proposal for an adjustment in the Contract Price shall comply with the provisions of Paragraph 11.06. Any Claim for an adjustment of Contract Price shall comply with the provisions of Article 12.
- B. An adjustment in the Contract Price will be determined as follows:
 - 1. where the Work involved is covered by unit prices contained in the Contract Documents, then by application of such unit prices to the quantities of the items involved (subject to the provisions of Paragraph 13.03); or
 - 2. where the Work involved is not covered by unit prices contained in the Contract Documents, then by a mutually agreed lump sum (which may include an allowance for overhead and profit not necessarily in accordance with Paragraph 11.04.C.2); or

3. where the Work involved is not covered by unit prices contained in the Contract Documents and the parties do not reach mutual agreement to a lump sum, then on the basis of the Cost of the Work (determined as provided in Paragraph 13.01) plus a Contractor's fee for overhead and profit (determined as provided in Paragraph 11.04.C).
- C. *Contractor's Fee*: When applicable, the Contractor's fee for overhead and profit shall be determined as follows:
1. a mutually acceptable fixed fee; or
 2. if a fixed fee is not agreed upon, then a fee based on the following percentages of the various portions of the Cost of the Work:
 - a. for costs incurred under Paragraphs 13.01.B.1 and 13.01.B.2, the Contractor's fee shall be 15 percent;
 - b. for costs incurred under Paragraph 13.01.B.3, the Contractor's fee shall be five percent;
 - c. where one or more tiers of subcontracts are on the basis of Cost of the Work plus a fee and no fixed fee is agreed upon, the intent of Paragraphs 11.01.C.2.a and 11.01.C.2.b is that the Contractor's fee shall be based on: (1) a fee of 15 percent of the costs incurred under Paragraphs 13.01.A.1 and 13.01.A.2 by the Subcontractor that actually performs the Work, at whatever tier, and (2) with respect to Contractor itself and to any Subcontractors of a tier higher than that of the Subcontractor that actually performs the Work, a fee of five percent of the amount (fee plus underlying costs incurred) attributable to the next lower tier Subcontractor; provided, however, that for any such subcontracted work the maximum total fee to be paid by Owner shall be no greater than 27 percent of the costs incurred by the Subcontractor that actually performs the work;
 - d. no fee shall be payable on the basis of costs itemized under Paragraphs 13.01.B.4, 13.01.B.5, and 13.01.C;
 - e. the amount of credit to be allowed by Contractor to Owner for any change which results in a net decrease in cost will be the amount of the actual net decrease in cost plus a deduction in Contractor's fee by an amount equal to five percent of such net decrease; and
 - f. when both additions and credits are involved in any one change, the adjustment in Contractor's fee shall be computed on the basis of the net change in accordance with Paragraphs 11.04.C.2.a through 11.04.C.2.e, inclusive.

11.05 *Change of Contract Times*

- A. The Contract Times may only be changed by a Change Order. Any Change Proposal for an adjustment in the Contract Times shall comply with the provisions of Paragraph 11.06. Any Claim for an adjustment in the Contract Times shall comply with the provisions of Article 12.
- B. An adjustment of the Contract Times shall be subject to the limitations set forth in Paragraph 4.05, concerning delays in Contractor's progress.

11.06 *Change Proposals*

- A. Contractor shall submit a Change Proposal to Engineer to request an adjustment in the Contract Times or Contract Price; appeal an initial decision by Engineer concerning the requirements of the Contract Documents or relating to the acceptability of the Work under the Contract Documents; contest a set-off against payment due; or seek other relief under the Contract. The Change Proposal shall specify any proposed change in Contract Times or Contract Price, or both, or other proposed relief, and explain the reason for the proposed change, with citations to any governing or applicable provisions of the Contract Documents.
1. *Procedures:* Contractor shall submit each Change Proposal to Engineer promptly (but in no event later than 10 days) after the start of the event giving rise thereto, or after such initial decision. The Contractor's obligation to deliver a fully completed Change Proposal within such 10-day period is a material term of the Contract Documents and provides the Owner with the opportunity to mitigate its damages. Failure to provide a written Change Proposal within the time period specified herein shall constitute a waiver by the Contractor of its rights to an adjustment to the Contract Time or Contract Price for the Work that is the subject matter of the Change Proposal. The Contractor shall submit supporting data, including the proposed change in Contract Price or Contract Time (if any), to the Engineer and Owner within 10 days after the submittal of the Change Proposal. The supporting data shall be accompanied by a written statement that the supporting data are accurate and complete, and that any requested time or price adjustment is the entire adjustment to which Contractor believes it is entitled as a result of said event. Engineer will advise Owner regarding the Change Proposal, and consider any comments or response from Owner regarding the Change Proposal.
 2. *Engineer's Action:* Engineer will review each Change Proposal and, within 30 days after receipt of the Contractor's supporting data, either deny the Change Proposal in whole, approve it in whole, or deny it in part and approve it in part. Such actions shall be in writing, with a copy provided to Owner and Contractor. If Engineer does not take action on the Change Proposal within 30 days, then the Change Proposal is deemed denied, thereby commencing the time for appeal of the denial under Article 12.
 3. *Binding Decision:* Engineer's decision will be final and binding upon Owner and Contractor, unless Owner or Contractor appeals the decision by filing a Claim under Article 12.
- B. *Resolution of Certain Change Proposals:* If the Change Proposal does not involve the design (as set forth in the Drawings, Specifications, or otherwise), the acceptability of the Work, or other engineering or technical matters, then Engineer will notify the parties that the Engineer is unable to resolve the Change Proposal. For purposes of further resolution of such a Change Proposal, such notice shall be deemed a denial, and Contractor may choose to seek resolution under the terms of Article 12.

11.07 *Execution of Change Orders*

- A. Owner and Contractor shall execute appropriate Change Orders covering:
1. changes in the Contract Price or Contract Times which are agreed to by the parties, including any undisputed sum or amount of time for Work actually performed in accordance with a Work Change Directive;

2. changes in Contract Price resulting from an Owner set-off, unless Contractor has duly contested such set-off;
 3. changes in the Work which are: (a) ordered by Owner pursuant to Paragraph 11.02, (b) required because of Owner's acceptance of defective Work under Paragraph 14.04 or Owner's correction of defective Work under Paragraph 14.07, or (c) agreed to by the parties, subject to the need for Engineer's recommendation if the change in the Work involves the design (as set forth in the Drawings, Specifications, or otherwise), or other engineering or technical matters; and
 4. changes in the Contract Price or Contract Times, or other changes, which embody the substance of any final and binding results under Paragraph 11.06, or Article 12.
- B. If Owner or Contractor refuses to execute a Change Order that is required to be executed under the terms of this Paragraph 11.07, it shall be deemed to be of full force and effect, as if fully executed.

11.08 *Notification to Surety*

- A. If the provisions of any bond require notice to be given to a surety of any change affecting the general scope of the Work or the provisions of the Contract Documents (including, but not limited to, Contract Price or Contract Times), the giving of any such notice will be Contractor's responsibility. The amount of each applicable bond will be adjusted to reflect the effect of any such change and the surety shall be obligated, with respect to any change, regardless of any failure to provide notice to the surety of any such change.

ARTICLE 12 – CLAIMS

12.01 *Claims*

- A. *Claims Process:* The following disputes between Owner and Contractor shall be submitted to the Claims process set forth in this Article:
1. Appeals by Owner or Contractor of Engineer's decisions regarding Change Proposals;
 2. Owner demands for adjustments in the Contract Price or Contract Times, or other relief under the Contract Documents; and
 3. Disputes that Engineer has been unable to address because they do not involve the design (as set forth in the Drawings, Specifications, or otherwise), the acceptability of the Work, or other engineering or technical matters.
- B. *Submittal of Claim:* The Contractor shall deliver its claim directly to the Owner promptly (but in no event later than 10 days) after the start of the event giving rise thereto; in the case of appeals regarding Change Proposals within 10 days of the decision under appeal. The Contractor shall also furnish a copy to the Engineer, for its information only. The responsibility to substantiate a Claim shall rest with the party making the Claim. For each Claim the Contractor shall deliver a fully completed Statement of Claim Form, a copy of which form is a Contract Document, to the Engineer and the Owner. The Contractor's obligation to deliver a fully completed Statement of Claim within such 10-day period is a material term of the Contract Documents and provides the Owner with the opportunity to mitigate its damages.

Failure to provide written notice of a Claim as specified herein shall constitute a waiver by the Contractor of any Claim for adjustment to the Contract Time or Contract Price.

1. *False or Fraudulent Claim.* The Contractor shall not knowingly present or cause to be presented to the Owner a false or fraudulent Claim. Knowingly shall have the same meaning as in Section 3729(b) USC of the Federal False Claims Act. If the Contractor knowingly presents or causes to be presented a false or fraudulent Claim, then the Contractor shall be liable to the Owner for the same civil penalty and damages as the United States Government would be entitled to recover under such Section 3729(a) USC and shall also indemnify and hold the Owner harmless from all costs and expenses, including Owner's attorneys' and consultants' fees and expenses incurred in investigating and defending against such Claim and in pursuing the collection of such penalty, damages and fees and expenses.
2. *Claim Documentation:* Within ten (10) days of written request from the Owner, Contractor shall make available to Owner or its representative any books, records, or other documents in its possession or to which it has access, including but not limited to Contractor's daily logs/reports, original estimates of Work and applicable agreements, correspondence with subcontractors and suppliers, internal correspondence (including e-mail), accounting records, and other information from which the Contractor's costs may be derived. To the extent permitted by law, the Owner shall keep the Project accounting records and estimate for the Project confidential. As requested by the Owner, the Contractor shall provide such documents and information in paper copies and/or computer format (including the format of the Contractor's accounting software and/or ASCII format). The Contractor's provision of the requested documents and information shall be a condition precedent to any further proceeding under the Contract Documents or to payment of an Application for Payment

Failure to provide the requested documents shall be a material breach of the Contract, and Contractor shall indemnify Owner for all of Owner's costs, losses, and damages (including but not limited to all fees and charges of engineers, architects, attorneys, and other professionals and all court or arbitration or other dispute resolution costs) arising out of or relating to Contractor's failure to comply with this provision. If the Contractor fails to provide the requested documents, the Contractor shall be precluded from presenting such documents in any subsequent dispute resolution proceedings, if the data was reasonably available at the time of the request.

- C. *Review and Resolution:* The party receiving a Claim shall review it thoroughly, giving full consideration to its merits. The two parties shall seek to resolve the Claim through the exchange of information and direct negotiations. The parties may extend the time for resolving the Claim by mutual agreement. All actions taken on a Claim shall be stated in writing and submitted to the other party, with a copy to Engineer.
- D. *Mediation:*
 1. Any claim not resolved through direct negotiation of the parties, within 30 days of the date of the claim, shall be subject to mediation.
 2. Owner and Contractor shall each pay one-half of the mediator's fees and costs.
- E. Any Claim not resolved through mediation shall be subject to the procedure set forth in Article 17 for the final resolution of disputes.

- F. *Final and Binding Results:* If the parties reach a mutual agreement regarding a Claim, whether through approval of the Claim, direct negotiations, mediation, or otherwise; or if a Claim is approved in part and denied in part, or denied in full, and such actions become final and binding; then the results of the agreement or action on the Claim shall be incorporated in a Change Order to the extent they affect the Contract, including the Work, the Contract Times, or the Contract Price.
- G. In the event that Contractor files a Claim or files an action against Owner, Owner shall be entitled to make an offer of settlement of the Claim to Contractor at any time up to the date of trial. Such offer of settlement shall not be admissible into evidence at the litigation except on the issue of entitlement to recovery of attorneys' fees, costs, and expenses. If at any stage of the litigation, including any appeals, Contractor's claim is dismissed or found to be without merit, or if the damages awarded to Contractor on its claim do not exceed Owner's offer of settlement, Contractor shall be liable to Owner and shall reimburse Owner for all attorneys fees, costs and expenses incurred by Owner from the date of the offer of settlement until the date of the final adjudication and resolution of Contractor's claim.

ARTICLE 13 – COST OF THE WORK; ALLOWANCES; UNIT PRICE WORK

13.01 *Cost of the Work*

- A. *Purposes for Determination of Cost of the Work:* The term Cost of the Work means the sum of all costs necessary for the proper performance of the Work at issue, as further defined below. The provisions of this Paragraph 13.01 are used for two distinct purposes:
 - 1. To determine Cost of the Work when Cost of the Work is a component of the Contract Price, under cost-plus-fee, time-and-materials, or other cost-based terms; or
 - 2. To determine the value of a Change Order, Change Proposal, Claim, set-off, or other adjustment in Contract Price. When the value of any such adjustment is determined on the basis of Cost of the Work, Contractor is entitled only to those additional or incremental costs required because of the change in the Work or because of the event giving rise to the adjustment.
- B. *Costs Included:* Except as otherwise may be agreed to in writing by Owner, costs included in the Cost of the Work shall be in amounts no higher than those prevailing in the locality of the Project, shall not include any of the costs itemized in Paragraph 13.01.C, and shall include only the following items:
 - 1. Payroll costs for employees in the direct employ of Contractor in the performance of the Work under schedules of job classifications agreed upon by Owner and Contractor. Such employees shall include, without limitation, superintendents, foremen, and other personnel employed full time on the Work. Payroll costs for employees not employed full time on the Work shall be apportioned on the basis of their time spent on the Work. Payroll costs shall include, but not be limited to, salaries and wages plus the cost of fringe benefits, which shall include social security contributions, unemployment, excise, and payroll taxes, workers' compensation, health and retirement benefits, bonuses, sick leave, and vacation and holiday pay applicable thereto. The expenses of performing Work outside of regular working hours, on Saturday, Sunday, or legal holidays, shall be included in the above to the extent authorized by Owner.

2. Cost of all materials and equipment furnished and incorporated in the Work, including costs of transportation and storage thereof, and Suppliers' field services required in connection therewith. All cash discounts shall accrue to Contractor unless Owner deposits funds with Contractor with which to make payments, in which case the cash discounts shall accrue to Owner. All trade discounts, rebates, and refunds and returns from sale of surplus materials and equipment shall accrue to Owner, and Contractor shall make provisions so that they may be obtained.
3. Payments made by Contractor to Subcontractors for Work performed by Subcontractors. If required by Owner, Contractor shall obtain competitive bids from subcontractors acceptable to Owner and Contractor and shall deliver such bids to Owner, who will then determine, with the advice of Engineer, which bids, if any, will be acceptable. If any subcontract provides that the Subcontractor is to be paid on the basis of Cost of the Work plus a fee, the Subcontractor's Cost of the Work and fee shall be determined in the same manner as Contractor's Cost of the Work and fee as provided in this Paragraph 13.01.
4. Costs of special consultants (including but not limited to engineers, architects, testing laboratories, surveyors, attorneys, and accountants) employed for services specifically related to the Work.
5. Supplemental costs including the following:
 - a. The proportion of necessary transportation, travel, and subsistence expenses of Contractor's employees incurred in discharge of duties connected with the Work.
 - b. Cost, including transportation and maintenance, of all materials, supplies, equipment, machinery, appliances, office, and temporary facilities at the Site, and hand tools not owned by the workers, which are consumed in the performance of the Work, and cost, less market value, of such items used but not consumed which remain the property of Contractor.
 - c. Rentals of all construction equipment and machinery, and the parts thereof, whether rented from Contractor or others in accordance with rental agreements approved by Owner with the advice of Engineer, and the costs of transportation, loading, unloading, assembly, dismantling, and removal thereof. All such costs shall be in accordance with the terms of said rental agreements. The rental of any such equipment, machinery, or parts shall cease when the use thereof is no longer necessary for the Work.
 - d. Sales, consumer, use, and other similar taxes related to the Work, and for which Contractor is liable, as imposed by Laws and Regulations.
 - e. Deposits lost for causes other than negligence of Contractor, any Subcontractor, or anyone directly or indirectly employed by any of them or for whose acts any of them may be liable, and royalty payments and fees for permits and licenses.
 - f. Losses and damages (and related expenses) caused by damage to the Work, not compensated by insurance or otherwise, sustained by Contractor in connection with the performance of the Work (except losses and damages within the deductible amounts of property insurance established in accordance with Paragraph 6.05), provided such losses and damages have resulted from causes other than the negligence of Contractor, any

Subcontractor, or anyone directly or indirectly employed by any of them or for whose acts any of them may be liable. Such losses shall include settlements made with the written consent and approval of Owner. No such losses, damages, and expenses shall be included in the Cost of the Work for the purpose of determining Contractor's fee.

- g. The cost of utilities, fuel, and sanitary facilities at the Site.
 - h. Minor expenses such as communication service at the Site, express and courier services, and similar petty cash items in connection with the Work.
 - i. The costs of premiums for all bonds and insurance that Contractor is required by the Contract Documents to purchase and maintain.
- C. *Costs Excluded:* The term Cost of the Work shall not include any of the following items:
 - 1. Payroll costs and other compensation of Contractor's officers, executives, principals (of partnerships and sole proprietorships), general managers, safety managers, engineers, architects, estimators, attorneys, auditors, accountants, purchasing and contracting agents, expeditors, timekeepers, clerks, and other personnel employed by Contractor, whether at the Site or in Contractor's principal or branch office for general administration of the Work and not specifically included in the agreed upon schedule of job classifications referred to in Paragraph 13.01.B.1 or specifically covered by Paragraph 13.01.B.4. The payroll costs and other compensation excluded here are to be considered administrative costs covered by the Contractor's fee.
 - 2. Expenses of Contractor's principal and branch offices other than Contractor's office at the Site.
 - 3. Any part of Contractor's capital expenses, including interest on Contractor's capital employed for the Work and charges against Contractor for delinquent payments.
 - 4. Costs due to the negligence of Contractor, any Subcontractor, or anyone directly or indirectly employed by any of them or for whose acts any of them may be liable, including but not limited to, the correction of defective Work, disposal of materials or equipment wrongly supplied, and making good any damage to property.
 - 5. Other overhead or general expense costs of any kind and the costs of any item not specifically and expressly included in Paragraph 13.01.B.
- D. *Contractor's Fee:* When the Work as a whole is performed on the basis of cost-plus, Contractor's fee shall be determined as set forth in the Agreement. When the value of any Work covered by a Change Order, Change Proposal, Claim, set-off, or other adjustment in Contract Price is determined on the basis of Cost of the Work, Contractor's fee shall be determined as set forth in Paragraph 11.04.C.
- E. *Documentation:* Whenever the Cost of the Work for any purpose is to be determined pursuant to this Article 13, Contractor will establish and maintain records thereof in accordance with generally accepted accounting practices and submit in a form acceptable to Engineer an itemized cost breakdown together with supporting data.

13.02 Allowances

- A. It is understood that Contractor has included in the Contract Price all allowances so named in the Contract Documents and shall cause the Work so covered to be performed for such sums and by such persons or entities as may be acceptable to Owner and Engineer.
- B. *Cash Allowances*: Contractor agrees that:
 - 1. the cash allowances include the cost to Contractor (less any applicable trade discounts) of materials and equipment required by the allowances to be delivered at the Site, and all applicable taxes; and
 - 2. Contractor's costs for unloading and handling on the Site, labor, installation, overhead, profit, and other expenses contemplated for the cash allowances have been included in the Contract Price and not in the allowances, and no demand for additional payment on account of any of the foregoing will be valid.
- C. *Contingency Allowance*: Contractor agrees that a contingency allowance, if any, is for the sole use of Owner to cover unanticipated costs.
- D. Prior to final payment, an appropriate Change Order will be issued as recommended by Engineer to reflect actual amounts due Contractor on account of Work covered by allowances, and the Contract Price shall be correspondingly adjusted.

13.03 Unit Price Work

- A. Where the Contract Documents provide that all or part of the Work is to be Unit Price Work, initially the Contract Price will be deemed to include for all Unit Price Work an amount equal to the sum of the unit price for each separately identified item of Unit Price Work times the estimated quantity of each item as indicated in the Agreement. Contractor shall not be paid for any Unit Price Work that represents an actual quantity greater than 10% of the estimated quantity, without a Change Order. The Contractor shall maintain such records as the Engineer may require to track the quantities of Unit Price Work.
- B. The estimated quantities of items of Unit Price Work are not guaranteed and are solely for the purpose of comparison of Bids and determining an initial Contract Price. Payments to Contractor for Unit Price Work will be based on actual quantities.
- C. Each unit price will be deemed to include an amount considered by Contractor to be adequate to cover Contractor's overhead and profit for each separately identified item.
- D. Engineer will determine the actual quantities and classifications of Unit Price Work performed by Contractor. Engineer will review with Contractor the Engineer's preliminary determinations on such matters before rendering a written decision thereon (by recommendation of an Application for Payment or otherwise). Engineer's written decision thereon will be final and binding (except as modified by Engineer to reflect changed factual conditions or more accurate data) upon Owner and Contractor, subject to the provisions of the following paragraph.
- E. Within 30 days of Engineer's written decision under the preceding paragraph, Contractor may submit a Change Proposal, or Owner may file a Claim, seeking an adjustment in the Contract Price if:

1. the quantity of any item of Unit Price Work performed by Contractor differs materially and significantly from the estimated quantity of such item indicated in the Agreement;
2. there is no corresponding adjustment with respect to any other item of Work; and
3. Contractor believes that it is entitled to an increase in Contract Price as a result of having incurred additional expense or Owner believes that Owner is entitled to a decrease in Contract Price, and the parties are unable to agree as to the amount of any such increase or decrease.

ARTICLE 14 – TESTS AND INSPECTIONS; CORRECTION, REMOVAL OR ACCEPTANCE OF DEFECTIVE WORK

14.01 *Access to Work*

- A. Owner, Engineer, their consultants and other representatives and personnel of Owner, independent testing laboratories, and authorities having jurisdiction will have access to the Site and the Work at reasonable times for their observation, inspection, and testing. Contractor shall provide them proper and safe conditions for such access and advise them of Contractor's safety procedures and programs so that they may comply therewith as applicable.

14.02 *Tests, Inspections, and Approvals*

- A. Contractor shall give Engineer timely notice of readiness of the Work (or specific parts thereof) for all required inspections and tests, and shall cooperate with inspection and testing personnel to facilitate required inspections and tests.
- B. If Laws or Regulations of any public body having jurisdiction require any Work (or part thereof) specifically to be inspected, tested, or approved by an employee or other representative of such public body, Contractor shall assume full responsibility for arranging and obtaining such inspections, tests, or approvals, pay all costs in connection therewith, and furnish Engineer the required certificates of inspection or approval.
- C. Contractor shall be responsible for arranging, obtaining, and paying for all inspections and tests required:
 1. by the Contract Documents, unless the Contract Documents expressly allocate responsibility for a specific inspection or test to Owner;
 2. to attain Owner's and Engineer's acceptance of materials or equipment to be incorporated in the Work;
 3. by manufacturers of equipment furnished under the Contract Documents;
 4. for testing, adjusting, and balancing of mechanical, electrical, and other equipment to be incorporated into the Work; and
 5. for acceptance of materials, mix designs, or equipment submitted for approval prior to Contractor's purchase thereof for incorporation in the Work.

Such inspections and tests shall be performed by independent inspectors, testing laboratories, or other qualified individuals or entities acceptable to Owner and Engineer.

- D. If the Contract Documents require the Work (or part thereof) to be approved by Owner, Engineer, or another designated individual or entity, then Contractor shall assume full responsibility for arranging and obtaining such approvals.
- E. If any Work (or the work of others) that is to be inspected, tested, or approved is covered by Contractor without written concurrence of Engineer, Contractor shall, if requested by Engineer, uncover such Work for observation. Such uncovering shall be at Contractor's expense unless Contractor had given Engineer timely notice of Contractor's intention to cover the same and Engineer had not acted with reasonable promptness in response to such notice.

14.03 *Defective Work*

- A. *Contractor's Obligation:* It is Contractor's obligation to assure that the Work is not defective.
- B. *Engineer's Authority:* Engineer has the authority to determine whether Work is defective, and to reject defective Work.
- C. *Notice of Defects:* Prompt notice of all defective Work of which Owner or Engineer has actual knowledge will be given to Contractor.
- D. *Correction, or Removal and Replacement:* Promptly after receipt of written notice of defective Work, Contractor shall, at its own expense, correct all such defective Work, whether or not fabricated, installed, or completed, or, if Engineer has rejected the defective Work, remove it from the Project and replace it with Work that is not defective.
- E. *Preservation of Warranties:* When correcting defective Work, Contractor shall take no action that would void or otherwise impair Owner's special warranty and guarantee, if any, on said Work.
- F. *Costs and Damages:* In addition to its correction, removal, and replacement obligations with respect to defective Work, Contractor shall pay all claims, costs, losses, and damages arising out of or relating to defective Work, including but not limited to legal fees, the cost of the inspection, testing, correction, removal, replacement, or reconstruction of such defective Work, fines levied against Owner by governmental authorities because the Work is defective, and the costs of repair or replacement of work of others resulting from defective Work. Prior to final payment, if Owner and Contractor are unable to agree as to the measure of such claims, costs, losses, and damages resulting from defective Work, then Owner may impose a reasonable set-off against payments due under Article 15.

14.04 *Acceptance of Defective Work*

- A. If, instead of requiring correction or removal and replacement of defective Work, Owner prefers to accept it, Owner may do so (subject, if such acceptance occurs prior to final payment, to Engineer's confirmation that such acceptance is in general accord with the design intent and applicable engineering principles, and will not endanger public safety). Contractor shall pay all claims, costs, losses, and damages attributable to Owner's evaluation of and determination to accept such defective Work (such costs to be approved by Engineer as to reasonableness), and for the diminished value of the Work to the extent not otherwise paid by Contractor. If any such acceptance occurs prior to final payment, the necessary revisions in the Contract Documents with respect to the Work shall be incorporated in a Change Order. If the parties are unable to agree as to the decrease in the Contract Price, reflecting the diminished value of Work so accepted, then Owner may impose a reasonable set-off against payments

due under Article 15. If the acceptance of defective Work occurs after final payment, Contractor shall pay an appropriate amount to Owner.

14.05 *Uncovering Work*

- A. Engineer has the authority to require special inspection or testing of the Work, whether or not the Work is fabricated, installed, or completed.
- B. If any Work is covered contrary to the written request of Engineer, then Contractor shall, if requested by Engineer, uncover such Work for Engineer's observation, and then replace the covering, all at Contractor's expense.
- C. If Engineer considers it necessary or advisable that covered Work be observed by Engineer or inspected or tested by others, then Contractor, at Engineer's request, shall uncover, expose, or otherwise make available for observation, inspection, or testing as Engineer may require, that portion of the Work in question, and provide all necessary labor, material, and equipment.
 - 1. If it is found that the uncovered Work is defective, Contractor shall be responsible for all claims, costs, losses, and damages arising out of or relating to such uncovering, exposure, observation, inspection, and testing, and of satisfactory replacement or reconstruction (including but not limited to all costs of repair or replacement of work of others); and pending Contractor's full discharge of this responsibility the Owner shall be entitled to impose a reasonable set-off against payments due under Article 15. Contractor shall not be entitled to any contract extension or additional payment resulting from such defective work.
 - 2. If the uncovered Work is not found to be defective, Contractor shall be allowed an increase in the Contract Price or an extension of the Contract Times, or both, directly attributable to such uncovering, exposure, observation, inspection, testing, replacement, and reconstruction. If the parties are unable to agree as to the amount or extent thereof, then Contractor may submit a Change Proposal within 30 days of the determination that the Work is not defective.

14.06 *Owner May Stop the Work*

- A. If the Work is defective, or Contractor fails to supply sufficient skilled workers or suitable materials or equipment, or fails to perform the Work in such a way that the completed Work will conform to the Contract Documents, then Owner may order Contractor to stop the Work, or any portion thereof, until the cause for such order has been eliminated; however, this right of Owner to stop the Work shall not give rise to any duty on the part of Owner to exercise this right for the benefit of Contractor, any Subcontractor, any Supplier, any other individual or entity, or any surety for, or employee or agent of any of them.

14.07 *Owner May Correct Defective Work*

- A. If Contractor fails within two business days (or such longer time as may be stated in the Notice) of a written notice from the Owner or Engineer to correct, or take reasonable steps to commence to correct, defective Work, or to remove and replace, or take responsible steps to commence to remove and replace rejected Work as required by Engineer, or if Contractor fails to perform the Work in accordance with the Contract Documents, or if Contractor fails to comply with any other provision of the Contract Documents, then Owner may, after seven days written notice to Contractor, correct or remedy any such deficiency. In such case an appropriate Change Order shall be issued deducting from payments then or thereafter due the Contractor all the costs, losses, and damages (including but not limited to all fees and charges of

engineers, architects, attorneys, and other professionals and all court or arbitration or other dispute resolution costs) incurred or sustained by Owner in exercising the rights and remedies under this Paragraph. If payments then or thereafter due the Contractor are not sufficient to cover such amounts, the Contractor shall pay the difference to the Owner. The Contractor irrevocably designates the Owner as the Contractor's attorney-in-fact to execute the Change Orders provided for in this Paragraph.

- B. In exercising the rights and remedies under this Paragraph 14.07, Owner shall proceed expeditiously. In connection with such corrective or remedial action, Owner may exclude Contractor from all or part of the Site, take possession of all or part of the Work and suspend Contractor's services related thereto, and incorporate in the Work all materials and equipment stored at the Site or for which Owner has paid Contractor but which are stored elsewhere. Contractor shall allow Owner, Owner's representatives, agents and employees, Owner's other contractors, and Engineer and Engineer's consultants access to the Site to enable Owner to exercise the rights and remedies under this paragraph.
- C. All claims, costs, losses, and damages incurred or sustained by Owner in exercising the rights and remedies under this Paragraph 14.07 will be charged against Contractor as set-offs against payments due under Article 15. Such claims, costs, losses and damages will include but not be limited to all costs of repair, or replacement of work of others destroyed or damaged by correction, removal, or replacement of Contractor's defective Work.
- D. Contractor shall not be allowed an extension of the Contract Times because of any delay in the performance of the Work attributable to the exercise by Owner of Owner's rights and remedies under this Paragraph 14.07.

ARTICLE 15 – PAYMENTS TO CONTRACTOR; SET-OFFS; COMPLETION; CORRECTION PERIOD

15.01 *Progress Payments*

- A. *Basis for Progress Payments:* The Schedule of Values established as provided in Article 2 will serve as the basis for progress payments and will be incorporated into a form of Application for Payment acceptable to Engineer. Progress payments on account of Unit Price Work will be based on the number of units completed during the pay period, as determined under the provisions of Paragraph 13.03. Progress payments for cost-based Work will be based on Cost of the Work completed by Contractor during the pay period. The Engineer-approved version of the Application for Payment form, which includes information on completed Schedule of Values items, is to be used by the Contractor when making an Application for Progress Payment.
- B. *Applications for Payments:*
 - 1. Not more often than once every 30 days, Contractor shall submit to Engineer for review an Application for Payment (including a Schedule of Values described in Paragraph 2.05.A of the Modified General Conditions) filled out and signed by Contractor covering the Work completed as of the date of the Application and accompanied by a properly completed Contractor's Payment Application Checklist, all the documentation required to be submitted with such Checklist, and any other supporting documentation required by the Contract Documents or by the Engineer. The Application for Payment will be in the form and submitted with the number of copies of it and all related documents as required by the

Contract Documents. If payment is requested on the basis of materials and equipment not incorporated in the Work but delivered and suitably stored at the Site or at another location agreed to in writing, the Application for Payment shall also be accompanied by a bill of sale, invoice, or other documentation warranting that Owner has received the materials and equipment free and clear of all Liens, and evidence that the materials and equipment are covered by appropriate property insurance, a warehouse bond, or other arrangements to protect Owner's interest therein, all of which must be satisfactory to Owner.

2. Beginning with the second Application for Payment, each Application shall include a) a Waiver and Release Agreement for itself and a Subcontractors – Suppliers Waiver and Release Agreement for each of its subcontractors, and b) a Contractor's Affidavit with List of Subcontractors and Suppliers with Amounts Withheld.
3. The amount of retainage with respect to payments will be as stipulated in the Agreement. The Owner and the Contractor agree that there shall be no escrow account required in connection with the Project; nor, shall retainage earn interest.

C. *Review of Applications:*

1. Engineer will, within 10 days after receipt of each Application for Payment, including each resubmittal, either indicate in writing a recommendation of payment and present the Application to Owner, or return the Application to Contractor indicating in writing Engineer's reasons for refusing to recommend payment. In the latter case, Contractor may make the necessary corrections and resubmit the Application.
2. Engineer's recommendation of any payment requested in an Application for Payment will constitute a representation by Engineer to Owner, based on Engineer's observations of the executed Work as an experienced and qualified design professional, and on Engineer's review of the Application for Payment and the accompanying data and schedules, that to the best of Engineer's knowledge, information and belief:
 - a. the Work has progressed to the point indicated;
 - b. the quality of the Work is generally in accordance with the Contract Documents (subject to an evaluation of the Work as a functioning whole prior to or upon Substantial Completion, the results of any subsequent tests called for in the Contract Documents, a final determination of quantities and classifications for Unit Price Work under Paragraph 13.03, and any other qualifications stated in the recommendation); and
 - c. the conditions precedent to Contractor's being entitled to such payment appear to have been fulfilled in so far as it is Engineer's responsibility to observe the Work.
3. By recommending any such payment Engineer will not thereby be deemed to have represented that:
 - a. inspections made to check the quality or the quantity of the Work as it has been performed have been exhaustive, extended to every aspect of the Work in progress, or involved detailed inspections of the Work beyond the responsibilities specifically assigned to Engineer in the Contract; or

- b. there may not be other matters or issues between the parties that might entitle Contractor to be paid additionally by Owner or entitle Owner to withhold payment to Contractor.
 - 4. Neither Engineer's review of Contractor's Work for the purposes of recommending payments nor Engineer's recommendation of any payment, including final payment, will impose responsibility on Engineer:
 - a. to supervise, direct, or control the Work, or
 - b. for the means, methods, techniques, sequences, or procedures of construction, or the safety precautions and programs incident thereto, or
 - c. for Contractor's failure to comply with Laws and Regulations applicable to Contractor's performance of the Work, or
 - d. to make any examination to ascertain how or for what purposes Contractor has used the money paid on account of the Contract Price, or
 - e. to determine that title to any of the Work, materials, or equipment has passed to Owner free and clear of any Liens.
 - 5. Engineer may refuse to recommend the whole or any part of any payment if, in Engineer's opinion, it would be incorrect to make the representations to Owner stated in Paragraph 15.01.C.2.
 - 6. Engineer will recommend reductions in payment (set-offs) necessary in Engineer's opinion to protect Owner from loss because:
 - a. the Work is defective, requiring correction or replacement;
 - b. the Contract Price has been reduced by Change Orders;
 - c. Owner has been required to correct defective Work in accordance with Paragraph 14.07, or has accepted defective Work pursuant to Paragraph 14.04;
 - d. Owner has been required to remove or remediate a Hazardous Environmental Condition for which Contractor is responsible; or
 - e. Engineer has actual knowledge of the occurrence of any of the events that would constitute a default by Contractor and therefore justify termination for cause under the Contract Documents.
 - f. The Contractor is in default of any other Agreement it has with the Owner.
- D. *Payment Becomes Due:*
- 1. Ten days after presentation of the Application for Payment, the Payment Application Checklist, and all required documentation to Owner with Engineer's recommendation and the approval of any agencies and/or lenders, the amount recommended and approved will (subject to the provisions of Paragraph 14.02.D) become due, and when due will be paid by Owner to Contractor.

E. *Reductions in Payment by Owner.*

1. In addition to any reductions in payment (set-offs) recommended by Engineer, Owner is entitled to impose a set-off against payment based on any of the following:
 - a. claims have been made against Owner on account of Contractor's conduct in the performance or furnishing of the Work, or Owner has incurred costs, losses, or damages on account of Contractor's conduct in the performance or furnishing of the Work, including but not limited to claims, costs, losses, or damages from workplace injuries, adjacent property damage, non-compliance with Laws and Regulations, and patent infringement;
 - b. Contractor has failed to take reasonable and customary measures to avoid damage, delay, disruption, and interference with other work at or adjacent to the Site;
 - c. Contractor has failed to provide and maintain required bonds or insurance;
 - d. Owner has been required to remove or remediate a Hazardous Environmental Condition for which Contractor is responsible;
 - e. Owner has incurred extra charges or engineering costs related to submittal reviews, evaluations of proposed substitutes, tests and inspections, or return visits to manufacturing or assembly facilities;
 - f. the Work is defective, requiring correction or replacement;
 - g. Owner has been required to correct defective Work in accordance with Paragraph 14.07, or has accepted defective Work pursuant to Paragraph 14.04;
 - h. the Contract Price has been reduced by Change Orders;
 - i. an event that would constitute a default by Contractor and therefore justify a termination for cause has occurred;
 - j. liquidated damages have accrued as a result of Contractor's failure to achieve Milestones, Substantial Completion, or final completion of the Work;
 - k. Liens have been filed in connection with the Work;
 - l. there are other items entitling Owner to a set off against the amount recommended.
2. If Owner imposes any set-off against payment, whether based on its own knowledge or on the written recommendations of Engineer, Owner will give Contractor immediate written notice (with a copy to Engineer) stating the reasons for such action and the specific amount of the reduction, and promptly pay Contractor any amount remaining after deduction of the amount so withheld. Owner shall promptly pay Contractor the amount so withheld, or any adjustment thereto agreed to by Owner and Contractor, if Contractor remedies the reasons for such action. The reduction imposed shall be binding on Contractor unless it duly submits a Change Proposal contesting the reduction.

15.02 *Contractor's Warranty of Title*

- A. Contractor warrants and guarantees that title to all Work, materials, and equipment furnished under the Contract will pass to Owner free and clear of (1) all Liens and

other title defects, and (2) all patent, licensing, copyright, or royalty obligations, no later than seven days after the time of payment by Owner.

15.03 *Substantial Completion*

- A. When Contractor considers the entire Work ready for its intended use Contractor shall notify Owner and Engineer in writing that the entire Work is substantially complete and request that Engineer issue a certificate of Substantial Completion. Contractor shall at the same time submit to Owner and Engineer an initial draft of punch list items to be completed or corrected before final payment.
- B. Promptly after Contractor's notification, Owner, Contractor, and Engineer shall make an inspection of the Work to determine the status of completion. If Engineer does not consider the Work substantially complete, Engineer will notify Contractor in writing giving the reasons therefor.
- C. If Engineer considers the Work substantially complete, Engineer will deliver to Owner a preliminary certificate of Substantial Completion which shall fix the date of Substantial Completion. Engineer shall attach to the certificate a punch list of items to be completed or corrected before final payment. Owner shall have seven days after receipt of the preliminary certificate during which to make written objection to Engineer as to any provisions of the certificate or attached punch list. If, after considering the objections to the provisions of the preliminary certificate, Engineer concludes that the Work is not substantially complete, Engineer will, within 14 days after submission of the preliminary certificate to Owner, notify Contractor in writing that the Work is not substantially complete, stating the reasons therefor. If Owner does not object to the provisions of the certificate, or if despite consideration of Owner's objections Engineer concludes that the Work is substantially complete, then Engineer will, within said 14 days, execute and deliver to Owner and Contractor a final certificate of Substantial Completion (with a revised punch list of items to be completed or corrected) reflecting such changes from the preliminary certificate as Engineer believes justified after consideration of any objections from Owner.
- D. At the time of receipt of the preliminary certificate of Substantial Completion, Owner and Contractor will confer regarding Owner's use or occupancy of the Work following Substantial Completion, review the builder's risk insurance policy with respect to the end of the builder's risk coverage, and confirm the transition to coverage of the Work under a permanent property insurance policy held by Owner. Unless Owner and Contractor agree otherwise in writing, Owner shall bear responsibility for security, operation, protection of the Work, property insurance, maintenance, heat, and utilities upon Owner's use or occupancy of the Work.
- E. After Substantial Completion the Contractor shall promptly begin work on the punch list of items to be completed or corrected prior to final payment. In appropriate cases Contractor may submit monthly Applications for Payment for completed punch list items, following the progress payment procedures set forth above.
- F. Owner shall have the right to exclude Contractor from the Site after the date of Substantial Completion subject to allowing Contractor reasonable access to remove its property and complete or correct items on the punch list.
- G. Time for Completion of Items on Tentative List and Remedies. The time fixed by the Engineer for the completion of all items on the list accompanying the tentative certificate of Substantial Completion shall not be greater than forty-five (45). The Contractor shall complete all items on the list within such 45-day period. If the Contractor fails to do so, the Owner in its discretion may perform the Work by itself or

others and the cost thereof shall be charged to the Contractor. The Contractor irrevocably designates the Owner as the Contractor's attorney-in-fact to execute a Change Order deducting such cost from the balance of the Contract Price and also any additional costs or expenses incurred by the Owner arising out of or related to the failure of the Contractor to complete such items, including but not limited to attorneys', consultants', and Engineer's fees. The Contractor's warranties under the Contract Documents shall remain in full force and effect and cover any remedial Work, even if performed by others. If more than one inspection by the Engineer for purposes of evaluating corrected Work is required, it will be performed at the Contractor's expense.

15.04 *Partial Use or Occupancy*

- A. Prior to Substantial Completion of all the Work, Owner may use or occupy any substantially completed part of the Work which has specifically been identified in the Contract Documents, or which Owner, Engineer, and Contractor agree constitutes a separately functioning and usable part of the Work that can be used by Owner for its intended purpose without significant interference with Contractor's performance of the remainder of the Work, subject to the following conditions:
 - 1. At any time Owner may request in writing that Contractor permit Owner to use or occupy any such part of the Work that Owner believes to be substantially complete. If and when Contractor agrees that such part of the Work is substantially complete, Contractor, Owner, and Engineer will follow the procedures of Paragraph 15.03.A through E for that part of the Work.
 - 2. At any time Contractor may notify Owner and Engineer in writing that Contractor considers any such part of the Work substantially complete and request Engineer to issue a certificate of Substantial Completion for that part of the Work.
 - 3. Within a reasonable time after either such request, Owner, Contractor, and Engineer shall make an inspection of that part of the Work to determine its status of completion. If Engineer does not consider that part of the Work to be substantially complete, Engineer will notify Owner and Contractor in writing giving the reasons therefor. If Engineer considers that part of the Work to be substantially complete, the provisions of Paragraph 15.03 will apply with respect to certification of Substantial Completion of that part of the Work and the division of responsibility in respect thereof and access thereto.
 - 4. No use or occupancy or separate operation of part of the Work may occur prior to compliance with the requirements of Paragraph 6.05 regarding builder's risk or other property insurance.
- B. Owner may at any time request Contractor in writing to permit Owner to take over operation of any part of the Work although it is not substantially complete. A copy of such request will be sent to Engineer, and within a reasonable time thereafter, Owner, Contractor, and Engineer shall inspect that part of the Work to determine its status of completion and will prepare a list of the items remaining to be completed or corrected thereon before final payment. If Contractor does not object in writing to Owner and Engineer that such part of the Work is not ready for separate operation by Owner, Engineer will finalize the list of items to be completed or corrected and will deliver such lists to Owner and Contractor together with a written recommendation as to the division of responsibilities pending final payment between Owner and Contractor with respect to security, operation, safety, maintenance, utilities, insurance, warranties, and guarantees for that part of the Work which will become binding upon Owner and

Contractor at the time when Owner takes over such operation (unless they shall have otherwise agreed in writing and so informed Engineer). During such operation and prior to Substantial Completion of such part of the Work, Owner shall allow Contractor reasonable access to complete or correct items on said list and to complete other related Work.

15.05 *Final Inspection*

- A. Upon written notice from Contractor that the entire Work or an agreed portion thereof is complete, Engineer will promptly make a final inspection with Owner and Contractor and will notify Contractor in writing of all particulars in which this inspection reveals that the Work, or agreed portion thereof, is incomplete or defective. Contractor shall immediately take such measures as are necessary to complete such Work or remedy such deficiencies.

15.06 *Final Payment*

A. *Application for Payment:*

1. After Contractor has, in the opinion of Engineer, satisfactorily completed all corrections identified during the final inspection and has delivered, in accordance with the Contract Documents, all maintenance and operating instructions, schedules, guarantees, bonds, certificates or other evidence of insurance, certificates of inspection, annotated record documents (as provided in Paragraph 7.11), and other documents, Contractor may make application for final payment.
2. The final Application for Payment shall be accompanied (except as previously delivered) by:
 - a. all documentation called for in the Contract Documents;
 - b. consent of the surety, if any, to final payment;
 - c. satisfactory evidence that all title issues have been resolved such that title to all Work, materials, and equipment has passed to Owner free and clear of any Liens or other title defects, or will so pass upon final payment; and
 - d. a list of all disputes that Contractor believes are unsettled;
3. Contractor's Waiver and Release Agreement for itself as of the date of the Final Application for Payment and Subcontractors – Suppliers Waiver and Release Agreements for each of its Subcontractors and Suppliers as of the date of the Final Application for Payment. If any Subcontractor or Supplier fails to furnish such a release or receipt in full, Contractor may furnish a bond or other collateral satisfactory to Owner to indemnify Owner against any Lien, or Owner at its option may issue joint checks payable to Contractor and specified Subcontractors and Suppliers.

B. *Engineer's Review of Application and Acceptance:*

1. If, on the basis of Engineer's observation of the Work during construction and final inspection, and Engineer's review of the final Application for Payment and accompanying documentation as required by the Contract Documents, Engineer is satisfied that the Work has been completed and Contractor's other obligations under the Contract have been fulfilled, Engineer will, within ten days after receipt of the final Application for Payment, indicate in writing Engineer's recommendation of final payment and present the Application for Payment to Owner for payment. Such recommendation shall account for any set-offs against

payment that are necessary in Engineer's opinion to protect Owner from loss for the reasons stated above with respect to progress payments. At the same time Engineer will also give written notice to Owner and Contractor that the Work is acceptable, subject to the provisions of Paragraph 15.07. Otherwise, Engineer will return the Application for Payment to Contractor, indicating in writing the reasons for refusing to recommend final payment, in which case Contractor shall make the necessary corrections and resubmit the Application for Payment.

- C. *Completion of Work:* The Work is complete (subject to surviving obligations) when it is ready for final payment as established by the Engineer's written recommendation of final payment.
- D. *Payment Becomes Due:* Thirty days after the presentation to Owner of the final Application for Payment and accompanying documentation, the amount recommended by Engineer (less any further sum Owner is entitled to set off against Engineer's recommendation, including but not limited to set-offs for liquidated damages and set-offs allowed under the provisions above with respect to progress payments) will become due and shall be paid by Owner to Contractor.

15.07 *Waiver of Claims*

- A. The making of final payment will not constitute a waiver by Owner of claims or rights against Contractor. Owner expressly reserves claims and rights arising from unsettled Liens, from defective Work appearing after final inspection pursuant to Paragraph 15.05, from Contractor's failure to comply with the Contract Documents or the terms of any special guarantees specified therein, from outstanding Claims by Owner, or from Contractor's continuing obligations under the Contract Documents.
- B. The acceptance of final payment by Contractor will constitute a waiver by Contractor of all claims and rights against Owner other than those pending matters that have been duly submitted or appealed under the provisions of Article 17.

15.08 *Correction Period*

- A. If within one year after the date of Substantial Completion (or such longer period of time as may be prescribed by the terms of any applicable special guarantee required by the Contract Documents, or by any specific provision of the Contract Documents), any Work is found to be defective, or if the repair of any damages to the Site, adjacent areas that Contractor has arranged to use through construction easements or otherwise, and other adjacent areas used by Contractor as permitted by Laws and Regulations, is found to be defective, then Contractor shall promptly, without cost to Owner and in accordance with Owner's written instructions:
 - 1. correct the defective repairs to the Site or such other adjacent areas;
 - 2. correct such defective Work;
 - 3. if the defective Work has been rejected by Owner, remove it from the Project and replace it with Work that is not defective, and
 - 4. satisfactorily correct or repair or remove and replace any damage to other Work, to the work of others, or to other land or areas resulting therefrom.
- B. If Contractor does not promptly comply with the terms of Owner's written instructions, or in an emergency where delay would cause serious risk of loss or damage, Owner may have the defective Work corrected or repaired or may have the rejected Work removed and replaced. Contractor shall pay all claims, costs, losses, and damages (including but not limited to all fees and charges of engineers, architects, attorneys,

and other professionals and all court or arbitration or other dispute resolution costs) arising out of or relating to such correction or repair or such removal and replacement (including but not limited to all costs of repair or replacement of work of others).

- C. In special circumstances where a particular item of equipment is placed in continuous service before Substantial Completion of all the Work, the correction period for that item may start to run from an earlier date if so provided in the Specifications.
- D. Where defective Work (and damage to other Work resulting therefrom) has been corrected or removed and replaced under this paragraph, the correction period hereunder with respect to such Work will be extended for an additional period of one year after such correction or removal and replacement has been satisfactorily completed.
- E. Contractor's obligations under this paragraph are in addition to all other obligations and warranties. The provisions of this paragraph shall not be construed as a substitute for, or a waiver of, the provisions of any applicable statute of limitation or repose.

ARTICLE 16 – SUSPENSION OF WORK AND TERMINATION

16.01 *Owner May Suspend Work*

- A. At any time and without cause, Owner may suspend the Work or any portion thereof for a period of not more than 90 consecutive days by written notice to Contractor and Engineer. Such notice will fix the date on which Work will be resumed. Contractor shall resume the Work on the date so fixed. Contractor shall be entitled to an adjustment in the Contract Price or an extension of the Contract Times, or both, directly attributable to any such suspension. Any Change Proposal seeking such adjustments shall be submitted no later than 30 days after the date fixed for resumption of Work.

16.02 *Owner May Terminate for Cause*

- A. The occurrence of any one or more of the following events will constitute a default by Contractor and justify termination for cause:
 - 1. Contractor's failure to perform the Work in accordance with the Contract Documents (including, but not limited to, failure to supply sufficient skilled workers or suitable materials or equipment or failure to adhere to the Progress Schedule);
 - 2. Failure of Contractor to perform or otherwise to comply with a material term of the Contract Documents;
 - 3. Contractor's disregard of Laws or Regulations of any public body having jurisdiction; or
 - 4. Contractor's repeated disregard of the authority of Owner or Engineer.
- B. If one or more of the events identified in Paragraph 16.02.A occurs, then after giving Contractor (and any surety) 3 days written notice that Owner is considering a declaration that Contractor is in default and termination of the contract, Owner may proceed to:
 - 1. declare Contractor to be in default, and give Contractor (and any surety) notice that the Contract is terminated. Such termination shall be effective as of the date stated in the termination notice provided to Contractor; and

2. enforce the rights available to Owner under any applicable performance bond.
- C. If Owner has terminated the Contract for cause, Owner may exclude Contractor from the Site, take possession of the Work, incorporate in the Work all materials and equipment stored at the Site or for which Owner has paid Contractor but which are stored elsewhere, and complete the Work as Owner may deem expedient.
- D. Owner may not proceed with termination of the Contract under Paragraph 16.02.B if Contractor within seven days of receipt of notice of intent to terminate begins to correct its failure to perform and proceeds diligently to cure such failure.
- E. If Owner proceeds as provided in Paragraph 16.02.B, Contractor shall not be entitled to receive any further payment until the Work is completed. If the unpaid balance of the Contract Price exceeds the cost to complete the Work, including all related claims, costs, losses, and damages (including but not limited to all fees and charges of engineers, architects, attorneys, and other professionals) sustained by Owner, such excess will be paid to Contractor. If the cost to complete the Work including such related claims, costs, losses, and damages exceeds such unpaid balance, Contractor shall pay the difference to Owner. Such claims, costs, losses, and damages incurred by Owner will be reviewed by Engineer as to their reasonableness and, when so approved by Engineer, incorporated in a Change Order. When exercising any rights or remedies under this paragraph, Owner shall not be required to obtain the lowest price for the Work performed.
- F. Where Contractor's services have been so terminated by Owner, the termination will not affect any rights or remedies of Owner against Contractor then existing or which may thereafter accrue, or any rights or remedies of Owner against Contractor or any surety under any payment bond or performance bond. Any retention or payment of money due Contractor by Owner will not release Contractor from liability.
- G. If and to the extent that Contractor has provided a performance bond under the provisions of Paragraph 6.01.A, the provisions of that bond shall govern over any inconsistent provisions of Paragraphs 16.02.B and 16.02.D.

16.03 Owner May Terminate For Convenience

- A. Upon three days written notice to Contractor and Engineer, Owner may, without cause and without prejudice to any other right or remedy of Owner, terminate the Contract. In such case, Contractor shall be paid for (without duplication of any items). Such termination shall be effective as of the date stated in the written notice:
 1. completed and acceptable Work as defined in the Contract Documents executed in accordance with the Contract Documents prior to the effective date of termination, including fair and reasonable sums for overhead and profit on such Work;
 2. expenses sustained prior to the effective date of termination in performing services and furnishing labor, materials, or equipment as required by the Contract Documents in connection with uncompleted Work, plus fair and reasonable sums for overhead and profit on such expenses; and
 3. other reasonable expenses directly attributable to termination, including costs incurred to prepare a termination for convenience cost proposal.
- B. Contractor shall not be paid on account of loss of anticipated overhead, profits, or revenue, or other economic loss arising out of or resulting from such termination.

16.04 *Contractor May Stop Work or Terminate*

- A. If, through no act or fault of Contractor, (1) the Work is suspended for more than 90 consecutive days by Owner or under an order of court or other public authority, or (2) Engineer fails to act on any Application for Payment within 30 days after it is submitted, or (3) Owner fails for 30 days to pay Contractor any sum finally determined to be due, then Contractor may, upon seven days written notice to Owner and Engineer, and provided Owner or Engineer do not remedy such suspension or failure within that time, terminate the contract and recover from Owner payment on the same terms as provided in Paragraph 16.03.
- B. In lieu of terminating the Contract and without prejudice to any other right or remedy, if Engineer has failed to act on an Application for Payment within 30 days after it is submitted, or Owner has failed for 30 days to pay Contractor any sum finally determined to be due, Contractor may, seven days after written notice to Owner and Engineer, stop the Work until payment is made of all such amounts due Contractor, including interest thereon. The provisions of this paragraph are not intended to preclude Contractor from submitting a Change Proposal for an adjustment in Contract Price or Contract Times or otherwise for expenses or damage directly attributable to Contractor's stopping the Work as permitted by this paragraph.
- C. Contractor shall require similar provisions contained in this Article 16 in each of its subcontracts to protect Contractor from claims by Subcontractors arising from the Owner's termination for convenience, or to minimize claims by such subcontractors. The remedy provided to Contractor under this Paragraph shall be the Contractor's sole remedy in the event of termination for convenience by Owner.

ARTICLE 17 – FINAL RESOLUTION OF DISPUTES

17.01 *Methods and Procedures*

- A. Any Claim not resolved by mediation or within 60 days of the date of the Claim shall be subject to litigation. Any lawsuit which may be brought to enforce any provision of this Contract or any remedy with respect thereto, shall be brought in a state court of competent jurisdiction in the county in which the Owner is located and each party expressly consents to the jurisdiction of such court. Each party expressly waives its right to remove any such suit to federal court.

ARTICLE 18 – MISCELLANEOUS

18.01 *Giving Notice*

- A. Whenever any provision of the Contract Documents requires the giving of written notice, it will be deemed to have been validly given if:
 - 1. delivered in person, by a commercial courier service or otherwise, to the individual or to a member of the firm or to an officer of the corporation for which it is intended; or
 - 2. delivered at or sent by registered or certified mail, postage prepaid, to the last business address known to the sender of the notice.

18.02 *Computation of Times*

- A. When any period of time is referred to in the Contract by days, it will be computed to exclude the first and include the last day of such period. If the last day of any such

period falls on a Saturday or Sunday or on a day made a legal holiday by the law of the applicable jurisdiction, such day will be omitted from the computation.

18.03 Cumulative Remedies

- A. The duties and obligations imposed by these General Conditions and the rights and remedies available hereunder to the parties hereto are in addition to, and are not to be construed in any way as a limitation of, any rights and remedies available to any or all of them which are otherwise imposed or available by Laws or Regulations, by special warranty or guarantee, or by other provisions of the Contract. The provisions of this paragraph will be as effective as if repeated specifically in the Contract Documents in connection with each particular duty, obligation, right, and remedy to which they apply.

18.04 Limitation of Damages

- A. With respect to any and all Change Proposals, Claims, disputes subject to final resolution, and other matters at issue, neither Owner nor Engineer, nor any of their officers, directors, members, partners, employees, agents, consultants, or subcontractors, shall be liable to Contractor for any claims, costs, losses, or damages sustained by Contractor on or in connection with any other project or anticipated project.
- B. The Contractor waives Claims against the Owner for consequential damages arising out of or relating to this Contract. This waiver includes but is not limited to:
 - 1. damages incurred by the Contractor for principal office expenses including the compensation of personnel stationed there, for losses of financing, business and reputation, loss of bonding capacity and for loss of profit except anticipated profit arising directly from the Work.
- C. The waiver in Paragraph 18.04(B) is applicable, without limitation, to all consequential damages due to either party's termination in accordance with the terms of the Contract. Nothing contained in this Paragraph 18.04 shall be deemed to preclude an award of liquidated damages, when applicable, in accordance with the requirements of the Contract Documents.

18.05 No Waiver

- A. The Owner's non-enforcement of any provision shall not constitute a waiver of that provision, nor shall it affect the enforceability of that provision or of the remainder of this Contract.

18.06 Survival of Obligations

- A. All representations, indemnifications, warranties, and guarantees made in, required by, or given in accordance with the Contract, as well as all continuing obligations indicated in the Contract, will survive final payment, completion, and acceptance of the Work or termination or completion of the Contract or termination of the services of Contractor.

18.07 Controlling Law

- A. This Contract is to be governed by the law of the state in which the Project is located.

18.08 Headings

- A. Article and paragraph headings are inserted for convenience only and do not constitute parts of these General Conditions.

**STATE OF OHIO BUREAU OF WORKER'S COMPENSATION INSURANCE
CERTIFICATE ATTACHMENT SHEET**



**Bureau of Workers'
Compensation**

30 W. Spring St.
Columbus, OH 43215

Certificate of Ohio Workers' Compensation


This certifies that the employer listed below participates in the Ohio State Insurance Fund as required by law. Therefore, the employer is entitled to the rights and benefits of the fund for the period specified. This certificate is only valid if premiums and assessments, including installments, are paid by the applicable due date. To verify coverage, visit www.bwc.ohio.gov, or call 1-800-644-6292.

This certificate must be conspicuously posted.

Policy number and employer
00294130

Period Specified Below
07/01/2023 to 07/01/2024

STRAWSER PAVING CO INC
1595 FRANK RD
COLUMBUS OH 43223-3737

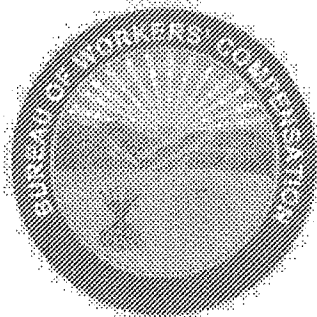

www.bwc.ohio.gov
Issued by: BWC

Administrator/CEO

You can reproduce this certificate as needed.

Ohio Bureau of Workers' Compensation

Required Posting

Section 4123.54 of the Ohio Revised Code requires notice of rebuttable presumption. Rebuttable presumption means an employee may dispute or prove untrue the presumption (or belief) that alcohol, marihuana or a controlled substance not prescribed by the employee's physician is the proximate cause (main reason) of the work-related injury.

The burden of proof is on the employee to prove the presence of alcohol, marihuana or a controlled substance was not the proximate cause of the work-related injury. An employee who tests positive or refuses to submit to chemical testing may be disqualified for compensation and benefits under the Workers' Compensation Act.



**Bureau of Workers'
Compensation**

You must post this language with the Certificate of Ohio Workers' Compensation.

INSURANCE CERTIFICATE ATTACHMENT SHEET



CERTIFICATE OF LIABILITY INSURANCE

DATE (MM/DD/YYYY)

12/05/2023

THIS CERTIFICATE IS ISSUED AS A MATTER OF INFORMATION ONLY AND CONFERS NO RIGHTS UPON THE CERTIFICATE HOLDER. THIS CERTIFICATE DOES NOT AFFIRMATIVELY OR NEGATIVELY AMEND, EXTEND OR ALTER THE COVERAGE AFFORDED BY THE POLICIES BELOW. THIS CERTIFICATE OF INSURANCE DOES NOT CONSTITUTE A CONTRACT BETWEEN THE ISSUING INSURER(S), AUTHORIZED REPRESENTATIVE OR PRODUCER, AND THE CERTIFICATE HOLDER.

IMPORTANT: If the certificate holder is an ADDITIONAL INSURED, the policy(ies) must have ADDITIONAL INSURED provisions or be endorsed. If SUBROGATION IS WAIVED, subject to the terms and conditions of the policy, certain policies may require an endorsement. A statement on this certificate does not confer rights to the certificate holder in lieu of such endorsement(s).

PRODUCER Kernan Insurance Agency, Inc. 9932 Brewster Lane Powell OH 43065		CONTACT NAME: Batchelder, Laura M. PHONE (A/C, No, Ext): (614)764-0121 FAX (A/C, No): (614)764-0310 E-MAIL ADDRESS: certificates@kernaninsurance.com																						
INSURED Strawser Paving Co., Inc. 1595 Frank Road Columbus OH 43223		<table border="1"><thead><tr><th colspan="2">INSURER(S) AFFORDING COVERAGE</th><th>NAIC #</th></tr></thead><tbody><tr><td>INSURER A:</td><td>Erie Ins Exch</td><td>26271</td></tr><tr><td>INSURER B:</td><td>CNA</td><td>000000</td></tr><tr><td>INSURER C:</td><td></td><td></td></tr><tr><td>INSURER D:</td><td></td><td></td></tr><tr><td>INSURER E:</td><td></td><td></td></tr><tr><td>INSURER F:</td><td></td><td></td></tr></tbody></table>		INSURER(S) AFFORDING COVERAGE		NAIC #	INSURER A:	Erie Ins Exch	26271	INSURER B:	CNA	000000	INSURER C:			INSURER D:			INSURER E:			INSURER F:		
INSURER(S) AFFORDING COVERAGE		NAIC #																						
INSURER A:	Erie Ins Exch	26271																						
INSURER B:	CNA	000000																						
INSURER C:																								
INSURER D:																								
INSURER E:																								
INSURER F:																								

COVERAGES**CERTIFICATE NUMBER:****REVISION NUMBER:**

THIS IS TO CERTIFY THAT THE POLICIES OF INSURANCE LISTED BELOW HAVE BEEN ISSUED TO THE INSURED NAMED ABOVE FOR THE POLICY PERIOD INDICATED. NOTWITHSTANDING ANY REQUIREMENT, TERM OR CONDITION OF ANY CONTRACT OR OTHER DOCUMENT WITH RESPECT TO WHICH THIS CERTIFICATE MAY BE ISSUED OR MAY PERTAIN, THE INSURANCE AFFORDED BY THE POLICIES DESCRIBED HEREIN IS SUBJECT TO ALL THE TERMS, EXCLUSIONS AND CONDITIONS OF SUCH POLICIES. LIMITS SHOWN MAY HAVE BEEN REDUCED BY PAID CLAIMS.

INSR LTR	TYPE OF INSURANCE	ADDL INSD	SUBR WVD	POLICY NUMBER	POLICY EFF (MM/DD/YYYY)	POLICY EXP (MM/DD/YYYY)	LIMITS
A	<input checked="" type="checkbox"/> COMMERCIAL GENERAL LIABILITY <input type="checkbox"/> CLAIMS-MADE <input checked="" type="checkbox"/> OCCUR GEN'L AGGREGATE LIMIT APPLIES PER: <input type="checkbox"/> POLICY <input checked="" type="checkbox"/> PRO-JECT <input type="checkbox"/> LOC OTHER:	Y	N	Q48-0152061	12/01/2023	12/01/2024	EACH OCCURRENCE \$ 1000000 DAMAGE TO RENTED PREMISES (Ea occurrence) \$ 1000000 MED EXP (Any one person) \$ 10000 PERSONAL & ADV INJURY \$ 1000000 GENERAL AGGREGATE \$ 2000000 PRODUCTS - COMP/OP AGG \$ 2000000 \$
	<input checked="" type="checkbox"/> AUTOMOBILE LIABILITY <input checked="" type="checkbox"/> ANY AUTO <input type="checkbox"/> OWNED AUTOS ONLY <input type="checkbox"/> SCHEDULED AUTOS <input checked="" type="checkbox"/> HIRED AUTOS ONLY <input checked="" type="checkbox"/> NON-OWNED AUTOS ONLY	N	N	Q12-5140039	12/01/2023	12/01/2024	COMBINED SINGLE LIMIT (Ea accident) \$ 1000000 BODILY INJURY (Per person) \$ BODILY INJURY (Per accident) \$ PROPERTY DAMAGE (Per accident) \$ 1000000 \$
	<input checked="" type="checkbox"/> UMBRELLA LIAB <input checked="" type="checkbox"/> OCCUR <input type="checkbox"/> EXCESS LIAB <input type="checkbox"/> CLAIMS-MADE DED RETENTION \$	N	N	Q36-0170674	12/01/2023	12/01/2024	EACH OCCURRENCE \$ 10000000 AGGREGATE \$ \$
	<input checked="" type="checkbox"/> WORKERS COMPENSATION AND EMPLOYERS' LIABILITY ANY PROPRIETOR/PARTNER/EXECUTIVE OFFICER/MEMBER EXCLUDED? (Mandatory in NH) If yes, describe under DESCRIPTION OF OPERATIONS below Y/N <input type="checkbox"/>	N/A	N	Q48-0152061	12/01/2023	12/01/2024	PER STATUTE OTH-ER *Ohio Stop Gap Only E.L. EACH ACCIDENT \$ 1,000,000 E.L. DISEASE - EA EMPLOYEE \$ 1,000,000 E.L. DISEASE - POLICY LIMIT \$ 1,000,000
B	Contractors Equipment	N	N	C 6075630001	12/01/2022	12/01/2023	Blanket Limit 17,573,480 Limit Per Item \$1,000,000 Deductible 1,000

DESCRIPTION OF OPERATIONS / LOCATIONS / VEHICLES (ACORD 101, Additional Remarks Schedule, may be attached if more space is required)

Certificate Holder is additional insured as respects general liability for any and all work performed during policy term.

CERTIFICATE HOLDER**CANCELLATION**

SHOULD ANY OF THE ABOVE DESCRIBED POLICIES BE CANCELLED BEFORE THE EXPIRATION DATE THEREOF, NOTICE WILL BE DELIVERED IN ACCORDANCE WITH THE POLICY PROVISIONS.

AUTHORIZED REPRESENTATIVE

Fax:

Email:

© 1988-2015 ACORD CORPORATION. All rights reserved.

ACORD 25 (2016/03)

The ACORD name and logo are registered marks of ACORD

NOTICE OF COMMENCEMENT OF PUBLIC IMPROVEMENT

Section 1311.252, Ohio Revised Code

Notice is hereby given of the commencement of a public improvement as follows:

1. The public improvement is identified as:

Project Name: 2024 Street and Sidewalk Program, ST-1110
Project Location: The City of Gahanna, Ohio

2. The public authority and Owner responsible for the public improvement is:

City of Gahanna
200 S Hamilton Rd
Gahanna, OH 43230

3. The principal contractor and its surety on the public improvement are as follows:

Principal Contractor: Strawser Paving Company
Surety: Fidelity and Deposit Company of Maryland

4. The date the City of Gahanna first executed a contract with a principal contractor for this public improvement is: April 2, 2024

5. The name and address of the representative for the City of Gahanna upon whom service may be made for the purposes of serving an affidavit pursuant to Section 1311.26 of the Ohio Revised Code is:

Tom Komlanc
Director of Engineering
City of Gahanna
200 S Hamilton Rd
Gahanna, OH 43230

The foregoing is true and accurate to the best of my knowledge and the information available to me.



Signature


Title



Printed Name

Sworn and subscribed before me this 8th day of April, 2024.



GINA K SHEPPARD
Notary Public
State of Ohio
My Comm. Expires
July 8, 2025


Notary Public

NOTICE OF AWARD TO CONTRACTOR

To: Strawser Paving Company

Date:

Project: 2024 Street and Sidewalk Program, ST-1110

The Owner has considered the Bid submitted by you for the above-described work in response to the Legal Notice dated: January 23, 2024 & January 30, 2024.

You are hereby notified that your bid has been accepted for items in the amount of \$5,265,406.86 (Base Bid + 3 Alternates).


You are required by the Information for Bidders to execute the Contract and furnish the required documents within ten (10) calendar days from the date of this notice to you.

If you fail to execute said Contract within ten (10) days from the date of this notice, Owner may—at its discretion—exercise its rights with respect to your bid guaranty and be entitled to such other rights as may be granted by Law.

You are required to return an acknowledged copy of this Notice of Award to the Owner.

Dated this 16 day of April, 2024

By:



Tom Komlanc
Director of Engineering

ACCEPTANCE OF NOTICE

Receipt of the above Notice of Award is hereby acknowledged.

Contractor:

This 16th day of Apr. 7, 2024

By:



Name: Cory Strawser

Title: Secretary - Treasurer

NOTICE OF AWARD TO SURETY AND SURETY'S AGENT

Date:

SENT BY REGULAR U.S. MAIL

Surety Company
Fidelity and Deposit Company of Maryland
1299 Zurich Way
Schaumburg, IL 50196-1056


Surety Agent
Kernan Insurance Agency, Inc.
9932 Brewster Lane
Powell, OH 43065

Re: Notice of Award of Contract

To Whom It May Concern:

You are notified that your principal, Strawser Paving Company, has been awarded a contract for the 2024 Street and Sidewalk Program, ST-1110, in the amount of \$5,265,406.86, by the City of Gahanna.

Thank you,

By: 
Angela Roth
Engineering Program Coordinator

NOTICE TO PROCEED

To: Strawser Paving Company

Date:

Project: 2024 Street and Sidewalk Program, ST-1110

Owner: City of Gahanna
200 South Hamilton Road
Gahanna, Ohio 43230

You are hereby notified to commence Work in accordance with the Agreement dated April 2, 2024 and you are to complete the Work in the time required by Section 3.2 of the Owner/Contractor Agreement and other Contract Documents. Within ten (10) days from this Notice to Proceed date, you will begin physical, on-site improvements. You are required to return an acknowledged copy of this Notice to Proceed, to the Owner, indicating Acceptance of this Notice to Proceed.



Tom Komlanc
Director of Engineering

ACCEPTANCE OF NOTICE TO PROCEED

Receipt of the above NOTICE TO PROCEED is hereby acknowledged by
Strawser Paving Co., Inc. this the day of April 16, 2024.

By: 

Title: Secretary - Treasurer

CHANGE ORDER

Order No: _____

Date: _____

Agreement Date: _____

Name of PROJECT: **2024 Street and Sidewalk Program, ST-1110**

OWNER: **City of Gahanna, Ohio**

CONTRACTOR: **Strawser Paving Company**

The following changes are hereby made to the CONTRACT DOCUMENTS:

Justification: _____

Change to CONTRACT PRICE: \$_____

Original CONTRACT PRICE: \$_____

Current CONTRACT PRICE adjusted by previous
CHANGE ORDER \$_____

The CONTRACT PRICE due to this CHANGE ORDER will be (increased)
(decreased) by : \$_____

The CONTRACT PRICE amount INCLUDING this CHANGE ORDER: \$_____

Change to CONTRACT TIME:

The CONTRACT TIME will be (increased) (decreased) by _____
calendar days.

The date for completion of all WORK will be _____(Date)

CONTRACTOR AGREES THAT THIS CHANGE ORDER SHALL CONSTITUTE A FINAL SETTLEMENT OF ALL MATTERS RELATING TO THE CHANGE IN THE WORK THAT IS THE SUBJECT OF THIS CHANGE ORDER, INCLUDING, BUT NOT LIMITED TO, ALL DIRECT, INDIRECT, AND CUMULATIVE COSTS ASSOCIATED WITH SUCH CHANGE AND ALL ADJUSTMENTS TO THE CONTRACT SUM AND THE DATE FOR SUBSTANTIAL COMPLETION.

Contractor's Signature: _____

Owner: _____

Project Administrator: _____

PAYROLL INFORMATION

Date _____

I, _____ (Name of Signatory Party), _____
(Title), do hereby certify:

1. That I pay or supervise the payment of the persons employed
by _____ (Contractor) on the _____ (Project).

2. That during the payroll period commencing on the _____ day of
_____, 2024, and ending on the _____ day of _____,
2024, all persons employed on said project have been paid in full weekly wages earned; that
no rebates have been or will be made either directly or indirectly to or on behalf of said
_____ (Contractor) from the full weekly wages earned by such
persons; and that no deductions have been made either directly or indirectly from the wages
earned by such persons, other than permissible deductions which are described below:

3. That any payrolls otherwise under this Contract required for the above period are correct
and complete; that the wage rates for laborers or mechanics contained therein are not less
than the applicable wage rates contained in the specifications as supplied by the Department
of Industrial Relations or any wage determination incorporated into the Contract and that the
classifications set forth therein for each laborer or mechanic conform with the work he
performed.

4. That any apprentices employed in the above period are duly registered in a bona fide
apprenticeship program registered with the Ohio Apprenticeship Council.

5. That:

(a) Where fringe benefits are paid to approved plans, funds, or programs, in addition
to the basic hourly wage rates paid to each laborer or mechanic listed in the above referenced
payroll, payments of fringe benefits listed in the Contract have been or will be made to
appropriate programs for the benefit of such employees, except as noted in Section 5(c)
below; and

(b) Where fringe benefits are paid in cash, each laborer or mechanic listed in the above
referenced payroll has been paid as indicated on the payroll, and amount not less than the
sum of the applicable basic hourly wage rate plus the amount of the required fringe benefits
as listed in the Contract, except as noted in Section 5(c) below:

(c) Exceptions:

Exception (Craft)

Explanation

Remarks

Name and Title _____,

Signature

The willful falsification of any of the above statements may subject the Contractor or Subcontractor to fines as described in Section 4115.99 of the Ohio Revised Code.

FINAL PAYROLL AFFIDAVIT

I, _____ (Name of person signing affidavit),
_____ (title),
of the _____, do hereby certify that the
wages paid to all employees for the full number of hours worked in connection with the
Contract to the Improvement, Repair and Construction of: **2024 Street and Sidewalk
Program, ST-1110** (Project) during the following period from _____
to _____ is in accordance with the prevailing wages prescribed by the
Contract Documents. I further certify that no rebates or deductions for any wages due any
person have been directly or indirectly made other than those provided by law.

(Signature of Officer or Agent)

Sworn to and subscribed in my presence this _____ day of
_____, 2024.

Notary Public

The above affidavit must be executed and sworn to by the officer or agent or the Contractor or Subcontractor who supervised the payment of employees, before the Owner will release the surety and/or make final payment due under the terms of the Contract.

CONTRACTOR'S PAYMENT APPLICATION CHECKLIST

THE CONTRACTOR MUST COMPLETE THIS CHECKLIST AND SUBMIT IT TO THE DESIGN PROFESSIONAL WITH ITS PAYMENT APPLICATION AND ALL REQUIRED DOCUMENTATION.

1. Contractor's Name: _____
2. Name, title, and telephone and fax numbers of Contractor's representative to contact regarding the Payment Application and required documentation:
Name: _____ Title: _____
Office Telephone No.: (____) _____ FAX No.: (____) _____
3. Payment Application Number and Date:
No. _____ Date: _____, 2024
4. The following is a list of required documentation that must accompany its Payment Application. The Contractor certifies that it has submitted the documentation listed below with its Payment Application. If the Contractor cannot do so, the Contractor should explain why in Paragraph 5. Such explanations shall not excuse the Contractor from the requirements for submitting this documentation.
 - _____ .1 Two (2) copies of a properly completed and executed Application for Payment with a properly completed and executed Schedule of Values attached to each;
 - _____ .2 Properly Completed Contractor's Affidavit with List of Subcontractors and Suppliers and Any Amounts Withheld;
 - _____ .3 Contractor's Wavier and Release Agreement (beginning with the second Application for Payment);
 - _____ .4 For each of its Subcontractors and Suppliers, a Subcontractor's – Supplier's Waiver and Release Agreement (beginning with the second Application for Payment);
 - _____ .5 Schedule of all materials and equipment stored on-site;
 - _____ .6 For materials and equipment stored off-site:
 - _____ A list of the materials and equipment consigned and stored off-site in connection with the Project (which shall be clearly identified), giving the place of storage, together with copies of invoices and reasons why the materials and equipment cannot be delivered to the site;
 - _____ Certification that all items have been tagged for delivery to the Project and that they will not be used for any other purpose;
 - _____ A letter from the Contractor's surety bonding company indicating agreement to the arrangements and that

payment to the Contractor shall not relieve either party of its responsibility to complete the facility;

_____ Evidence of adequate insurance covering the material and equipment in storage, which shall name the Owner as additional insured;

_____ Evidence that the Design Professional has visited the Contractor's place of storage and found that all the materials and equipment set forth in the payment request and represented to be stored off-site are stored at the place of storage (any costs incurred by the Design Professional to inspect material and equipment in off-site storage shall be paid by the Contractor); and

_____ Itemization of the materials and equipment and their cost, which were approved on previous Pay Applications and which remain in off-site storage.

_____ .7 Other documentation or information required by the Contract Documents or by the Design Professional or Owner.

5. Reason why required documentation is not submitted:

NOTE: The failure to submit required documentation, regardless of the reason, may result in non- payment, partial payment, and/or late payment.

Signature

Printed Name

Date

PROJECT ADMINISTRATOR REVIEW

_____ Checklist and documentation complete.

_____ Checklist and documentation incomplete.

Signature

Printed Name

Date

**CONTRACTOR'S AFFIDAVIT WITH LIST OF SUBCONTRACTORS AND SUPPLIERS
WITH ANY AMOUNTS WITHHELD**

PROJECT:
2024 Street Program,
ST-1110
Various Streets in Gahanna

CONTRACTOR:
Strawser Paving Company

STATE OF _____ :
COUNTY OF _____ : SS,

The undersigned after first being sworn swears that a) all previous progress payments received on account of the Work have been applied on account to discharge Contractor's legitimate obligations associated with prior Applications for Payment, b) the Contractor has submitted Subcontractor(s) – Supplier(s) Waiver and Release Agreements for each of its Subcontractors and Suppliers using the form set forth in the Project Manual or as requested by the Design Professional, c) set forth below is a complete list of its Subcontractors and Suppliers, and d) set forth below is a complete description of all amounts withheld from any Subcontractor or Supplier and the reason why. Attach additional sheets if necessary. Contractor certifies that it has self-performed work amounting to not less than 50% of the total contract sum.

[illegible]

WITHHOLDINGS FROM SUBCONTRACTORS AND/OR SUPPLIERS:

Typed or Printed Name of Subcontractor or Supplier	Amount Withheld	Reason for Withholding

CONTRACTOR: [insert name]

BY: _____
(Signature of authorized representative)

NOTARY PUBLIC

Subscribed and sworn to before me on this date by _____ on behalf of
_____.

Signature of Notary Public

Notary Public: _____

My Commission Expires: _____

CONTRACTOR'S WAIVER & RELEASE AGREEMENT

("AGREEMENT")

Project: 2024 Street and Sidewalk Program, ST-1110

The undersigned hereby acknowledges receipt of payment from the Owner for all Work on the Project through the date of its prior Application for Payment. The undersigned acknowledges and agrees that the terms in this Agreement shall have the same meaning as in the Contract Documents for the Project.

In return for said payment, and/or pursuant to certain contractual obligations of the undersigned, the undersigned hereby waives and releases any rights it has or may have through the date of its last Application for Payment to any and all Claims and liens related to the Project, including without limitation: Claims of payment, mechanic's liens, liens against funds, surety bond Claims, and Claims for breach of contract or unjust enrichment. The sole exception to this waiver and release is for any Claims the undersigned has made by properly and timely submitting a Statement of Claim form. The undersigned acknowledges and agrees that this waiver and release is intended to be a comprehensive release of all Claims and liens related to the Project, including without limitation all Claims against the Owner, the Design Professional, any Construction Manager, and the employees, board members, agents and representatives of any of the foregoing persons. The undersigned further certifies that this Agreement covers Claims and liens by all persons with which it did business related to the Project, including without limitation subcontractors and suppliers, through the date of its last Application for Payment. The undersigned represents that all such persons have signed an agreement in the form of this Agreement releasing any and all Claims and liens related to the Project, except for any Claims made by properly and timely submitting a Statement of Claim form, a copy of which has been delivered to the Design Professional and the Owner. The undersigned hereby represents and warrants that it has paid any and all welfare, pension, vacation or other contributions required to be paid on account of the employment by the undersigned of any laborers on the Project.

This Agreement is for the benefit of, and may be relied upon by the Owner, Design Professional and any Construction Manager. The undersigned hereby agrees to indemnify, defend and hold harmless each of the foregoing, the Project, work or improvement, and real property from any and all Claims, or liens that are or should have been released in accordance with this Agreement.

Company Name

Authorized Signature (Company Officer)

Title

Date

State of: _____ County of _____

Subscribed and sworn to before me this _____ day of _____, 2024.

Notary Public: _____

My Commission Expires: _____

SUBCONTRACTOR'S/SUPPLIER'S WAIVER & RELEASE AGREEMENT
("AGREEMENT")

Project: 2024 Street and Sidewalk Program, ST-1110

The undersigned hereby acknowledges receipt of payment for all Work on the Project through the date of the prior Application for Payment by the Prime Contractor ("Prime Contractor") with which it has a contract. The undersigned acknowledges and agrees that the terms in this Agreement shall have the same meaning as in the Contract Documents for the Project.

In return for said payment, and/or pursuant to certain contractual obligations of the undersigned, the undersigned hereby waives and releases any rights it has or may have through the date of the Prime Contractor's last Application for Payment and to any and all Claims and liens related to the Project, including without limitation: Claims of payment, mechanic's liens, liens against funds, surety bond Claims, and Claims for breach of contract or unjust enrichment. The sole exception to this waiver and release is for any Claims the undersigned has made by properly and timely submitting a Statement of Claim form, a copy of which the undersigned represents has been delivered to the Owner and the Design Professional. The undersigned acknowledges and agrees that this waiver and release is intended to be a comprehensive release of all Claims and liens related to the Project, including without limitation all Claims against the Prime Contractor, the Prime Contractor's surety, the Owner, the Design Professional, any Construction Manager, and the employees, board members, agents and representatives of any of the foregoing persons. The undersigned further certifies that this Agreement covers Claims and liens by all persons with which it did business related to the Project, including without limitation sub-subcontractors and suppliers, through the date of the Prime Contractor's last Application for Payment. The undersigned represents that all such persons have signed an agreement in the form of this Agreement releasing any and all Claims and liens related to the Project, except for any Claims made by properly and timely submitting a Statement of Claim form, a copy of which has been delivered to the Design Professional and the Owner. The undersigned hereby represents and warrants that it has paid any and all welfare, pension, vacation or other contributions required to be paid on account of the employment by the undersigned of any laborers on the Project.

The undersigned agrees that upon receipt of the payment from the Prime Contractor with respect to the Prime Contractor's current Application for Payment, it shall, upon request of the Prime Contractor, Owner, Design Professional, or any Construction Manager, execute a waiver and release agreement in the form of this Agreement, except that such Agreement shall be current through the date of the Prime Contractor's current Payment Application. The undersigned further agrees that, upon receipt of such payment, it shall execute any other documents requested to cause the prejudicial release of any and all Claims and liens through the date of the Prime Contractor's current Payment Application.

This Agreement is for the benefit of, and may be relied upon by, the Prime Contractor, the Prime Contractor's surety, the Owner, the Design Professional and any Construction Manager. The undersigned hereby agrees to indemnify, defend and hold harmless each of the foregoing: the Project, its Work, and real property from any and all Claims and/or liens that are or should have been released in accordance with this Agreement and from any liability, cost, or expense incurred as a result of any breach of this Agreement by the undersigned.

Company Name

Authorized Signature (Company Officer)

Title

Date

State of: _____ County of _____

Subscribed and sworn to before me this _____ day of _____, 2024.

Notary Public: _____

My Commission Expires: _____

STATEMENT OF CLAIM FORM

Claim No. ____ for Contractor

1. Name of Contractor: _____

2. Date written claim given: _____.

3. Contractor's representative to contact regarding the claim:

Name: _____ Title: _____

Telephone No. _____ (office) FAX No. _____

E-mail: _____

4. General description of claim:

5. Contract Documents. If the claim is based upon any part or provision in the Contract Documents, including but not limited to pages in the Drawings and/or paragraphs in the Specifications, Owner-Contractor Agreement, General Conditions or Supplementary General Conditions, state upon which parts or provisions the claim is based:

6. Delay claims:

6.1 Date delay commenced: _____

6.2 Duration or expected duration of the delay, if known: _____

6.3 Apparent cause of the delay and part of critical path affected:

6.4 Expected impact of the delay and recommendations for minimizing such impact:

7. Additional compensation. Set forth in detail all additional compensation to which the Contractor believes it is entitled with respect to this claim:

8. Instructions for Completing the Statement of Claim Form ("Instructions"). The Instructions are incorporated in this Form.

9. Truth of Claim. By submitting this claim, the Contractor and its representative certify that after conscientious and thorough review and to the best of his or her knowledge and belief a) the Contractor has complied fully with the Instructions, b) the information in this State of Claim is accurate, c) the Contractor is entitled to recover the compensation in paragraph 7, and d) the Contractor has not knowingly presented a false or fraudulent claim. The Contractor by its authorized representative must acknowledge this Statement of Claim before a notary public.

CONTRACTOR: _____

By: _____

Name and Title: _____

Date: _____

CONTRACTOR'S ACKNOWLEDGMENT

State of _____,

County of _____, ss:

_____ first being sworn, states that after conscientious and thorough review, the statements made in attached Statement of Claim Form are complete and true to the best of his or her knowledge and belief.

Sworn to before me a notary public by _____ on _____, 2024.

Notary Public

WHEN COMPLETED, FORWARD A COPY OF THIS NOTICE AND STATEMENT OF CLAIM FORM TO THE OWNER AND DESIGN PROFESSIONAL.

STATEMENT OF CLAIM FORM INSTRUCTIONS

1. Completing the Statement of Claim Form ("Claim Form") is a material term of the Contract. The Claim Form tells the Owner and Design Professional that the Contractor is making a Claim and that they need to act promptly to mitigate the effects of the occurrence giving rise to the Claim. The Claim Form also provides them with information so that they can mitigate such effects. The Contractor acknowledges that constructive knowledge of the conditions giving rise to the Claim through job meetings, correspondence, site observations, etc. is inadequate notice, because knowledge of these conditions does not tell the Owner and Design Professional that the Contractor will be making a Claim and most often is incomplete.
2. If the space provided in the Claim Form is insufficient, the Contractor, as necessary to provide complete and detailed information, must attach pages to the Claim Form with the required information.
3. Paragraph 4. The Contractor must state what it wants, *i.e.*, time and/or compensation, and the reason why it is entitled to time and/or compensation.
4. Paragraph 5. The Contractor must identify the exact provisions of the Contract Documents it is relying on in making its Claim. For example, if the Claim is for a change in the scope of the Contractor's Work, the Contractor must identify the specific provisions of the Specifications, and the Plan sheets and details that provide the basis for the scope change.
5. Paragraph 6. This paragraph applies to delay claims, including delays that the Contractor believes result in constructive acceleration. The Contractor must identify the cause of the delay, party or parties responsible, and what the party did or did not do that caused the delay, *i.e.*, specific work activities. The Contractor acknowledges that general statements are not sufficient, and do not provide the Owner with sufficient information to exercise the remedies available to the Owner or to mitigate the effects of the delay.

For example, if the Contractor claims a slow response time on submittals caused a delay, the Contractor must identify the specific submittals, all relevant dates, and then show on the applicable schedule, by circling or highlighting, the activities immediately affected by the delays. Also for example, if the Contractor claims it was delayed by another Contractor, the Contractor must identify the delaying Contractor, specifically what the delaying Contractor did or did not do that caused the delay, and then show the applicable schedule, by circling or highlighting, the activities immediately affected by the delays. Further by example, if the Contractor seeks an extension of time for unusually severe weather, the Contractor must submit comparative weather data along with a record of the actual weather at the job site and job site conditions.

6. Paragraph 6.4. Time is of the essence under the Contract Documents. If there is a delay, it is important to know what can be done to minimize the impact of the delay. It therefore is important that the Contractor provide specific recommendations on how to do so.

7. Paragraph 7. The Contractor must provide a specific and detailed breakdown of the additional compensation it seeks to recover. For future compensation, the Contractor shall provide its best estimate of such compensation.
8. Paragraph 8 and Acknowledgment. By submitting this Claim, the Contractor and its representative certify that after conscientious and thorough review and to the best of his or her knowledge and belief a) the Contractor has complied fully with the Instructions, b) the information in this Claim Form is accurate, c) the Contractor is entitled to recover the compensation in paragraph 7, and d) the Contractor has not knowingly presented a false or fraudulent claim. The Contractor by its authorized representative must acknowledge this Statement of Claim before a notary public.

END OF INSTRUCTIONS

**DESIGN PROFESSIONAL'S
CERTIFICATE OF SUBSTANTIAL COMPLETION**

Project:
2024 Street and Sidewalk
Program, ST-1110
Various Streets in Gahanna

Contract For:
Concrete Work, Pavement Milling,
Asphalt Resurfacing, Crack Sealing,
Street Rebuilds, & Striping; Add
Alternates: Additional Crack Seal,
Gahanna Golf Course Paths,
Additional Striping

Owner:
City of Gahanna
200 South Hamilton Road
Gahanna, Ohio 43230

CONTRACTOR:
Strawser Paving Company
1595 Frank Rd
Columbus, OH 43223

The Design Professional hereby certifies that the Date for Substantial Completion of the Contractor's Work as set forth in the Owner-Contractor Agreement is:

Date: August 2, 2024 (Street Program) & November 25, 2024 (Gahanna Golf Course Paths)

The Design Professional hereby certifies that the Date for Substantial Completion in the Contractor's Agreement with the Owner (the "Agreement"), as extended by Change Orders and Claims submitted by the Contractor that have been resolved, as defined below, is:

1. Date for Substantial Completion in the Agreement (above): _____
2. Additional days added to Date for Substantial Completion by Change Order: _____
3. Additional days added by Claims that have been Finally Resolved: _____
4. Date for Substantial Completion in the Contract Adjusted by days under No. 2 and No. 3 _____

The Design Professional certifies that the Contractor's Work to the best of the Design Professional's knowledge, information, and belief was Substantially Complete, as Substantial Completion is defined in the Contract Documents, on _____.

The Design Professional hereby certifies that the difference between (a) the Date for Substantial Completion adjusted by the days under No. 2 and No. 3 above and (b) the date the Contractor's Work was Substantially Complete is _____ days.

NOTICES OF DELAY. The Design Professional hereby certifies that all “NOTICES OF DELAY” submitted by the Contractor and described in the General Conditions are attached to this Certificate. This certification is solely for the purpose of identifying all “NOTICES OF DELAY” submitted by the Contractor and is not intended to imply that any of these NOTICES OF DELAY were properly submitted in accordance with Contract Documents or are valid.

STATEMENT OF CLAIM FORMS. The Design Professional hereby certifies that all Statement of Claim Forms described in the General Conditions and submitted by the Contractor are attached to this Certificate. This certification is solely for the purpose of identifying all Statement of Claim Forms submitted by the Contractor and is not intended to imply that any of these Statement of Claim Forms were properly submitted in accordance with Contract Documents or are valid.

PUNCHLIST ITEMS. A list of items to be completed by the Contractor is attached to this Certificate. The failure to include items on this list does not change the responsibility of the Contractor to complete its Work in accordance with the Contract Documents. The Contractor shall complete all items on the Punchlist in accordance with the Contract Documents.

Security, maintenance, utilities, damage to the Work and insurance are the responsibility of the Owner and the Contractor based on their operations pursuant to final completion of the Work.

Copies of this Certificate were provided to the Contractor and the Owner on _____.

Design Professional: _____

Signature: _____

Date: _____

APPENDIX F

City of Columbus Construction & Material Specifications Supplement

CITY OF COLUMBUS CONSTRUCTION AND MATERIAL SPECIFICATIONS SUPPLEMENT

This Supplement shall apply where and to the extent that the City of Columbus Construction and Material Specifications, in the current version as of January 23, 2024 is expressly incorporated into the Contract Documents via the Owner-Contractor Agreement, or when designated as a Contract Document in the list of Contract Documents in the Owner-Contractor Agreement or is referenced anywhere else in the Contract Documents as one of the Contract Documents.

1. Regardless of any terms to the contrary in Division 100 or elsewhere, any directions or orders of the Engineer that will result in an adjustment of the Contract Price or the Contract Time shall require the prior written approval of the Owner. It is expressly understood and agreed that the Engineer does not have authority to authorize changes or modifications in the Contract Price or Contract Time.
2. The Contractor's obligations under this Supplement are in addition to and not in limitation of its other obligations under the Contract Documents.
3. **Delays.** Regardless of the terms in this Supplement, all time adjustments shall be subject to a) filing a Change Proposal and / or Claim in accordance with Articles 11 and 12 of the Modified Standard General Conditions of the Contract for Construction (EJCDC C-700, 2013 edition) ("Modified Standard General Conditions"), b) substantiating the Contractor's entitlement to a time adjustment in accordance with the Modified Standard General Conditions and c) Item 109.05(c). The Contractor will be entitled to additional compensation for delays but only for those delays described in the Modified Standard General Conditions. As part of the Claims process and as a condition precedent to receiving any additional compensation, the Contractor shall prepare a cost analysis as allowed by Item 109.05(c) substantiating its entitlement to additional compensation.
4. **Division 100, General Provisions.** The following Division 100 General Provisions of City of Columbus Construction and Material Specifications, in the current version as of January 23, 2024, are incorporated in this Supplement, subject to any changes or limitations herein.
 - a. Item 101.02, Abbreviations.
 - b. Item 101.03, Definitions, provided where terms that are defined in the other Contract Documents, the definition in the other Contract Documents shall control, and further provided that the following definitions are deleted, modified and/or added:
 - i. "City" shall mean City of Gahanna.
 - ii. Director shall mean the Director of Engineering for the City.
 - iii. Department is deleted.
 - iv. Engineer is deleted.
 - v. Notice of Intent to Award is deleted.

- vi. "Owner" shall mean City of Gahanna.
 - vii. Proposal Form is deleted.
 - viii. Director shall mean the Owner's Representative.
 - ix. "Engineer" shall mean Owner's Representative.
 - x. Laboratory is deleted.
 - xi. Proposal Guaranty is deleted.
 - xii. Subcontractor is deleted.
 - xiii. Work is deleted.
- c. Item 103.03, Cancellation of Award.
 - d. Item 104.05, Right In and Use of Materials Found on the Work.
 - e. Item 104.07, Final Cleaning Up.
 - f. Item 105.02, Plans and Working Drawings, provided that the review of submittals may be by the Owner or the Engineer in the Owner's discretion.
 - g. Item 105.10 Photographs and Videos.
 - h. Item 105.11, Inspection of Work.
 - i. Item 105.12, Removal of Unacceptable and Unauthorized Work.
 - j. Item 105.13, Load Restrictions.
 - k. Item 105.14, Maintenance During Construction.
 - l. Item 105.15, Failure to Maintain Roadway or Structures, Traffic Control Facilities and Other Appurtenance.
 - m. Item 105.16, Borrow and Waste Areas.
 - n. Item 106.01, Source of Supply and Quality Requirements.
 - o. Item 106.02, Samples, Tests and Cited Specifications, provided that this Item will be optional at the discretion of the Owner. If the Owner elects to proceed under this Item, a) the Contractor without additional cost will provide material samples as required by the Owner, and b) the Owner may conduct such tests as it determines proper.
 - p. Item 106.04, Plant Inspection.
 - q. Item 106.05, Storage of Materials.
 - r. Item 106.06, Handling Materials.
 - s. Item 106.07, Unacceptable Materials.
 - t. Item 106.08, City Furnished Material.
 - u. Item 107.01, Laws to be Observed.
 - v. Item 107.02, Permits, Licenses, and Taxes.
 - w. Item 107.03, Patented Devices, Materials, and Processes.
 - x. Item 107.05, Federal-Aid Provisions.

- y. Item 107.06, Sanitary Provisions.
- z. Item 107.07, Public Convenience and Safety.
- aa. Item 107.08, Barricades and Warning Signs.
- bb. Item 107.09, Maintenance of Traffic.
- cc. Item 107.10, Use of Explosives, provided that both bringing explosives onto the site and any use of explosives shall require the prior written approval of the Owner.
- dd. Item 107.11, Protection and Restoration of Property, provided that the Contractor shall remain responsible for all damage and injury to property until the Project is Finally Complete.
- ee. Item 107.13, Responsibility for Damage Claims.
- ff. Item 107.16, Contractor's Responsibility for Work.
- gg. Item 107.17, Contractor's Responsibility for Utility Property and Services.
- hh. Item 107.18, Furnishing Right-of-Way.
- ii. Item 107.19, Personal Liability of Public Officials.
- jj. Item 107.20, No Waiver of Legal Rights.
- kk. Item 107.24, Indemnification.
- ll. Item 108.01, Subletting of Contract.
- mm. Item 108.04, Limitation of Operations.
- nn. Item 108.05, Character of Workers, Methods, and Equipment.
- oo. Item 108.09, Certified Payroll.
- pp. Item 109.01, Measurement of Quantities, provided that this item will apply only where payment is to be based on the measurement of quantities.
- qq. Item 109.04, Compensation for Altered Quantities.

5. **Divisions 200 through 1000.** City of Columbus Construction and Material Specifications, in the current version as of January 23, 2024, are incorporated in this Supplement as follows.

- a. All references to Division 100 Items in Divisions 200 through 1000 shall be to the Division 100 Items as modified in this Supplement.
- b. Where Division 100 Items are referred to in Divisions 200 through 1000 but are not included in this Supplement, the deleted references will be governed by this Paragraph 5.
- c. In Item 203.04, the reference to Item 108.06 shall be governed by Paragraph 3, Delays, in this Supplement.
- d. Any reference to Section 109.05 shall be governed by the payment provisions in the Modified Standard General Conditions, instead.

- e. In Item 514.24, the reference to Item 109.10 shall be governed by the payment provisions in the Modified Standard General Conditions.
- f. In Item 614.02(B), the reference to item 109.11 or 109.12 shall be governed by the payment provisions in the Modified Standard General Conditions, i.e., the Owner will process and make payments in accordance with the provisions in the Modified Standard General Conditions.
- g. General to Divisions 200 through 1000. The basis for payment provided in the Basis for Payment items in these Divisions shall be the basis for payment to the Contractor when applicable.

END OF COLUMBUS CMS SUPPLEMENT